



University of Southern Maine
USM Digital Commons

Maine Collection

10-23-1988

The Modern Defenses of the Coast of Maine, 1891 - 1945 (Vol. 2)

Joel W. Eastman
University of Southern Maine

Follow this and additional works at: https://digitalcommons.usm.maine.edu/me_collection

 Part of the [Architectural History and Criticism Commons](#), [Defense and Security Studies Commons](#), [Historic Preservation and Conservation Commons](#), [Military and Veterans Studies Commons](#), [Military, War, and Peace Commons](#), [Other Architecture Commons](#), and the [Peace and Conflict Studies Commons](#)

Recommended Citation

Eastman, Joel W., "The Modern Defenses of the Coast of Maine, 1891 - 1945 (Vol. 2)" (1988). *Maine Collection*. 19.

https://digitalcommons.usm.maine.edu/me_collection/19

This Book is brought to you for free and open access by USM Digital Commons. It has been accepted for inclusion in Maine Collection by an authorized administrator of USM Digital Commons. For more information, please contact jessica.c.hovey@maine.edu.

ANNEXES

TO THE MODERN DEFENSES OF THE COAST OF MAINE

1891 – 1945

Compiled by

Joel W. Eastman

UG
411
M2
E37
1988
v.2
c.2

USM LIBRARIES

V6
41
M2 E31
1988
V.2 v.2

ANNEXES

TO THE MODERN DEFENSES OF THE COAST OF MAINE

1891-1945

Compiled by

Joel W. Eastman

Prepared for

Maine Historic Preservation Commission
Augusta, Maine

October 23, 1988

INTRODUCTION

The following annexes have been compiled to supplement the main report by providing maps of all of the sites and drawings and photographs of representative types of ordnance, batteries and structures. The maps come mainly from the 1938 and 1945 "Annexes to the Harbor Defense Project, Harbor Defenses of Portland." The battery and structure plans come from the records of the Corps of Engineers at the National Archives. The ordnance drawings and photographs come from a variety of publications of the departments of Army, Ordnance and War. The historic photographs of buildings come from the Quartermaster building record forms 117 in the possession of the South Portland-Cape Elizabeth Historic Society and the Cape Elizabeth Town Library. The contemporary photographs were taken by the author.

Sources Utilized

- Department of the Army. Artillery Material and Associated Equipment. Washington, D.C.: U.S. Government Printing Office, 1949.
- War Department, "Annexes to the Harbor Defense Project, Harbor Defenses of Portland, 1938.
- War Department, "Annexes to the Harbor Defense Project, Harbor Defenses of Portland," 1945.
- War Department, Coast Artillery Weapons and Material. Washington, D.C.: U.S. Government Printing Office, 1940.
- War Department, Fundamentals of Artillery Weapons. Washington, D.C.: U.S. Government Printing Office, 1947.
- U.S. Ordnance Department. Ordnance Document, various numbers. Washington, D.C.: U.S. Government Printing Office, various dates.

LIST OF ANNEXES

Introduction

Annex 1--Maps of Forts, Reservations and Locations . . .	5
Annex 2--Representative Batteries and Ordnance	45
Annex 3--Plans of Representative Structures	76
Annex 4--Photographs of Representative Structures . . .	117

5

Annex 1--MAPS OF FORTS, RESERVATIONS AND LOCATIONS

Endicott, Taft and Inter-War Periods, 1891-1938

Fort Baldwin, Kennebec River, 1920
Fort Foster, Gerrish Island, 1935
Fort Gorges, Diamond Island Ledge, 1935
Fort Levett, Cushing Island, 1935
Fort Lyon, Cow Island, 1935
Fort McKinley, Great Diamond Island, 1935
 D-1 North Fork
 D-2 Parade Ground
 D-3 North and South Forks
Fort Preble, Spring Point, 1935
Fort Scammel, House Island, 1935
Fort Williams, 1935
Jewells Island, 1935
Long Island, 1919
Peaks Island, 1935

World War II, 1939-1945

Location of Elements, Harbor Defenses of Portland, 1945
Location no. 148 Fort Foster
Location no. 149 Sisters Point
Location no. 150 Seal Head Point
Location no. 151 Cape Neddick
Location no. 152 Bald Head Cliff
Location no. 153 Moody Beach
Location no. 154 Gelaspus Point
Location no. 155 Cape Porpoise
Location no. 156 Fletchers Neck
Location no. 157 Prouts Neck
Location no. 158 Cape Elizabeth
Location no. 159 Trundy Point
Location no. 160 Fort Williams
Location no. 161 Fort Levett
Location no. 162 Fort Preble
Location no. 163 Peak Island
Location no. 164 Fort McKinley
Location no. 165 Fort Lyon
Location no. 166 Long Island
Location no. 166A Great Chebeague Island
Location no. 167 Jewell Island
Location no. 168 Bailey Island
Location no. 169 Small Point
Location no. 170 Fort Baldwin


[EDITION OF JAN. 14, 1915.
REVISED: DEC. 7, 1915; APRIL 10, 1920.

- LEGEND.
3. OFFICERS QRS.
4. HOSPITAL.
6. NCOFFICERS QRS.
8. GUARD HOUSE.
12. BOAT HOUSE.
13. STABLE.
14. WOOD SHED.
15. STONEHOUSE.
31. ORDNANCE ST. HQ.
41. HOSPTER HOUSE AND
CEMENT SHED.
80. LIGHT-KEEPER'S HQ.
81. WOOD SHED.
82. OIL HOUSE.

KENNEBEC RIVER, ME.
FORT BALDWIN
SABINO HEAD.

CONFIDENTIAL

ABANDONED

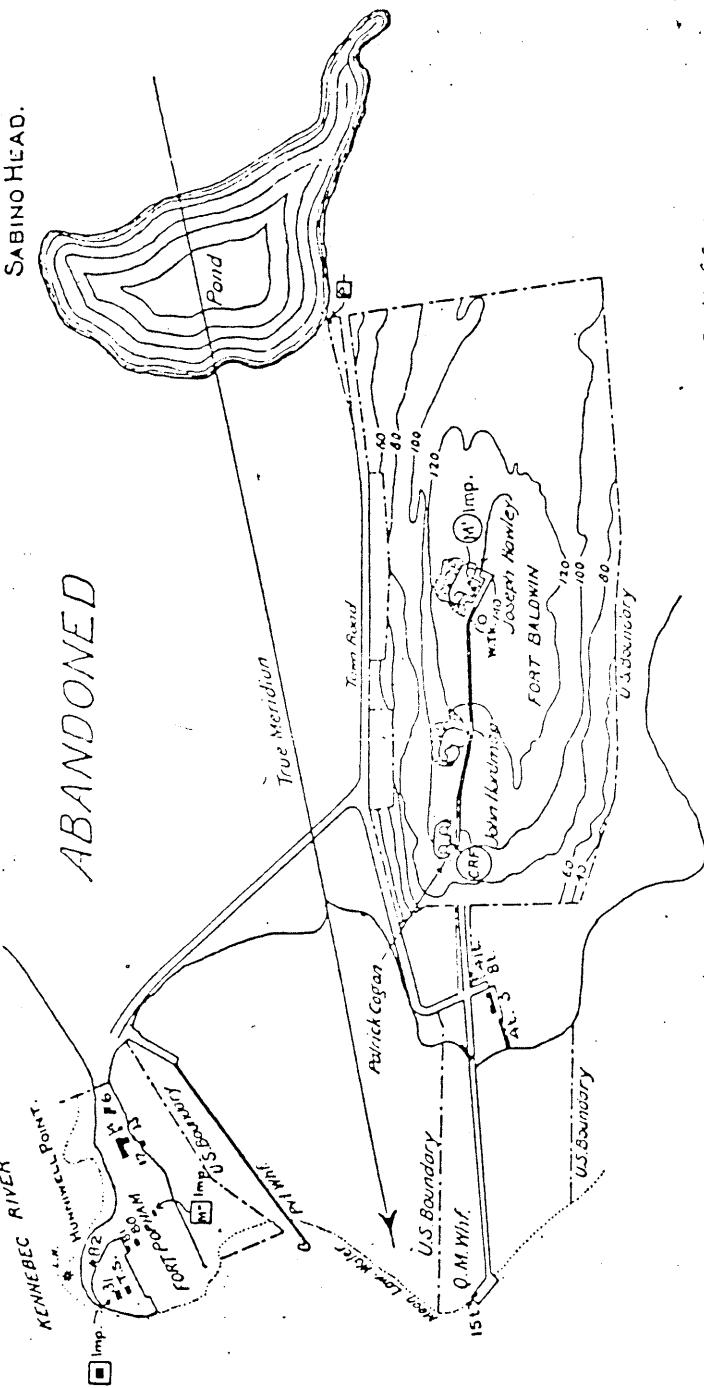


Scale of feet
100' 0' 200' 300' 400' 500' 600' 700' 800' 900' 1000' 1100'

Contour Interval 20 feet.

LEGEND. EDITION OF JAN 14, 1915.
REVISIONS, OCT. 7, 1915 MAR. 27, 1916:
APRIL 10, 1920; FEB. 11, 1921.
MAY 6, 1929, FEB. 12, 1935

SERIAL NUMBER

FORT FOSTER PORTSMOUTH HARBUR, N.H.
BOHLEN...3-10" DIE
CHAPIN.....2-3" P.
DATTENLOH.

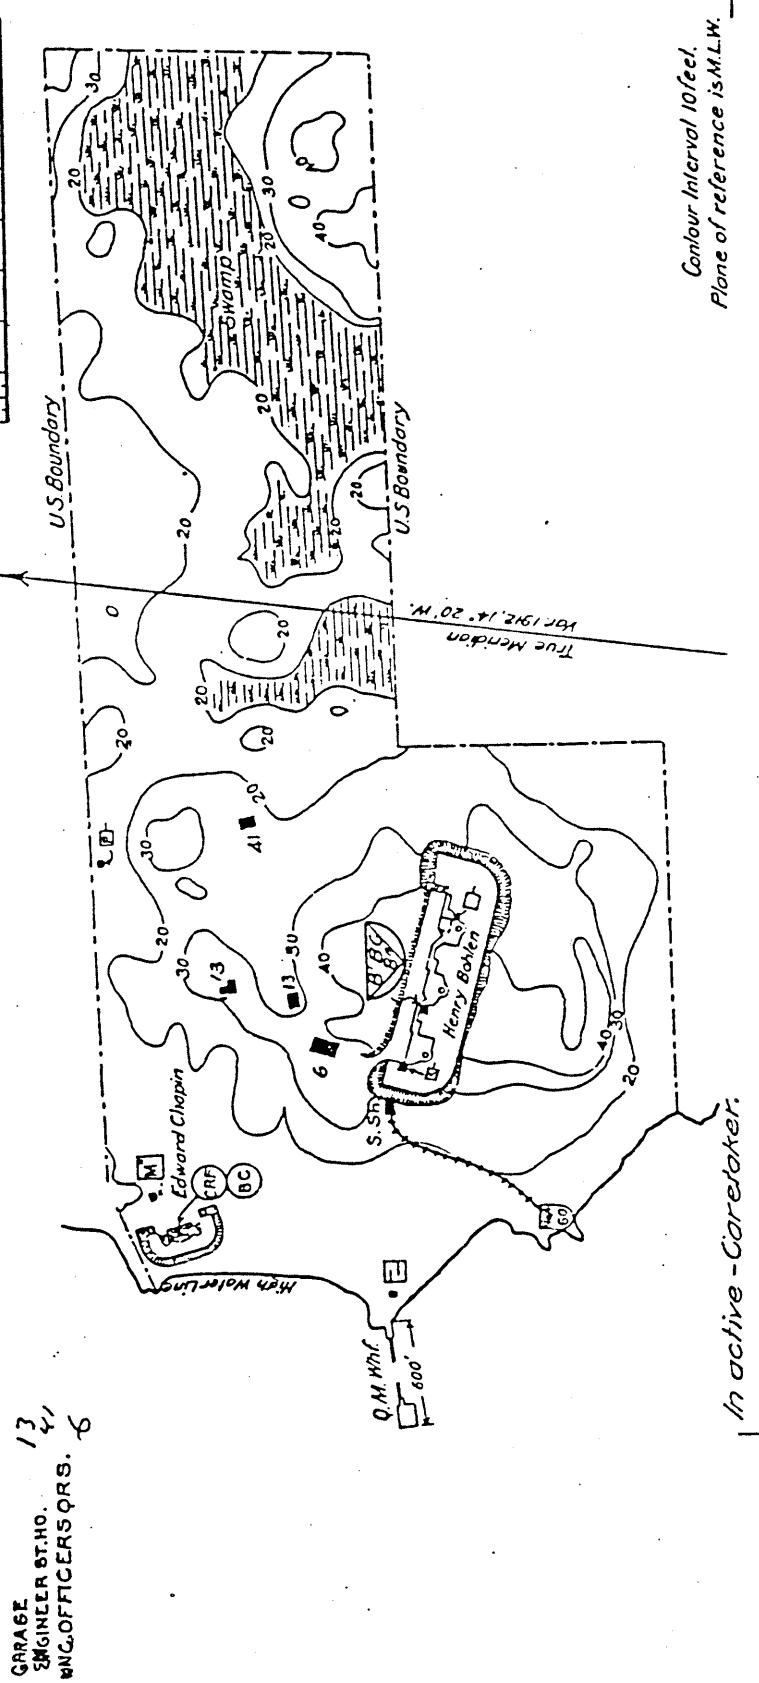

Contour Interval 10 feet.
Plane of reference is M.L.W.

In active-caretaker.

~~SECRET~~

Exhibit 10-
Loc 148
Army
138

3

8


PORTLAND HARBOR ME
FORT GORGES
DIAMOND ISLAND LEDGE

136

SERIAL NUMBER

EDITION OF JAN 1 1915
REVISIONS MAY 6, 1923
FEB 12, 1938

LEGEND
ENGINEER ST. HO

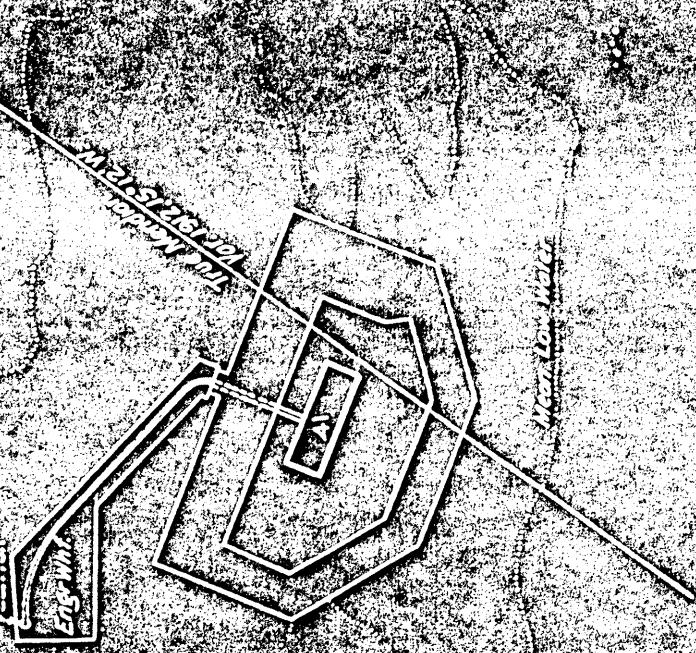

Scale 1/2 inch = 100 feet


LEGEND.
6 N.C.Q. QUARTERS
10: WOOD SHED

EDITION OF JAN 14, 1915.
REVISIONS: CCC 7 1915 MAR 21 1916.
APRIL 10, 1920; FEB 11, 1921; JAN 25, 1925.
AUG. 17, 1929, FCO. 12, 1935.

PORTLAND HARBOR, ME.
FORT LYON
Cow Island

BATTERIES.
BAYARD-----
ABBOT-----3-3° P.

A. - A.A. Guns 2-3°
One empl for A.A. Gun

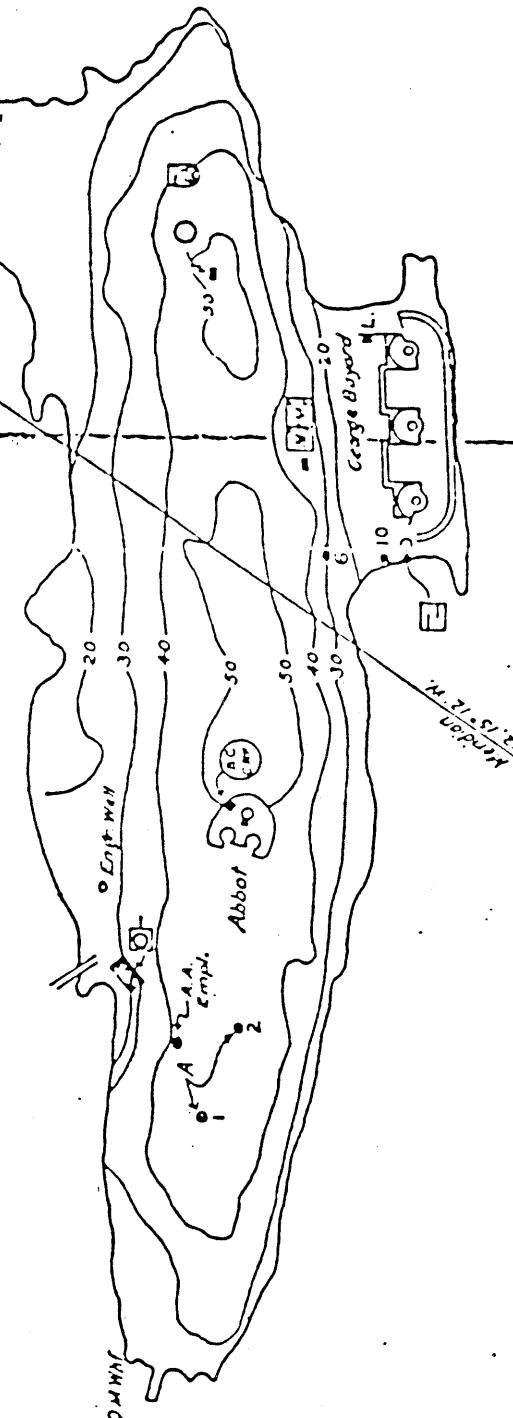

Inactive-Caretaker.
L

Contour interval 10 feet.
The plane of reference is M.L.W.

Scale of feet
100 0 100 200 300 400 500

SERIALIZED

Exhibit 5-A

LEGEND

- 1 ADMINISTRATION BLDG.
- 2 OFFICERS QUARTERS.
- 3 N. C. O. QRS.
- 4 BARRACKS
- 5 GUARD HOUSE.
- 6 POST EXCHANGE.
- 7 BOWLING ALLEY.
- 8 BOAT HOUSE.
- 9 BOWMILL.
- 10 BAND STAND.
- 11 TARGET PITS.
- 12 TEMP. SMTH. HO.
- 13 T.M.P. BLKSMTH. SHOP.
- 14 DORMITORY.
- 15 GAS GENERATOR.
- 16 BALLOON HANGAR.
- 17 HOISTER HOUSE.

EDITION OF OCTOBER 20, 1919.
REVISIONS: APRIL 10, 1920. JAN. 29, 1925.
MAY 6, 1929, FEB. 12, 1935.

SERIAL NUMBER
Q-333-34-1

BATTERIES.

NORTH FORK.....4-12" N
INGALLS.....4-12" N
BERRY.....2-12" DI
THOMPSON.....3-8"
ACKER.....2-6"
FARRY.....


PORTLAND HARBOR, MAINE.

FORT MCKINLEY D-1.

GREAT DIAMOND ISLAND.

Scale of Feet.
0 500 1000

- 101
- 114
- 115

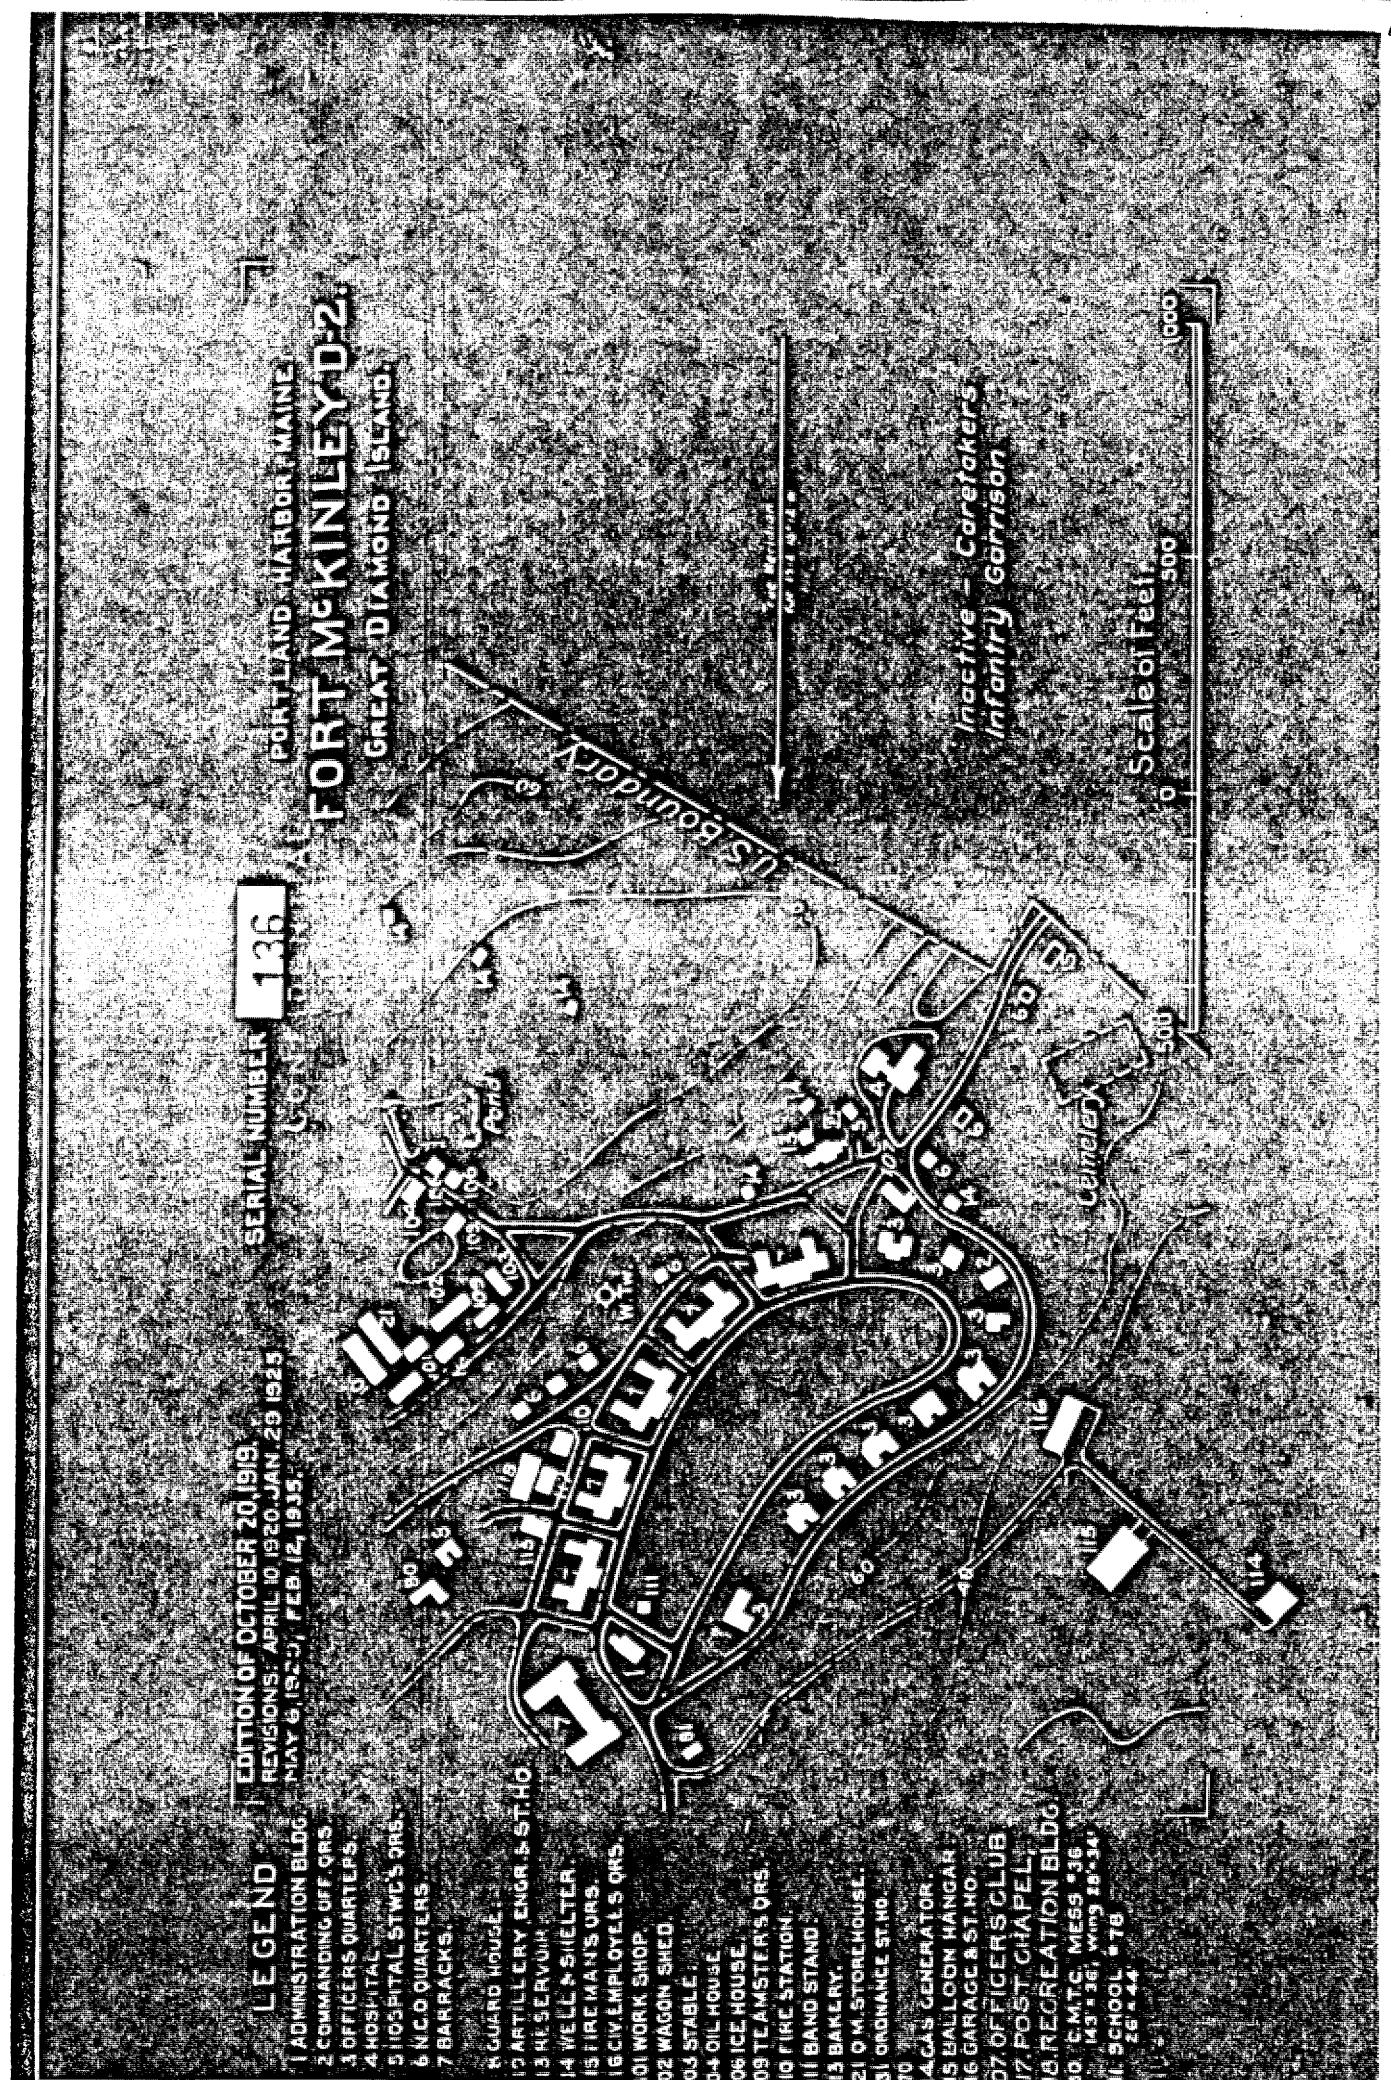

EDITION OF OCTOBER 20, 1919,
SERIAL NUMBER 2
EDITIONS: APRIL 10, 1920, FEB 11, 1921;
JAN 25, 1925; MAY 6, 1929; FEB 12, 1935


SERIAL NUMBER
2
FORT MCKINLEY D-3.

PORLAND HARBOR, MAINE.


GREAT DIAMOND ISLAND.

Scale of Feet.

500

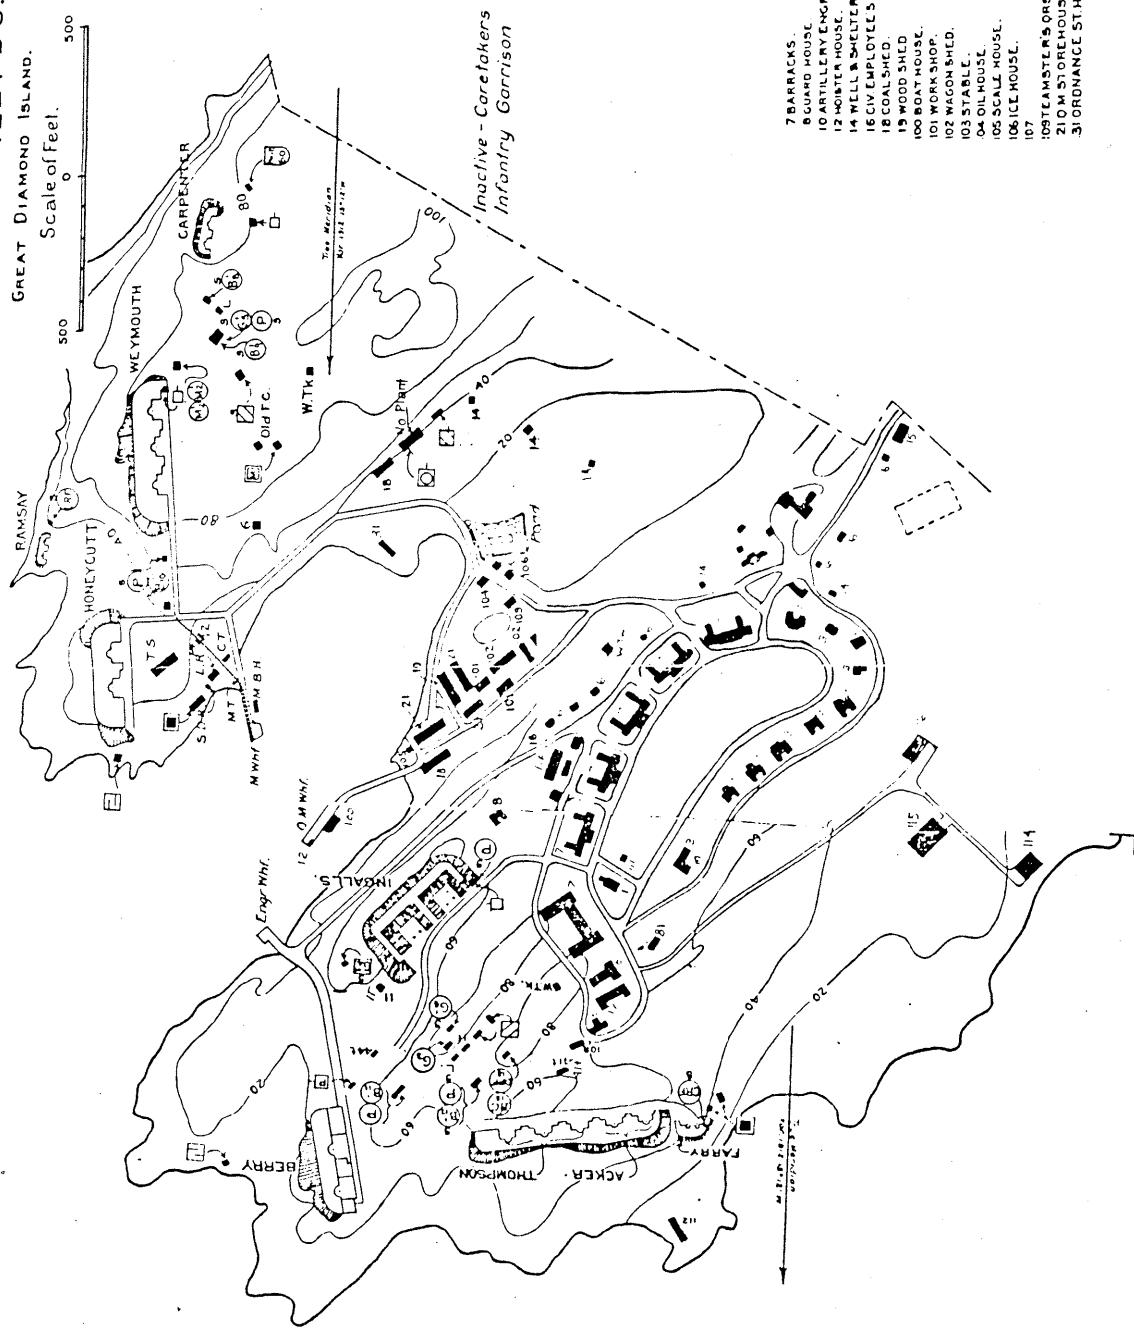

SECRET

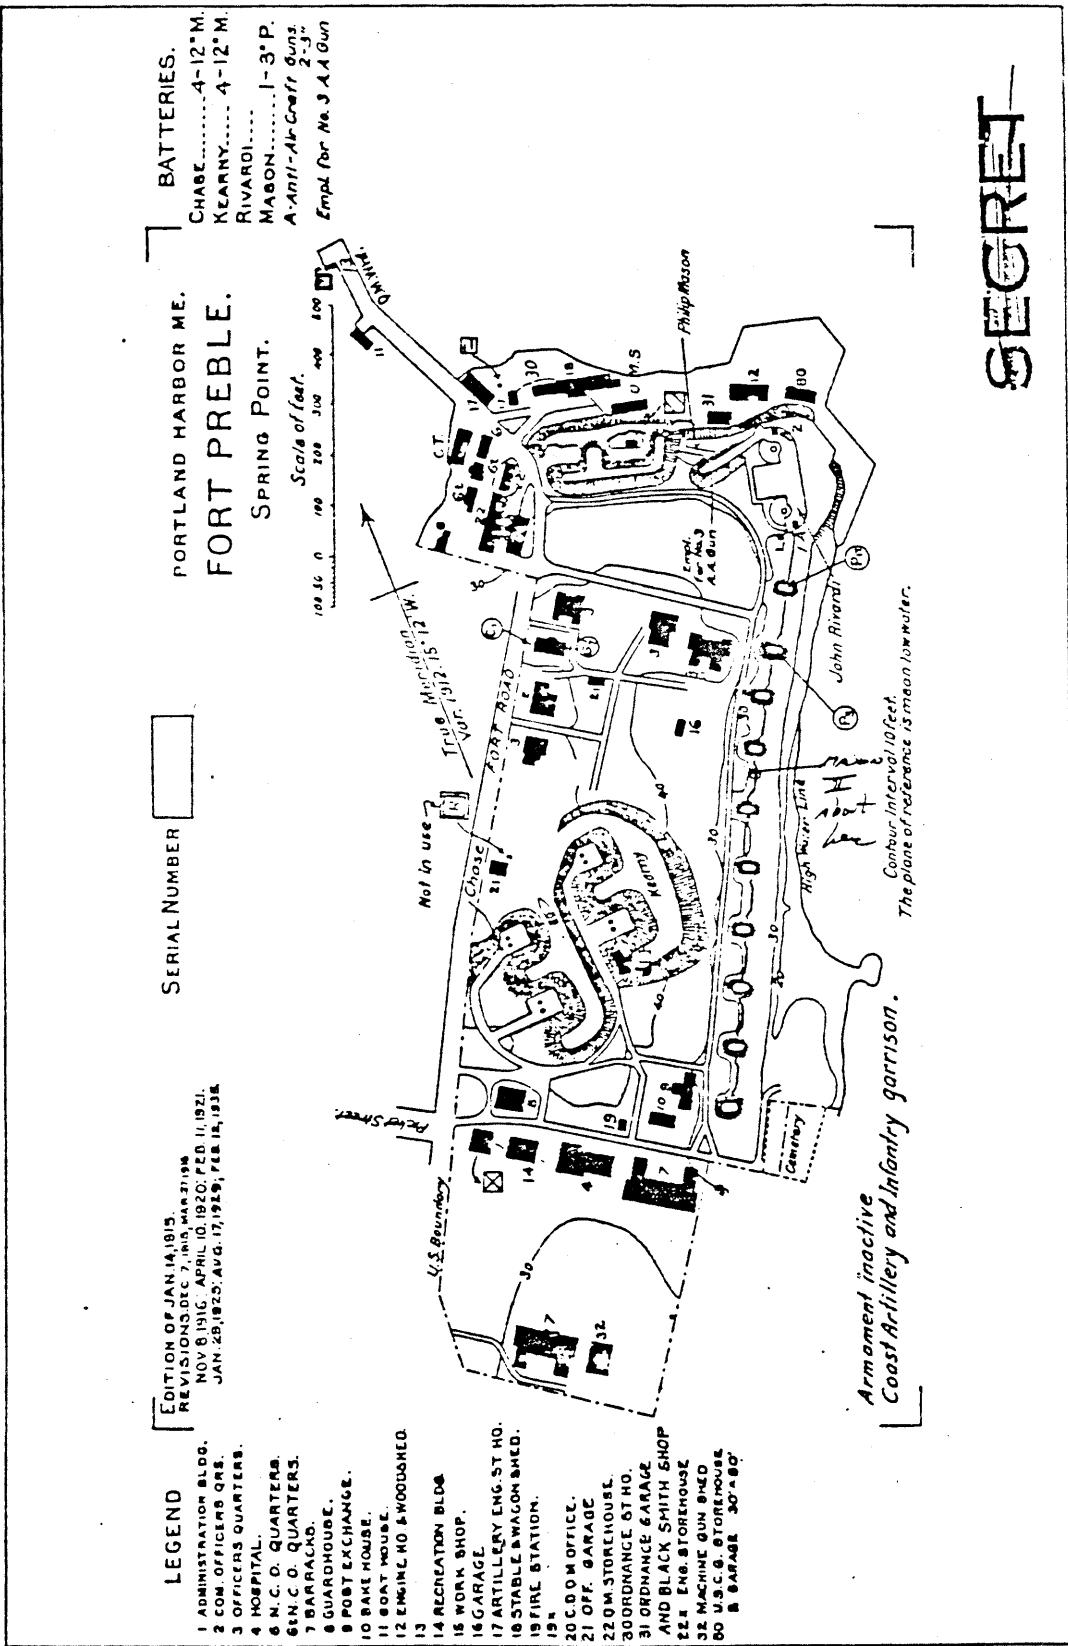


LEGEND
SHELTER
WELL SHELTER (TEMP)

EDITION OF JAN 14 1915
REVISIONS MAR 21 1916
MAY 8 1929 FEB 21 1935

SERIAL NUMBER 136

PORTLAND HARBOR ME
FORT SCAMMEL
House Island
A-3 Anti-Air Craft Gun
(B-22 Gun)

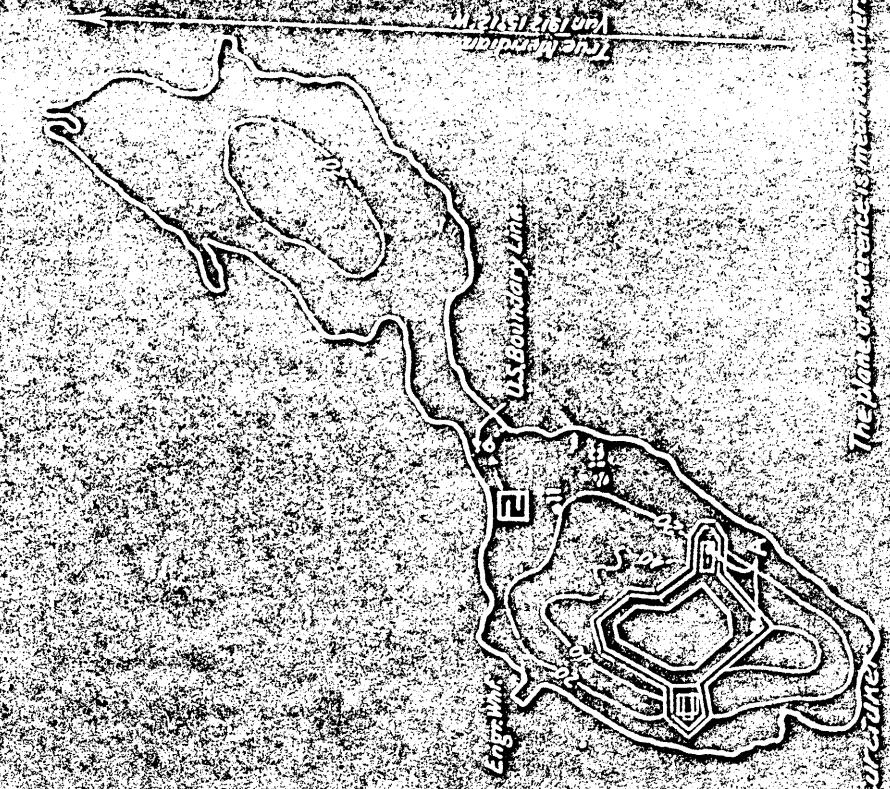









Exhibit 1A

SECRET

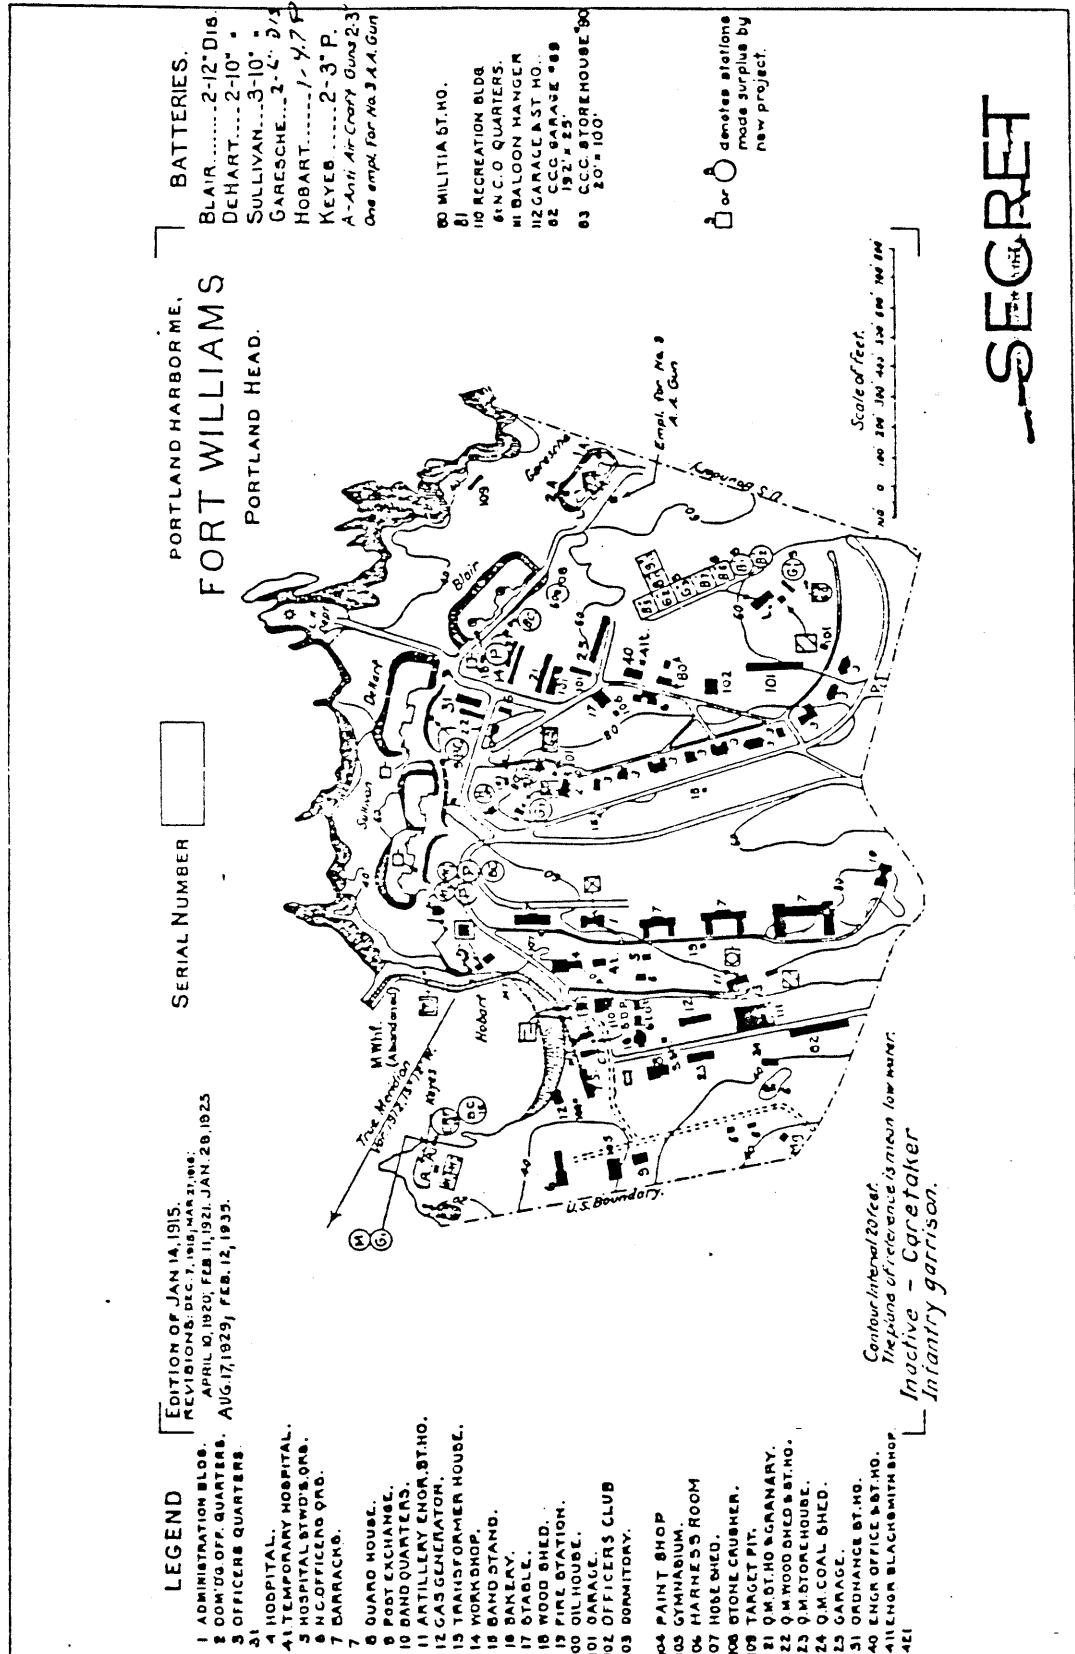

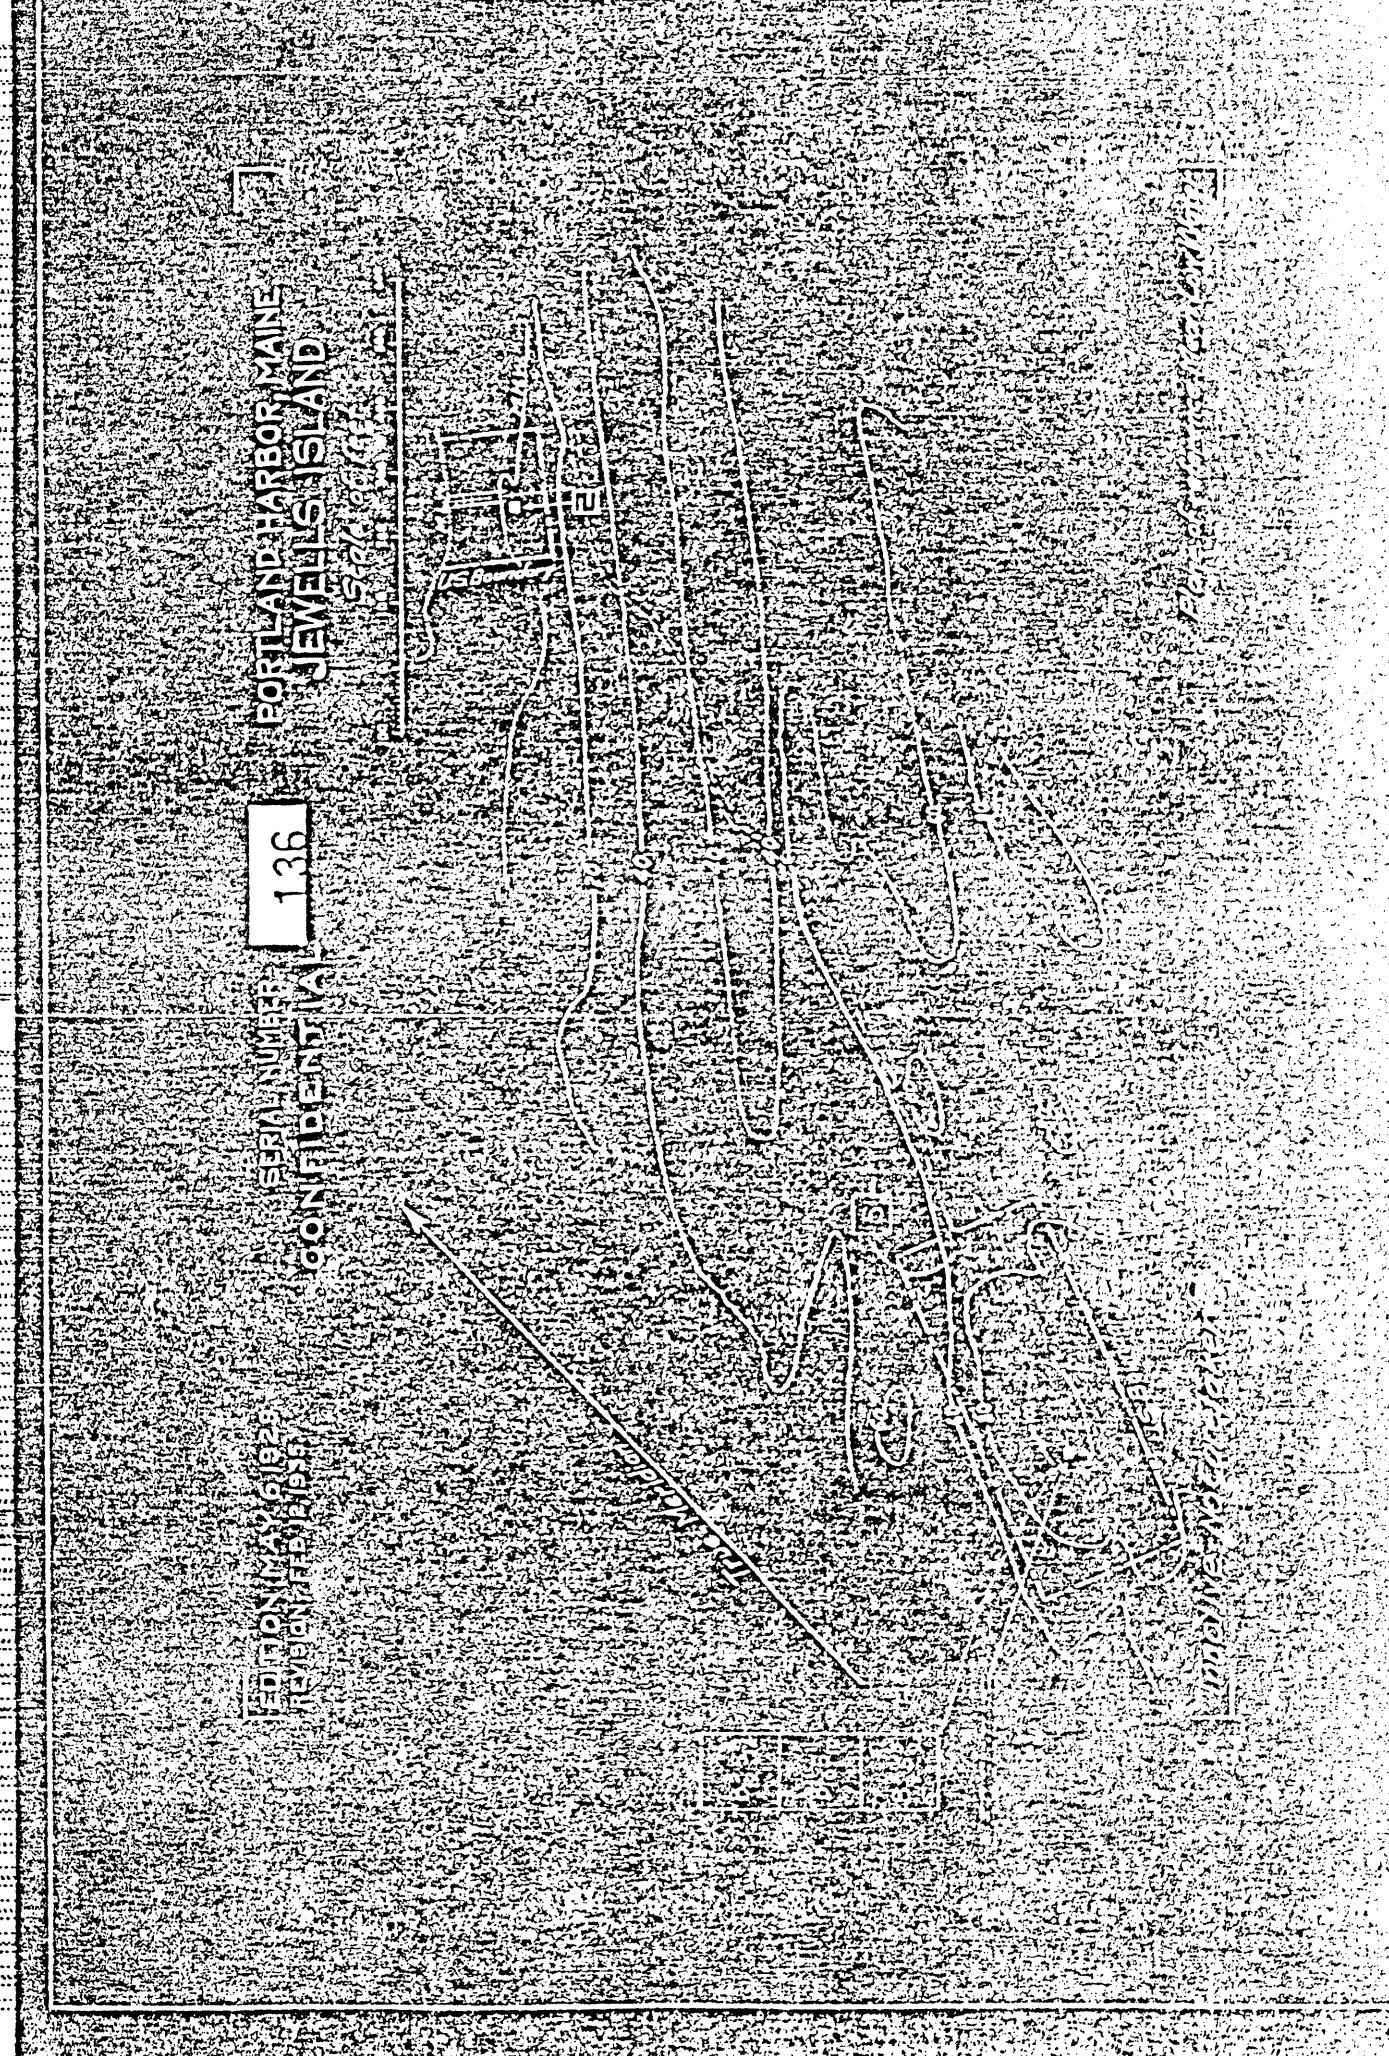



PORTLAND HARBOR MAINE
JEWELL'S ISLAND


136



CONFIDENTIAL
SERIAL NUMBER


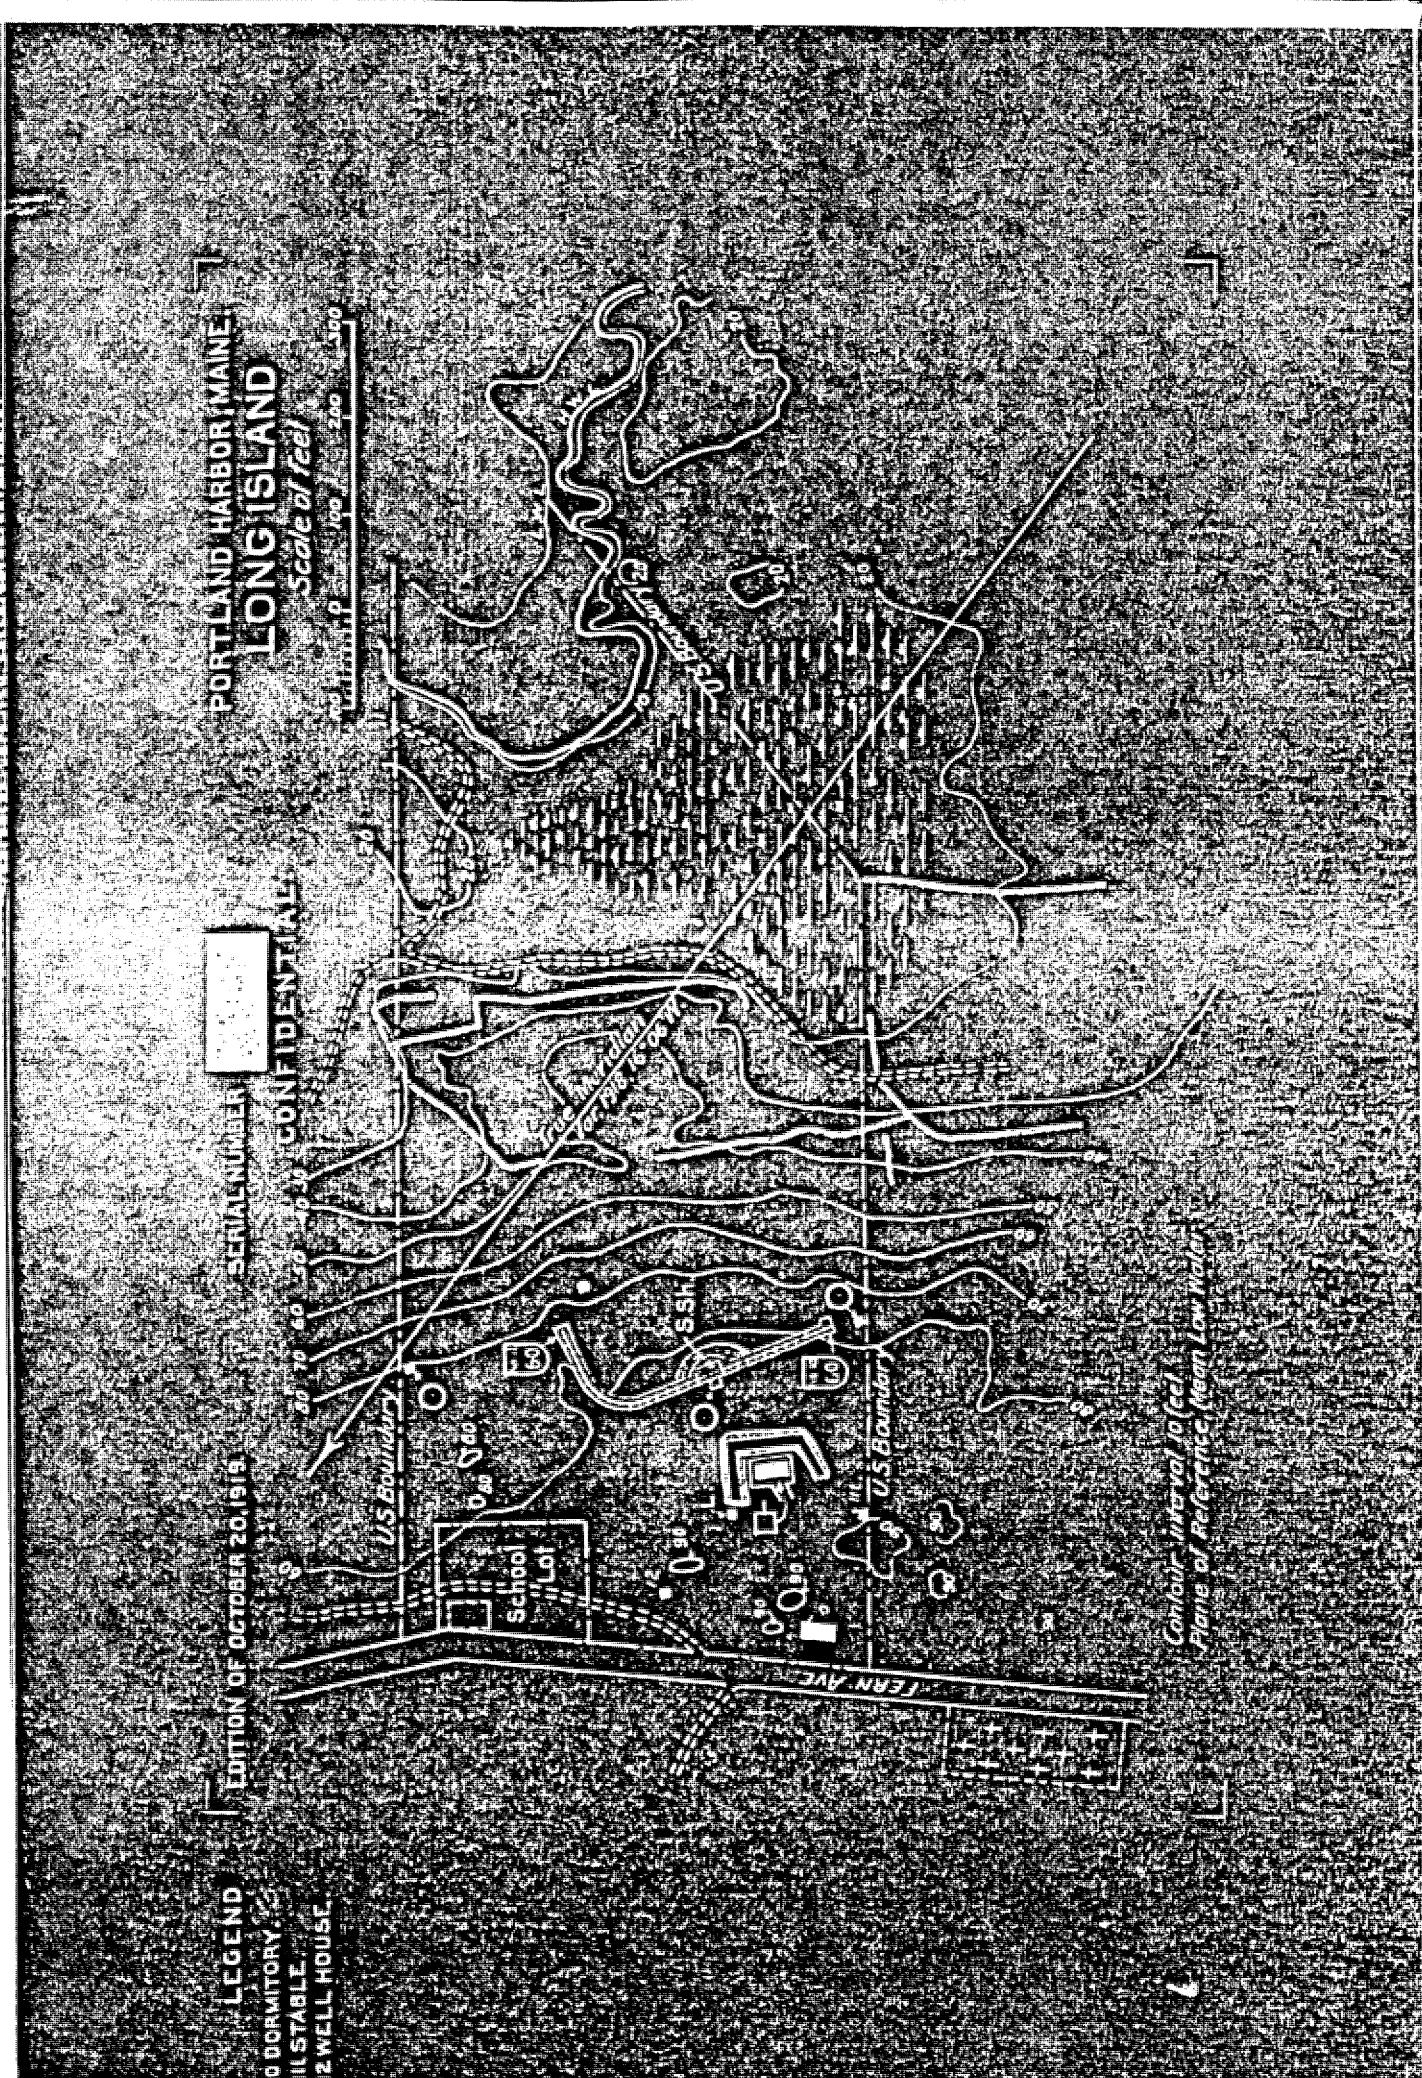

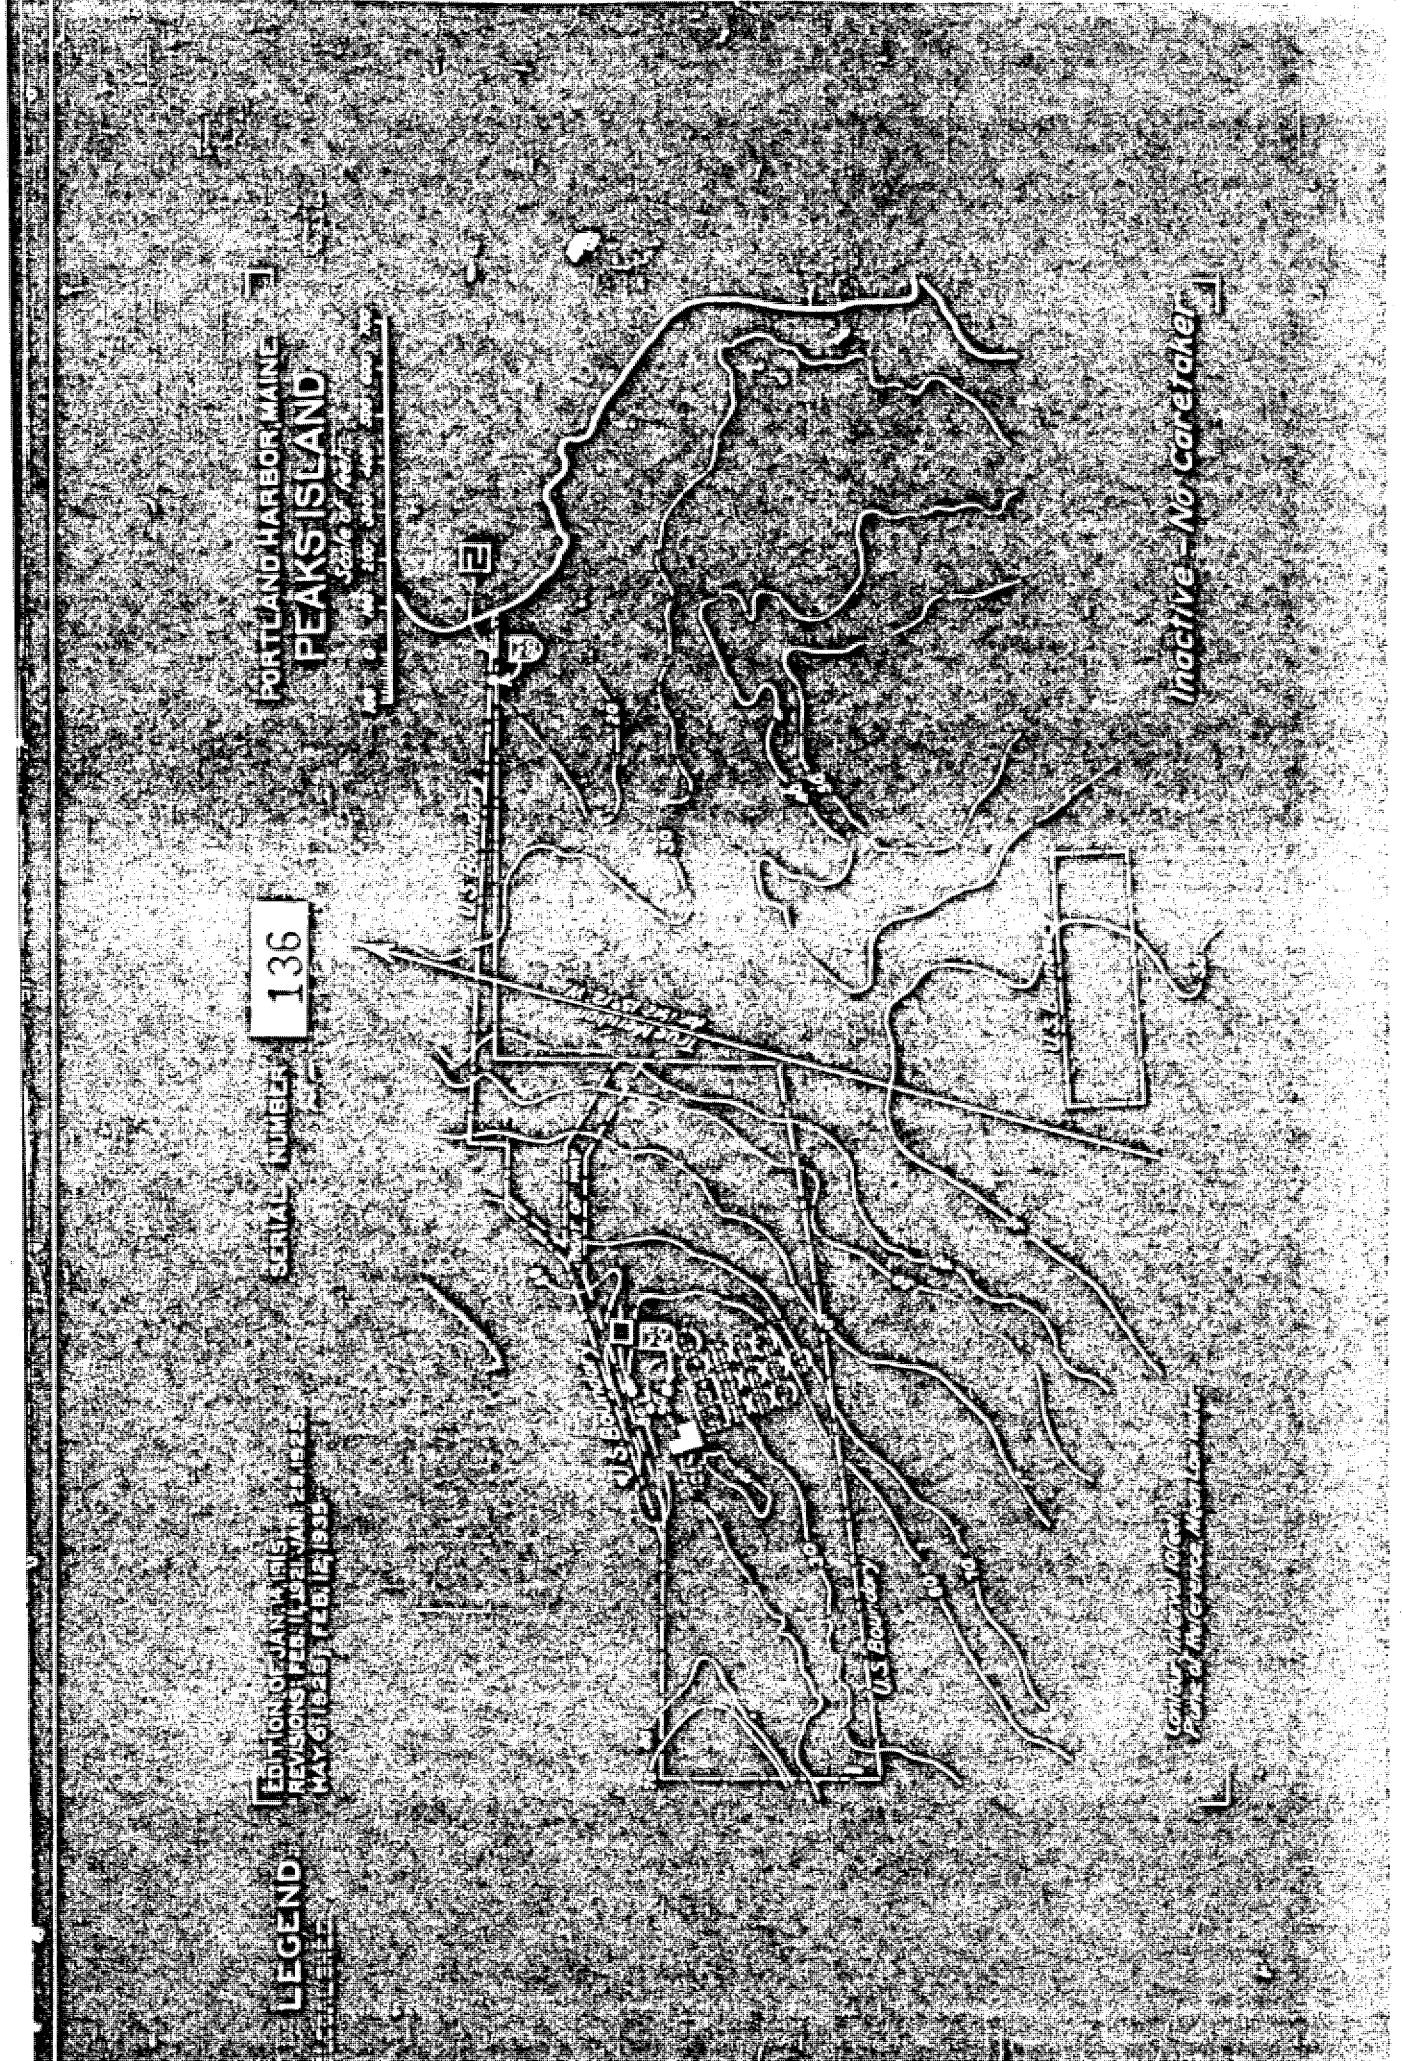

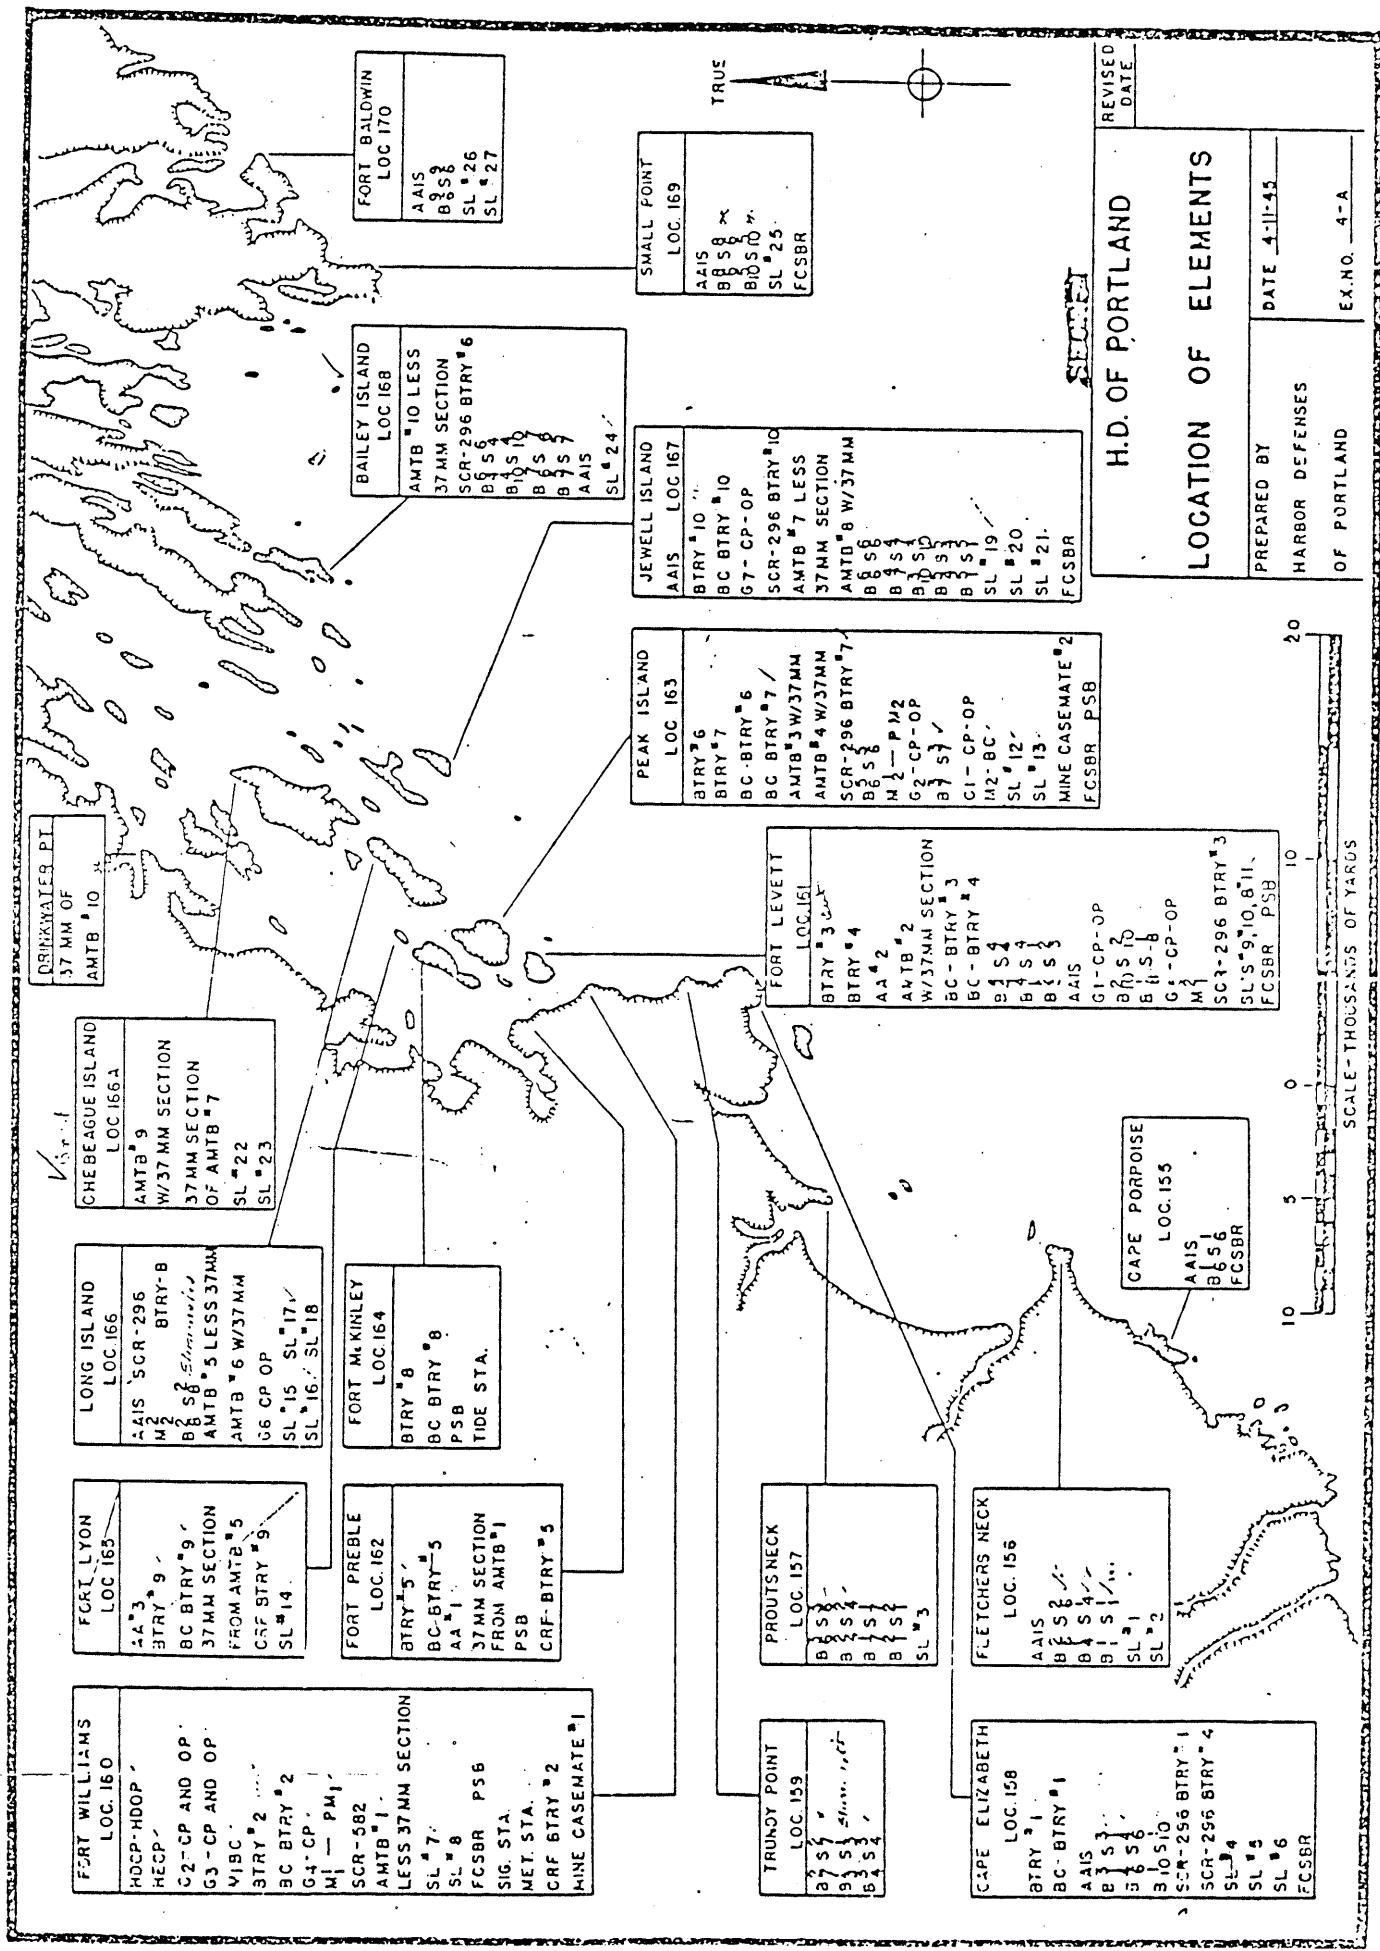


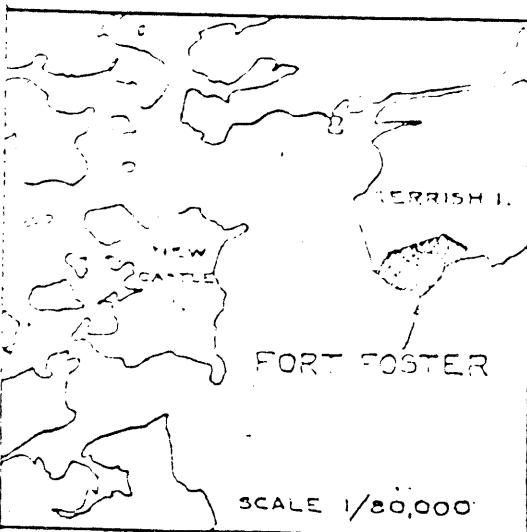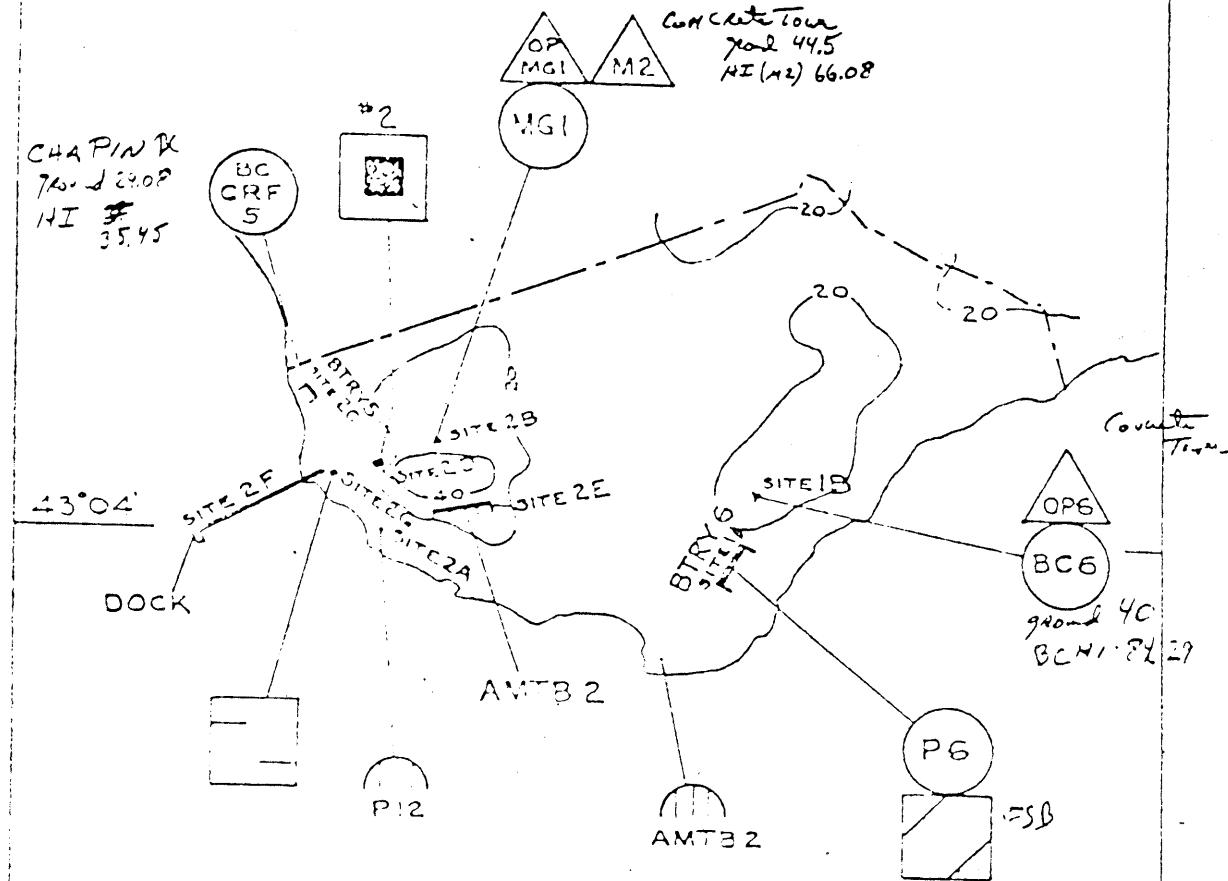

SECRET

H.D. OF PORTSMOUTH
LOCATION '48
FORT FOSTER

PREPARED BY H.D. OF PORTSMOUTH	DATE 1-1-48	REVISED EX. NO. 9-3-15
SCALE 1 / 10,000		

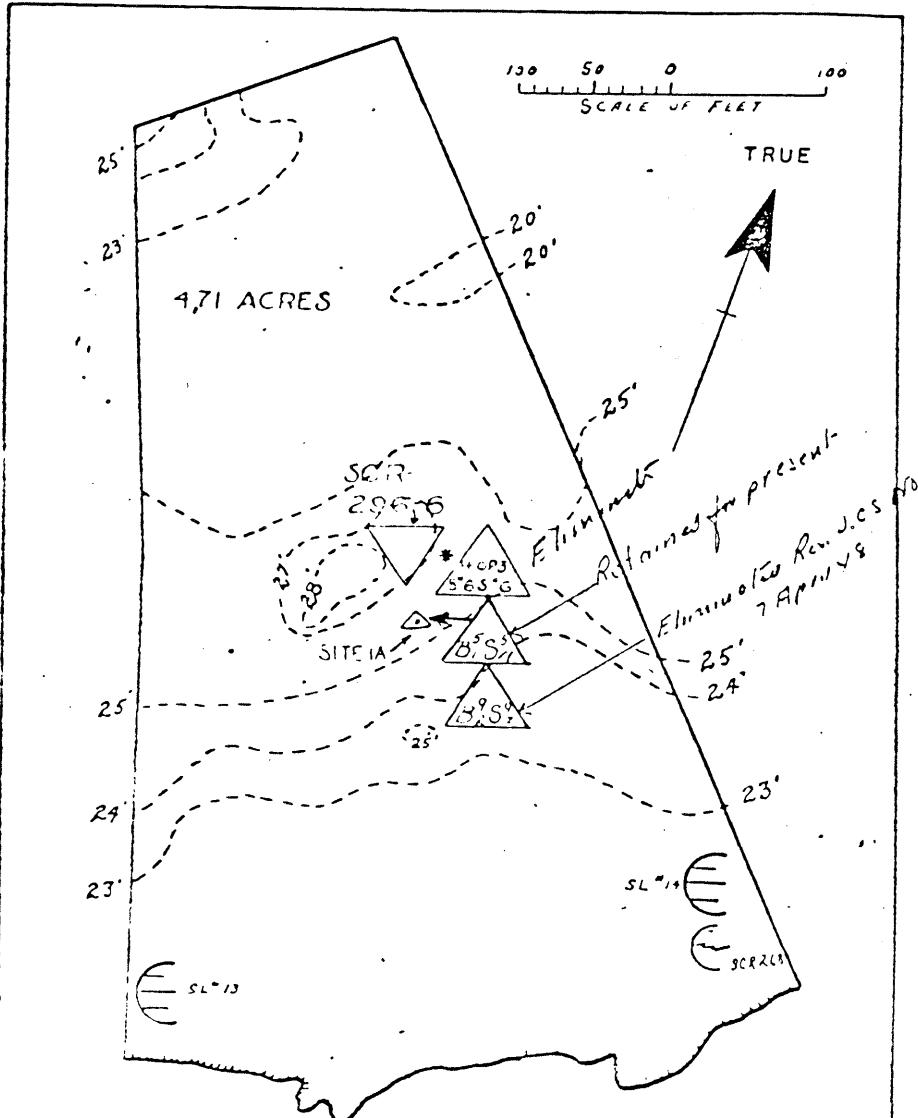

* H-OP 3 COMBINED WITH B⁴ S⁴₆, NO ADDITIONAL COMMUNICATIONS REQUIRED.



SECRET



HD OF PORTSMOUTH LOC. 149 SISTERS POINT	
PREPARED BY HD OF PORTSMOUTH	DATE 7-1-43 EXH. NO. 9-B-16
REVISED DATE 1-4-45	
SCALE - 1" = 100'	

DECLASSIFIED
11070162
37 NARS, Date

LOC. 150
SEAL HEAD PT.

10	10
B	2
2	S 2
3	6
4	1
W	5
5	6


GLS 15,15

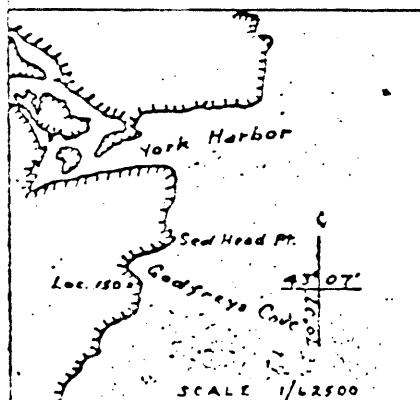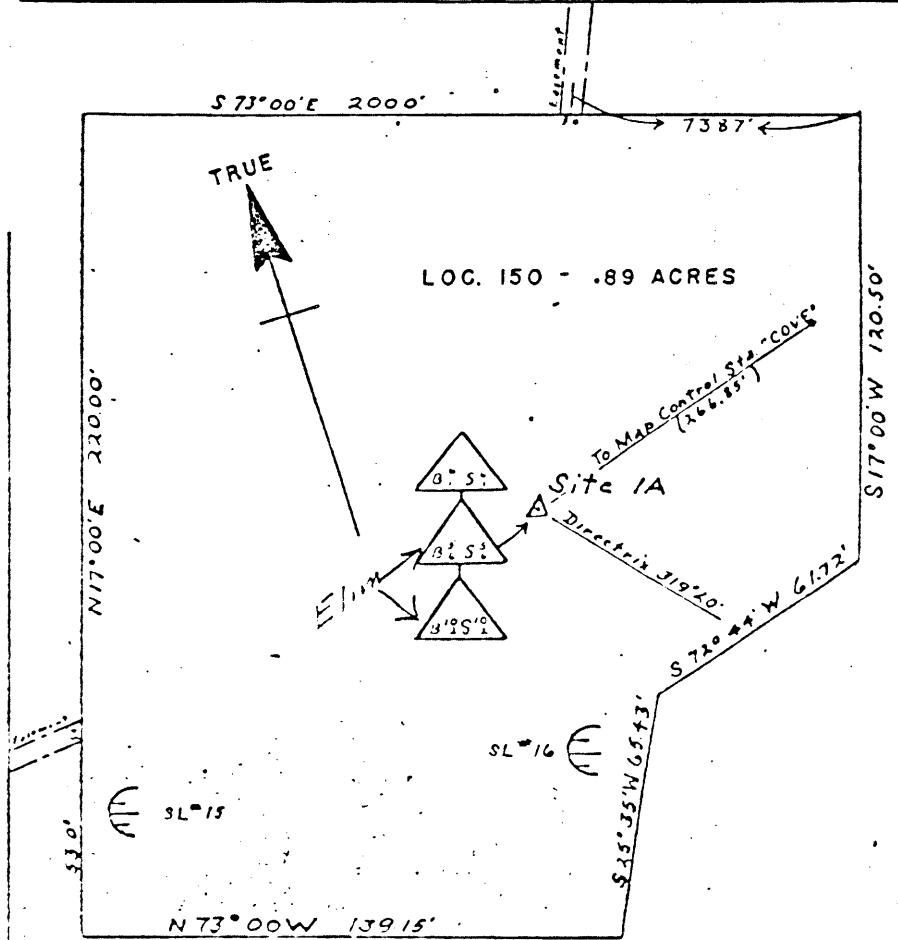

SECRET

H D OF PORTSMOUTH	
LOC. 150	
SEAL HEAD POINT	
PREPARED BY	DATE 1-1-45
REVISED	
H D OF EXHIBIT NO. DATE	
PORTSMOUTH 9-B-17	
SCALE - 1" = 40'	

DECLASSIFIED
NND 7-10-16-2
By _____ NARS, Date _____

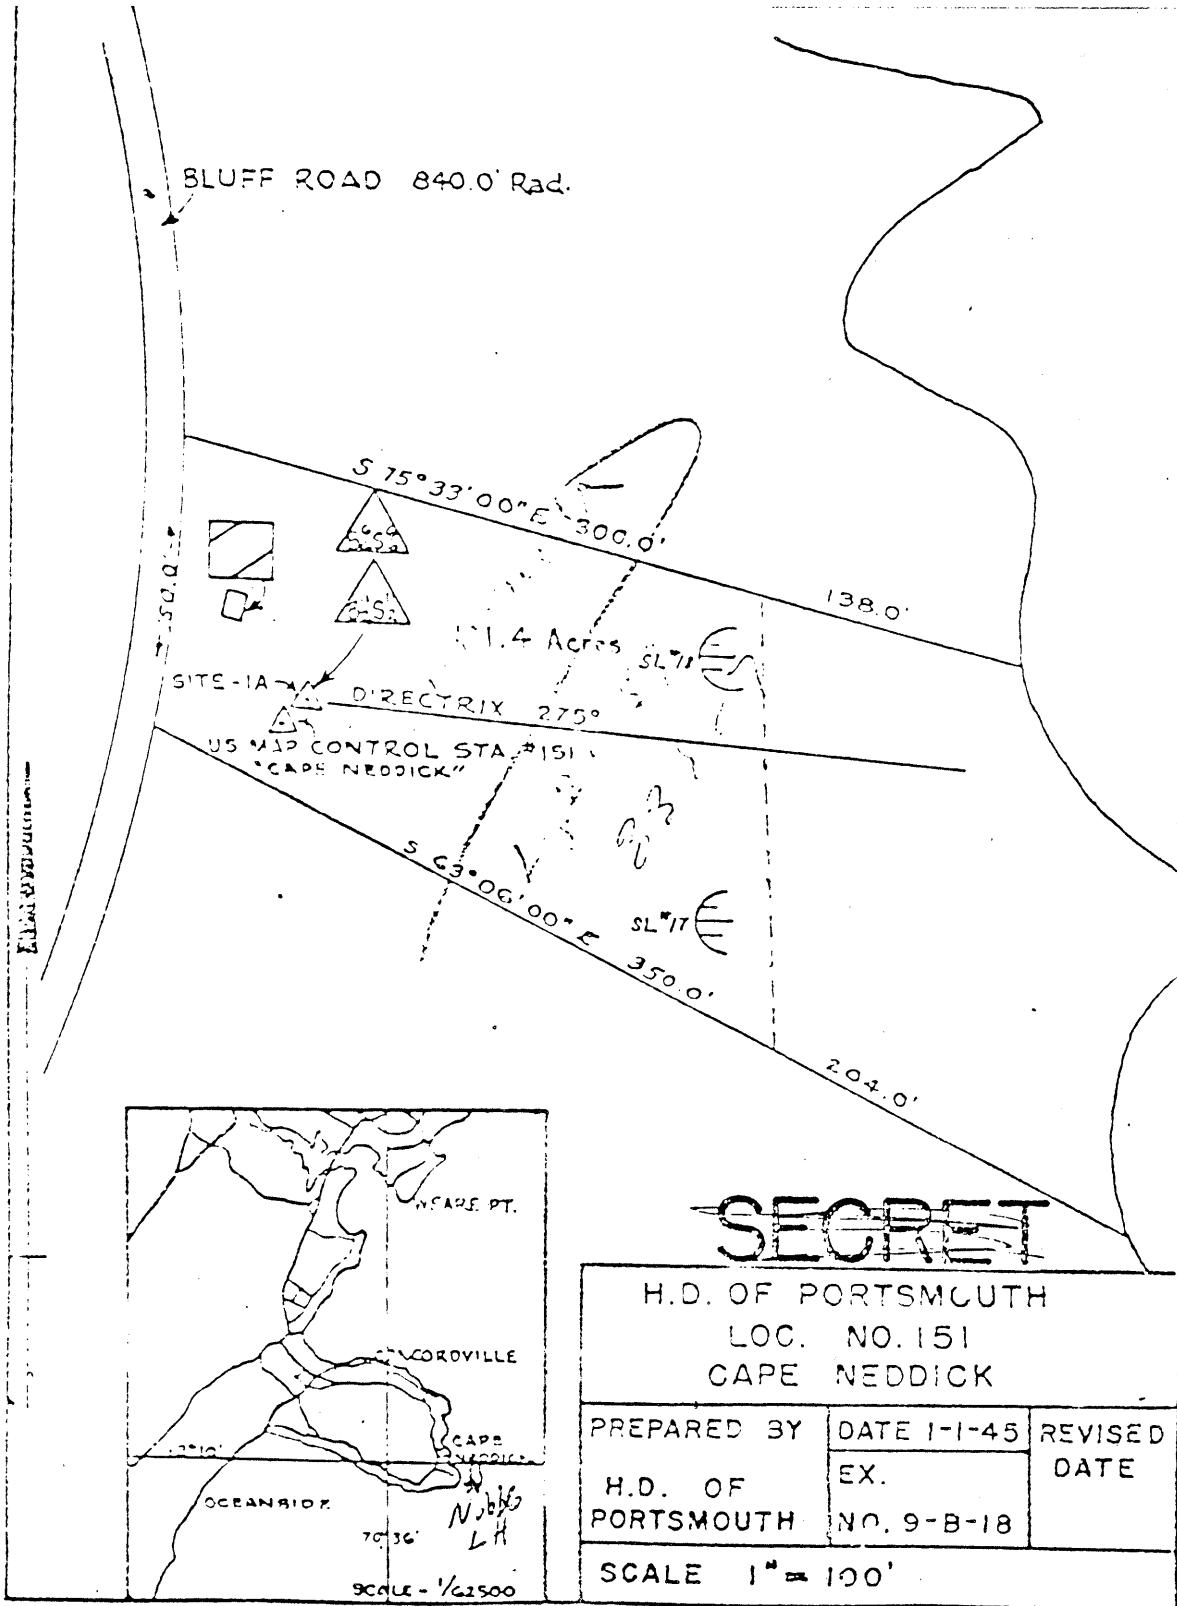

TRUE

S'EASEMENT FOR SEWER

DUE EAST - 135 0'

DUE NORTH - 110 0'

0.37 ACRES

DUE SOUTH 110 0'

B'2 S'2

SITE 1A 27005° DIRECRIX

SL 74



DUE WEST - 135 0'


Coastal State
Jan 73
Scale 1:20,000

RIGHT OF WAY 20' WIDE



MAP CONTROL DISK
• 52° BALD HEAD CLIFF


CLIFF HOUSE HOTEL

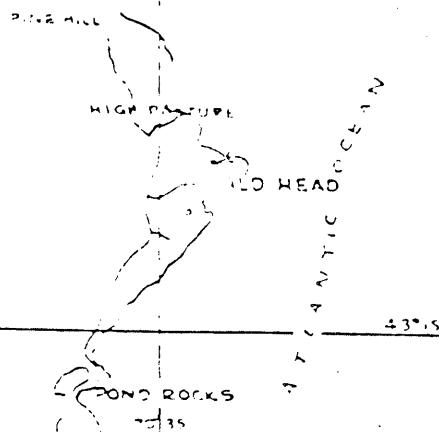**SECRET**

HO OF PORTSMOUTH
LOC. 152
BALD HEAD CLIFF

PREPARED BY	DATE 1-1-45	REVISED DATE
HO OF PORTSMOUTH	EX	
	NO 98-19	

SCALE - 1" = 40'

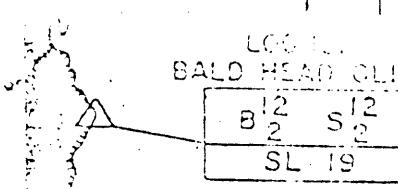

S 60° 45' 55" E

100.0'

TRUE

Ocean Avenue

99.03'

N-26° 52' 40"E

32'

0.32 Acres

29'

30'

31'

SL X0

15064

S-27° 05' 25" W

285°
DIRECT LINE
from 310
SEAN HI 55.5465.06'
N 52° 00' 00"Ocean Avenue
TO OCEAN FRONT

LOC 153
LOC 154
LOC 155
LOC 156
SL 20

60.57'
R 44.00

SCALE - 1/62500

WELLS BEACH

MOODY BEACH
Loc. 153

OGUNGUIT BEACH


43° 17'

2° 33'



SECRETH. D. OF PORTSMOUTH
LOC. 153

MOODY BEACH



PREPARED BY	DATE	REVISED
H. D. OF PORTSMOUTH	EX. NO.	DATE
	9-B-20	1-1-45

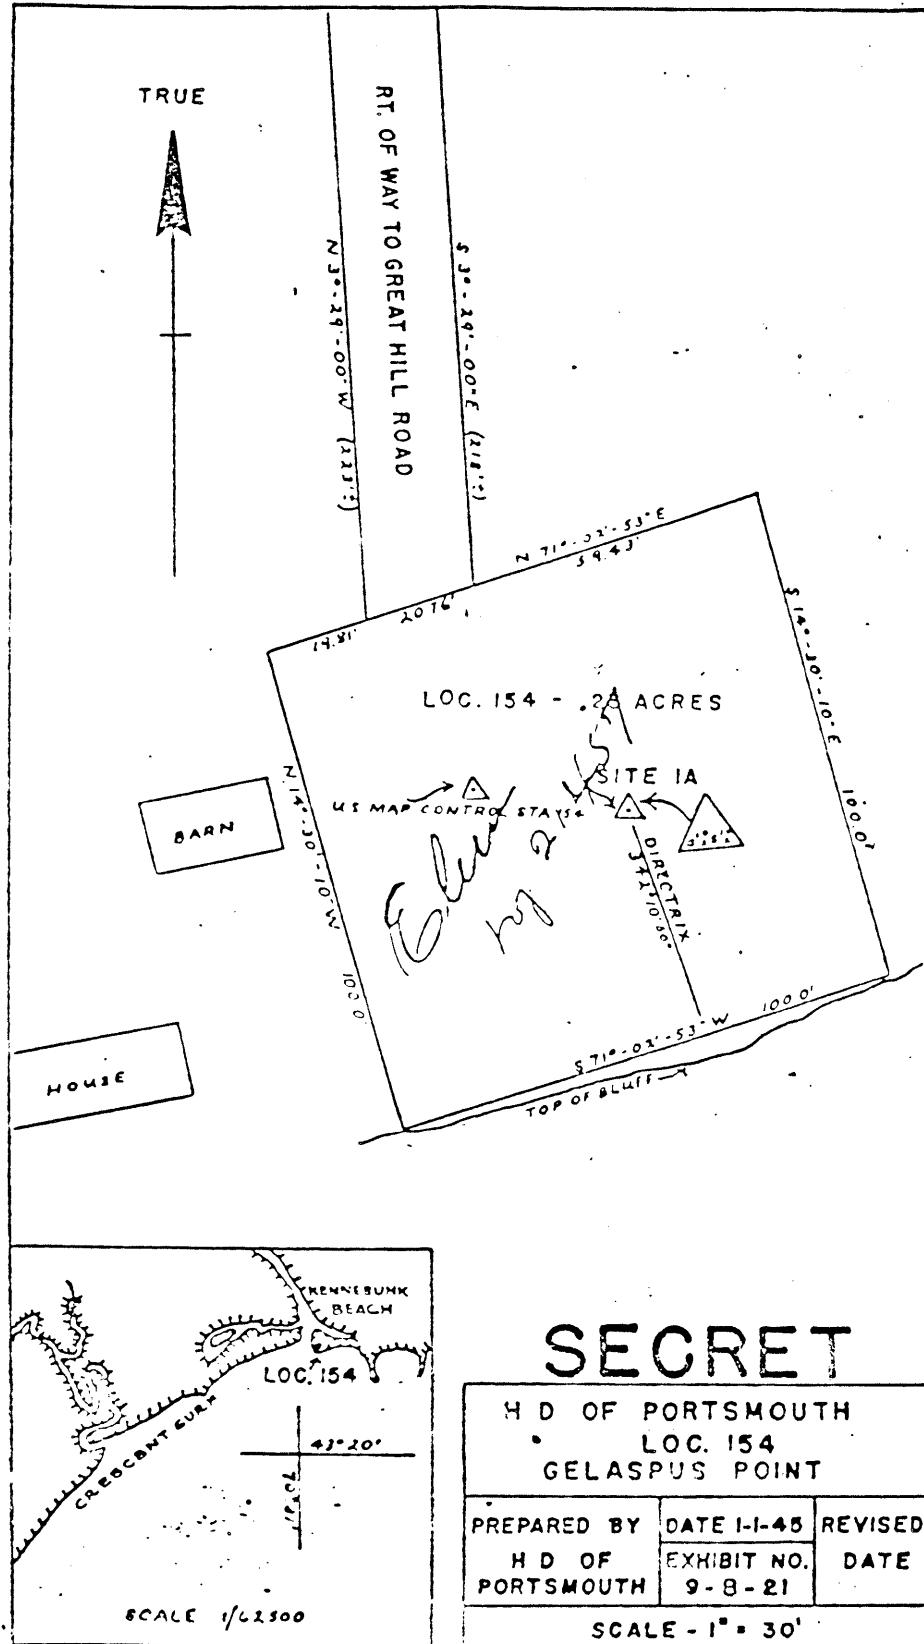

DECLASSIFIED
NAD 1983
By [Signature] Date [Signature]

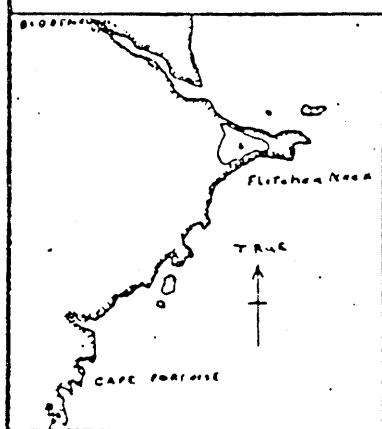
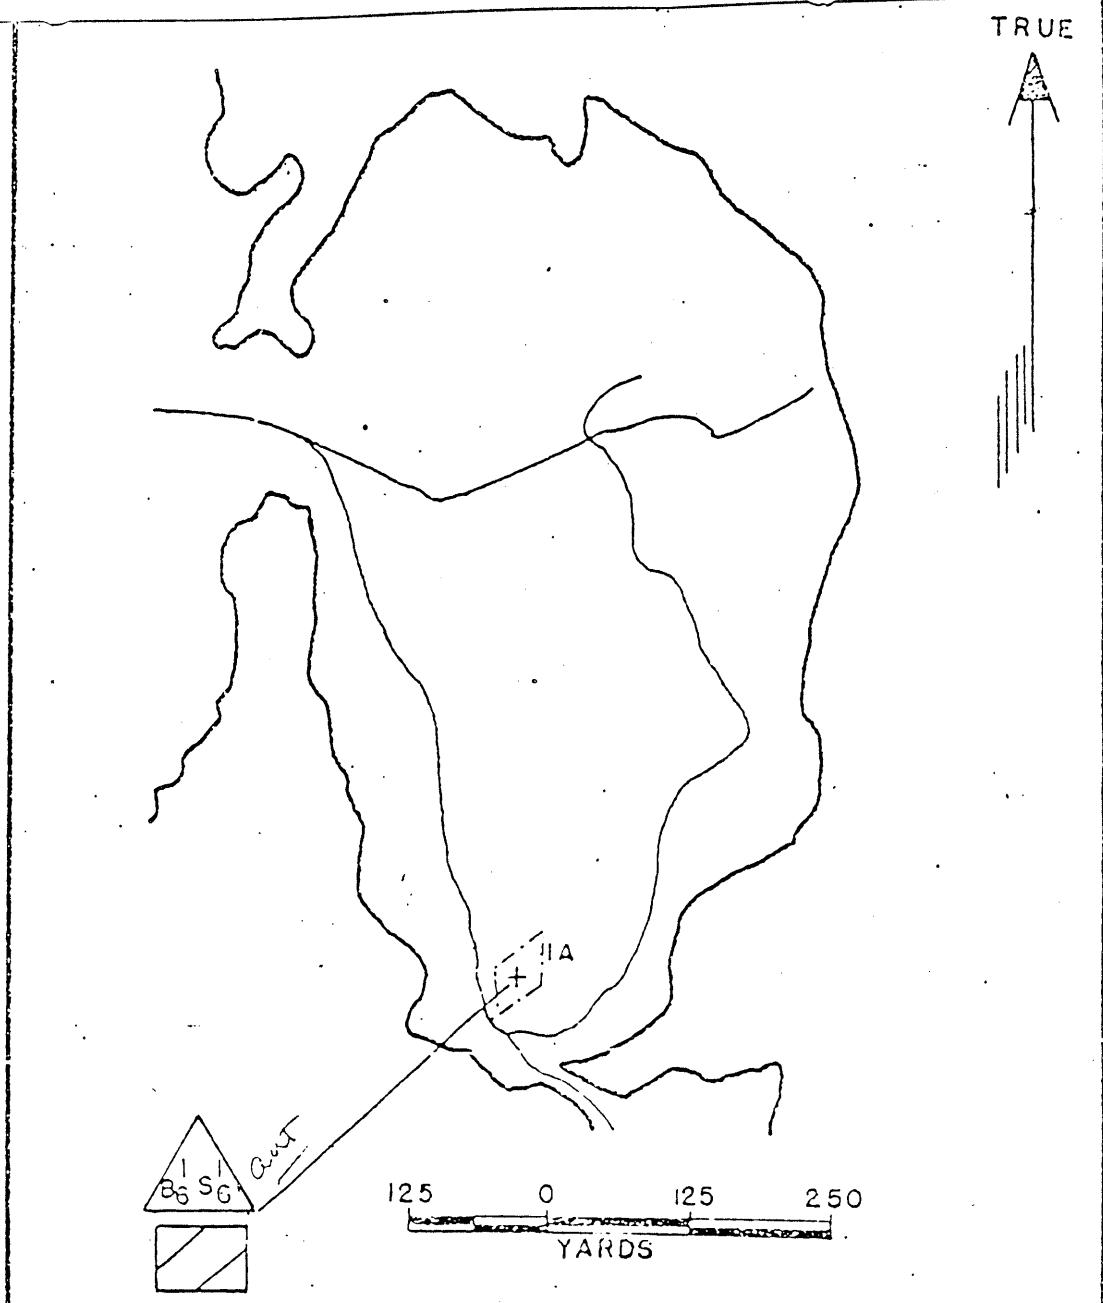


H.D. OF PORTLAND		REV'D DATE
LOC. NO. 155		
CAPE PORPOISE		
FIRE CONTROL INSTALLATIONS		
PREPARED BY	DATE 4-11-45	
HARBOR DEFENSES		
OF PORTLAND	EX. NO. 98	

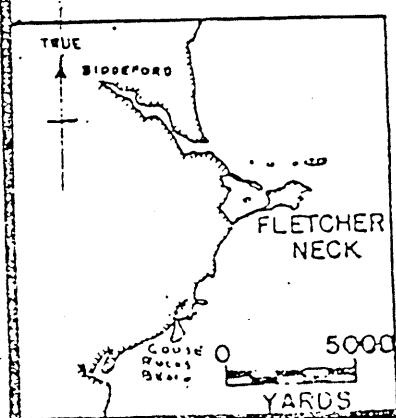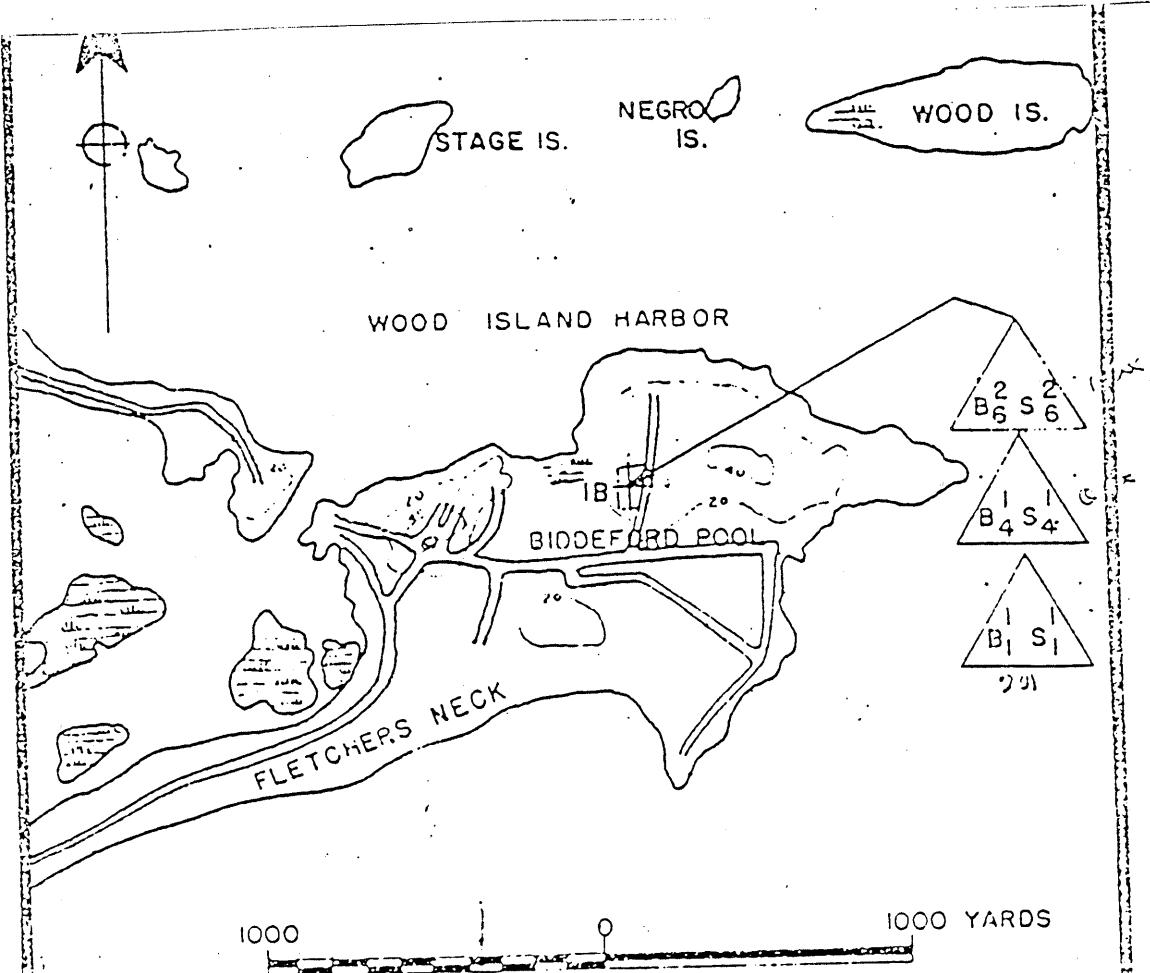


~~SECRET~~

H.D. OF PORTLAND		REV'D DATE
LOC. NO. 156 - FLETCHERSNECK		
FIRE CONTROL INSTALLATIONS		
PREPARED BY HARBOR DEFENSES OF PORTLAND	DATE 4-11-45	EX. NO 9B-1

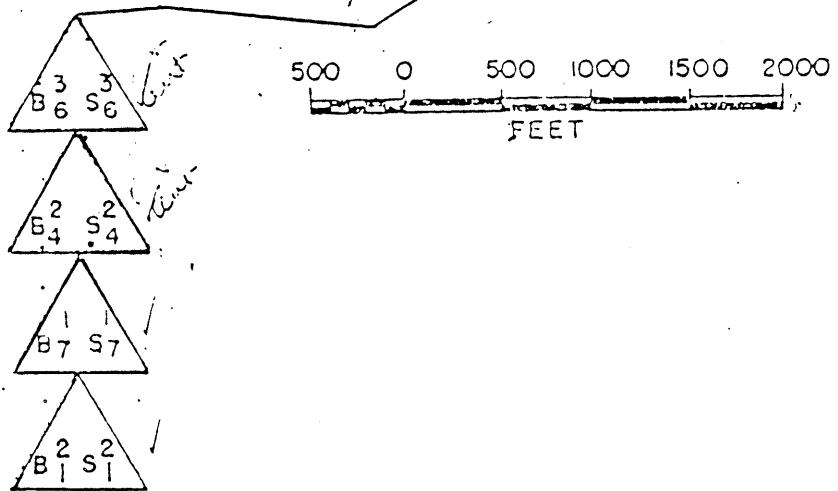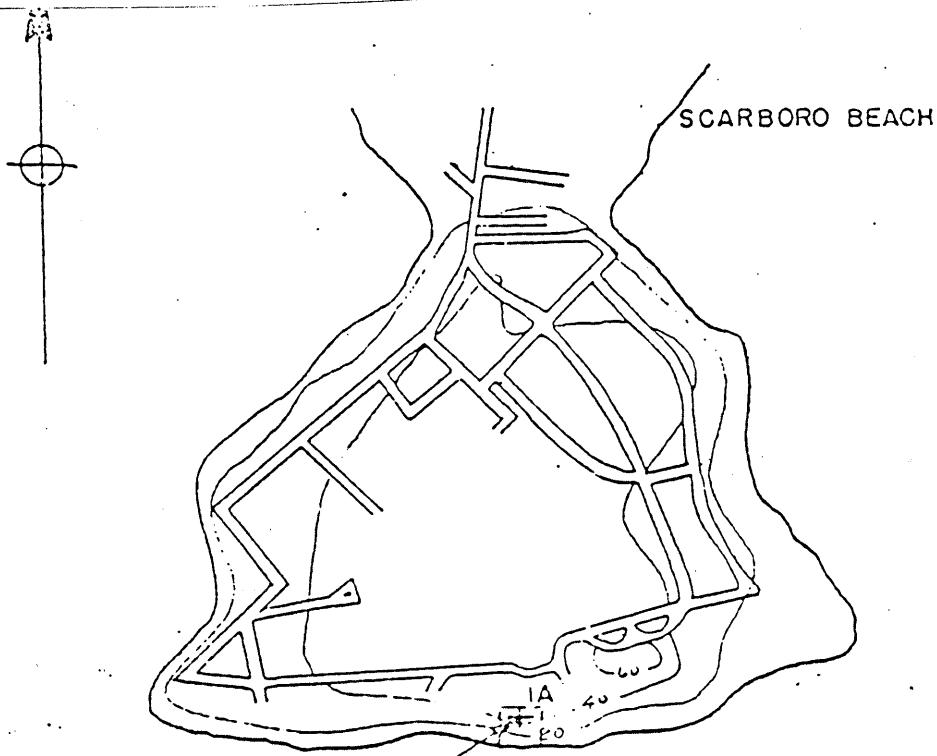


MILITARY RESERVATION
BOUNDARY LINE

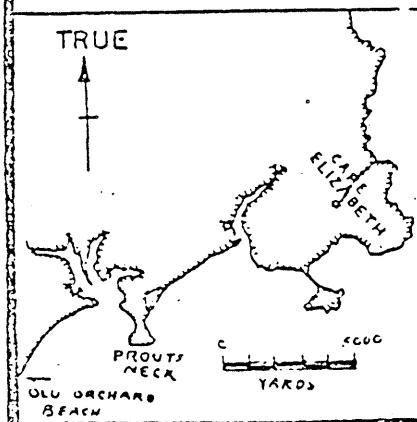


~~SECRET~~

H.D. OF PORTLAND		REV'D DATE
LOC. NO. 157		
PROUTS NECK		
FIRE CONTROL INSTALLATIONS		
PREPARED BY HARBOR DEFENSES OF PORTLAND	DATE 4-11-45	
		EX. NO. 98-2

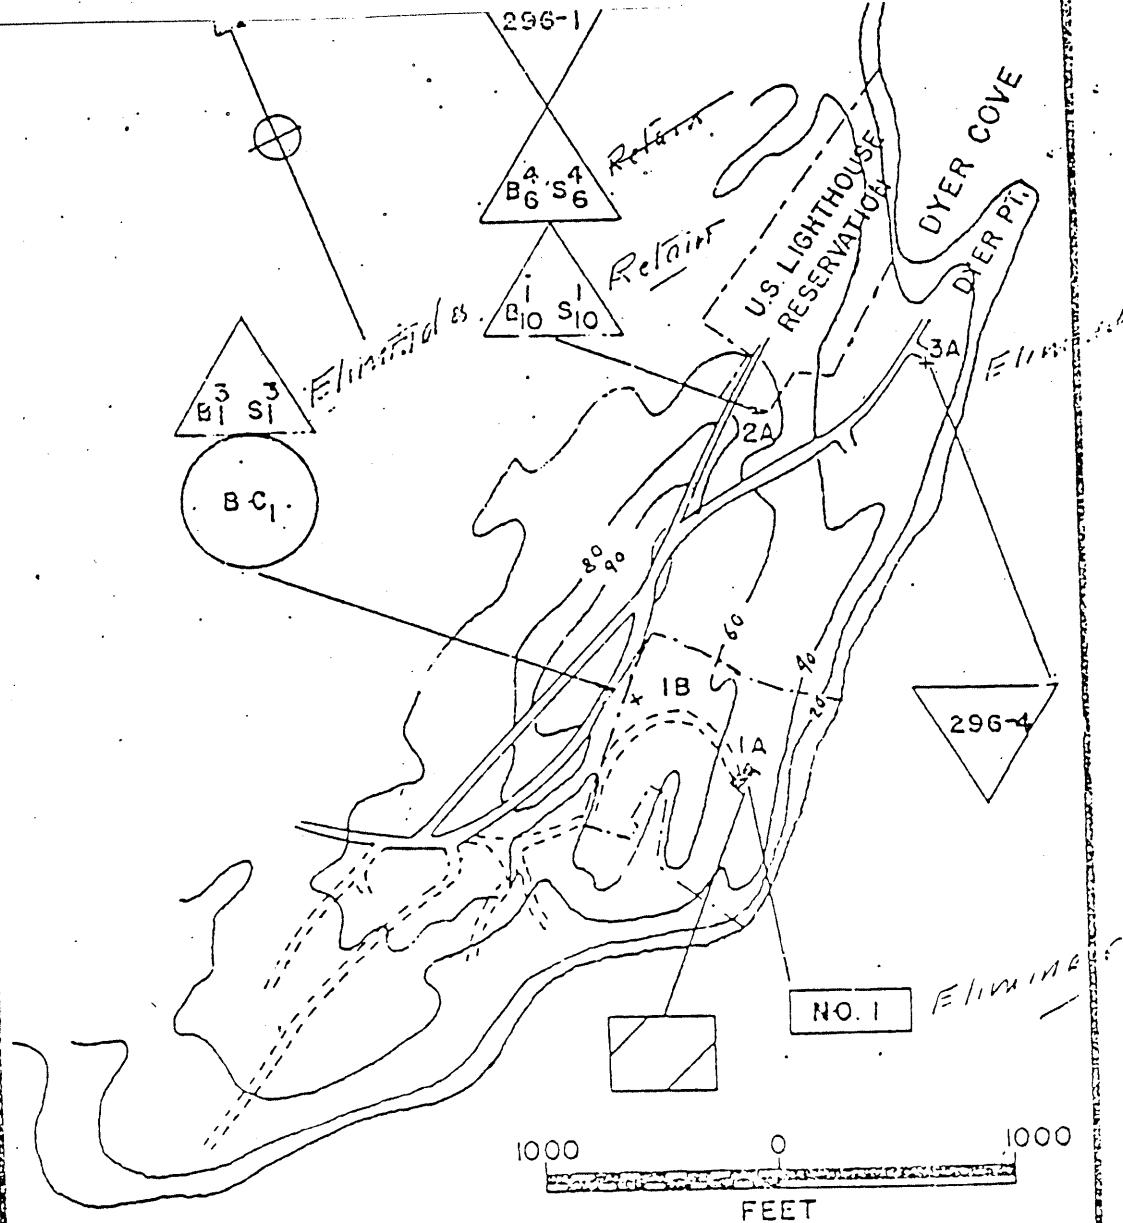

MILITARY RESERVATION
BOUNDARY LINE


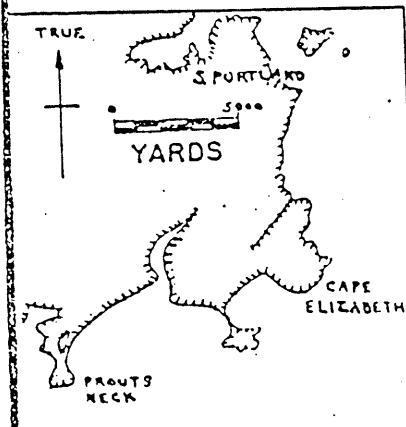


~~SECRET~~

H.D. OF PORTLAND
LOC. NO. 158
CAPE ELIZABETH
FIRE CONTROL INSTALLATIONS

PREPARED BY
HARBOR DEFENSES
OF PORTLAND


DATE: 4-11-45
EX.NO. 98-3

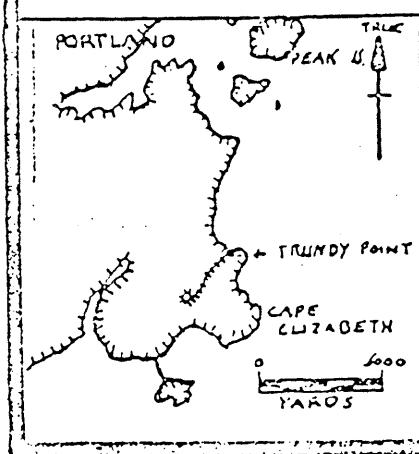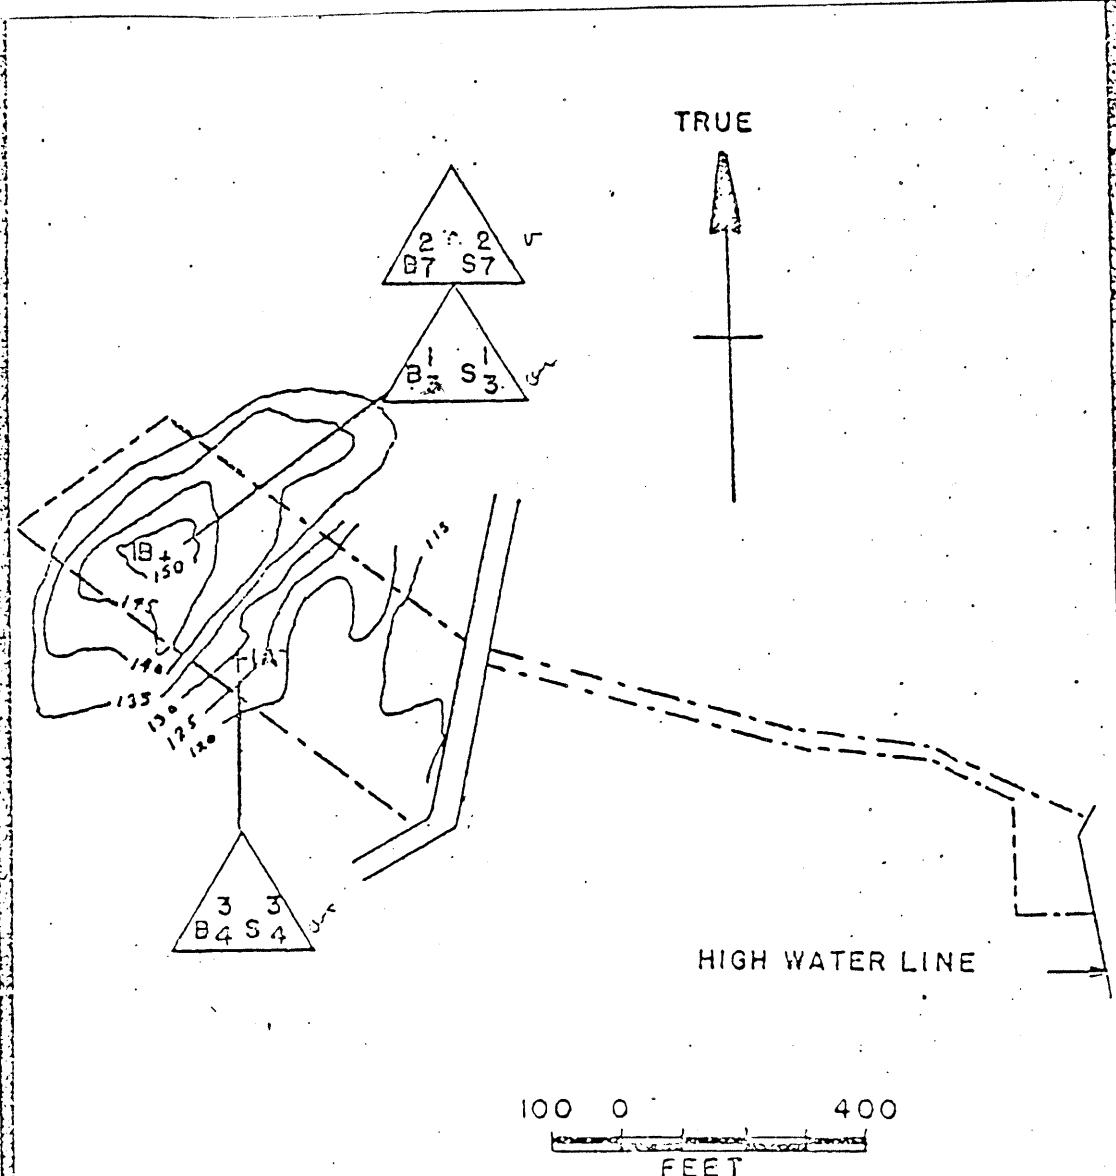

SECRET


H.D. OF PORTLAND		REV'D DATE
LOC. NO. 159		
TRUNDY POINT		
FIRE CONTROL INSTALLATION		
PREPARED BY HARBOR DEFENSES OF PORTLAND	DATE 4-11-45.	EX. NO 98-4

TRUE

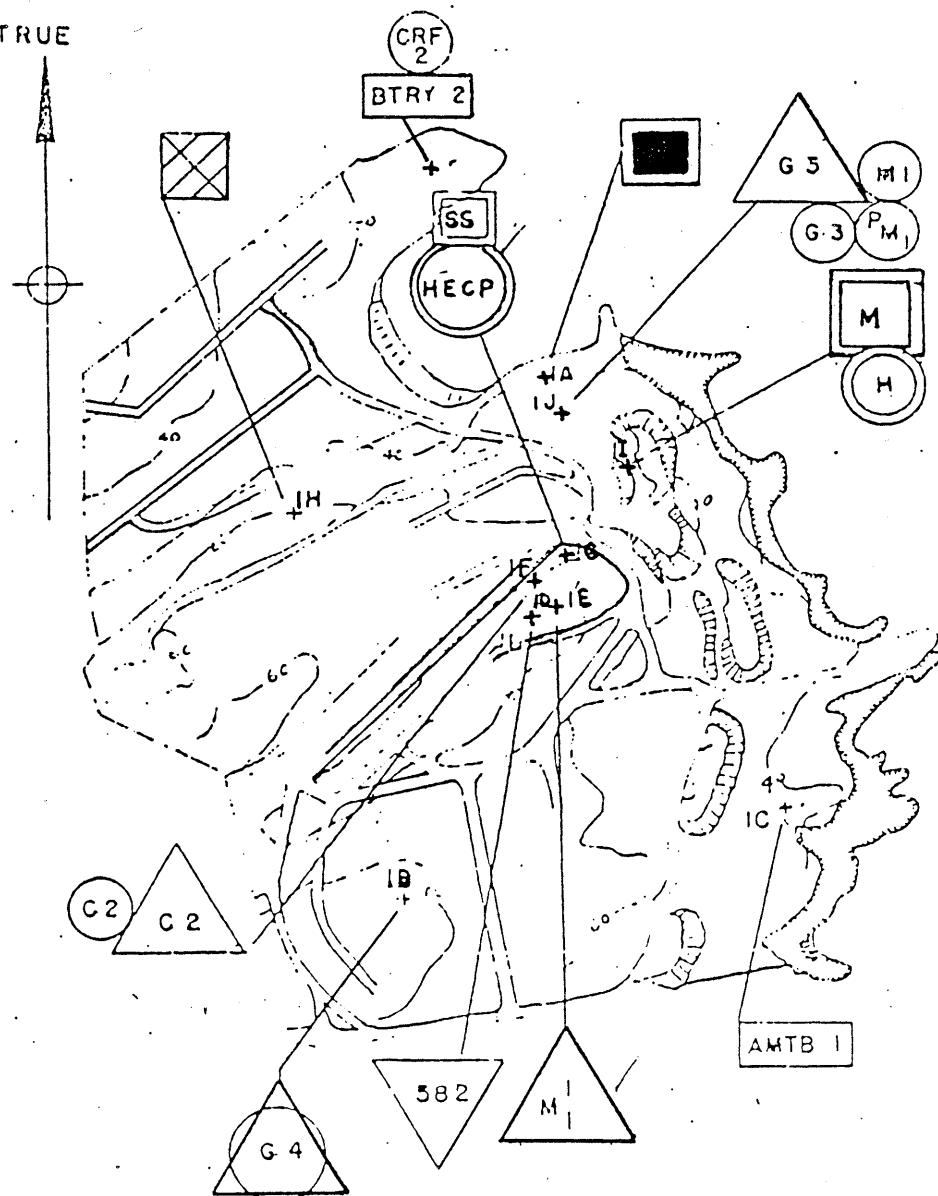

100 0 400 800

~~SECRET~~

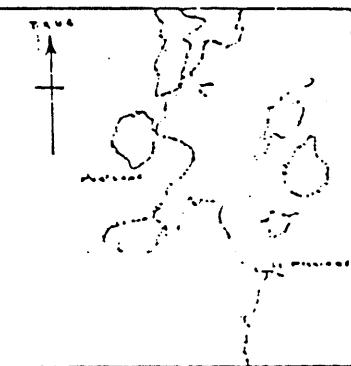



~~SECRET~~

H.D. OF PORTLAND
LOC. NO. 160
FT. WILLIAMS
FIRE CONTROL INSTALLATIONS



PREPARED BY
HARBOUR DEFENSES
OF PORTLAND

REV'D
DATE


DATE 4-11-45
EX. NO. 98-5

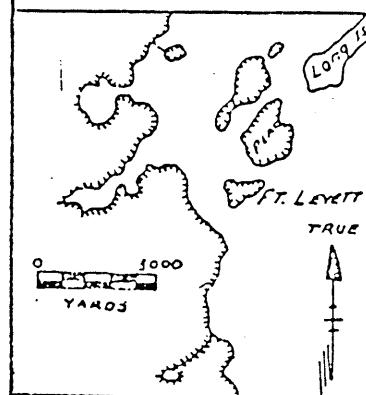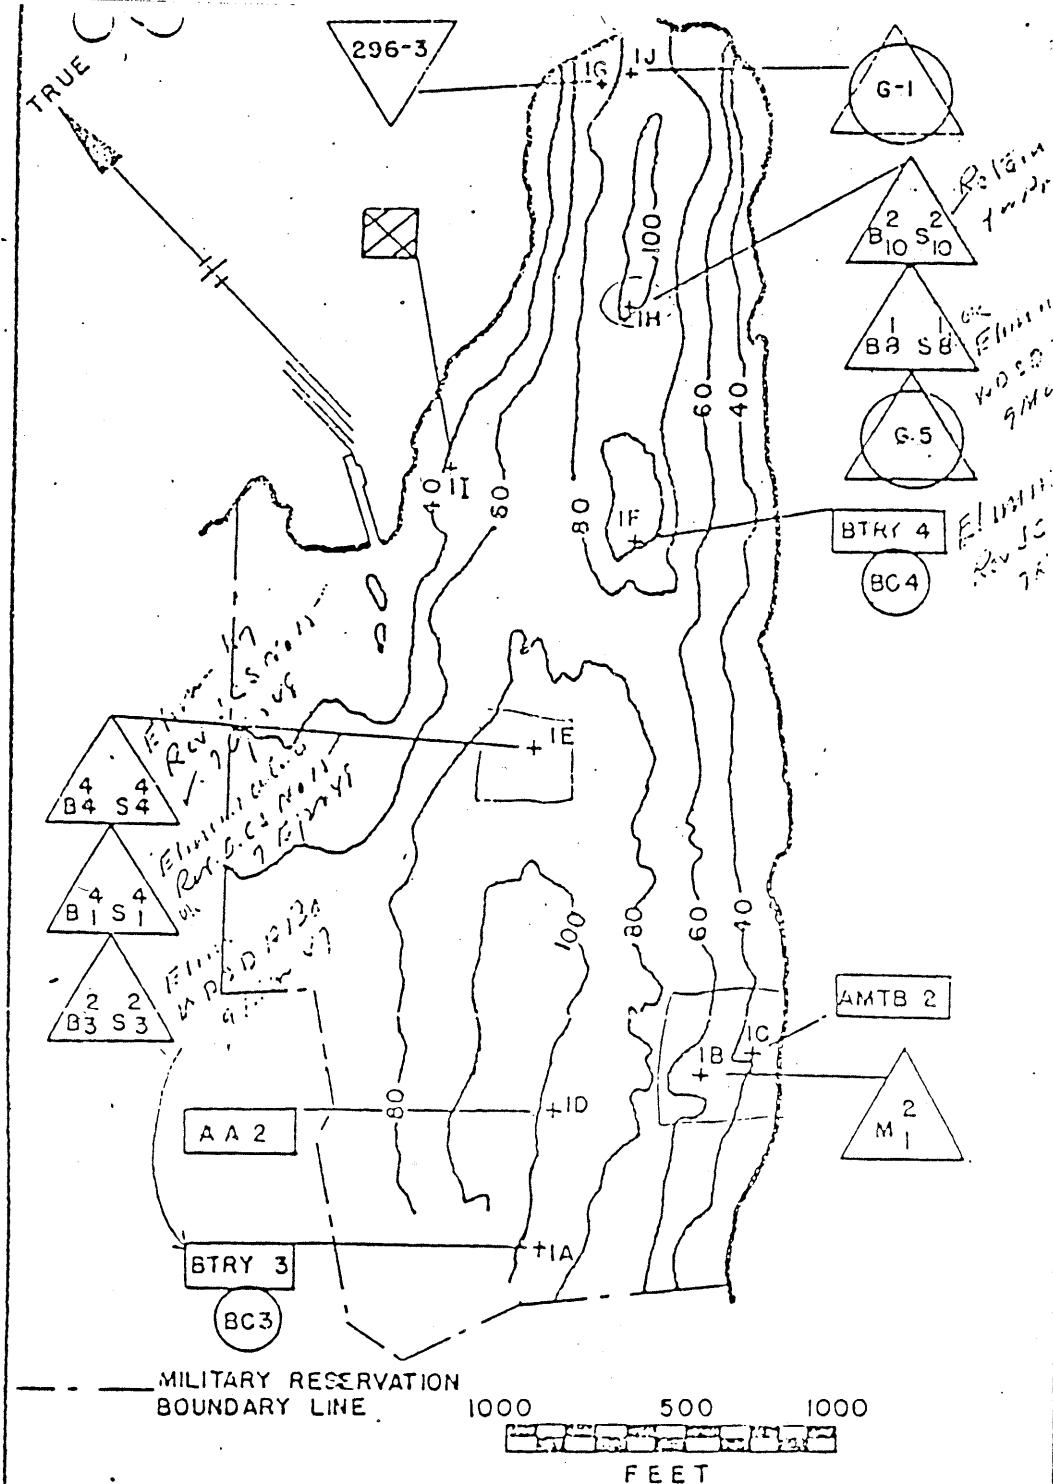

HD OF PORTLAND		REV'D DATE
LOC. NO. 161		
FORT LEVEITT		
FIRE CONTROL INSTALLATION		
PREPARED BY	DATE	
HD OF PORTLAND	4-11-45	
EX NO. 98-6		

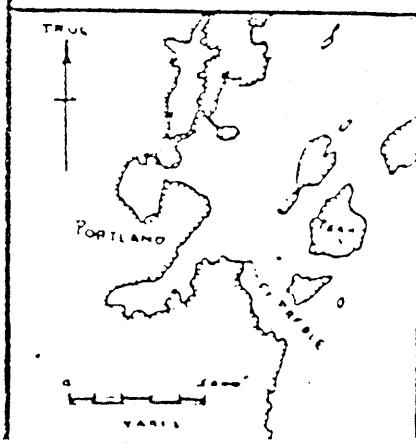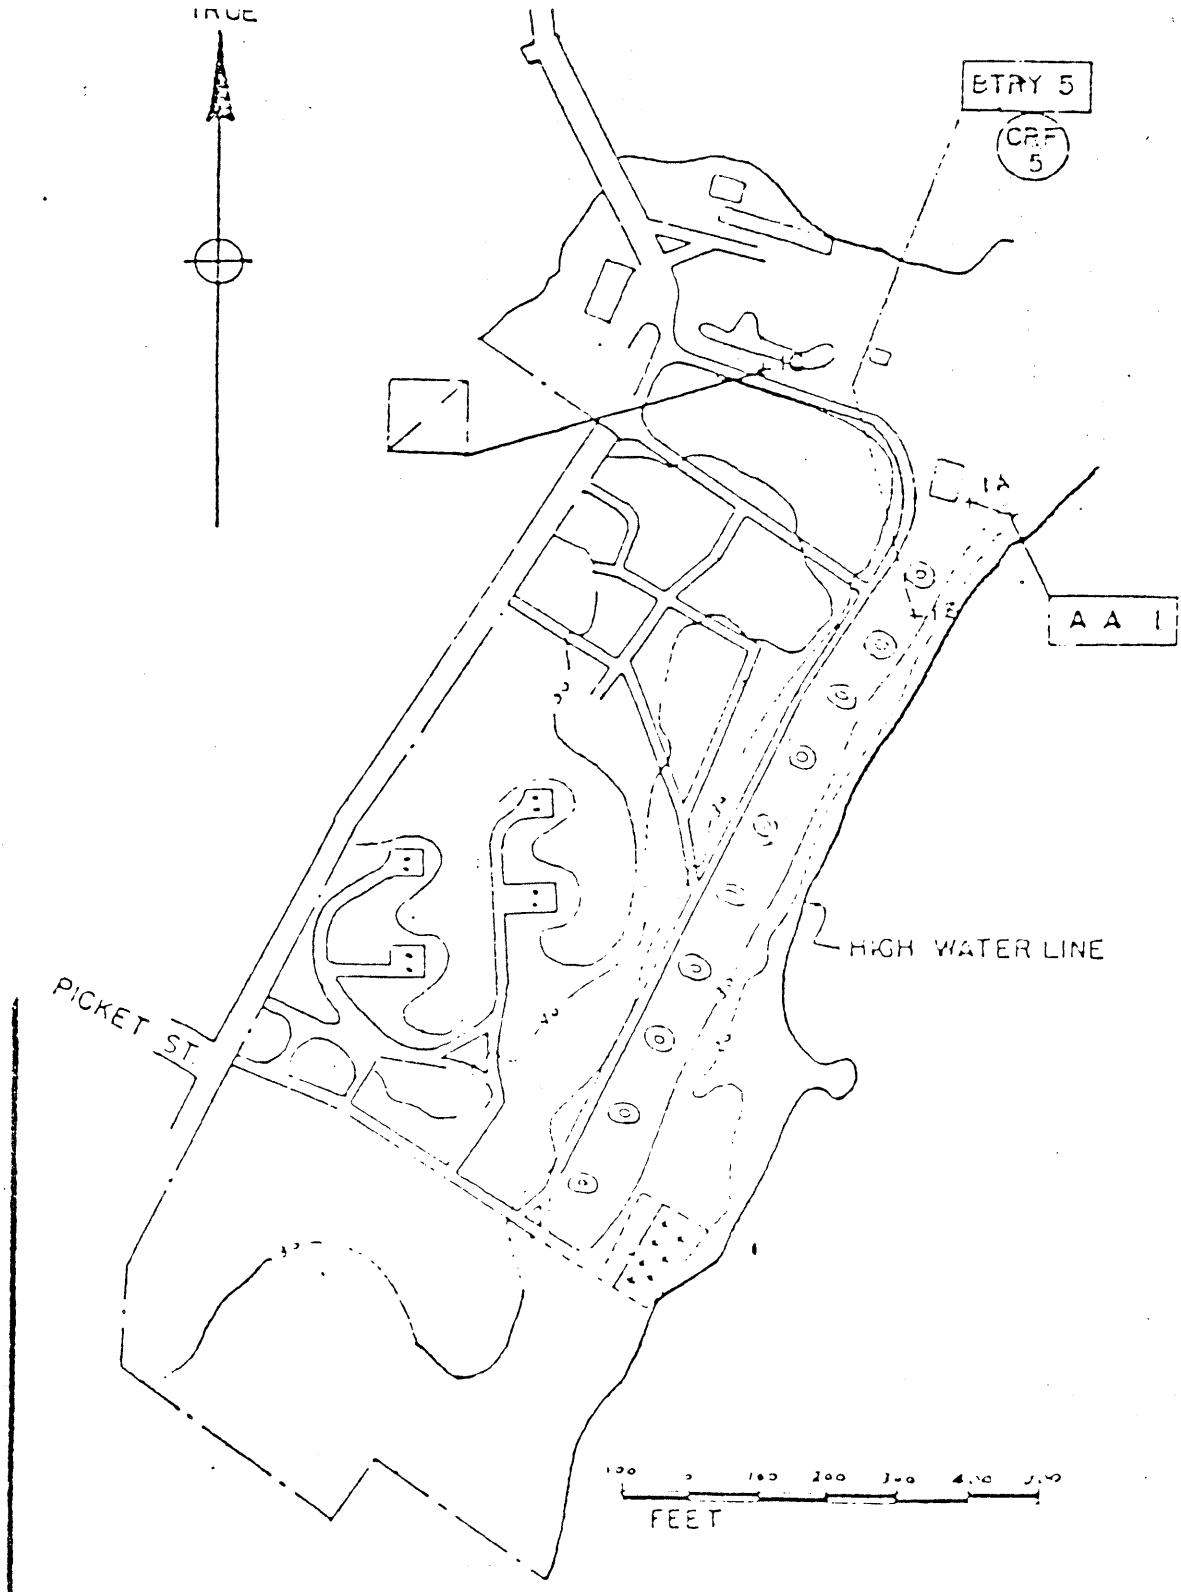

H.D OF PORTLAND		REV'D DATE
LOC NO 1162		
FORT PREBLE		
FIRE CONTROL INSTALLATIONS		
FREED BY	DATE 4-11-45	
HARBOR DEFENSES		
OF PORTLAND	I.FX NO 98-7	

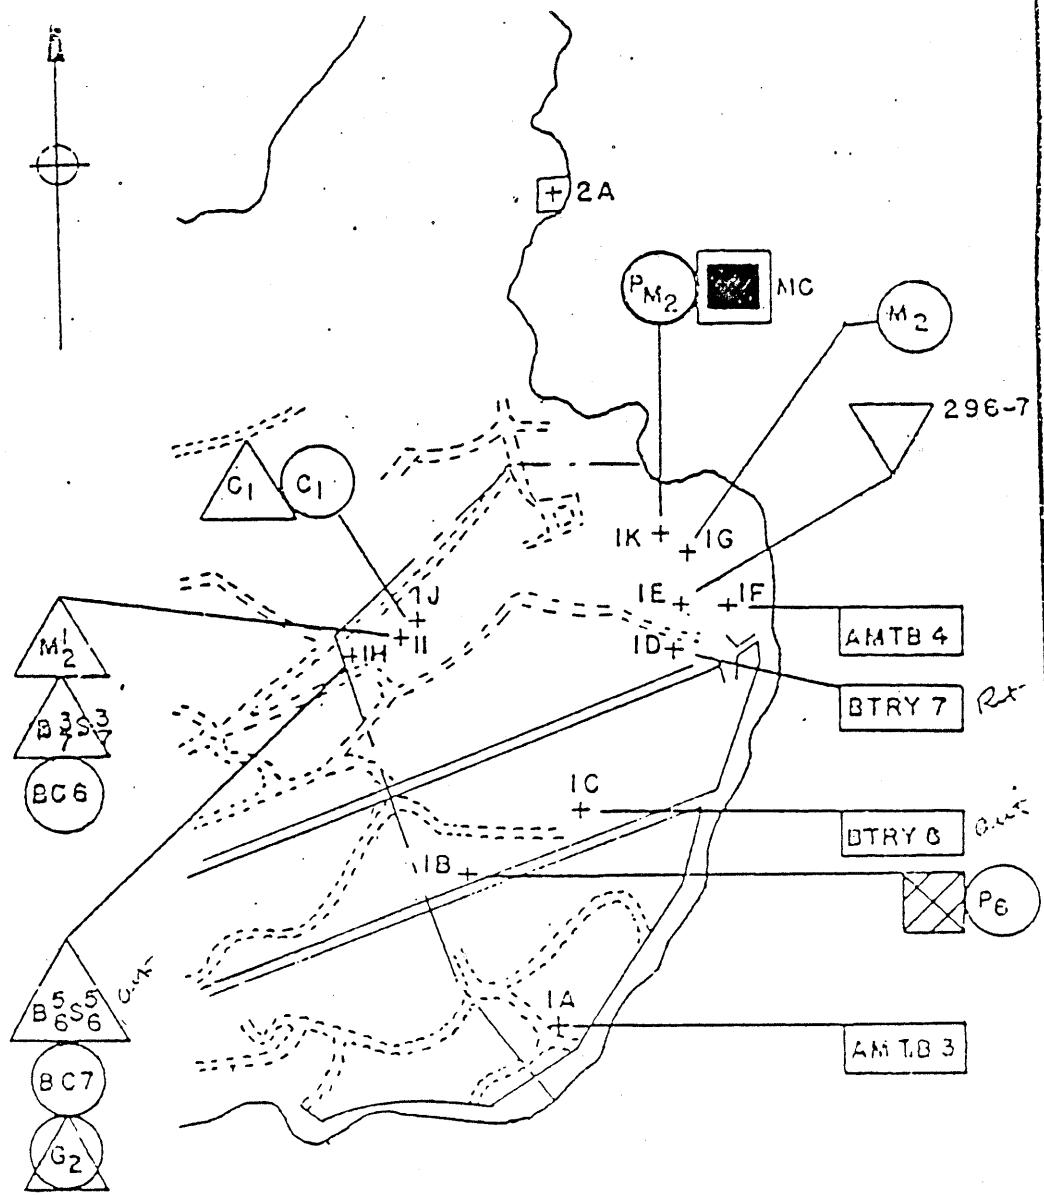


500 9 1000 2000



F E F T

MILITARY RESERVATION
BOUNDARY LINE

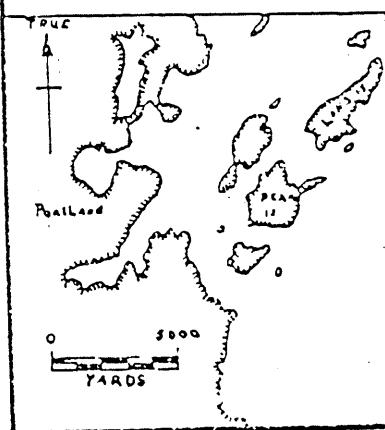


W.D. OF PORTLAND

H.D. OF PORTLAND		REV'D DATE
LOC. NO. 163		
PEAK ISLAND		
FIRE CONTROL INSTALLATIONS		
PREPARED BY HARBOR DEFENSE OF PORTLAND	DATE 4-11-45	
EX. NO. 9B-B		


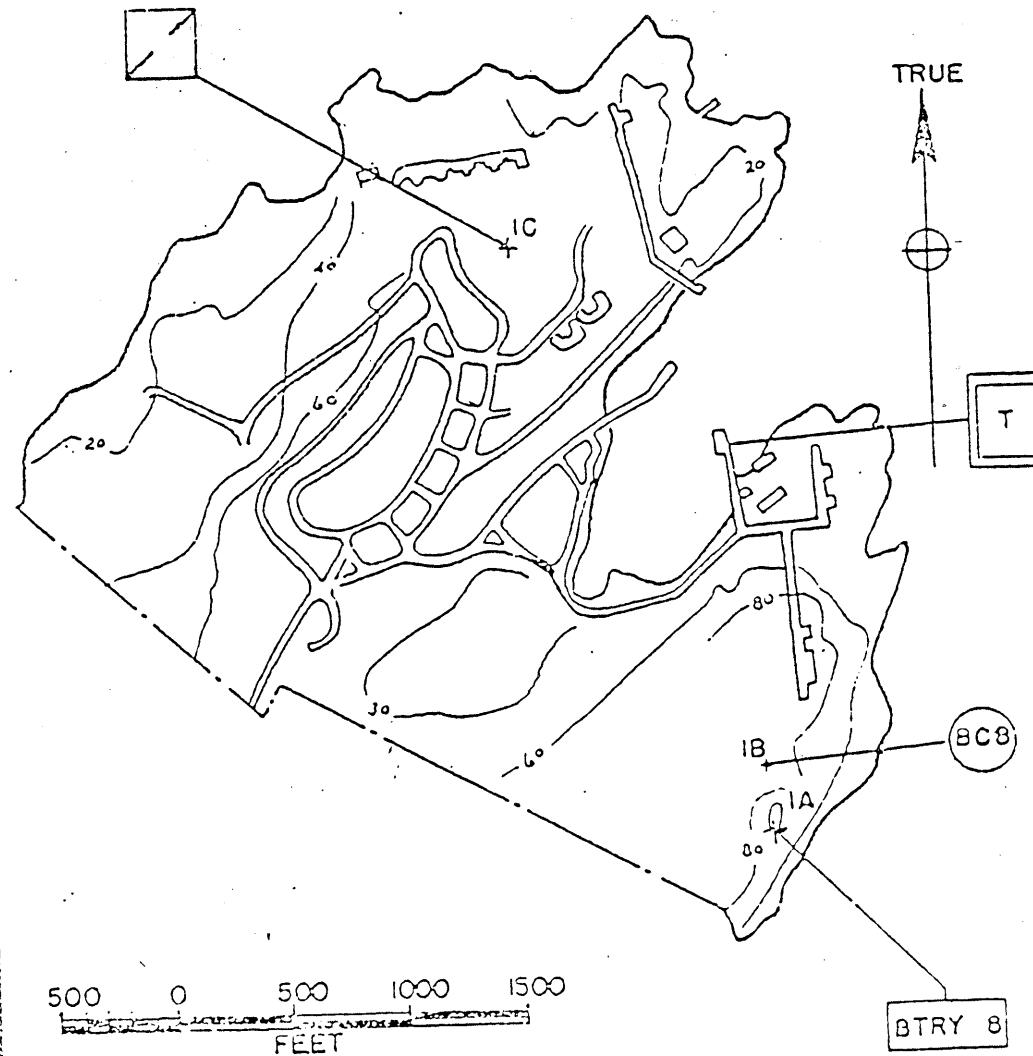


MILITARY RESERVATION
BOUNDARY LINE

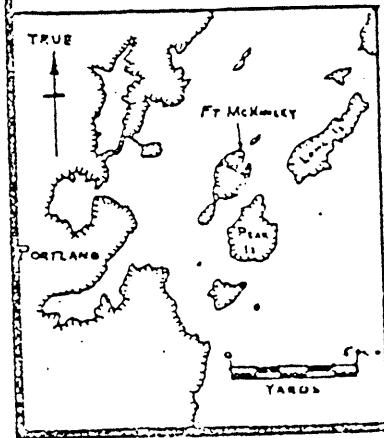


~~SECRET~~


H.D. OF PORTLAND LOC. NO. 164 FORT MCKINLEY FIRE CONTROL INSTALLATIONS		REV'D DATE
PREPARED BY HARBOR DEFENSES OF PORTLAND	DATE 4-11-45	EX. NO. 98-9

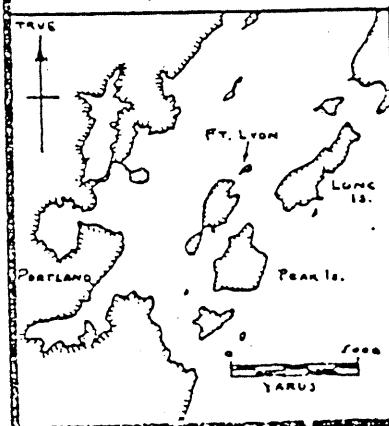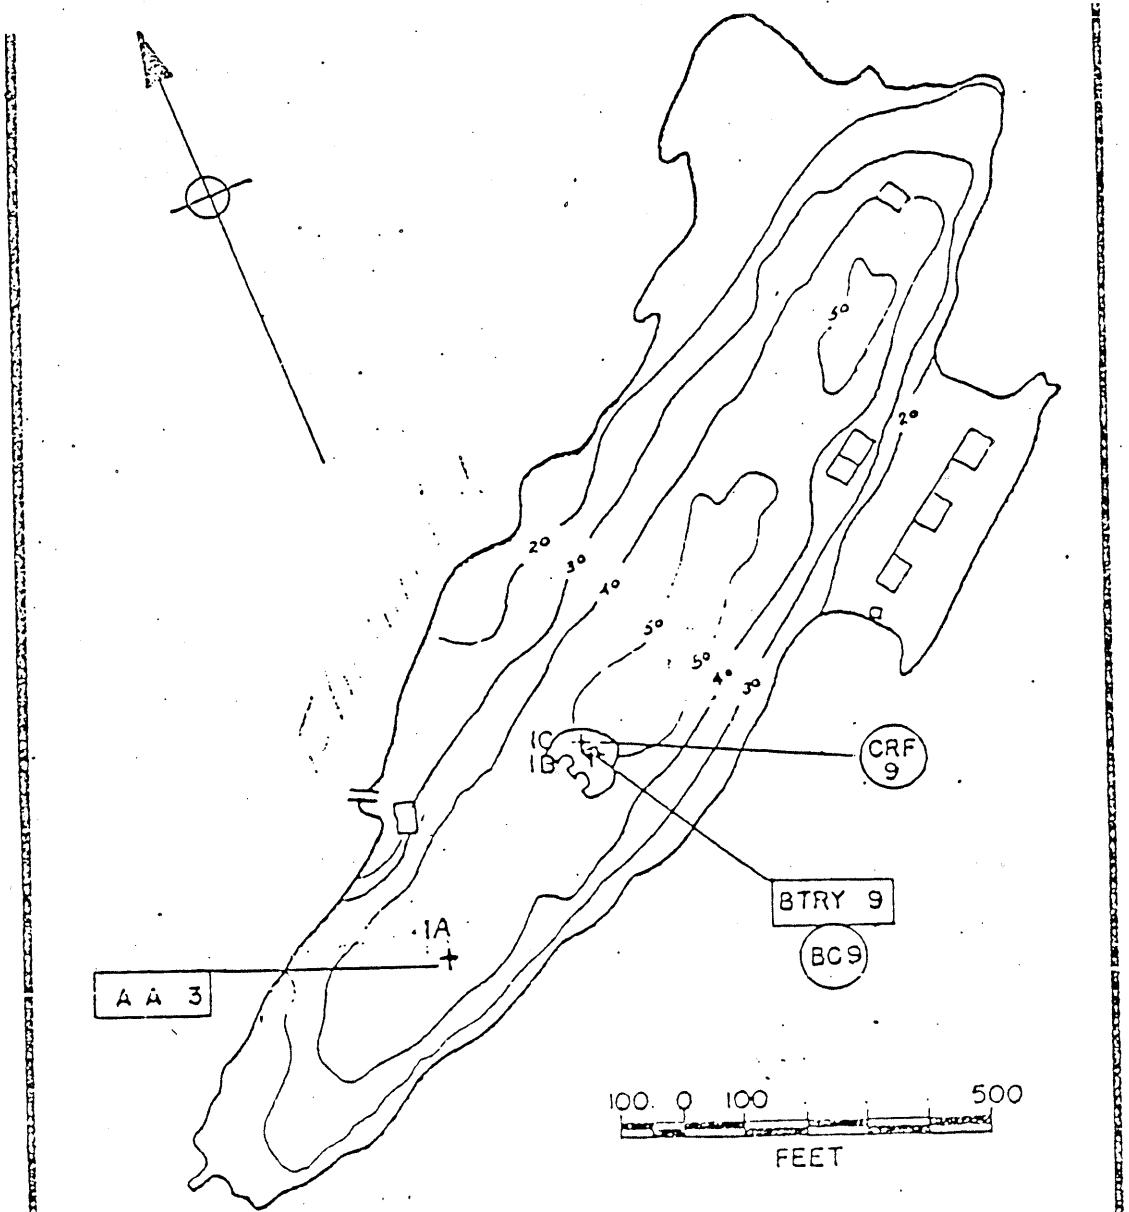


SECRET		REV'D DATE
H. D. OF PORTLAND LOC. NO. 165 FORT LYON FIRE CONTROL INSTALLATIONS		
PREPARED BY HARBOR DEFENSES OF PORTLAND	DATE 4-11-45	EX. NO. 9B-10


*H.D. of Portland
H tank - 50 Cal. gun*

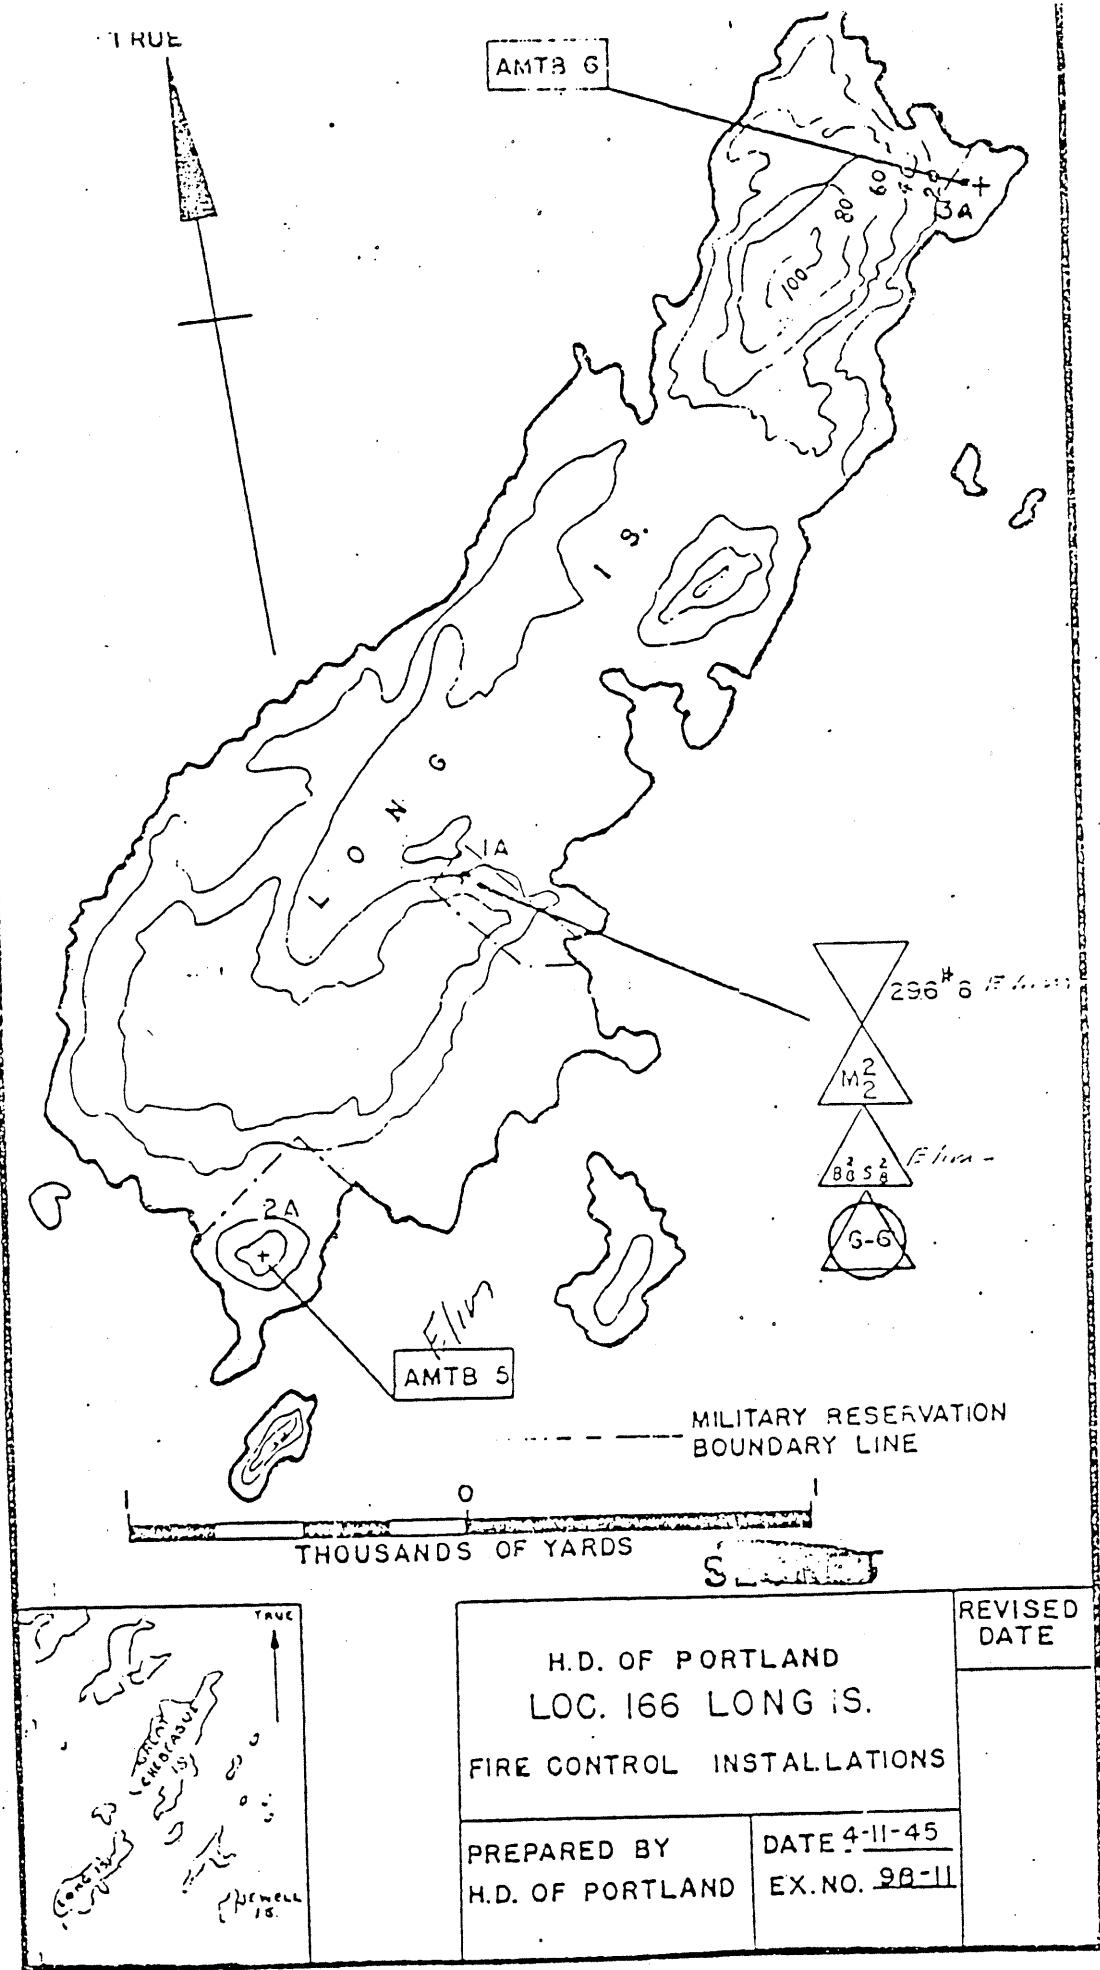

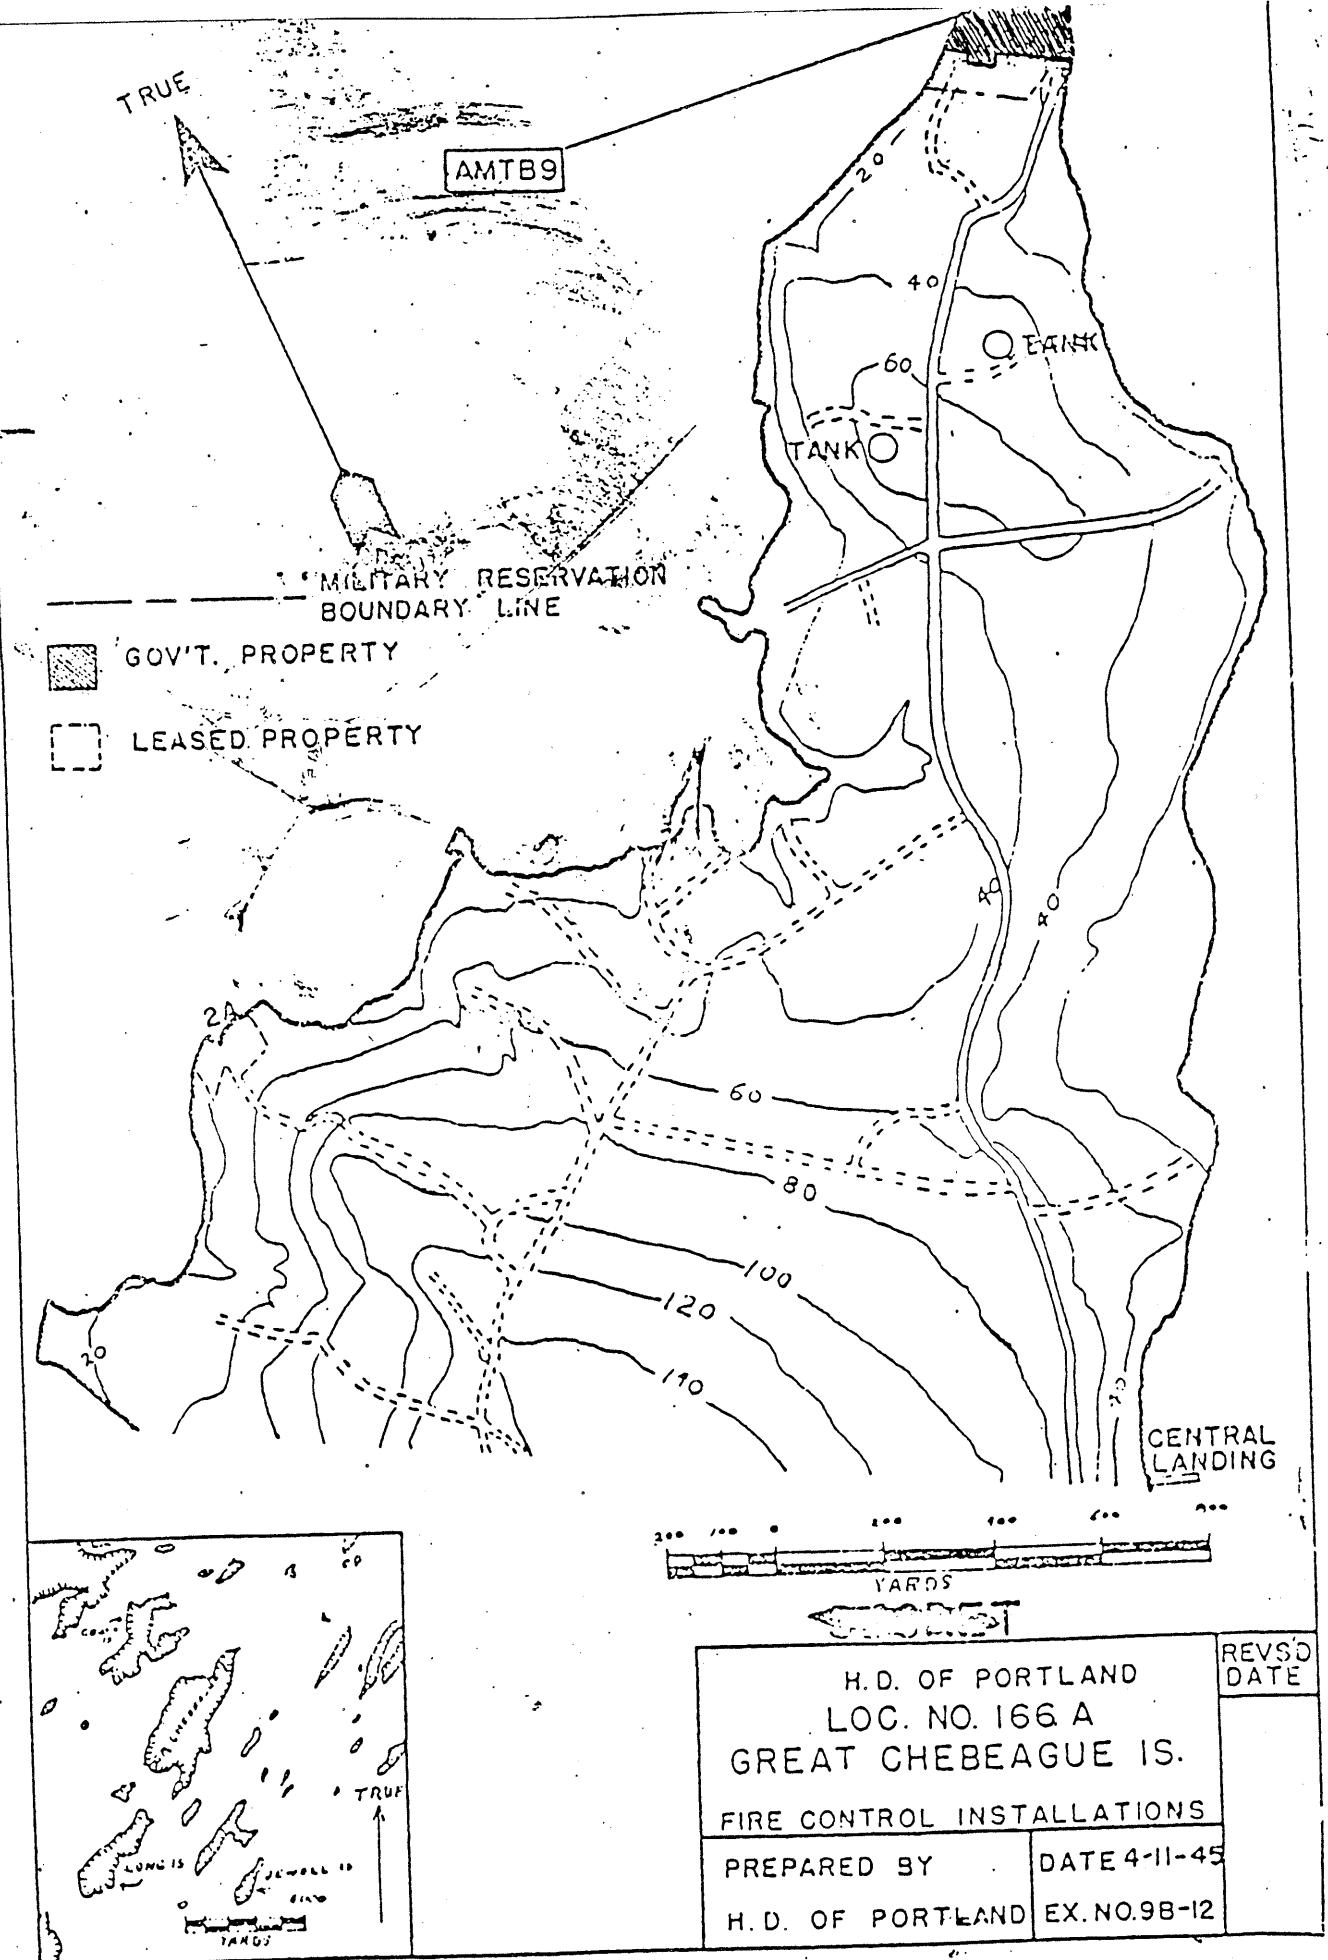

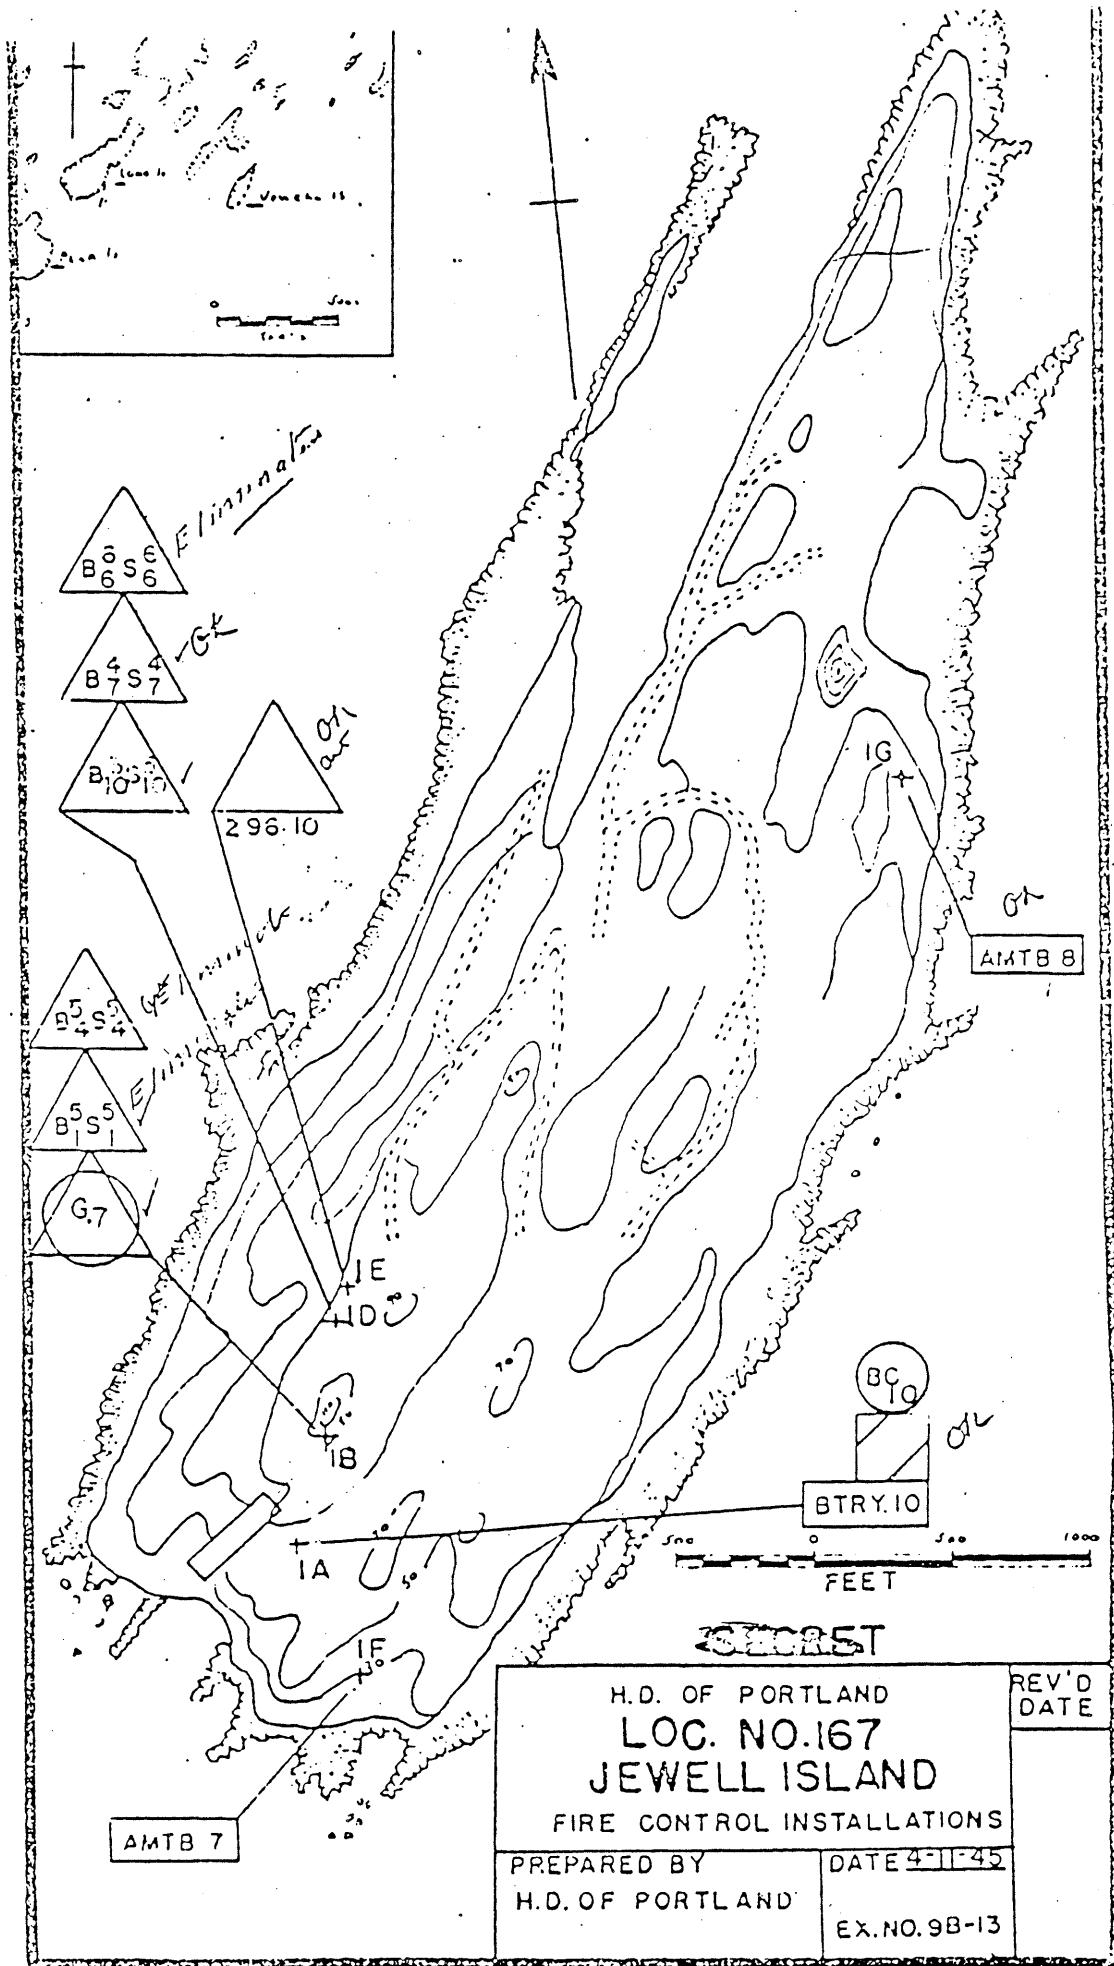


4 - 50 cal. guns in Anti-motor Torpedo Boat Battery # 1

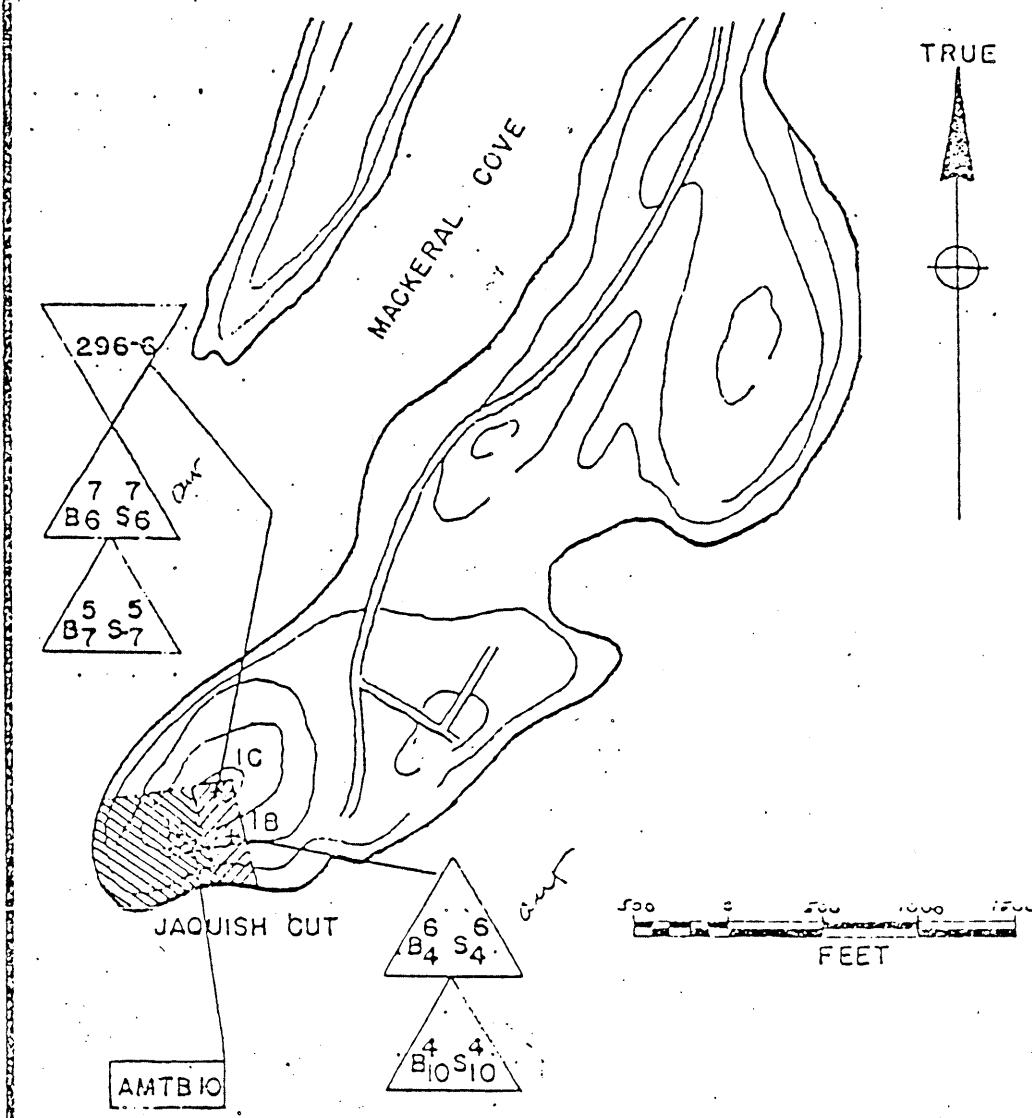


■ GOVT. OWNED PROPERTY
■ GOVT. LEASED PROPERTY

MILITARY RESERVATION
BOUNDARY LINE

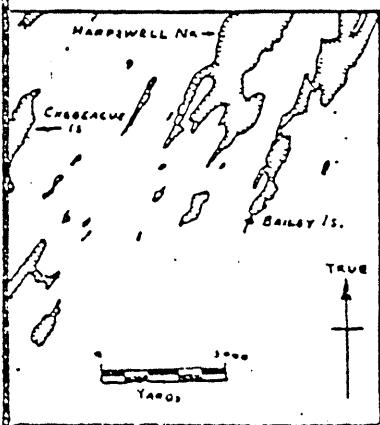


SECRET

H.D. OF PORTLAND		REV'D DATE
LOC. NO. 168		
BAILEY ISLAND		
FIRE CONTROL INSTALLATIONS.		
PREPARED BY HARBOR DEFENSES OF PORTLAND	DATE 4-11-45	EX. NO. 98-14

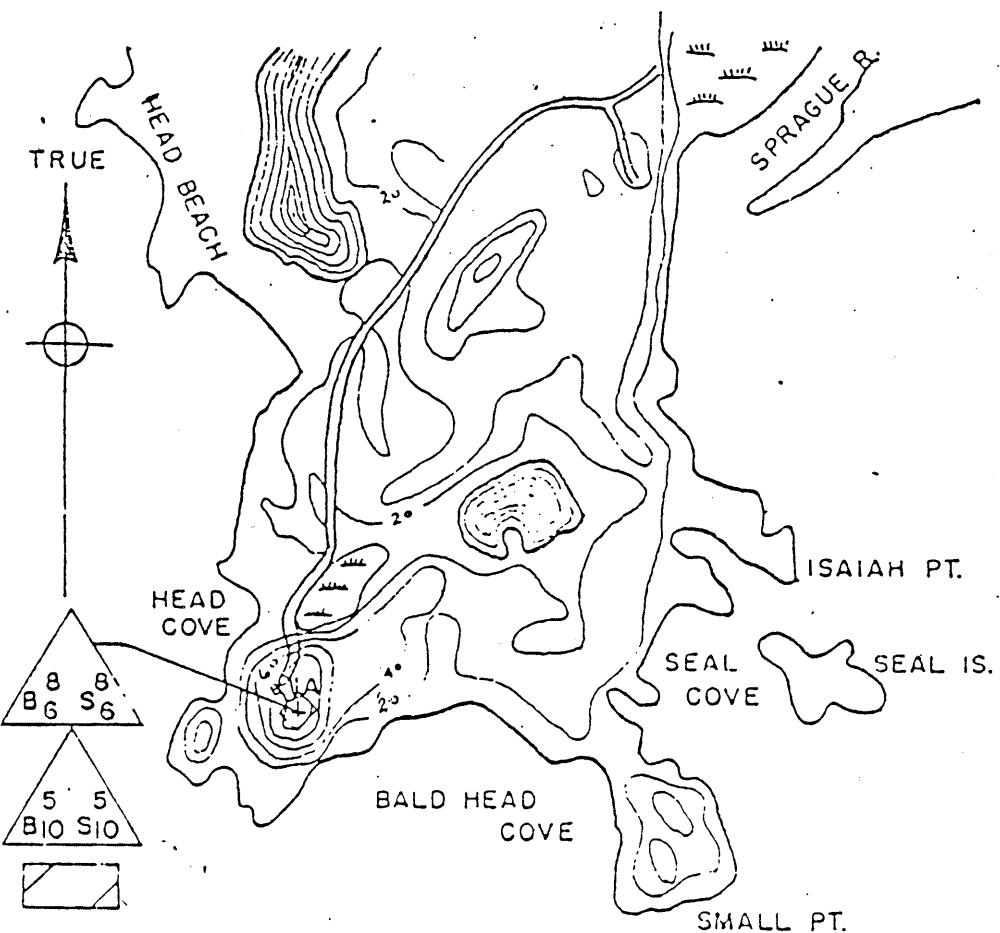


MILITARY RESERVATION
BOUNDARY LINE


~~SECRET~~

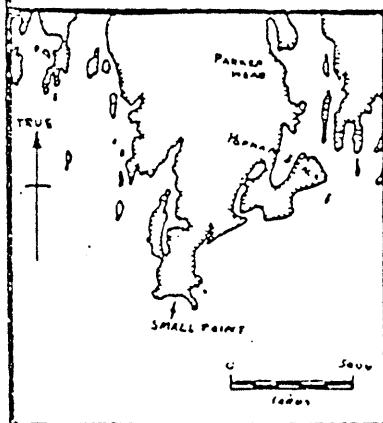

H. D. OF PORTLAND LOC. NO. 169 SMALL POINT FIRE CONTROL INSTALLATIONS	REV'D DATE
PREPARED BY H. D. OF PORTLAND	DATE 4-11-45
	EX. NO. 98-15

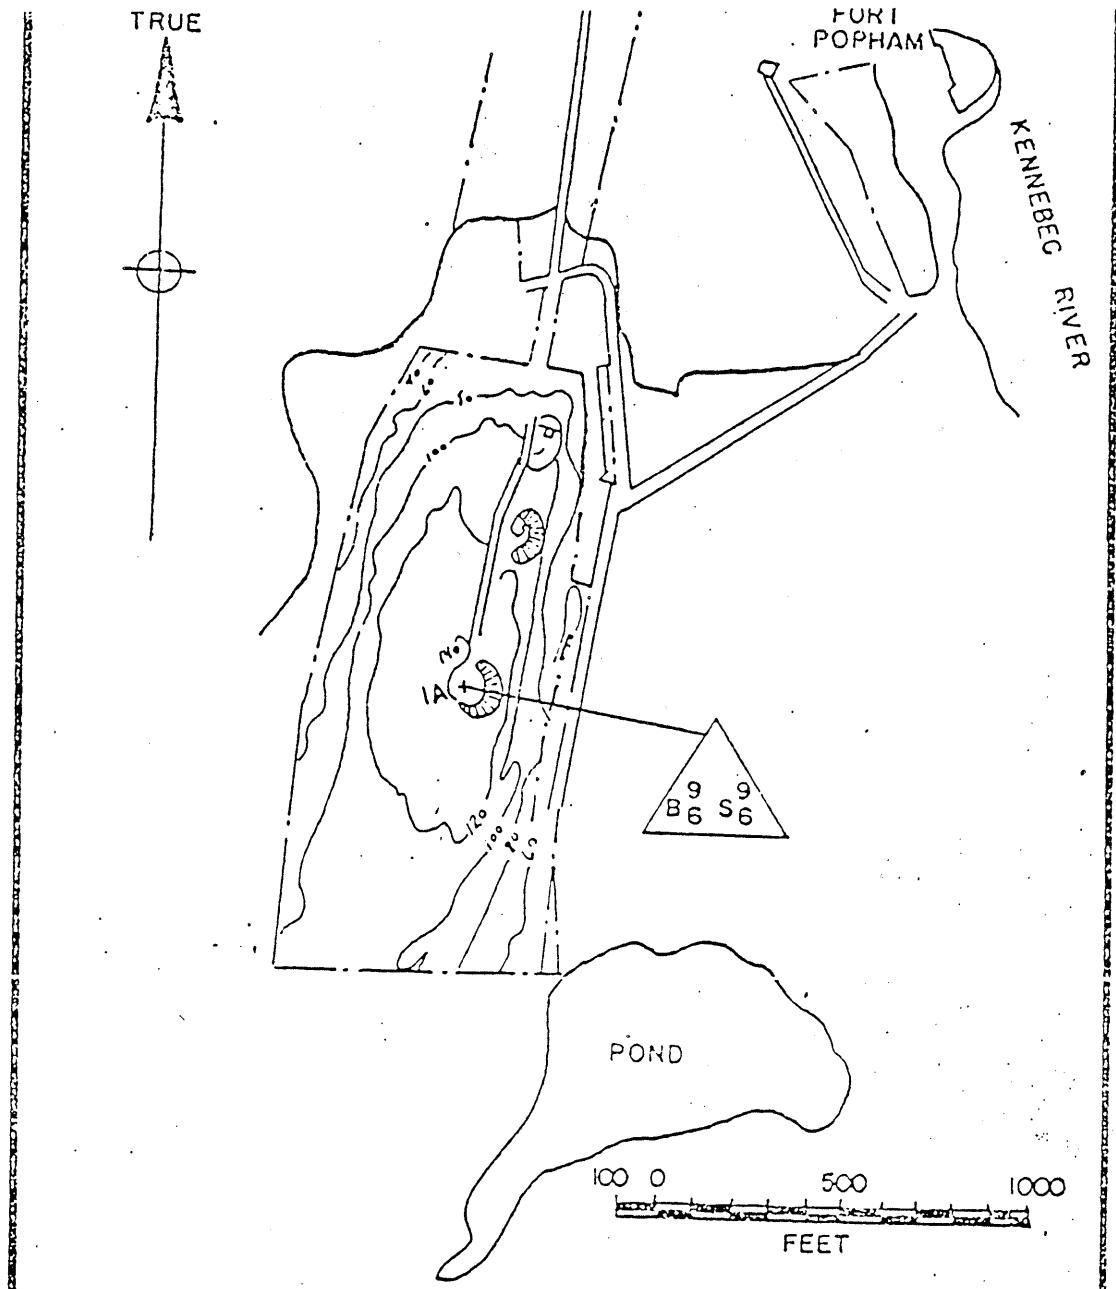

MILITARY RESERVATION
BOUNDARY LINE

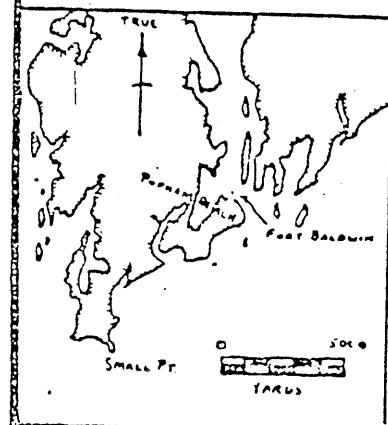

~~SECRET~~

H. D. OF PORTLAND LOC. NO. 170 FORT BALDWIN FIRE CONTROL INSTALLATIONS		REV'D DATE
PREPARED BY H. D. OF PORTLAND	DATE 4-11-45	
		EX. NO. 9B-16

Annex 2--REPRESENTATIVE BATTERIES AND ORDNANCE

Endicott and Taft Periods, 1891-1916

3" gun (Model 1902) on pedestal mount (Model 1902)
Battery Keyes, Fort Williams, 1906
Battery Abbott, Fort Lyon, 1909
6" gun Armstrong (M1898) on barbette carriage (M1898)
Battery Hobart, Fort Williams, 1898
6" gun (Model 1900) on barbette carriage (Model 1900)
Battery Ferguson, Fort Levett, 1906
6" gun on disappearing carriage (Model 1898)
Battery Garesche, Fort Williams, 1906
8" gun on disappearing carriage (Model 1896)
Battery Honeycutt, Fort McKinley, 1901
10" gun on disappearing carriage (Model 1894)
Battery DeHart, Fort Williams, 1898
12" gun on disappearing carriage (Model 1897)
Battery Blair, Fort Williams, 1903
12" mortar (M1890MI) on carriage (M1896MI)
Battery Chase, Fort Preble, 1901

World War I and the Inter-War Period, 1917-1938

3" gun (M1917MII) on anti-aircraft mount (M1917MI)
Example of anti-aircraft gun emplacement, 1921
12" long range gun on barbette carriage (Model 1917)
Battery Foote, Fort Levett, 1920

World War II, 1939-1945

Example of 3" anti-motor torpedo boat battery, 1943
90mm anti-motor torpedo boat gun with shield
Anti-Motor Torpedo Boat Battery, Fort Williams, 1944
Example of 155mm gun emplacement, 1934
6" gun on barbette carriage (M1 and M2) with shield
Battery 205, Fort Foster, 1944
16" gun on barbette carriage (M1919M3) with shield in casemate
16" casemated battery, 1942

20676


37977
J. J. G.

1756

BETHLEHEM STEEL CO.
15000 PER SF STAIN MOUNT

3 (15 por) PETIC

GENERAL VIEWS.

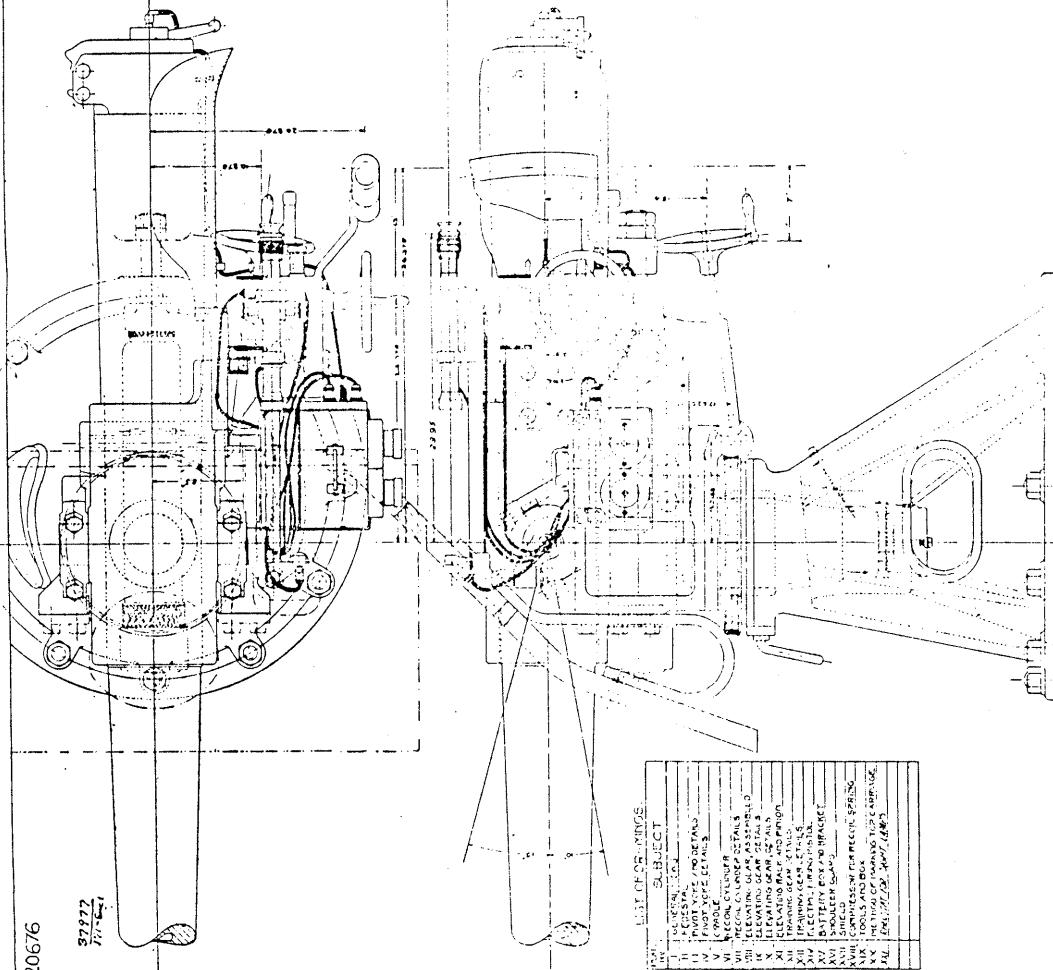



15 F.D.R.
BARTONTE CARRIAGE
MODEL OF 1902.

APPROVED
W.H. COOPER
BUREAU OF FIRE PROTECTION
U.S. TREASURY DEPARTMENT


2076

REPORT
COMBINE COAST FORTIFICATIONS
Plan 13

Completed 10 Mar 1. 1920


Form 7

COAST DEFENSES OF PORTLAND
FORT WILLIAMS
BATTERIES REYES
No. of guns 2
Muzzle load 15
Carriage load 15

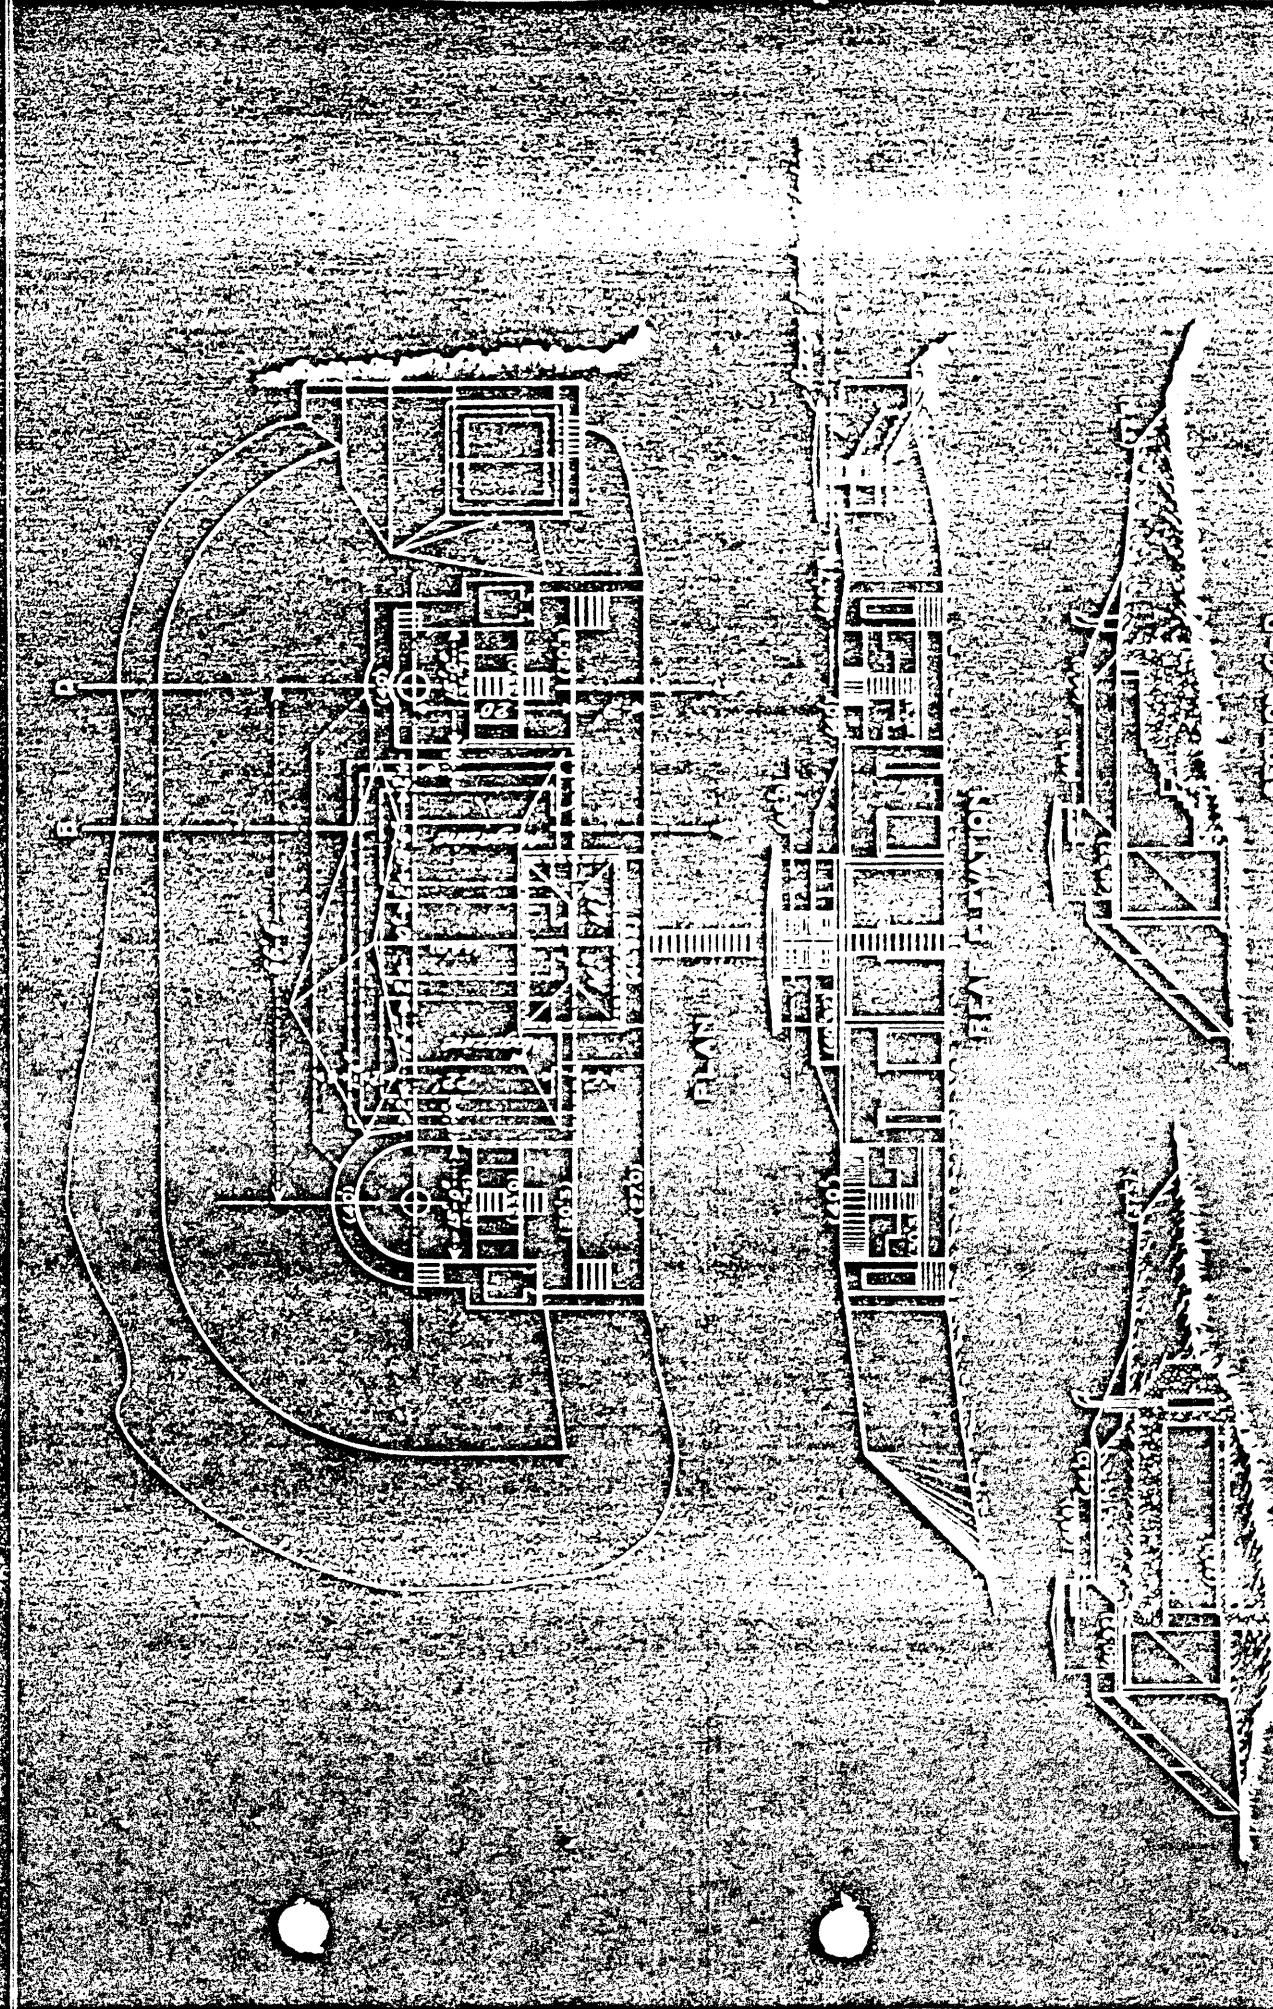





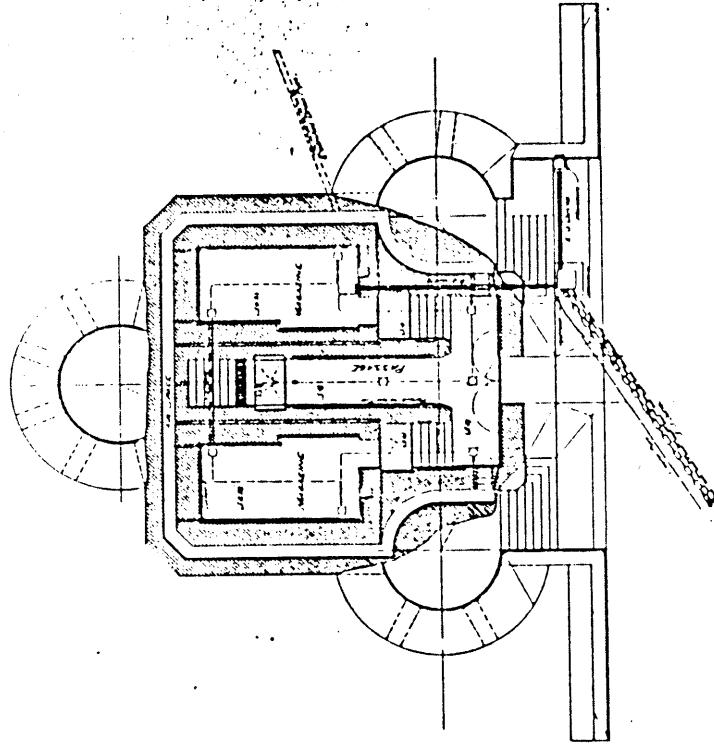

FORT LYON
PORTLAND HARBOR, ME.
BATTERY ABBOTT

Scale 1 in. = 40 ft.

U.S. Engineers Office
Portland, Me., Dec. 2, 1908

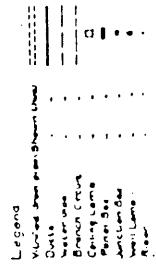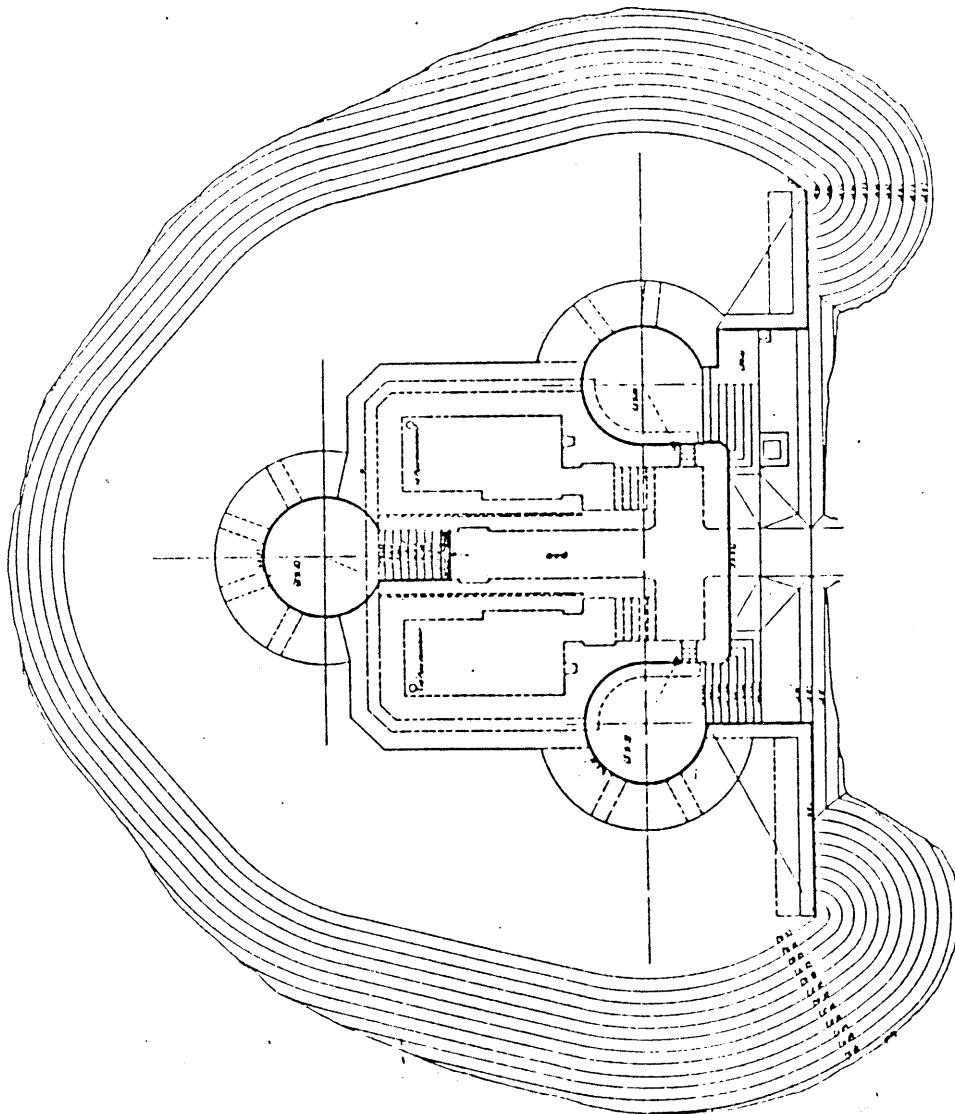


War Department,
Approved, *Frank J. Steele*,
Chief of Engineers,
U.S. Army.

Officer in Charge of Engineers,
U.S. Army,
Jan. 12, 1909.
Respectfully submitted to the
Secretary of War with recommen-
dation for approval.
John C. Stetson,
Chief of Engineers,
U.S. Army.

6-INCH BARBETTE CARRIAGE, ARMSTRONG.

PLATE II
1752

40 CALIBRE GUN

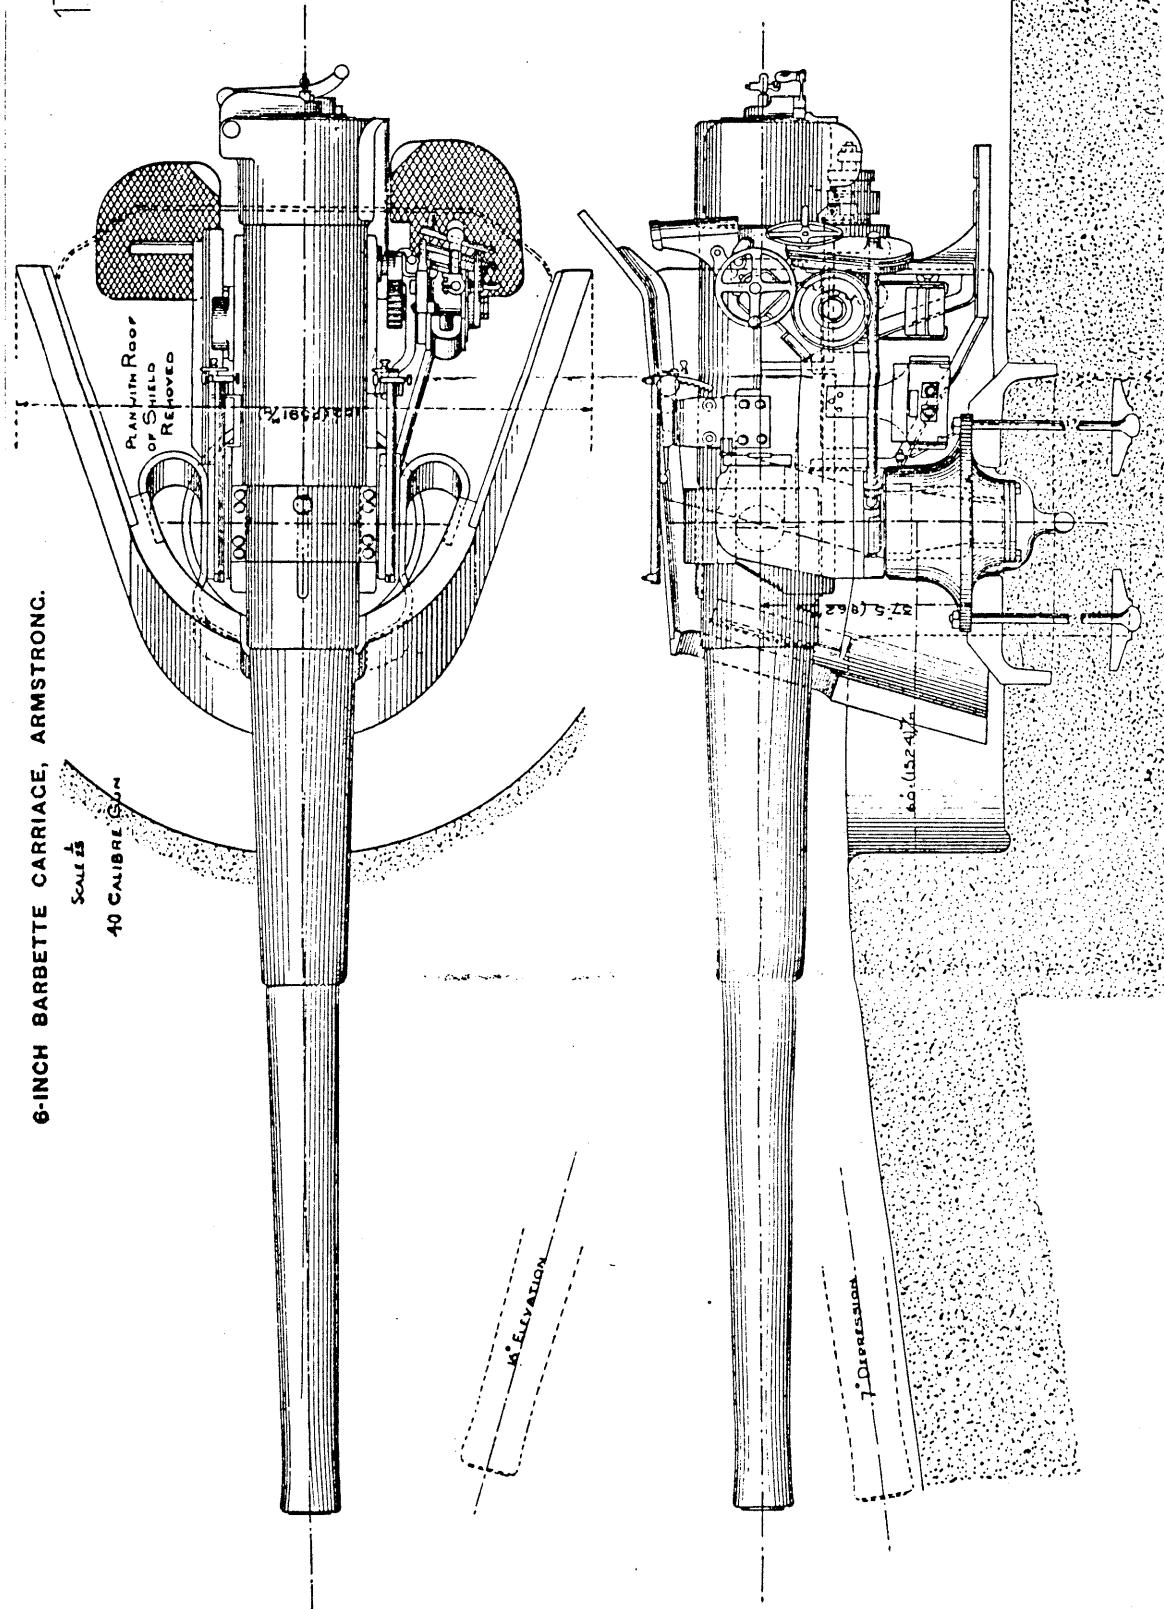



REPORT OF WORKS SEACOAST FORTIFICATIONS
(Batteries) Plan

EPR - THE NATIONAL ARCHIVES

Form 7. Corrected to Mar. 1, 1920.

FORT WILLIAMS
BATTERY HOBART
No. of guns 1
caliber 6" Search pedestal F

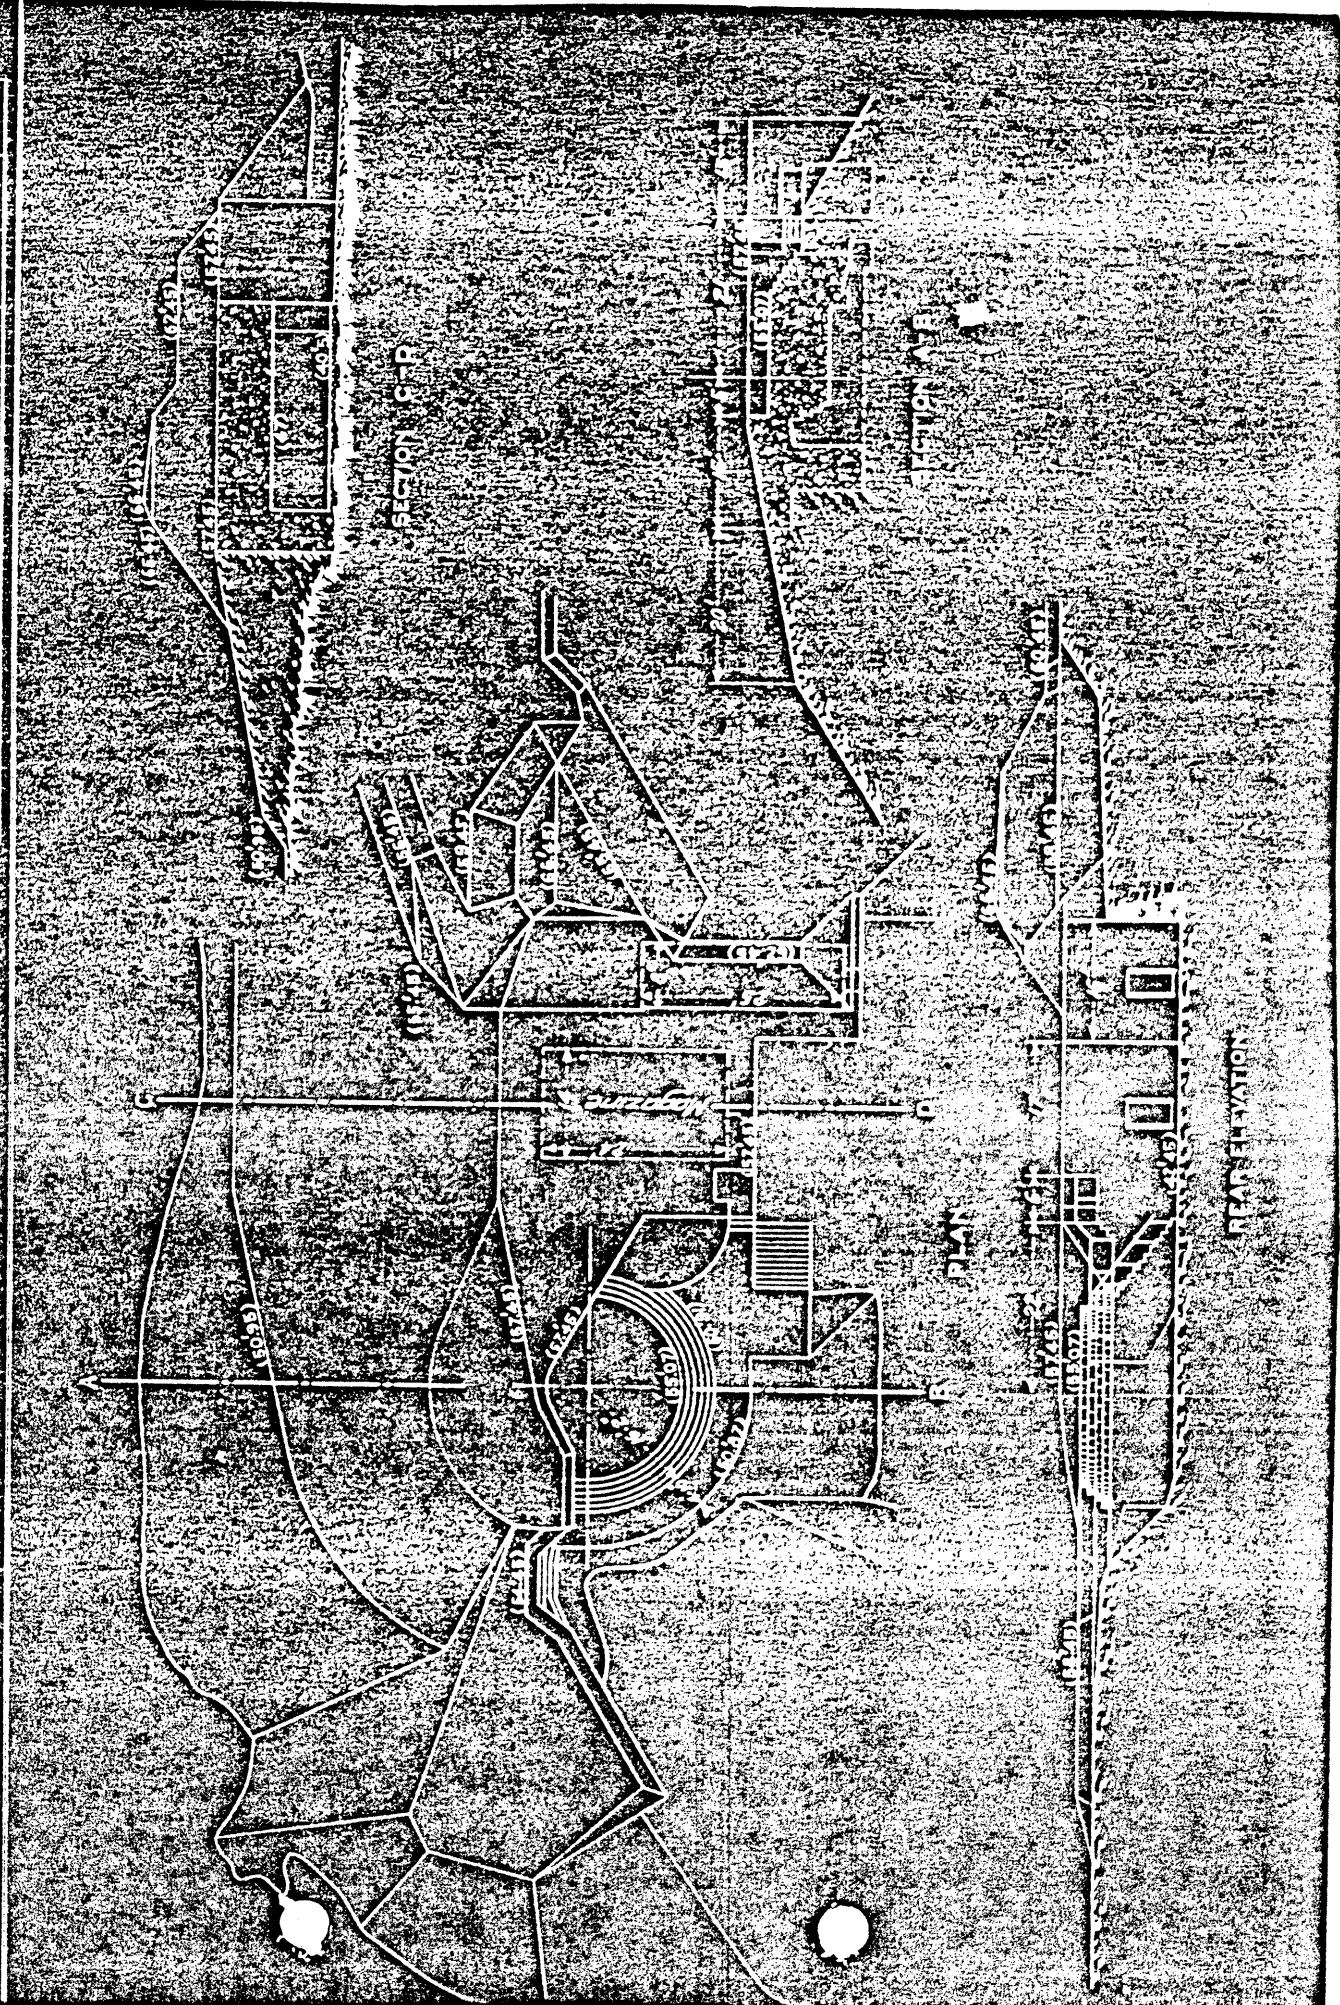

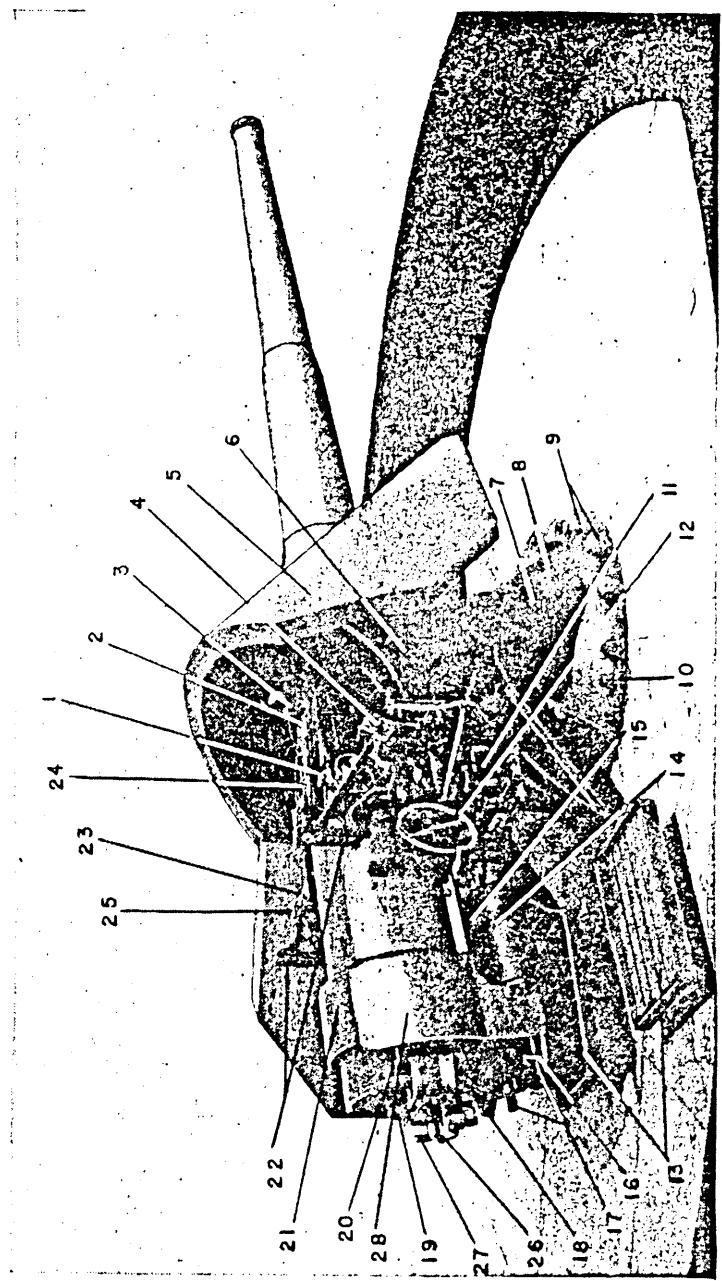

1. Deflection screw.
 2. Sight cradle.
 3. Trunnion hoop.
 4. Firing pistol.
 5. Shield.
 6. Shield support.
 7. Manhole cover.
 8. Pedestal base.
 9. Foundation bolts.
 10. Leveling screw.
 11. Battery case.
 12. Traversing handwheel.
 13. Gun pointer's platform.
 14. Spring case extension.
 15. Recoil cylinder.
 16. Piston rod.
 17. Spring rods.
 18. Loading tray.
 19. Breech carrier.
 20. Breech pin.
 21. Recoil hoop.
 22. Shoulder rests.
 23. Elevation handwheel.
 24. Telescopic sight.
 25. Open sight.
 26. Gear segment.
 27. Breech operating handle.
 28. Shoulder rest.

FIGURE 37.—6-inch rapid-fire gun M1900 on barbette carriage M1900 (pedestal mount).

Report of COMPLETED WORKS - SEACOAST FORTIFICATIONS
Battery Plan

COAST DEFENSES OF PORTLAND, MAINE


FORT LEVETTE

BATTERY FERGUSON
No of guns 2

Carriage Ped L.F.
16 FT.

Corrected to Mar. 1, 1970

Form 7

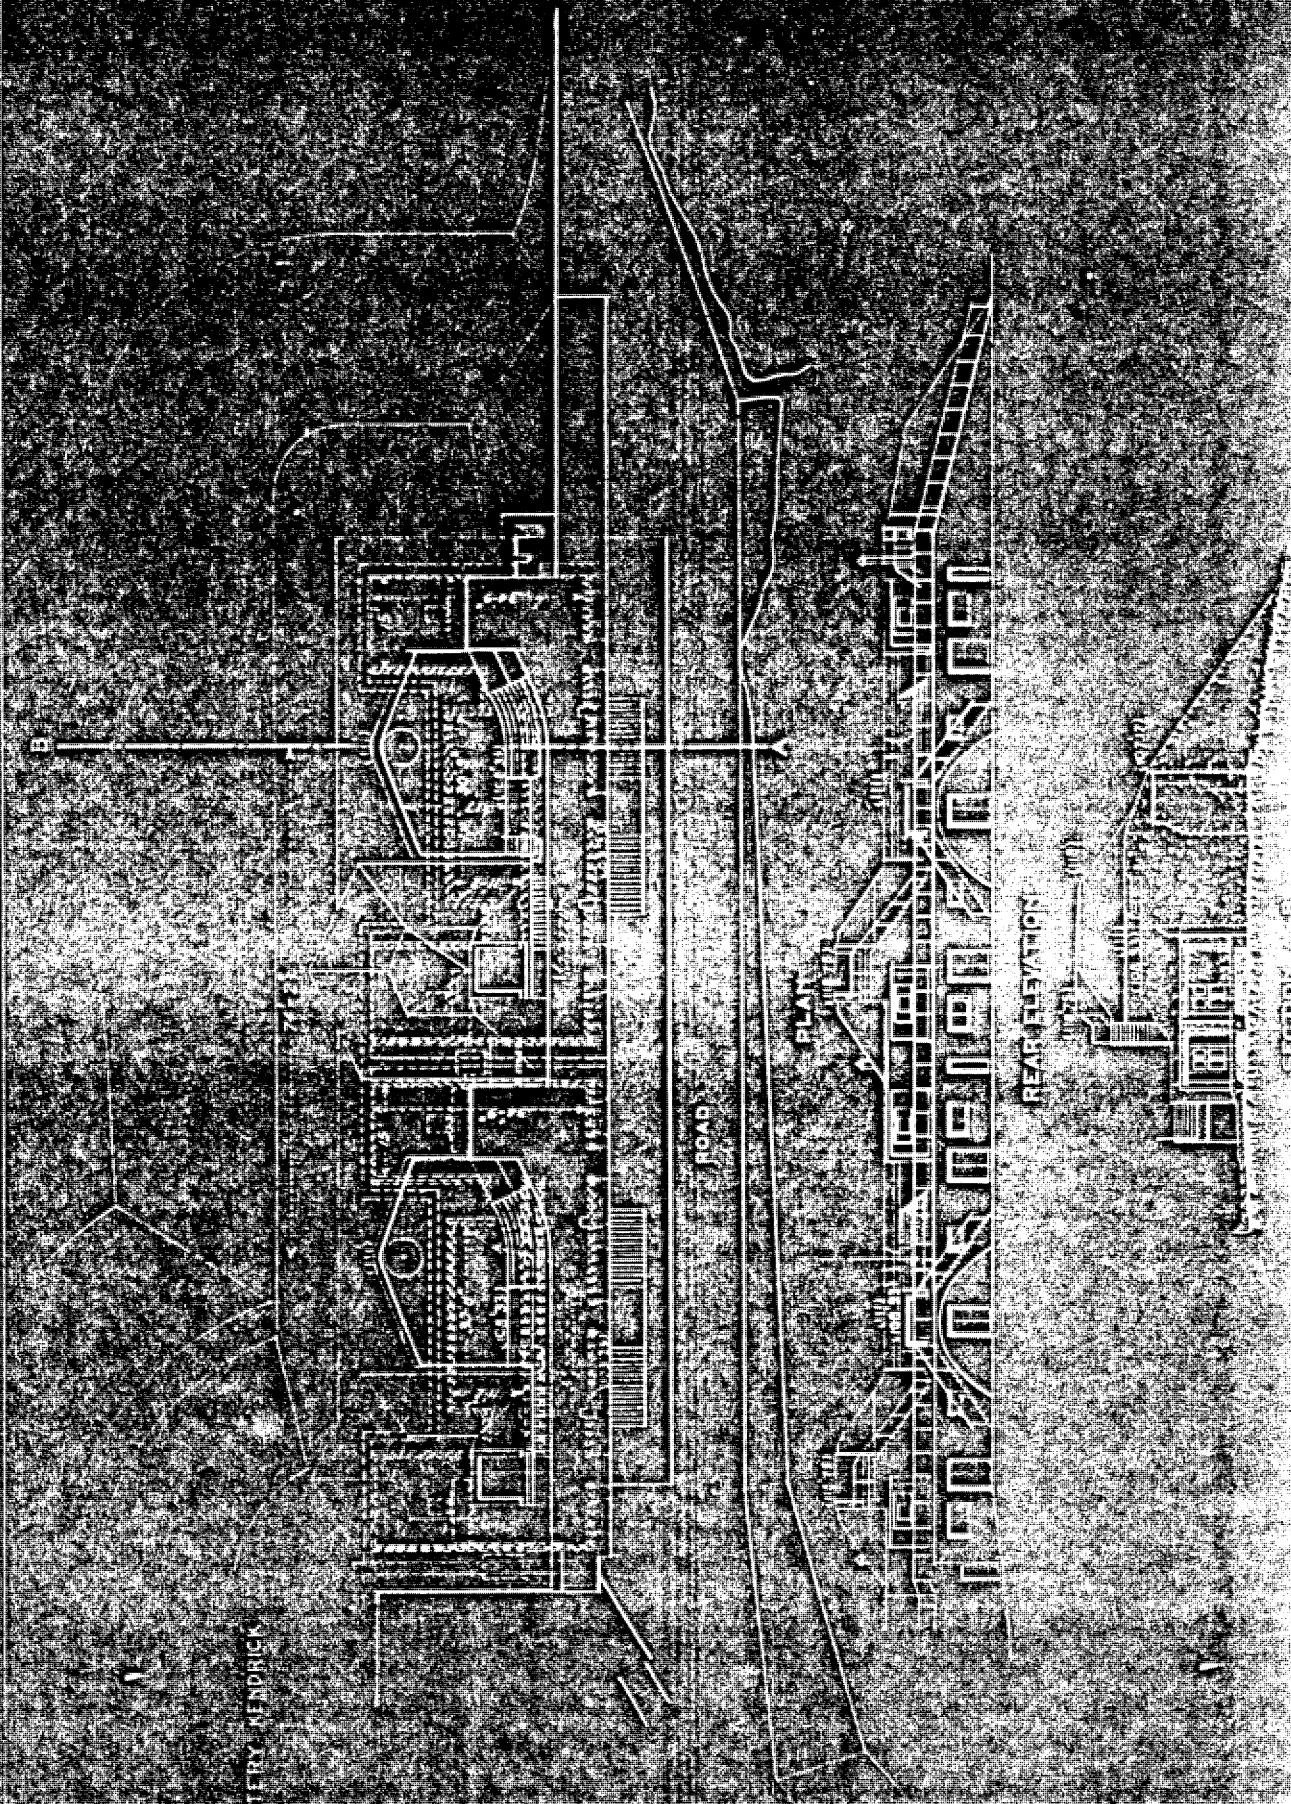

54



1686


List of Drawings.

PLATE	SUBJECT
I	Elevation



Class 7	Division 3	Drawing 1	12
---------	------------	-----------	----

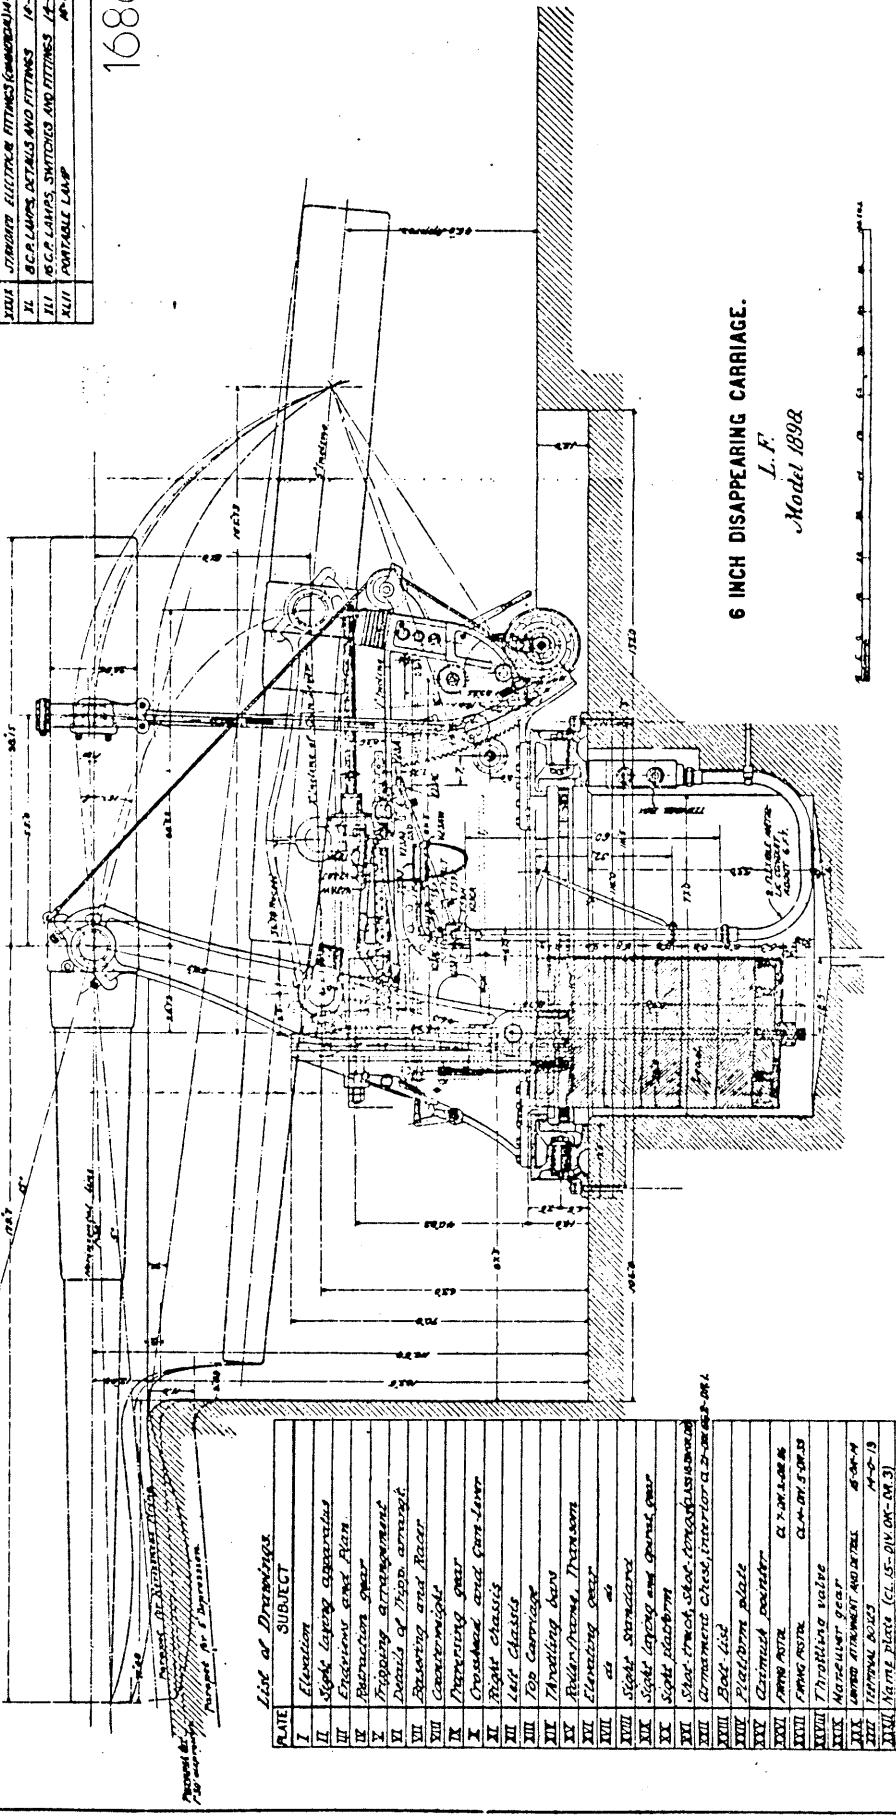






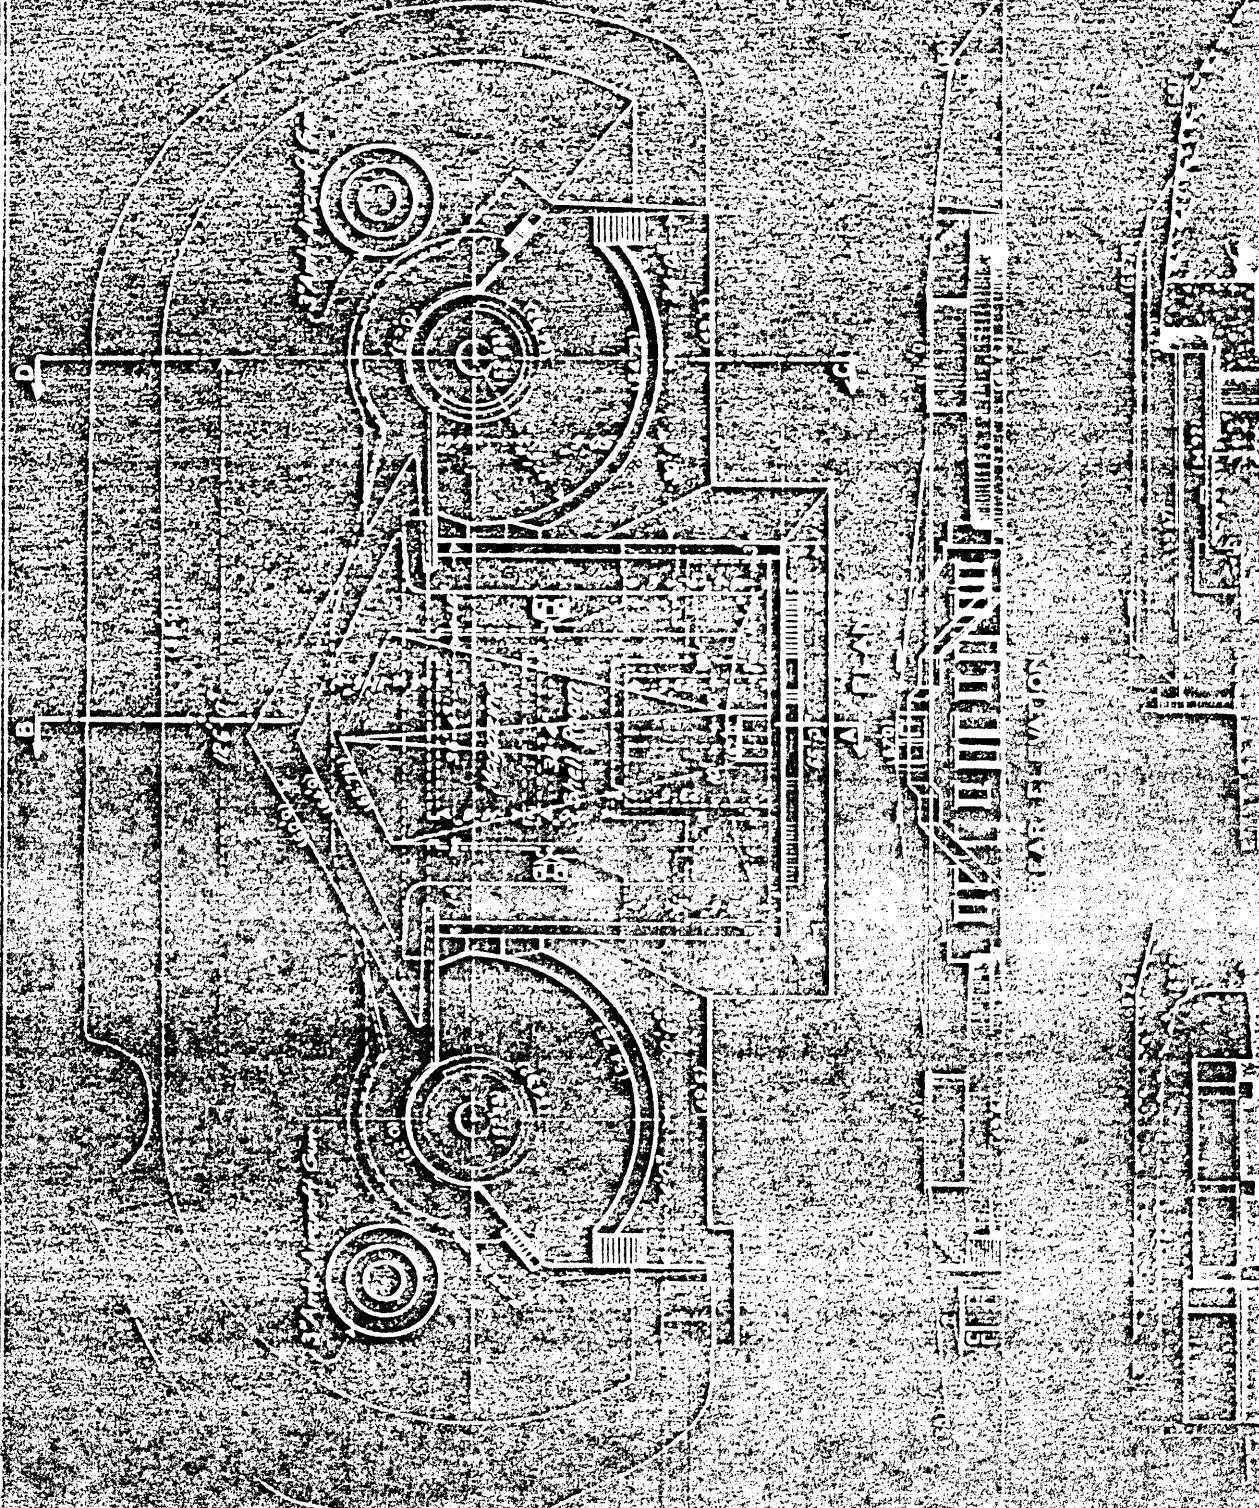

Notes and instructions for Garrison in caring for drainage and water supply system of Battery Hoveycutt, Great Diamond Island, Maine.


(N) Each stage should be measured after start time, and any reading, & EIGHT or longer should be reported as in Engineers' Observations.

U.S. Engineer Office, Portland, Maine.
December 3, 1900.
Submitted to the Chief of Engineers U.S.A.
or of this date
A. L. [Signature]
Major, Corps of Engineers U.S.A.

Major, Corps of Engineers, U.S.A.



Approved: *[Signature]*
Date: *[Signature]*


See class 2




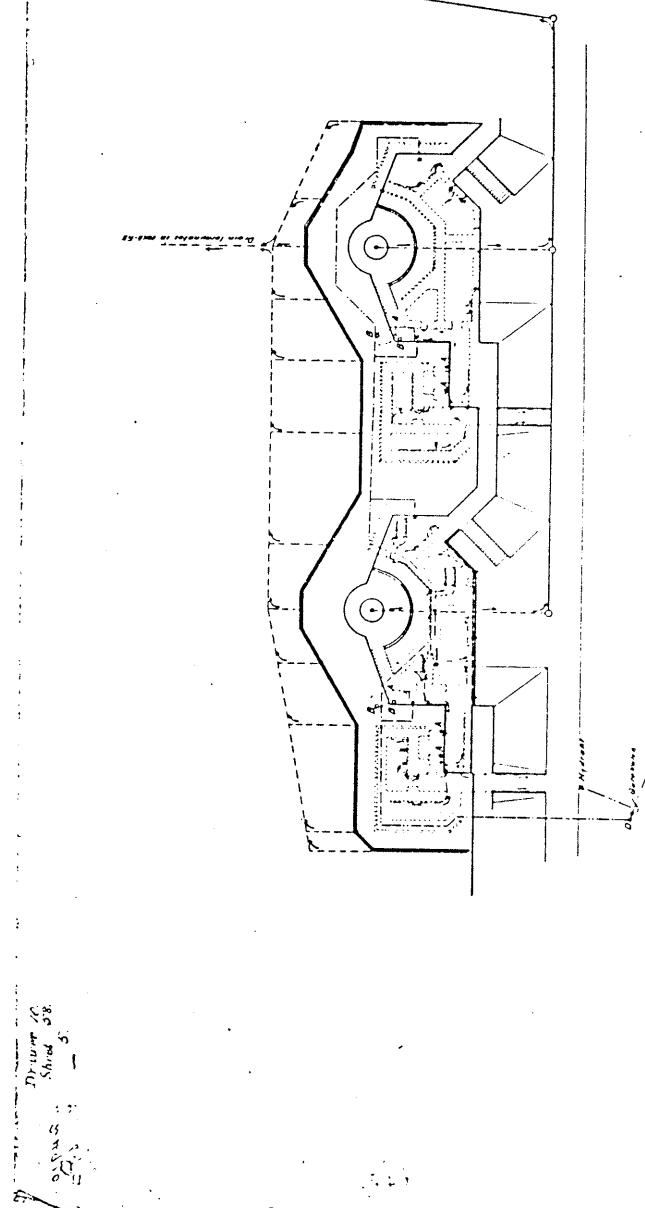

1691

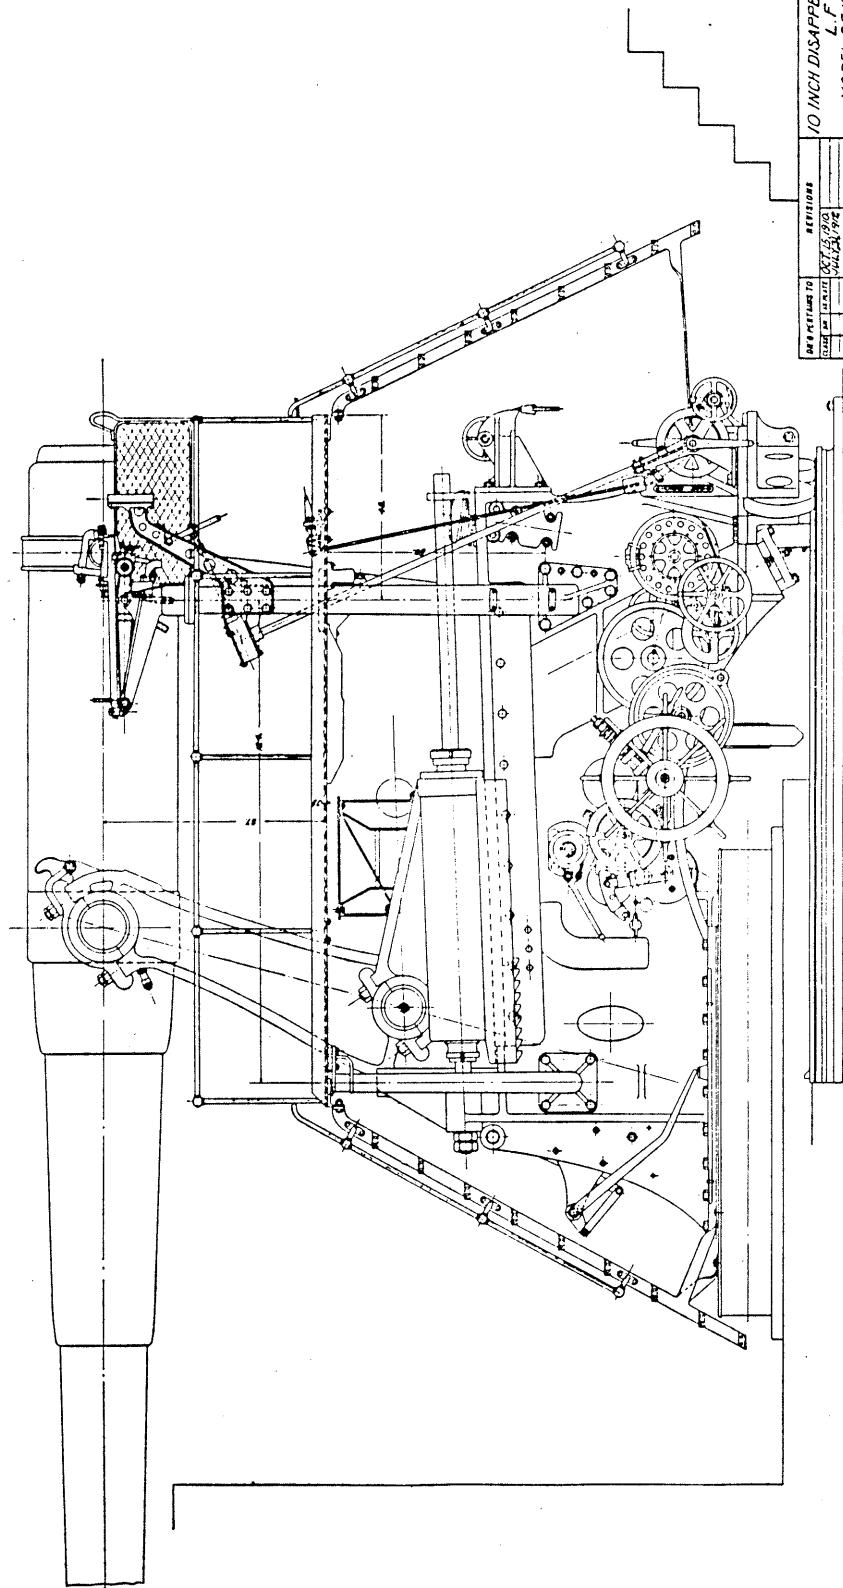

10 INCH DISAPPEARING CARRIAGE	
REVISIONS	L.F.
DATE OF DRAWING	MODEL OF 1894 M1
DATE OF ISSUE	LEFT SIDE ELEVATION
SIGNATURE	WATERTOWN ARSENAL U.S.A. JUNE 25, 1898
INITIALS	I.E. [initials]
REMARKS	10 INCH DISAPPEARING CARRIAGE
CLASS	2
SECTION	1/2
DIVISION	2
FILE	1691

COMPLEX OF SEACOAST FORTIFICATIONS
Batteries Plan

Form 7

Concord, October 1, 1922.

Catalogue No. 1

Copy of

Map








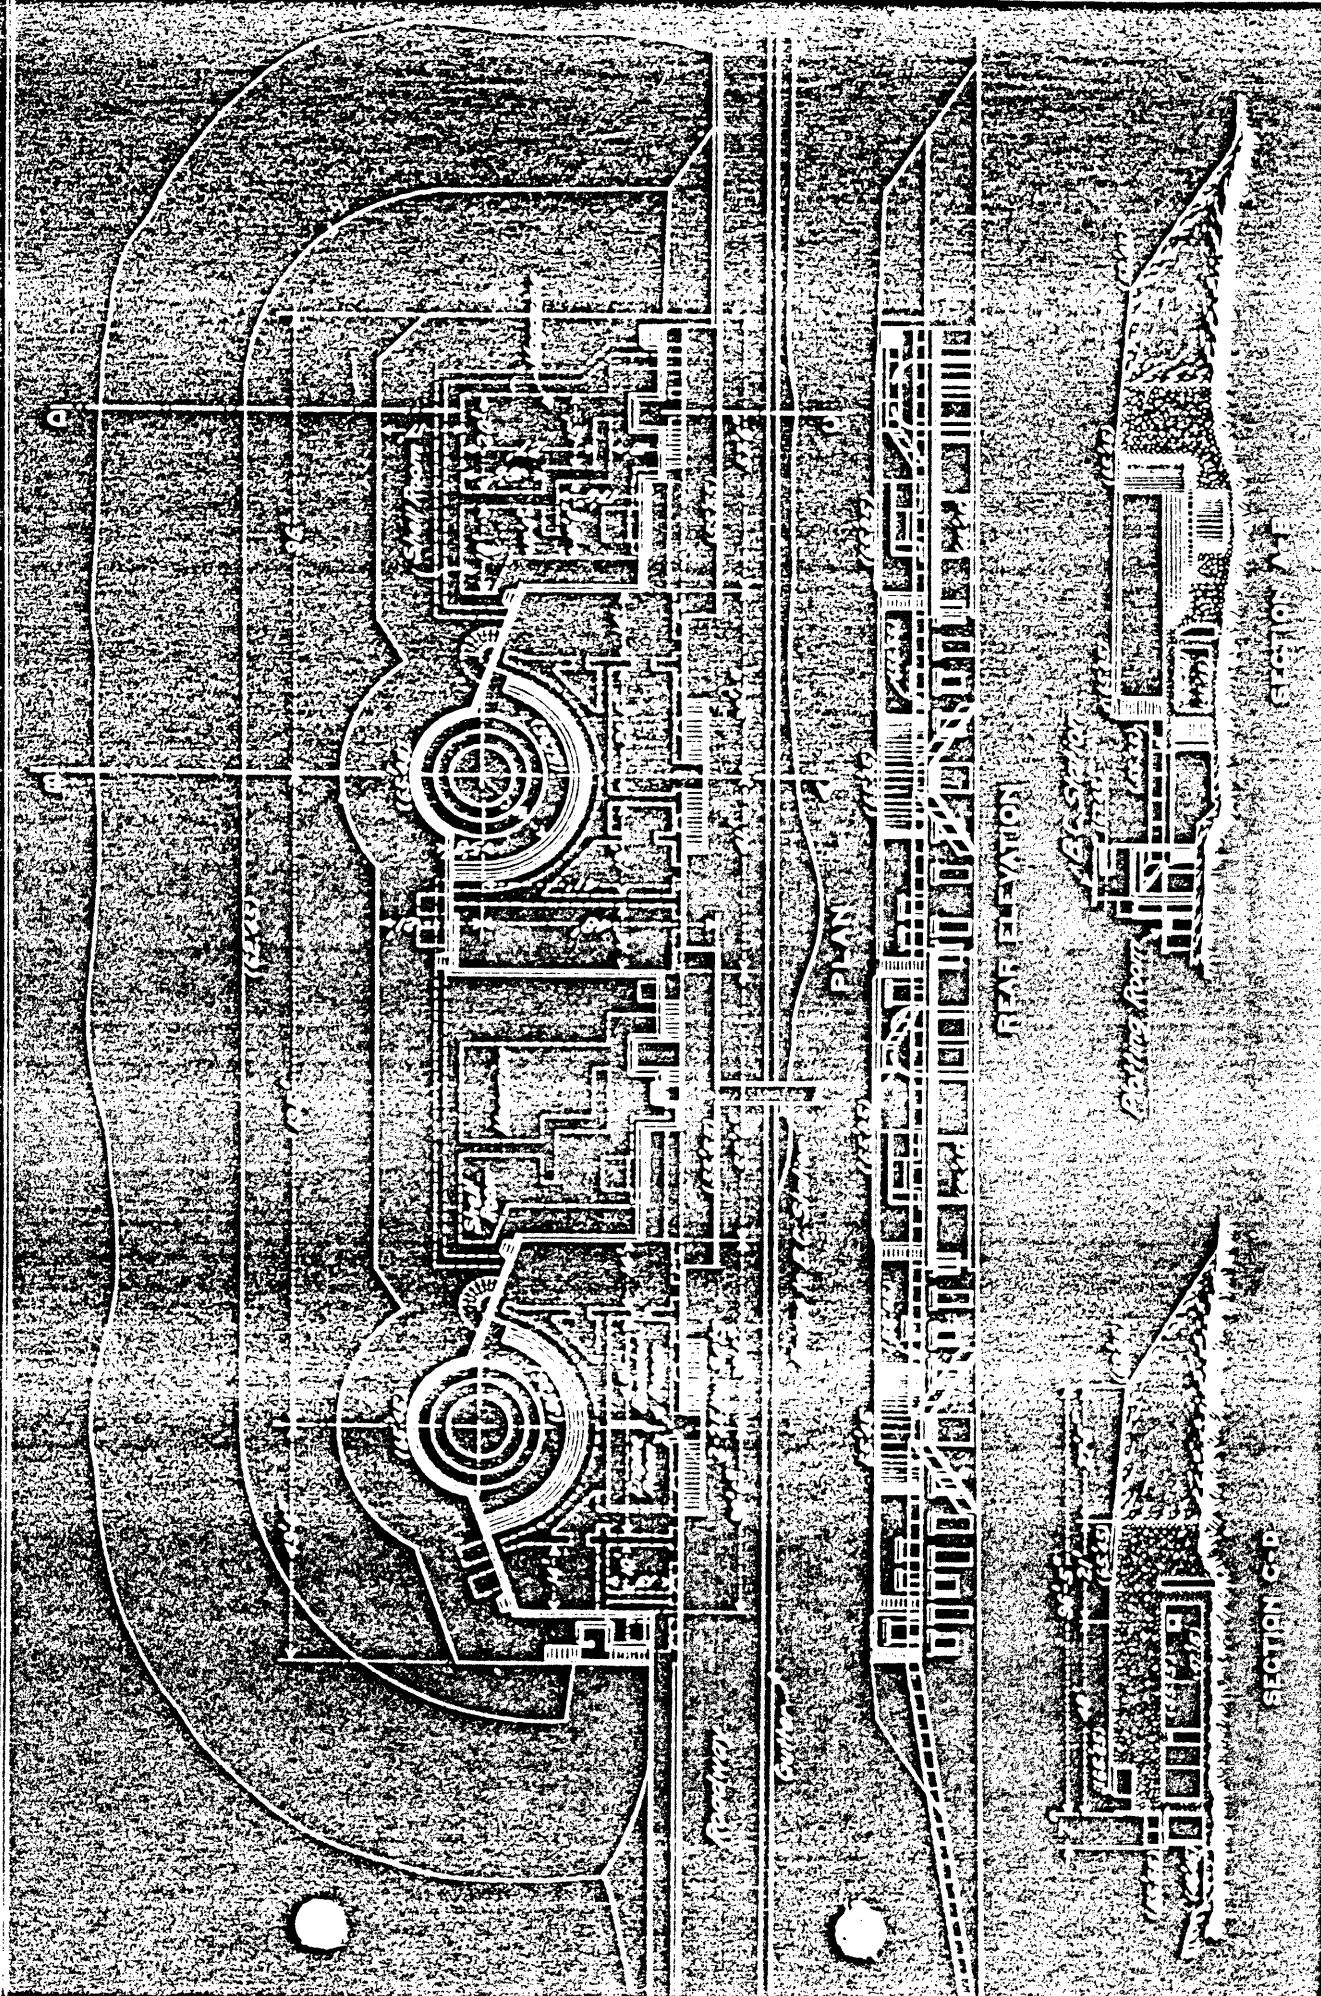

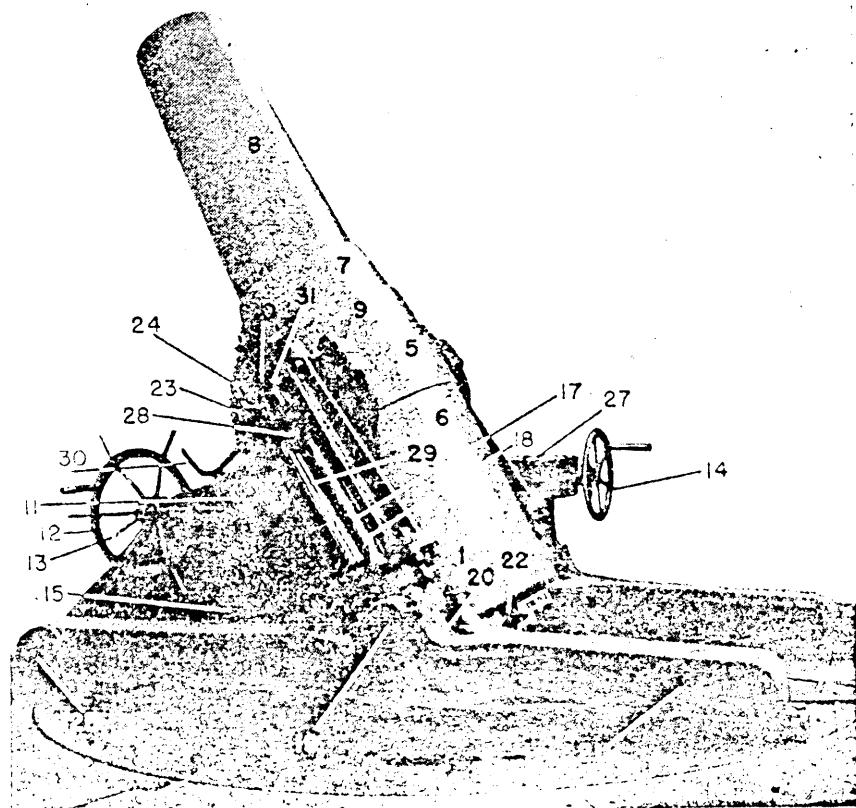

1. Recoil cylinder filling hole and plug.
 2. Racer.
 3. Graduated azimuth scale.
 4. Removable floor plate.
 5. Trunnion band or hoop.
 6. "V" row.
 7. "D" row.
 8. "C" row.
 9. Trunnion cap square.
 10. Buffer plates and cushions.
 11. Top carriage or saddle.
 12. Elevating handwheel.
 13. Elevating friction clamp.
 14. Traversing crank.
 15. Spring columns.
 16. Floor plates.
 17. Piston rod.
 18. Studing box.
 19. Recoil cylinder trunnion.
 20. Recoil cylinder.
 21. Side rails.
 22. Breech mechanism.
 23. Elevation quadrant.
 24. Elevating rack.
 25. Saddle trunnion.
 26. Shot truck track.
 27. Traversing gear box.
 28. Cross head.
 29. Cross head guide.
 30. Zero elevation locking device lever.
 31. Trunnion grease cup.

FIGURE 13.—12-inch mortar, M1890ML, mounted on carriage M1896ML.

REPORT OF COMPLETED WORKS - SEA COAST FORTIFICATIONS
(Battery Plan)

COAST DEFENSES OF PORTLAND, MAINE

FORT PREBLE
BATTERY CHASE

No. of guns 4

Drop 0


Caliber 12

Carriage, Mort.

12

Corrected to Mar 1, 1920

Form 7

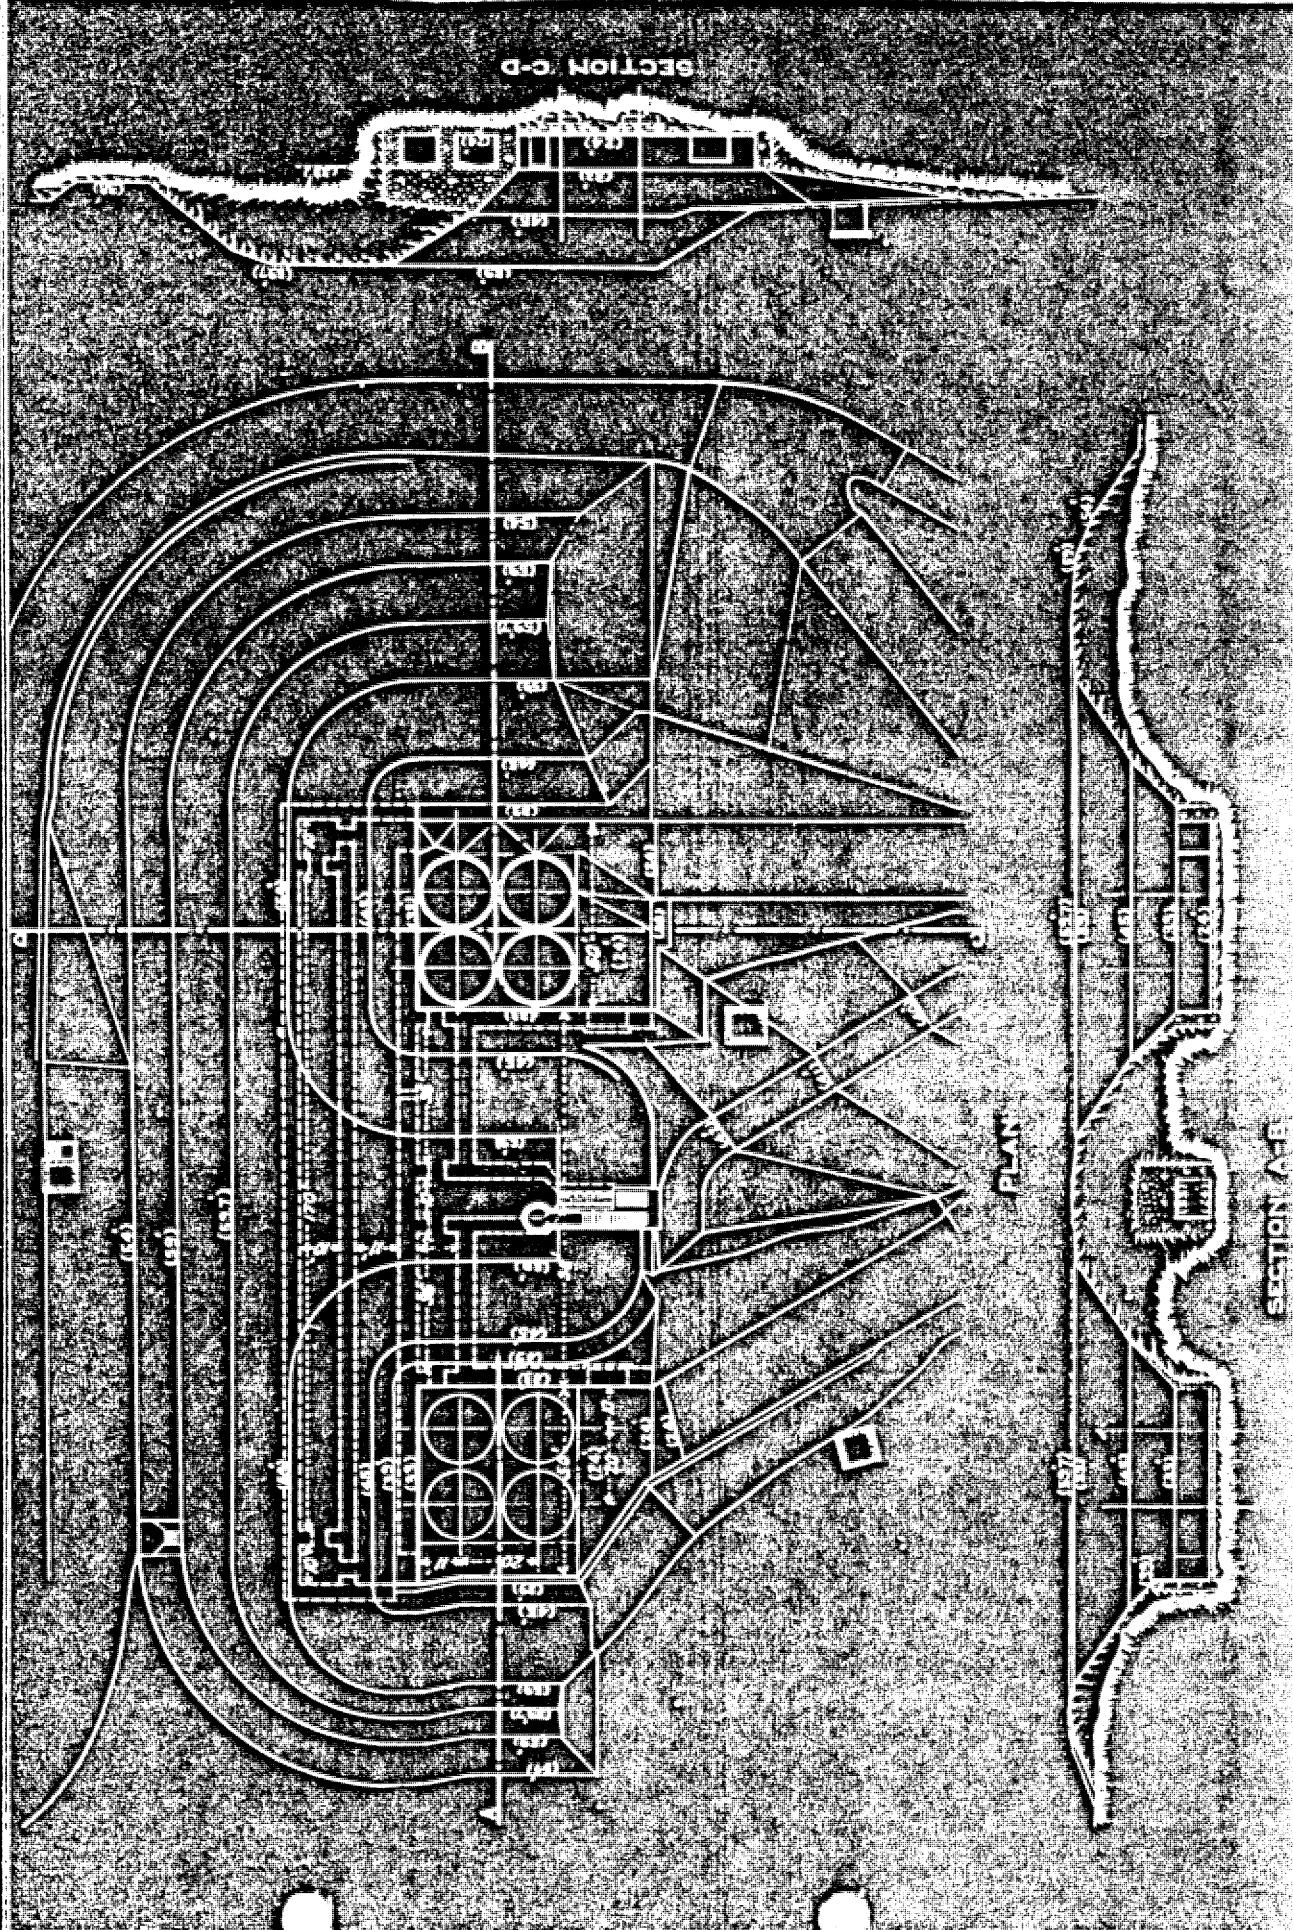

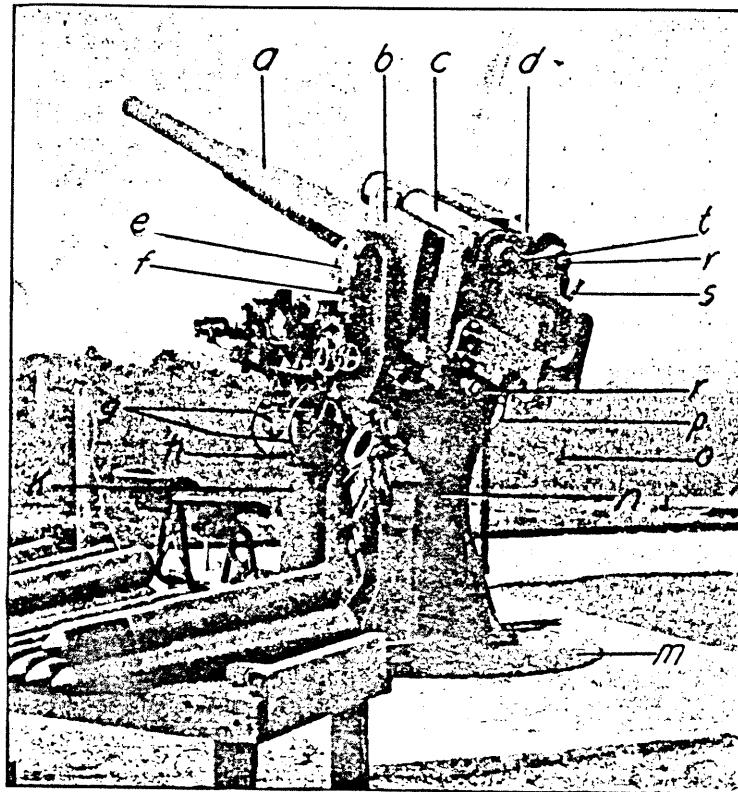


FIGURE 155.—3-inch AA mount, M1917MII (left side) (with M1917MII gun and experimental pointing equipment).


- | | |
|----------------------------|------------------------------|
| a. Gun. | k. Traversing shaft. |
| b. Cradle. | m. Racer. |
| c. Counterrecoil cylinder. | n. Pivot yoke. |
| d. Recoil cylinder. | o. Lanyard. |
| e. Antifriction device. | p. Elevating handwheel. |
| f. Belleville springs. | r. Recoil piston rod. |
| g. Traversing handwheels. | s. Operating handle. |
| h. Traversing gear case. | t. Counterrecoil piston rod. |

REPORT OF COMPLETED WORKS SECOAST FORTIFICATIONS

COAST DEFENSES OF SANDY HOOK




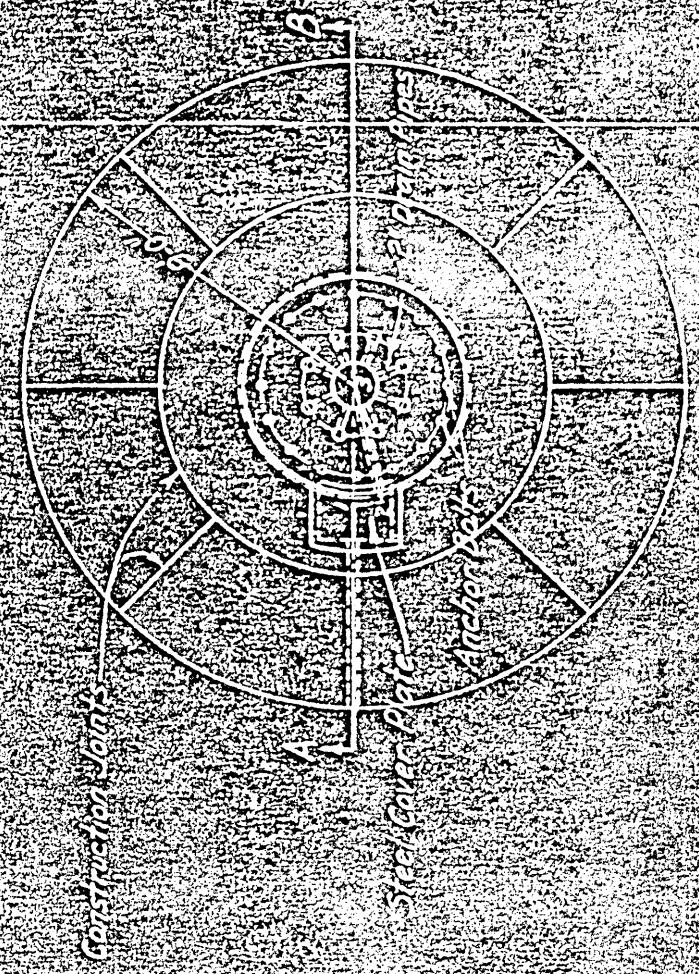

Note: Distance from Gun No 1
to Gun No 2 1/26+


96 98 5454
2702 WCGY

1722

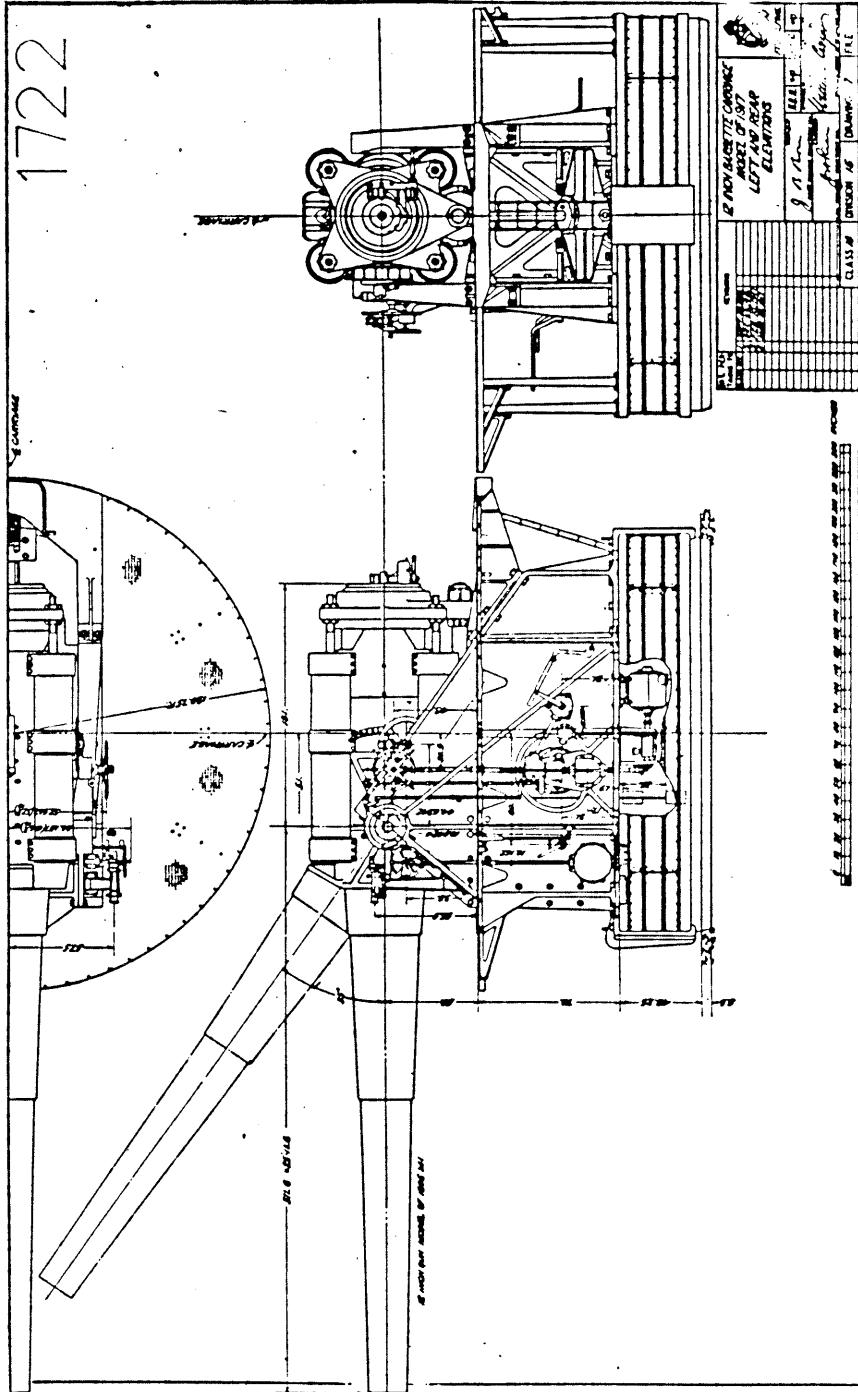


FORT LEV
BATTERY

Sheet No. 1
U.S. Engineer Office, Port.
Submitted:

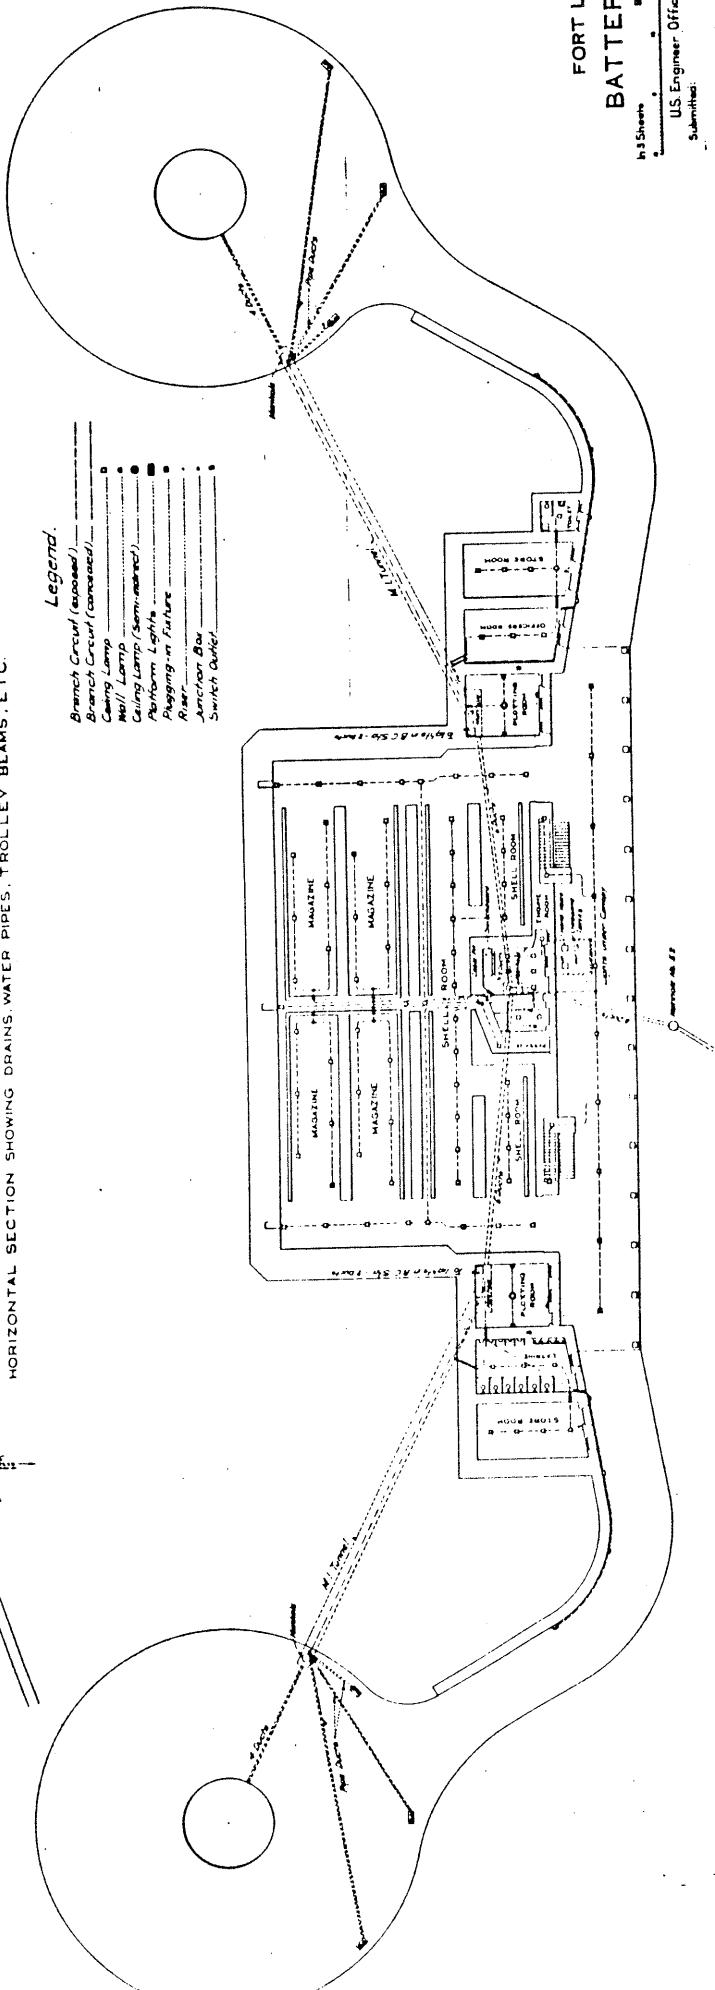

HORIZONTAL SECTION SHOWING DRAINS, WATER PIPES, TROLLEY BEAMS, ETC.

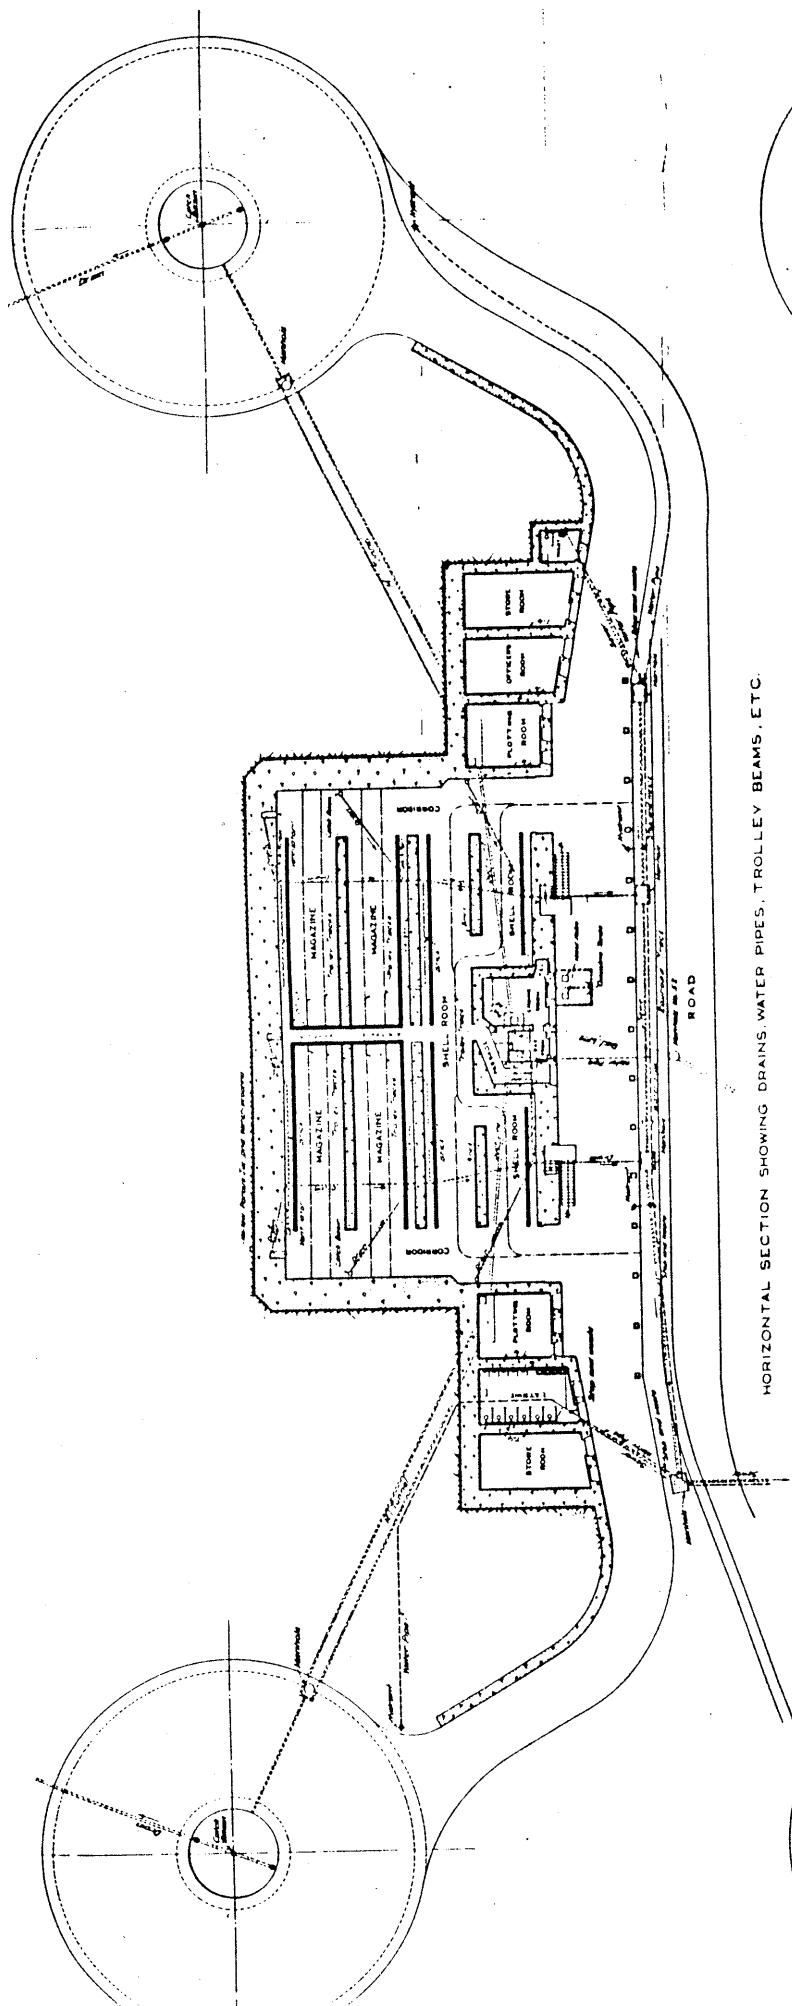

REPORT OF COMPLETED WORKS - SEACOAST FORTIFICATIONS
(Individual Battery)


Part VII.

Corrected to 1 November 1943.


~~SECRET~~

Sheet 2 of 2 Sls.


HARBOR DEFENSES OF Boston, Mass.
FORT DAWES
STRUCTURE Re-location of Battery
Taylor Location No. 127.

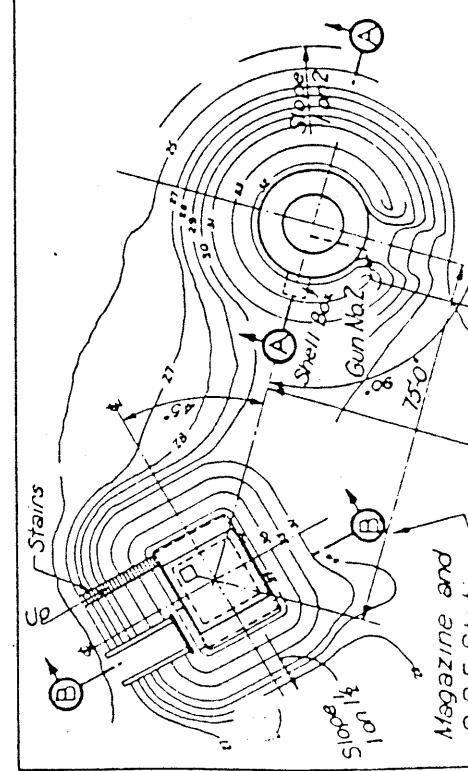

GENERAL PLAN

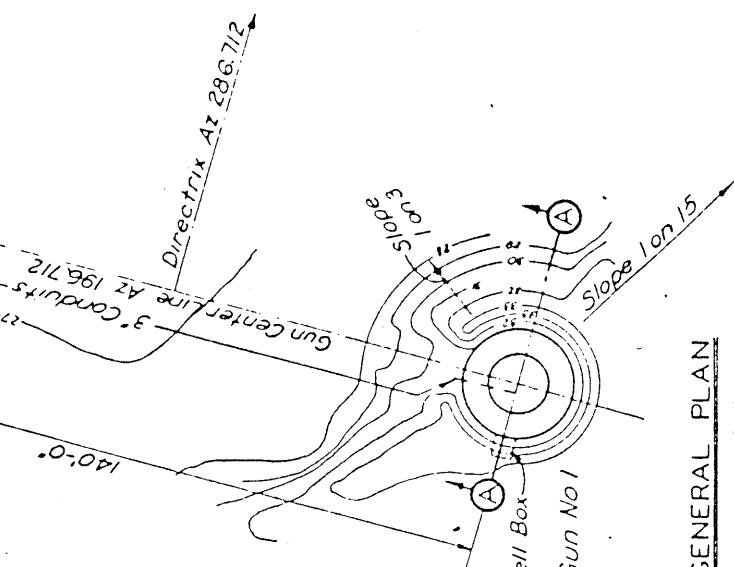


GENERAL PLAN

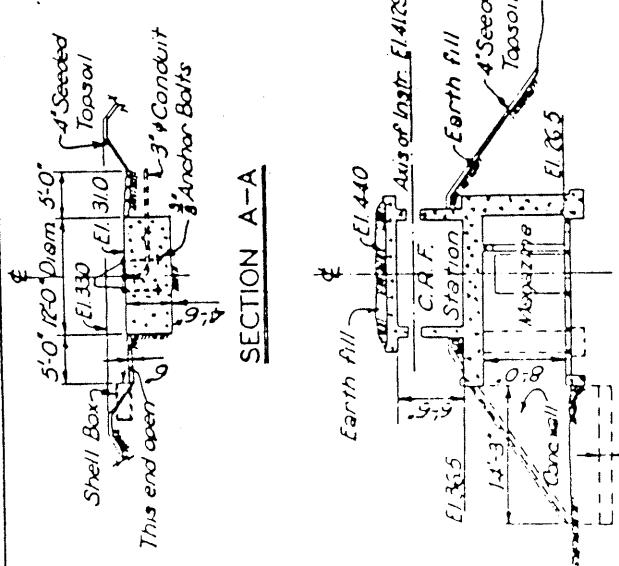


SECTION A-A




SECTION B-B

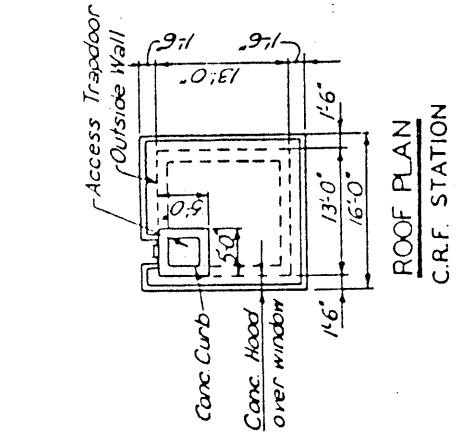

ROOF PLAN
C.R.F. STATION

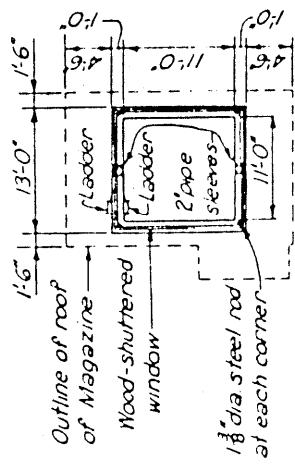

FLOOR PLAN
C.R.F. STATION

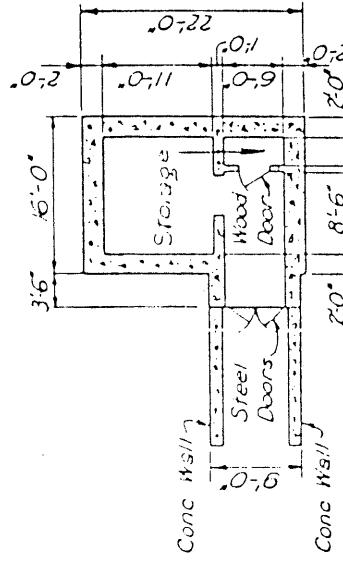

FLOOR PLAN - MAGAZINE

SCALE OF FEET
10 0 10 20

SCALE OF FEET
20 0 20 40


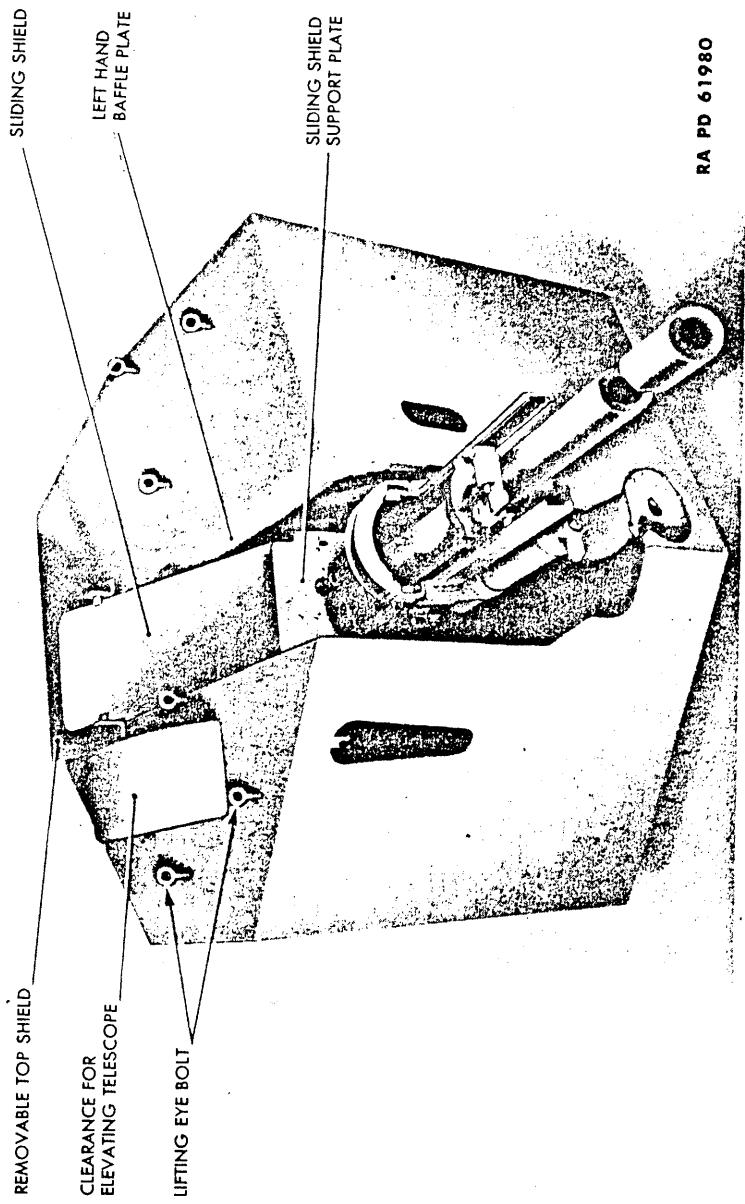


Figure 110. Shield for all-around protection (90-mm gun).

ENT WAR DE


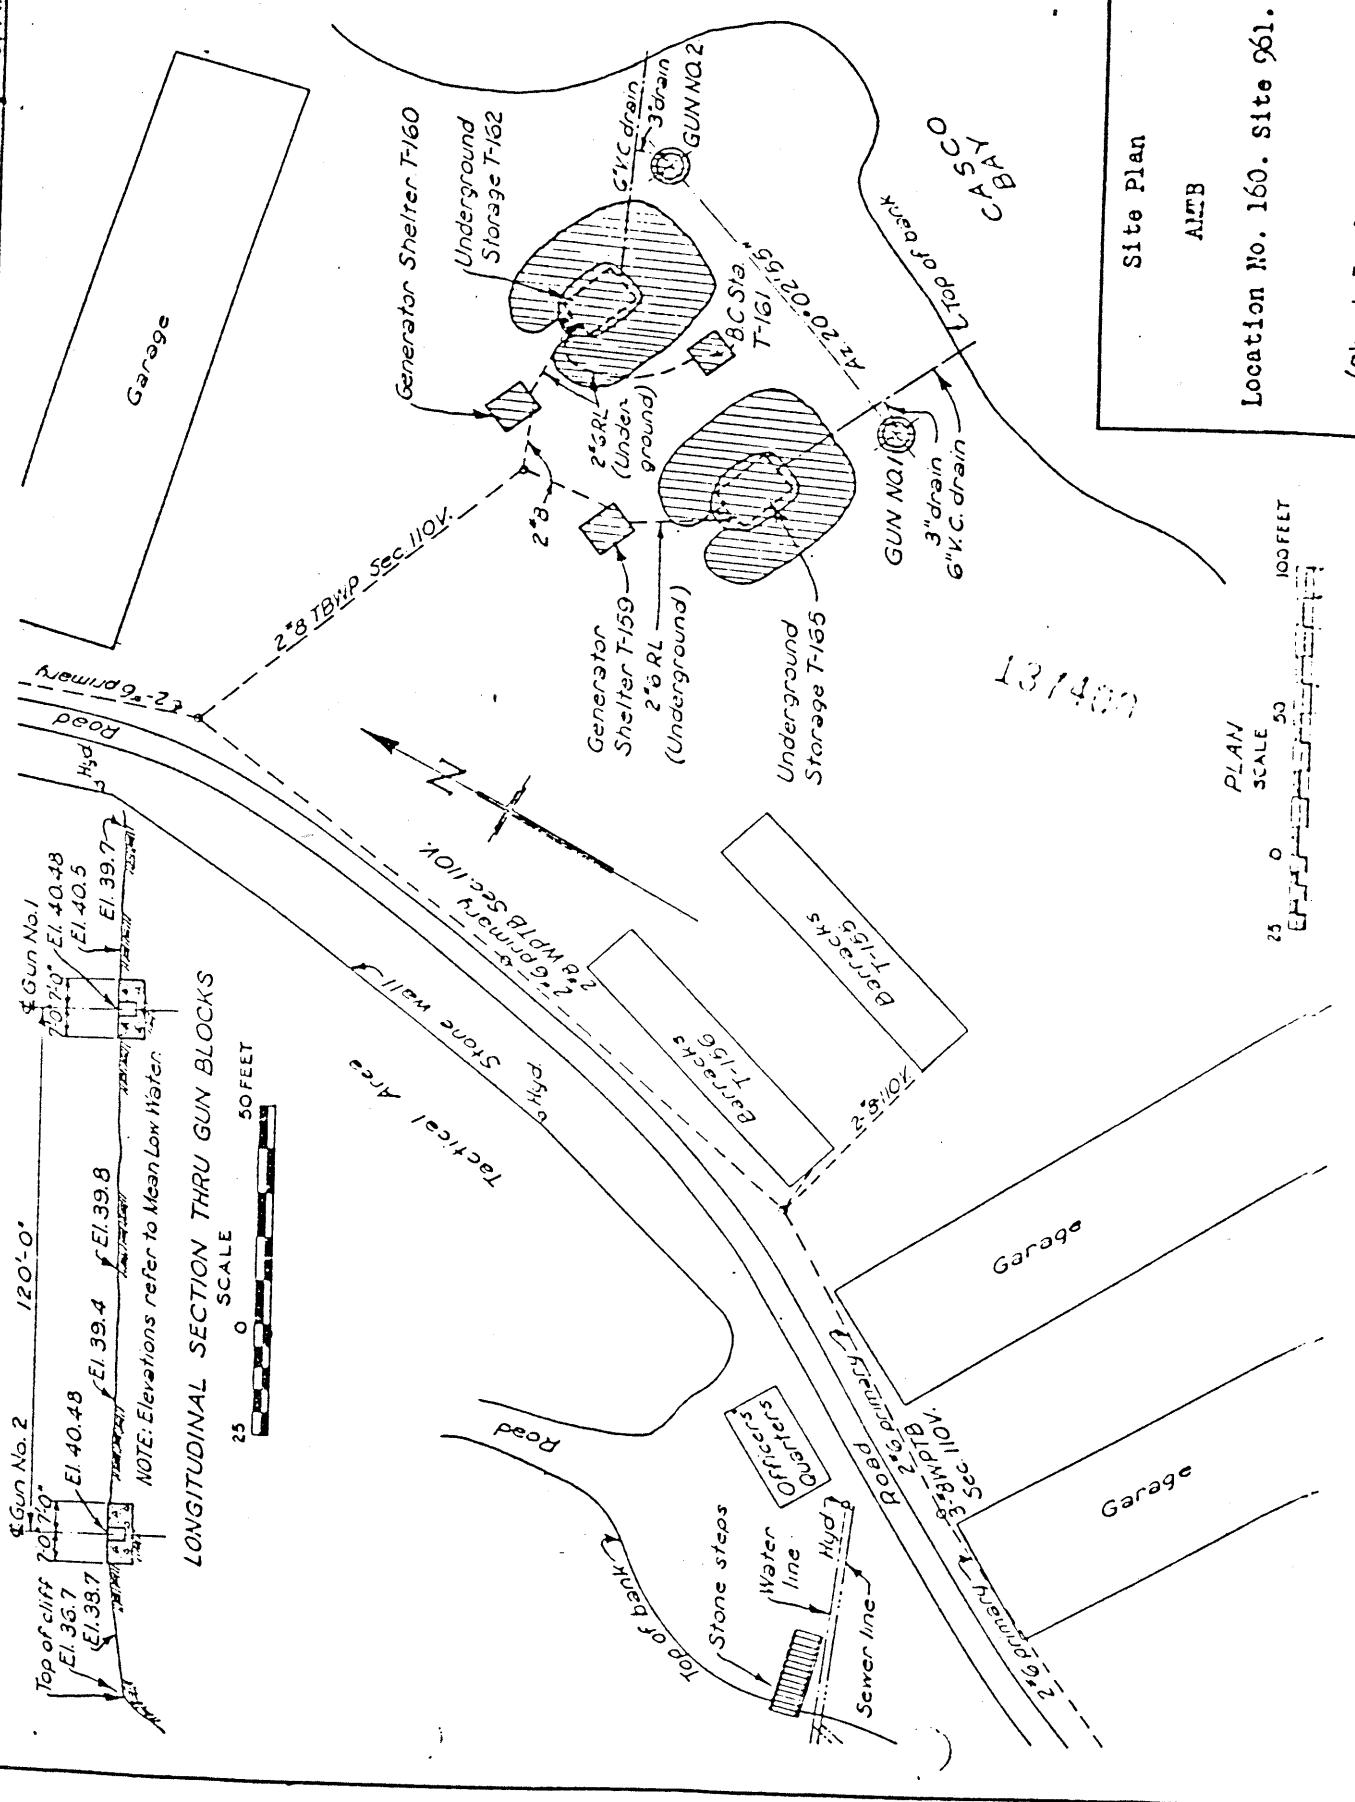



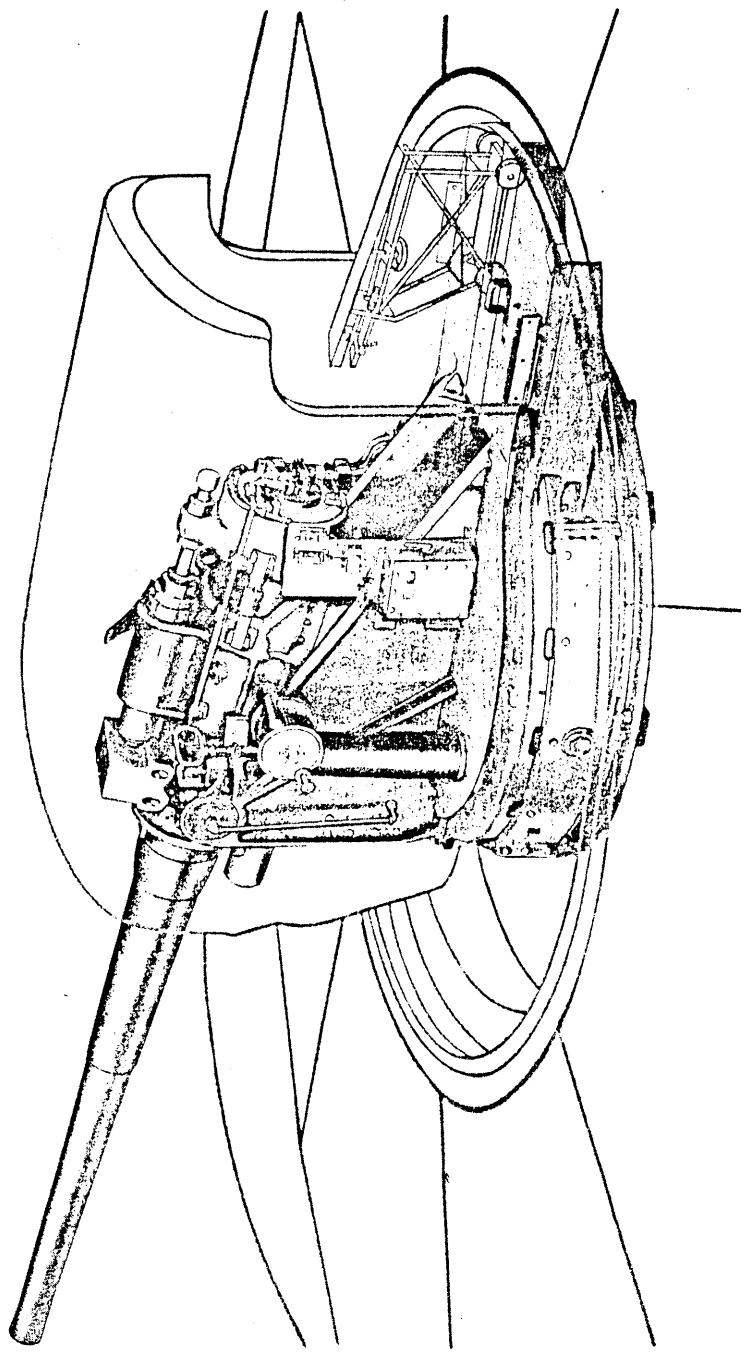



Figure 53. 6-inch gun mounted on barbette carriages M1 and M2 (shield in phantom) RA PD 110778

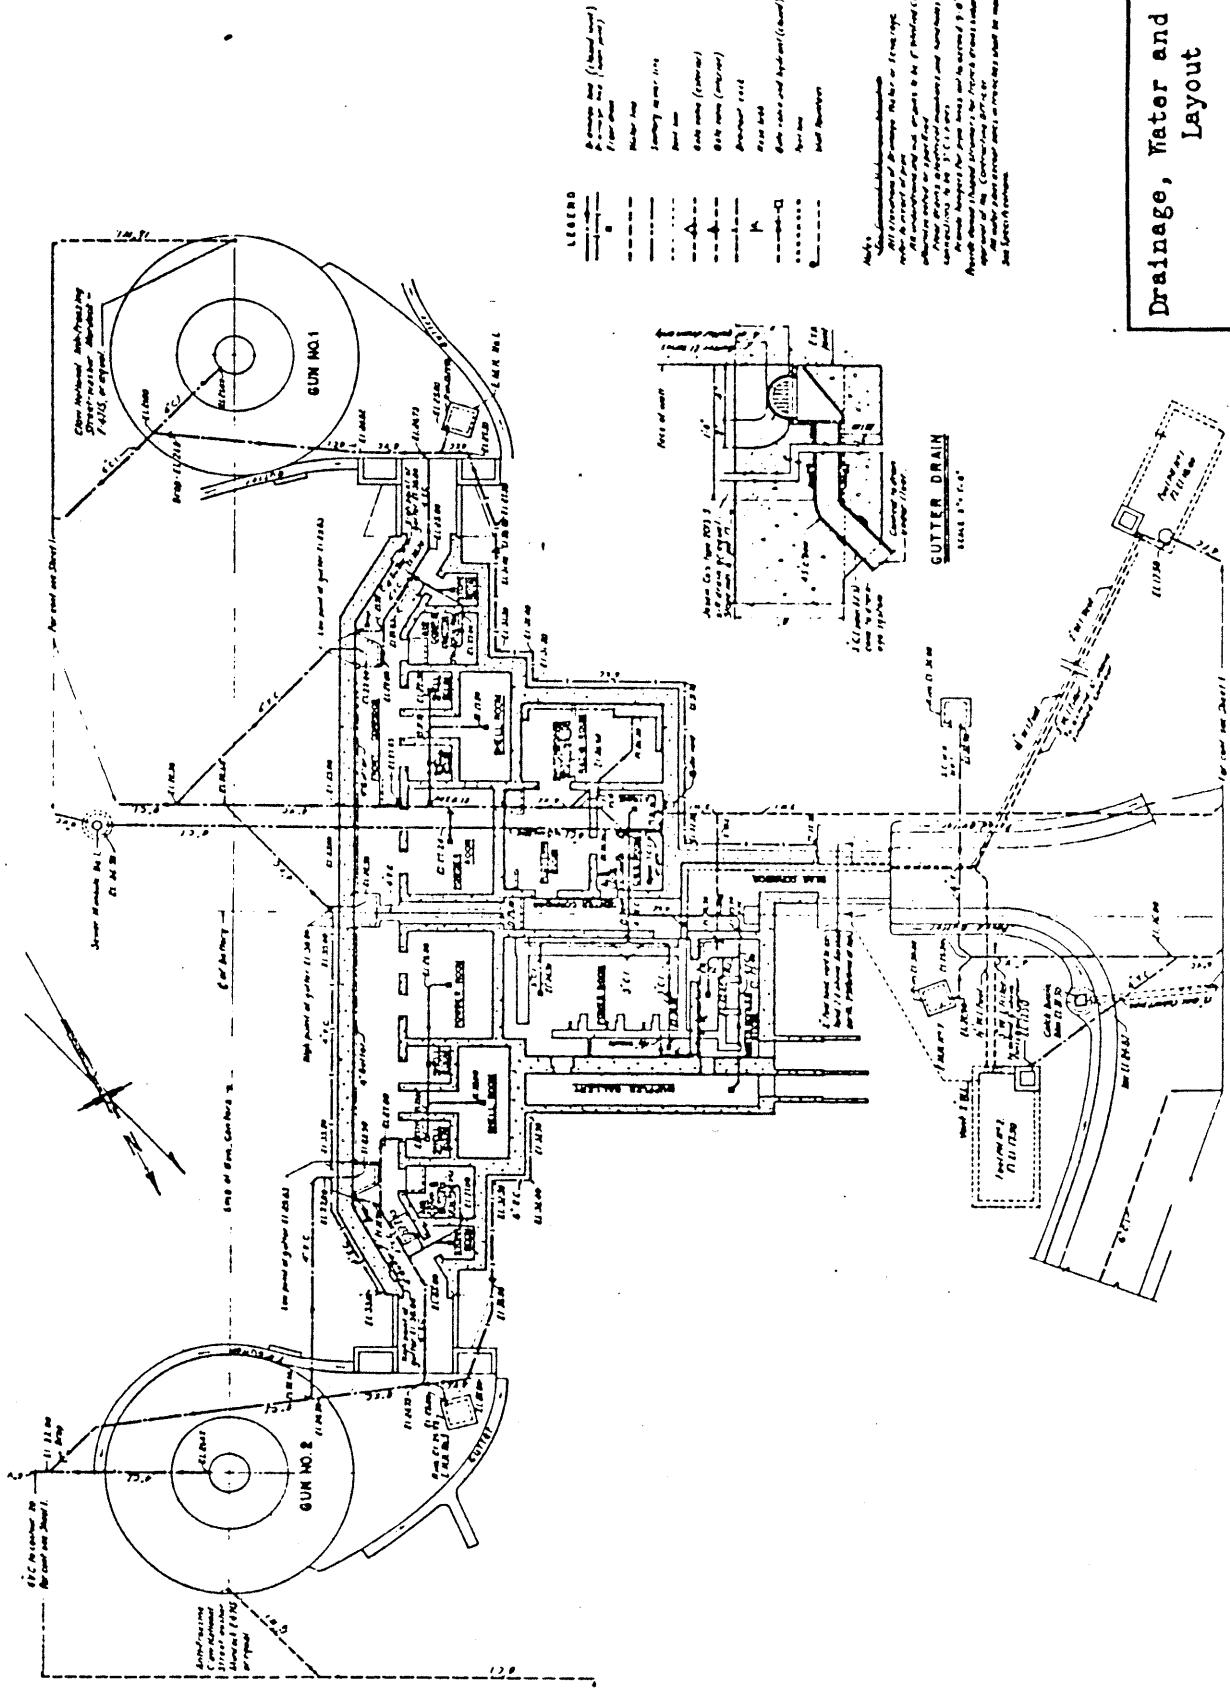

Drainage, Water and Sewerage
Layout

Battery 205
Location No. 148. Site 1A.
Fort Foster



(Sheet 7 of 9 Sheets)

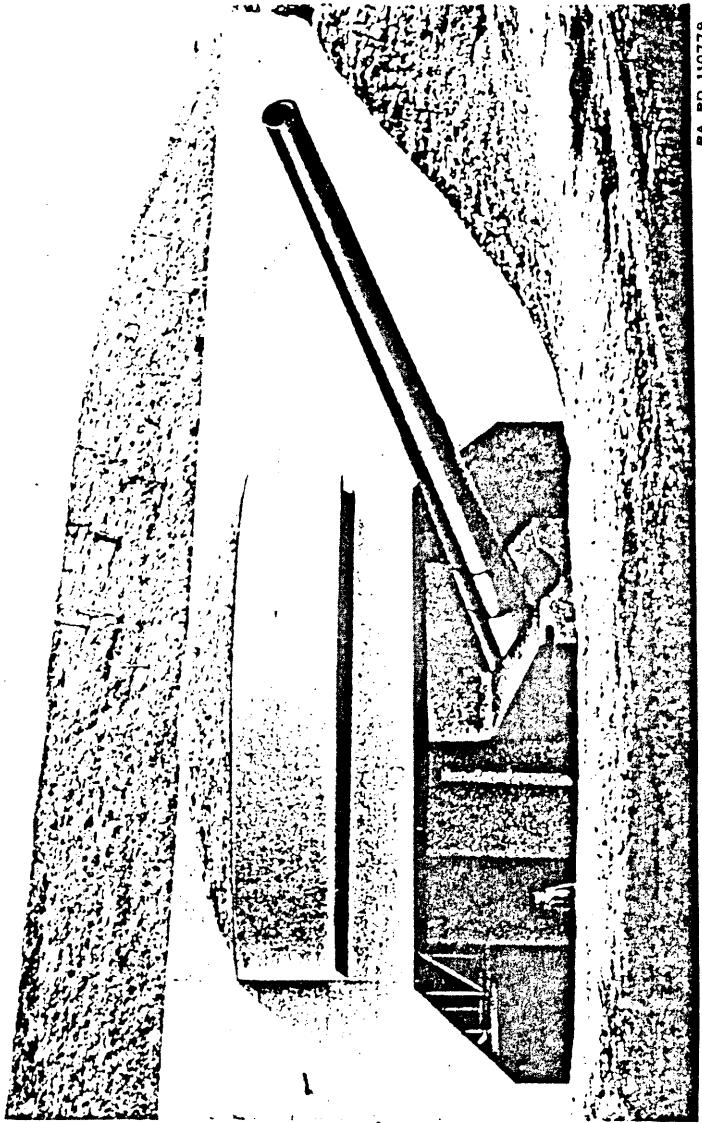

RA PD 110779

Figure 54. 16-inch barbette carriage in casemate.

THE SHIELD SHOWN IS
THE FORGED STEEL
SHIELD FOR THE 16-IN.
BARBETTE CARRIAGE
M1919 M3. THE SHIELD
FOR THE M4 MOUNT
IS CAST AND HAS
THE CORNERS AND
SURFACES ROUNDED.

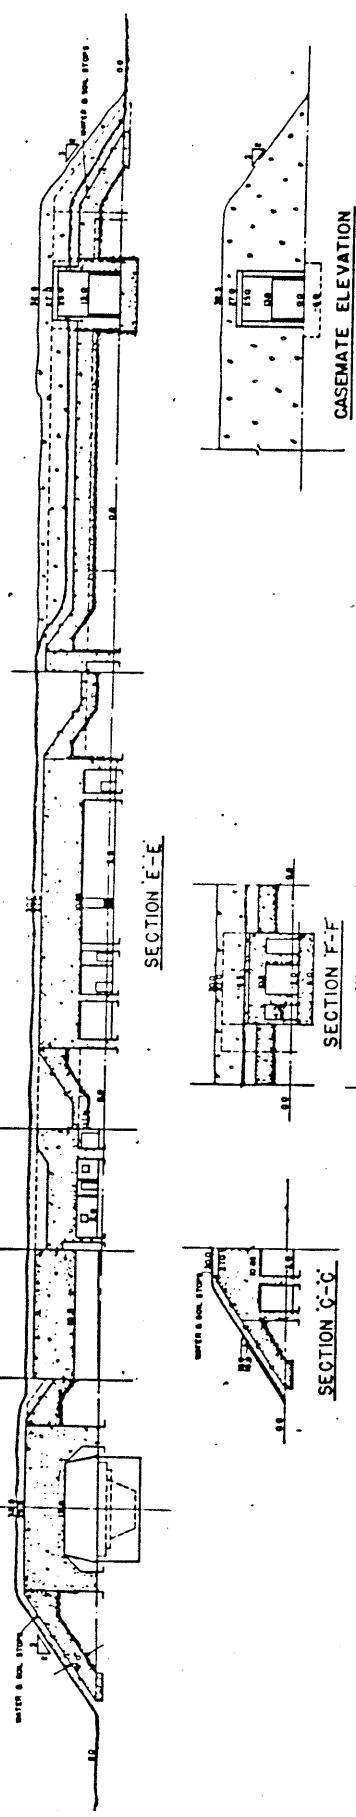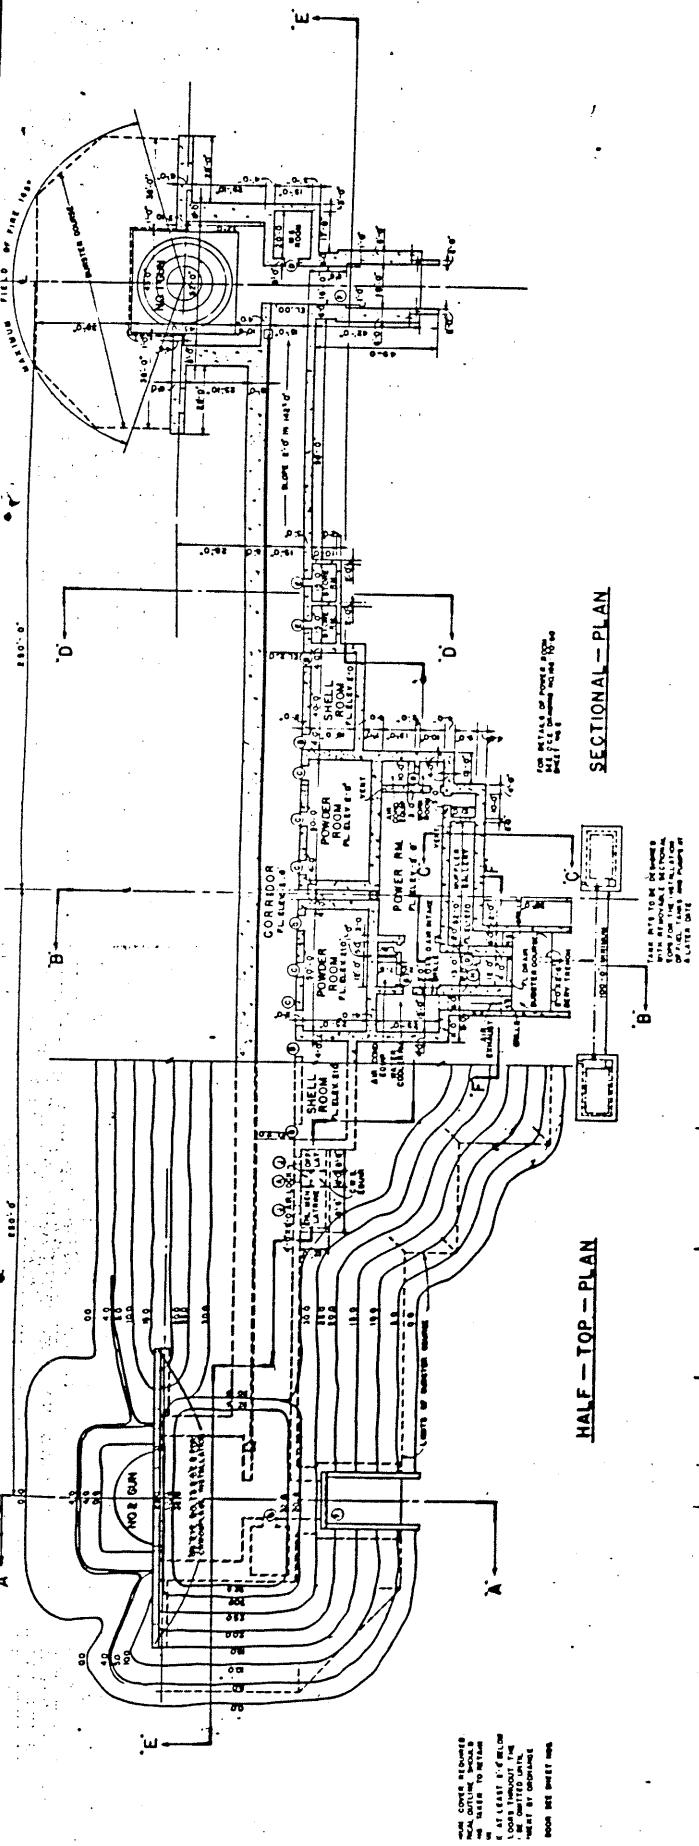

CONFIDENTIAL

16" CASEMATED BATTERY STRUCTURAL FEATURES GENERAL PLAN AND SECTIONS

CONSTRUCTION DIVISION
OFFICE, CHIEF OF ENGINEERS
ENGINEERING BRANCH



SECTION D-D


SECTION A-A

Annex 3--PLANS OF REPRESENTATIVE STRUCTURES


Endicott, Taft and the Inter-War Periods, 1891-1938

Battery Berry, Observing Room, Fort McKinley, 1908
Battery Honeycutt, Observing Room, Fort McKinley, 1909
Battery Thompson, Observing Room, Fort McKinley, 1908
Battle Commander's Station, Fort McKinley, 1908
Cable Tank, Fort Williams, 1908
Combined Primary and Secondary Station, Fort Williams, 1907
Combined Range Finding Station, Peaks Island, 1909
Combined Stations, Fort McKinley, 1909
District Signal Station, Fort Levett, 1909
Double Mine Station, Fort Williams, 1908
Double Mine Station, Fort Williams, 1908
Electric Plant, Fort McKinley, 1905
Fire Commander Station, Fort McKinley, 1902
Fire Control Station, Jewell's Island, 1934
Mining Casemate, North Fork, Fort McKinley, 1909
Mining Casemate, North Fork, Fort McKinley, 1920
Observing Station, Fort Preble, 1905
Protected Mining Casemate, Fort Williams, 1918
Range Finder Station, Battery Farry, Fort McKinley, 1919
Searchlight Installation, Long Island, 1917
Searchlight Observing Station, Fort Lyon, 1910
Searchlight Power House, 1911
Switchboard Building, Fort Preble, 1920
Switchboard Building, All-Around Protection, Fort Levett, 1918
Switchboard Building, South Fork, Fort McKinley, 1908
Temporary Searchlight Tower-Timber, Fort Williams, 1906
Torpedo Shed, Fort Gorges, 1897
Torpedo Storehouse, Fort Williams, 1908
Torpedo Loading Room, Fort Williams, 1907
Wharf and Tramway, Fort McKinley, 1910


World War II, 1939-1945

B.C. Station, AMTB Battery, Fort Williams, 1943
Mine Casemate, Type Plan for 10 Mine Groups, n.d.
Operations Building, SCR-296A, n.d.
Observation Station, Bailey Island, 1944
Observation Tower, Cape Neddick, 1943
Observation Tower, Fort Foster, 1943
Plotting Room (side view), n.d.
Plotting Room (top view), n.d.
Underground Storage and Generator Building, AMTB, Fort Williams, 1943

Drafter 19
Sheet 42

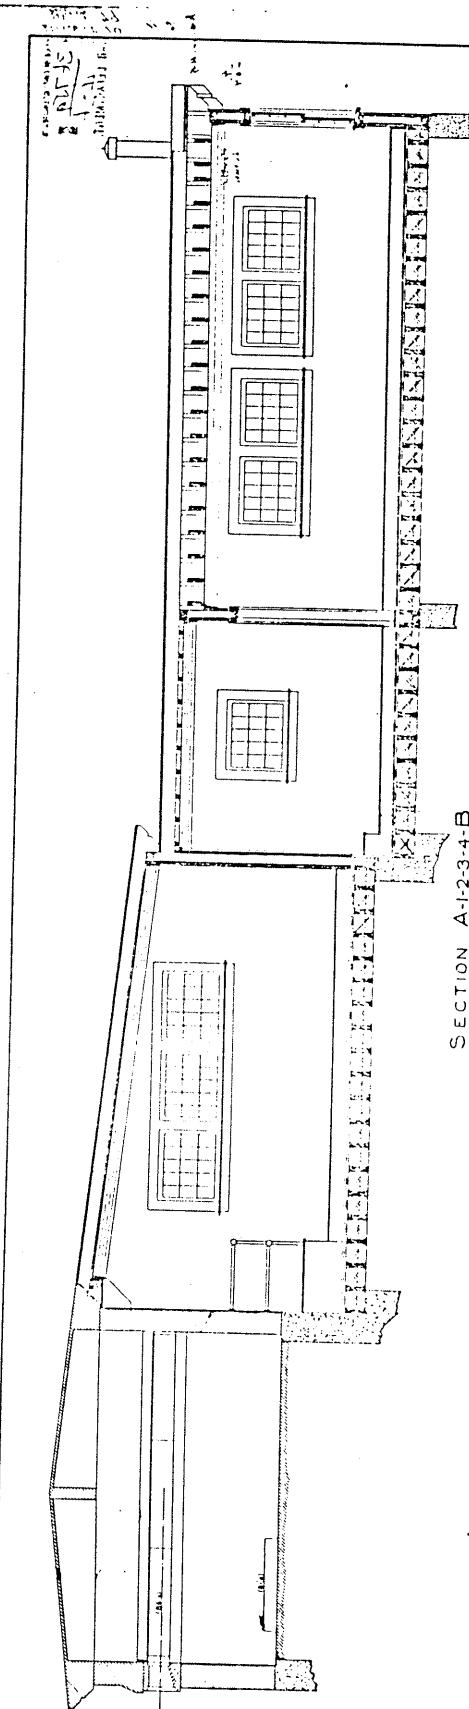

SECTION A-1-2-3-4-B

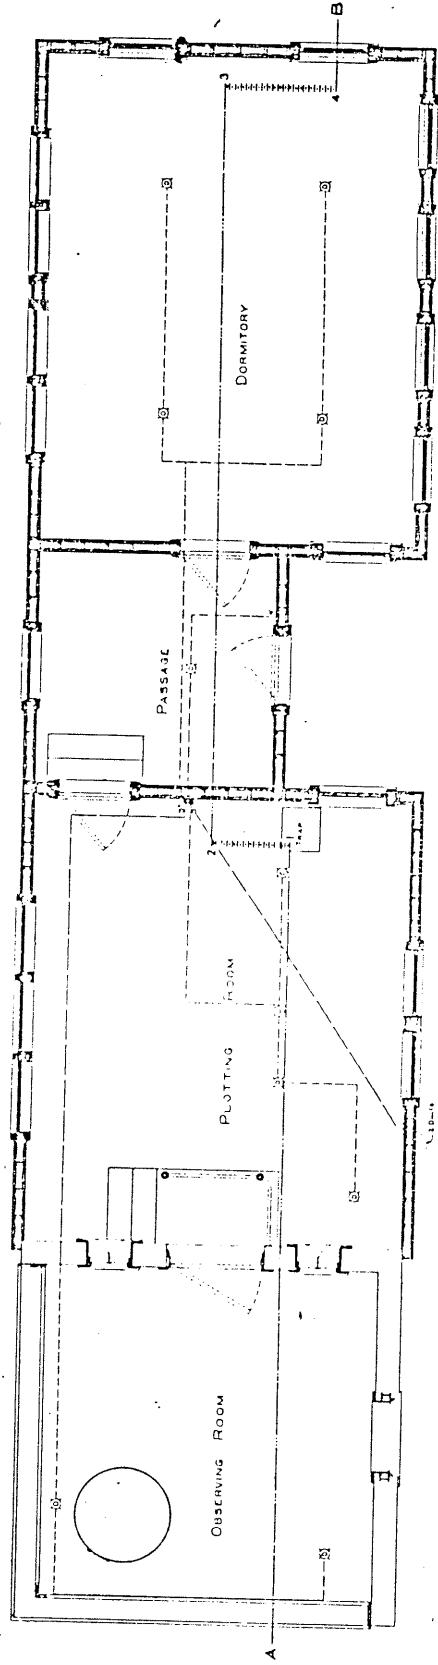

PLAN

FORT MCKINLEY
PORTLAND HARBOR, MAINE.

(B) BATTERY BERRY

Scale 1:1

NOTE
No holes should be made in walls or rails, or nails driven into woodwork.
Necessary cutting and sawing will be performed by the Engineer Department.
Type of Construction - Wooden frame and cement plaster, in addition to our current observing station.

Office of the Engineers,

U. S. Army,

May 15, 1908.

Respectfully submitted to the
Secretary of War with recommendation
for approval.

W. C. L. C. - J. G. W.
W. C. L. C. - J. G. W.
Major Gen. Chief of Engineers.


U. S. Army.

U. S. Engineer Office,
Portland, Maine, April 29, 1908.
Transmitted to the Chief of Engineers, War Department,
with letter of this date.

10-779
J. G. W.

Major Corps of Engineers, U.S. Army.




79

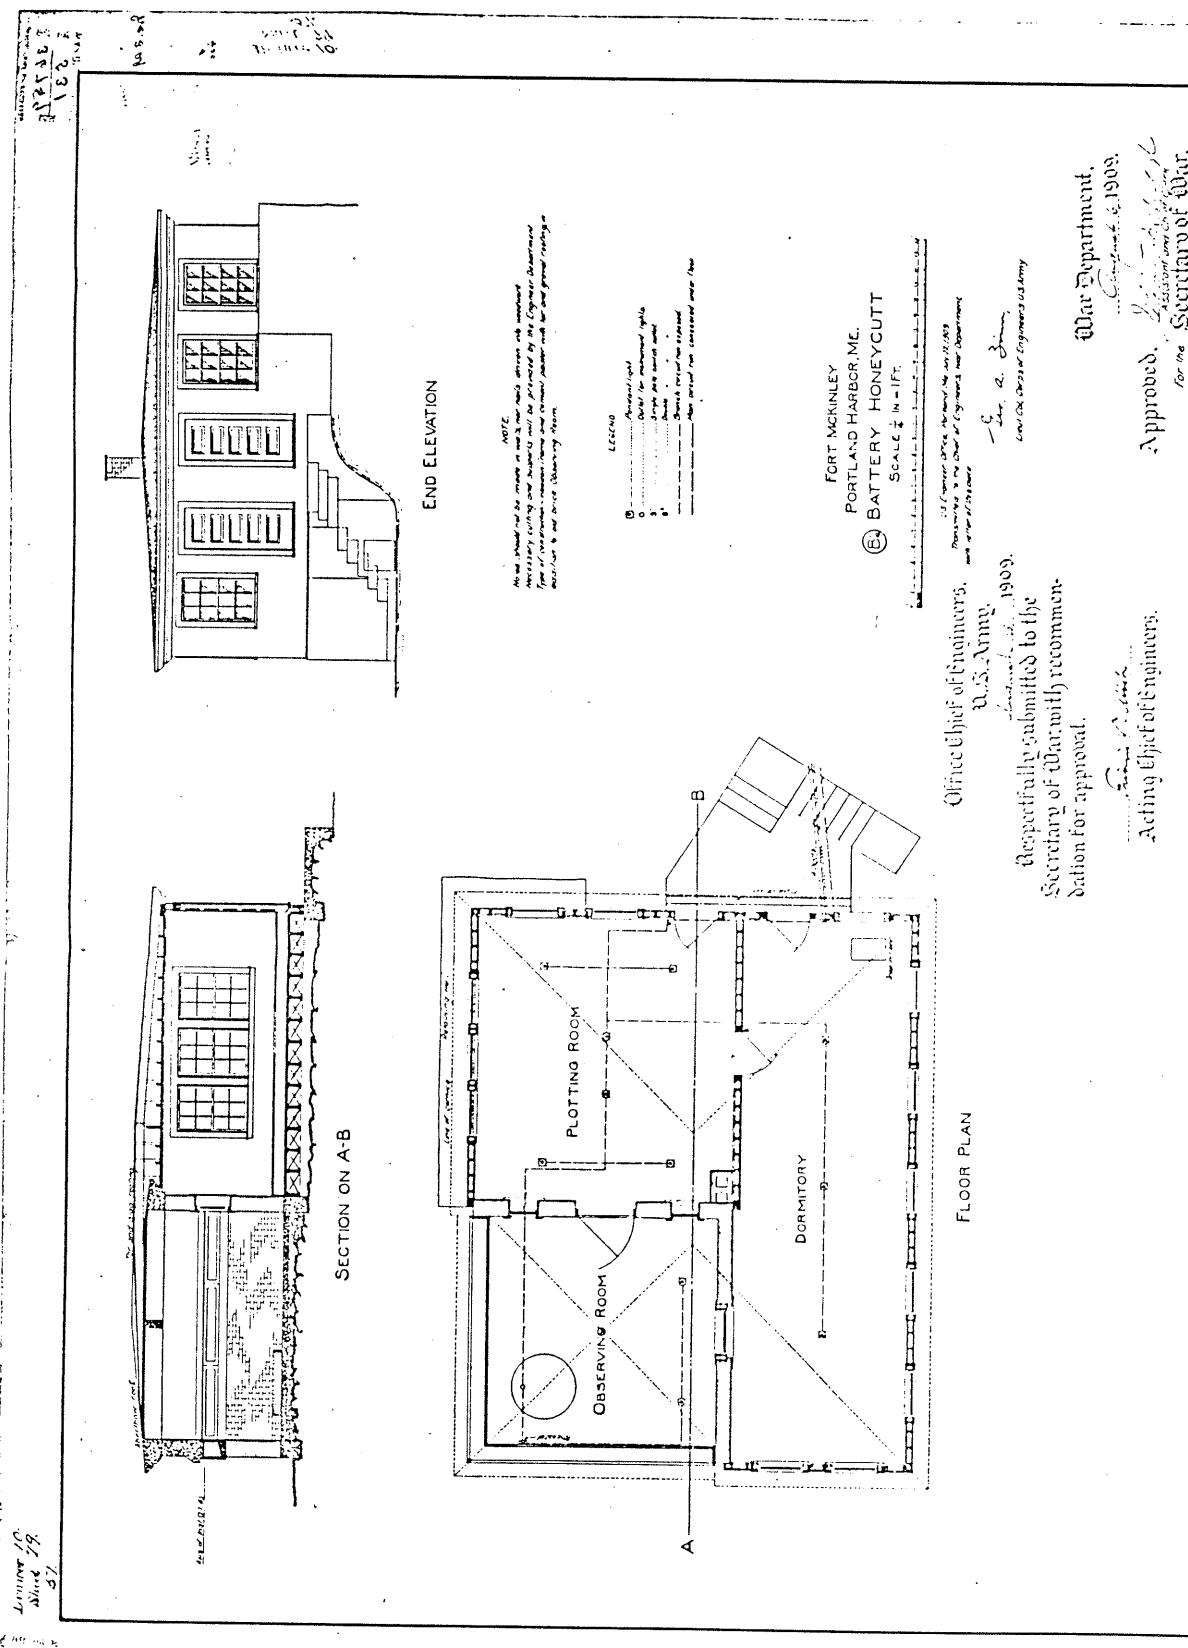

Office Chief of Engineers,
U. S. Army.

May 15, 1908.
Respectfully submitted to the
Secretary of War with recommenda-
tion for approval.
A. C. Gilman,
Brig. Gen., Chief of Engineers,
U. S. Army.

U. S. Department
May 20, 1908.
Approved,
J. A. Westland,
Acting Secretary of War.

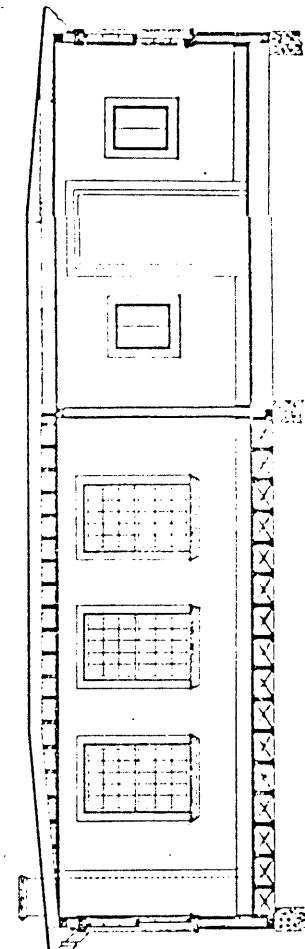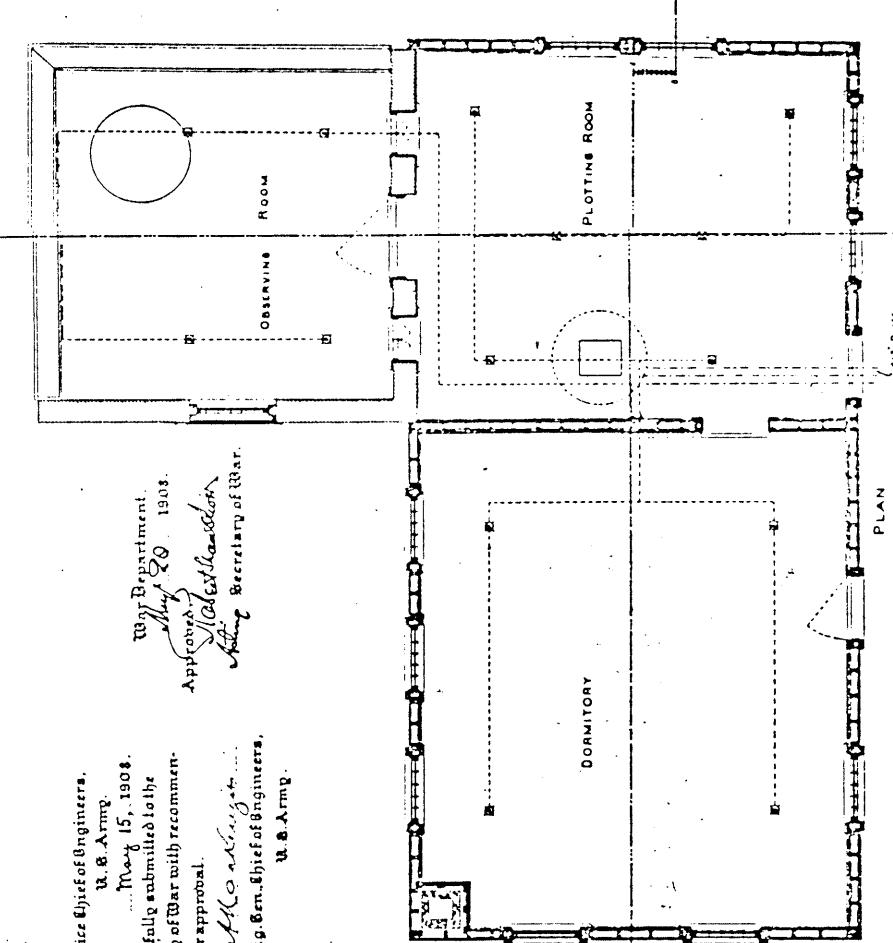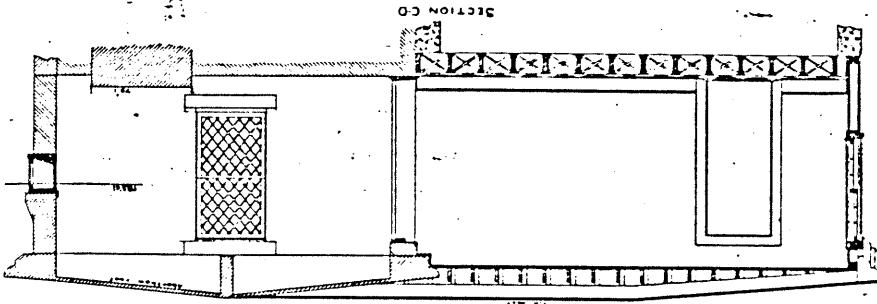

FORT MCKINLEY,
PORTLAND HARBOR, MAINE.
B) BATTERY THOMPSON

Scale 1:1000

SECTION A-B

Note


Major Corps of Engineers, U. S. Army.

U. S. Engineer Office.


Portland, Me., April 29, 1908.
Transmitted to the Chief of Engineers, War Department,
with letter of this date.

E. J. B.
Major Corps of Engineers, U. S. Army


10-79
93

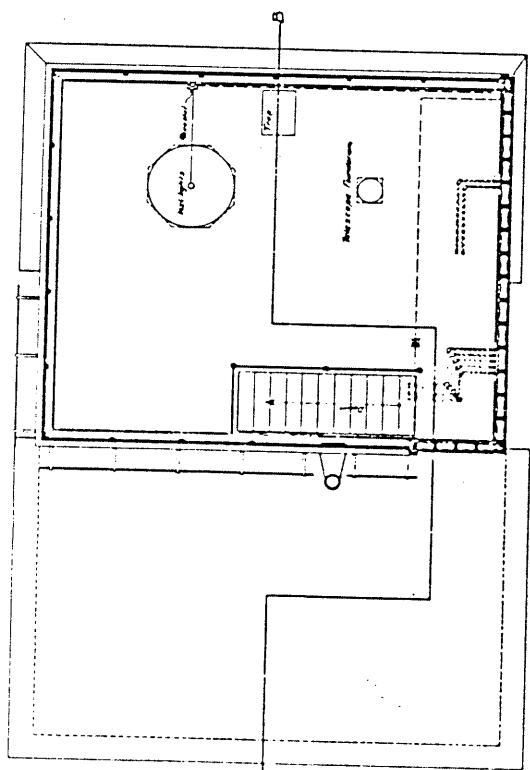

FIRST FLOOR PLAN

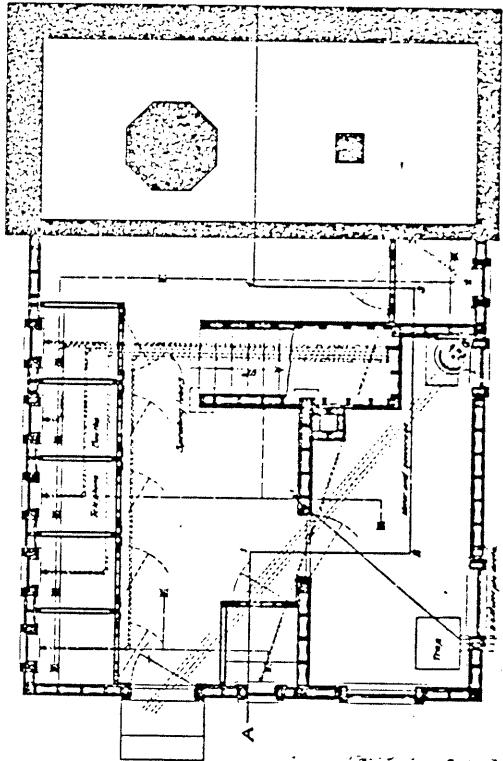

GROUND FLOOR PLAN.

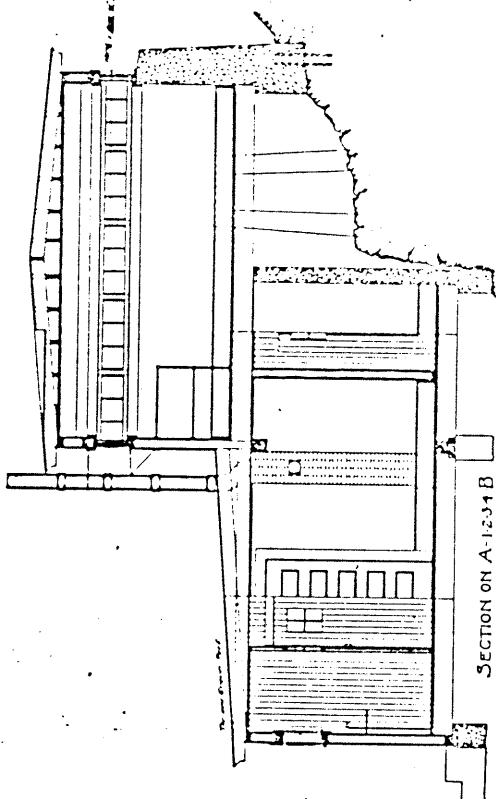

C
SCALE: 1 IN. = 1 FT.

FORT MCKINLEY
PORTLAND HARBOR, MAINE.
BATTLE COMMANDERS STATION

Office Chief of Engineers
U. S. Army
July 6, 1908.
Respectfully submitted to the
Secretary of War with recommenda-
tion for approval

Frank V. Black
Acting Chief of Engineers.


U.S. Engineer Office
Portland, Maine June 25, 1908
Transmitted to the Chief of Engineers, War Department,
with letter of his date.



Gen. J. W.
Lieut. General Corps of Engineers U. S. Army

Note

War Department
J. G. O., 1908.
Approved.
William D. Brewster
Secretary of War.

10-379
46

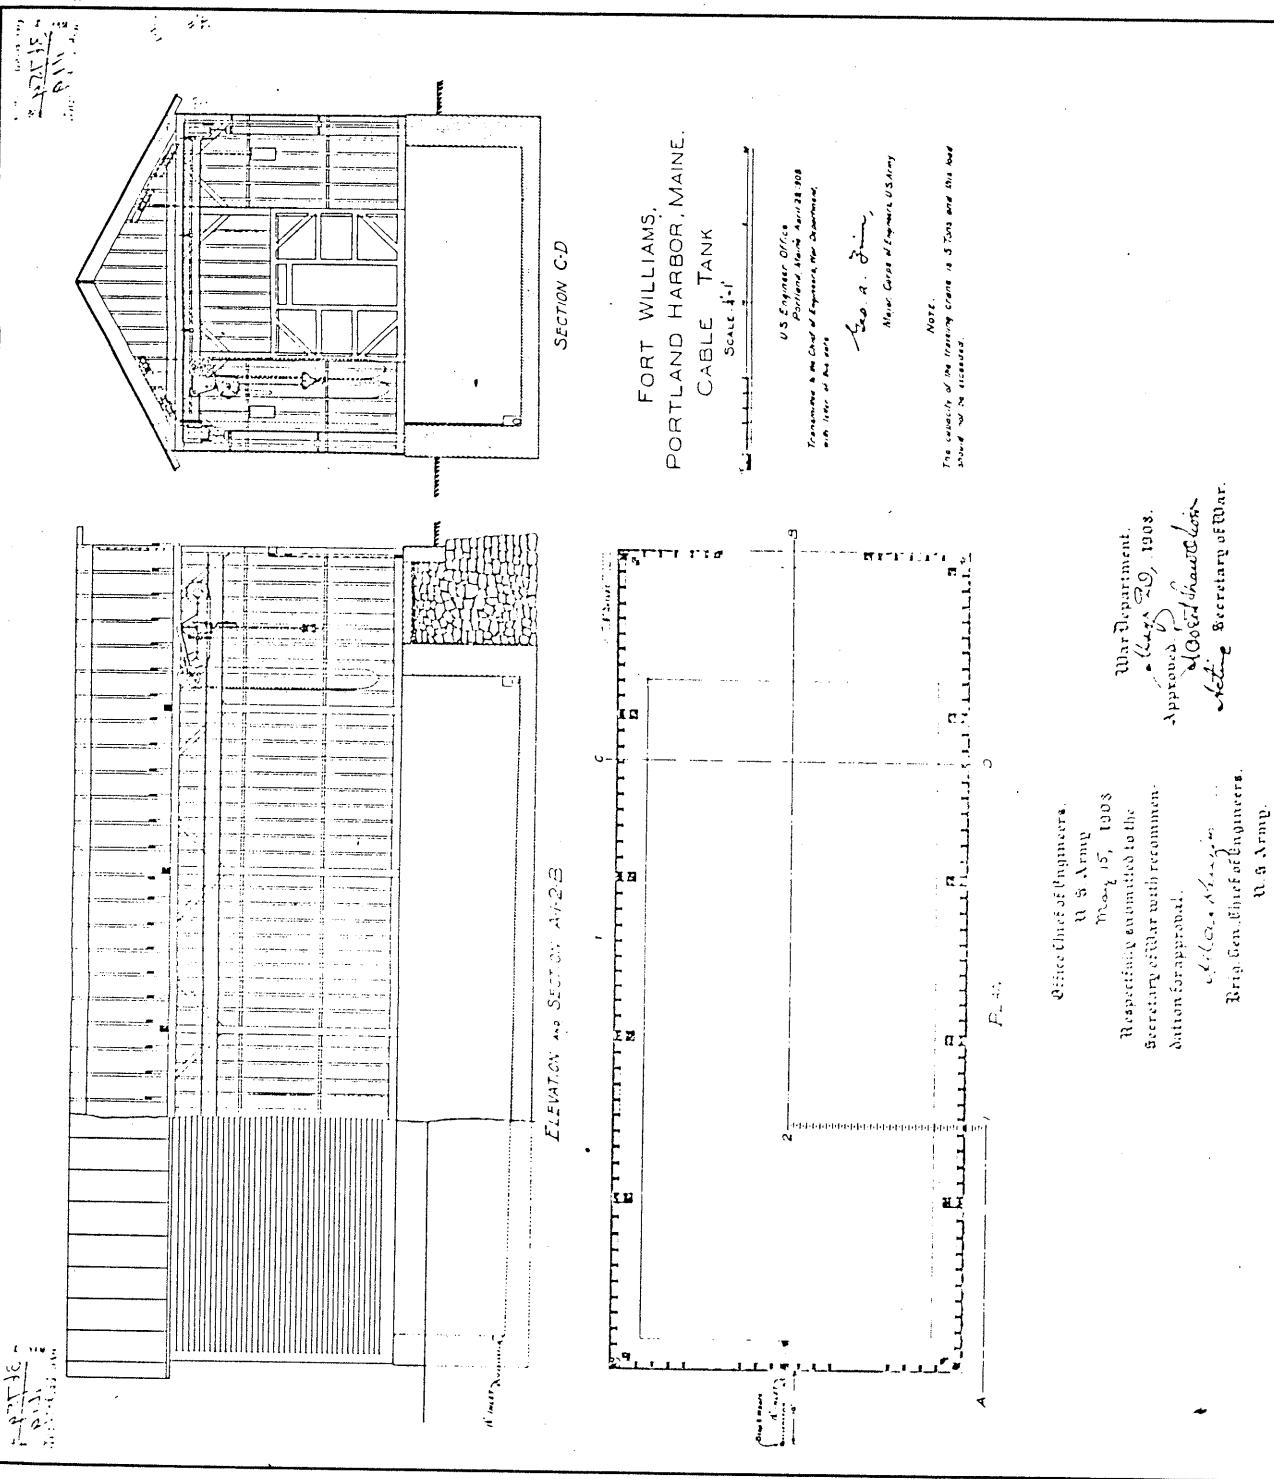

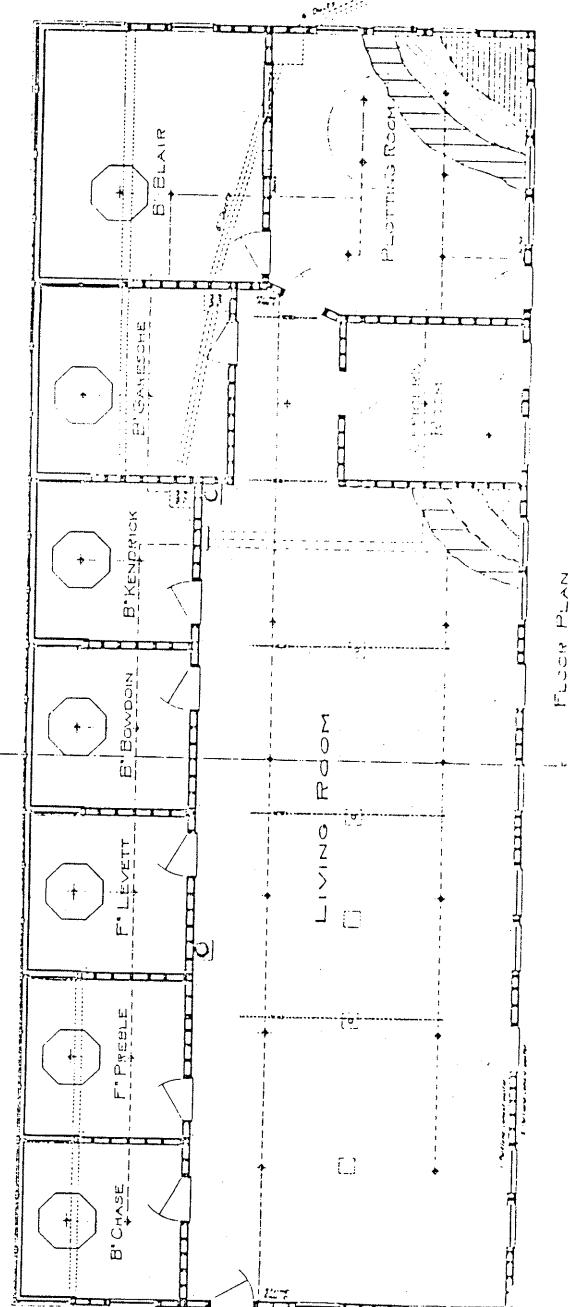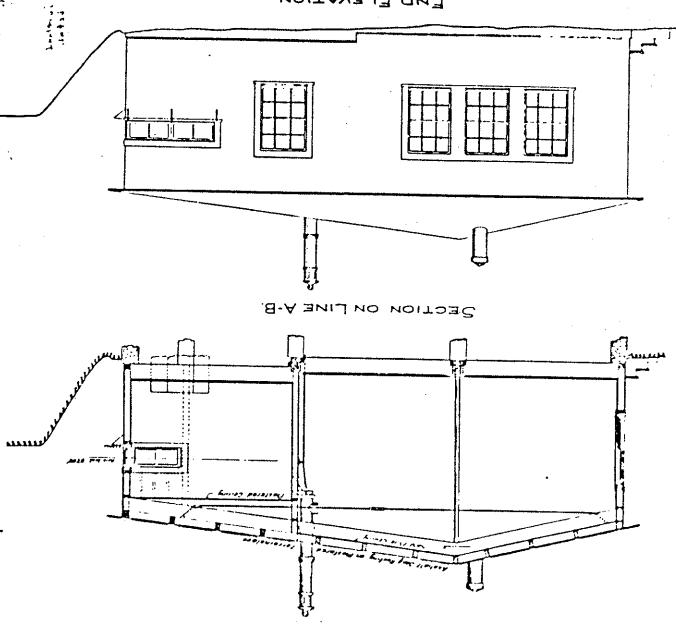

FORT WILLIAMS

PORTLAND HARBOR, MAINE

COMBINED PRIMARY AND SECONDARY STATION

Scale 1"-1'-0"


Approved
John G. Schaff
Acting Secretary of War.


Office Chief of Engineers.

U. S. Army
November 6, 1907.
Respectfully submitted to the
Secretary of War with recommenda-
tion for approval.

C. C. C.
Brig Gen., Chief of Engineers,
U. S. Army.


Approved
John G. Schaff
Acting Secretary of War.

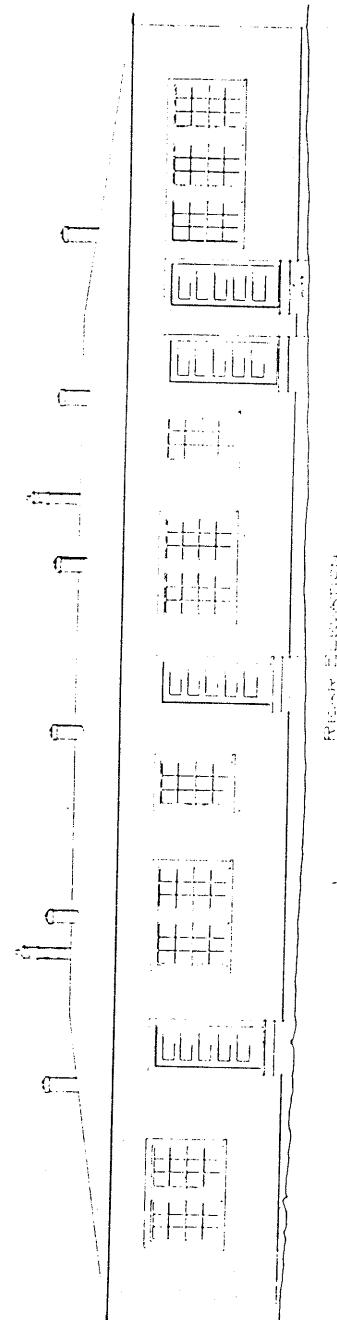

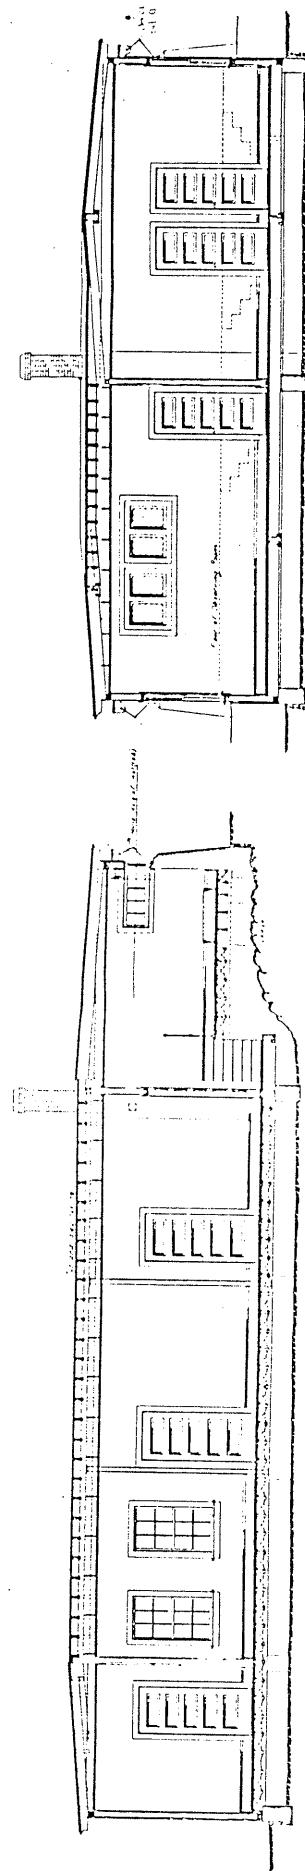


SECTION ON A-2-B

SECTION ON C-D.

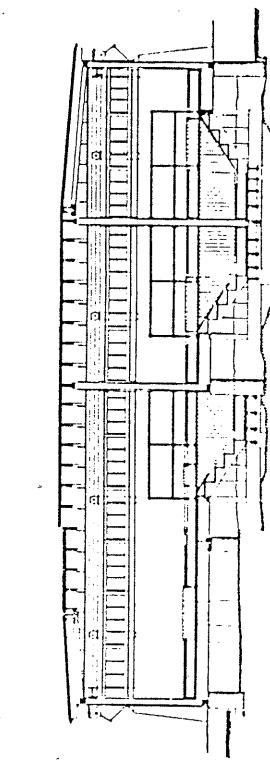

SECTION ON E-1-2-F

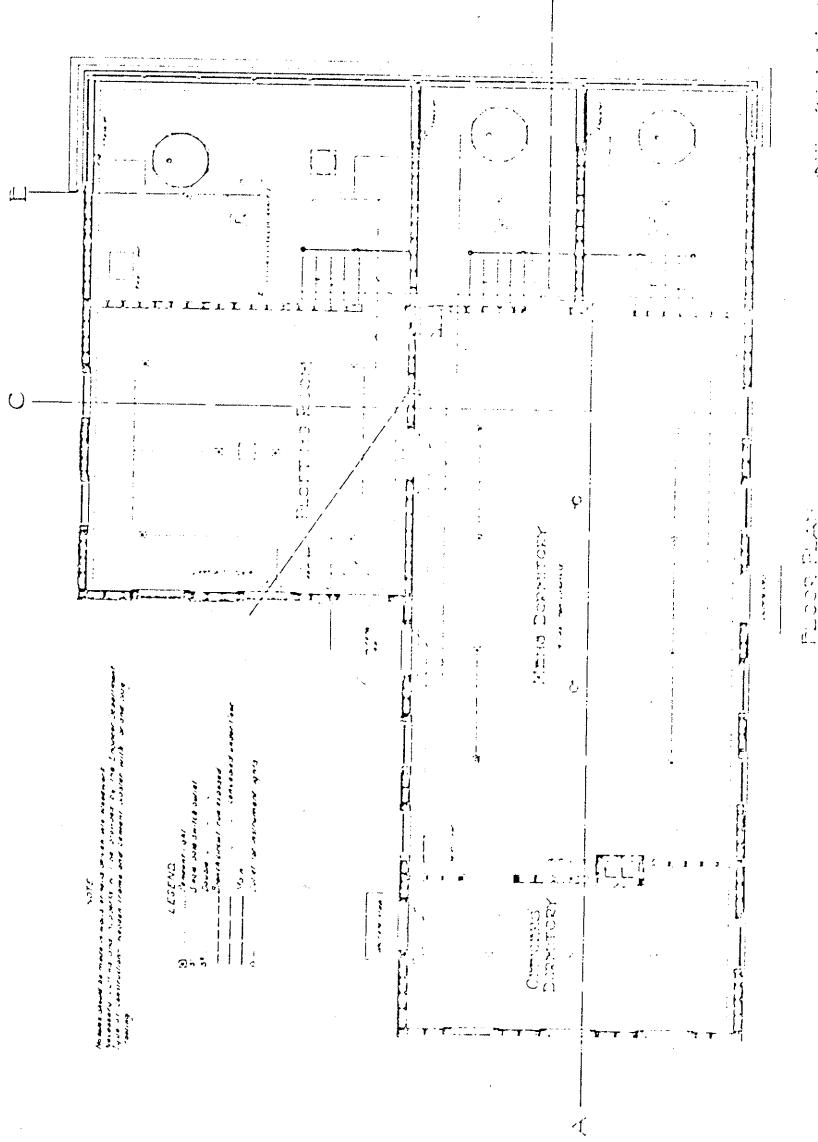

PEAKS ISLAND
PORTLAND HARBOUR, ME.
COMBINED RANGE FINDING STATION.

SCALE 1 IN. = 10'-0"

(Handwritten notes and signatures follow)


Approved, *[Signature]*
J. J. [Signature]
Chief of Engineers,
U.S. Army, *[Signature]*
Portland, Me., June 22, 1900.


War Department,

Approved, *[Signature]*
J. J. [Signature]
Secretary of War.

U.S. Army, *[Signature]*

21

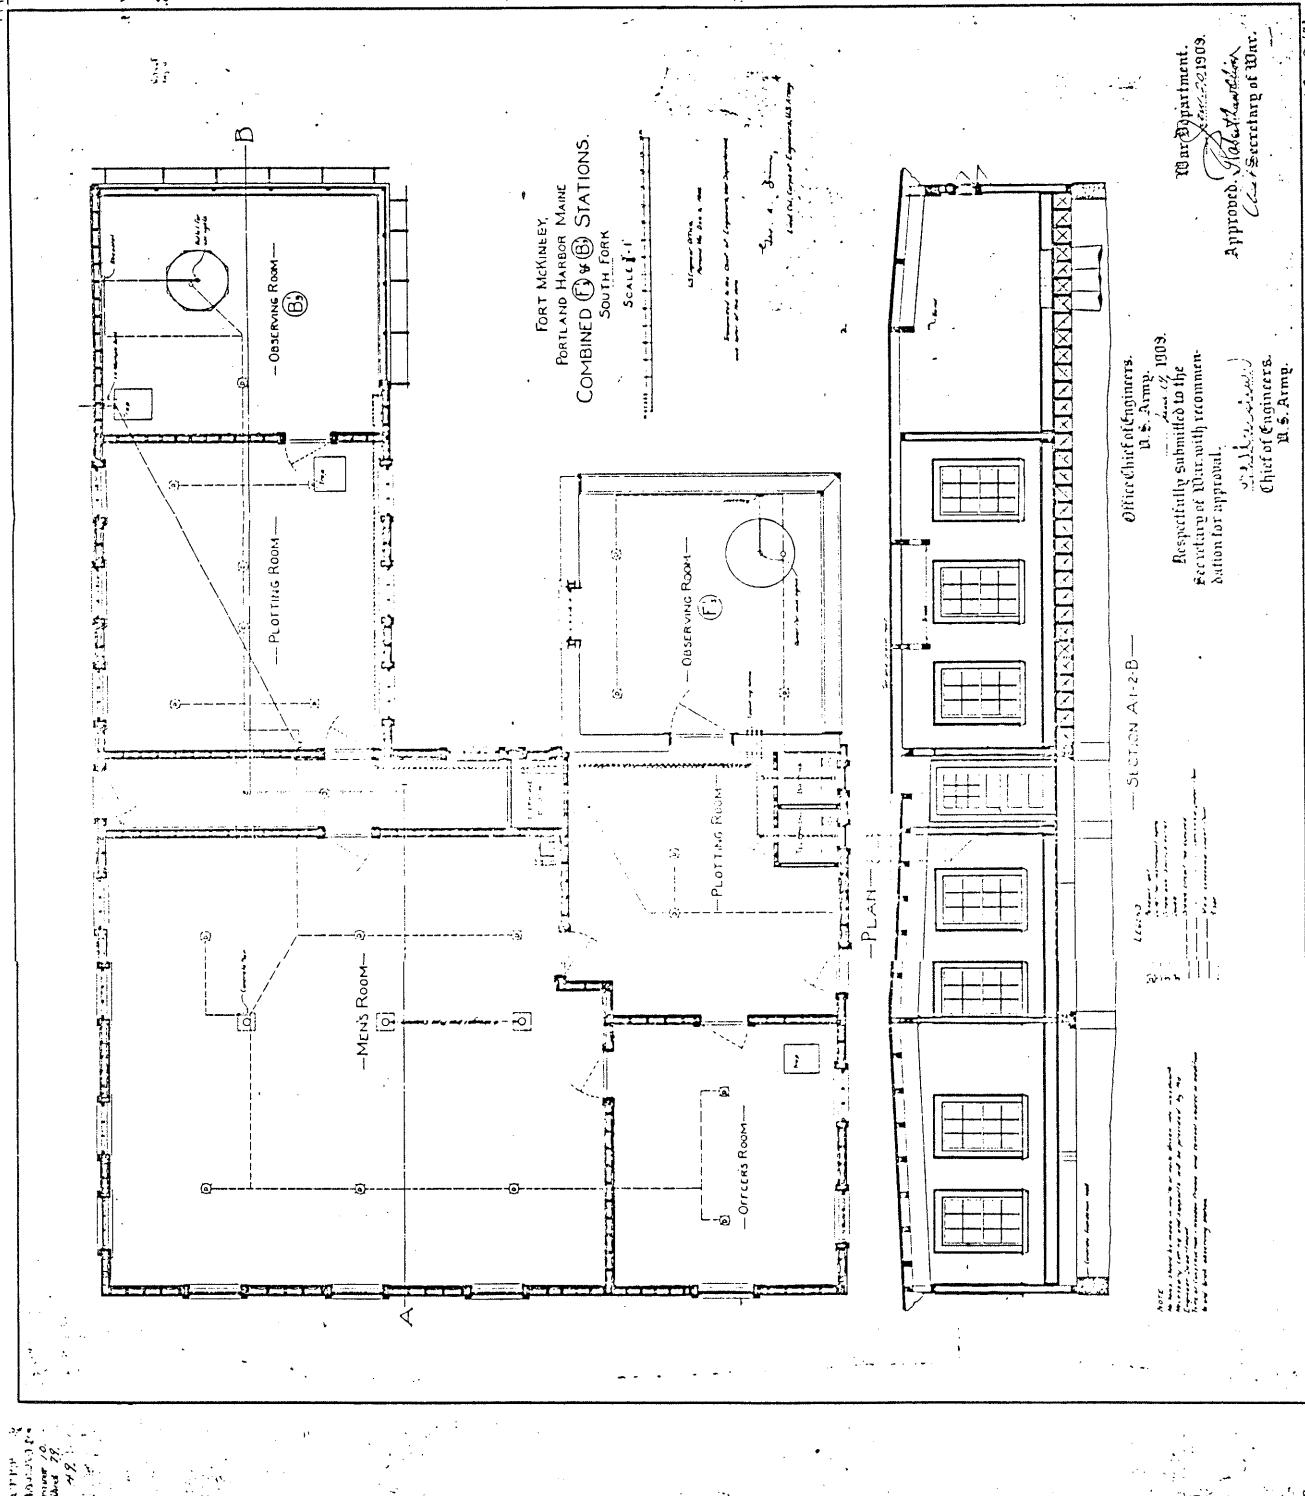

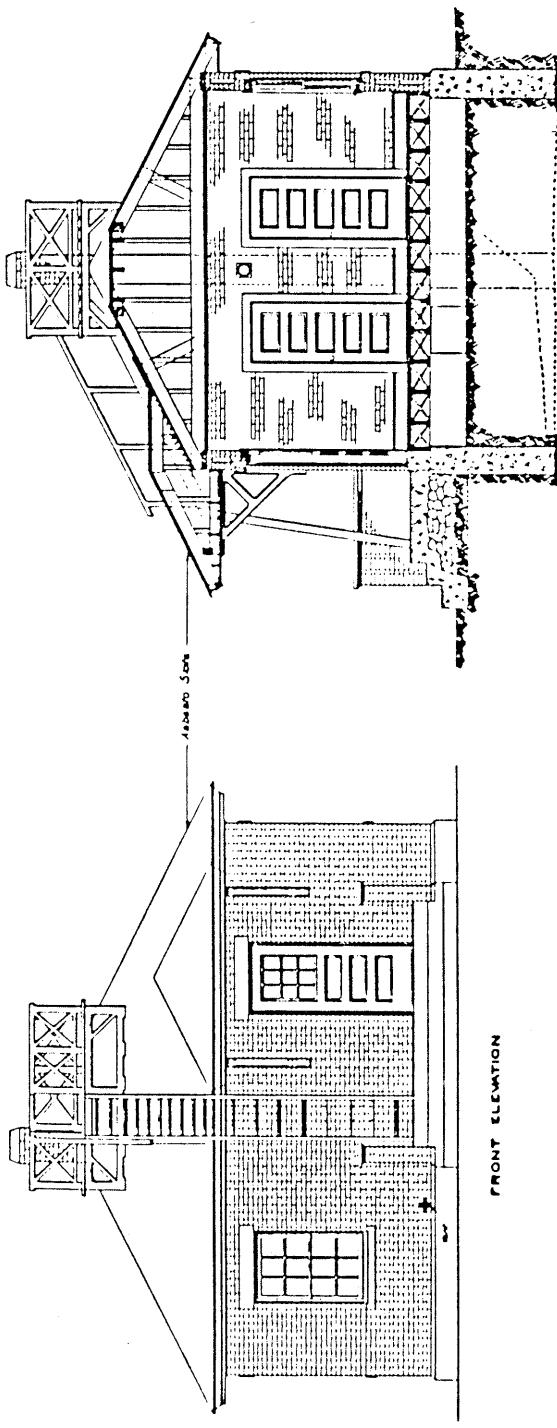

SECTION ON C-D

LEGEND.

- Ambient light
- — Ceiling
- S — Single pole switch outlet
- S' — Double
- Branch circuit run exposed.
- Main circuit run concealed under floor.

NOTE.
Holes should not be made in masonry, nor nests driven into woodwork
necessary cutting and opening will be performed by the Engineer Department
for communication - obtain

FORT LEVETT
PORTLAND HARBOR, ME.
DISTRICT SIGNAL STATION


SCALE : 1 IN. = 1 FT.

U.S. Engineers Office Portland Me July 12, 1908
Transmitted to the Chief of Engineers, War Department
with letter from me on
Gen. J. S. Sims
Lieut. Col. Corps of Engineers, U.S. Army

War Department,
August 6, 1909.


Approved, J. S. Sims,
Assistant and Chief Clerk
Former Secretary of War, in his absence.





Acting Chief of Engineers,
Gen. J. S. Sims

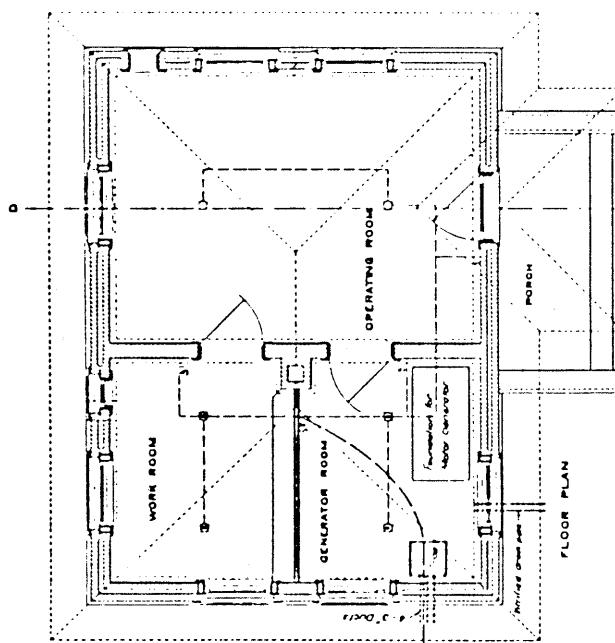

Office Chief of Engineers,
U. S. Army,
August 6, 1909.

Respectfully submitted to the
Secretary of War with recommenda-
tion for approval.

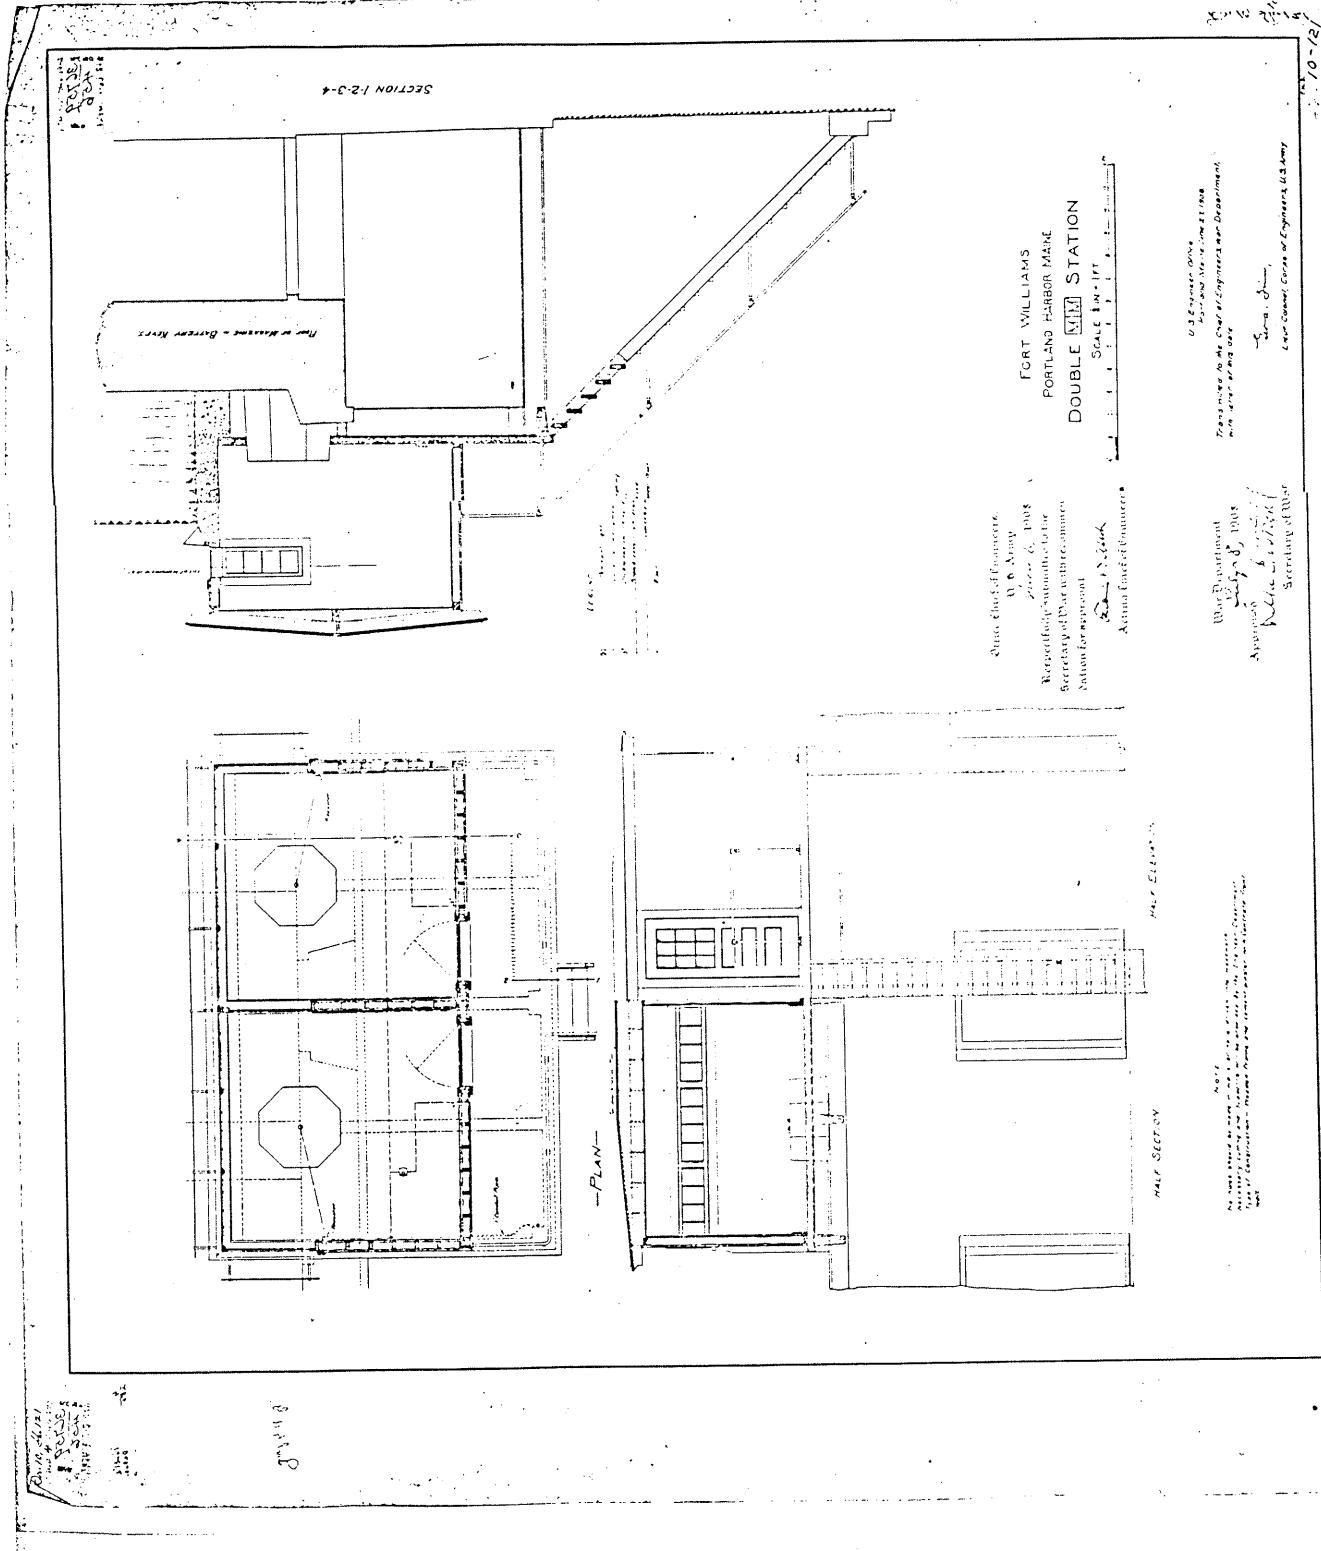

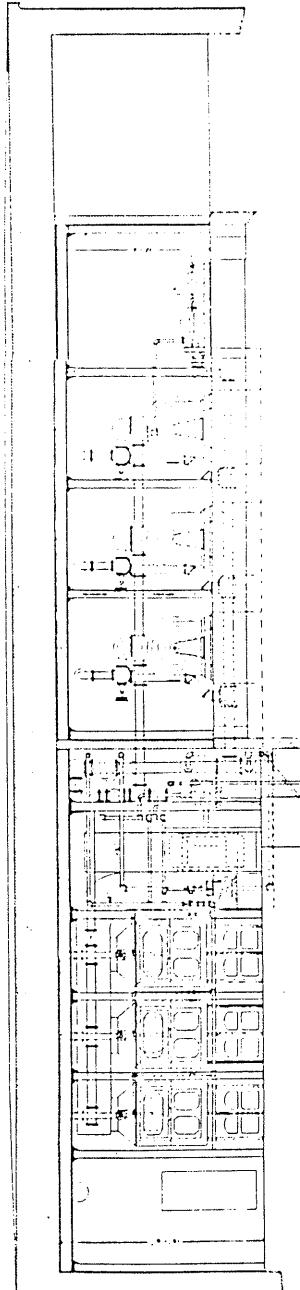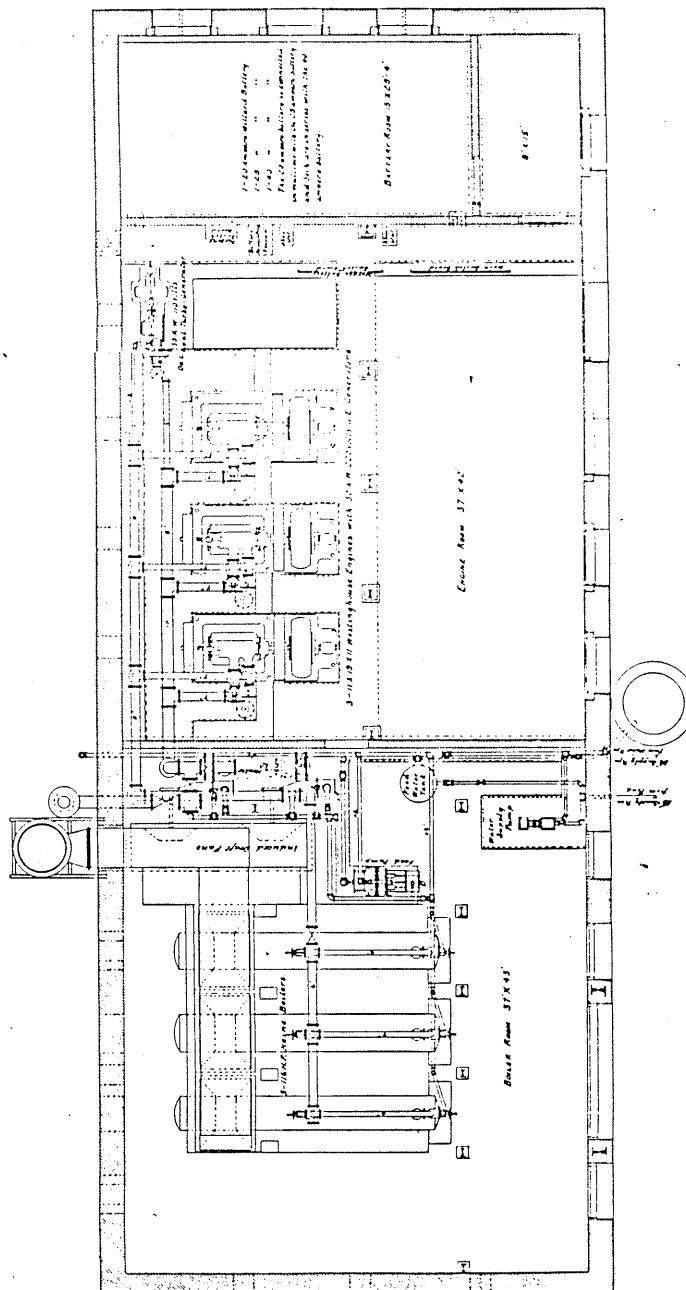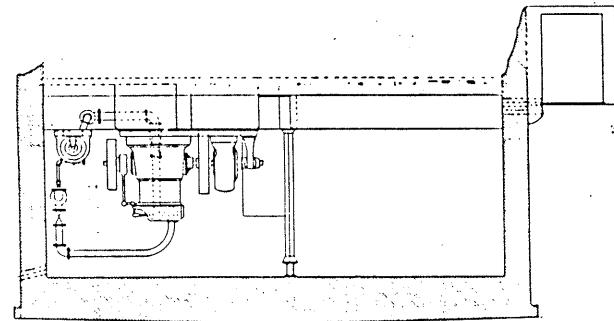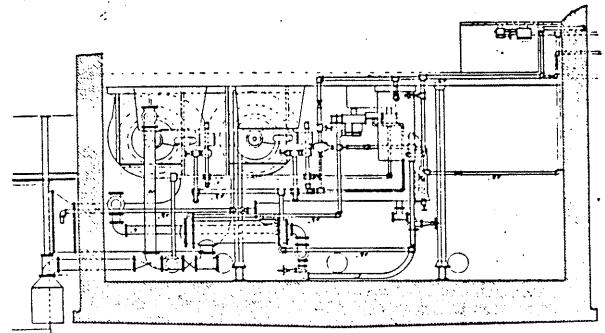

Notes and Instructions for the care of the Electric Plant.


Office of the Secretary of Engineers,
U. S. Army,
January 29, 190
Respectfully submitted to the
Secretary of War, with recommenda-
tion for approval.

~~Academy~~
Brig Gen, Chief of Engineers,
U.S. Army

Approved. *S. S. C. S.*
Secretary of the
Senate

10-093-12

89



Fort McKNIGHT

Brainerd 10
Sheet 90


Horizontal Section and B

Horizontal section on E-F

四

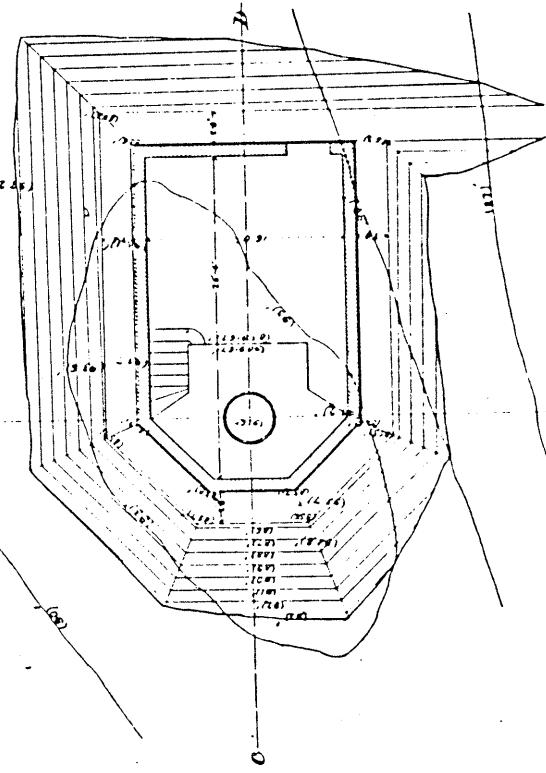

A detailed technical drawing of a horizontal section of a building, labeled "Horizontal section on EF". The drawing shows a multi-story structure with various rooms, a central circular feature, and a staircase. It includes dimensions, labels like "H" and "G", and a small inset drawing of a staircase.

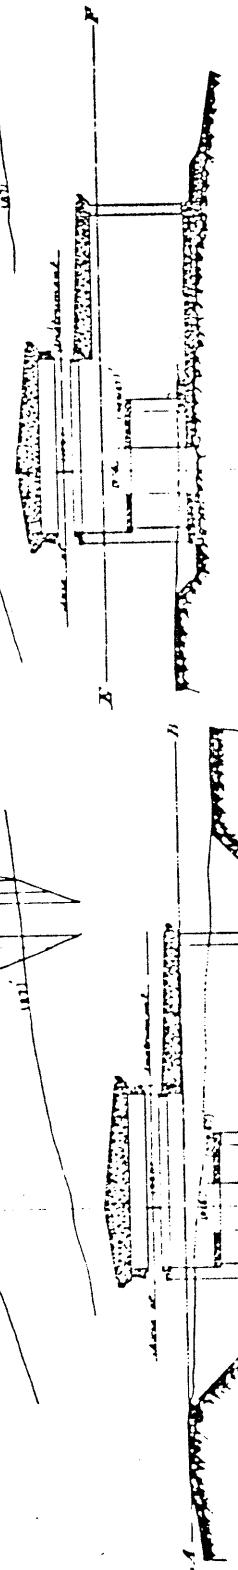

Vertical Section on C-D
Fig. 2 Sketch of station with Axis of Instrument
at Elevation 1002 as it will be built

*Fig. 1 Sketch of Station with their
various features proposed.*

PORTLAND JOURNAL

FIRE COMMANDER STATION

NORTH FORK


Scale 1:4' 39
25 26 27



T.S. Engineer Office
Portland, Me.

Transmitted to the Chief of Engineers U.S.A. with endorsement
Aug. 1-1902

S. W. Scoville


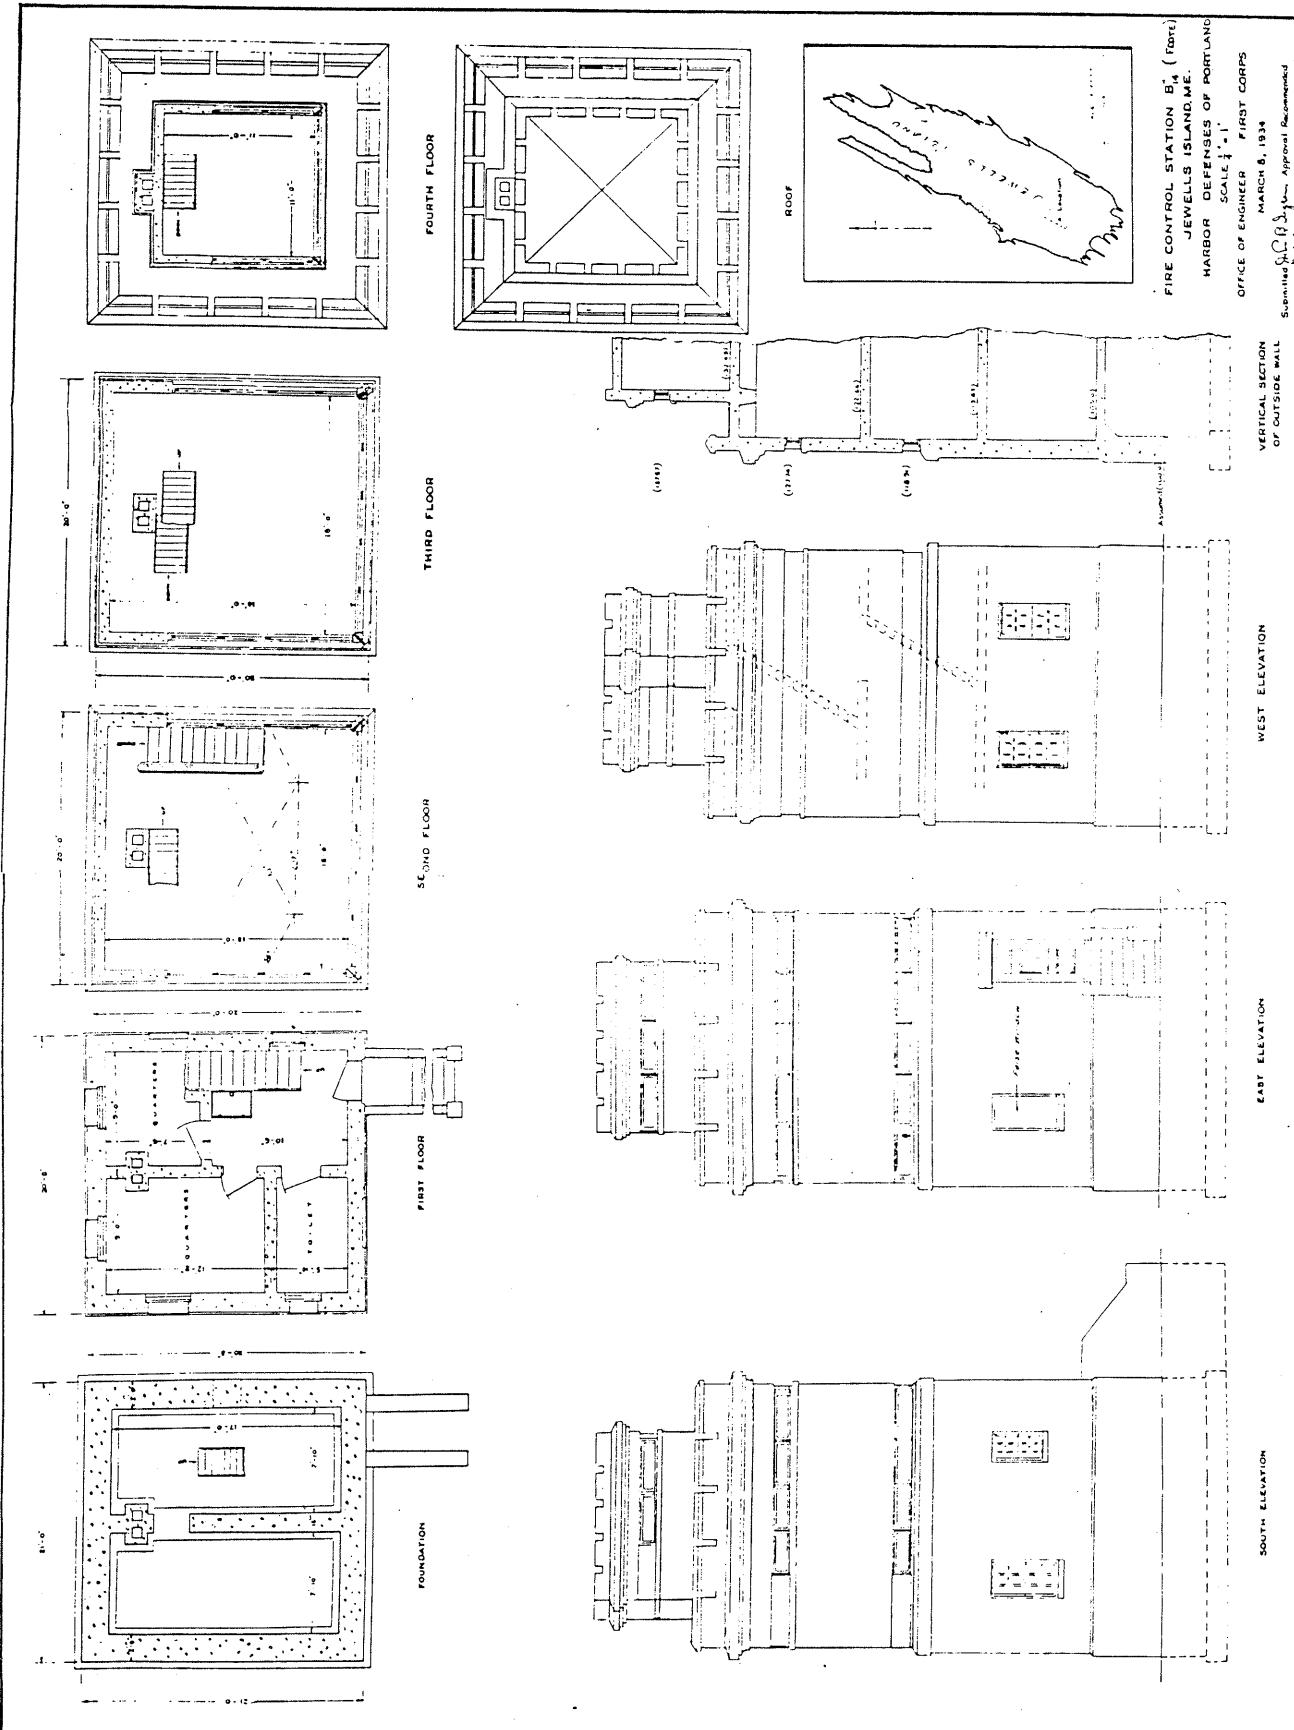

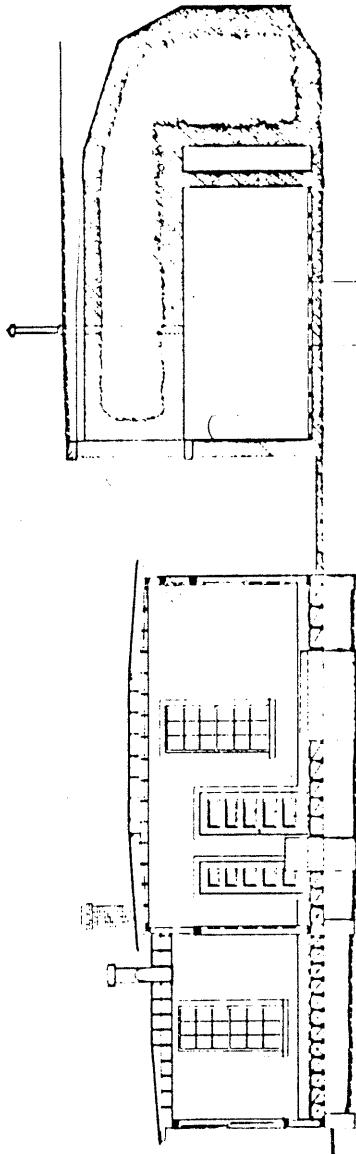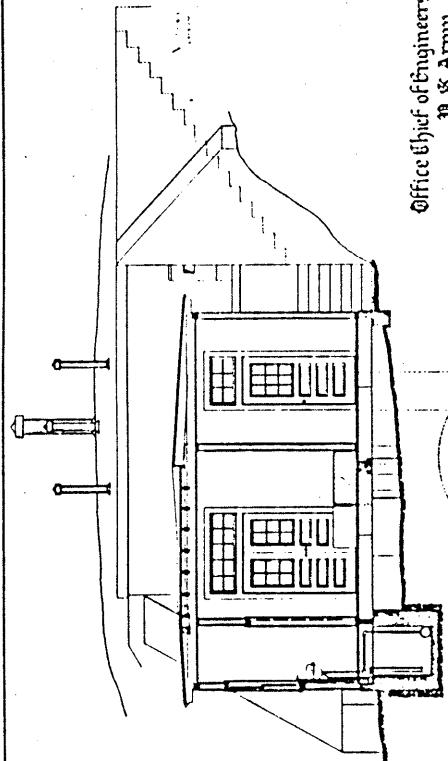


SECTION ON A-1-2-3-4-B

CABLE GALLERY

Office of Chief of Engineers,
U.S. Army,
March 6, 1900
Respectfully submitted to the
Secretary of War with recom-
mendation for approval.

Acting Chief of Engineers.
[Signature]

SECTION ON C-1-2-3-4-O

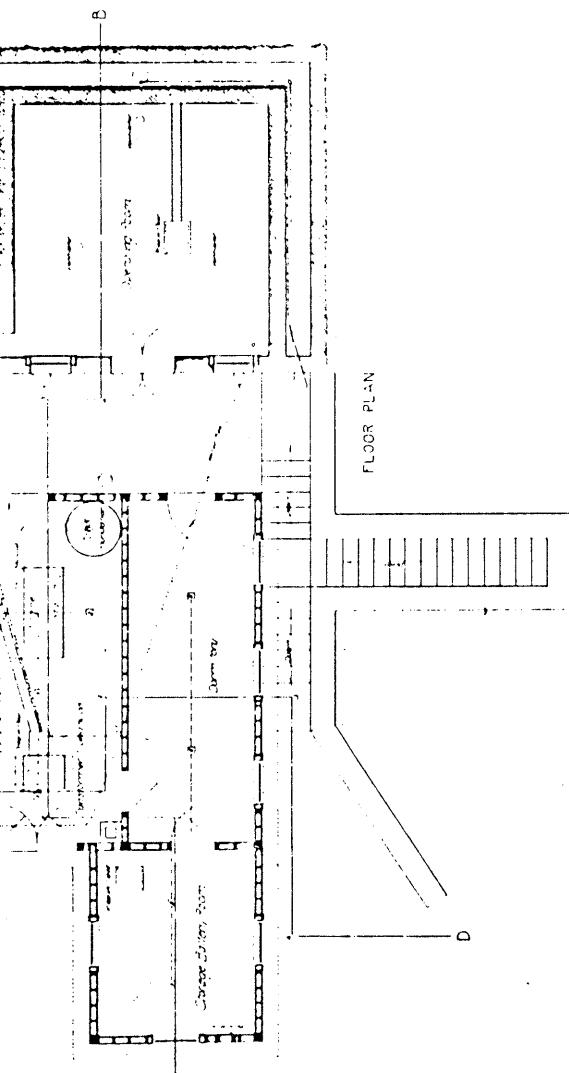


Chief of Engineers,
U.S. Army,
March 6, 1900
Approved,
for the Secretary of War
in his absence.


FORT MCKINLEY
PORTLAND HARBOR VT
MINING CASEMATE
NORTH TORK
SCALE 1 IN. = 1 FT



7-12
10-12

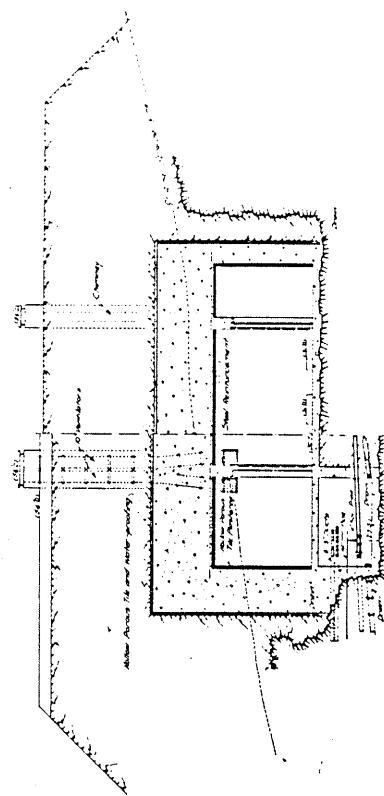


SECTION A-12: B

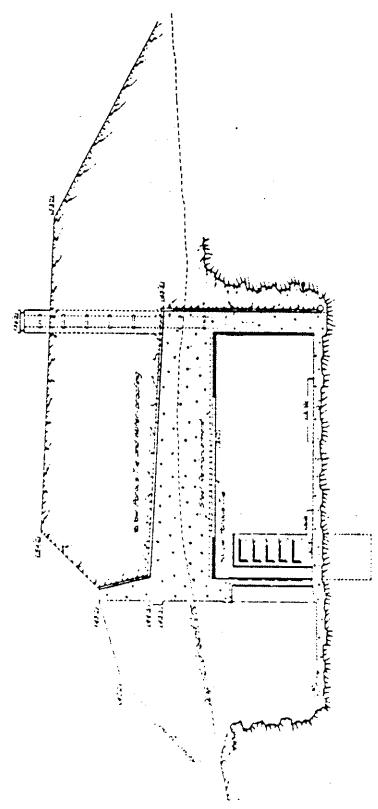

SECTION C-8

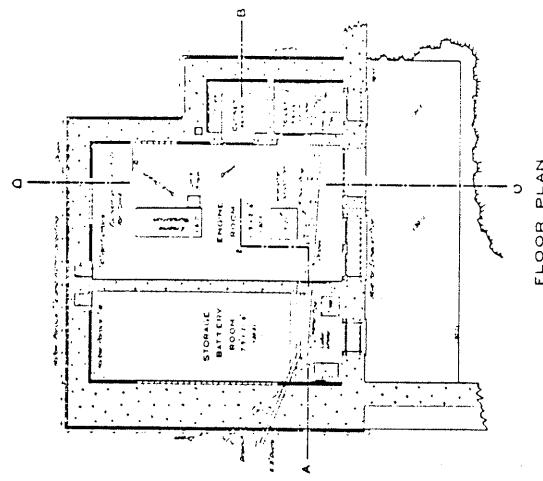

FLOOR PLAN

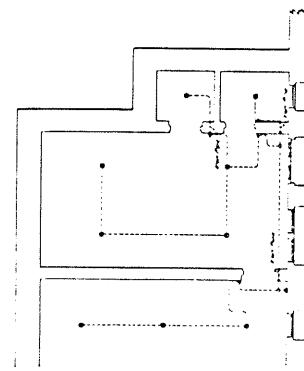



FORT MCKINLEY, ME.
MINING CASEMATE


NORTH FORK

In 1 Street U.S. Eng. Office Portland, Me. May 18, 1920.
 Submittal
 Approved recommendations
 U.S. Eng. Office
 Portland, Me.
 May 18, 1920.
 F. D. McKinley May 14, 1920
 Approved and signed
 and may 18, 1920.


$$10 - 78 = 37$$

Drawer 12
Sheet 68


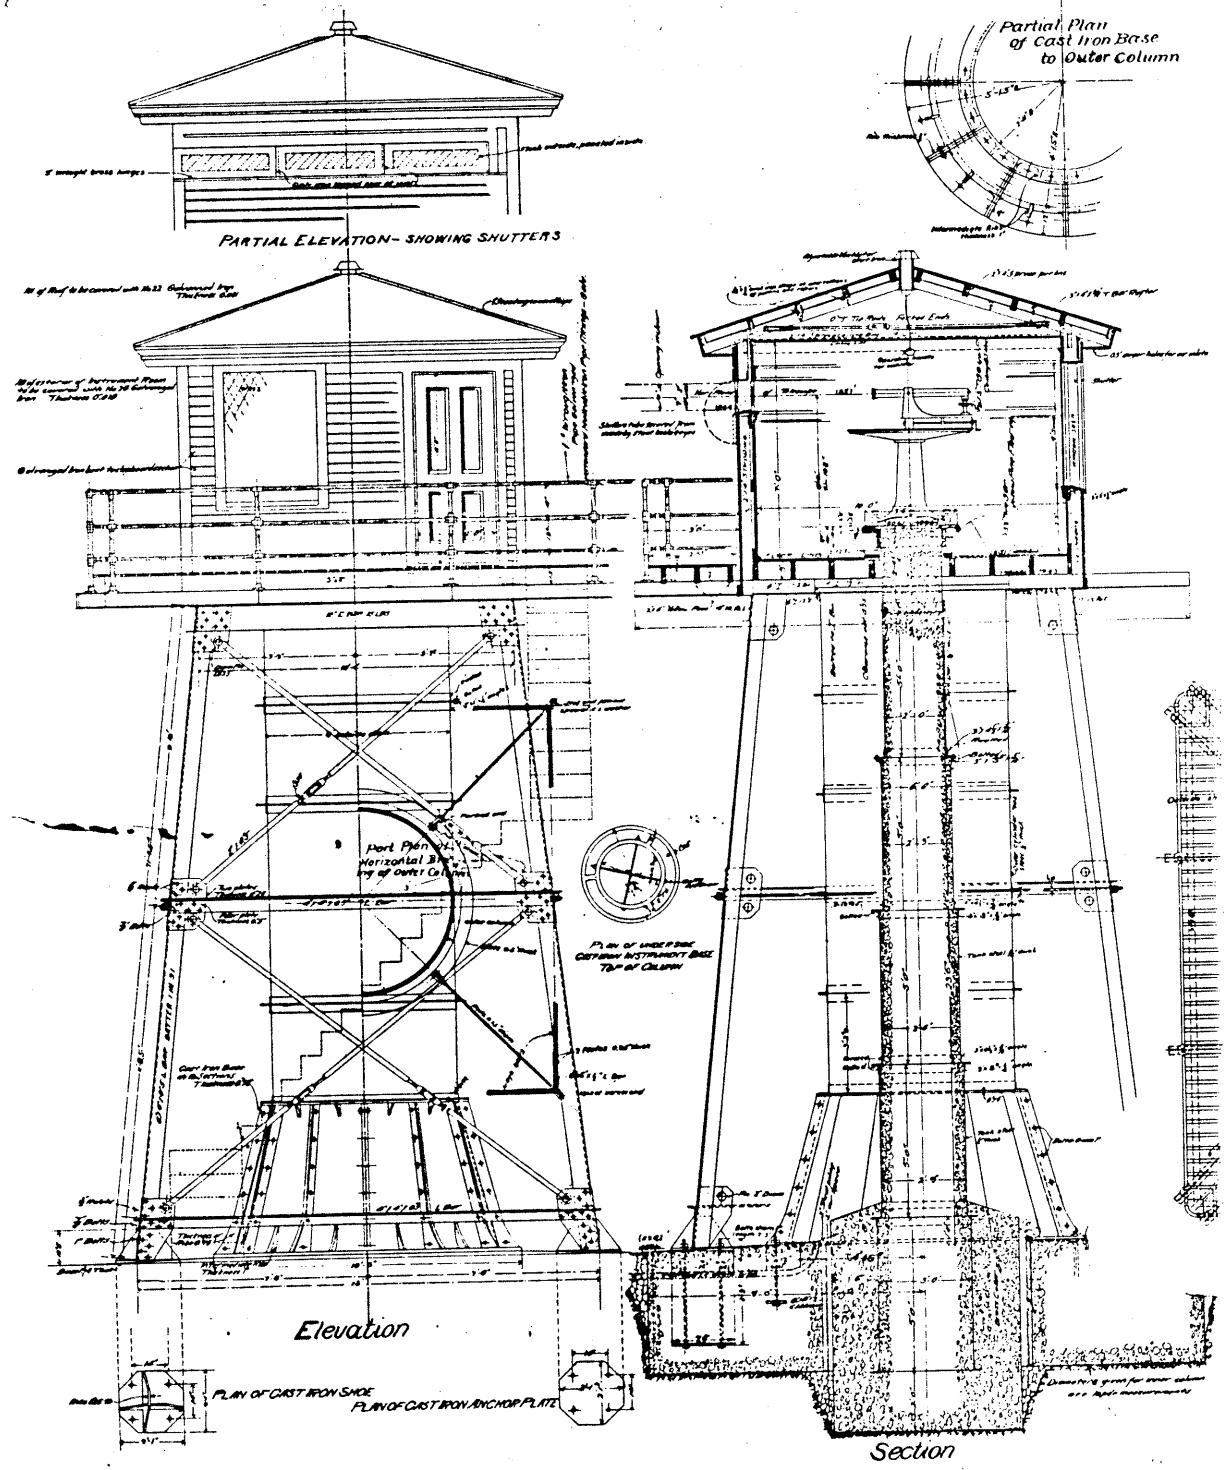


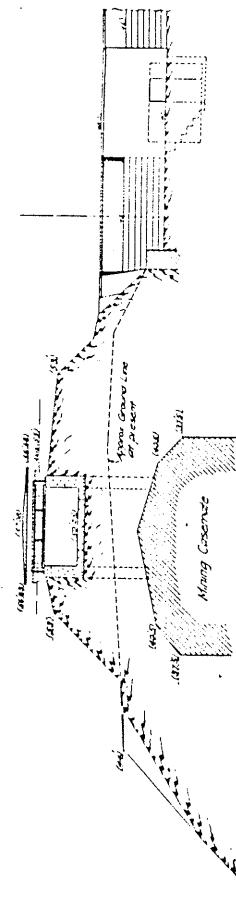

SECTION A-B

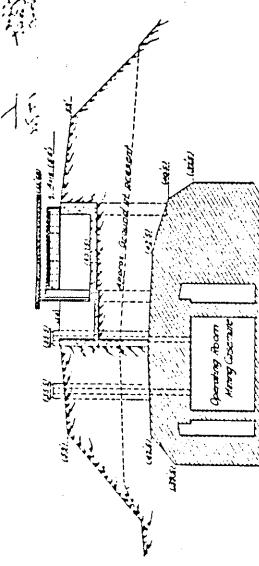

SECTION C-I-2-3-4-D

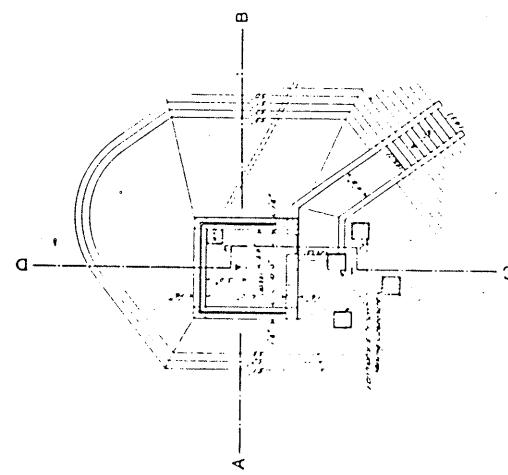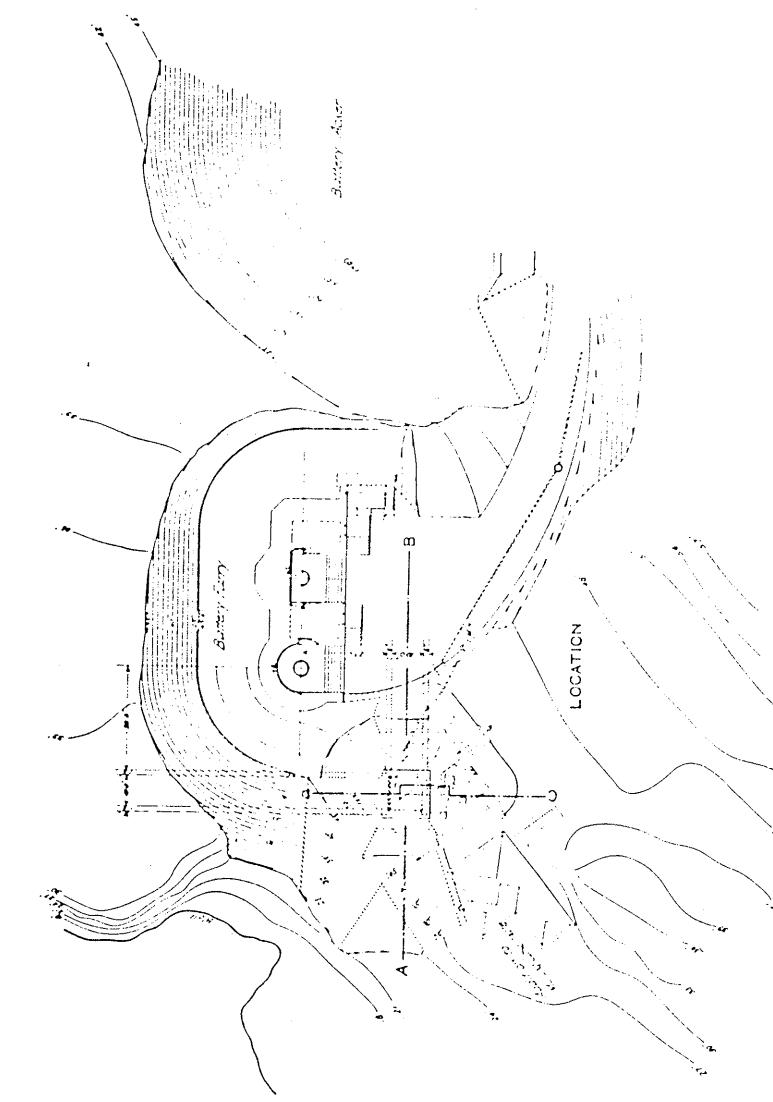FORT MCKINLEY, ME.
BATTERY FARRY

In 1 Sheet
Scale 1 in. = 8 ft., or 20 ft.
0 5 10 15 20 25 30 35 40 45 50 55 60 65 70 75 80 85 90 95 100

U.S. Engineer Office, Portland, Me., Feb. 1, 1919.
Approved recommended.
S. G. Smith, Chief Engineer
Drawing by C. J. Smith
Tracing and ink, engraving
Ft. MCKINLEY 12-68
Scale 1 in. = 8 ft., or 20 ft.
Drawn Feb. 22, 1919





10-56-15

War Department.

AER DEPARTMENT.

CORPS OF ENGINEERS, U.S. ARMY.

CONST DATA

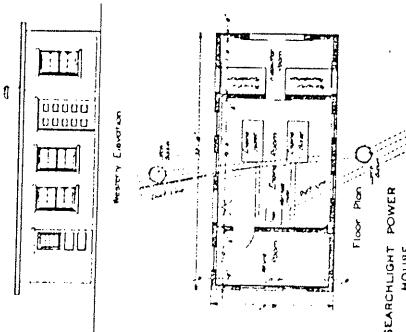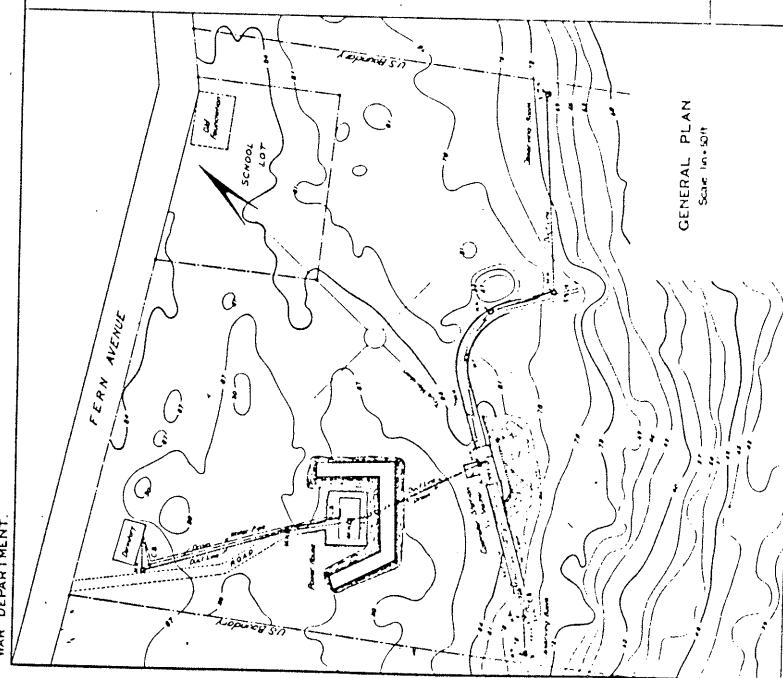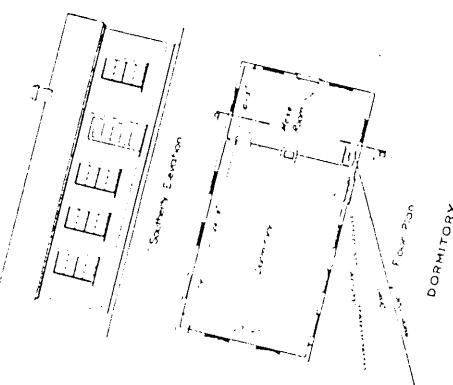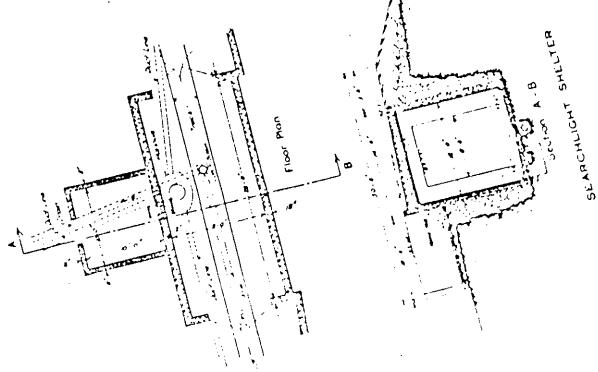

**LONG ISLAND
PORTLAND HARBOR, ME.
SEARCHLIGHT INSTALLATION**

In 1 Sheet AS CONSTRUCTED Scale In feet

12.57

R.
C.
W.

11






A. 9. 217.

6


1


100%
50%

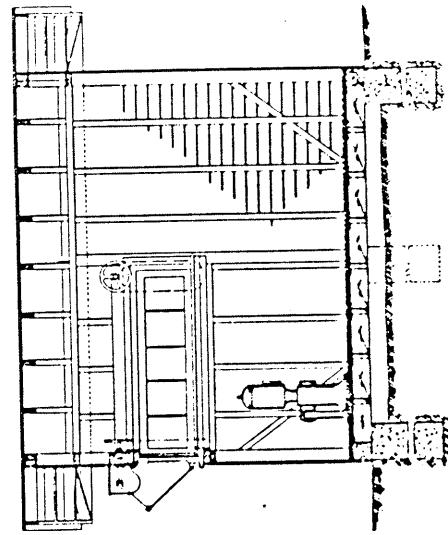

SECTION ON A-8

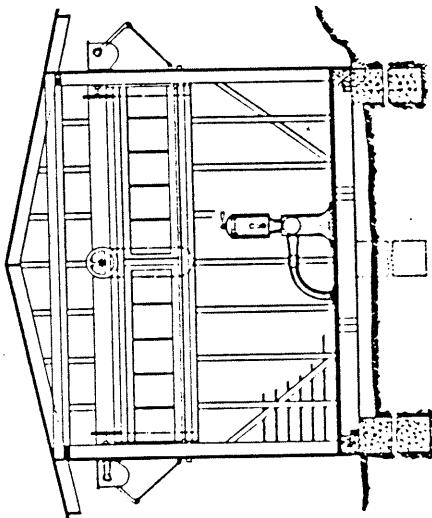

SECTION ON O-O

SEARCHLIGHT OBSERVING STATION

BOSTON AND HARBOR. ME.




FLOOR PLAN







Transmitted to the Chief of Engineers, War Department
with copy of the order *Luna. Dime*

10-99
15

1932

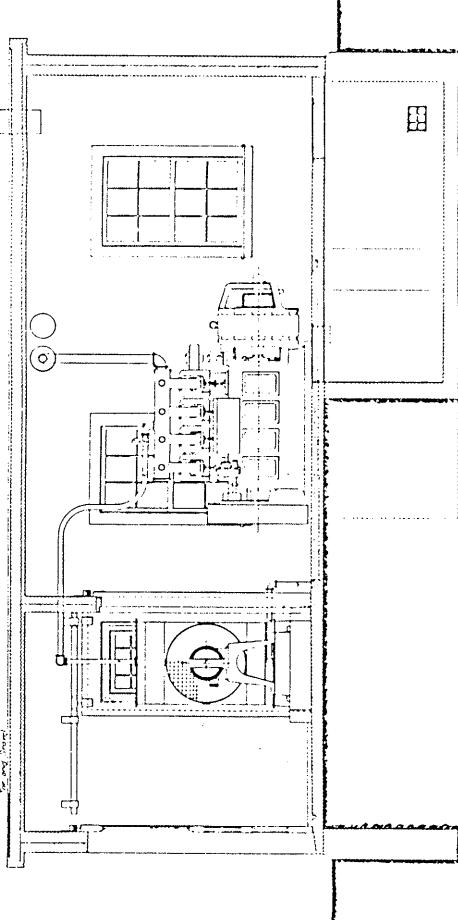

SECTION ON A-B

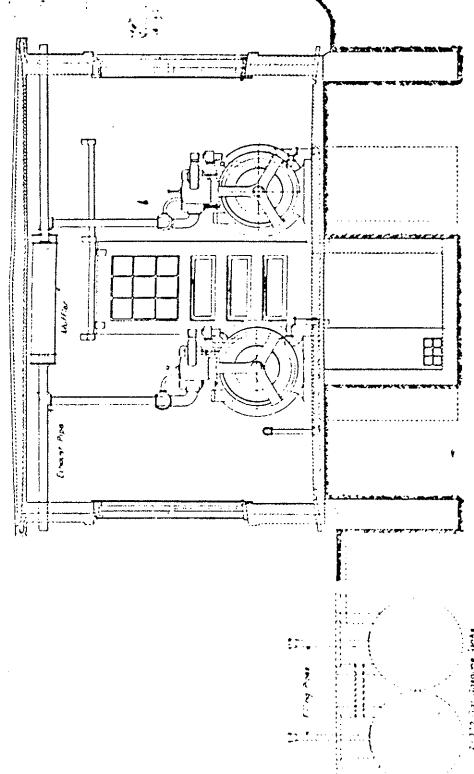

SECTION ON C-D

Office of Chief of Engineers

U. S. Army

January 22, 1911.
Respectfully submitted to the
Secretary of War with recom-
mendation for approval.

Acting Chief of Engineers.

War Department,
January 23, 1911.

Approved—
John T. Alderson
Secretary of War.

PEAK'S ISLAND
PORTLAND HARBOR ME.
SEARCHLIGHT POWER HOUSE


Scale 1 in. = 100 ft.

F. C. G. 2-49

NOTES AND INSTRUCTIONS:
1. All dimensions given in feet
and inches. All dimensions given
in feet and inches are to be taken
from the outer face of the exterior
wall.


F. C. G. 2-49

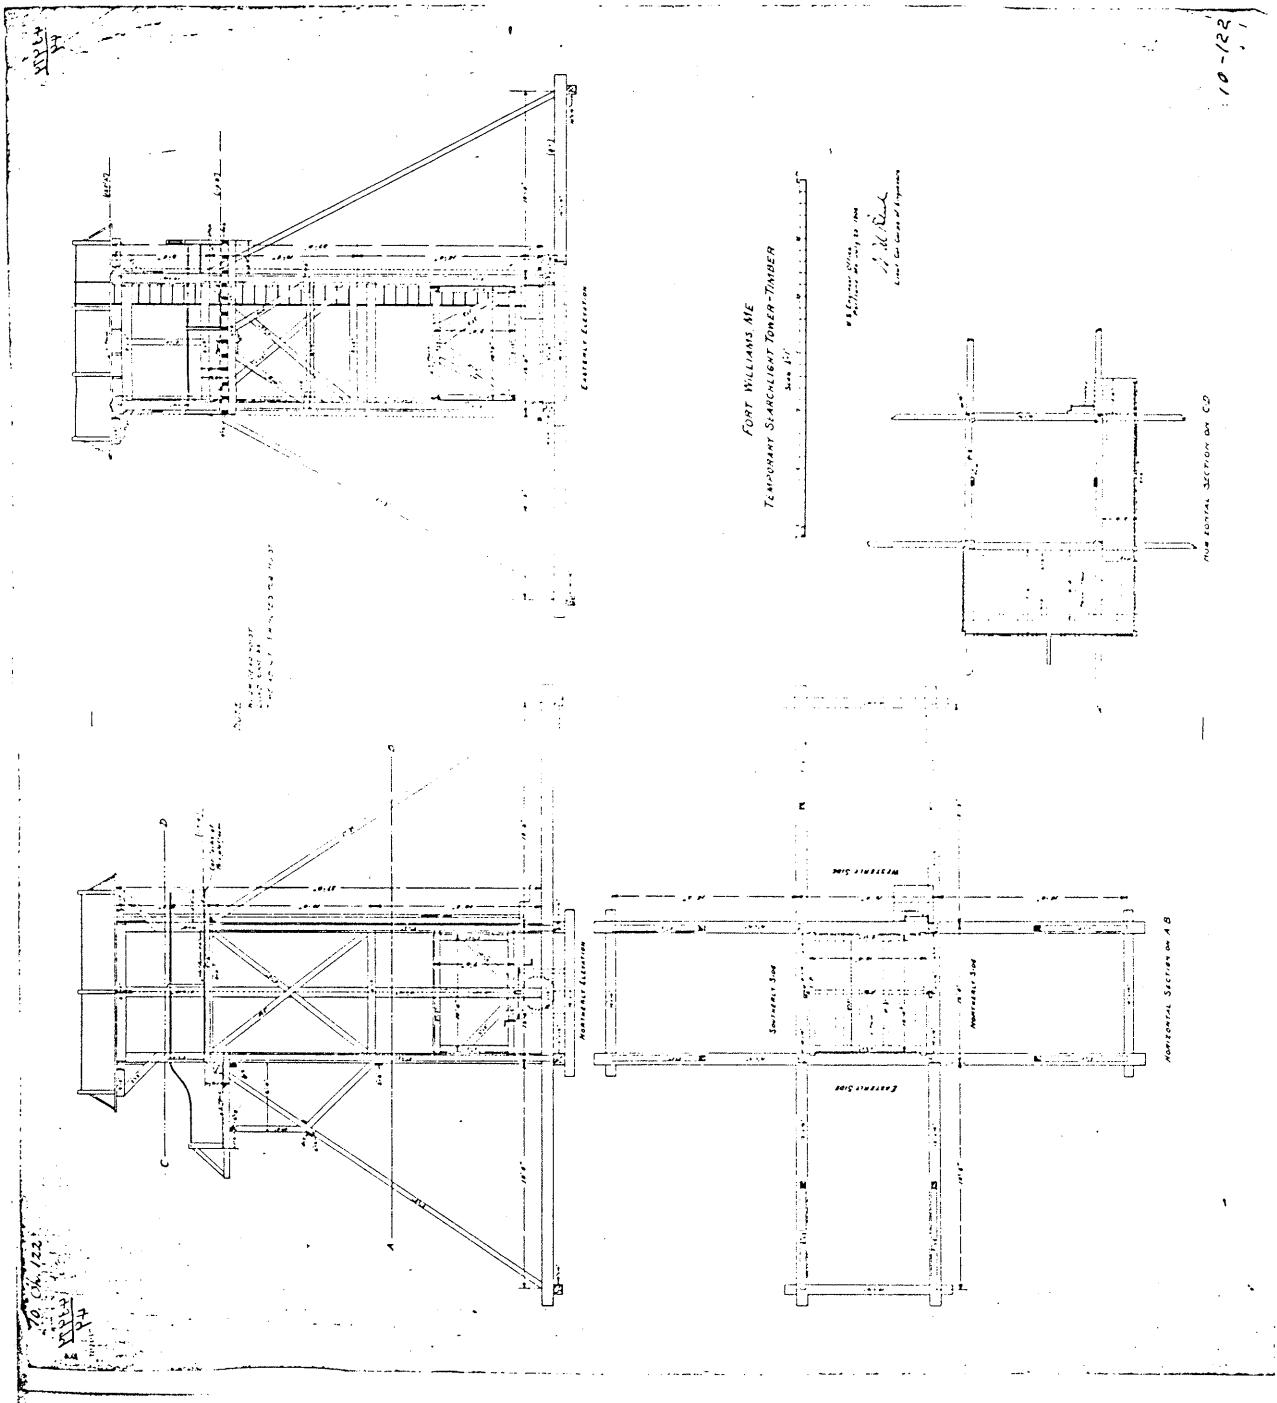


101
U.S. ENGINEERS
CORPS OF ENGINEERS, U.S. ARMY
WAR DEPARTMENT


Scale 1:100

Sheet No. 1


10-119-9

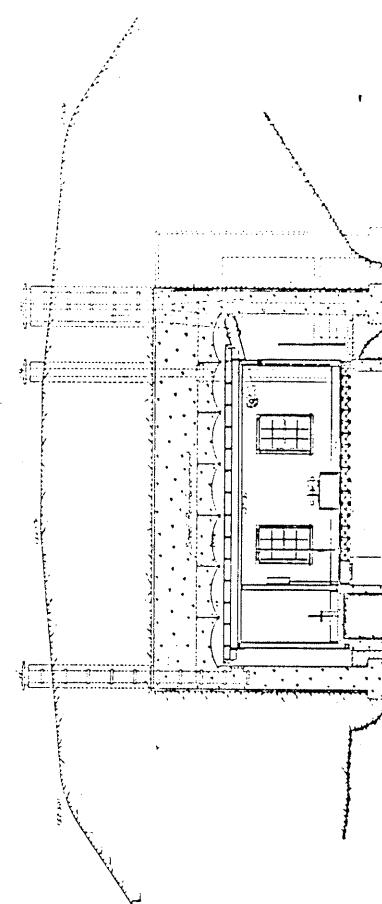


SECTION A-B

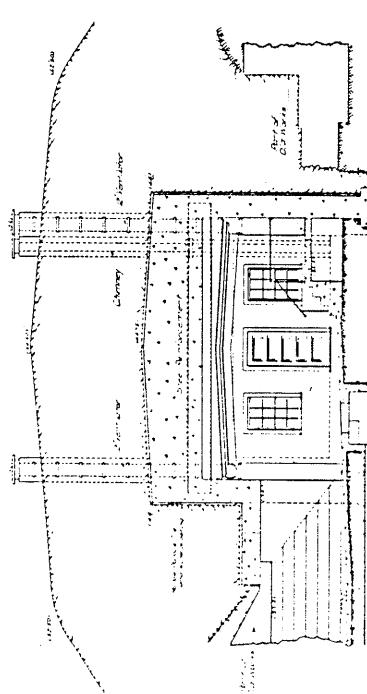

SECTION C-D

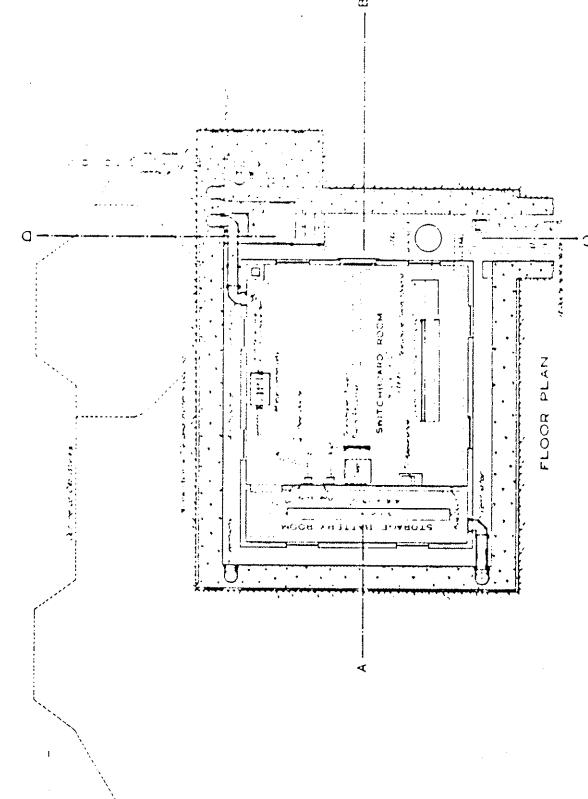

FLOOR PLAN

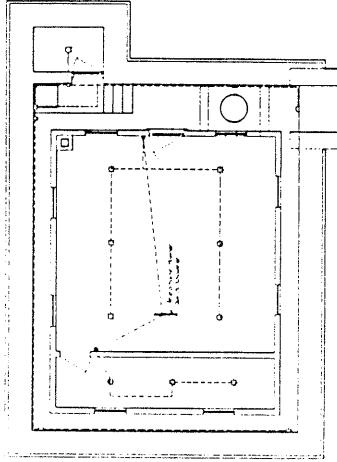

ELECTRIC LIGHTING

FORT PEBBLE, ME.
SWITCHBOARD BUILDING


Scale 1:100
Sheet No. 1
U.S. Engineer Office, Portland, Me., Jan 1, 1910
F. No. PEBBLE S-62


10-119-9






WAR DEPARTMENT.


Portland, Me. 04102
35 Fallbrook St.
Roger Davis

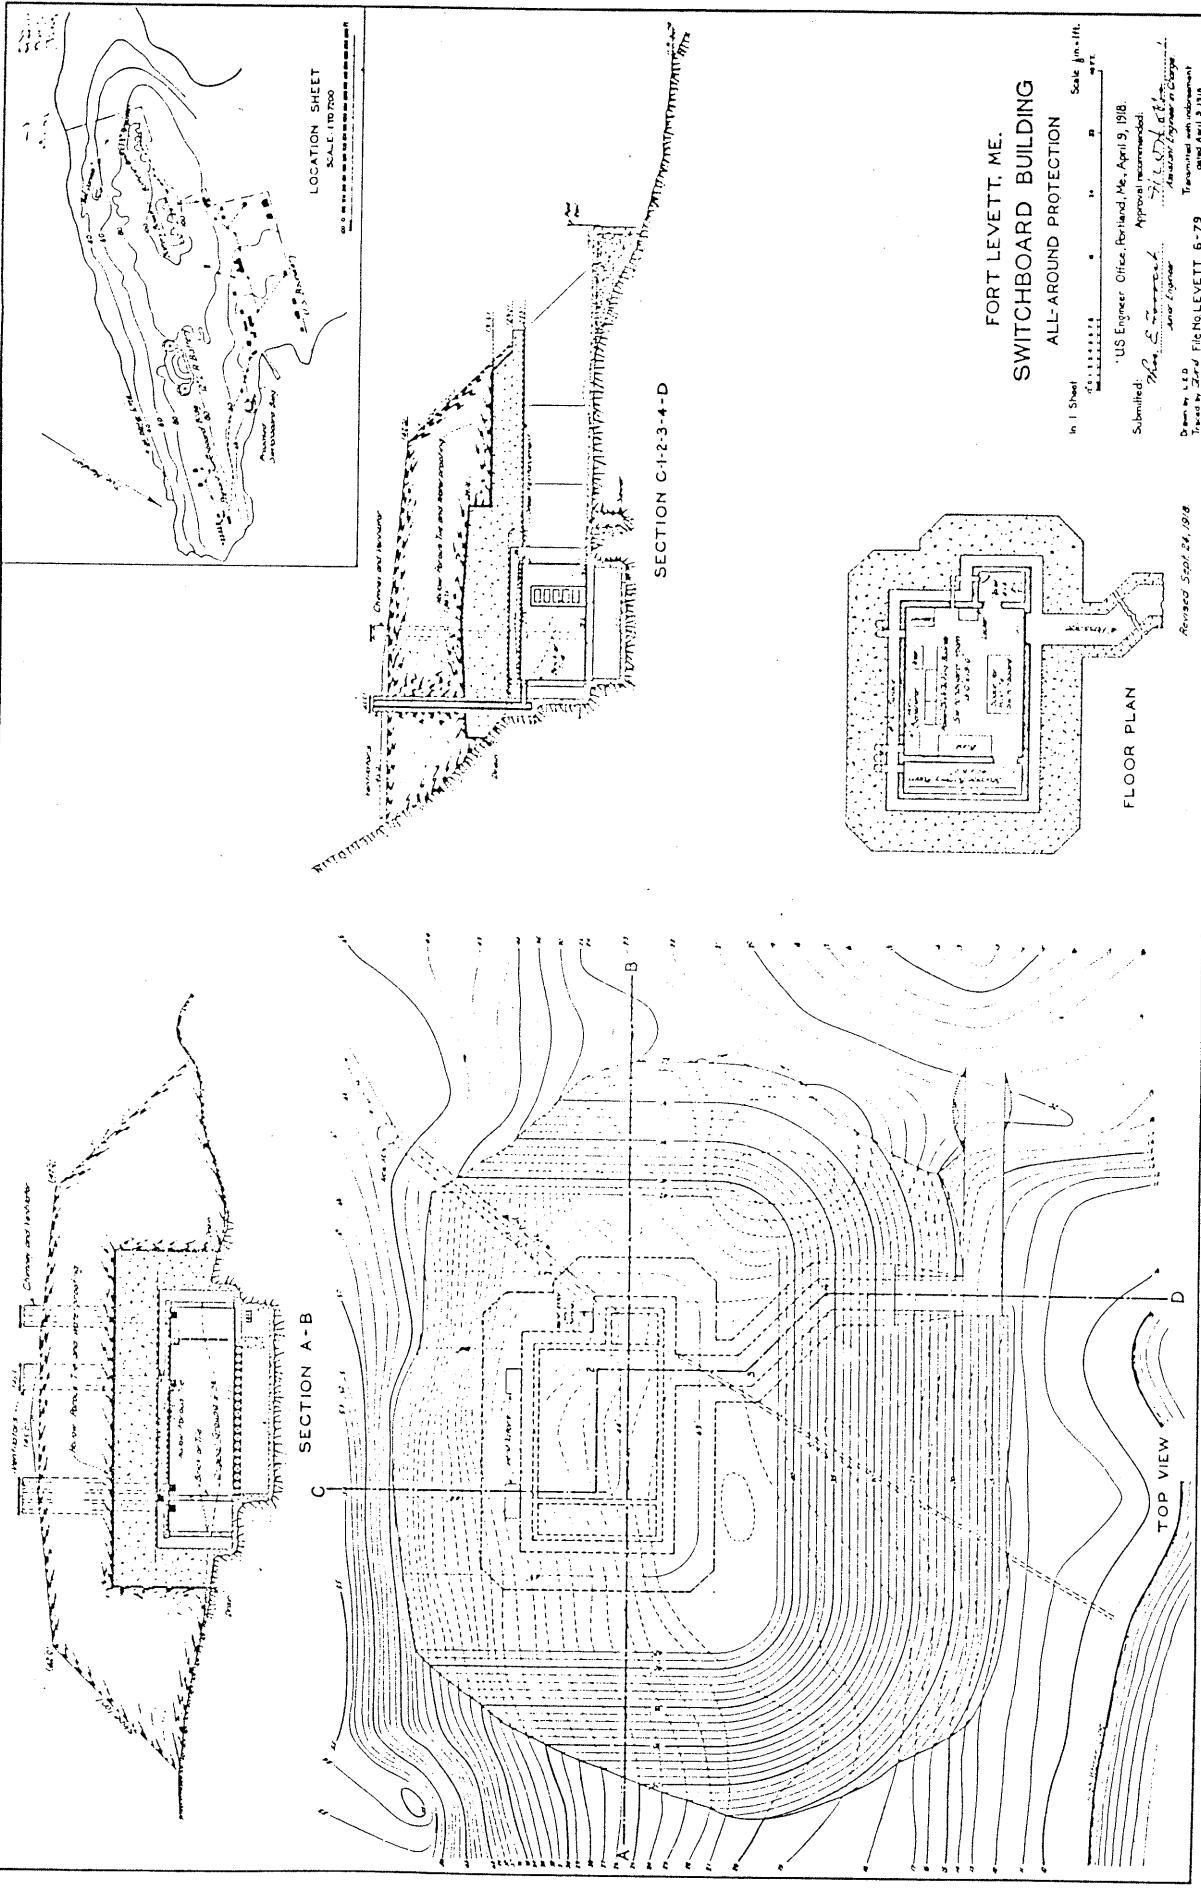

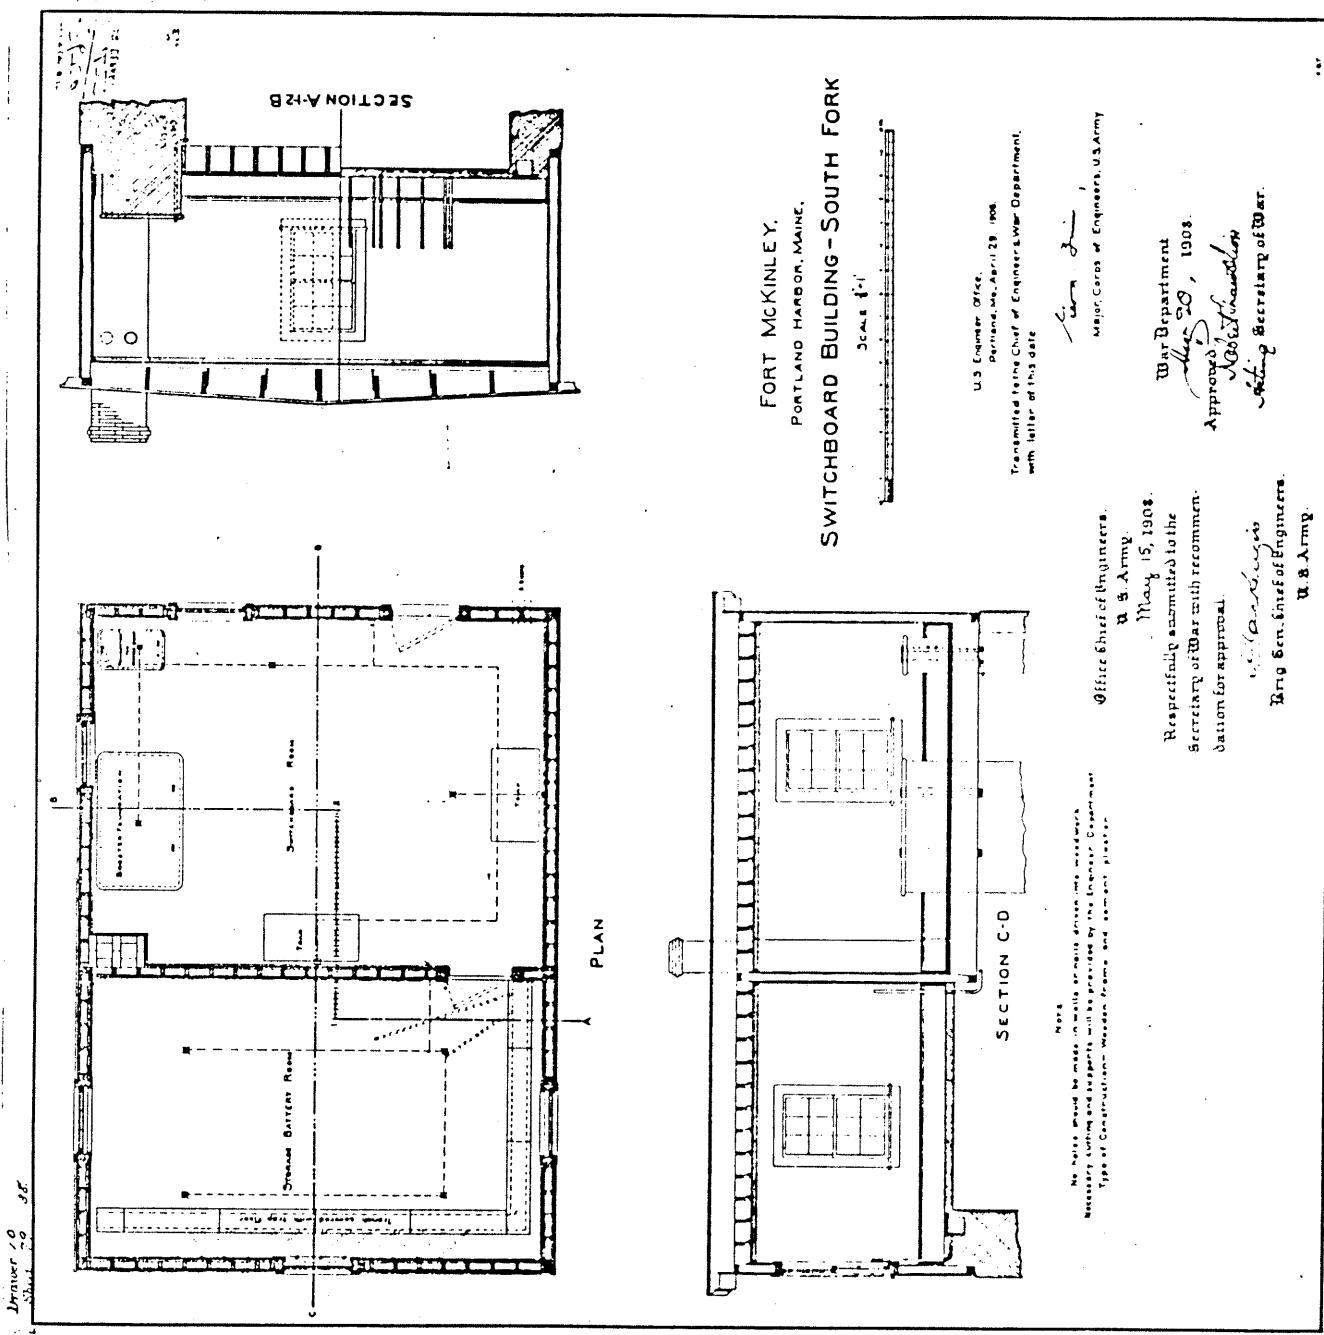


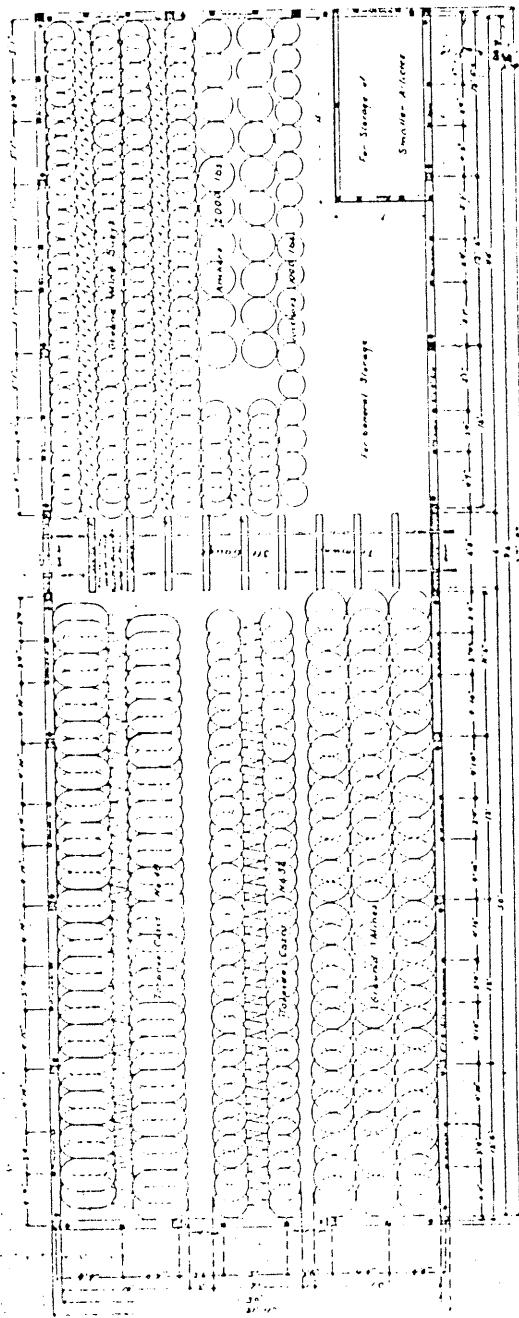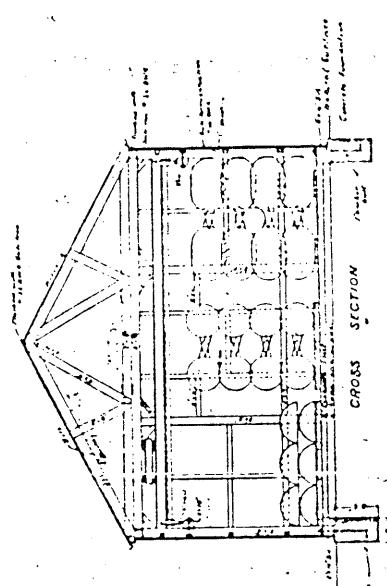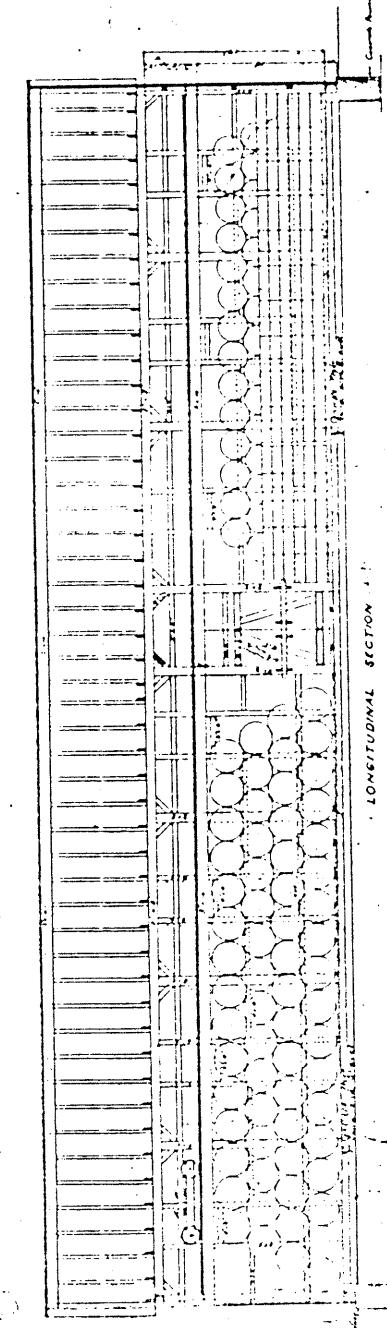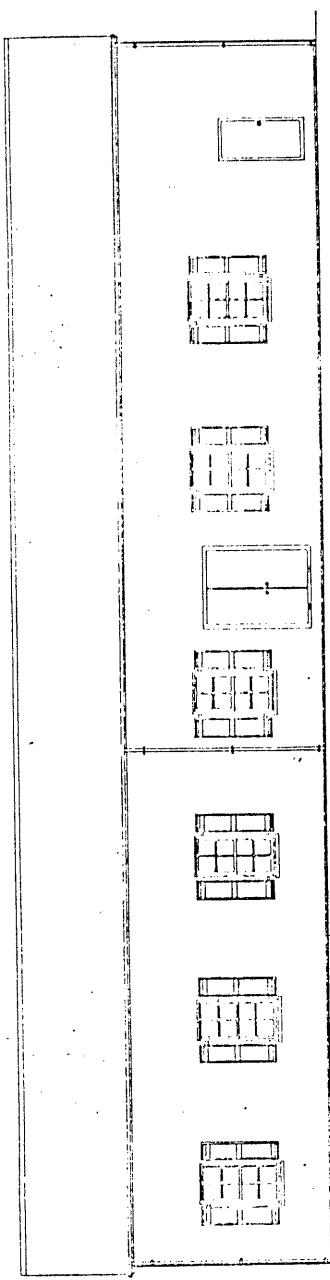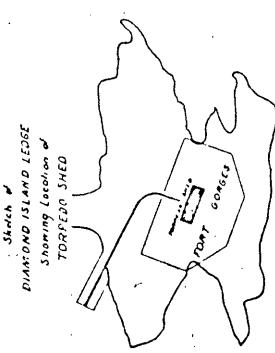



TORPEDO SHED
FORT GORGES, PORTLAND, ME.

Scale 1 inch = 5 feet

U.S. Engineer Office
Portland Maine, September 1st, 1897.
Transmitted by Board of Engineers, U.S.A. with their kind permission
Major General Officers, U.S.A.

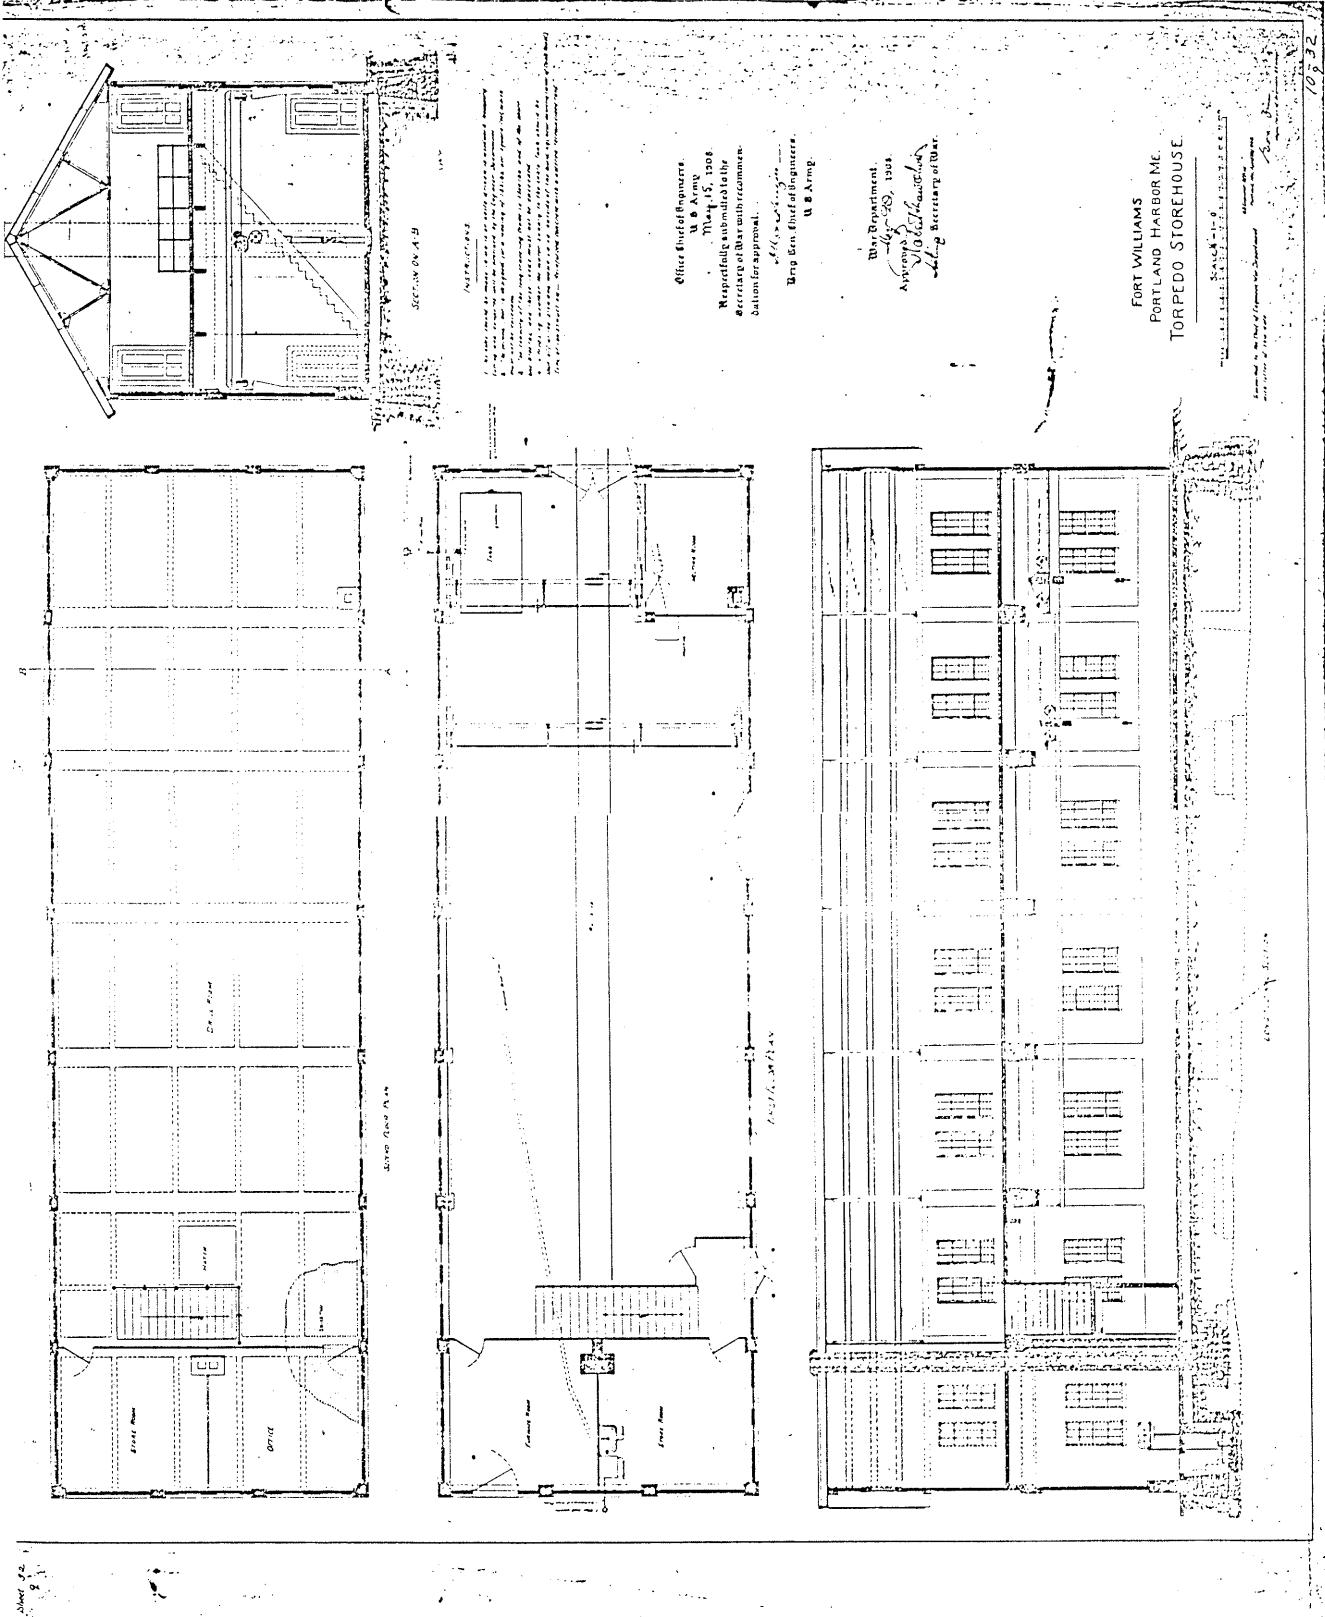

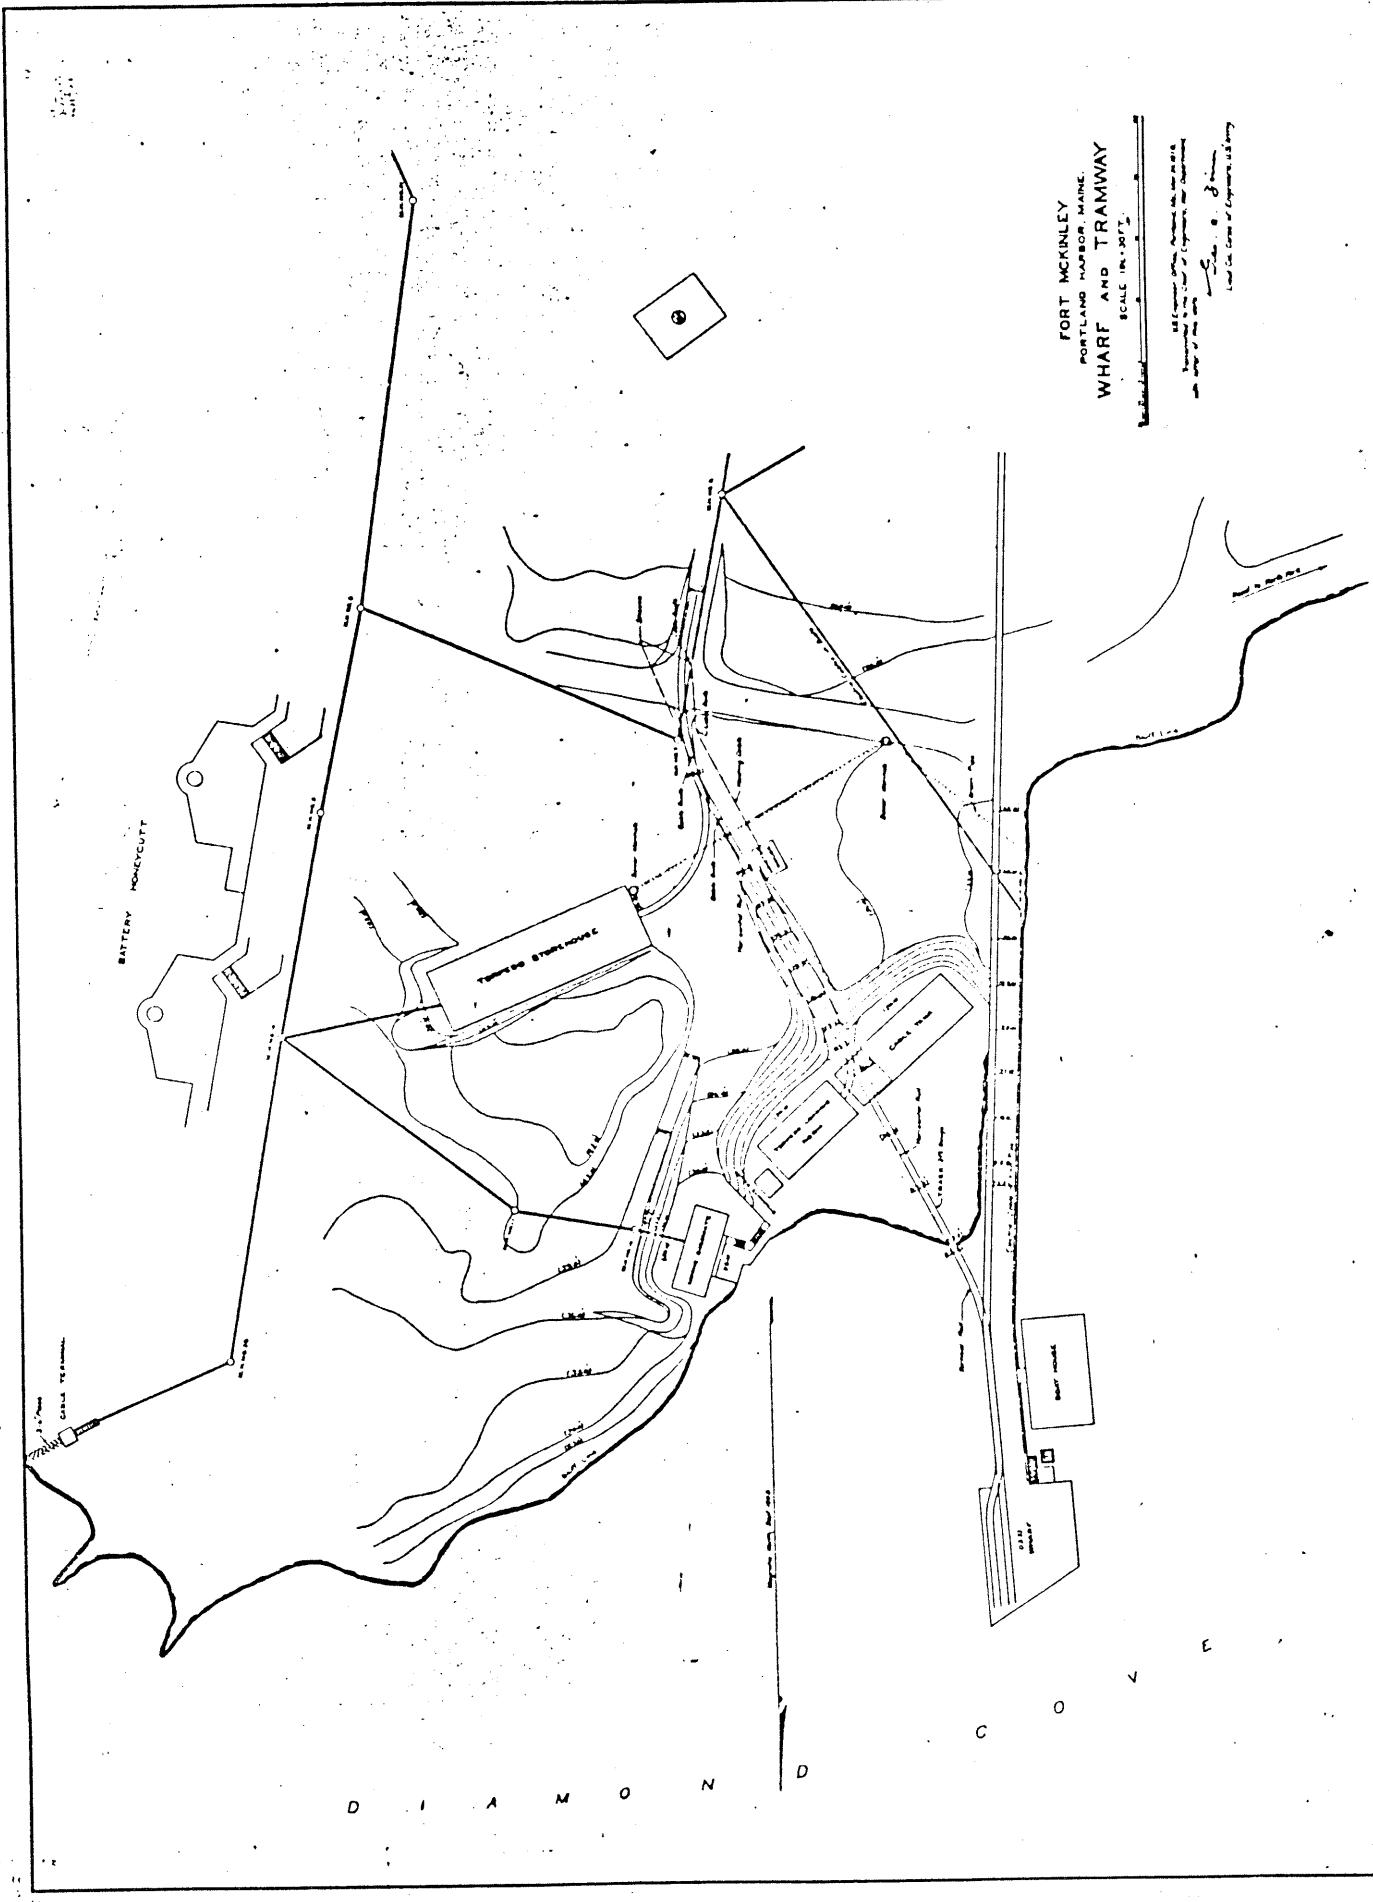

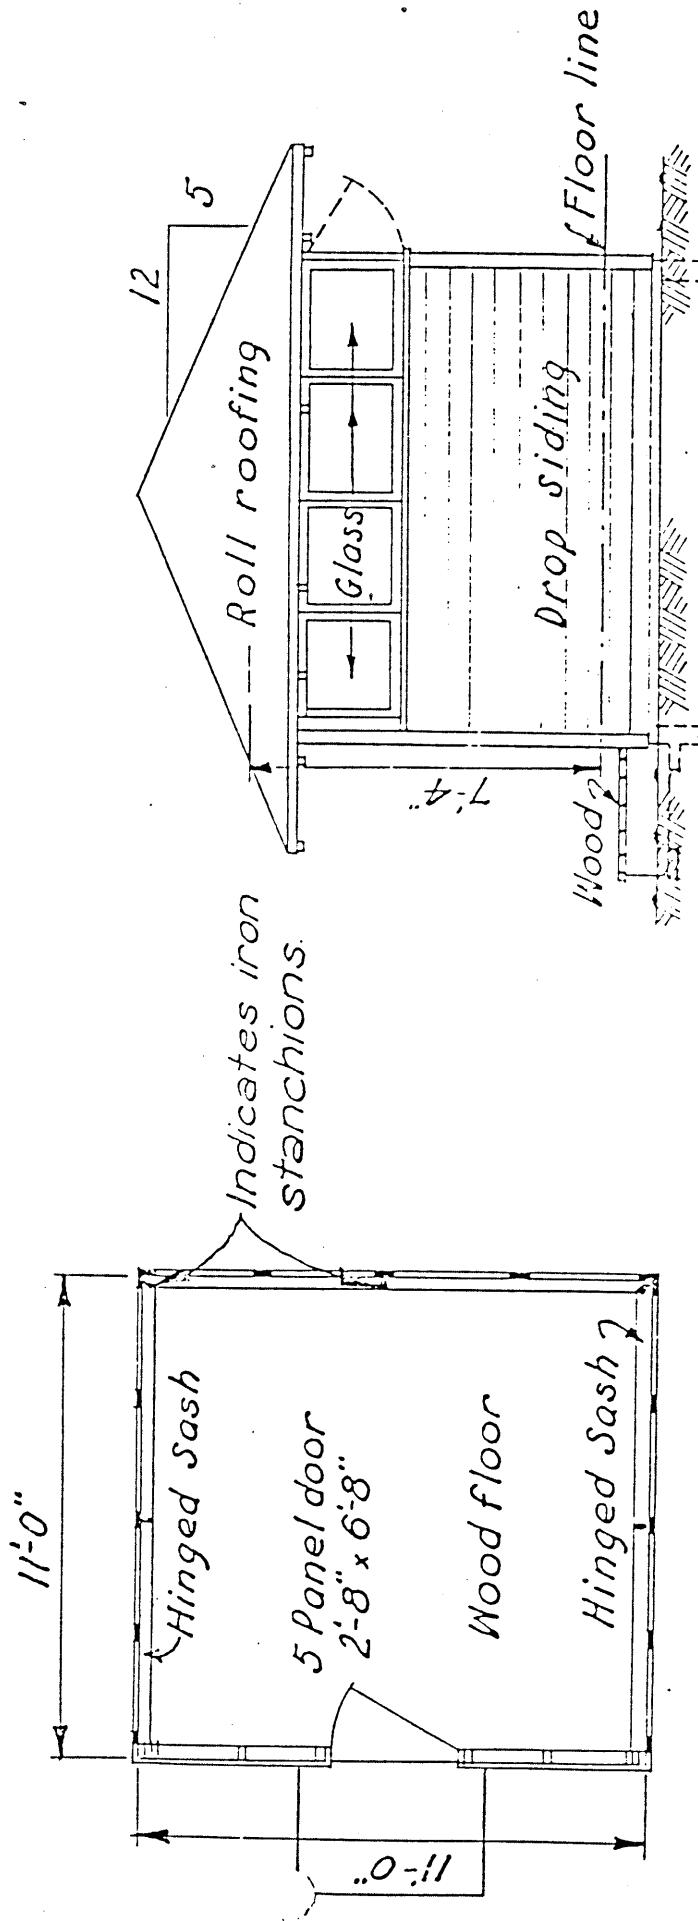

ELEVATION

B.C. STATION

PLAN

SCALE

4	0	4	8	12	16 FT.
---	---	---	---	----	--------




Location No. 160. Site 961.


ALT 8

109


SECTION - ONE

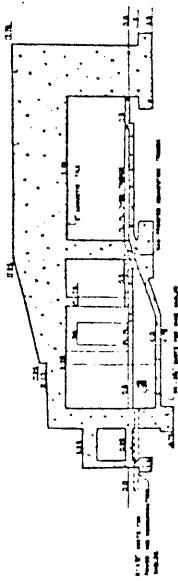


2

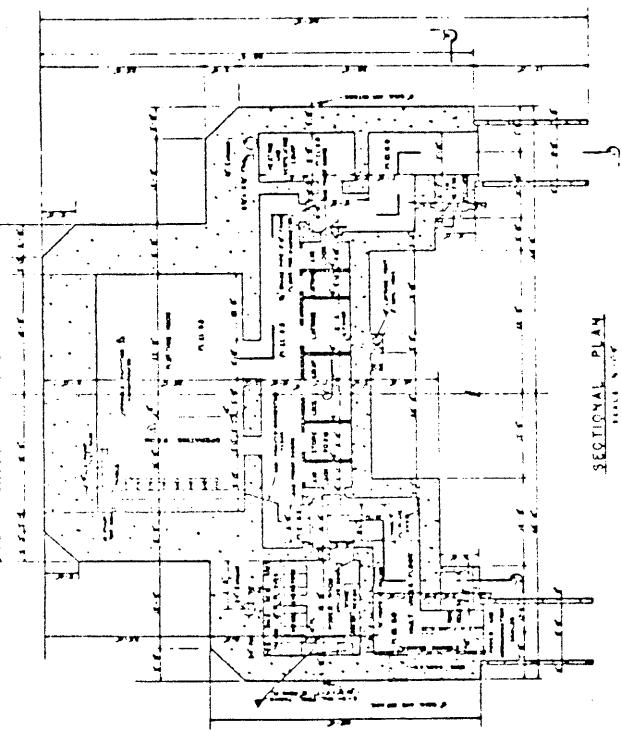


SECTION - A-2

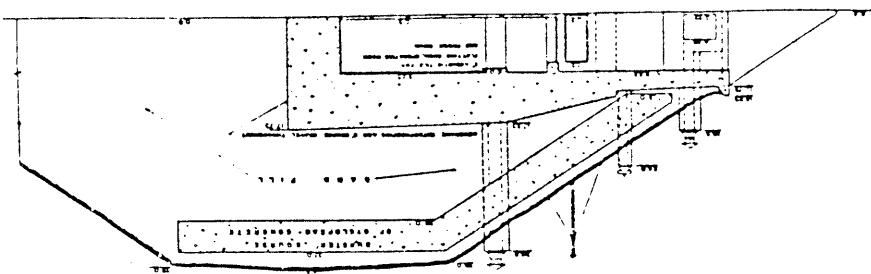

NOTE

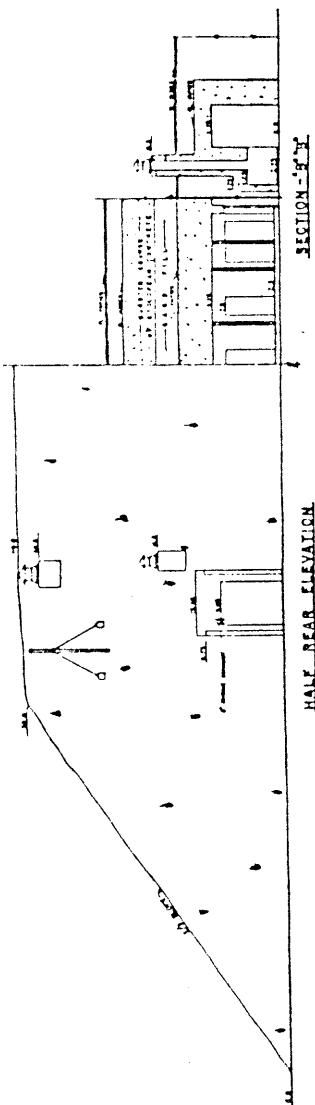

HALF TOP PLATE

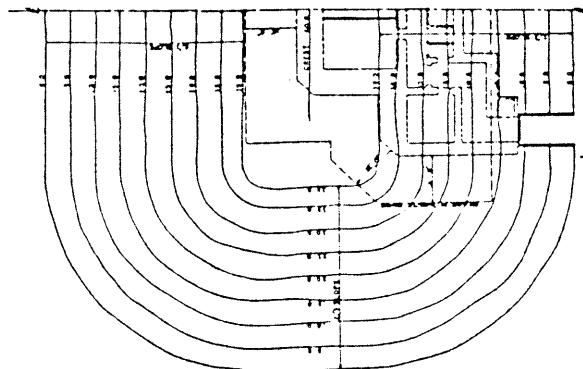


MINE CASE STATEMENT





WAR DEPARTMENT

CORPS OF ENGINEERS, U. S. ARMY

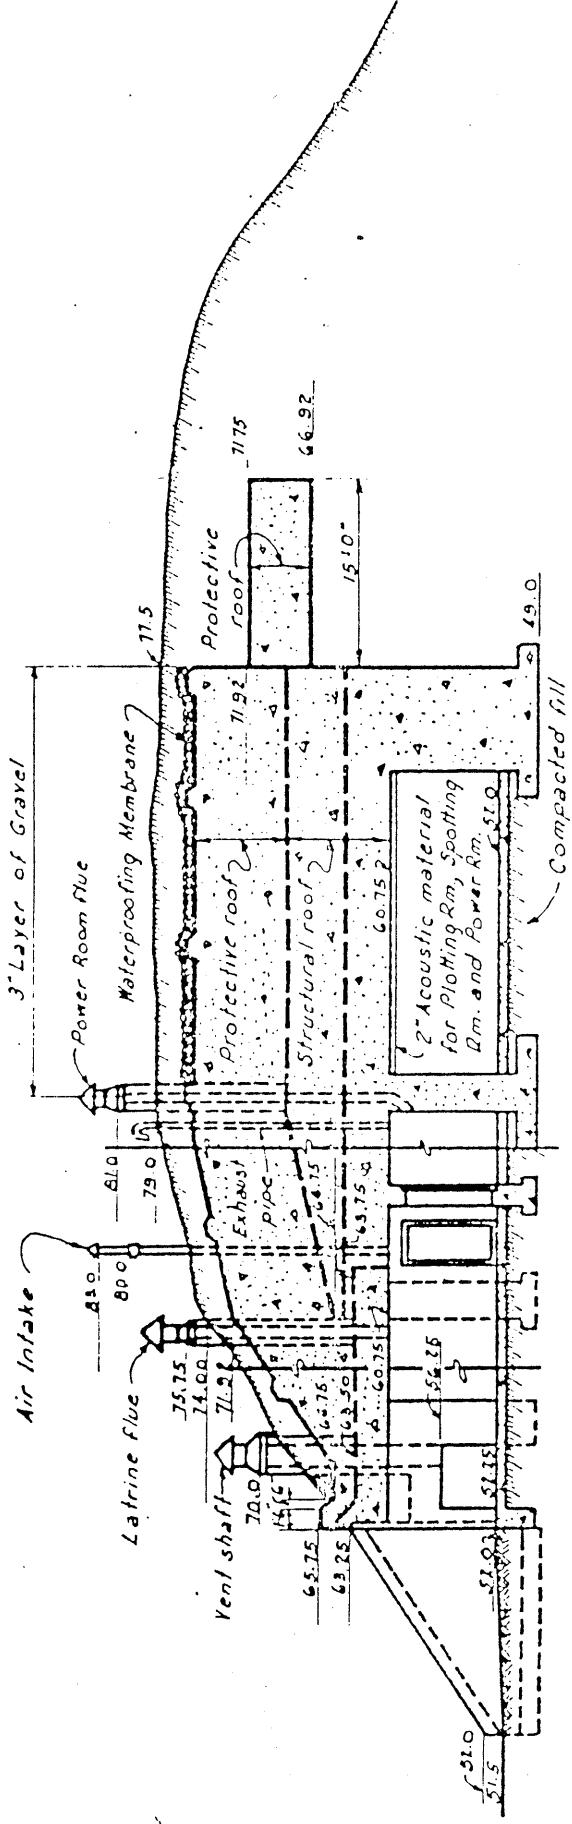

SECTION A - A

110

HARBOR DEFENSES OF L. I. SOUND
PLOTTING ROOM
BATTERY DUNN
10'
0
10'
20'


CAMP HERO, L.I.
NEW YORK

WAR DEPARTMENT

CORPS OF ENGINEERS, U. S. ARMY




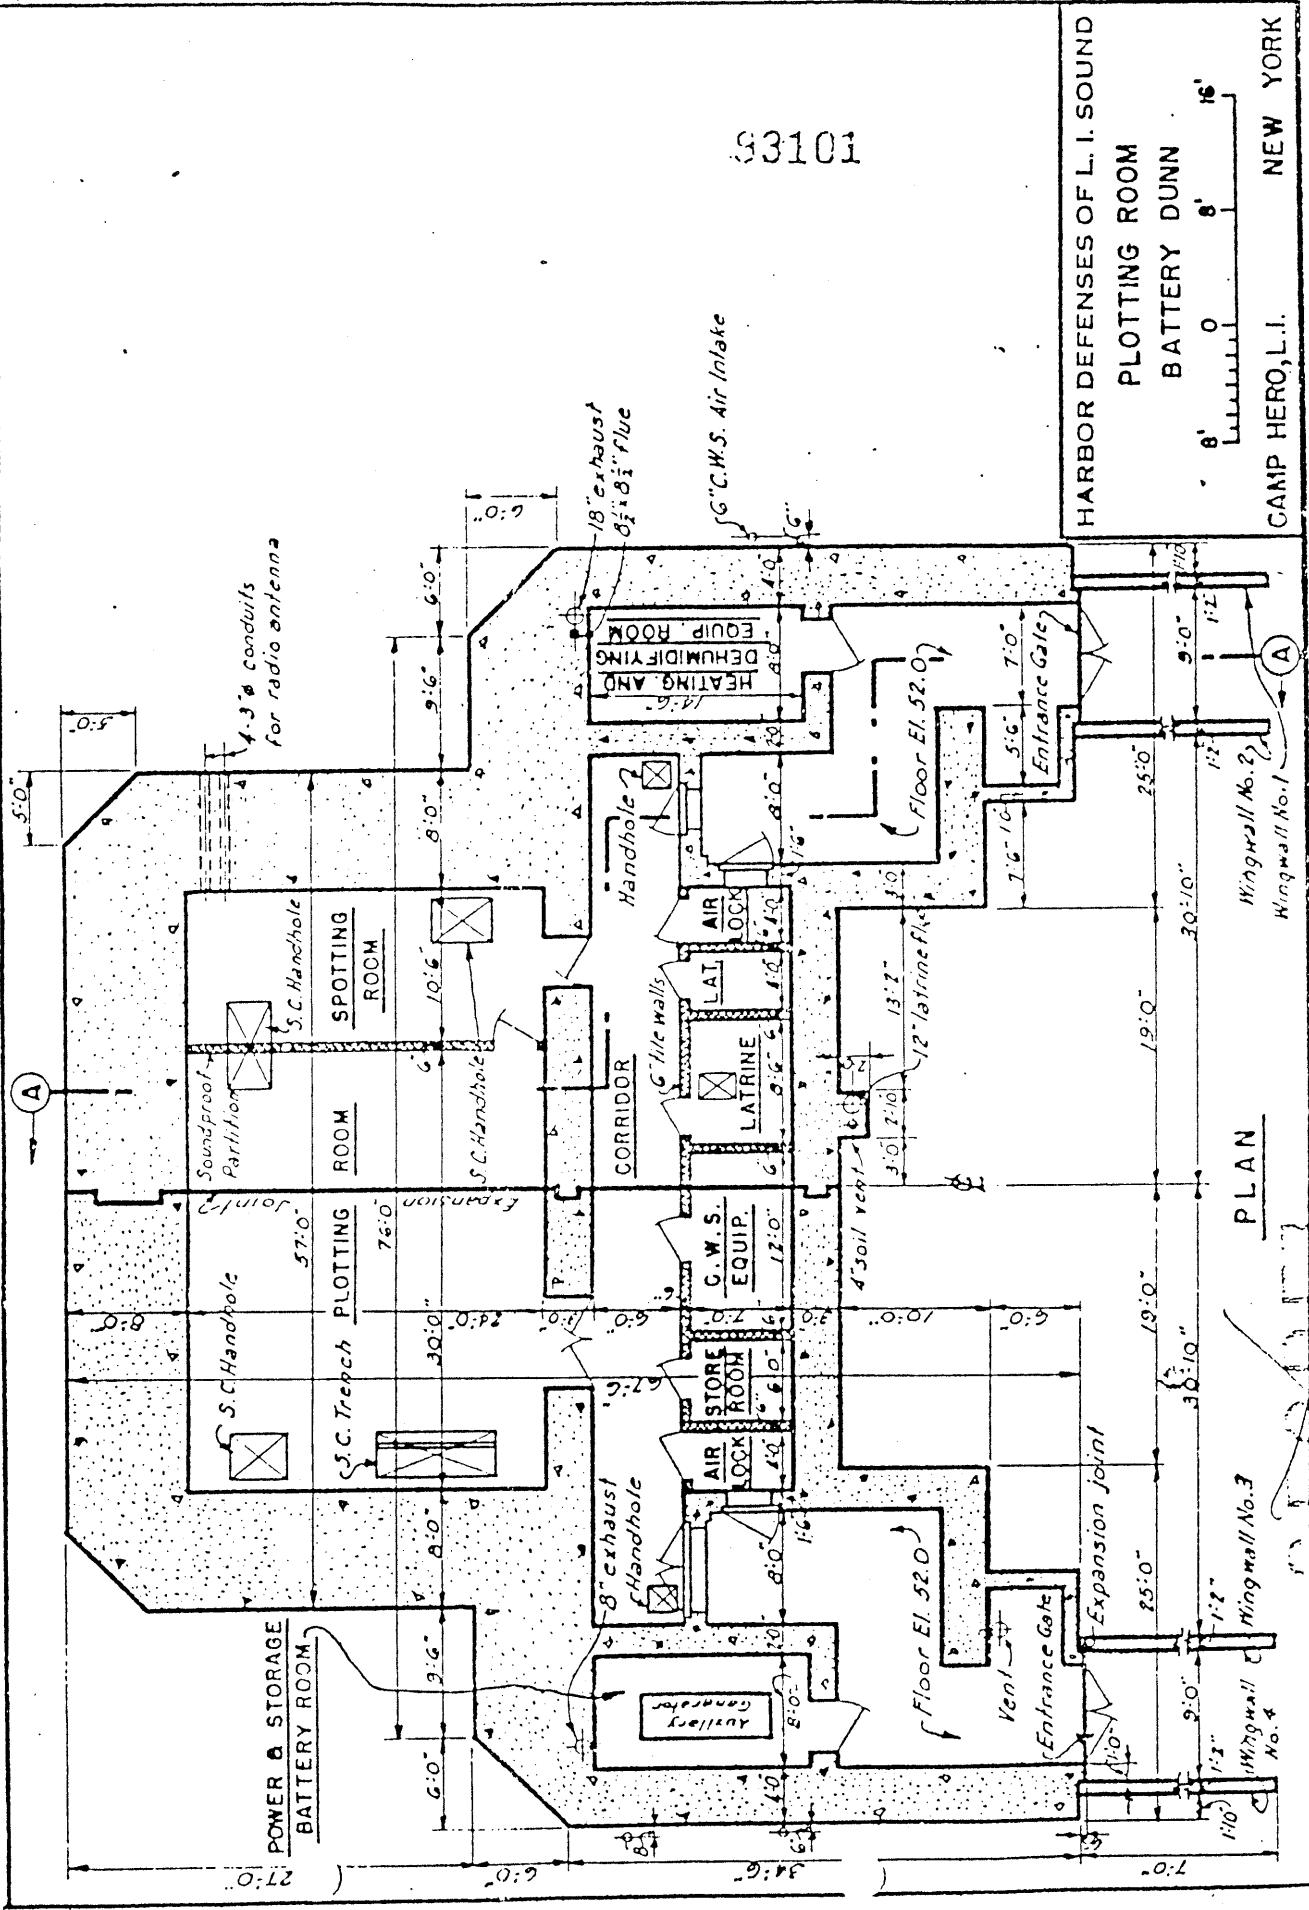

WAR DEPARTMENT

CORPS OF ENGINEERS U.S. ARMY

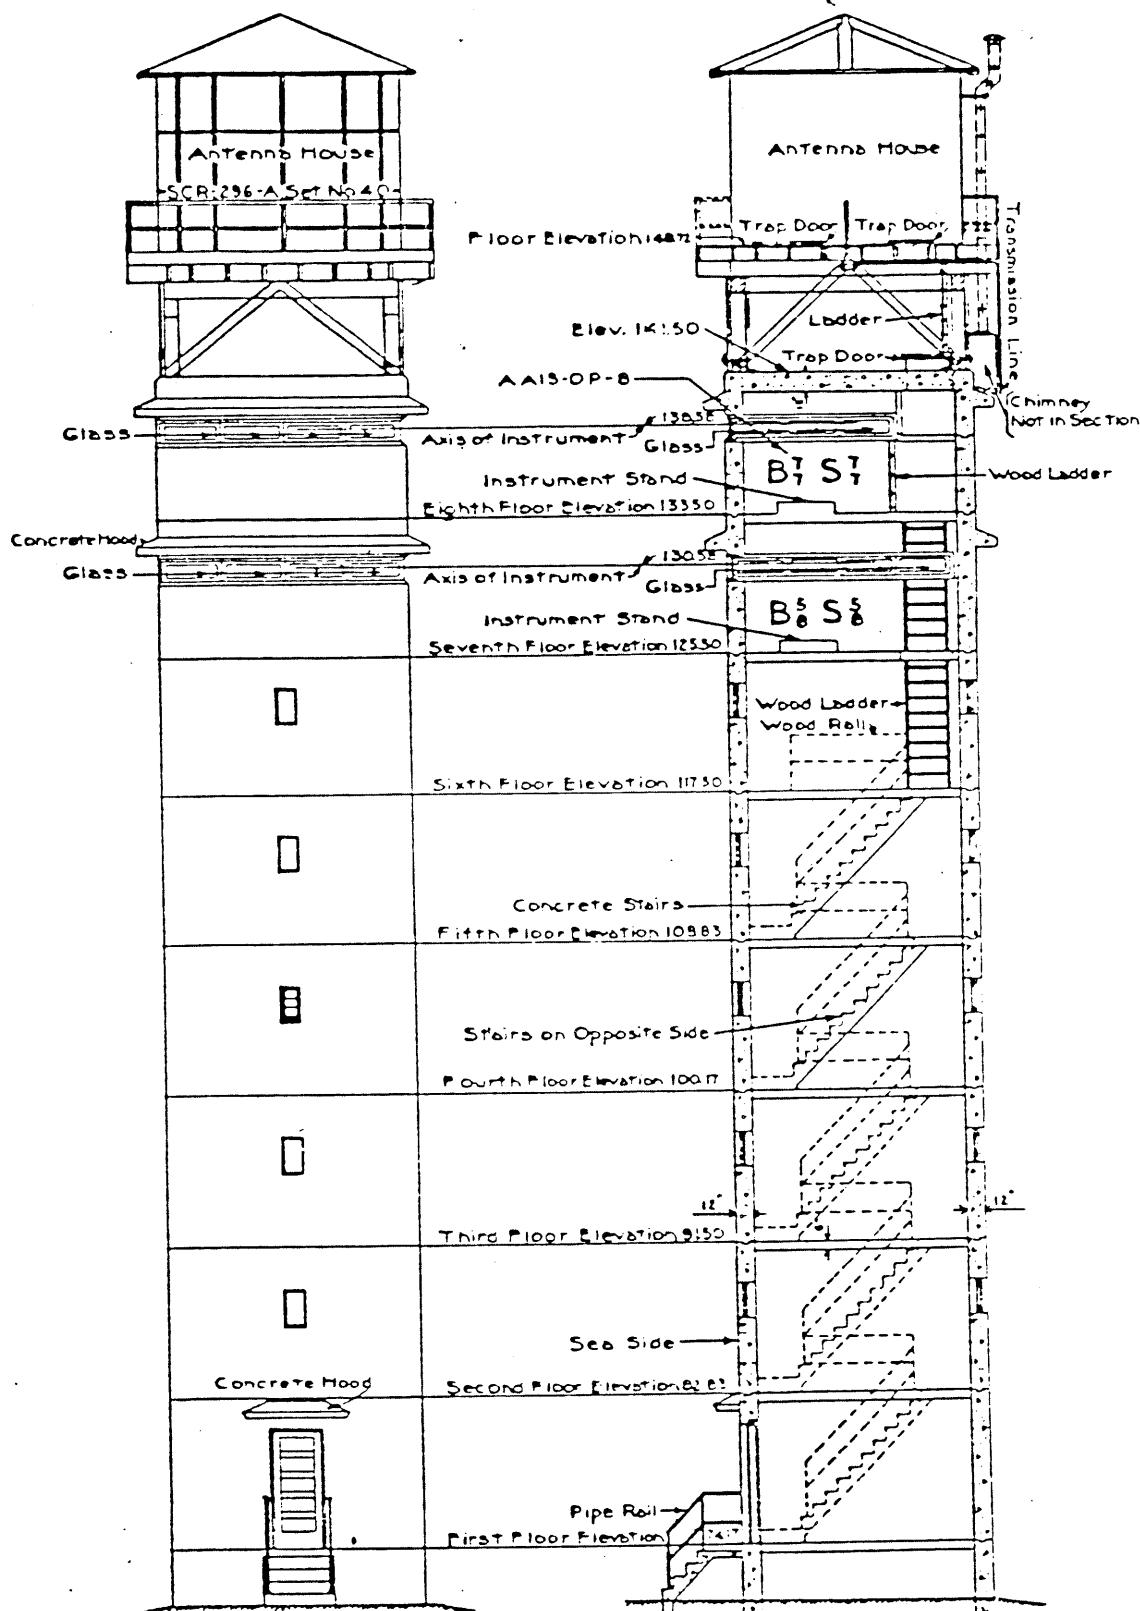

SECTION AA

SCALE 0 1 2 3 4 5 10 15

(Sheet 2 of 2 Sheets)


Sheet 1

REPORT OF CONTINUED WORKS - SEACOAST FORTIFICATIONS
 (Fire Control or Submarine Mine Structure)


CORRECTED TO 21 September 1943

PART II

HARBOR DEFENSES OF Portsmouth, New Hampshire
Cape Neddick Location No. 151 Site 1A
STRUCTURE Observation Tower
Elevations and Section

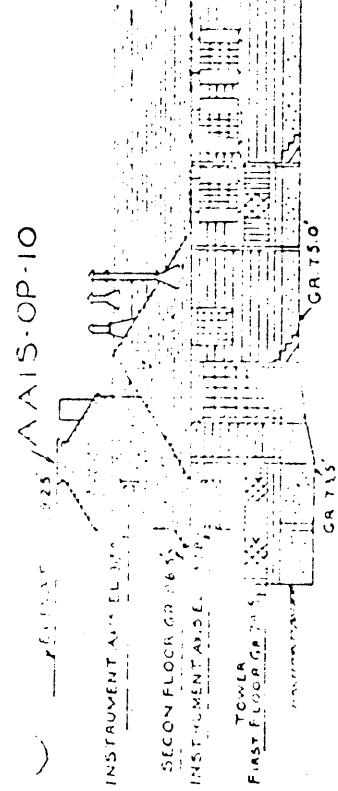


NORTH ELEVATION

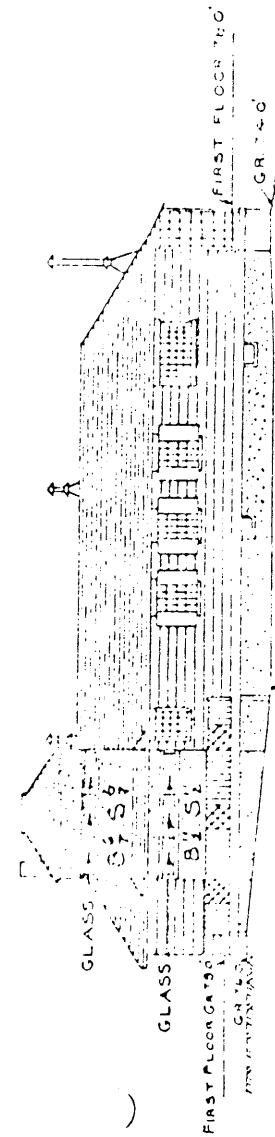

ELEVATION TOWARD OCEAN

SCALE
 5 10 15 20 25 30 35

LOCATION NO 151 SITE 1A

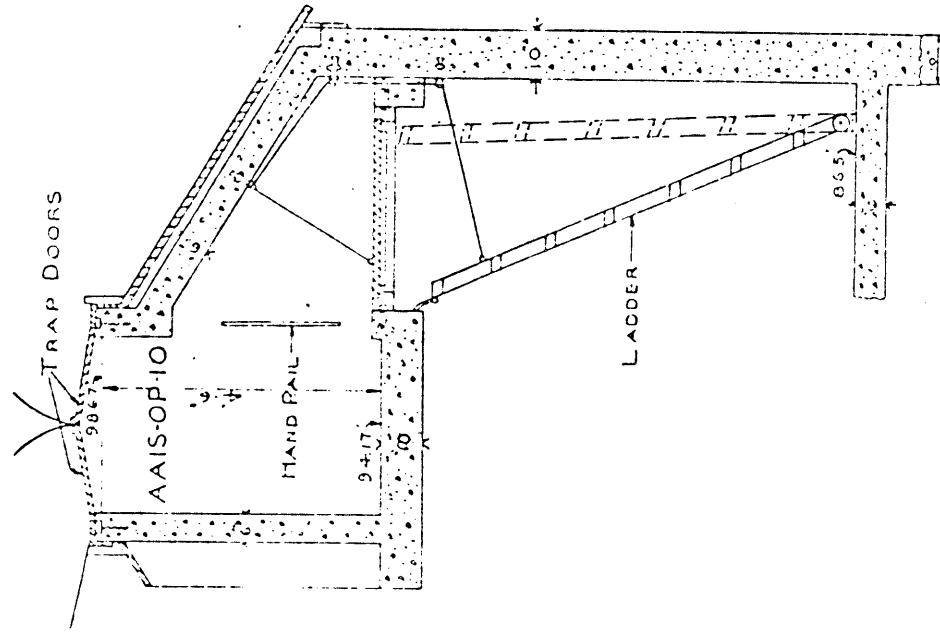

TOWER LOOKOUT
 SCALE
 0 1 2 3 4 5 6

REVIEW OF COMPLETED WORKS - SEACOAST FORTIFICATIONS
(Fire Control or Torpedo Stations)


Location No. 143, Site 1B.

Corroded to 19 May 1943

Shoot 2 of 2 shoots

HARBOR DEFENSES OF PORTSMOUTH, NEW HAMPSHIRE
Fort Foster - Gorrell Island - Portsmouth Harbor
Structure Quesnay Tower - 6 Stories
Station Assignments. BC7-OP / BC7-CP

Form 2 Corroded to 19 May 1943


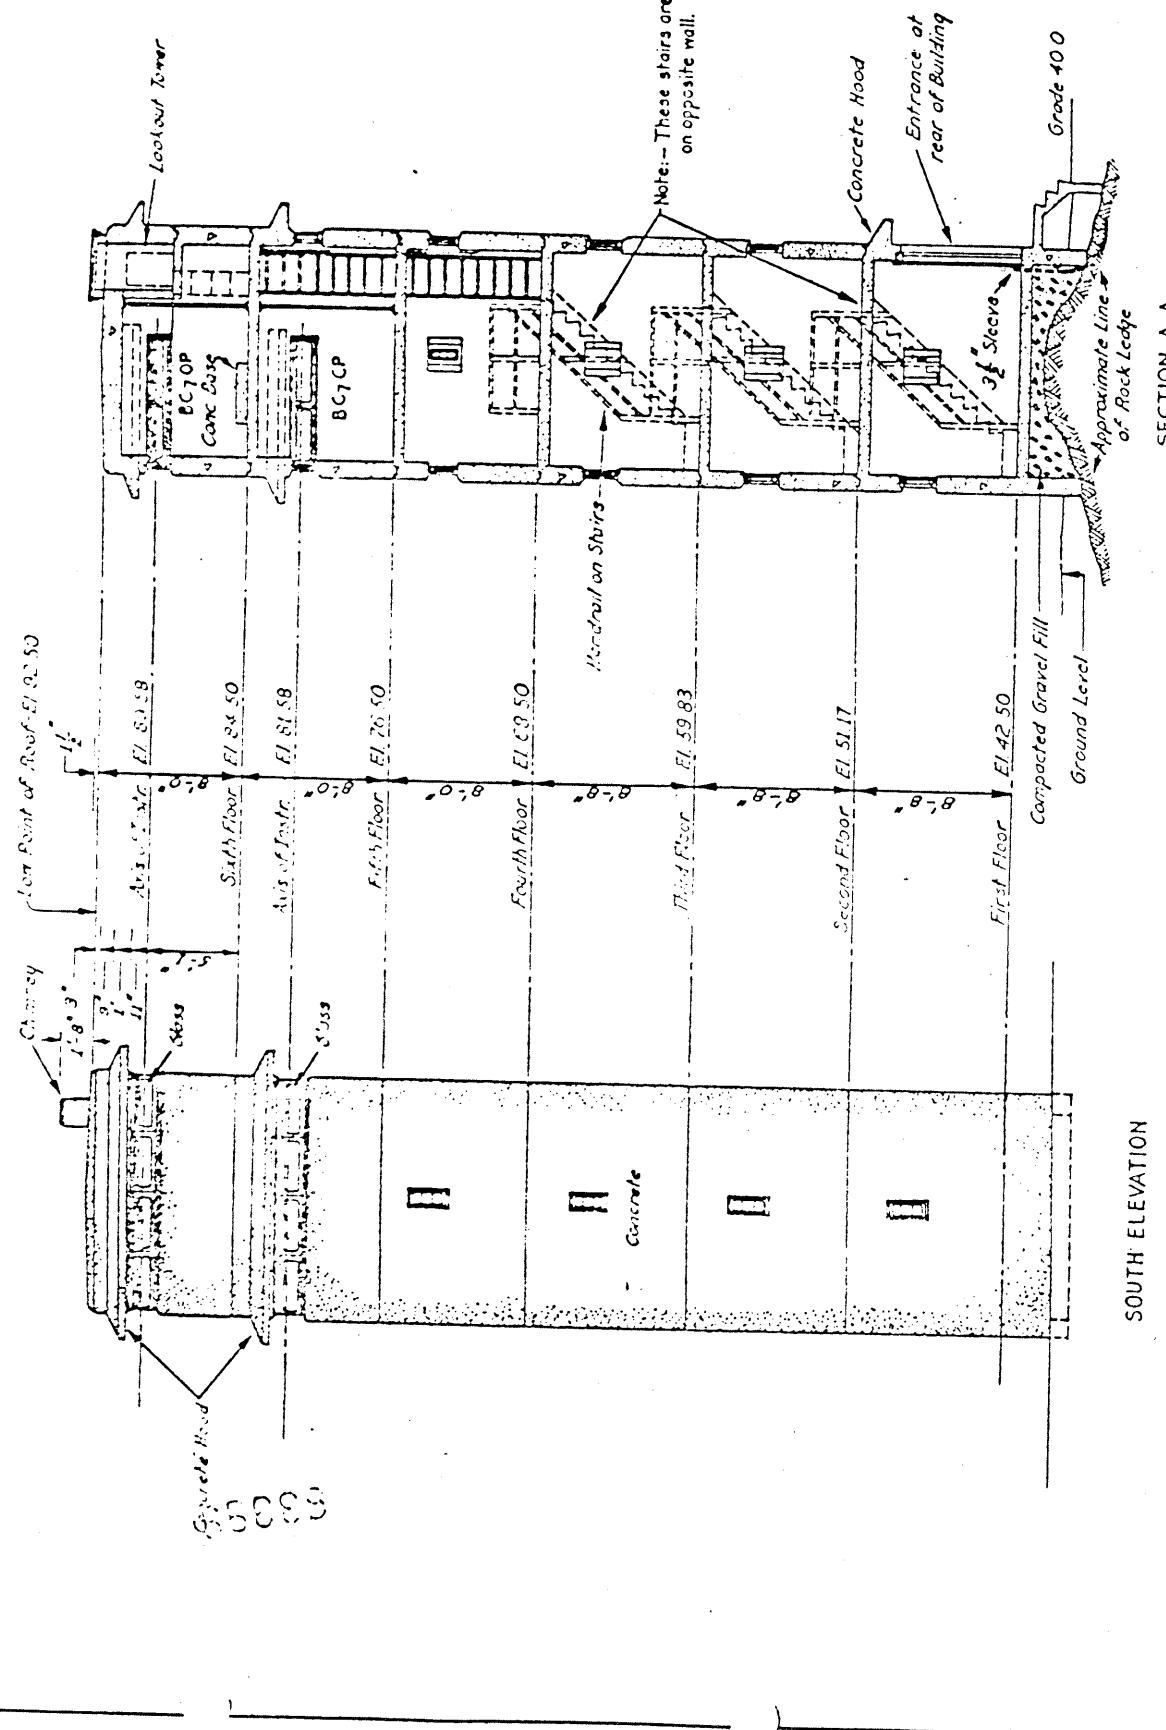


SOUTH ELEVATION

SECTION A-A


CORPS OF ENGINEERS, U.S. ARMY

WAR DEPARTMENT

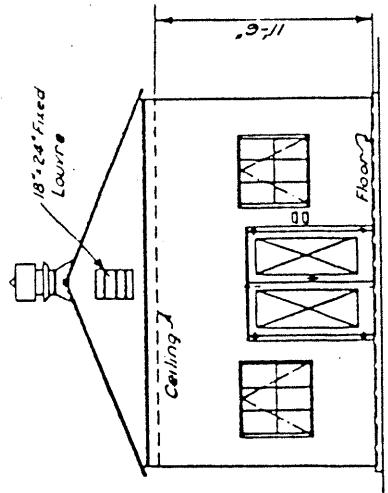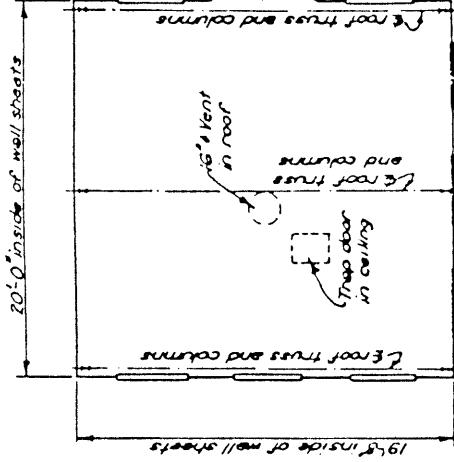

HOUSE, HO-2-A

SCALE 0 TO FLEET

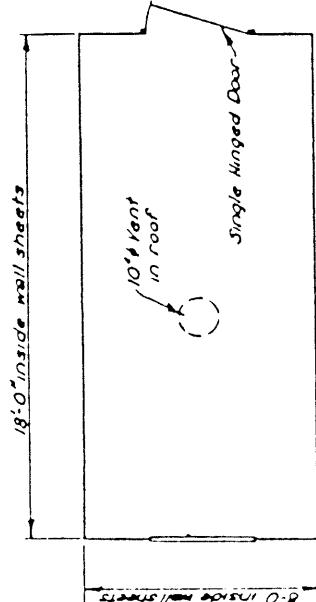


END ELEVATION

HOUSE, HO-1-A

SCALE 0 TO FLEET

NOTES
HO-1-A and HO-2-A buildings are reinforced
concrete sheet metal on structural steel frames,
with walls and ceiling for HO-2-A having 1" insulation.
HO-1-A and HO-2-A buildings have conc. floors.
Steel towers have an elevator running down from the
ground to a platform 10' below entrance. Access
to antennae house from platform is by ladder.




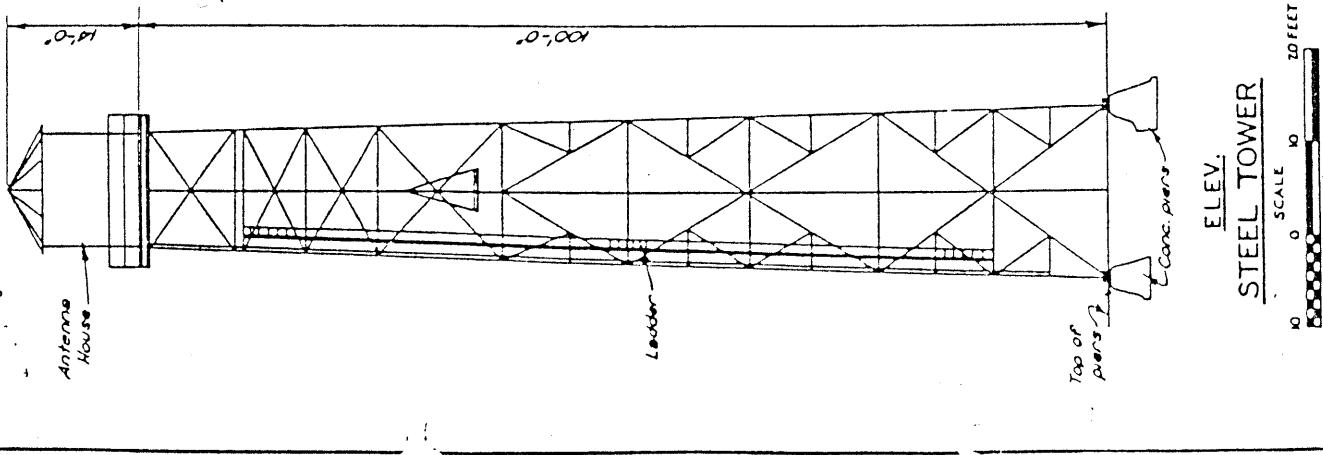


SCALE 0 TO FLEET

Plan and Elevations
Operations Building, SCR-296A

Location 127, Set #26
Fort Dunes-Deer Island

(Sheet 4 of 4 sheets)

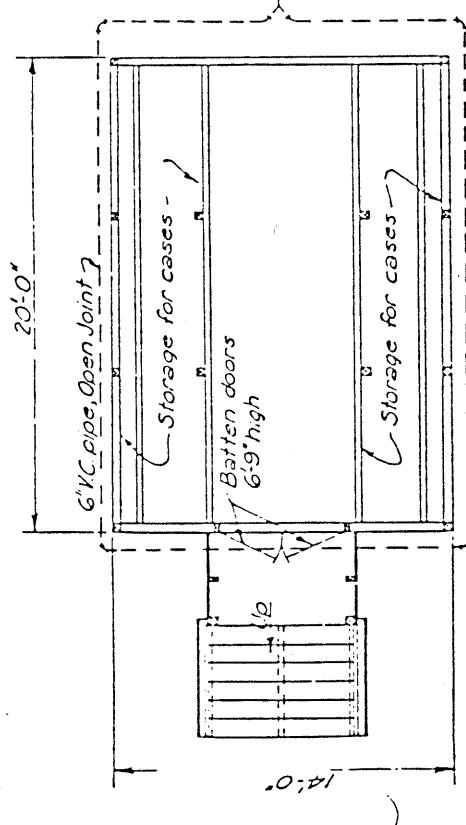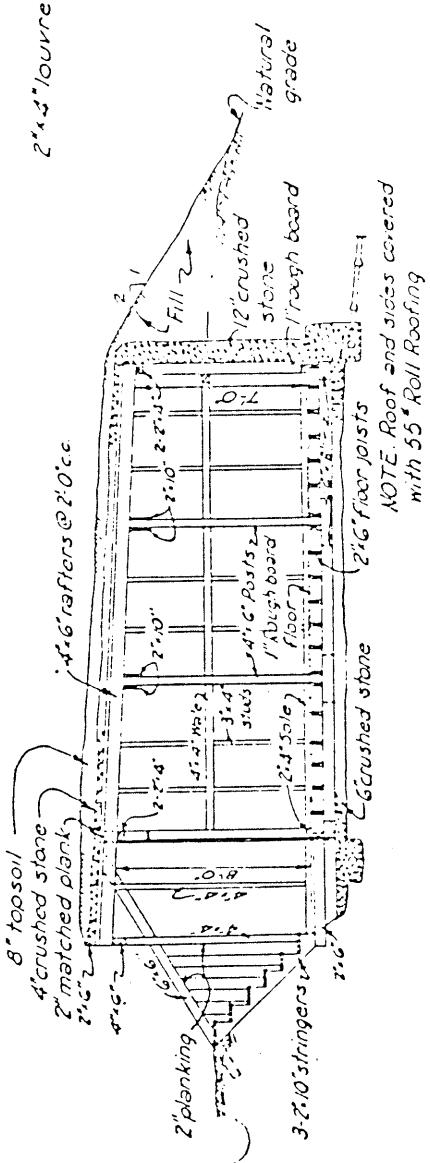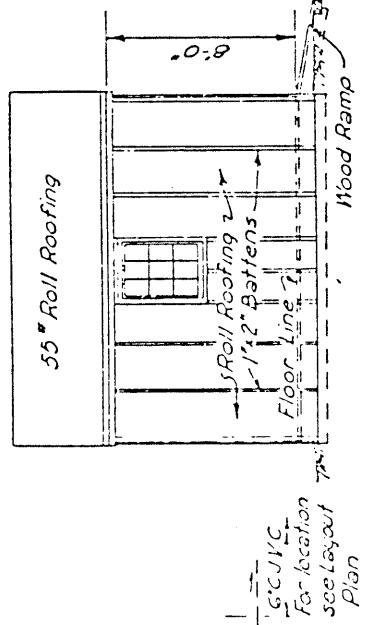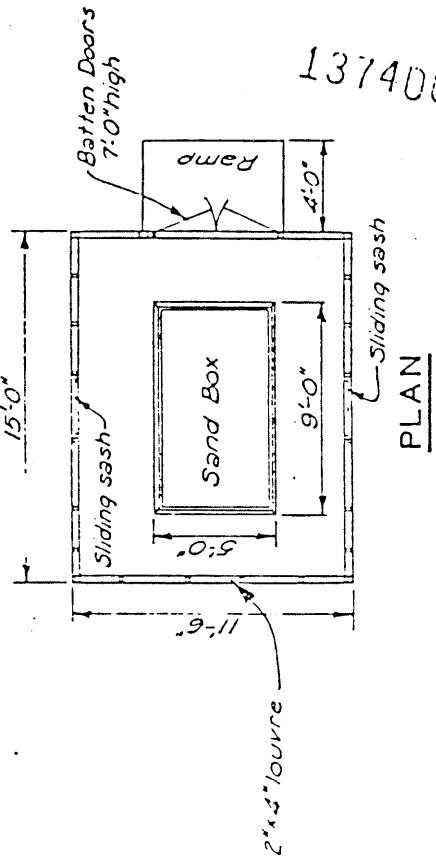SECTIONAL ELEVATIONUNDERGROUND STORAGEFRONTGENERATOR BUILDING

Underground Storage and
Generator Building

AUTB

SCALE 0 5 10 15 FEET

Location No. 160. Site 961.

(Sheet 4 of 5 Sheets)

and,

Me.

Annex 4--PHOTOGRAPHS OF REPRESENTATIVE STRUCTURES

Endicott and Taft Periods, 1891-1916


Administration Building, 1911, Fort Williams, Cape Elizabeth, Me.
Bachelor Officers Quarters, 1909, Fort Williams, Cape Elizabeth, Me.
Bakery, 1910, Fort Williams, Cape Elizabeth, Me.
Band Stand, ca. 1911, Fort Williams, Cape Elizabeth, Me.
Barracks, 1902, Fort Williams, Cape Elizabeth, Me.
Battery Commander's Sta., 1905, Btry. Bowdoin, Ft. Levett, Cushing Island, Me.
Double Non-Commissioned Officers Qtrs., 1909, Ft. Williams, Cape Elizabeth, Me.
Double Non-Commissioned Officers Qtrs., 1909, Ft. Williams, Cape Elizabeth, Me.
Double Officers Quarters, 1901, Fort Williams, Cape Elizabeth, Me.
Fire Station, 1911, Fort Williams, Cape Elizabeth, Me.
Guard House, 1911, Fort Williams, Cape Elizabeth, Me.
Hospital, 1901, Fort Williams, Cape Elizabeth, Me.
Hospital Steward's Quarters, 1901, Fort Williams, Cape Elizabeth, Me.
Officers Quarters, 1902, Fort Williams, Cape Elizabeth, Me.
Post Exchange, 1904, Fort Williams, Cape Elizabeth, Me.
Post Gymnasium, 1908, Fort Williams, Cape Elizabeth, Me.
Quartermaster Storehouse & Office, 1910, Fort Williams, Cape Elizabeth, Me.

World War I and the Inter-War Period, 1917-1938


Combined Range Finding Station, 1909, Peaks Island, Me.
Disappearing Searchlight, 1921, Peaks Island, Me.
Observation Tower, 1921, Trundy Point, Cape Elizabeth, Me.
Quartermaster Garage, 1921, Fort Williams, Cape Elizabeth, Me.
Searchlight Shelter, 1921, Fort Foster, Kittery, Me.
Searchlight Powerhouse, 1921, Peaks Island, Me.
War Department Theater, 1938, Fort McKinley, Great Diamond Island, Me.

World War II, 1939-1945

Barracks, 1941, Fort Williams, Cape Elizabeth, Me.
Battery Cravens, 1944, Peaks Island, Me.
Battery 201, 1944, Cape Elizabeth, Me.
Company Administration and Storehouse, 1941, Fort Williams, Cape Elizabeth, Me.
Double Mine Control Station, 1944, Peaks Island, Me.
Double Mine Control Station, 1944, Fort Levett, Cushing Island, Me.
Framework, Camouflage Net, Btry. Kendrick, 1943, Ft. Levett, Cushing Is., Me.
Generator Building, Radar Station, 1944, Long Island, Me.
Mine Casemate, 1944, Peaks Island, Me.
90mm Gun Block, AMTB Battery, 1943, Fort Levett, Cushing Island, Me.
Observation Tower, 1944, Fort Levett, Cushing Island, Me.
Observation Tower, 1944, Prout's Neck, Scarborough, Me.
Observation Tower, 1944, Long Island, Me.
Officers Quarters and Mess, 1941, Fort Williams, Cape Elizabeth, Me.
Plotting, Switchboard and Radio Room, Battery Steel, 1944, Peaks Island, Me.
Range Finder Station and Magazine, AMTB Battery, 1943, Peaks Island, Me.

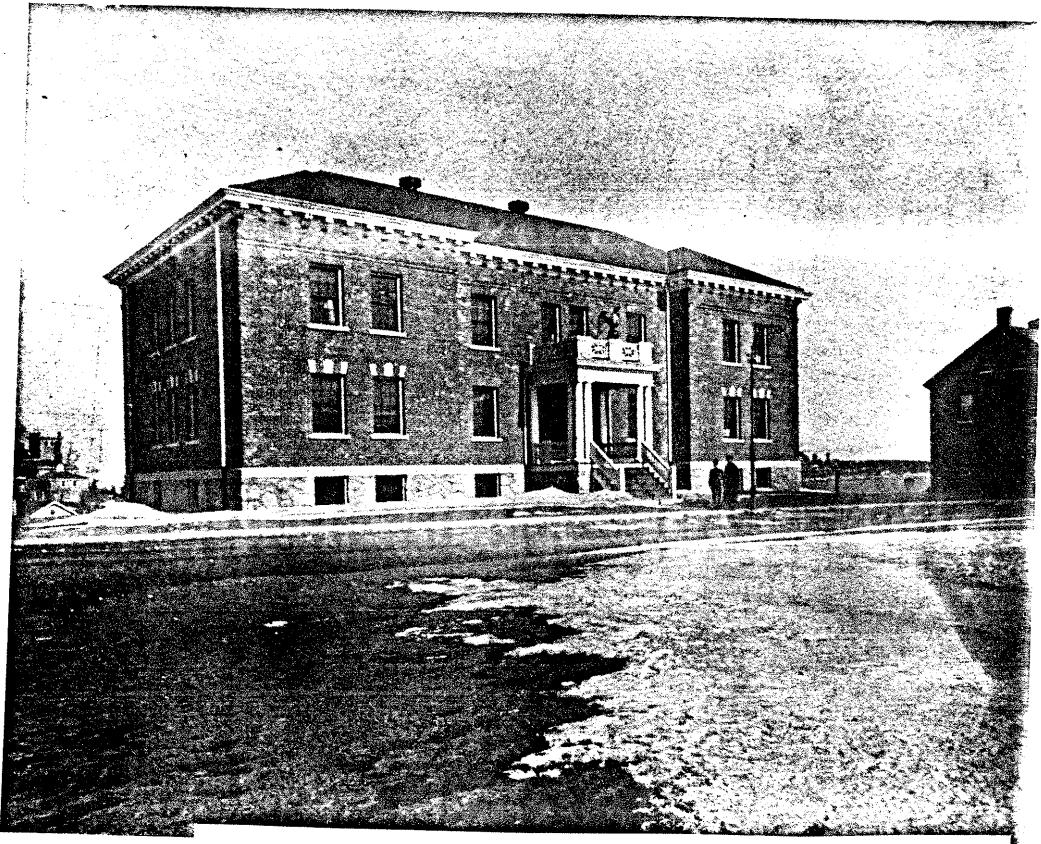

Administration Building, 1911, Fort Williams, Cape Elizabeth, Me.

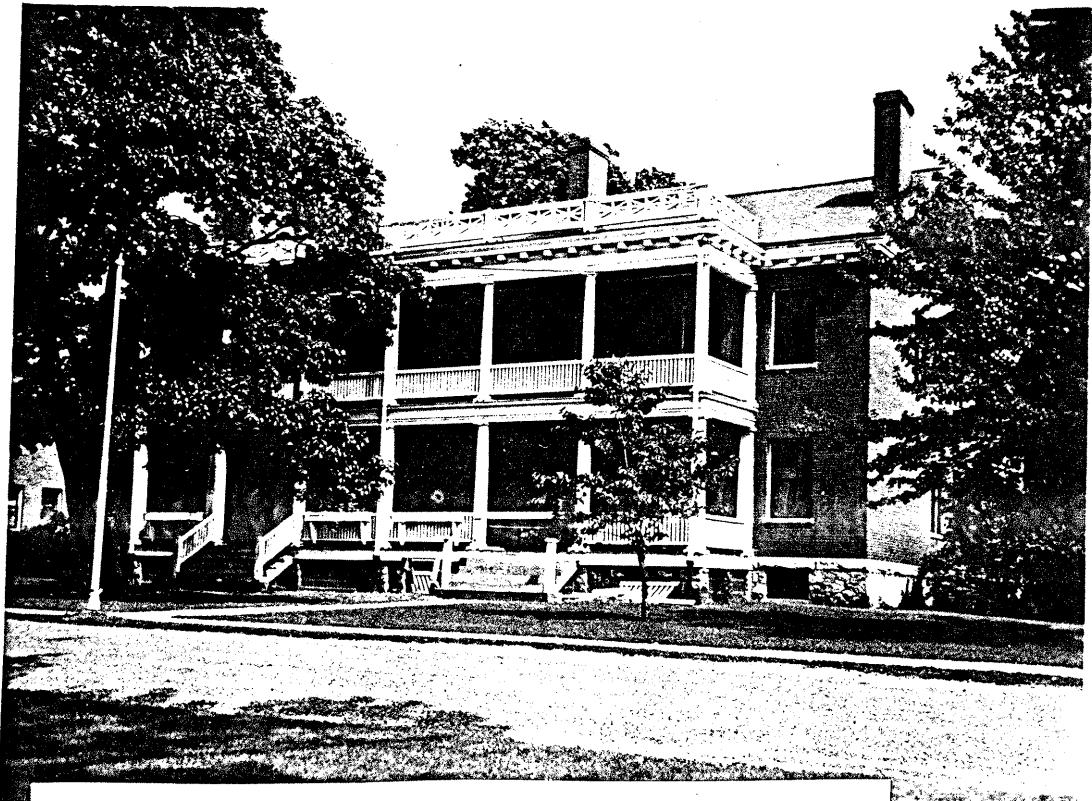

Bachelor Officers Quarters, 1909, Fort Williams, Cape Elizabeth, Me.




Bakery, 1910, Fort Williams, Cape Elizabeth, Me.




Band Stand, ca. 1911, Fort Williams, Cape Elizabeth, Me.



Barracks, 1902, Fort Williams, Cape Elizabeth, Me.

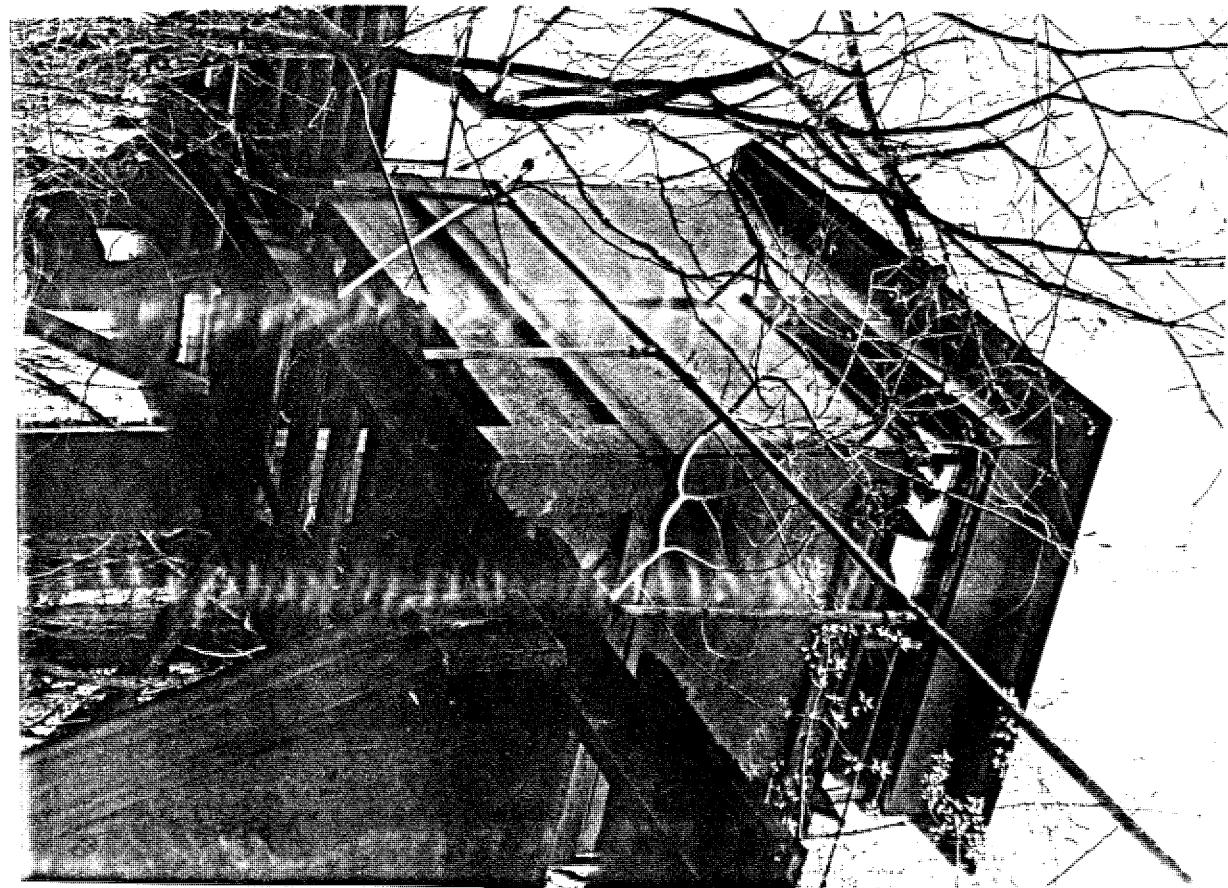

Battery Commander's Sta., 1905, Btry. Bowdoin, Ft. Levett, Cushing Island, Me.

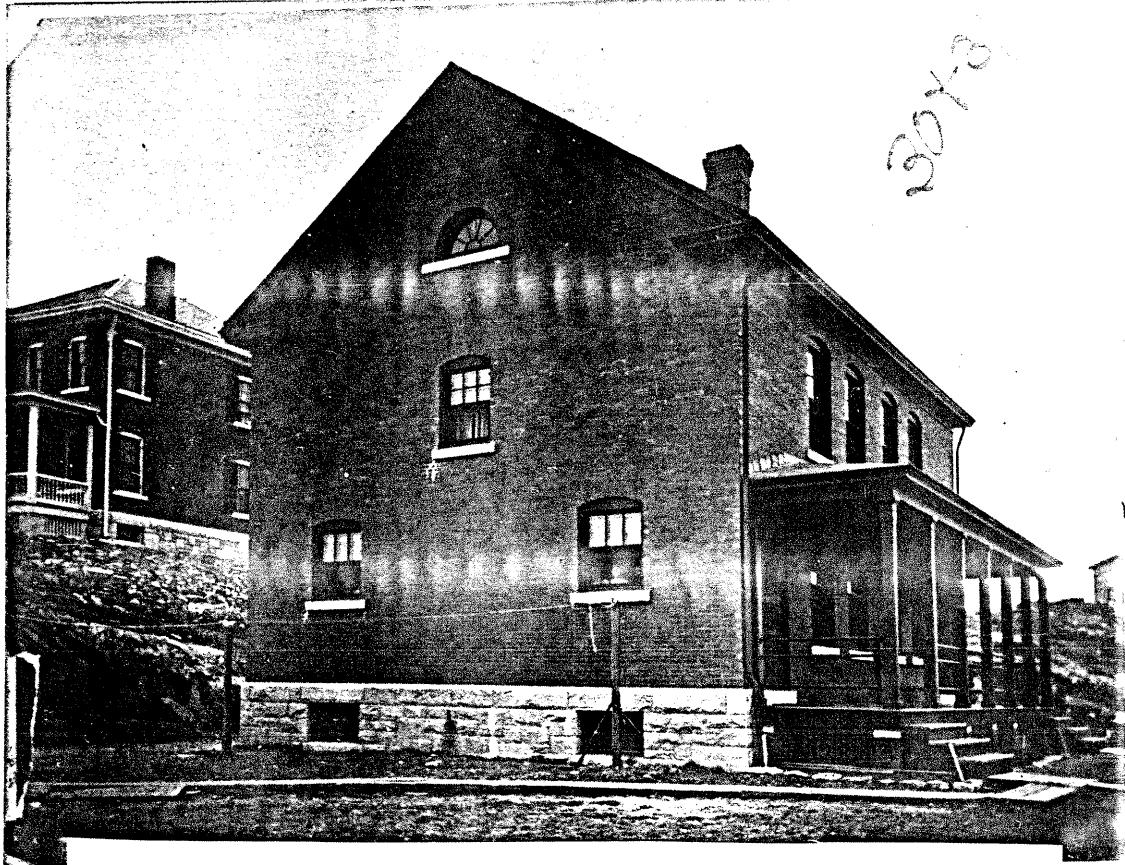

30x30

Double Non-Commissioned Officers Qtrs., 1909, Ft. Williams, Cape Elizabeth, Me.




Double Non-Commissioned Officers Qtrs., 1909, Ft. Williams, Cape Elizabeth, Me.



Double Officers Quarters, 1901, Fort Williams, Cape Elizabeth, Me.



Fire Station, 1911, Fort Williams, Cape Elizabeth, Me.

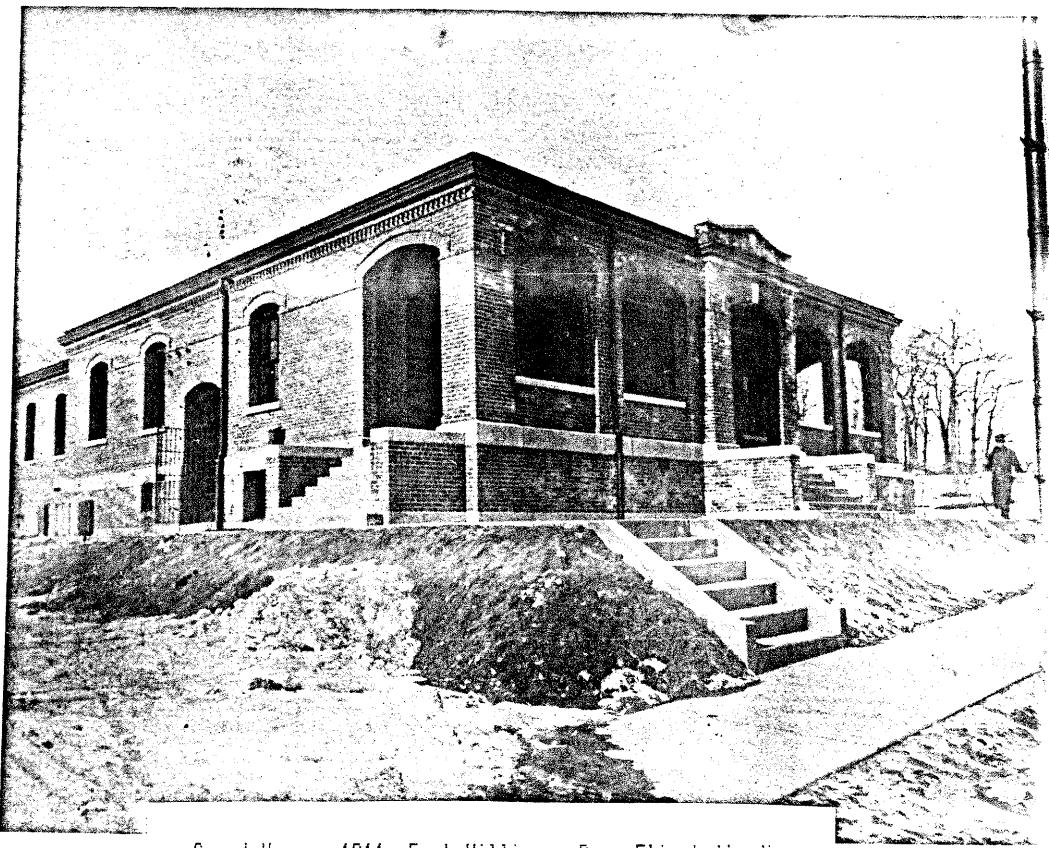


Guard House, 1911, Fort Williams, Cape Elizabeth, Me.



Hospital, 1901, Fort Williams, Cape Elizabeth, Me.



Hospital Steward's Quarters, 1901, Fort Williams, Cape Elizabeth, Me.

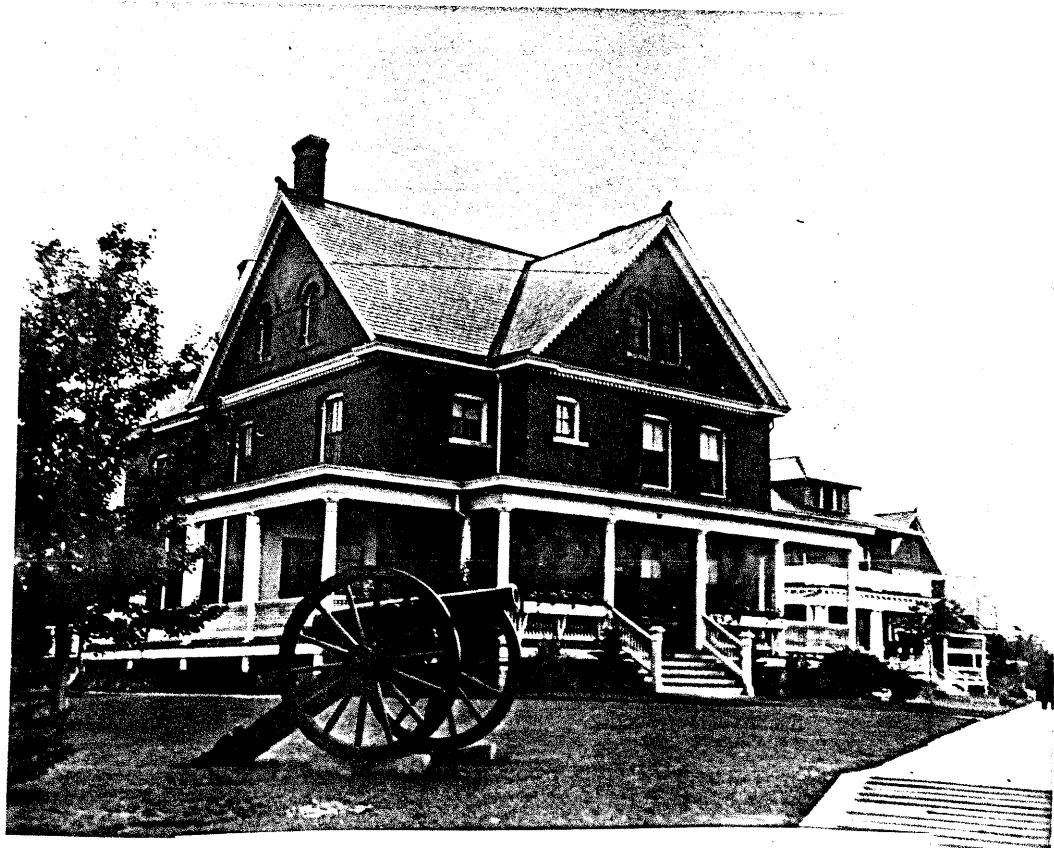


Officers Quarters, 1902, Fort Williams, Cape Elizabeth, Me.



Post Exchange, 1904, Fort Williams, Cape Elizabeth, Me.



Post Gymnasium, 1908, Fort Williams, Cape Elizabeth, Me.

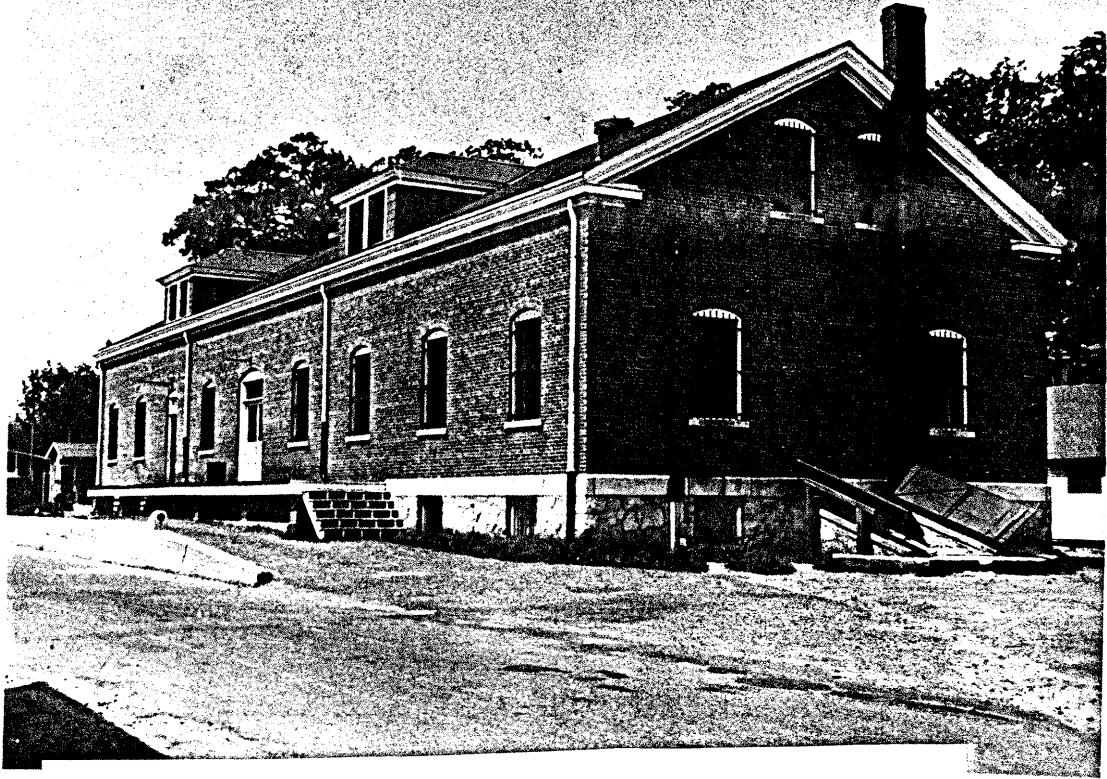

Quartermaster Storehouse & Office, 1910, Fort Williams, Cape Elizabeth, Me.




Combined Range Finding Station, 1909, Peaks Island, Me.




Disappearing Searchlight, 1921, Peaks Island, Me.



Observation Tower, 1921, Trundy Point, Cape Elizabeth, Me.

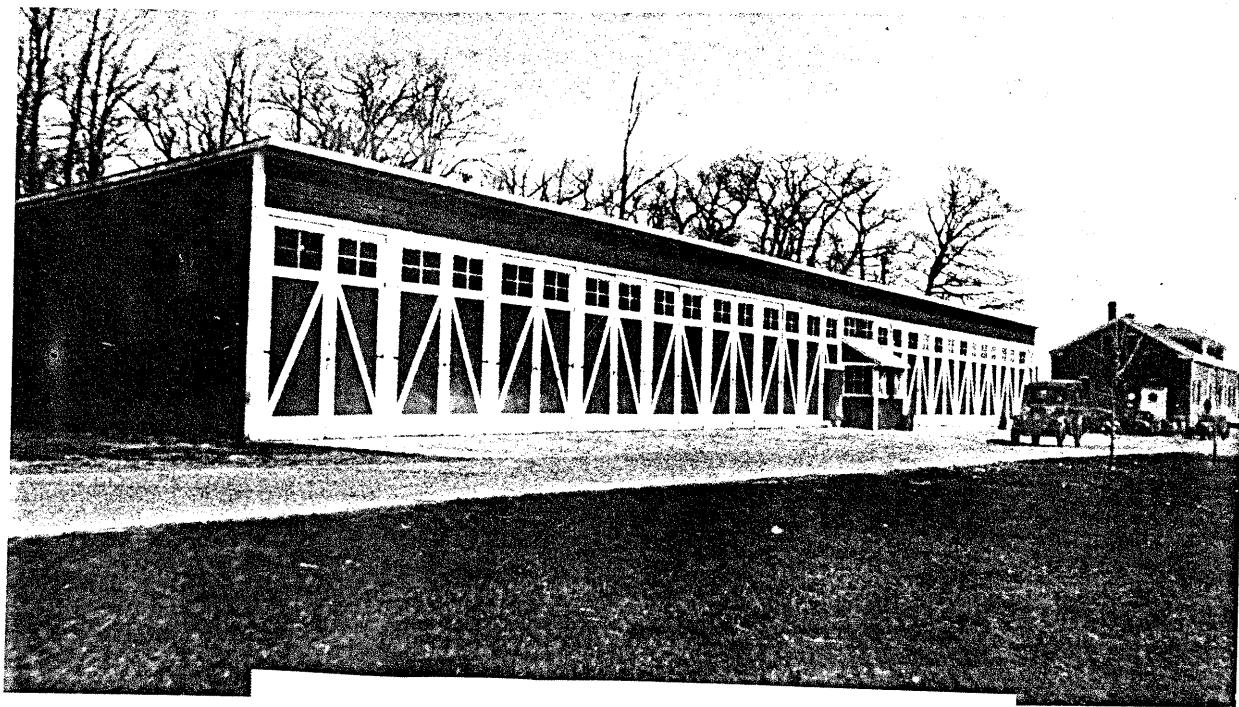

Quartermaster Garage, 192, Fort Williams, Cape Elizabeth, Me.

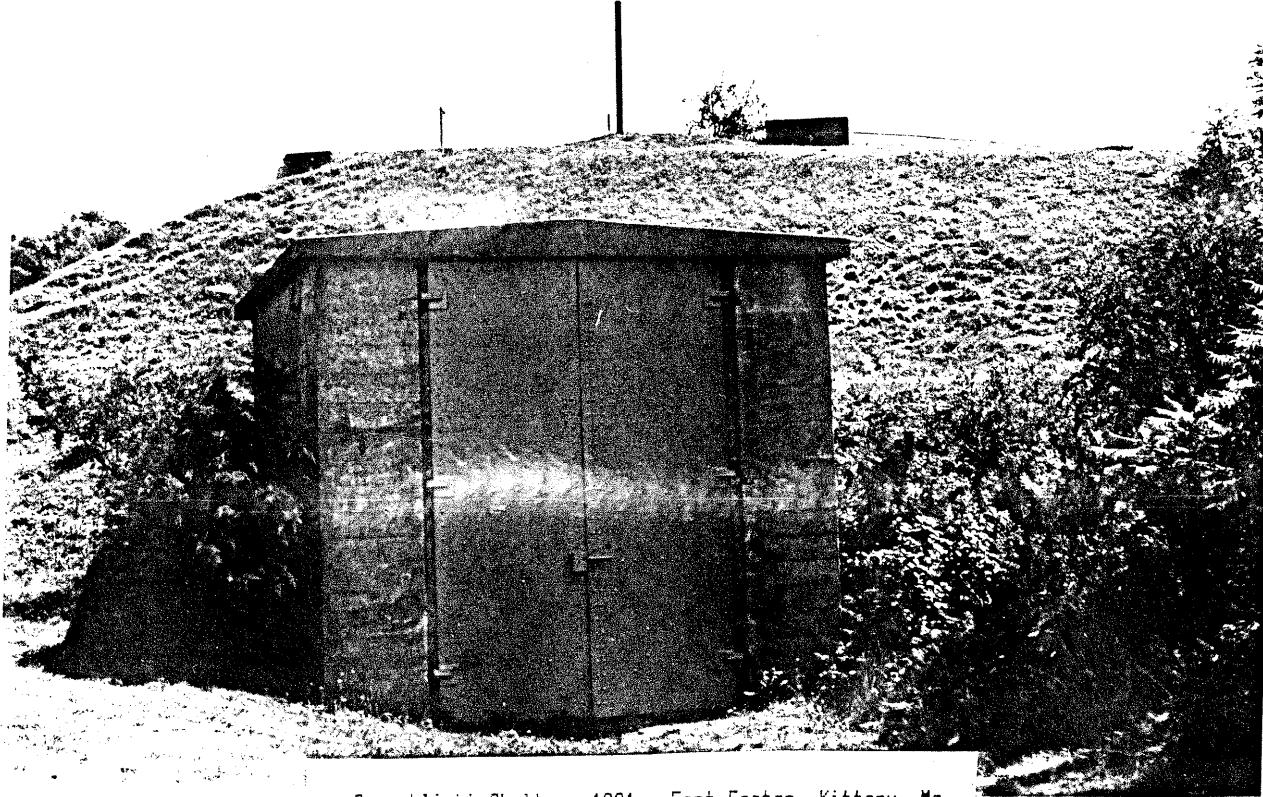


Searchlight Shelter, 1921, Fort Foster, Kittery, Me.




Searchlight Powerhouse, 1921, Peaks Island, Me.




War Department Theater, 1938, Fort McKinley, Great Diamond Island, Me.

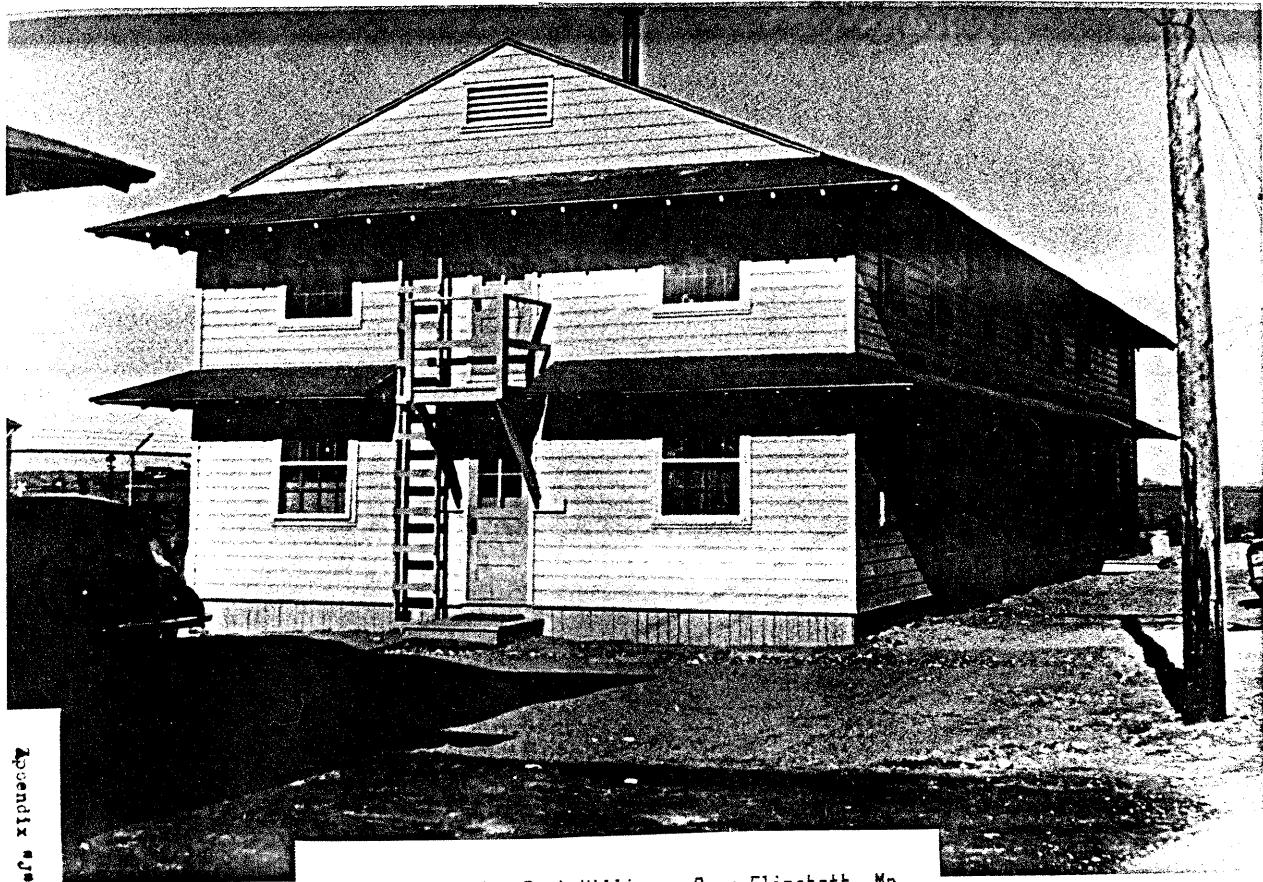


Barracks, 1941, Fort Williams, Cape Elizabeth, Me.

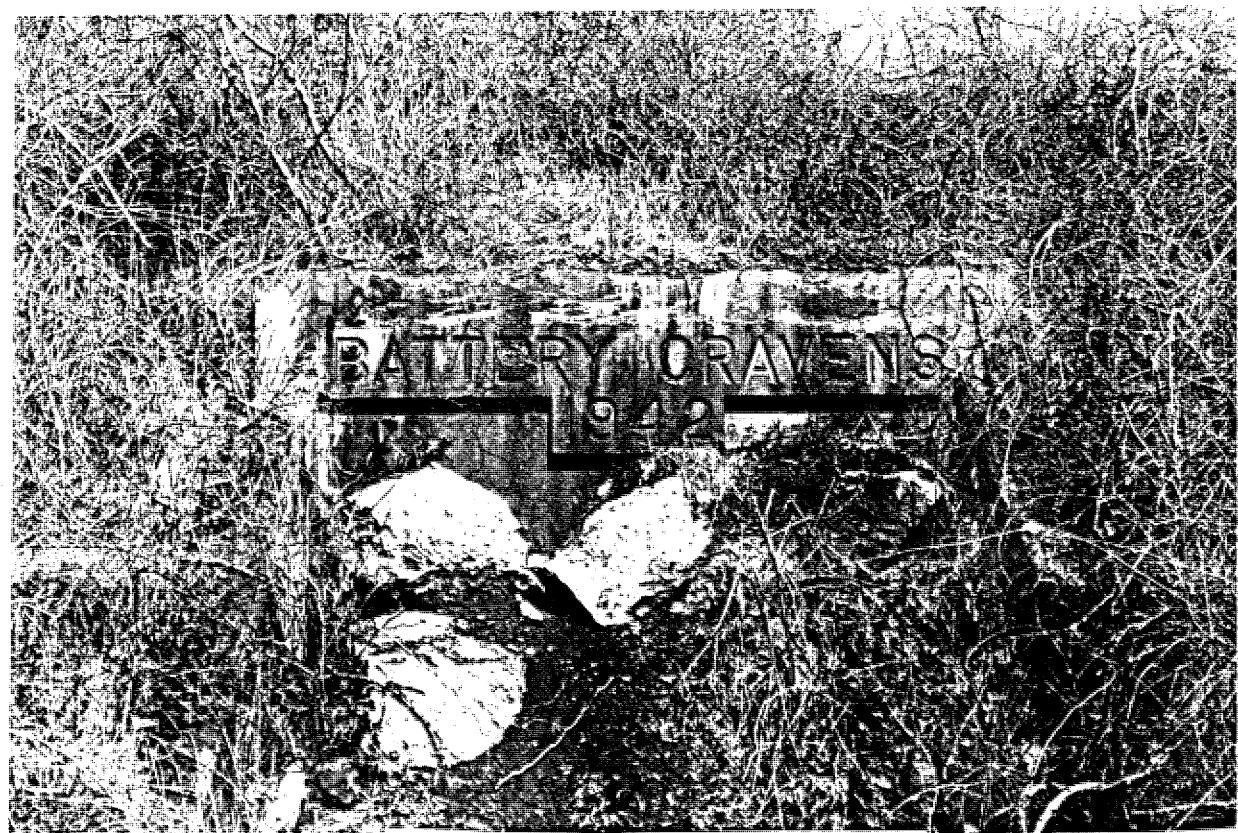


Battery Cravens, 1944, Peaks Island, Me.

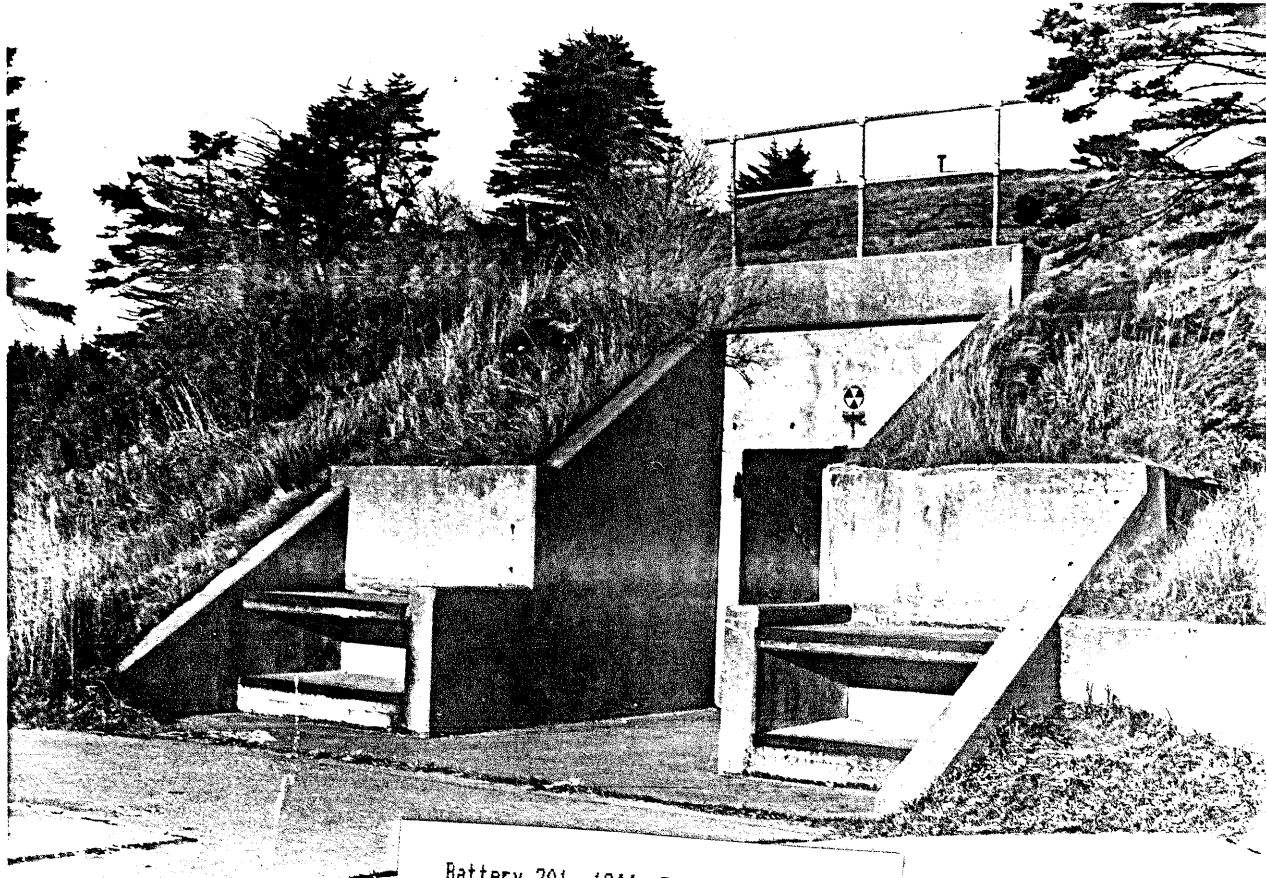


Battery 201, 1944, Cape Elizabeth, Me.

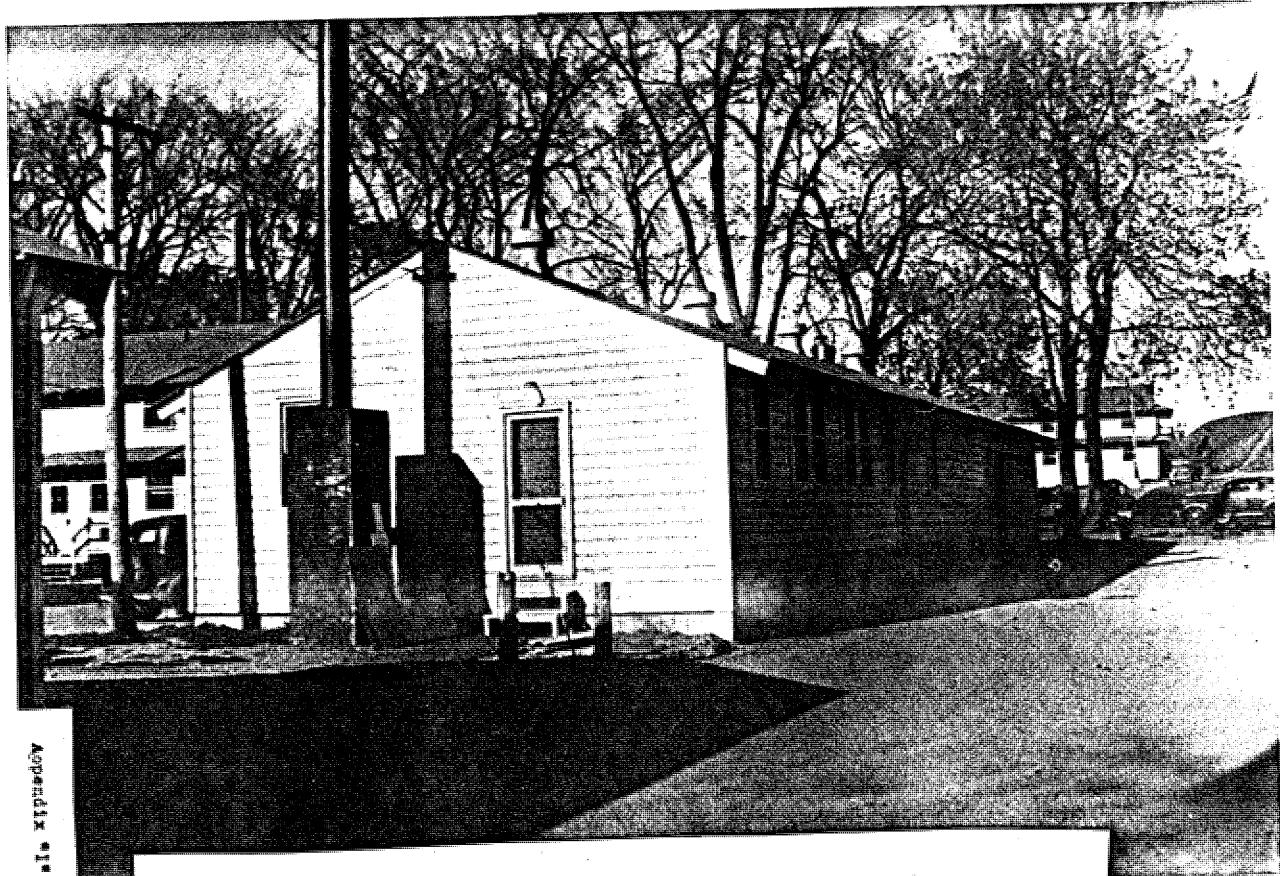


Company Administration and Storehouse, 1941, Fort Williams, Cape Elizabeth, Me.

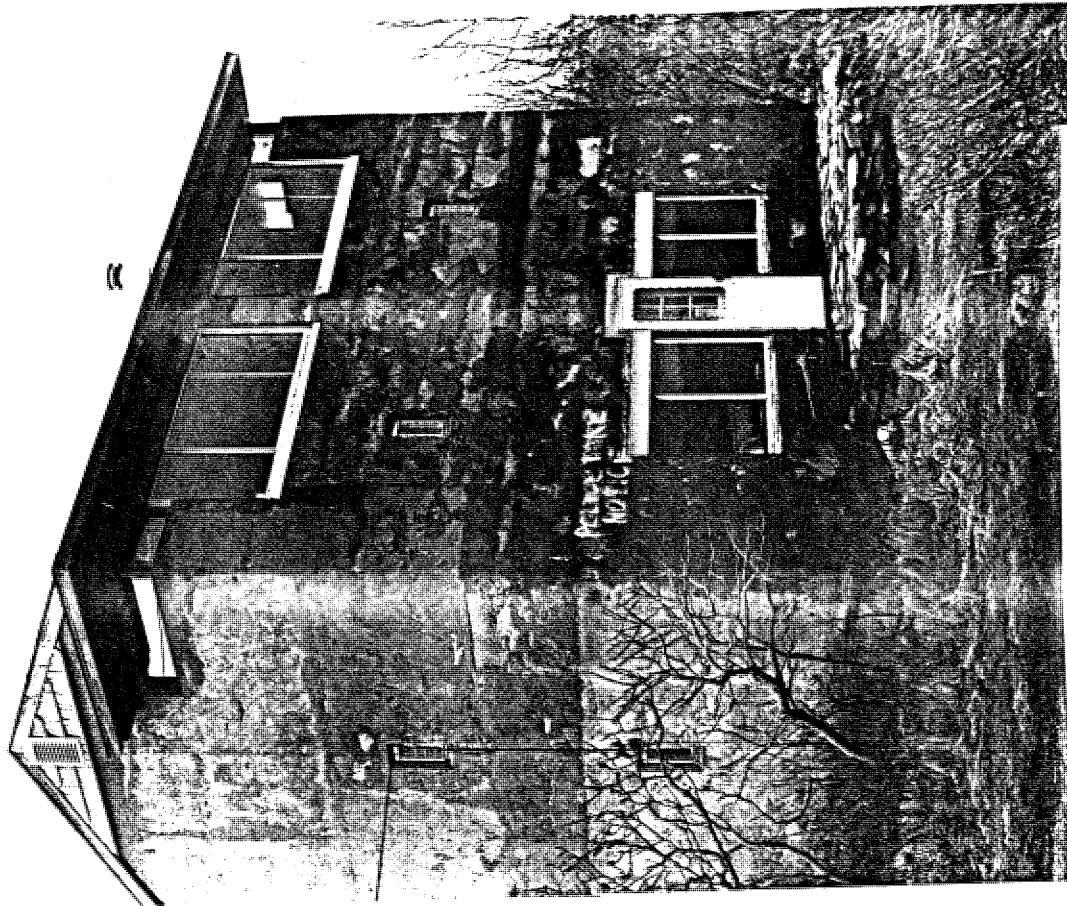


Double Nine Control Station, 1944, Peaks Island, Me.

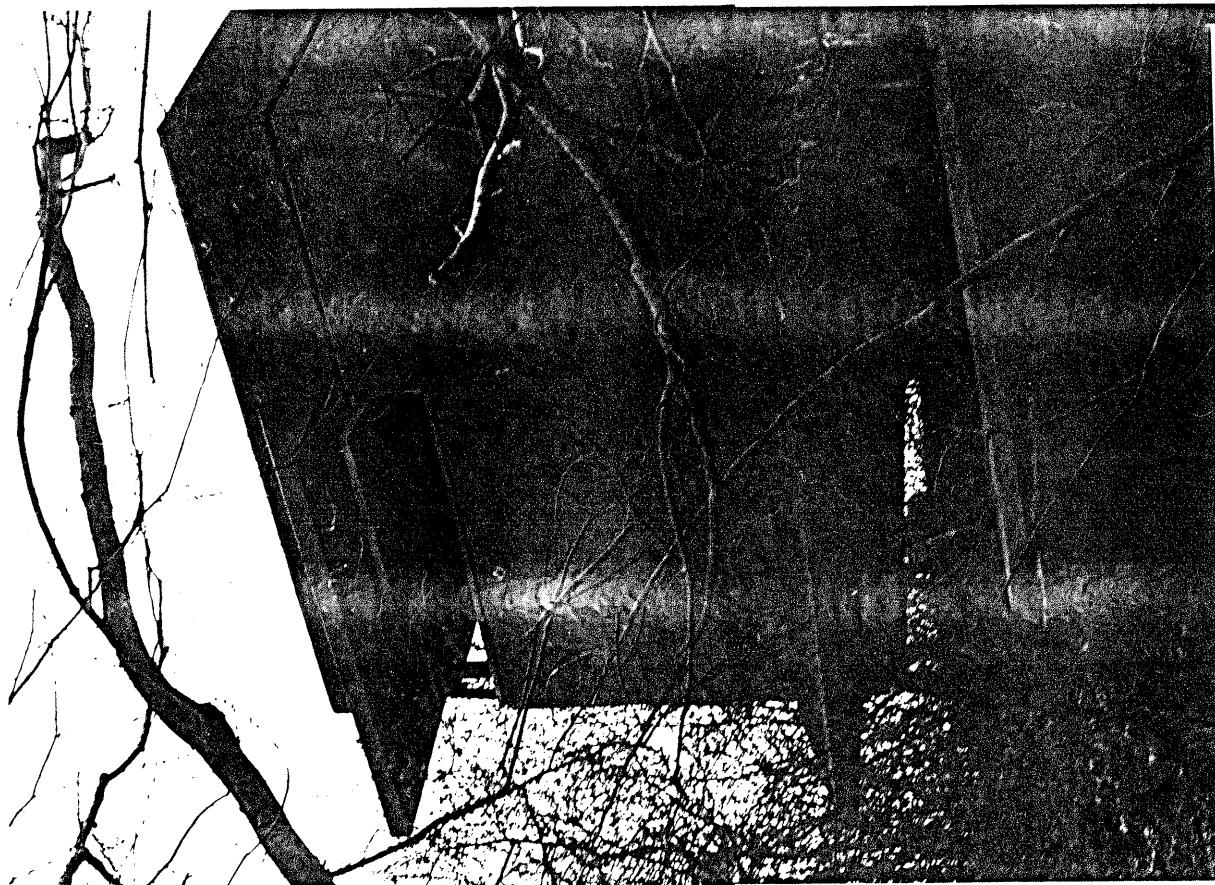



Double Nine Control Station, 1944, Fort Leveet, Cushing Island, Me.

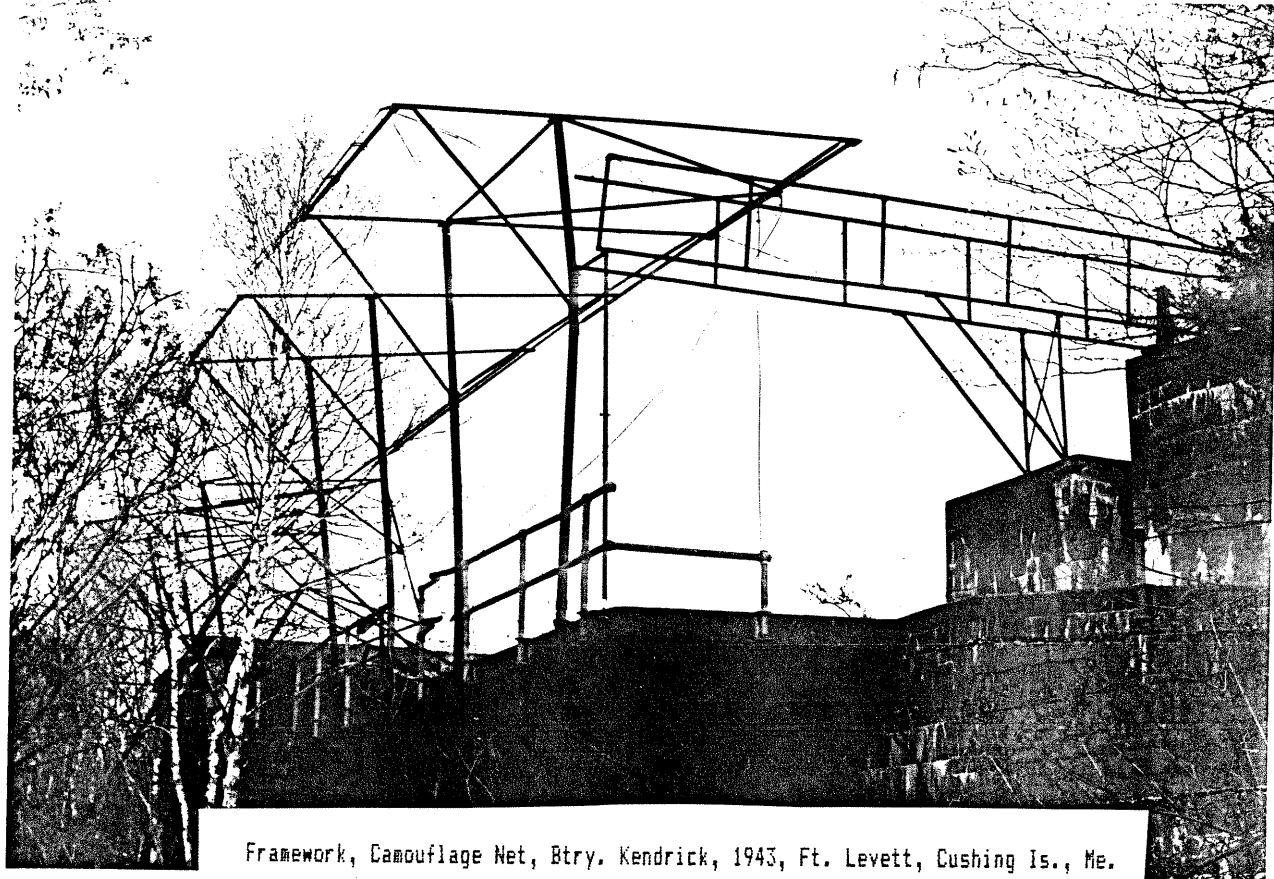


Framework, Camouflage Net, Btry. Kendrick, 1943, Ft. Levett, Cushing Is., Me.

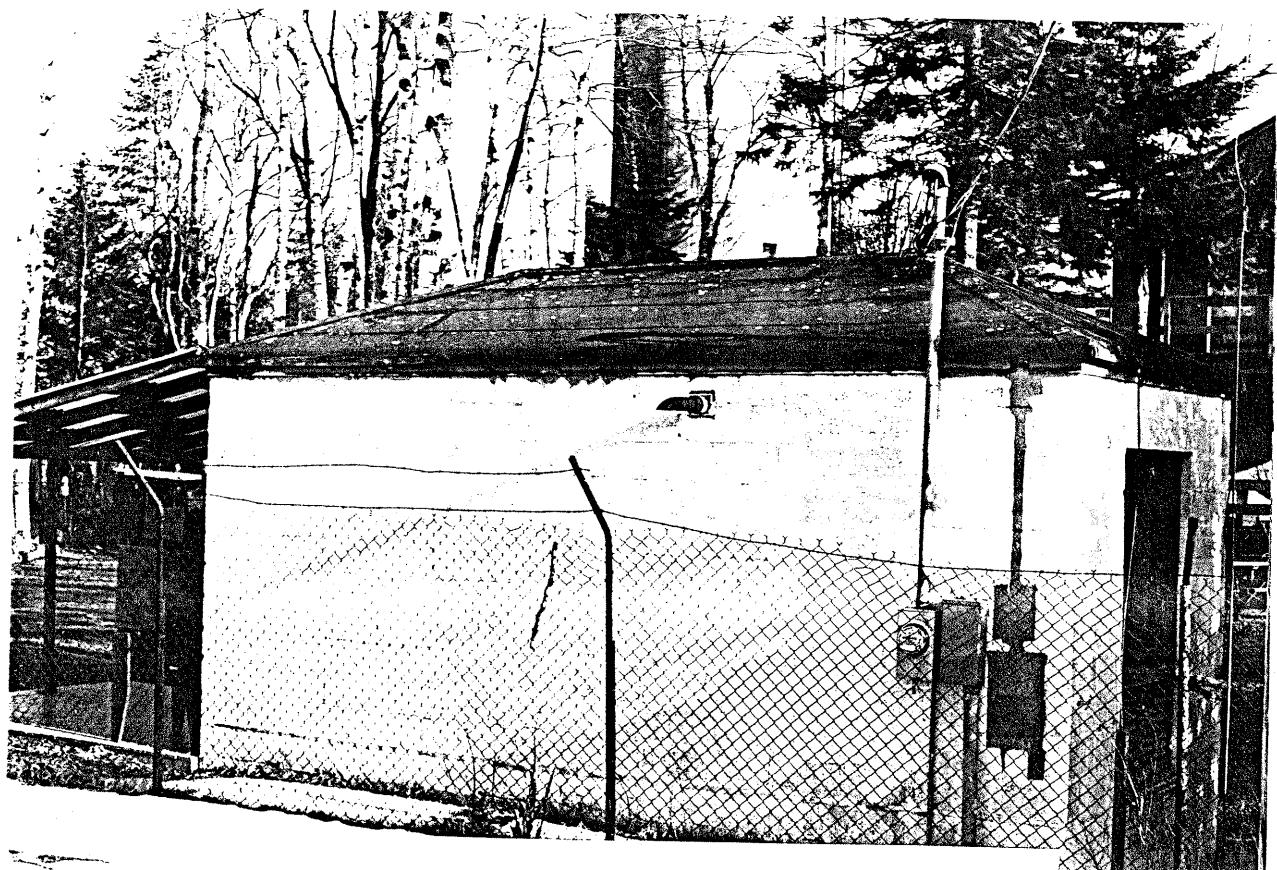


Generator Building, Radar Station, 1944, Long Island, Me.

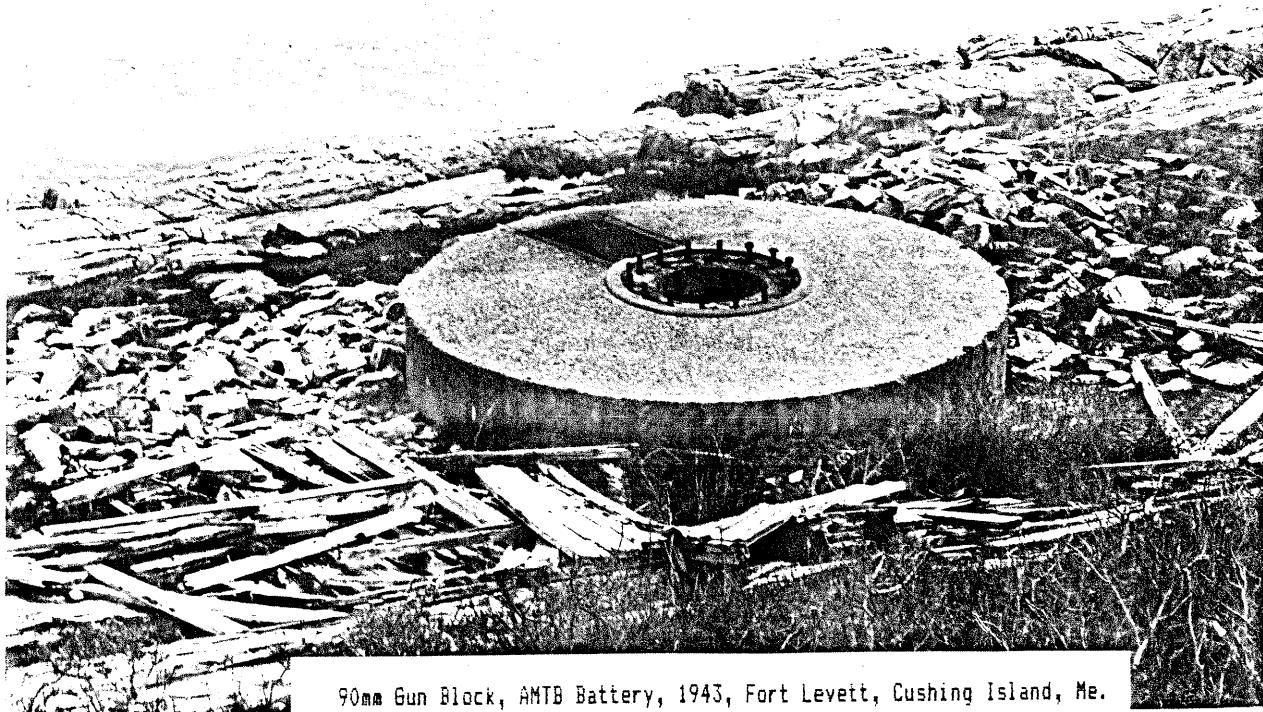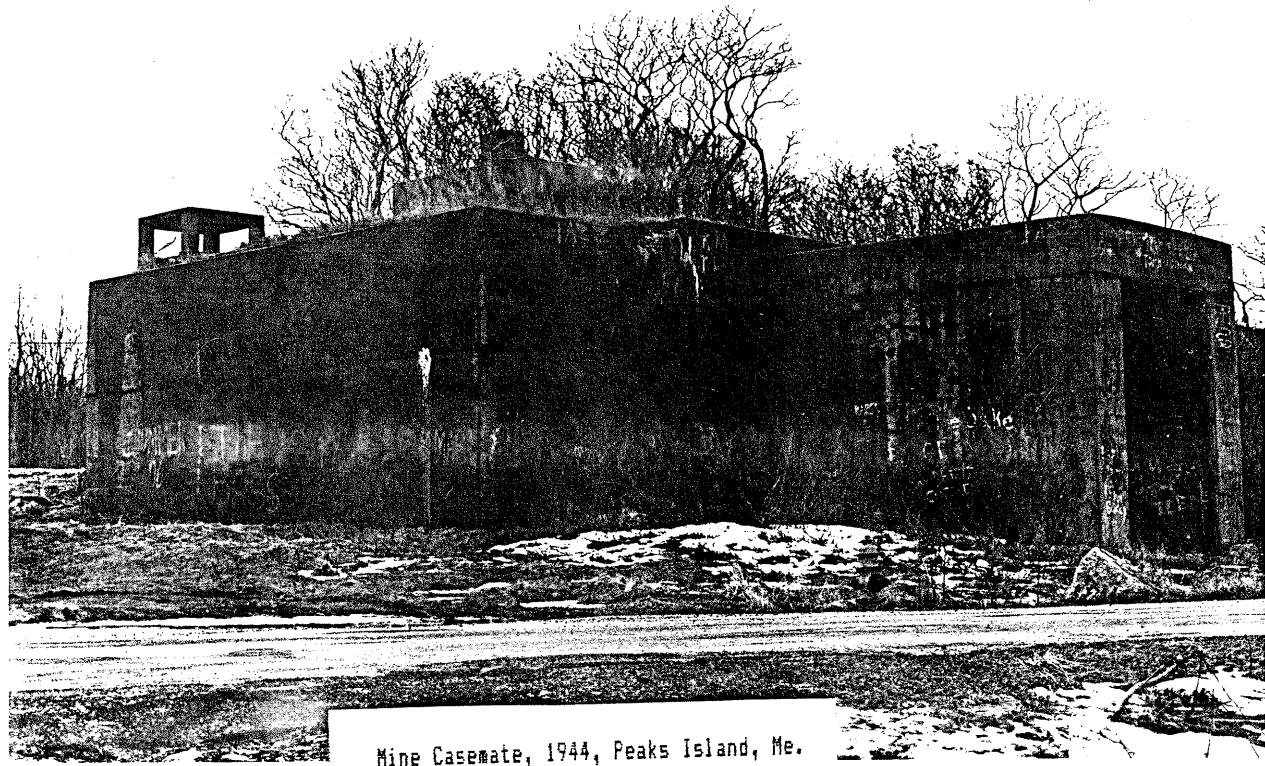

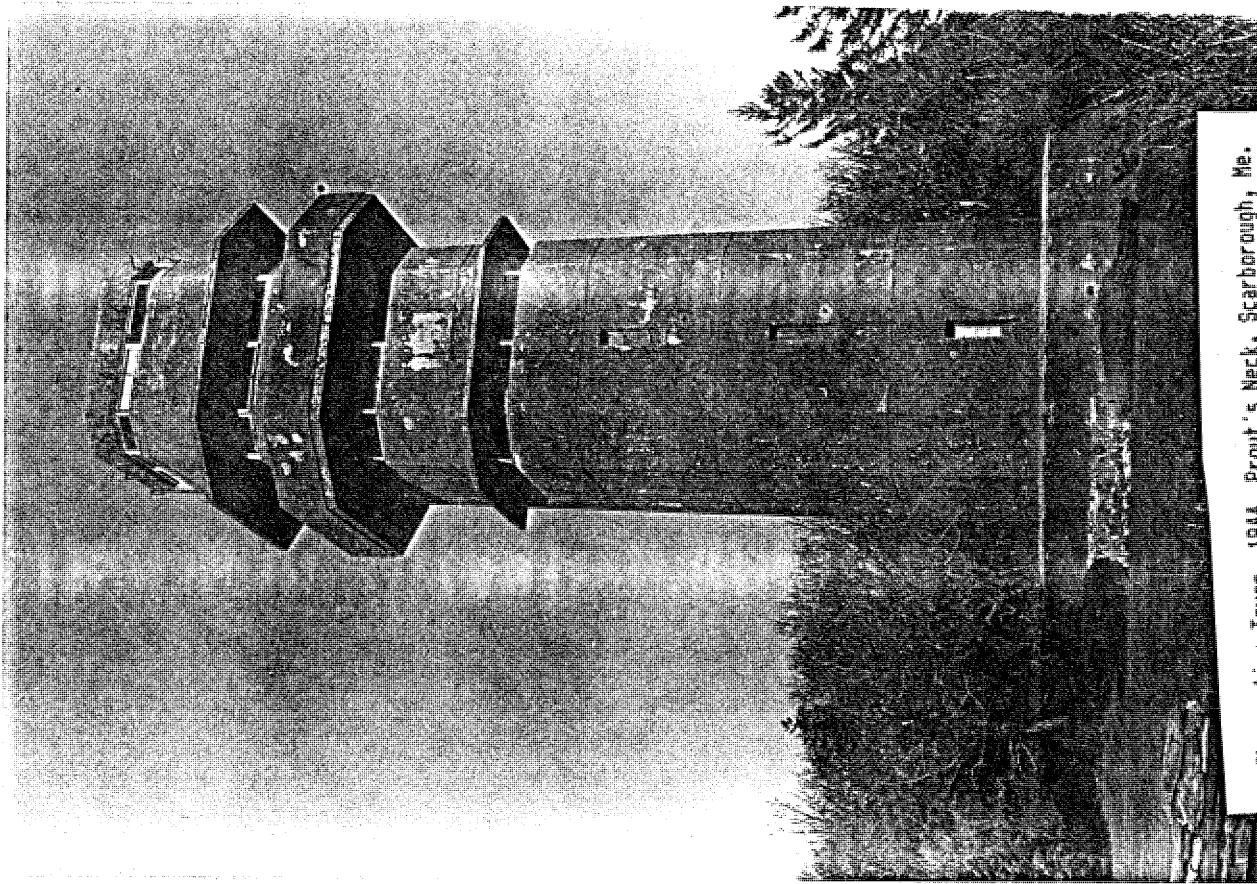


Observation Tower, 1944, Prout's Neck, Scarborough, Me.

136

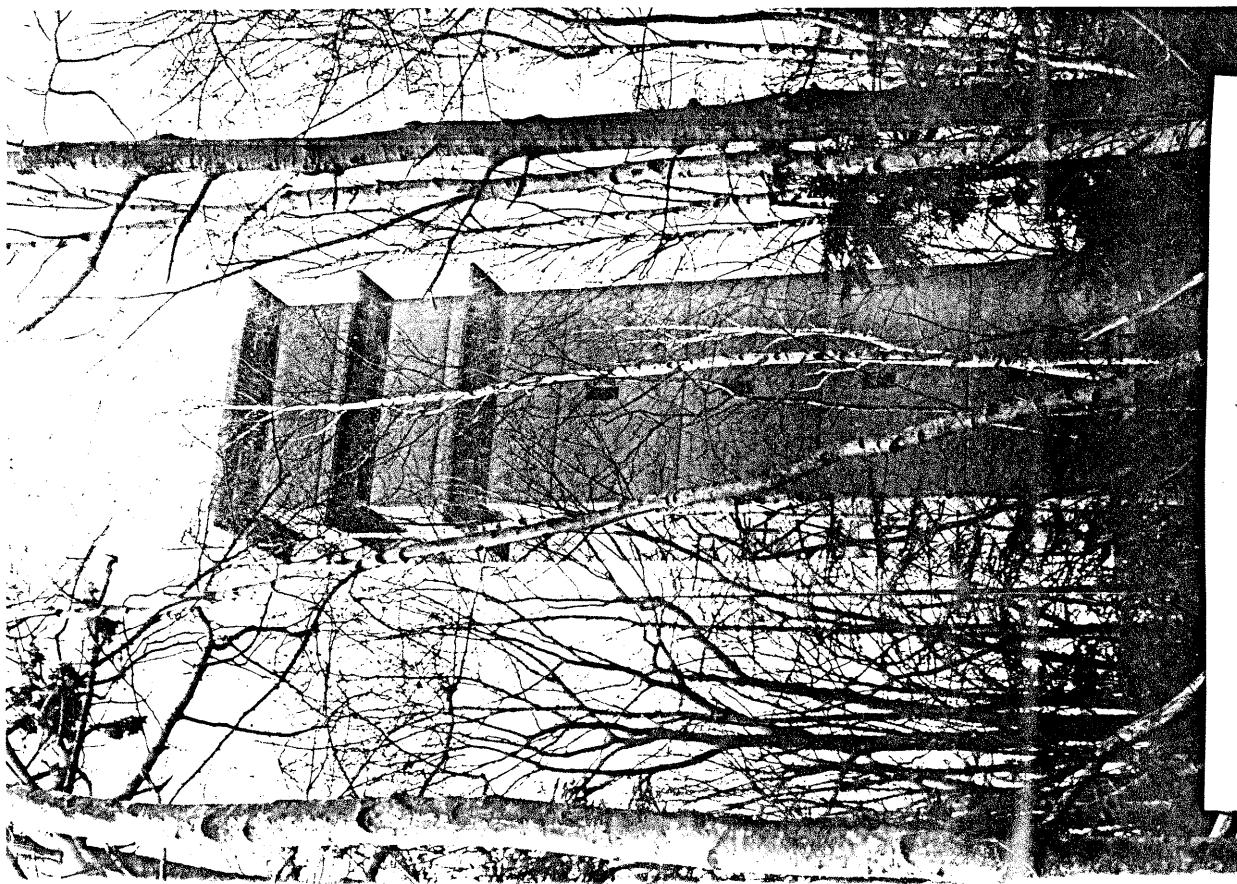


Observation Tower, 1944, Fort Leavett, Cushing Island, Me.

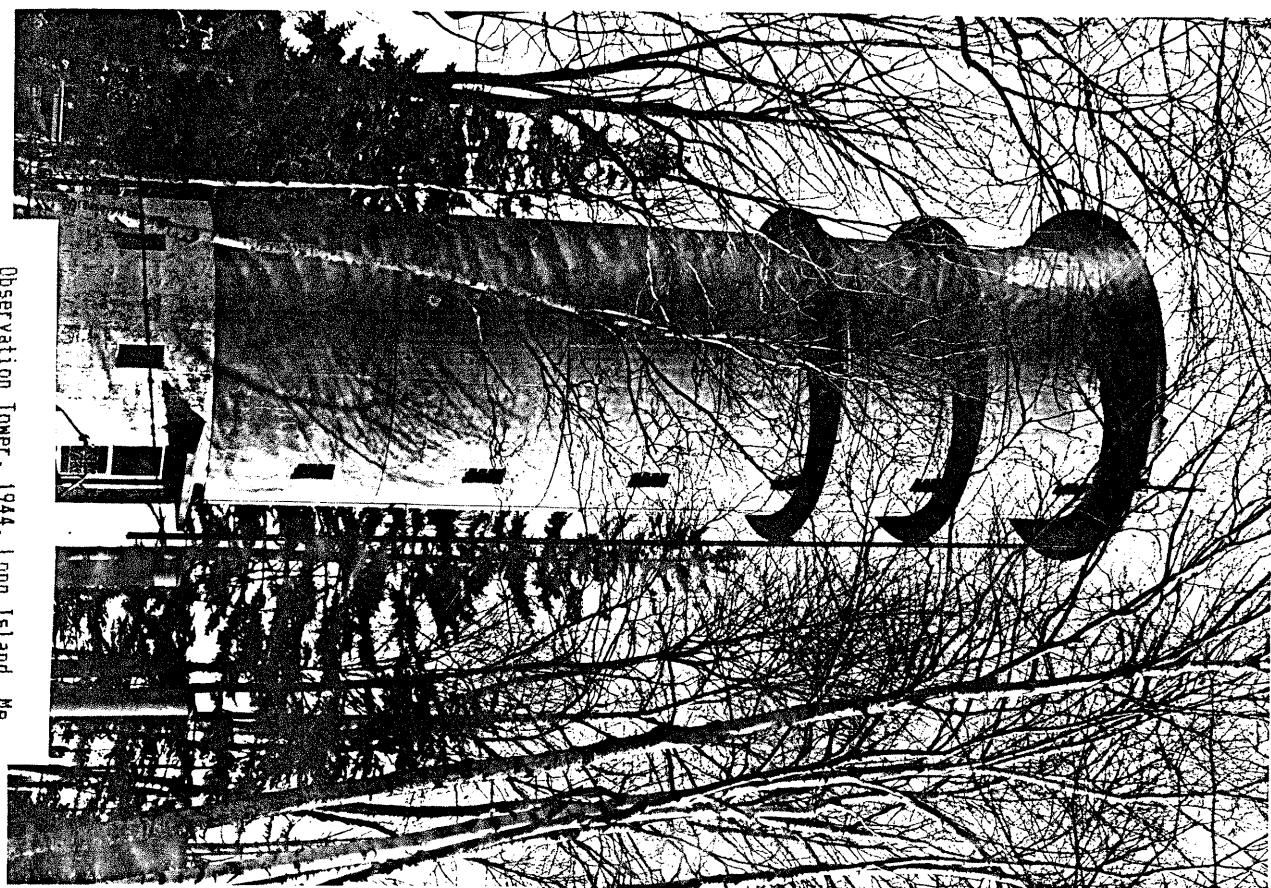


Observation Tower, 1944, Long Island, Me.



Officers Quarters and Mess, 1941, Fort Williams, Cape Elizabeth, Me.

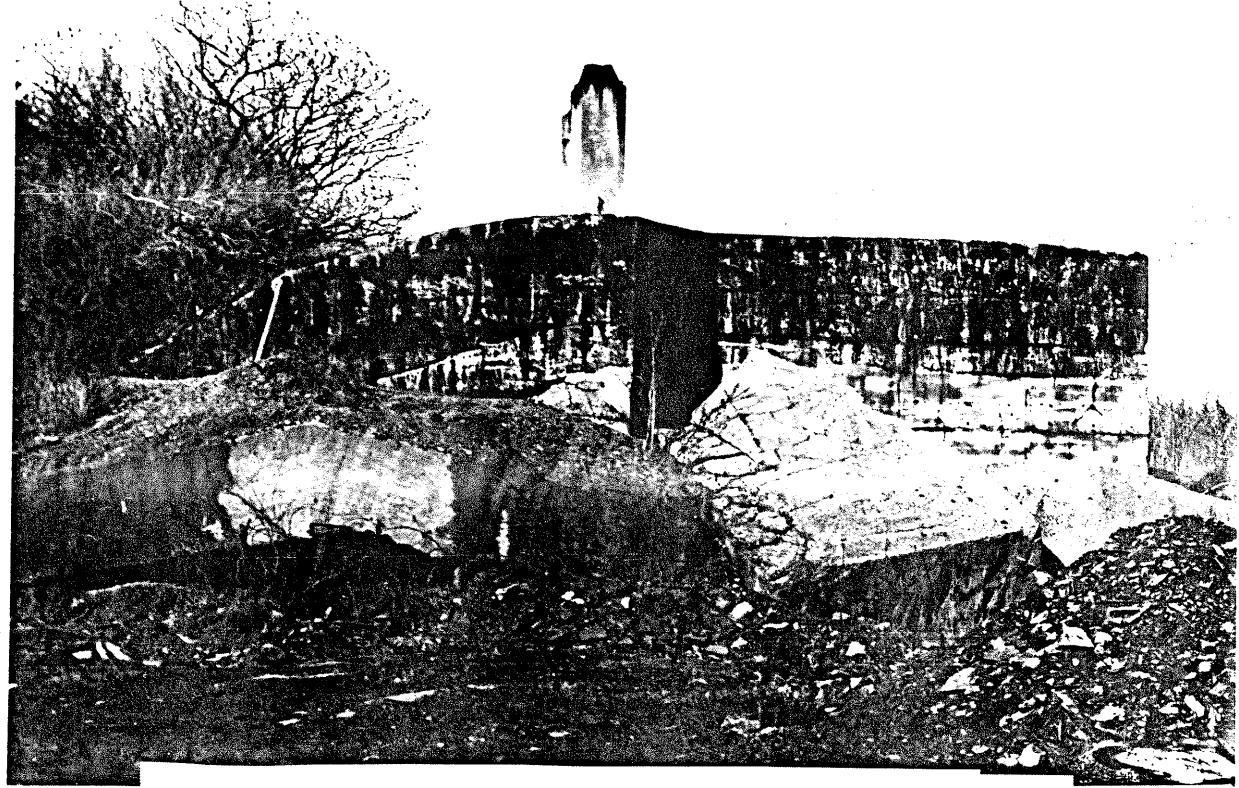

Plotting, Switchboard and Radio Room, Battery Steel, 1944, Peaks Island, Me.

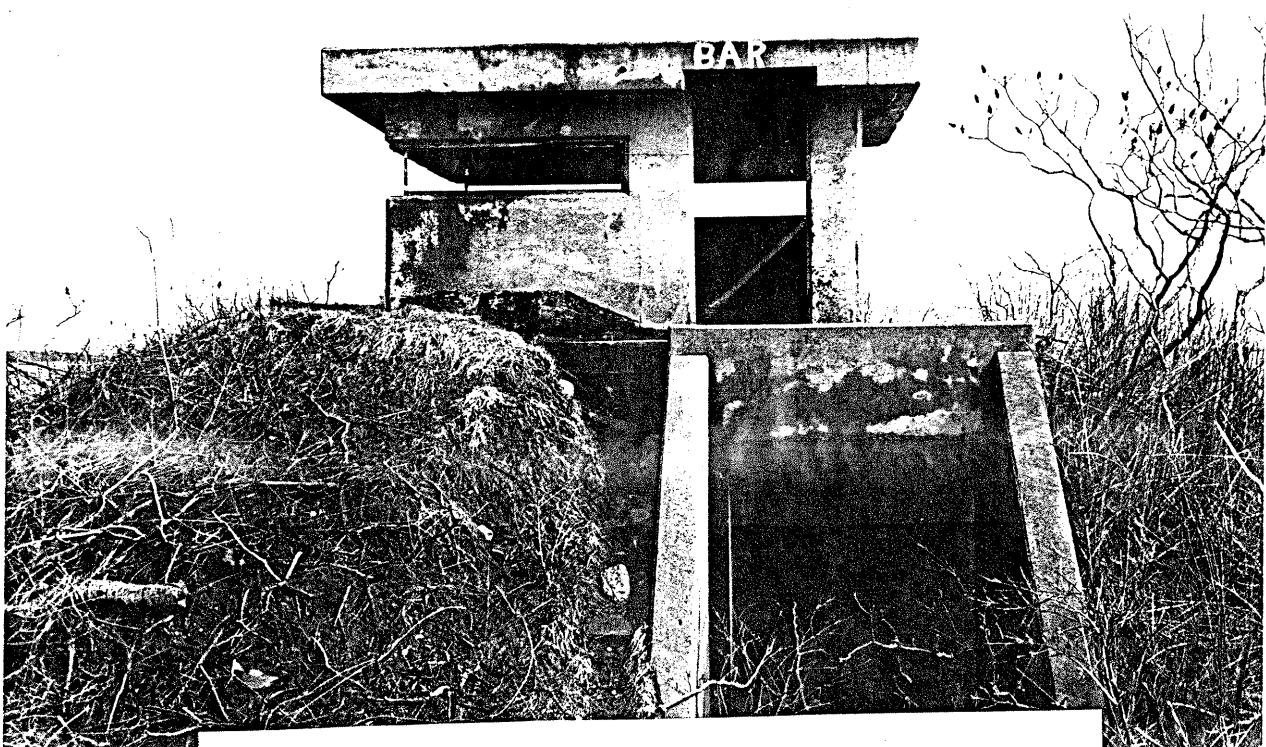

Range Finder Station and Magazine, AMTB Battery, 1943, Peaks Island, Me.


3 1390 00418421 2

DATE DUE
PORTLAND CAMPUS

THE BORROWER WILL BE CHARGED
AN OVERDUE FEE IF THIS BOOK IS
NOT RETURNED TO THE LIBRARY
ON OR BEFORE THE LAST DATE
STAMPED BELOW. NON-RECEIPT OF
OVERDUE NOTICES DOES NOT
EXEMPT THE BORROWER FROM
OVERDUE FEES.

~~MAR 26 2009~~

~~JUN 1 2009~~

~~JUL 1 2009~~

~~JUL 1 2009~~

~~JUL 1 2009~~

USM LIBRARIES

