

N O T I C E

THIS DOCUMENT HAS BEEN REPRODUCED FROM
MICROFICHE. ALTHOUGH IT IS RECOGNIZED THAT
CERTAIN PORTIONS ARE ILLEGIBLE, IT IS BEING RELEASED
IN THE INTEREST OF MAKING AVAILABLE AS MUCH
INFORMATION AS POSSIBLE

NASA-CR-165129) MOD-OA 200 KW WIND TURBINE
GENERATOR ENGINEERING Final Engineering
Drawing Report (Westinghouse Electric Corp.)
246 p HC A11/HP A01 CSCL 10B

N81-23598

Unclas

G3/44 42242

DOE/NASA/0163-3
NASA CR-165129
AESD-TME-3053

MOD-OA 200 kW WIND TURBINE GENERATOR ENGINEERING DRAWING REPORT

T.S. Andersen, C.A. Bodenschatz,
A.G. Eggers, P.S. Hughes, and R.F. Lampe
Westinghouse Electric Corporation
Advanced Energy Systems Division



AUGUST 1980

Prepared for
NATIONAL AERONAUTICS AND SPACE ADMINISTRATION
Lewis Research Center
Under Contract DEN 3-163

U.S. DEPARTMENT OF ENERGY
Conservation and Solar Energy
Office of Solar Power Applications

TABLE OF CONTENTS

<u>Section</u>	<u>Page</u>
ACKNOWLEDGEMENTS	ii
SUMMARY	1
INTRODUCTION	2
DISCUSSION	6

LIST OF FIGURES

<u>Figure No.</u>		<u>Page</u>
1	MOD-OA 200 kW Wind Turbine Generator; Clayton, NM.	5

LIST OF TABLES

<u>Table No.</u>		<u>Page</u>
1	List of Drawings for the MOD-OA 200 kW Wind Turbine Generator - Correlation of Westinghouse Drawings to NASA LeRC Drawings	7
2	List of Drawings for the MOD-OA 200 kW Wind Turbine Generator - Correlation of NASA LeRC Drawings to Westinghouse Drawings	23

PRECEDING PAGE BLANK NOT FILMED

SUMMARY

This report provides engineering drawings which document the design of the MOD-OA 200 kW wind turbine generator installed at Clayton, NM. The MOD-OA wind turbine was designed and built by the NASA Lewis Research Center for the U.S. Department of Energy as part of the Federal Wind Energy Program. The objective of the MOD-OA project is to obtain early operation and performance data and experience with horizontal-axis wind turbines in utility environments. The first MOD-OA wind turbine was released to the Town of Clayton Light and Water Plant for utility operation in March 1978.

This report contains the engineering drawings for all mechanical and electrical systems except the blades. Included are drawings for the hub, pitch change mechanism, drive train, nacelle equipment, yaw drive system, tower, foundation, electrical power system, and the control and safety systems.

INTRODUCTION

HISTORY AND BACKGROUND

Wind energy systems have been utilized for centuries as a source of power for a variety of applications. Some of the more recent applications included sailing ships for transportation and wind turbines (windmills) for grinding grain, pumping water, and generating electricity. In the early 1940's, a Smith-Putnam large Horizontal-Axis Wind Turbine (HAWT) was designed and built to feed power into the existing electrical network of the Central Vermont Public Service Company. This machine consisted of a two-bladed 175 foot (53.3 m) diameter rotor which was capable of producing 1.25 MW of power. In addition, Dr. U. Hütter designed and built a 100 kW Wind Turbine Generator (WTG) in West Germany in the late 1950's and gained operating experience with his machine tied to the utility network. The Hütter machine used a downwind 112 foot (34.1 m) diameter two-bladed rotor. Several of the design criteria and design features of the Smith-Putnam and Hütter WTGs were considered or incorporated into the MOD-0 and MOD-0A HAWTs.

RECENT DEVELOPMENTS

The recent national concern over the increase in energy demand and costs of fossil fuels, the dwindling supplies of domestic gas and oil, and the nation's increasing dependence upon imported oil has made it necessary to develop alternate energy sources. Wind energy conversion has long been recognized as a potentially abundant source of electrical power. Utilization of wind energy is becoming more attractive as the cost differential between wind and the more conventional fossil alternative narrows.

A Federal Wind Energy Program originated at the National Science Foundation in 1973. The objective of this program is to accelerate the development of reliable and economically viable wind energy systems and achieve early commercialization. Satisfying this objective requires advancing the technology, developing a sound industrial base, and addressing the non-technological issues which could impede its development. In January 1975, the responsibility for managing the program was transferred to the Energy Research and Development Administration (ERDA). These efforts were continued by the Division of Distributed Solar Technology in the U.S. Department of Energy (DOE) after October 1, 1977.

One segment of the Federal Wind Program is the development of large horizontal-axis WTGs. In 1973, the NASA Lewis Research Center (LeRC) was asked by the National Science Foundation (and later by ERDA and DOE) to develop, and provide project management for, the designs of large, experimental, horizontal-axis WTGs and perform the necessary supporting research and technology development. Initially, a review of prior experience

in WTGs was performed. Then, analytical techniques and computer codes were developed to predict the structural dynamics of large HAWT systems such as the MOD-OA.

MOD-O WIND TURBINE GENERATOR

As part of the federal wind program, NASA LeRC designed, built, and started testing a 100 kW wind turbine in September 1975. This experimental project, designated the MOD-O, had primary objectives of providing the engineering data and serving as a test bed for evaluating advanced wind turbine design concepts. The MOD-O WTG was designed using available technology and "off-the-shelf" components where possible. Design, fabrication, and assembly were completed in 18 months. The MOD-O WTG has a 125 foot (38.1 m) diameter downwind rotor which operates at 40 rpm. The rotor drives a 60 Hz synchronous alternator through a step-up gearbox at 1800 rpm. The MOD-O project has been used to help understand the performance and the dynamic behavior of wind turbines. The MOD-O WTG was utilized to: 1) understand the tower shadow and wind shear effects; 2) assess operational performance; 3) evaluate automatic startup and shutdown capabilities, including synchronization to a large and small utility network; and 4) test various components, such as induction generators and steel spar wind turbine blades.

MOD-OA WIND TURBINE GENERATOR

The MOD-OA 200 kW wind turbine generator is, in most respects, an updated version of the MOD-O 100 kW WTG. The MOD-OA WTG was designed and analyzed by the NASA LeRC for the DOE. The objective of the MOD-OA Project is to conduct early testing of wind turbines in utility environments so that the machine operating performance and dynamic characteristics can be determined. Besides gaining operational experience with wind turbines interfaced with utility networks, an additional objective of the -OA project is obtaining the utility's and the public's reaction to intermediate size WTGs. The prototype MOD-O design was simplified and made "field-worthy" as it was updated to the 200 kW size.

The purpose of this engineering drawing report is to document the design of the MOD-OA 200 kW wind turbine generator at Clayton, NM now being operated by the Town of Clayton Light and Water Plant. This machine was built to NASA drawings and specifications. Updated drawings were subsequently prepared in Westinghouse format to reflect as-built conditions on the Clayton and later machines. These latest drawings are presented here with a cross index to the original NASA drawings.

The MOD-OA wind turbine is shown in operation at the Clayton site in Figure 1. The operational history for the Clayton MOD-OA WTG during its initial phases of use is as follows:

Date	Event
● November 30, 1977	First rotation
● January 19, 1978	First 100 hours (0.36 megaseconds) of operation
● January 28, 1978	Formal dedication of wind turbine
● March 6, 1978	Turned over the operation by the utility
● May 24, 1978	1000 hours (3.6 megaseconds) of operation [94,000 kW-hr (338.GJ)]

SUPPLEMENTARY MOD-OA REPORTS

Two supplementary reports to this MOD-OA engineering drawing report provide the details¹ and an executive summary² of the design and analysis of the MOD-OA wind turbine generator.

¹ Andersen, T.S., Bodenschatz, C.A., Eggers, A.G., Hughes, P.S., Lampe, R.F., Lipner, M.H., and Schornhorst, J.R., "MOD-OA 200 kW Wind Turbine Generator Design and Analysis Report," DOE/NASA/O163-2, NASA CR-165128, and AESD-TME-3052, August 1980.

² Andersen, T.S., Bodenschatz, C.A., Eggers, A.G., Hughes, P.S., Lampe, R.F., Lipner, M.H., and Schornhorst, J.R., "Executive Summary. MOD-OA 200 kW Wind Turbine Generator Design and Analysis Report," DOE/NASA/O163-1, NASA CR-165127, and AESD-TME-3051, August 1980.



Figure 1. MOD-0A 200 kW Wind Turbine
Generator; Clayton, NM

ORIGINAL PAGE IS
OF POOR QUALITY

DISCUSSION

The MOD-OA engineering drawings follow this discussion in numerical order (by Westinghouse drawing number). The mechanical drawings (Westinghouse drawings 1015F-- and 1017F--) are followed by the electrical drawings (1016F--). Table 1 provides a list of drawings and title in this order with cross-reference to the number and title of the NASA drawings from which the Westinghouse drawings were prepared. The NASA drawings formed the basis for assembly and installation of the MOD-OA wind turbine generators and are listed in numerical order in Table 2 with cross reference to the number and title of the corresponding Westinghouse drawings.

TABLE 1
 LIST OF DRAWINGS FOR THE MOD-0A 200 kW WIND TURBINE GENERATOR
 CORRELATION OF WESTINGHOUSE DRAWINGS TO NASA LEWIS RESEARCH CENTER DRAWINGS

WESTINGHOUSE DRAWING NUMBER	NUMBER OF SHTS.	MASA LEWIS DRAWING NUMBER	NUMBER OF SHTS.	*REV.	TITLE OF DRAWING
1015F01	11	CR758862 CR758863	1 1	K G	(NASA) MOD-0A 200 kW WIND TURBINE GENERATOR ASSEMBLY (NASA) MOD-0A 200 kW WIND TURBINE GENERATOR ASSEMBLY (W) ASSEMBLY MOD-0A 200 kW WIND TURBINE GENERATOR
1015F02	1	CD758836	1	A	(NASA) HUB FORGING (W) HUB PITCH FORGING MOD-0A 200 kW WIND TURBINE GENERATOR
1015F03	4	CR758864 CD758875	1 1	D C	(NASA) ASSEMBLY-GEAR TYPE PITCH CONTROL HUB (NASA) SUB-ASSEMBLY BEARING & GEAR ADJUSTMENT (W) PITCH CONTROL HUB ASS'Y MOD-0A 200 kW WIND TURB. GEN.
1015F04	1	CF758865	1	B	(NASA) ASSEMBLY-GEAR TYPE PITCH CONTROL HUB - DETAIL 1 (W) HUB PITCH DETAIL MOD-0A 200 kW WIND TURBINE GENERATOR
1015F05	1	CD758866	1	A	(NASA) ASSEMBLY-GEAR TYPE PITCH CONTROL HUB - DETAIL 2 (W) BLADE SPINDLE SLEEVE MOD-0A 200 kW WIND TURBINE GEN.
1015F06	1	CD758867	1	D	(NASA) ASSEMBLY-GEAR TYPE PITCH CONTROL HUB - DETAIL 3 (W) BLADE SPINDLE HOUSING MOD-0A 200 kW WIND TURBINE GEN.
1015F07	1	CD758868	1	C	(NASA) ASSEMBLY-GEAR TYPE PITCH CONTROL HUB - DETAIL 4 (W) DRIVE SHAFT BEARING RETAINER MOD-0A 200 kW WTG
1015F08	1	CD758869	1	B	(NASA) ASS'Y-GEAR TYPE PITCH CONTROL HUB-DETAILS 5 THRU 11 (W) HUB PITCH DETAILS MOD-0A 200 kW WIND TURBINE GENERATOR
1015F09	1	CD758870	1	B	(NASA) ASSEMBLY-GEAR TYPE PITCH CONTROL HUB - DETAIL 12 (W) HUB PITCH DRIVE SHAFT MOD-0A 200 kW WIND TURBINE GEN.
1015F10	1	CD758872	1	C	(NASA) ASSEMBLY-GEAR TYPE PITCH CONTROL HUB - DETAIL 15 (W) HUB PITCH BEVEL PINION GEAR MOD-0A 200 kW WTG
1015F11	1	CD758873	1	C	(NASA) ASSEMBLY-GEAR TYPE PITCH CONTROL HUB - DETAIL 16 (W) HUB PITCH BEVEL GEAR SECTOR MOD-0A 200 kW WTG

*All Westinghouse Drawings are Revision - (i.e., Unrevised)

TABLE 1 (Cont'd.)
 LIST OF DRAWINGS FOR THE MOD-OA 200 kW WIND TURBINE GENERATOR
 CORRELATION OF WESTINGHOUSE DRAWINGS TO NASA LEWIS RESEARCH CENTER DRAWINGS

WESTINGHOUSE DRAWING NUMBER	NUMBER OF SHTS.	NASA LEWIS DRAWING NUMBER	NUMBER OF SHTS.	REV.	TITLE OF DRAWING
1015F12	1	CF758874	1	C	(NASA) ASS'Y-GEAR TYPE PITCH CONTROL HUB-DETAILS 17 THRU 25 (W) HUB PITCH DETAILS MOD-OA 200 kW WIND TURBINE GENERATOR
1015F13	1	NONE	-	-	(W) GENERAL OUTLINE MOD-OA 200 kW WIND TURBINE GENERATOR
1015F14	6	CR758877	1	E	(NASA) BEDPLATE (W) BEDPLATE MOD-OA 200 kW WIND TURBINE GENERATOR
1015F15	3	CR758878	1	D	(NASA) FWD CENTER SHROUD (W) FORWARD CENTER SHROUD MOD-OA 200 kW WIND TURBINE GEN.
1015F16	4	CR758879	1	E	(NASA) REAR CENTER SHROUD (W) REAR CENTER SHROUD MOD-OA 200 kW WIND TURB. GENERATOR
1015F17	1	CF758880	1	A	(NASA) NOSE COME (W) NOSE COME MOD-OA 200 kW WIND TURBINE GENERATOR
1015F18	1	CF758881	1	C	(NASA) PROP COME (W) PROP COME (SPINNER) MOD-OA 200 kW WIND TURBINE GEN.
1015F19	1	CD758882	1	B	(NASA) PROP HUB & COME COVER PLATE (W) BLADE OPENING COVERS MOD-OA 200 kW WIND TURBINE GEN.
1015F20	1	CD758883	1	-	(NASA) COME SUPPORT DETAILS (W) COME SUPPORT DETAILS MOD-OA 200 kW WIND TURBINE GEN.
1015F21	1	CD758884	1	A	(NASA) FRONT HUB SUPPORT (W) MOUNTING PANEL-PROP COME MOD-OA 200 kW WIND TURB. GEN.
1015F22	1	CD758885	1	-	(NASA) REAR HUB SUPPORT (W) SUPPORT-PROP COME MOD-OA 200 kW WIND TURBINE GENERATOR
1015F23	2	CF758886	1	C	(NASA) WALKWAYS (W) WALKWAYS MOD-OA 200 kW WIND TURBINE GENERATOR
1015F24	1	CF758887	1	A	(NASA) ADJ. GENERATOR BOTTOM PLATE (W) BOTTOM PLATE-GENERATOR ADJUSTMENT MOD-OA 200 kW WTG

ALL Westinghouse Drawings are Revision -

Sheet 2

TABLE 1 (Cont'd.)
 LIST OF DRAWINGS FOR THE MOD-0A 200 kW WIND TURBINE GENERATOR
 CORRELATION OF WESTINGHOUSE DRAWINGS TO NASA LEWIS RESEARCH CENTER DRAWINGS

WESTINGHOUSE DRAWING NUMBER	NUMBER OF SHTS.	NASA LEWIS DRAWING NUMBER	NUMBER OF SHTS.	REV.	TITLE OF DRAWING
1015F25	1	CF758888	1	A	(NASA) ADJ. GEN. TOP & LOCK BAR (W) GENERATOR ADJUSTMENT DETAILS
1015F26	1	CF758889	1	C	(NASA) DETAILS (W) DETAILS MOD-0A 200 kW WIND TURBINE GENERATOR
1015F27	1	CF758890	1	C	(NASA) MAIN DRIVE SHAFT (W) MAIN DRIVE SHAFT MOD-0A 200 kW WIND TURBINE GENERATOR
1015F28	1	CD758892	1	-	(NASA) BRAKE SUPPORT (W) BRAKE SUPPORT MOD-0A 200 kW WIND TURBINE GENERATOR.
1015F29	1	CD758895	1	-	(NASA) PULLEY DRIVE SHAFT (W) PULLEY DRIVE SHAFT MOD-0A 200 kW WIND TURB. GENERATOR
1015F30	2	CR758896	1	E	(NASA) MAIN YAW BRG SUPPORT (W) MAIN YAW BRG SUPPORT MOD-0A 200 kW WIND TURBINE GEN.
1015F31	1	CF758897	1	A	(NASA) YAW DRIVE BRG HOUSING (W) YAW DRIVE BRG HOUSING MOD-0A 200 kW WIND TURBINE GEN.
1015F32	1	CF758898	1	-	(NASA) YAW DRIVE SHAFT (W) YAW DRIVE SHAFT MOD-0A 200 kW WIND TURBINE GENERATOR
1015F33	1	CF758899	1	-	(NASA) YAW BRG RETAINER & SEAL (W) YAW-BRG RETAINERS MOD-0A 200 kW WIND TURBINE GENERATOR
1015F34	1	CD758900	1	A	(NASA) INTER. YAW DRIVE SHAFT (W) INTERMEDIATE YAW DRIVE SHAFT MOD-0A 200 kW MTG
1015F35	1	CD758901	1	B	(NASA) YAW DRIVE MOUNTING (W) YAW DRIVE MOUNTING PLATE MOD-0A 200 kW WIND TUR. GEN.
1015F36	1	CD758902	1	C	(NASA) SHEAR KEY & THRUST BUTTON (W) SHEAR KEY & THRUST BUTTON MOD-0A 200 kW WIND TUR. GEN.
1015F37	1	CC758903	1	B	(NASA) MAIN SLIP RING SUPPORT HORIZ. (W) MAIN SLIP RING SUPPORT (HORIZ.) MOD-0A 200 kW MTG

* All Westinghouse Drawings are Revision -

Sheet 3

TABLE 1 (Cont'd.)
 LIST OF DRAWINGS FOR THE MOD-OA 200 kW WIND TURBINE GENERATOR
 CORRELATION OF WESTINGHOUSE DRAWINGS TO NASA LEWIS RESEARCH CENTER DRAWINGS

WESTINGHOUSE DRAWING NUMBER	NUMBER OF SHTS.	NASA LEWIS DRAWING NUMBER	NUMBER OF SHTS.	REV.	TITLE OF DRAWING
1015F38	2	EF758904	1	C	(NASA) BREAK PRESS. SYST. (W) PIPING SCHEMATIC & PANEL LAYOUT BREAK CHAMBER & PRESSURIZING SYSTEM MOD-OA 200 kW WIND TURBINE GENERATOR
1015F39	1	CC758905 CC758907 CC758931	1 1 1	- - A	(NASA) LIFTING BOOM (NASA) "U" BOLT - BOTTLE HOLD DOWN (NASA) WIND SPEED MOUNTING BRACKET (W) LIFTING BOOM, U-BOLT & WIND SPEED & DIRECTIONAL MOUNT- BRACKET MOD-OA 200 kW WIND TURBINE GENERATOR
1015F40	1	CD758906	1	-	(NASA) HYD PACK SUPPORT BED (W) HYDRAULIC PACKAGE SUPPORT BED MOD-OA 200 kW WTG
1015F41	1	CD758909	1	B	(NASA) LIFTING BEAM & SLING ASSEMBLY (W) LIFTING BEAM & SLING ASSEMBLY MOD-OA 200 kW WTG
1015F42	1	CD758908	1	A	(NASA) HYD. PACK FAN SHROUD (W) HYDRAULIC PACKAGE FAN SHROUD MOD-OA 200 kW WTG
1015F43	3	CR758975 CR758976	1 1	A C	(NASA) SENSOR LOCATION (PLAN VIEW) (NASA) SENSOR LOCATION (ELEVATION VIEW) (W) SENSOR LOCATIONS & CONDUIT ROUTING MOD-OA 200 kW WTG
1015F44	1	CF758910	1	B	(NASA) DETAILS (W) HIGH SPEED BRADE DETAILS MOD-OA 200 kW WIND TURB. GEN.
1015F45	1	CF758912	1	A	(NASA) ROTARY COUPLING SUPPORT (W) DEUBLIN CPLG SUPPORT BRACKET MOD-OA 200 kW WTG
1015F46	1	CD758913	1	B	(NASA) LADDER (W) LADDER WELDED ASSEMBLY MOD-OA 200 kW WIND TURB. GEN.
1015F47	1	CF758914	1	-	(NASA) REAR PROP COME SUPPORTS (W) REAR PROP COME SUPPORT MOD-OA 200 kW WIND TURBINE GEN.
1015F48	1	CD758915	1	A	(NASA) HYD SUPPLY CLAMP & SUPPORTS (W) HYDRAULIC SUPPLY CLAMP & SUPPORT MOD-OA 200 kW WTG

* All Westinghouse Drawings are Revision -

Sheet 4

TABLE 1 (Cont'd.)

LIST OF DRAWINGS FOR THE MOD-OA 200 KW WIND TURBINE GENERATOR
CORRELATION OF WESTINGHOUSE DRAWINGS TO NASA LEWIS RESEARCH CENTER DRAWINGS

WESTINGHOUSE DRAWING NUMBER	NUMBER OF SHTS.	NASA LEWIS DRAWING NUMBER	NUMBER OF SHTS.	REV.	TITLE OF DRAWING
1015F49	2	CF758916	1	C	(NASA) CO AXIAL FLOW LINE ASSEMBLY (W) CO AXIAL FLOW LINE - ASSEMBLY & DETAIL MOD-OA 200 KW WIND TURBINE GENERATOR
1015F50	1	CD758919	1	A	(NASA) SPINNER RAIN GUARD (W) SPINNER RAIN GUARD MOD-OA 200 KW WIND TURBINE GENERATOR
1015F51	1	CF758920	1	A	(NASA) SLIP RING ANTI-ROTATION SUPPORT & BRKT. (W) SLIP RING ANTI-ROTATION SUPPORT & BRKT. MOD-OA 200 KW WIND TURBINE GENERATOR
1015F52	3	CF758921 CF758922 CF758923	1 1 1	A A -	(NASA) HYDRAULIC PUMP PACKAGE ASSEMBLY (W) HYDRAULIC PUMP PACKAGE ASSY MOD-OA 200 KW MTG
1015F53	2	CF758924	1	-	(NASA) DETAILS (W) HYDRAULIC PUMP PACKAGE ASSY MOD-OA 200 KW MTG
1015F54	1	CR758926	1	-	(NASA) DETAILS (W) HYDRAULIC PUMP DETAILS MOD-OA 200 KW WIND TURB. GEN.
1015F55	4	CR758926	1	B	(NASA) ACTUATOR ASSEMBLY (W) ACTUATOR ASSEMBLY MOD-OA 200 KW WIND TURB. GEN.
1015F56	1	CF758927	1	A	(NASA) DETAILS (W) ACTUATOR ASSY DETAILS MOD-OA 200 KW WIND TURB. GEN.
1015F57	1	CF758928	1	A	(NASA) DETAILS (W) ACTUATOR ASSY DETAILS MOD-OA 200 KW WIND TURB. GEN.
1015F58	1	CF758929 CP758929	1	B -	(NASA) HYDRAULIC SCHEMATIC DIAGRAM (NASA) OPERATIONAL REQUIREMENTS & PARTS LIST (W) CONTROL SCHEMATIC DIAGRAM MOD-OA 200 KW MTG
1015F59	1	CF758930	1	B	(NASA) INTERFACE-METAL BLADE TO PITCH CONTROL HUB (W) INTERFACE-BLADE TO HUB MOD-OA 200 KW WIND TURBINE GEN.
1015F60	1	None			(NASA) NONE (W) DETAILS MOD-OA 200 KW MTG

All Westinghouse Drawings are Revision -

TABLE 1 (Cont'd.)
LIST OF DRAWINGS FOR THE MOD-0A 200 kW WIND TURBINE GENERATOR
CORRELATION OF WESTINGHOUSE DRAWINGS TO NASA LEWIS RESEARCH CENTER DRAWINGS

WESTINGHOUSE DRAWING NUMBER	NUMBER OF SHTS.	NASA LEWIS DRAWING NUMBER	NUMBER OF SHTS.	* REV.	TITLE OF DRAWING
1015F61	1	CD758932	1	A	(NASA) UPPER BRAKE SUPPORT (W) UPPER BRAKE SUPPORT MOD-0A 200 kW WIND TURBINE GEN.
1015F62	1	CD758933	1	-	(NASA) TURNTABLE BEARING & GEAR ASSY (W) TURNTABLE BRG & GEAR ASSY MOD-0A 200 kW WIND TURB. GEN.
1015F63	1	CD758934	1	C	(NASA) LIFTING BEAM (W) LIFTING BEAM DETAILS MOD-0A 200 kW WIND TURBINE GEN.
1015F64	1	CF758936	1	A	(NASA) EXTERIOR FINISH-FIBERGLAS HOUSING (W) EXTERIOR FINISH-FIBERGLAS HOUSING MOD-0A 200 kW WTG
1015F65	1	CB758490 CC758937	1 1	A B	(NASA) BUTTRES RING RETAINER (NASA) TRANSFORMER BRACKETS (W) TRANSFORMER ANTI-ROTATION BRACKET & BUTTRES RING RETAINER DETAILS MOD-0A 200 kW WIND TURBINE GENERATOR
1015F66	1	CD758938	1	-	(NASA) OUTPUT SHAFT CONFIGURATION FOR DOUBLE REDUCTION WORM GEAR UNIT (W) DOUBLE REDUCTION WORM GEAR UNIT YAW DRIVE MOD-0A 200 kW WIND TURBINE GENERATOR
1015F67	1	CF758939	1	A	(NASA) TOWER SLIP RING ANTI-ROTATION ASSEMBLY (W) TOWER SLIP RING ANTI-ROTATION ASSY MOD-0A 200 kW WTG
1015F68	1	CC758871 CC758945	1 1	A A	(NASA) DETAILS (NASA) BUTTRES RING (W) DETAIL MOD-0A 200 kW WIND TURBINE GENERATOR
1015F69	1	CF758946	1	B	(NASA) MOD 0A WIND TURBINE GENERATOR SITE PLAN & GENERAL ASSY (W) SITE PLAN & GENERAL ASSY MOD-0A 200 kW WIND TURBINE GEN.
1015F70	4	CF758948 CF758949 CF758950	1 1 1	B A A	(NASA) STRUCTURAL-TOWER ELEVATION & DETAILS (NASA) STRUCTURAL-TOWER PLANS & DETAILS (NASA) STRUCTURAL-TOWER DETAILS (W) TOWER ELEVATIONS, PLAN & DETAILS MOD-0A 200 kW WTG
1015F71	2	CF758952	1	-	(NASA) STRUCTURAL-ASSEMBLY STAND PLAN & DETAILS (W) ASSY STAND PLAN & DETAILS MOD-0A 200 kW WIND TURB. GEN.

ALL Westinghouse Drawings are Revision -

TABLE 1 (Cont'd.)
 LIST OF DRAWINGS FOR THE MOD-0A 200 kW WIND TURBINE GENERATOR
 CORRELATION OF WESTINGHOUSE DRAWINGS TO NASA LEWIS RESEARCH CENTER DRAWINGS

WESTINGHOUSE DRAWING NUMBER	NUMBER OF SHTS.	NASA LEWIS DRAWING NUMBER	NUMBER OF SHTS.	REV.	TITLE OF DRAWING
1015F72	1	CD758957	1	B	(NASA) SPEED INCREASER-DIMENSIONAL REQUIREMENTS (W) SPECIAL SPEED INCREASER MOD-0A 200 kW WIND TURBINE
1015F73	1	CC758972	1	A	(NASA) GEAR BOX SLIP RING ASSEMBLY (W) GEAR BOX SLIP RING ASSEMBLY-ELECTRICAL MOD-0A 200 kW WIND TURBINE GENERATOR
1015F74	1	CF758973	1	A	(NASA) TOWER SLIP RING ASSY-ELECTRICAL (W) TOWER SLIP RING ASSY (ELEC) MOD-0A 200 kW WTG
1015F75	1	CF758974	1	B	(NASA) TOWER SLIP RING ASSY-ELECTRICAL (W) TOWER SLIP RING ASSY (ELEC) MOD-0A 200 kW WTG
1015F76	2	CF758981	1	B	(NASA) ELECTRICAL-EQUIPMENT LAYOUT, LIGHTING, GROUNDING & DETAILS (W) ELECTRICAL-EQUIPMENT LAYOUT, LIGHTING, GROUNDING & DETAILS MOD-0A 200 kW WIND TURBINE GENERATOR
1015F77	2	CF758982	1	B	(NASA) ELECTRICAL-POWER CONTROL & INSTRUMENTATION TERMINAL BOXES & DETAILS (W) ELECTRICAL-POWER CONTROL & INSTRUMENTATION TERMINAL BOXES & DETAILS MOD-0A 200 kW WIND TURBINE GENERATOR
1015F78	1	CD758999	1	-	(NASA) INTERMEDIATE SHAFT (W) HIGH SPEED SHAFT ASSEMBLY MOD-0A 200 kW WIND TURB. GEN.
1015F79	1	CF758973 CF758974	1 1	A B	(NASA) TOWER SLIP RING ASSY-ELECTRICAL (NASA) TOWER SLIP RING ASSY-ELECTRICAL (W) TOWER SLIP RING ASSY MOD-0A 200 kW WIND TURBINE GEN.
1015F80	3	CF759019 CF760485	1 1	G A	(NASA) HYDRAULIC SCHEMATIC YAW BRAKE (NASA) HYDRAULIC SYSTEM PANEL YAW BRAKE (W) YAW BRAKE HYDRAULIC SYSTEM PANEL & SCHEMATIC MOD-0A 200 kW WIND TURBINE GENERATOR
1015F81	1	CC759020 CC760504	1 1	- B	(NASA) SPACERS YAW COUPLINGS (NASA) HUB SEAL HOLDER (W) DETAILS MOD-0A 200 kW WIND TURBINE GENERATOR

* All Westinghouse Drawings are Revision -

TABLE 1 (Cont'd.)
 LIST OF DRAWINGS FOR THE MOD-0A 200 kW WIND TURBINE GENERATOR
 CORRELATION OF WESTINGHOUSE DRAWINGS TO NASA LEWIS RESEARCH CENTER DRAWINGS

WESTINGHOUSE DRAWING NUMBER	NUMBER OF SHTS.	MASA LEWIS DRAWING NUMBER	NUMBER OF SHTS.	REV.	TITLE OF DRAWING
1015F82	1	CF759021	1	-	(NASA) PULLEY BEARING SUPPORT (W) PULLEY BEARING SUPPORT MOD-0A 200 kW WIND TURB. GEN.
1015F83	1	CD759023	1	A	(NASA) DETAILS FOR HYDRAULIC ACTUATOR (W) DETAILS FOR HYDRAULIC ACTUATOR MOD-0A 200 kW MTG
1015F84	1	CF759024	1	A	(NASA) DETAILS FOR PUMP PACKAGE (W) PUMP PACKAGE DETAILS MOD-0A 200 kW WIND TURBINE GEN.
1015F85	2	CF760271	1	A	(NASA) STRUCTURAL-ASSY STAND PLAN & DETAILS (W) ASSY STAND PLAN & DETAILS MOD-0A 200 kW WIND TURB. GEN.
1015F86	2	CF760300	1	-	(NASA) STRUCTURAL-TOWER & ASSY STAND-FOUNDATIONS & DETAILS- CLAYTON N.H. (W) TOWER & ASSY STAND FOUNDATION & DETAILS MOD-0A 200 kW WIND TURBINE GENERATOR
1015F87	1	CC760476	1	-	(NASA) GREASE & PRESSURE FITTINGS (W) GREASE & PRESSURE FITTINGS MOD-0A 200 kW MTG
1015F88	1	CD760477	1	-	(NASA) HUB COUNTER WEIGHTS (W) HUB COUNTER WEIGHTS MOD-0A 200 kW WIND TURBINE GEN.
1015F89	1	CF760478	1	-	(NASA) DETAILS (W) DETAILS MOD-0A 200 kW WIND TURBINE GENERATOR
1015F90	1	CF760484	1	A	(NASA) HYDRAULIC SYSTEM PANEL YAW BRAKE (W) HYDRAULICS COMPONENTS MTG PANEL MOD-0A 200 kW MTG
1015F91	1	CF760484	1	A	(NASA) HYDRAULIC SYSTEM PANEL YAW BRAKE (W) HYDRAULIC SYSTEM PANEL YAW BRAKE-STRUCTURAL SUPPORT MOD-0A 200 kW WIND TURBINE GENERATOR
1015F92	1	CD760486	1	A	(NASA) AIR BOTTLE GAGE BRACKET (W) AIR BOTTLE GAGE BRACKET DETAILS MOD-0A 200 kW MTG

* All Westinghouse Drawings are Revision -

Sheet 8

Table 1 (Cont'd)

LIST OF DRAWINGS FOR THE MOD-0A 200 kW WIND TURBINE GENERATOR
CORRELATION OF WESTINGHOUSE DRAWINGS TO NASA LEWIS RESEARCH CENTER DRAWINGS

WESTINGHOUSE DRAWING NUMBER	NUMBER OF SHTS.	NASA LEWIS DRAWING NUMBER	NUMBER OF SHTS.	REV.	TITLE OF DRAWING
1015F93	1	CC759000 CC760487	1	A -	(NASA) FLUID COUPLER ADAPTER (NASA) GEAR ALT. LOW SPEED SHAFT (W) DETAILS MOD-0A 200 kW WIND TURBINE GENERATOR
1015F94	1	CC760488 CC760500	1	A -	(NASA) DUBLIN MOUNT (NASA) SLIP RING COVER (W) DUBLIN MOUNT & SLIP RING DUST COVER MOD-0A 200 kW MTG
1015F95	2	CF760506 CF760520	1	- -	(NASA) ELECTRICAL-LOW SPEED SHAFT STRAIN GAGE LOCATION CONNECTION DIAGRAM & INSTALLATION (NASA) ELECTRICAL-LOW SPEED SHAFT STRAIN GAGE LOCATION (W) ELECTRICAL-LOW SPEED SHAFT STRAIN GAGE LOCATION MOD-0A 200 kW WIND TURBINE GENERATOR
1015F96	1	CF760491	1	-	(NASA) YAW BRAKE ASSEMBLY (W) YAW BRAKE ASSY MOD-0A 200 kW WIND TURBINE GENERATOR
1015F97	1	C0760492	1	-	(NASA) YAW BRAKE DETAILS (W) YAW BRAKE DETAIL MOD-0A 200 kW WIND TURBINE GENERATOR
1015F98	1	C0760493	1	-	(NASA) YAW BRAKE DETAILS (W) YAW BRAKE DETAIL MOD-0A 200 kW WIND TURBINE GENERATOR
1015F99	1	CC760512 C0760513	1	- -	(NASA) FIXTURE FOR SEAL INSTALLATION (NASA) SEAL INSTALLATION INSTRUCTIONS (W) FIXTURES FOR SEAL INSTALLATION MOD-0A 200 kW MTG
1017F02	1	NONE			(NASA) NONE (W) GENERATOR TACH MOUNT ASSY WITH KEYS & DETAILS MOD-0A 200 kW WIND TURBINE GENERATOR
1017F03	2	NONE			(NASA) NONE (W) DETAILS MOD-0A 200 kW WIND TURBINE GENERATOR

*All Westinghouse Drawings are Revision -

Sheet 9

TABLE 1 (Cont'd.)

LIST OF DRAWINGS FOR THE MOD-OA 200 KW WIND TURBINE GENERATOR
CORRELATION OF WESTINGHOUSE DRAWINGS TO MASA LEWIS RESEARCH CENTER DRAWINGS

WESTINGHOUSE DRAWING NUMBER	NUMBER OF SHTS.	MASA LEWIS DRAWING NUMBER	NUMBER OF SHTS.	REV.	TITLE OF DRAWING
1017F04	1	NONE			(MASA) NONE (W) DETAILS MOD-OA 200 KW WIND TURBINE GENERATOR
1017F05	1	NONE			(MASA) NONE (W) HYDRAULIC FITTINGS MOD-OA 200 KW WIND TURBINE GENERATOR
1016F01	4	CF758968 CF758969 CF758970	1 1 1	C E C	(MASA) ELECTRICAL-INSTRUMENTATION SENSOR WIRING LIST (MASA) ELECTRICAL-INSTRUMENTATION SENSOR WIRING LIST (MASA) ELECTRICAL-INSTRUMENTATION SENSOR WIRING LIST (W) INSTRUMENTATION SENSOR WIRING LIST MOD-OA 200 KW WTG
1016F02	1	CF758971	1	E	(MASA) ELECTRICAL-POWER ONE LINE CONNECTION DIAGRAM & SCHEDULE OF DMG. (W) POWER ONE LINE CONNECTION DIAGRAM SCHEDULE OF DMG'S MOD-OA 200 KW WIND TURBINE
1016F03	1	CF758977	1	C	(MASA) ELECTRICAL-AUXILIARY ELECTRONIC PACKAGE CONNECTION & INTERCONNECTION DIAGRAM (W) AUXILIARY ELECTRONIC PACKAGE CONNECTION & INTERCONNECTION DIAGRAM MOD-OA 200 KW WIND TURBINE
1016F04	2	CF758978	1	D	(MASA) ELECTRICAL-SENSOR IDENTIFICATION LIST (CLAYTON) (W) SENSOR IDENTIFICATION LIST MOD-OA 200 KW WIND TURBINE
1016F05	1	CF758979	1	F	(MASA) ELECTRICAL-CABLE INTERCONNECTION (W) ELECTRICAL-CABLE INTERCONNECTION MOD-OA 200 KW WTG
1016F06	1	CF758980	1	-	(MASA) ELECTRICAL-INSTRUMENTATION INTERCONNECTION DIAGRAM PHASE I TEST (W) INSTRUMENTATION INTERCONNECTION DIAGRAM LERC-ERB CM 72 PHASE I TEST MOD-OA 200 KW WIND TURBINE GENERATOR
1016F07	1	CF758983	1	C	(MASA) ELECTRICAL-GEAR BOX SLIP RING CONNECTION DIAGRAM (W) GEAR BOX SLIP RING CONNECTION DIAGRAM MOD-OA 200 KW WTG
1016F08	1	CF758984	1	G	(MASA) ELECTRICAL-TOWER SLIP RING CONNECTION DIAGRAM (W) TOWER SLIP RING CONNECTION DIAGRAM MOD-OA 200 KW WTG

* All Westinghouse Drawings are Revision -

Sheet 10

TABLE 1 (Cont'd.)
 LIST OF DRAWINGS FOR THE MOD-OA 200 kW WIND TURBINE GENERATOR
 CORRELATION OF WESTINGHOUSE DRAWINGS TO NASA LEWIS RESEARCH CENTER DRAWINGS

WESTINGHOUSE DRAWING NUMBER	NUMBER OF SHTS.	NASA LEWIS DRAWING NUMBER	NUMBER OF SHTS.	REV.	TITLE OF DRAWING
1016F09	1	CF758985	1	A	(NASA) ELECTRICAL-STATIC SHAFT TEST INTERCONNECTION DIAGRAM (W) PHASE I TEST (W) STATIC SHAFT TEST INTERCONNECTION DIAGRAM LERC-ERB (W) 22 PHASE I TEST MOD-OA 200 kW WIND TURBINE GENERATOR
1016F10	1	CF759025	1	C	(NASA) ELECTRICAL-TOWER SENSOR LOCATION PLAN, DETAILS, PIN LAYOUT & ELECTRICAL CONNECTION DIAGRAM (W) TOWER SENSOR LOCATION PLAN DETAILS, PIN LAYOUT & ELECTRICAL CONNECTION DIAG. MOD-OA 200 kW WIND TURBINE
1016F11	2	CF759026	1	E	(NASA) ELECTRICAL SAFETY SHUTDOWN-ELEMENTARY DIAGRAM (W) ELECTRICAL SAFETY SHUTDOWN-ELEMENTARY DIAGRAM MOD-OA 200 kW WIND TURBINE GENERATOR
1016F12	2	CF759027	1	F	(NASA) ELECTRICAL-CONTROL ELEMENTARY DIAGRAM (W) CONTROL ELEMENTARY DIAGRAM MOD-OA 200 kW MTG
1016F13	1	CF759028	1	D	(NASA) ELECTRICAL-YAW CONTROLLER CONNECTION DIAGRAM (W) YAW CONTROLLER CONNECTION DIAGRAM MOD-OA 200 kW MTG
1016F14	1	CF759029	1	A	(NASA) ELECTRICAL-MICRO PROCESSOR FLOW DIAGRAM (W) MICRO PROCESSOR FLOW DIAGRAM MOD-OA 200 kW MTG
1016F15	1	CF759030	1	C	(NASA) ELECTRICAL-CONNECTION DIAGRAM FOR PITCH CONTROLLER (W) ELECTRICAL CONNECTION DIAGRAM PITCH CONTROLLER MOD-OA 200 kW WIND TURBINE GENERATOR
1016F16	1	CF759031	1	E	(NASA) ELECTRICAL-MICRO PROCESSOR BLOCK DIAGRAM (W) MICROPROCESSOR BLOCK DIAGRAM MOD-OA 200 kW MTG
1016F17	1	CF759032	1	E	(NASA) ELECTRICAL-SUPERVISORY CONTROLLER INTERCONNECTION CENTRAL & REMOTE (W) SUPERVISORY CONTROLLER INTERCONNECT CENTRAL & REMOTES STATIONS & DETAIL "A" MOD-OA 200 kW WIND TURBINE GENERATOR
1016F18	2	CF759033	1	E	(NASA) ELECTRICAL-PITCH CONTROLLER SCHEMATIC (W) PITCH CONTROLLER SCHEMATIC MOD-OA 200 kW WIND TURBIN

* All Westinghouse Drawings are Revision -

TABLE 1 (Cont'd.)
 LIST OF DRAWINGS FOR THE MOD-0A 200 kW WIND TURBINE GENERATOR
 CORRELATION OF WESTINGHOUSE DRAWINGS TO NASA LEWIS RESEARCH CENTER DRAWINGS

WESTINGHOUSE DRAWING NUMBER	NUMBER OF SHTS.	NASA LEWIS DRAWING NUMBER	NUMBER OF SHTS.	REV.	TITLE OF DRAWING
1016F19	2	CF759034	1	F	(NASA) ELECTRICAL-CONTROL PANEL LAYOUTS & RELAY PANEL CONNECTION DIAGRAMS (W) CONTROL PANEL LAYOUTS & RELAY PANEL CONNECTION DIAGRAMS MOD-0A 200 kW MTG
1016F20	7	CF759035 CF759036 CF759037 CF759038 CF759039	1 1 1 1 1	C E F E F	(NASA) ELECTRICAL-480 V SWITCHGEAR ONE LINE DIAGRAM (NASA) ELECTRICAL-480 V SWITCHGEAR-ELEMENTARY 3 LINE DIAGRAM (NASA) ELECTRICAL-480 V SWITCHGEAR-UNIT NO. 1 CONNECTION DIA. (NASA) ELECTRICAL-480 V SWITCHGEAR-UNIT NO. 2 CONNECTION DIA. (NASA) ELECTRICAL-480 V SWITCHGEAR-UNIT NO. 3 CONNECTION DIA. (W) 480 V SWITCHGEAR WIRING DIAGRAM UNIT NOS. 1, 2 & 3 MOD-0A 200 kW MTG
1016F21	3	CF759040 CF759041 CF759042	1 1 1	D E D	(NASA) ELECTRICAL-CONNECTION DIAGRAM FOR TERMINAL BOXES 2B & 3B (NASA) ELECTRICAL-CONNECTION DIAGRAM FOR TERMINAL BOXES 2A & 2B (NASA) ELECTRICAL-CONNECTION DIAGRAM FOR TERMINAL BOXES NO. 4 (W) CONNECTION DIAGRAMS FOR TERMINAL BOXES, 2B, 3B, 2A, 3A & NO. 4 MOD-0A 200 kW MTG
1016F22	1	CF759043	1	F	(NASA) ELECTRICAL-ELECTRICAL CONNECTION DIAGRAM SAFETY SHUTDOWN PANEL (W) ELECTRICAL CONNECTION DIAGRAM SAFETY SHUTDOWN PANEL MOD-0A 200 kW MTG
1016F23	1	CF759044	1	E	(NASA) ELECTRICAL-YAW BRAKE ELEMENTARY & CONNECTION DIAGRAM (W) YAW BRAKE ELEMENTARY & CONNECTION DIAGRAM MOD-0A 200 kW MTG
1016F24	1	CF759045	1	C	(NASA) ELECTRICAL-MICRO PROCESSOR CIRCUIT CARD LOCATOR RACK A & RACK B (W) MICRO PROCESSOR CIRCUIT CARD LOCATION, RACK A & RACK B MOD-0A 200 kW MTG
1016F25	1	CF759047	1	D	(NASA) ELECTRICAL-YAW CONTROL PANEL LAYOUT (W) YAW CONTROL PANEL LAYOUT MOD-0A 200 kW MTG

* All Westinghouse Drawings are Revision -

Sheet 12

Table 1 (Cont'd)

LIST OF DRAWINGS FOR THE MOD-0A 200 KW WIND TURBINE GENERATOR
CORRELATION OF WESTINGHOUSE DRAWINGS TO NASA LEWIS RESEARCH CENTER DRAWINGS

WESTINGHOUSE DRAWING NUMBER	NUMBER OF SHTS.	NASA LEWIS DRAWING NUMBER	NUMBER OF SHTS.	*REV.	TITLE OF DRAWING
1016F26	1	CF759048	1	D	(NASA) ELECTRICAL-CONTROL RACK ANALOG TERMINAL STRIP INTERCONNECTION (W) CONTROL RACK ANALOG TERMINAL STRIP INTERCONNECTION MOD-0A 200 KW WIND TURBINE GENERATOR
1016F27	1	CF759049	1	E	(NASA) ELECTRICAL-ELECTRICAL CONNECTION DIAGRAM AMPLIFIER PANEL (W) ELECTRICAL CONNECTION DIAGRAM AMPLIFIER PANEL MOD-0A KW WIND TURBINE GENERATOR
1016F28	4	CF760480	3	-	(NASA) ELECTRICAL-INTRUSION ALARM (W) INTRUSION ALARM SYSTEM ALARM SYSTEM & ELEC. ELEMENTARY CONNECTION DIAGRAM & INSTALLATION DETAIL MOD-0A 200 KW WTG
1016F30	1	CD760481 CD760482	1	B	(NASA) ELECTRICAL-MICROPROCESSOR TIMER-CARD SCHEMATIC (NASA) ELECTRICAL-MICROPROCESSOR RELAY-CARD SCHEMATIC (W) MICROPROCESSOR TIMER-CARD AND RELAY-CARD SCHEMATIC MOD-0A 200 KW WTG
1016F31	1	CF760494	1	B	(NASA) ELECTRICAL-ELAPSE TIME PANEL (W) ELAPSE TIME PANEL MOD-0A 200 KW WIND TURBINE GENERATOR
1016F32	1	CF760495	1	C	(NASA) ELECTRICAL-RECLOSER & CIRCUIT BREAKER NO. 2 ELEMENTARY & WIRING DIAGRAMS (W) RECLOSER & CIRCUIT BREAKER NO. 2 ELEMENTARY & WIRING DIAGRAMS MOD-0A 200 KW WIND TURBINE GENERATOR
1016F33	1	CF760496	1	D	(NASA) ELECTRICAL-CLIMATRONICS & REFERENCE PANEL CONNECTION DIAGRAM (W) ELECTRICAL CONNECTION DIAGRAM CLIMATRONICS & REFERENCE PANEL MOD-0A 200 KW WIND TURBINE GENERATOR
1016F34	1	CF760497	1	B	(NASA) ELECTRICAL-PITCH CONTROLLER INTERNAL TERMINATIONS (W) PITCH CONTROLLER INTERNAL TERMINATIONS MOD-0A 200 KW WTG

*All Westinghouse Drawings are Revision -

Sheet 13

Table I (Cont'd)

LIST OF DRAWINGS FOR THE MOD-0A 200 KW WIND TURBINE GENERATOR
CORRELATION OF WESTINGHOUSE DRAWINGS TO NASA LEWIS RESEARCH CENTER DRAWINGS

WESTINGHOUSE DRAWING NUMBER	NUMBER OF SHTS.	NASA LEWIS DRAWING NUMBER	NUMBER OF SHTS.	*REV.	TITLE OF DRAWING
1016F35	1	CF760546	1	-	(NASA) ELECTRICAL-SYNCHRO-D.C. CONVERTER-AEROVANE TRANSLATER SCHEMATIC
1016F36	1	CF760552	1	-	(H) SYNCHRO-D.C. CONVERTER AEROVANE TRANSLATOR SCHEMATIC MOD-0A 200 KW WIND TURBINE GENERATOR
					(NASA) DAYTRONICS CONNECTION DIAGRAM-ELECTRICAL
					(H) DAYTRONICS CONNECTION DIAGRAM MOD-0A 200 KW WTG

*All Westinghouse Drawings are Revision -

Sheet 14 of 14

TABLE 2
 LIST OF DRAWINGS FOR THE MOD-OA 200 KW WIND TURBINE GENERATOR
 CORRELATION OF NASA LEWIS RESEARCH CENTER DRAWINGS TO WESTINGHOUSE DRAWINGS

NASA LEWIS DRAWING NUMBER	NUMBER OF SHTS.	*REV	WESTINGHOUSE DRAWING NUMBER	NUMBER OF SHTS.	TITLE OF DRAWING
CD758836	1	A	1015F02	1	(NASA) HUB FORGING (W) HUB PITCH FORGING MOD OA-200 KW WIND TURBINE GENERATOR
CR758862	1	F	1015F01	11	(NASA) MOD-OA 200 KW WIND TURBINE GENERATOR ASSEMBLY (W) ASSEMBLY MOD-OA 200 KW WIND TURBINE GENERATOR
CR758863	1	G	1015F01	11	(NASA) MOD-OA 200 KW WIND TURBINE GENERATOR ASSEMBLY (W) ASSEMBLY MOD-OA 200 KW WIND TURBINE GENERATOR
CR758864	1	D	1015F03	4	(NASA) ASSEMBLY-GEAR TYPE PITCH CONTROL HUB (W) PITCH CONTROL HUB ASS'Y MOD-OA 200 KW WIND TURB. GEN.
CF758865	1	B	1015F04	1	(NASA) ASSEMBLY-GEAR TYPE PITCH CONTROL HUB - DETAIL 1 (W) HUB PITCH DETAIL MOD-OA 200 KW WIND TURBINE GENERATOR
CD758866	1	A	1015F05	1	(NASA) ASSEMBLY-GEAR TYPE PITCH CONTROL HUB - DETAIL 2 (W) BLADE SPINDLE SLEEVE MOD-OA 200 KW WIND TURBINE GEN.
CD758867	1	D	1015F06	1	(NASA) ASSEMBLY-GEAR TYPE PITCH CONTROL HUB - DETAIL 3 (W) BLADE SPINDLE HOUSING MOD-OA 200 KW WIND TURBINE GEN.
CD758868	1	C	1015F07	1	(NASA) ASSEMBLY-GEAR TYPE PITCH CONTROL HUB - DETAIL 4 (W) DRIVE SHAFT BEARING RETAINER MOD-OA 200 KW WTG
CD758869	1	B	1015F08	1	(NASA) ASS'Y-GEAR TYPE PITCH CONTROL HUB-DETAILS 5 THRU 11 (W) HUB PITCH DETAILS MOD-OA 200 KW WIND TURBINE GENERATOR
CD758870	1	A	1015F09	1	(NASA) ASSEMBLY-GEAR TYPE PITCH CONTROL HUB - DETAIL 12 (W) HUB PITCH DRIVE SHAFT MOD-OA 200 KW WIND TURBINE GEN.
CC758871	1	A	1015F68	1	(NASA) DETAILS (W) HUB PITCH DETAILS MOD-OA 200 KW WIND TURBINE GENERATOR

*All Westinghouse Drawings are Revision - (i.e., Unrevised)

TABLE 2 (Cont'd.)
 LIST OF DRAWINGS FOR THE M00-OA 200 kW WIND TURBINE GENERATOR
 CORRELATION OF NASA LEWIS RESEARCH CENTER DRAWINGS TO WESTINGHOUSE DRAWINGS

ASA LEWIS DRAWING NUMBER	NUMBER OF SHTS.	REV.	WESTINGHOUSE DRAWING NUMBER	NUMBER OF SHTS.	TITLE OF DRAWING
CD758872	1	C	1015F10	1	(NASA) ASSEMBLY-GEAR TYPE PITCH CONTROL HUB - DETAIL 15 (W) HUB PITCH BEVEL PINION GEAR M00-OA 200 kW WTG.
CD758873	1	C	1015F11	1	(NASA) ASSEMBLY-GEAR TYPE PITCH CONTROL HUB - DETAIL 16 (W) HUB PITCH BEVEL GEAR SECTOR M00-OA 200 kW WTG.
CF758874	1	C	1015F12	1	(NASA) ASS'Y-GEAR TYPE PITCH CONTROL HUB-DETAILS 17 THRU 25 (W) HUB PITCH DETAILS M00-OA 200 kW WIND TURBINE GENERATOR
CD758875	1	C	1015F03	4	(NASA) SUB-ASSEMBLY BEARING & GEAR ADJUSTMENT (W) PITCH CONTROL HUB ASS'Y M00-OA 200 kW WIND TURB. GEN.
CR758877	1	E	1015F14	6	(NASA) BEDPLATE (W) BEDPLATE M00-OA 200 kW WIND TURBINE GENERATOR
CR758878	1	D	1015F15	3	(NASA) FWD CENTER SHROUD (W) FORWARD CENTER SHROUD M00-OA 200 kW WIND TURBINE GEN.
CR758879	1	E	1015F16	4	(NASA) REAR CENTER SHROUD (W) REAR CENTER SHROUD M00-OA 200 kW WIND TURB. GENERATOR
CF758880	1	A	1015F17	1	(NASA) NOSE CONE (W) NOSE CONE M00-OA 200 kW WIND TURBINE GENERATOR
CF758881	1	C	1015F18	1	(NASA) PROP CONE (W) PROP CONE (SPINNER) M00-OA 200 kW WIND TURBINE GEN.
CD758882	1	B	1015F19	1	(NASA) PROP HUB & CONE COVER PLATE (W) BLADE OPENING COVERS M00-OA 200 kW WIND TURBINE GEN.
CD758883	1	-	1015F20	1	(NASA) CONE SUPPORT DETAILS (W) CONE SUPPORT DETAILS M00-OA 200 kW WIND TURBINE GEN.
CD758884	1	A	1015F21	1	(NASA) FRONT HUB SUPPORT (W) MOUNTING PANEL-PROP CONE M00-OA 200 kW WIND TURB. GEN.

* All Westinghouse Drawings are Revision -

Sheet 2

TABLE 2 (Cont'd.)
 LIST OF DRAWINGS FOR THE MOD-0A 200 KW WIND TURBINE GENERATOR
 CORRELATION OF NASA LEWIS RESEARCH CENTER DRAWINGS TO WESTINGHOUSE DRAWINGS

ASA LEWIS WING NUMBER	NUMBER OF SHTS.	REV	WESTINGHOUSE DRAWING NUMBER	NUMBER OF SHTS.	TITLE OF DRAWING
C0758885	1	-	1015F22	1	(NASA) BEAR HUB SUPPORT (W) SUPPORT-PROP CONE MOD-0A 200 KW WIND TURBINE GENERATOR
CF758885	1	C	1015F23	2	(NASA) WALKWAYS (W) WALKWAYS MOD-0A 200 KW WIND TURBINE GENERATOR
CF758887	1	A	1015F24	1	(NASA) ADJ. GENERATOR BOTTOM PLATE (W) BOTTOM PLATE-GENERATOR ADJUSTMENT MOD-0A 200 KW WTG
CF758888	1	A	1015F25	1	(NASA) ADJ. GEN. TOP & LOCK BAR (W) GENERATOR ADJUSTMENT DETAILS
CF758889	1	C	1015F26	1	(NASA) DETAILS (W) DETAILS MOD-0A 200 KW WIND TURBINE GENERATOR
CF758890	1	C	1015F27	1	(NASA) MAIN DRIVE SHAFT (W) MAIN DRIVE SHAFT MOD-0A 200 KW WIND TURBINE GENERATOR
C0758892	1	-	1015F28	1	(NASA) BRAKE SUPPORT (W) BRAKE SUPPORT MOD-0A 200 KW WIND TURBINE GENERATOR.
C0758895	1	-	1015F29	1	(NASA) PULLEY DRIVE SHAFT (W) PULLEY DRIVE SHAFT MOD-0A 200 KW WIND TURB. GENERATOR
CR758896	1	E	1015F30	2	(NASA) MAIN YAW BRG SUPPORT (W) MAIN YAW BRG SUPPORT MOD-0A 200 KW WIND TURBINE GEN.
CF758897	1	A	1015F31	1	(NASA) YAW DRIVE BRG HOUSING (W) YAW DRIVE BRG HOUSING MOD-0A 200 KW WIND TURBINE GEN.
CF758898	1	-	1015F32	1	(NASA) YAW DRIVE SHAFT (W) YAW DRIVE SHAFT MOD-0A 200 KW WIND TURBINE GENERATOR
CF758899	1	-	1015F33	1	(NASA) YAW BRG RETAINER & SEAL (W) YAW-BRG RETAINERS MOD-0 200 KW WIND TURBINE GENERATOR
C0758900	1	A	1015F34	1	(NASA) INTER. YAW DRIVE SHAFT (W) INTERMEDIATE YAW DRIVE SHAFT MOD-0A 200 KW WTG

* All Westinghouse Drawings are Revised -

TABLE 2 (Cont'd.)
 LIST OF DRAWINGS FOR THE MOD-0A 200 KW WIND TURBINE GENERATOR
 CORRELATION OF NASA LEWIS RESEARCH CENTER DRAWINGS TO WESTINGHOUSE DRAWINGS

SA LEWIS DWS NUMBER	NUMBER OF SHTS.	REV	WESTINGHOUSE DRAWING NUMBER	NUMBER OF SHTS.	TITLE OF DRAWING
CD758901	1	B	1015F35	1	(NASA) YAW DRIVE MOUNTING (W) YAW DRIVE MOUNTING PLATE MOD-0A 200 KW WIND TURB. GEN.
CD758902	1	C	1015F36	1	(NASA) SHEAR KEY & THRUST BUTTOM (W) SHEAR KEY & THRUST BUTTOM MOD-0A 200 KW WIND TURB. GEN.
CD758903	1	B	1015F37	1	(NASA) MAIN SLIP RING SUPPORT HORIZ. (W) MAIN SLIP RING SUPPORT (HORIZ.) MOD-0A 200 KW WTG
CF758904	1	C	1015F38	2	(NASA) BREAK PRESS. SYST. (W) PIPING SCHEMATIC & PANEL LAYOUT BRAKE CHAMBER & & PRESSURIZING SYSTEM MOD-0A 200 KW WIND TURBINE GEN.
CD758905	1	-	1015F39	1	(NASA) LIFTING BOOM (W) LIFTING BOOM, U-BOLT & WIND SPEED & DIRECTIONAL MOUNT. BRACKET MOD-0A 200 KW WIND TURBINE GENERATOR
CD758906	1	-	1015F40	1	(NASA) HYD PACK SUPPORT BED (W) HYDRAULIC PACKAGE SUPPORT BED MOD-0A 200 KW WTG
CD758907	1	-	1015F39	1	(NASA) "U" BOLT - BOTTLE HOLD DOWN (W) LIFTING BOOM, U-BOLT & WIND SPEED & DIRECTIONAL MOUNT. BRACKET MOD-0A 200 KW WIND TURBINE GENERATOR
CD758908	1	A	1015F42	1	(NASA) HYD PACK FAN SHROUD (W) HYDRAULIC PACKAGE FAN SHROUD MOD-0A 200 KW WTG
CD758909	1	B	1015F41	1	(NASA) LIFTING BEAM & SLING ASSEMBLY (W) LIFTING BEAM & SLING ASSEMBLY MOD-0A 200 KW WTG
CF758910	1	B	1015F44	1	(NASA) DETAILS (W) HIGH SPEED BRADE DETAILS MOD-0A 200 KW WIND TURB. GEN.

* All Westinghouse Drawings are Revision -

TABLE 2 (Cont'd.)
 LIST OF DRAWINGS FOR THE MOD-0A 200 kW WIND TURBINE GENERATOR
 CORRELATION OF NASA LEWIS RESEARCH CENTER DRAWINGS TO WESTINGHOUSE DRAWINGS

SA LEWIS ING NUMBER	NUMBER OF SHTS.	REV	WESTINGHOUSE DRAWING NUMBER	NUMBER OF SHTS.	TITLE OF DRAWING
CF758912	1	A	1015F45	1	(NASA) ROTARY COUPLING SUPPORT (W) DEUBLIN CPLG SUPPORT BRACKET MOD-0A 200 kW MTG
C0758913	1	B	1015F46	1	(NASA) LADDER (W) LADDER WELDED ASSEMBLY MOD-0A 200 kW MTG
C0758914	1	-	1015F47	1	(NASA) REAR PROP CONE SUPPORTS (W) REAR PROP CONE SUPPORT MOD-0A 200 kW MTG
C0758915	1	A	1015F48	1	(NASA) HYD SUPPLY CLAMP & SUPPORTS (W) HYDRAULIC SUPPLY CLAMP & SUPPORT MOD-0A 200 kW MTG
C0758916	1	C	1015F49	1	(NASA) CO AXIAL FLOW LINE ASSEMBLY (W) CO AXIAL FLOW LINE - ASSEMBLY & DETAIL MOD-0A 200 kW MTG
C0758919	1	A	1015F50	1	(NASA) SPINNER RAIN GUARD (W) SPINNER RAIN GUARD MOD-0A 200 kW MTG
CF758920	1	A	1015F51	1	(NASA) SLIP RING ANTI-ROTATION & BRKT. (W) SLIP RING ANTI-ROTATION SUPPORT & BRKT. MOD-0A 200 kW MTG
CF758921	1	A	1015F52	3	(NASA) HYDRAULIC PUMP PACKAGE ASSEMBLY (W) HYDRAULIC PUMP PACKAGE ASSY MOD-0A 200 kW MTG
CF758922	1	A	1015F52	3	(NASA) HYDRAULIC PUMP PACKAGE ASSEMBLY (W) HYDRAULIC PUMP PACKAGE ASSY MOD-0A 200 kW MTG
CF758923	1	-	1015F52	3	(NASA) HYDRAULIC PUMP PACKAGE ASSEMBLY (W) HYDRAULIC PUMP PACKAGE ASSY MOD-0A 200 kW MTG
CF758924	1	-	1015F53	2	(NASA) DETAILS (W) HYDRAULIC PUMP PACKAGED ASSY MOD-0A 200 kW MTG

* All Westinghouse Drawings are Revision -

Sheet 5

TABLE 2 (Cont'd.)
 LIST OF DRAWINGS FOR THE MOD-0A 200 KW WIND TURBINE GENERATOR
 CORRELATION OF WESTINGHOUSE DRAWINGS TO NASA LEWIS RESEARCH CENTER DRAWINGS

ASA LEWIS DRAWING NUMBER	NUMBER OF SHTS.	REV	WESTINGHOUSE DRAWING NUMBER	NUMBER OF SHTS.	TITLE OF DRAWING
CF758925	1	-	1015F54	1	(NASA) DETAILS (W) HYDRAULIC PUMP DETAILS MOD-0A 200 KW WIND TURB. GEN.
DR758926	1	B	1015F55	4	(NASA) ACTUATOR ASSEMBLY (W) ACTUATOR ASSEMBLY MOD-0A 200 KW WIND TURB. GEN.
CF758927	1	A	1015F56	1	(NASA) DETAILS (W) ACTUATOR ASSY DETAILS MOD-0A 200 KW WIND TURB. GEN.
CF758928	1	A	1015F57	1	(NASA) DETAILS (W) ACTUATOR ASSY DETAILS MOD-0A 200 KW WIND TURB. GEN.
CF758929	1	B	1015F58	1	(NASA) HYDRAULIC SCHEMATIC DIAGRAM (W) CONTROL SCHEMATIC DIAGRAM MOD-0A 200 KW WTG
CF758929	7	-	1015F58	1	(NASA) OPERATIONAL REQUIREMENTS & PARTS LIST (W) CONTROL SCHEMATIC DIAGRAM MOD-0A 200 KW WTG
CF758930	1	B	1015F59	1	(NASA) INTERFACE-METAL BLADE TO PITCH CONTROL HUB (W) INTERFACE-BLADE TO HUB MOD-0A 200 KW WIND TURBINE GEN.
CC758931	1	A	1015F39	1	(NASA) WIND SPEED MOUNTING BRK'D (W) LIFTING BOOM, U-BOLT & WIND SPEED & DIRECTIONAL MOUNT- BRACKET MOD-0A 200 KW WIND TURBINE GENERATOR
CD758932	1	A	1015F61	1	(NASA) UPPER BRAKE SUPPORT (W) UPPER BRAKE SUPPORT MOD 0A-200 KW WIND TURBINE GEN.
CD758933	1	-	1015F62	1	(NASA) TURNTABLE BEARING & GEAR ASSY. (W) TURNTABLE BRG. & GEAR ASSY MOD-0A 200 KW WTG

* All Westinghouse Drawings are Revision -

Sheet 6

TABLE 2 (Cont'd.)
 LIST OF DRAWINGS FOR THE MOD-OA 200 KW WIND TURBINE GENERATOR
 CORRELATION OF NASA LEWIS RESEARCH CENTER DRAWINGS TO WESTINGHOUSE DRAWINGS

SA LEWIS ING NUMBER	NUMBER OF SHTS.	* REV	WESTINGHOUSE DRAWING NUMBER	NUMBER OF SHTS.	TITLE OF DRAWING
CD758934	1	C	1015F63	1	(NASA) LIFTING BEAM (W) LIFTING BEAM DETAILS MOD-OA 200 KW WIND TURBINE GEN.
CF758936	1	A	1015F64	1	(NASA) EXTERIOR FINISH - FIBERGLASS HOUSING (W) EXTERIOR FINISH-FIBERGLAS HOUSING MOD-OA 200 KW MTG
CC758937	1	B	1015F65	1	(NASA) TRANSFORMER BRACKETS (W) TRANSFORMER ANTI-ROTATION BRACKET & BUTTRES RING RETAINER DETAILS MOD-OA 200 KW WIND TURBINE GENERATOR
CD758938	1	-	1015F66	1	(NASA) OUTPUT SHAFT CONFIGURATION FOR DOUBLE REDUCTION WORM GEAR UNIT (W) DOUBLE REDUCTION WORM GEAR UNIT YAW DRIVE MOD-OA 200 KW WIND TURBINE GENERATOR
CF758939	1	A	1015F67	1	(NASA) TOWER SLIP RING ANTI-ROTATION ASSEMBLY (W) TOWER SLIP RING ANTI-ROTATION ASSY MOD-OA 200 KW MTG
CC758945	1	A	1015F68	1	(NASA) BUTTRES RING (W) DETAIL MOD-OA 200 KW WIND TURBINE GENERATOR
CF758946	1	B	1015F69	1	(NASA) MOD OA WIND TURBINE GENERATOR SITE PLAN & GENERAL ASSY (W) SITE PLAN & GENERAL ASSY MOD-OA 200 KW WIND TURBINE GEN.
CF758948	1	B	1015F70	4	(NASA) STRUCTURAL-TOWER ELEVATION & DETAILS (W) TOWER ELEVATIONS, PLAN & DETAILS MOD-OA 200 KW MTG
CF758949	1	A	1015F90	4	(NASA) STRUCTURAL-TOWER PLANS & DETAILS (W) TOWER ELEVATIONS, PLAN & DETAILS MOD-OA 200 KW MTG

* All Westinghouse Drawings are Revision -

Sheet 7

TABLE 2 (Cont'd.)
 LIST OF DRAWINGS FOR THE MOD-0A 200 kW WIND TURBINE GENERATOR
 CORRELATION OF NASA LEWIS RESEARCH CENTER DRAWINGS TO WESTINGHOUSE DRAWINGS

ASA LEWIS WING NUMBER	NUMBER OF SHTS.	REV	WESTINGHOUSE DRAWING NUMBER	NUMBER OF SHTS.	TITLE OF DRAWING
CF758950	1	A	1015F70	4	(NASA) STRUCTURAL-TOWER DETAILS (W) TOWER ELEVATIONS, PLAN & DETAILS MOD-0A 200 kW MTG
CF758952	1	-	1015F71	2	(NASA) STRUCTURAL-ASSEMBLY STAND PLAN & DETAILS (W) ASSY STAND PLAN & DETAILS MOD-0A 200 kW WIND TURB. GEN.
CD758957	1	B	1015F72	1	(NASA) SPEED INCREASE-DIMENSIONAL REQUIREMENTS (W) SPECIAL SPEED INCREASE MOD-0A 200 kW WIND TURBINE GEN.
CF758968	1	C	1016F01	4	(NASA) ELECTRICAL-INSTRUMENTATION SENSOR WIRING LIST (W) INSTRUMENTATION SENSOR WIRING LIST MOD-0A 200 kW MTG
CF758969	1	E	1016F01	4	(NASA) ELECTRICAL-INSTRUMENTATION SENSOR WIRING LIST (W) INSTRUMENTATION SENSOR WIRING LIST MOD-0A 200 kW MTG
CF758970	1	C	1016F01	4	(NASA) ELECTRICAL-INSTRUMENTATION SENSOR WIRING LIST (W) INSTRUMENTATION SENSOR WIRING LIST MOD-0A 200 kW MTG
CF758971	1	E	1016F02	1	(NASA) ELECTRICAL-POWER ONE LINE CONNECTION DIAGRAM & SCHEDULE OF DMG. (W) POWER ONE LINE CONNECTION DIAGRAM SCHEDULE OF DMG'S MOD-0A 200 kW WIND TURBINE GENERATOR
CC758972	1	A	1015F73	1	(NASA) GEAR BOX SLIP RING ASSEMBLY (W) GEAR BOX SLIP RING ASSY-ELECTRICAL MOD-0A 200 kW MTG
CF758973	1	A	1015F74 1015F79	1	(NASA) TOWER SLIP RING ASSY-ELECTRICAL (W) TOWER SLIP RING ASSY (ELEC) MOD-0A 200 kW MTG

All Westinghouse Drawings are Revision 1-

Sheet 8

TABLE 2 (Cont'd.)
 LIST OF DRAWINGS FOR THE MOD-OA 200 kW WIND TURBINE GENERATOR
 CORRELATION OF NASA LEWIS RESEARCH CENTER DRAWINGS TO WESTINGHOUSE DRAWINGS

NASA LEWIS DRAWING NUMBER	NUMBER OF SHTS.	REV	WESTINGHOUSE DRAWING NUMBER	NUMBER OF SHTS.	TITLE OF DRAWING
CF758974	1	B	1015F75 1015F79	1	(NASA) TOWER SLIP RING ASSY-ELECTRICAL (W) TOWER SLIP RING ASSY MOD-OA 200 kW WIND TURBINE GEN.
CR758975	1	A	1015F43	3	(NASA) SENSOR LOCATION (PLAN VIEW) (W) SENSOR LOCATION & CONDUIT ROUTING MOD-OA 200 kW MTG
CR758976	1	C	1015F43	3	(NASA) SENSOR LOCATION (ELEVATION VIEW) (W) ELECTRICAL SENSOR LOCATIONS MOD-OA 200 kW MTG
CF758977	1	C	1016F03	1	(NASA) ELECTRICAL-AUXILIARY ELECTRONIC PACKAGE CONNECTION & INTERCONNECTION DIAGRAM (W) AUXILIARY ELECTRONIC PACKAGE CONNECTION & INTERCONNECTION DIAGRAM MOD-OA 200 kW WIND TURBINE
CF758978	1	D	1016F04	2	(NASA) ELECTRICAL-SENSOR IDENTIFICATION LIST (CLAYTON) (W) SENSOR IDENTIFICATION LIST MOD-OA 200 kW MTG
CF758979	1	F	1016F05	1	(NASA) ELECTRICAL-CABLE INTERCONNECTION (W) ELECTRICAL-CABLE INTERCONNECTION MOD-OA 200 kW MTG
CF758980	1	-	1016F06	1	(NASA) ELECTRICAL-INSTRUMENTATION INTERCONNECTION DIAGRAM PHASE I TEST (W) INSTRUMENTATION INTERCONNECTION DIAGRAM LERC-ERB CW 22 PHASE I TEST MOD-OA 200 kW WIND TURBINE
CF758981	1	B	1015F76	2	(NASA) ELECTRICAL-EQUIPMENT LAYOUT, LIGHTING, GROUNDING & DETA (W) ELECTRICAL-EQUIPMENT LAYOUT, LIGHTING, GROUNDING DETAILS MOD-OA 200 kW MTG
CF758982	1	B	1015F77	2	(NASA) ELECTRICAL-POWER CONTROL & INSTRUMENTATION TERMINAL BOXES & DETAILS (W) ELECTRICAL-POWER CONTROL & INSTRUMENTATION TERMINAL BOXES MOD-OA 200 kW MTG

* All Westinghouse Drawings are Revision -

Sheet 9

TABLE 2 (Cont'd.)
 LIST OF DRAWINGS FOR THE MOD-OA 200 KW WIND TURBINE GENERATOR
 CORRELATION OF NASA LEWIS RESEARCH CENTER DRAWINGS TO WESTINGHOUSE DRAWINGS

ASA LEWIS WING NUMBER	NUMBER OF SHTS.	WESTINGHOUSE DRAWING NUMBER	* REV	NUMBER OF SHTS.	TITLE OF DRAWING
CF758983	1	1016F07	C	1	(NASA) ELECTRICAL-GEAR BOX SLIP RING CONNECTION DIAGRAM (W) GEAR BOX SLIP RING CONNECTION DIAGRAM MOD-OA 200 KW WTG
CF758984	1	1016F08	G	1	(NASA) ELECTRICAL-TOWER SLIP RING CONNECTION DIAGRAM (W) TOWER SLIP RING CONNECTION DIAGRAM MOD-OA 200 KW WTG
CF758985	1	1016F09	A	1	(NASA) ELECTRICAL-STATIC SHAFT TEST INTERCONNECTION DIAGRAM PHASE I TEST (W) STATIC SHAFT TEST INTERCONNECTION DIAGRAM LERC-ERB CW 22 PHASE I TEST MOD-OA 200 KW WIND TURBINE GENERATOR
CD758999	1	1015F78	-	1	(NASA) INTERMEDIATE SHAFT (W) HIGH SPEED SHAFT ASSEMBLY MOD-OA 200 KW WIND TURB. GEN.
CC759000	1	1015F93	A	1	(NASA) FLUID COUPLER ADAPTER (W) DETAILS MOD-OA 200 KW WIND TURBINE GENERATOR
CF759019	1	1015F80	G	3	(NASA) HYDRAULIC SCHEMATIC YAW BRAKE (W) YAW BRAKE HYDRAULIC SYSTEM PANEL & SCHEMATIC MOD-OA 200 KW WIND TURBINE GENERATOR
CC759020	1	1015F81	-	1	(NASA) SPACERS YAW COUPLINGS (W) DETAILS MOD-OA 200 KW WIND TURBINE GENERATOR
CF759021	1	1015F82	-	1	(NASA) PULLEY BEARING SUPPORT (W) PULLEY BEARING SUPPORT MOD-OA 200 KW WIND TURB. GEN.
CD759023	1	1015F83	A	1	(NASA) DETAILS FOR HYDRAULIC ACTUATOR (W) DETAILS FOR HYDRAULIC ACTUATOR MOD-OA 200 KW WTG
CF759024	1	1015F84	A	1	(NASA) DETAILS FOR PUMP PACKAGE (W) PUMP PACKAGE DETAILS MOD-OA 200 KW WIND TURBINE GEN.

* All Westinghouse Drawings are Revision -

Sheet 10

TABLE 2 (Cont'd.)
 LIST OF DRAWINGS FOR THE MOD-OA 200 kW WIND TURBINE GENERATOR
 CORRELATION OF NASA LEWIS RESEARCH CENTER DRAWINGS TO WESTINGHOUSE DRAWINGS

ASA LEWIS DRAWING NUMBER	NUMBER OF SHTS.	REV	WESTINGHOUSE DRAWING NUMBER	NUMBER OF SHTS.	TITLE OF DRAWING
CF759025	1	C	1016F10	1	(NASA) ELECTRICAL-TOWER SENSOR LOCATION PLAN, DETAILS, PIN LAYOUT & ELECTRICAL CONNECTION DIAGRAM (W) TOWER SENSOR LOCATION PLAN DETAILS, PIN LAYOUT & ELECTRICAL CONNECTION DIAG. MOD-OA 200 kW WTG
CF759026	1	E	1016F11	2	(NASA) ELECTRICAL SAFETY SHUTDOWN-ELEMENTARY DIAGRAM (W) ELECTRICAL SAFETY SHUTDOWN-ELEMENTARY DIAGRAM MOD-OA 200 kW WIND TURBINE GENERATOR
CF759027	1	F	1016F12	2	(NASA) ELECTRICAL-CONTROL ELEMENTARY DIAGRAM (W) CONTROL ELEMENTARY DIAGRAM MOD-OA 200 kW WTG
CF759028	1	D	1016F13	1	(NASA) ELECTRICAL-YAW CONTROLLER CONNECTION DIAGRAM (W) YAW CONTROLLER CONNECTION DIAGRAM MOD-OA 200 kW WTG
CF759029	1	A	1016F14	1	(NASA) ELECTRICAL-MICROPROCESSOR FLOW DIAGRAM (W) MICROPROCESSOR FLOW DIAGRAM MOD-OA 200 kW WTG
CF759030	1	C	1016F15	1	(NASA) ELECTRICAL-CONNECTION DIAGRAM FOR PITCH CONTROLLER (W) ELECTRICAL CONNECTION DIAGRAM PITCH CONTROLLER MOD-OA 200 kW WIND TURBINE GENERATOR
CF759031	1	E	1016F16	1	(NASA) ELECTRICAL-MICROPROCESSOR BLOCK DIAGRAM (W) MICROPROCESSOR BLOCK DIAGRAM MOD-OA 200 kW WTG
CF759032	1	E	1016F17	1	(NASA) ELECTRICAL-SUPERVISORY CONTROLLER INTERCONNECTION CENTRAL & REMOTE (W) SUPERVISORY CONTROLLER INTERCONNECT CENTRAL & REMOTES STATIONS & DETAIL "A" MOD-OA 200 kW WIND TURBINE GENERATOR
CF759033	1	E	1016F18	2	(NASA) ELECTRICAL-PITCH CONTROLLER SCHEMATIC (W) PITCH CONTROLLER SCHEMATIC MOD-OA 200 kW WTG

* All Westinghouse Drawings are Revision -

Sheet 11

TABLE 2 (Cont'd.)
 LIST OF DRAWINGS FOR THE MOD-OA 200 KW WIND TURBINE GENERATOR
 CORRELATION OF NASA LEWIS RESEARCH CENTER DRAWINGS TO WESTINGHOUSE DRAWINGS

NASA LEWIS DRAWING NUMBER	NUMBER OF SHTS.	REV	WESTINGHOUSE DRAWING NUMBER	NUMBER OF SHTS.	TITLE OF DRAWING
CF759034	1	F	1016F19	2	(NASA) ELECTRICAL-CONTROL PANEL LAYOUTS & RELAY PANEL CONNECTION DIAGRAMS (W) CONTROL PANEL LAYOUTS & RELAY PANEL CONNECTION DIAGRAMS MOD-OA 200 KW WIND TURBINE GENERATOR
CF759035	1	C	1016F20	7	(NASA) ELECTRICAL-480 V SWITCHGEAR ONE LINE DIAGRAM (W) 480 V SWITCHGEAR WIRING DIAGRAM UNIT NOS. 1, 2 & 3 MOD-OA 200 KW WIND TURBINE GENERATOR
CF759036	1	E	1016F20	7	(W) 480 V SWITCHGEAR WIRING DIAGRAM UNIT NOS. 1, 2 & 3 MOD-OA 200 KW WIND TURBINE GENERATOR
CF759037	1	F	1016F20	7	(W) 480 V SWITCHGEAR WIRING DIAGRAM UNIT NOS. 1, 2, & 3 MOD-OA 200 KW WIND TURBINE GENERATOR
CF759038	1	E	1016F20	7	(W) 480 V SWITCHGEAR WIRING DIAGRAM UNIT NOS. 1, 2, & 3 MOD-OA 200 KW WIND TURBINE GENERATOR

All Westinghouse Drawings are Revision -

Sheet 12

TABLE 2 (Cont'd.)
 LIST OF DRAWINGS FOR THE MOD-OA 200 kW WIND TURBINE GENERATOR
 CORRELATION OF NASA LEWIS RESEARCH CENTER DRAWINGS TO WESTINGHOUSE DRAWINGS

NASA LEWIS DRAWING NUMBER	NUMBER OF SHYS.	PEV	WESTINGHOUSE DRAWING NUMBER	NUMBER OF SHYS.	TITLE OF DRAWING
CF759039	1	F	1016F20	7	(W) 480 V SWITCHGEAR WIRING DIAGRAM UNIT NOS. 1, 2, & 3 MOD-OA 200 kW WIND TURBINE GENERATOR
CF759040	1	D	1016F21	3	(NASA) ELECTRICAL-CONNECTION DGM FOR TERMINAL BOXES 2B & 3B (W) CONNECTION DIAGRAMS FOR TERMINAL BOXES, 2B, 3B, 2A, 3A & NO. 4 MOD-OA 200 kW WIND TURBINE GENERATOR
CF759041	1	E	1016F21	3	(NASA) ELECTRICAL-CONNECTION DGM FOR TERMINAL BOXES 2A & 2B (W) CONNECTION DIAGRAMS FOR TERMINAL BOXES, 2B, 3B, 2A, 3A & NO. 4 MOD-OA 200 kW WIND TURBINE GENERATOR
CF759042	1	D	1016F21	3	(NASA) ELECTRICAL-CONNECTION DIAGRAM FOR TERMINAL BOXES NO. 4 (W) CONNECTION DIAGRAMS FOR TERMINAL BOXES, 2B, 3B, 2A, 3A & NO. 4 MOD-OA 200 kW WIND TURBINE GENERATOR
CF759043	1	F	1016F22	1	(NASA) ELECTRICAL-ELECTRICAL CONNECTION DIAGRAM SAFETY SHUTDOWN PANEL (W) ELECTRICAL CONNECTION DIAGRAM SAFETY SHUTDOWN PANEL MOD-OA 200 kW WIND TURBINE GENERATOR
CF759044	1	E	1016F23	1	(NASA) ELECTRICAL-YAW BRAKE ELEMENTARY & CONNECTION DIAGRAM (W) YAW BRAKE ELEMENTARY & CONNECTION DGM. MOD-OA 200 kW WTG
CF759045	1	C	1016F24	1	(NASA) ELECTRICAL-MICROPROCESSOR CIRCUIT CARD LOCATOR RACK A & RACK B (W) MICROPROCESSOR CIRCUIT CARD LOCATION, RACK A & RACK B MOD-OA 200 kW WIND TURBINE GENERATOR

Sheet 13

All Westinghouse Drawings are Revision -

Table 2 (Cont'd)

LIST OF DRAWINGS FOR THE MOD-OA 200 kW WIND TURBINE GENERATOR
CORRELATION OF NASA LEWIS RESEARCH CENTER DRAWINGS TO WESTINGHOUSE DRAWINGS

NASA LEWIS DRAWING NUMBER	NUMBER OF SHTS.	REV.	WESTINGHOUSE DRAWING NUMBER	NUMBER OF SHTS.	TITLE OF DRAWING
CF759047	1	D	1016F25	1	(NASA) ELECTRICAL-YAW CONTROL PANEL LAYOUT (W) YAW CONTROL PANEL LAYOUT MOD-OA 200 kW WTG
CF759048	1	D	1016F26	1	(NASA) ELECTRICAL-CONTROL RACK ANALOG TERMINAL STRIP INTERCONNECTION (W) CONTROL RACK ANALOG TERMINAL STRIP INTERCONNECTION MOD-OA 200 kW WIND TURBINE GENERATOR
CF759049	1	E	1016F27	1	(NASA) ELECTRICAL-ELECTRICAL CONNECTION DIAGRAM AMPLIFIER PANEL (W) ELECTRICAL CONNECTION DIAGRAM AMPLIFIER PANEL MOD-OA 200 kW WIND TURBINE GENERATOR
CF760271	1	A	1015F85	2	(NASA) STRUCTURAL-ASSY STAND PLAN & DETAILS (W) ASSY STAND PLAN & DETAILS MOD-OA 200 kW WIND TURB. GEN.
CF760300	1	-	1015F86	2	(NASA) STRUCTURAL-TOWER & ASSY STAND-FOUNDATIONS & DETAILS- CLAYTON N.M. (W) TOWER & ASSY STAND FOUNDATION & DETAILS MOD-OA 200 kW WIND TURBINE GENERATOR
CC760476	1	-	1015F87	1	(NASA) GREASE & PRESSURE FITTINGS (W) GREASE & PRESSURE FITTINGS MOD-OA 200 kW WTG
CD760477	1	-	1015F88	1	(NASA) HUB COUNTER WEIGHTS (W) HUB COUNTER WEIGHTS MOD-OA 200 kW WIND TURBINE GEN.
CF760478	1	-	1015F89	1	(NASA) DETAILS (W) DETAILS MOD-OA 200 kW WIND TURBINE GENERATOR
CF760480	3	-	1016F28	4	(NASA) ELECTRICAL-INTRUSION ALARM (W) INTRUSION ALARM SYSTEM ALARM SYSTEM & ELEC. ELEMENTARY CONNECTION DIAGRAM & INSTALLATION DETAIL MOD-OA 200 kW WTG
CD760481	1	B	1016F30	1	(NASA) ELECTRICAL-MICROPROCESSOR TIMER-CARD SCHEMATIC (W) MICROPROCESSOR TIMER CARD-SCHEMATIC MOD-OA 200 kW WTG

*All Westinghouse Drawings are Revision -

Sheet 14

Table 2 (Cont'd)

LIST OF DRAWINGS FOR THE MD9-OA 200 kW WIND TURBINE GENERATOR

CORRELATION OF NASA LEWIS RESEARCH CENTER DRAWINGS TO WESTINGHOUSE DRAWINGS

NASA LEWIS DRAWING NUMBER	NUMBER OF SHTS.	*REV	WESTINGHOUSE DRAWING NUMBER	NUMBER OF SHTS.	TITLE OF DRAWING
CD760482	1	B	1016F30	1	(NASA) ELECTRICAL-MICROPROCESSOR RELAY-CARD SCHEMATIC (W) MICROPROCESSOR RELAY CARD SCHEMATIC MD9-OA 200 kW MTG
CF760484	1	A	1015F90	1	(NASA) HYDRAULIC SYSTEM PANEL YAW BRAKE (W) HYDRAULICS COMPONENTS MTG PANEL MD9-OA 200 kW MTG
CF760484	1	A	1015F91	1	(NASA) HYDRAULIC SYSTEM PANEL YAW BRAKE (W) HYDRAULIC SYSTEM PANEL YAW BRAKE-STRUCTURAL SUPPORT MD9-OA 200 kW WIND TURBINE GENERATOR
CF760485	1	A	1015F80	3	(NASA) HYDRAULIC SYSTEM PANEL YAW BRAKE (W) YAW BRAKE HYDRAULIC SYSTEM PANEL & SCHEMATIC MD9-OA 200 kW WIND TURBINE GENERATOR
CD760486	1	A	1015F92	1	(NASA) AIR BOTTLE GAGE BRACKET (W) AIR BOTTLE GAGE BRACKET DETAILS MD9-OA 200 kW MTG
CC760487	1	A	1015F93	1	(NASA) GEAR ALT. LOW SPEED SHAFT (W) DETAILS MD9-OA 200 kW WIND TURBINE GENERATOR
CC760488	1	A	1015F94	1	(NASA) DUBLIN MOUNT (W) DUBLIN MOUNT & SLIP RING DUST COVER MD9-OA 200 kW MTG
CB760490	1	A	1015F65	1	(NASA) BUTTRES RING RETAINER (W) TRANSFORMER ANTI-ROTATION BRACKET & BUTTRES RING RETAINER DETAILS MD9-OA 200 kW MTG
CF760491	1	-	1015F96	1	(NASA) YAW BRAKE ASSEMBLY (W) YAW BRAKE ASSY MD9-OA 200 kW WIND TURBINE GENERATOR
CD760492	1	-	1015F97	1	(NASA) YAW BRAKE DETAILS (W) YAW BRAKE DETAIL MD9-OA 200 kW WIND TURBINE GENERATOR
CD760493	1	-	1015F98	1	(NASA) YAW BRAKE DETAILS (W) YAW BRAKE DETAIL MD9-OA 200 kW WIND TURBINE GENERATOR

*All Westinghouse Drawings are Revision -

Sheet 15

Table 2 (Cont'd)

LIST OF DRAWINGS FOR THE MOD-OA 200 kW WIND TURBINE GENERATOR

CORRELATION OF NASA LEWIS RESEARCH CENTER DRAWINGS TO WESTINGHOUSE DRAWINGS

NASA LEWIS DRAWING NUMBER	NUMBER OF SHTS.	*REV	WESTINGHOUSE DRAWING NUMBER	NUMBER OF SHTS.	TITLE OF DRAWING
CF760494	1	B	1016F31	1	(NASA) ELECTRICAL-ELAPSE THE PANEL (W) ELAPSE TIME PANEL MOD-OA 200 kW WIND TURBINE GENERATOR
CF760495	1	C	1016F32	1	(NASA) ELECTRICAL-RECLOSER & CIRCUIT BREAKER NO. 2 ELEMENTARY & WIRING DIAGRAMS (W) RECLOSER & CIRCUIT BREAKER NO. 2 ELEMENTARY & WIRING DIAGRAMS MOD-OA 200 kW WIND TURBINE GENERATOR
CF760496	1	D	1016F33	1	(NASA) ELECTRICAL-CLIMATRONICS & REFERENCE PANEL CONNECTION DIAGRAM (W) ELECTRICAL CONNECTION DIAGRAM CLIMATRONICS & REFERENCE PANEL MOD-OA 200 kW WIND TURBINE GENERATOR
CF760497	1	B	1016F34	1	(NASA) ELECTRICAL-PITCH CONTROLLER INTERNAL TERMINATIONS (W) PITCH CONTROLLER INTERNAL TERMINATIONS MOD-OA 200 WTG
CC760500	1	-	1015F94	1	(NASA) SLIP RING COVER (W) DUBLIN MOUNT & SLIP RING DUST COVER MOD-OA 200 kW WTG
CC760504	1	B	1015F81	1	(NASA) HUB SEAL HOLDER (W) DETAILS MOD-OA 200 kW WIND TURBINE GENERATOR
CF760506	1	-	1015F95	2	(NASA) ELECTRICAL-LOW SPEED SHAFT STRAIN GAGE LOCATION CONNECTION DIAGRAM & INSTALLATION (W) ELECTRICAL-LOW SPEED SHAFT STRAIN GAGE LOCATION MOD-OA 200 kW WIND TURBINE GENERATOR
CC760512	1	-	1015F99	1	(NASA) FIXTURE FOR SEAL INSTALLATION (W) FIXTURES FOR SEAL INSTALLATION MOD-OA 200 kW WTG

All Westinghouse Drawings are Revision -

Sheet 16

Table 2 (Cont'd.)

LIST OF DRAWINGS FOR THE MOD-OA 200 KW WIND TURBINE GENERATOR
CORRELATION OF NASA LEWIS RESEARCH CENTER DRAWINGS TO WESTINGHOUSE DRAWINGS


NASA LEWIS DRAWING NUMBER	NUMBER OF SHYS.	REV.	WESTINGHOUSE DRAWING NUMBER	NUMBER OF SHYS.	TITLE OF DRAWING
CD760513	1	-	1015F99	1	(NASA) SEAL INSTALLATION INSTRUCTIONS (W) FIXTURES FOR SEAL INSTALLATION MOD-OA 200 KW MTG
CF760520	1	-	1015F95	2	(NASA) ELECTRICAL-LOW SPEED SHAFT STRAIN GAGE LOCATION (W) ELECTRICAL-LOW SPEED SHAFT STRAIN GAGE LOCATION MOD-OA 200 KW WIND TURBINE GENERATOR
CF760546	1	-	1016F35	1	(NASA) ELECTRICAL-SYNCHRO-D.C. CONVERTER-AEROVANE TRANSLATER SCHEMATIC (W) SYNCHRO-D.C. CONVERTER AEROVANE TRANSLATOR SCHEMATIC MOD-OA 200 KW WIND TURBINE GENERATOR
CF760552	1	-	1016F36	1	(NASA) DAYTRONICS CONNECTION DIAGRAM-ELECTRICAL (W) DAYTRONICS CONNECTION DIAGRAM MOD-OA 200 KW MTG

*All Westinghouse Drawings are Revision -

Sheet 17

NO	DESCRIPTION	DATE	BY	REMARKS
1	RECEIVED			
2	RECEIVED			
NO	DESCRIPTION	DATE	BY	REMARKS
1	RECEIVED			
2	RECEIVED			
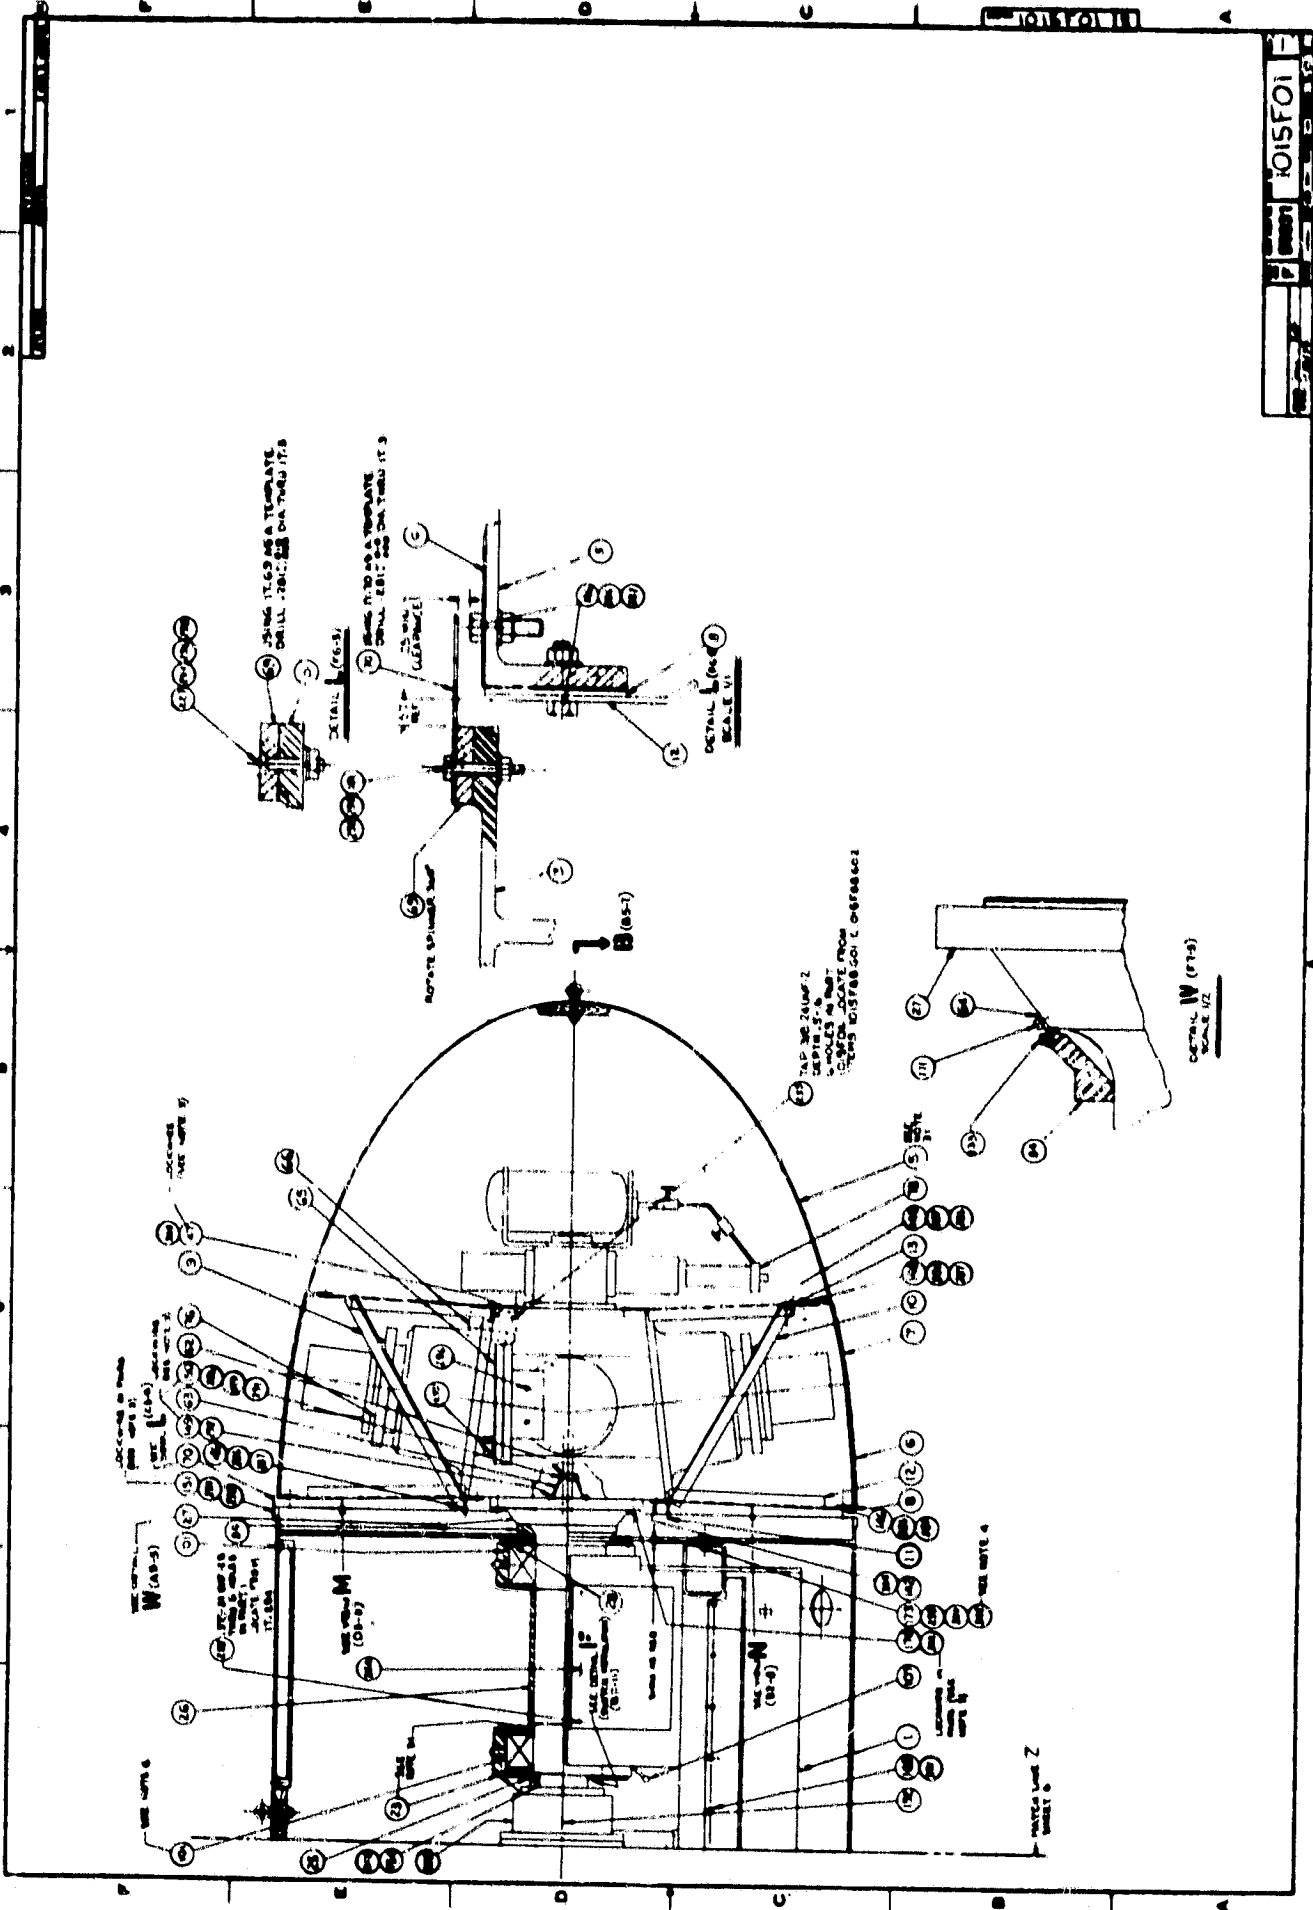

DETAIL IV (85-1)
SCALE 1/2"

DETAIL III (85-3)
SCALE 1/2"

W (85-5)

M (85-7)

B (85-1)

C

D

E

F























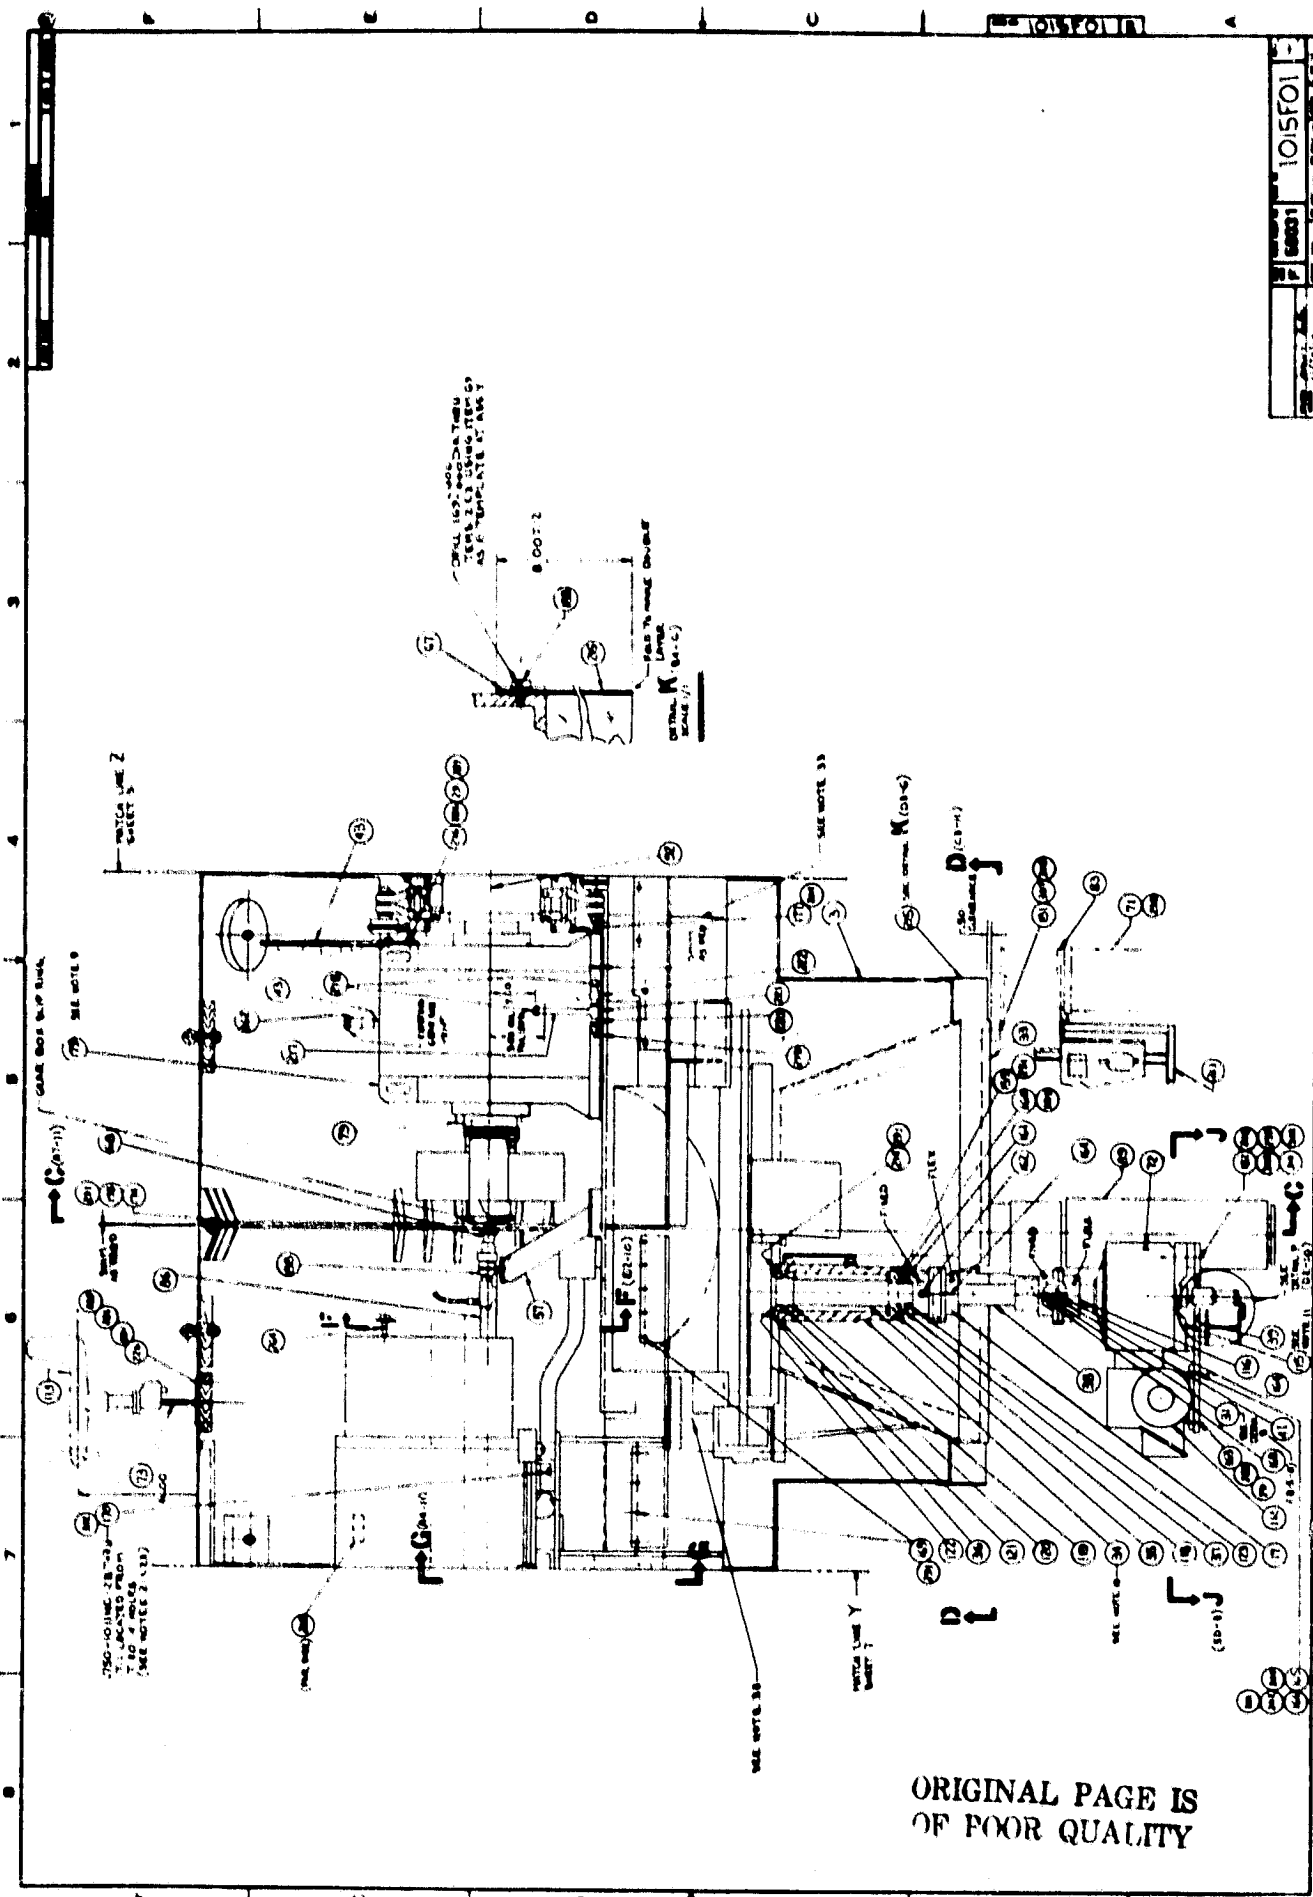

ORIGINAL PAGE IS OF POOR QUALITY

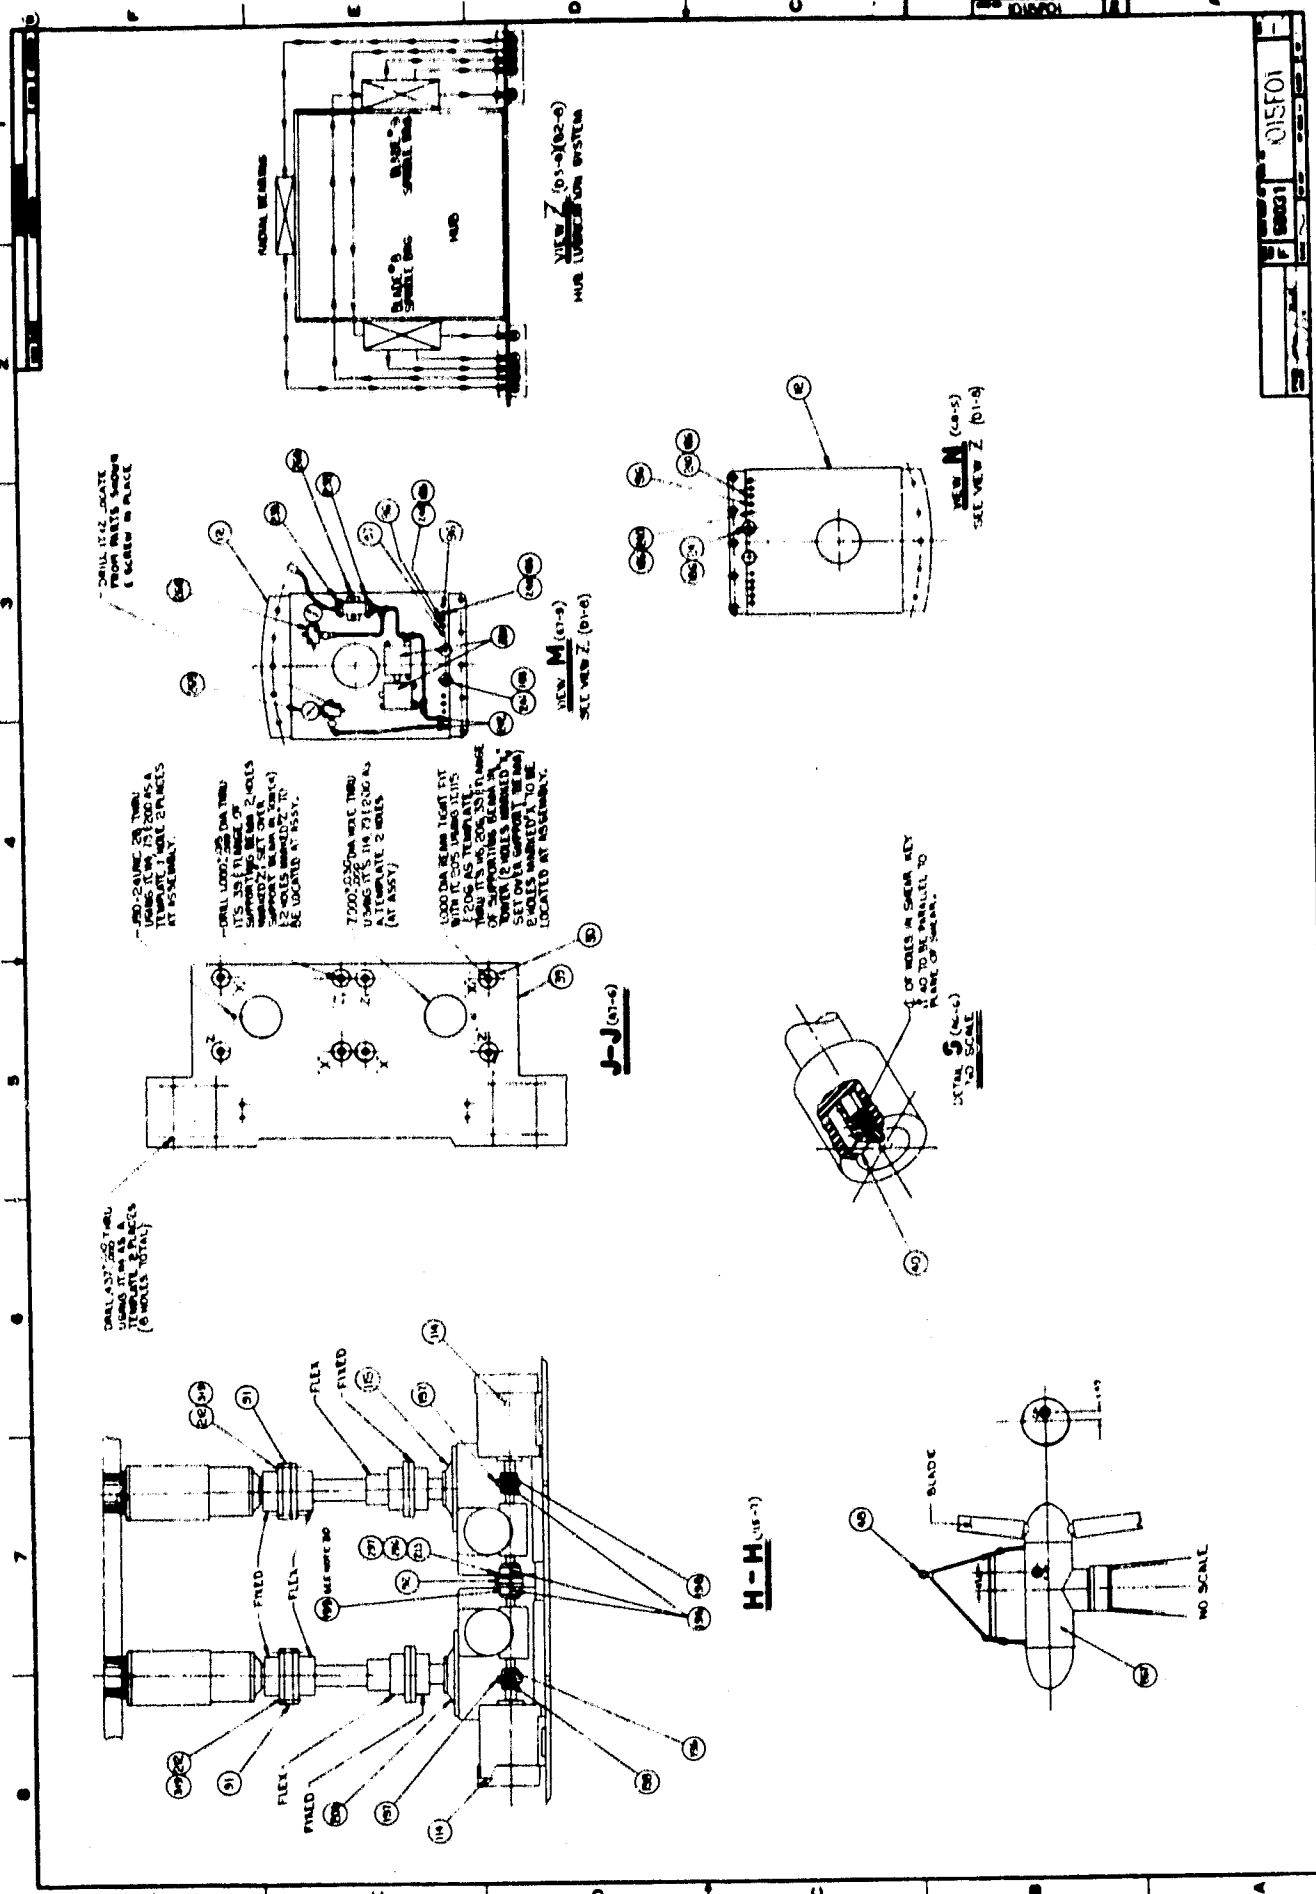










NO SCALE

NO SCALE

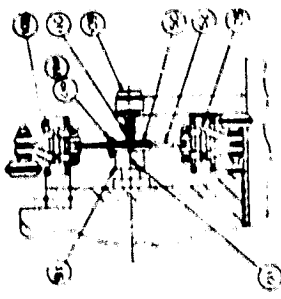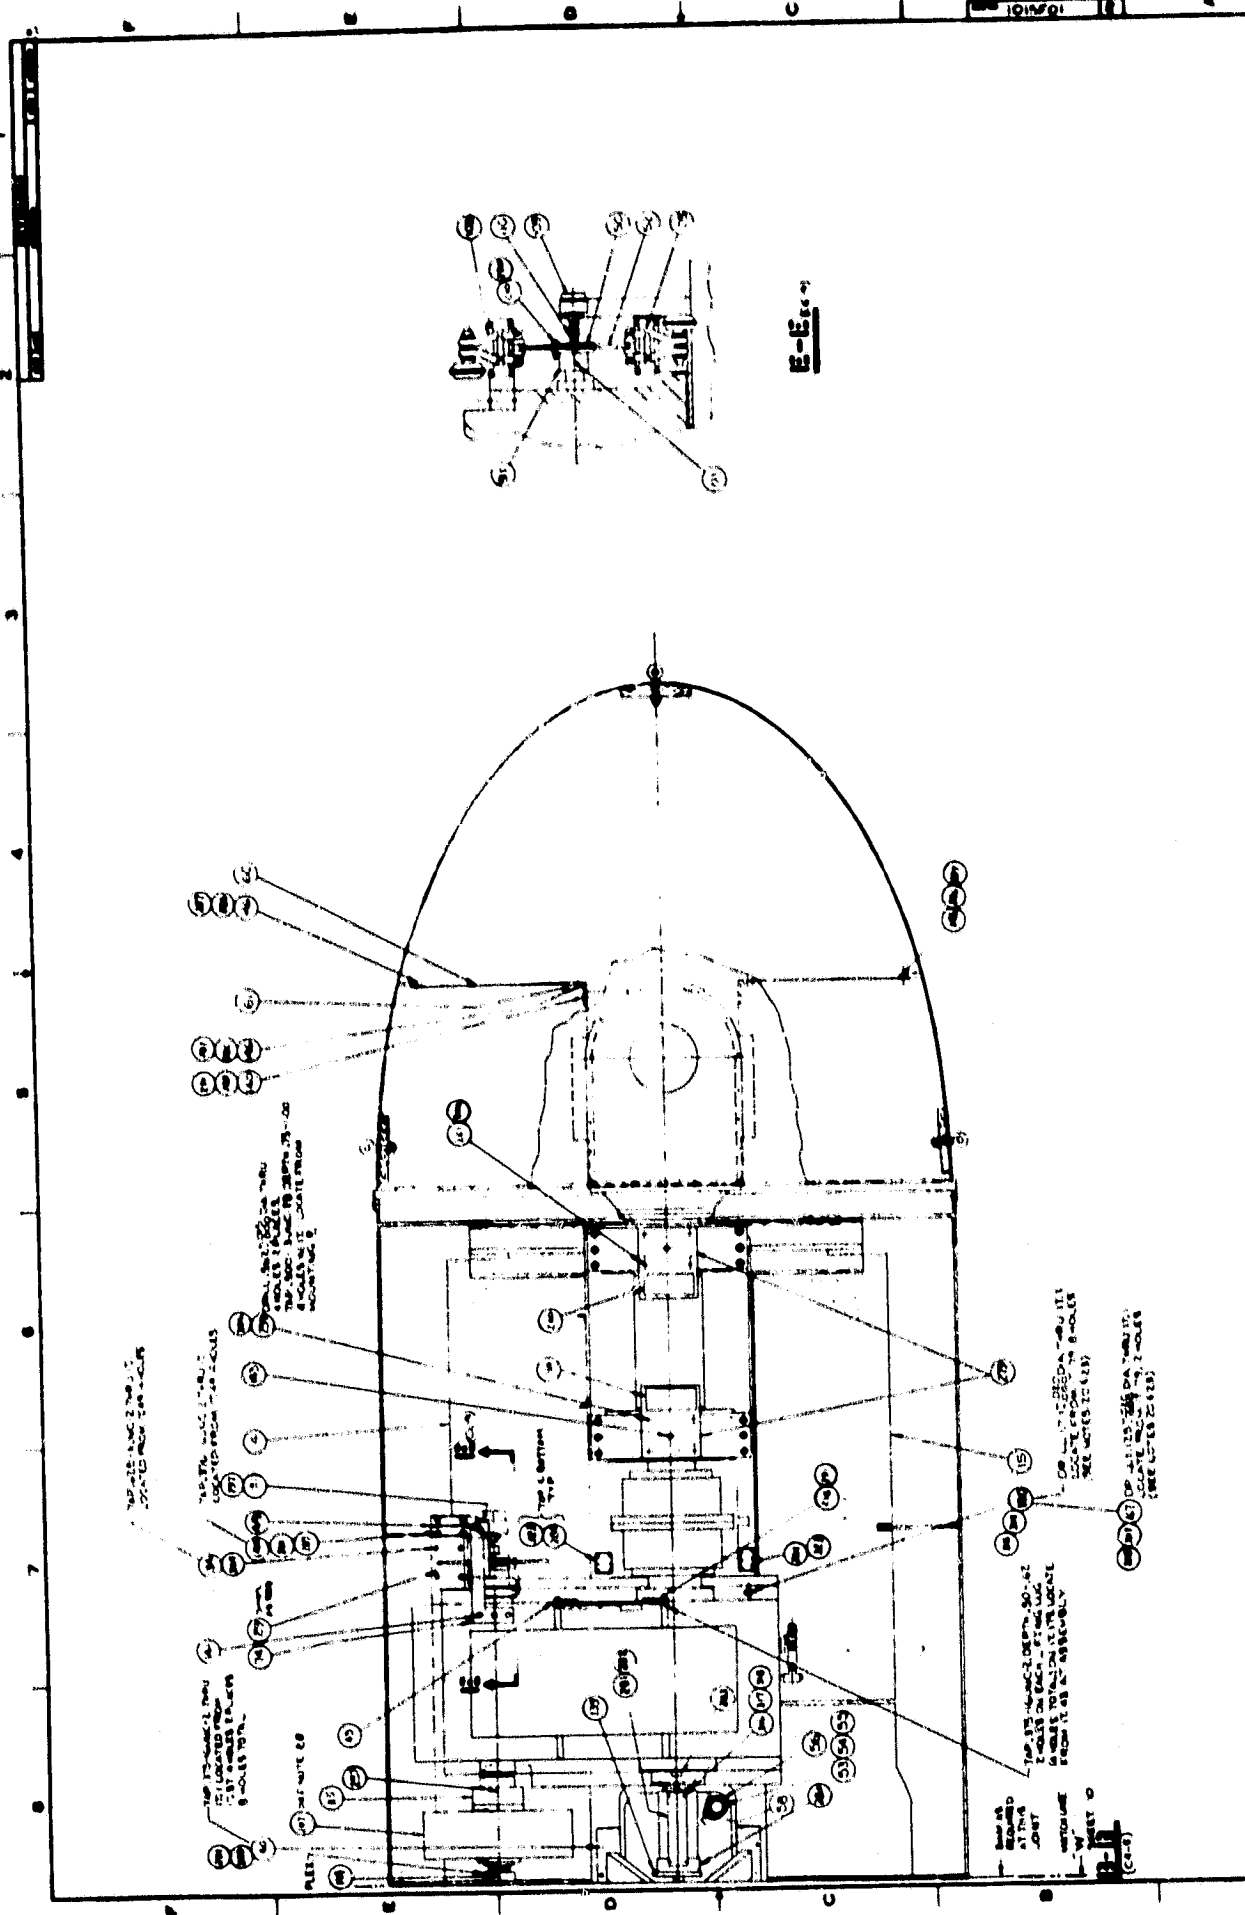

E-E

TOP OF DOME TO BE
LOCATED WITHIN
8 HOLES TOTAL














SEE LIST 101501

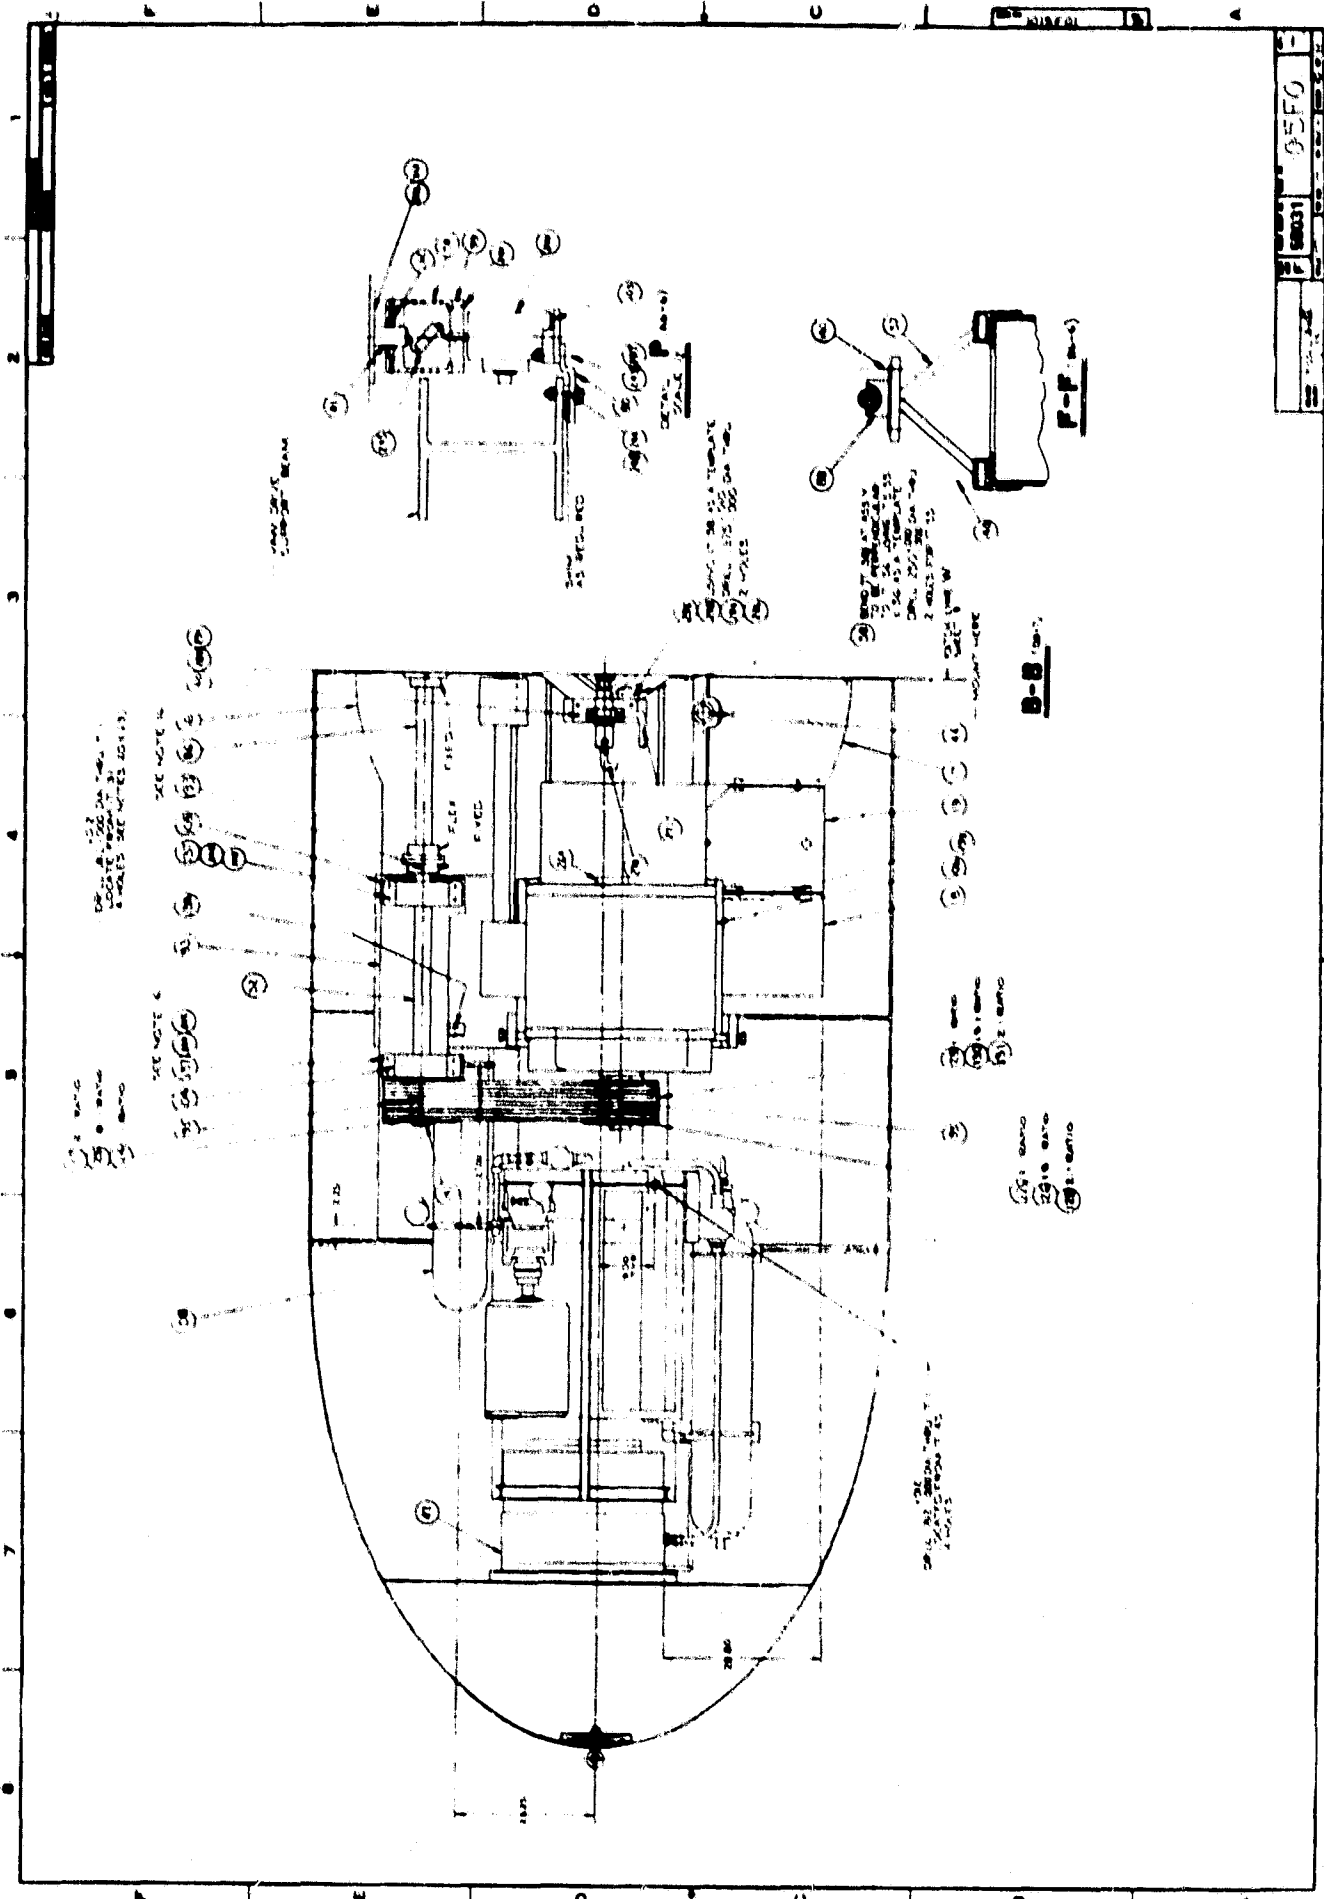



PATCH CONTROL - 400 ASSY
1100 CA-200 CV
WIND TURBINE GENERATOR
1015F03


1015 F03


1015 F03

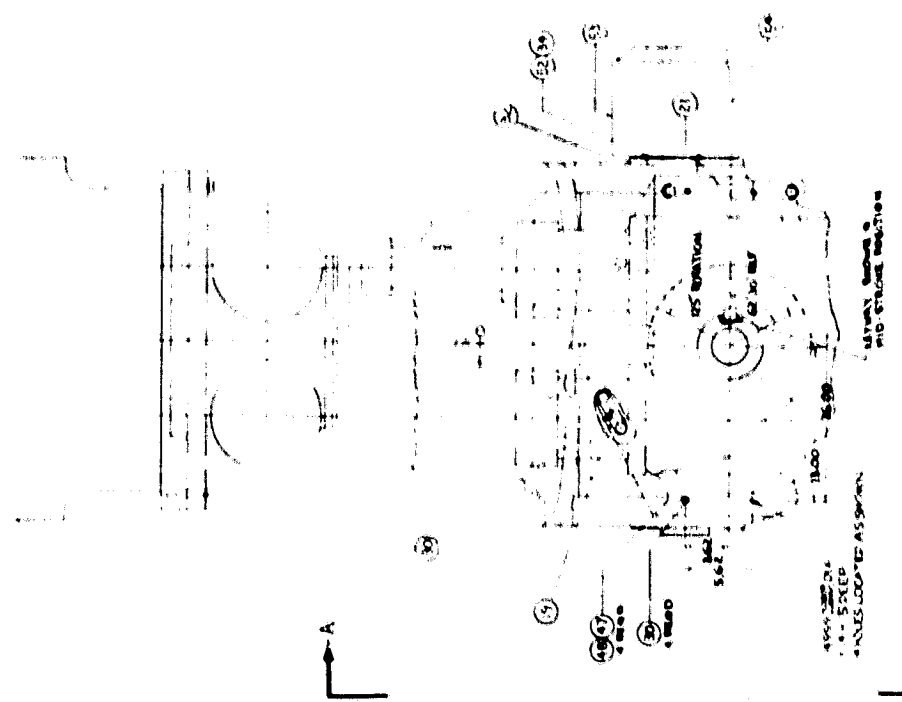

A


A (as is)

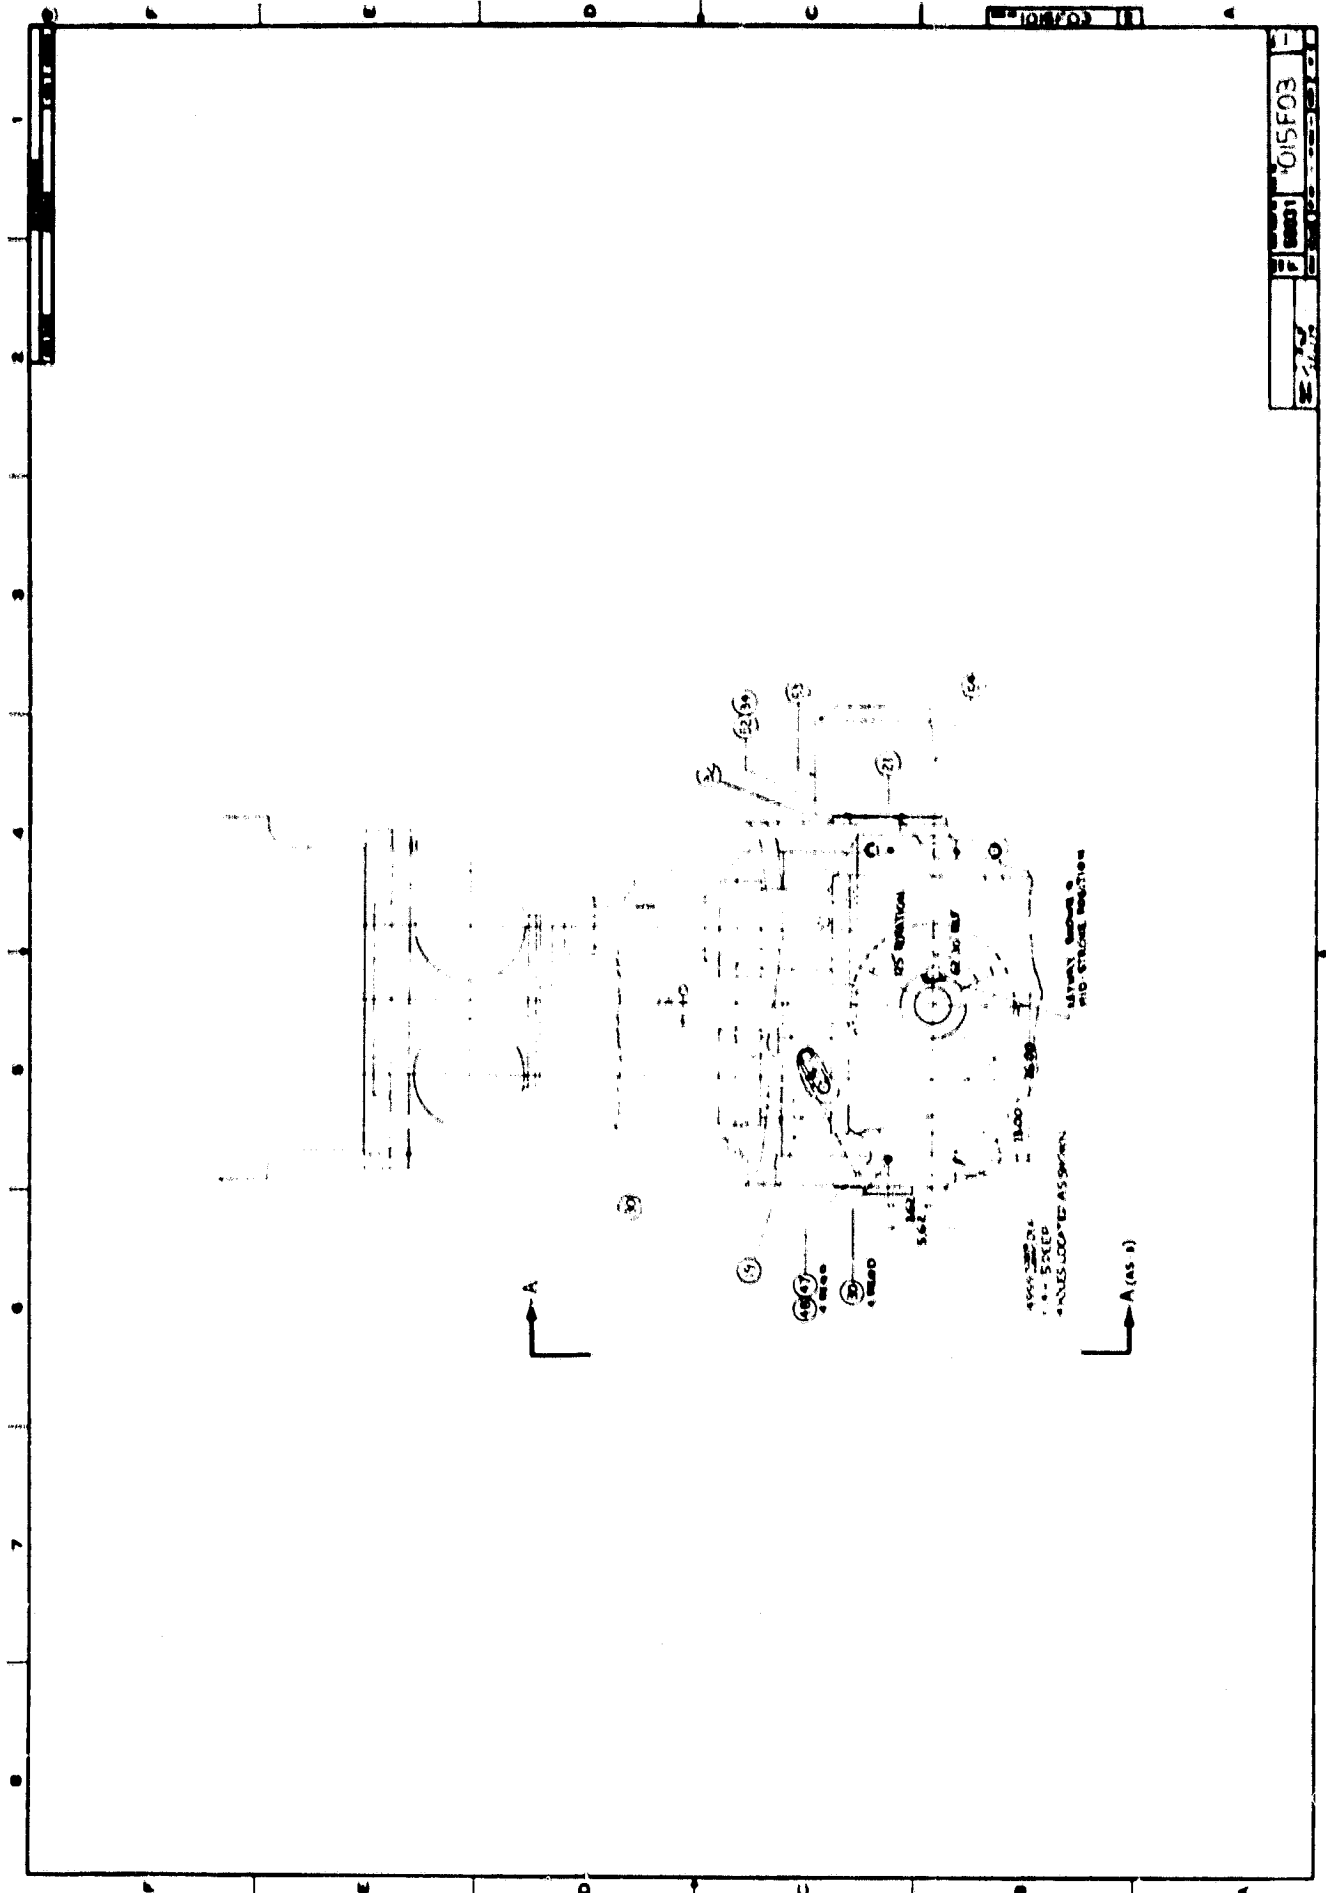

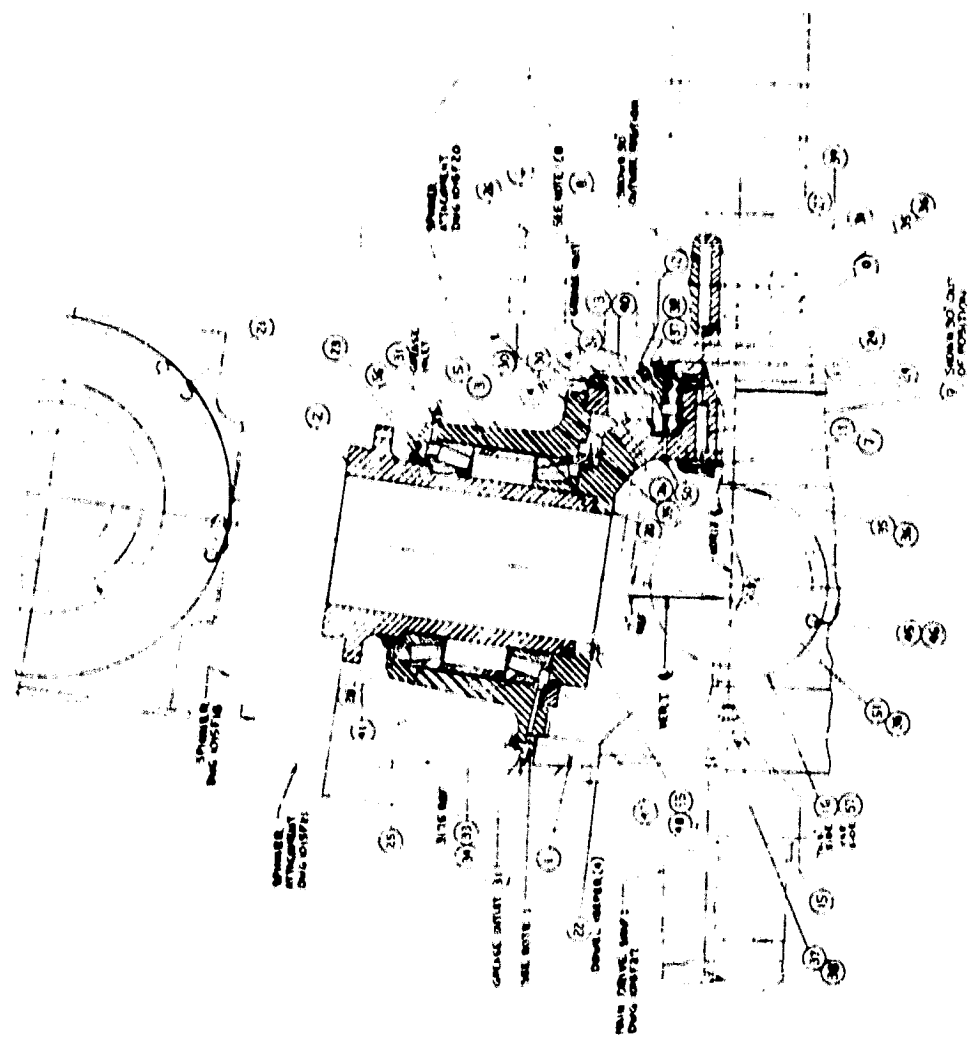


VIEW A-A (REV. 2)


ORIGINAL PAGE IS OF POOR QUALITY

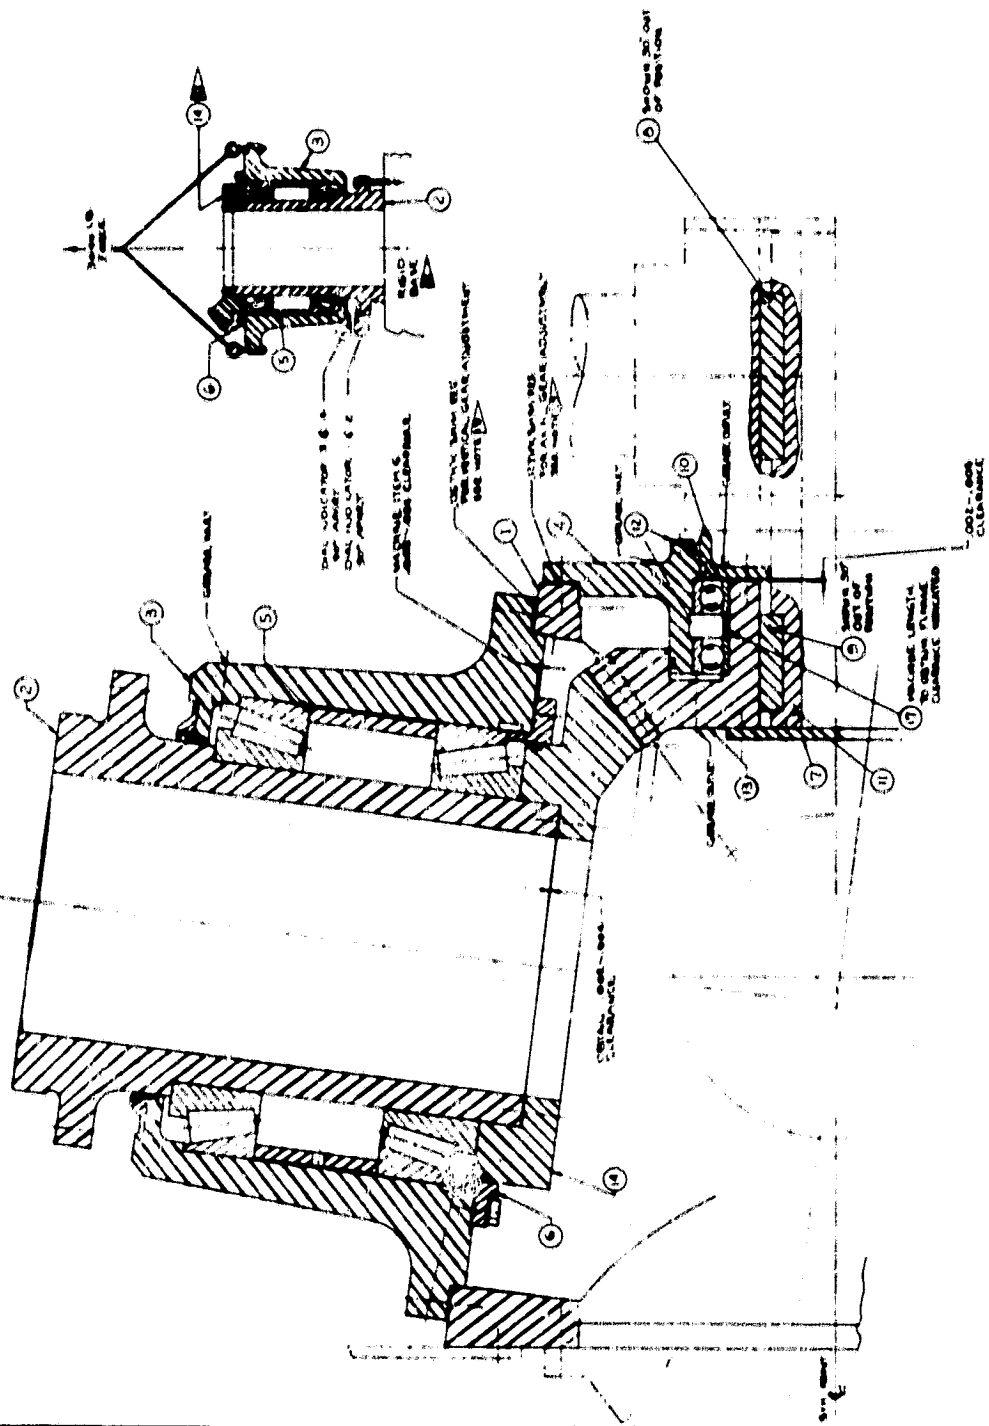

1015705

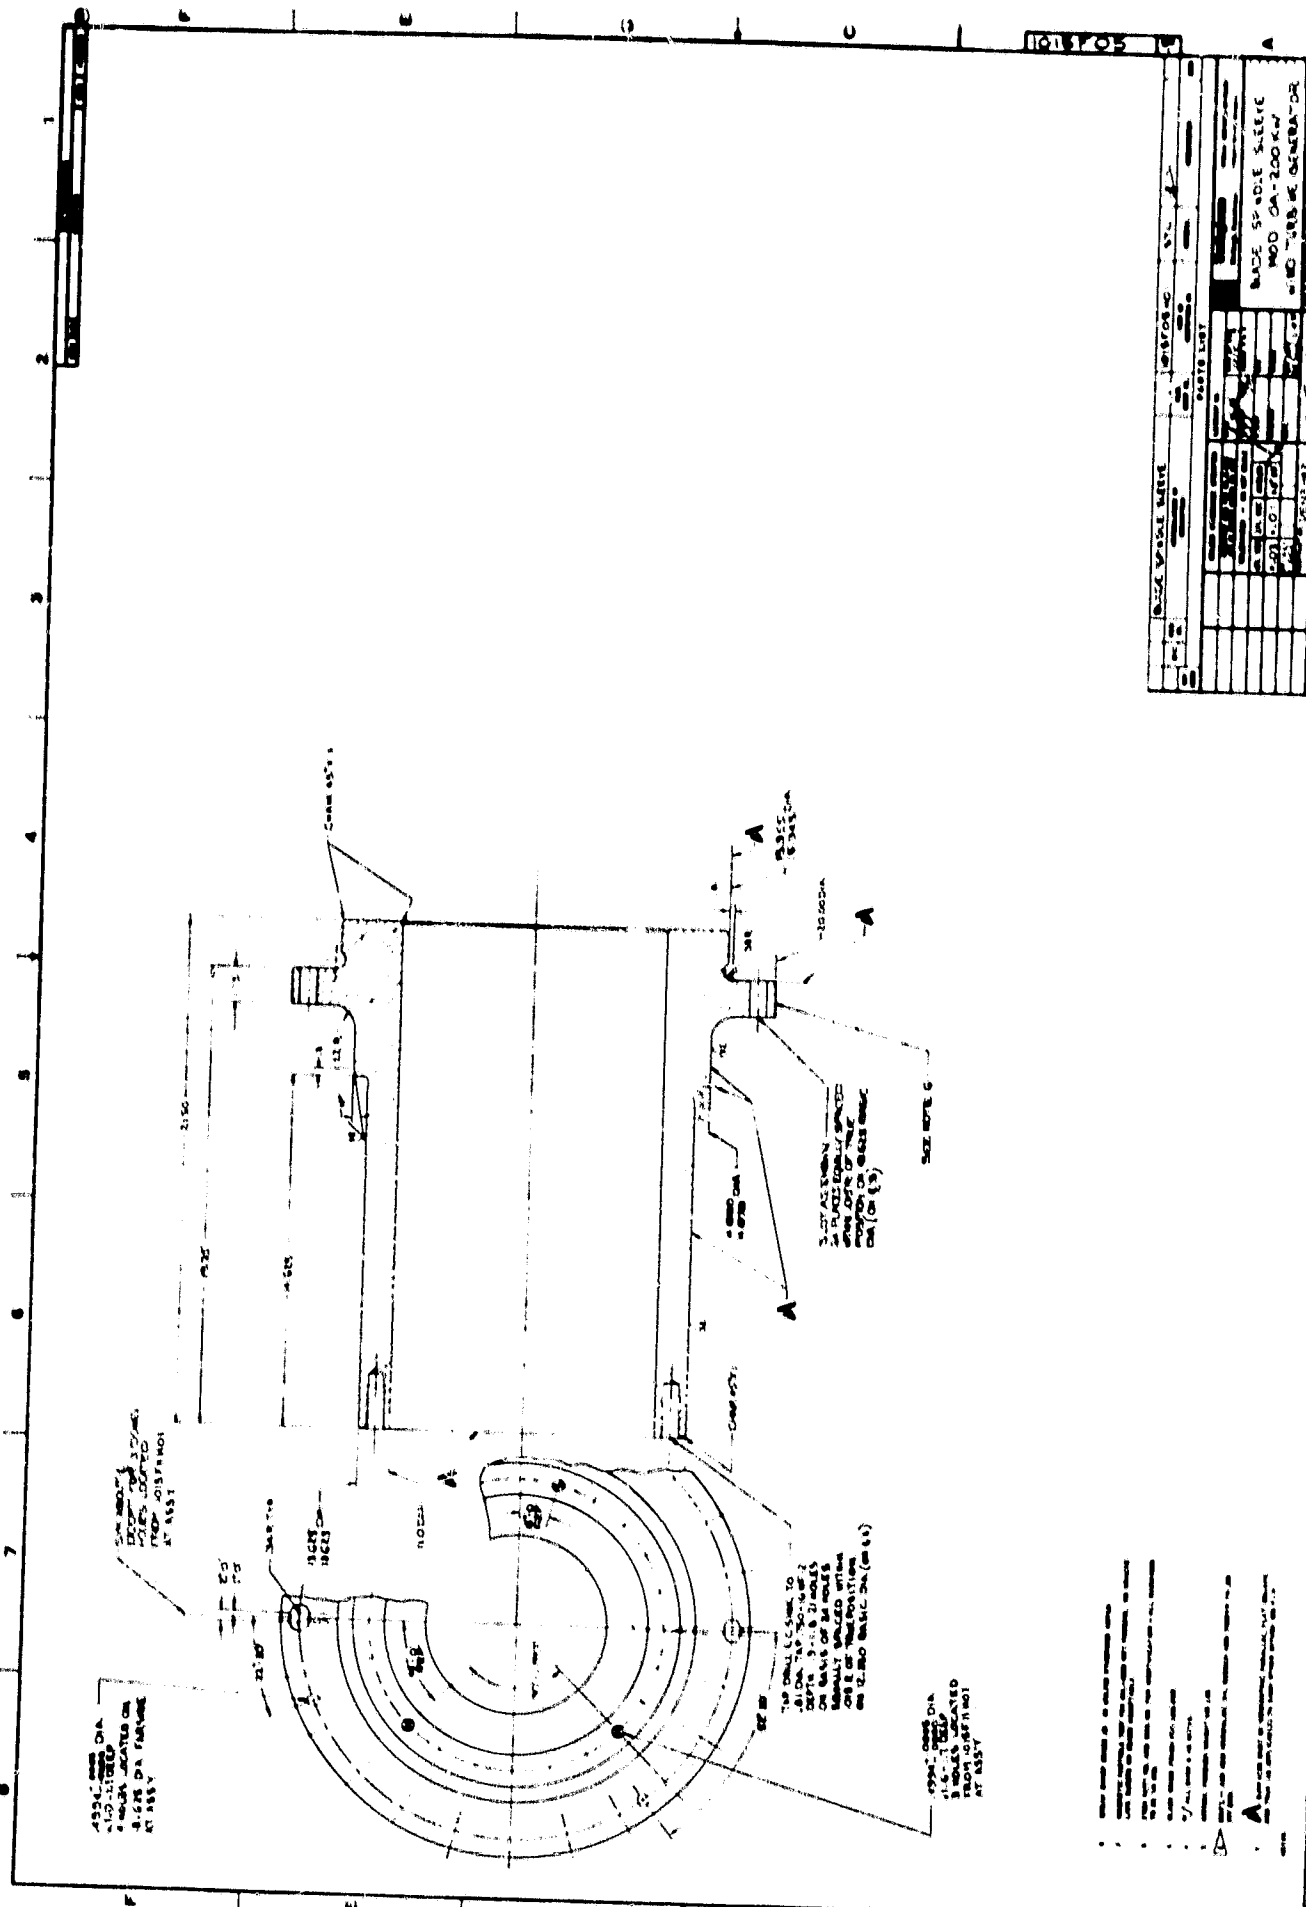

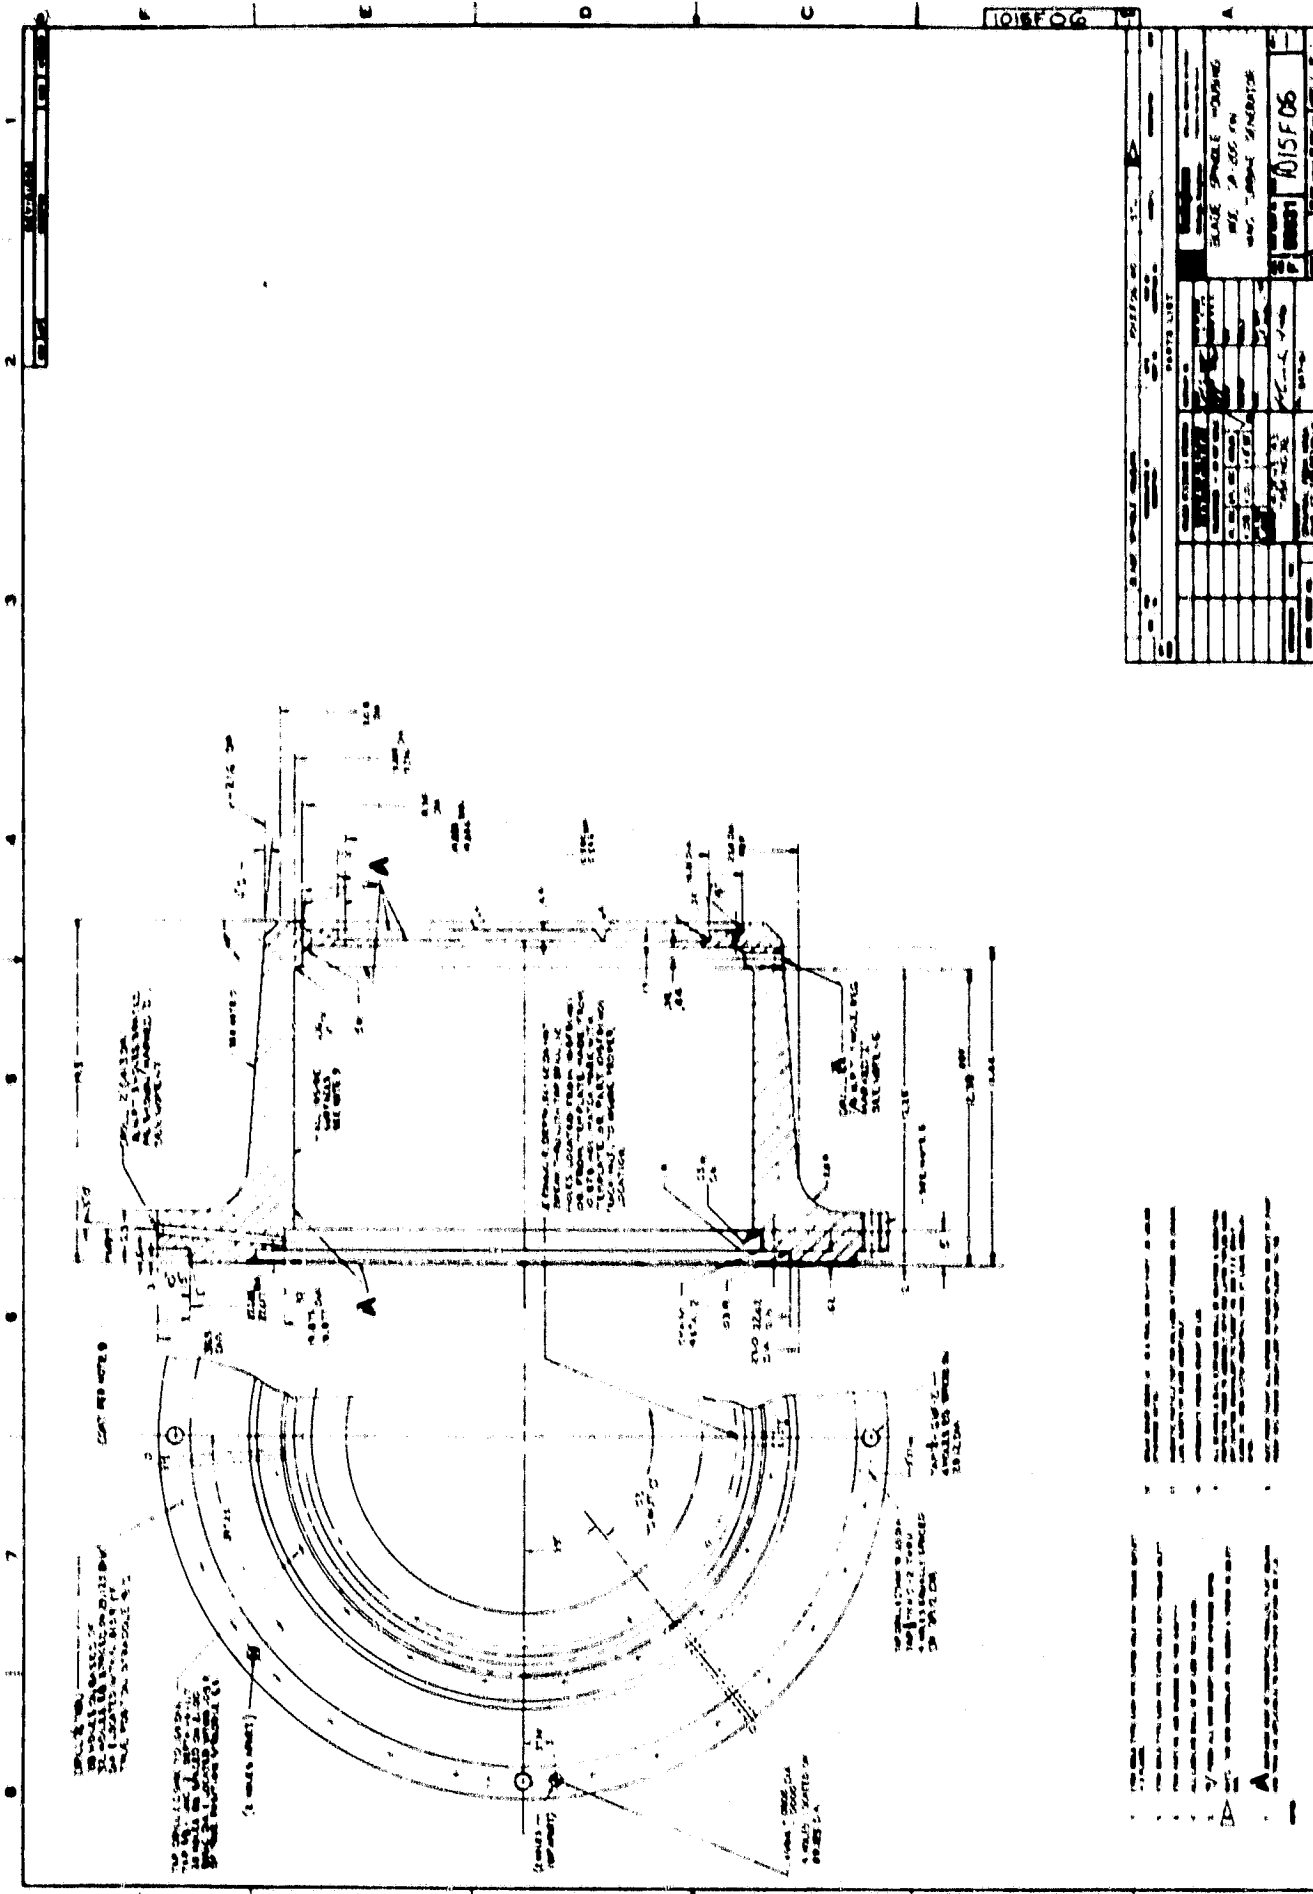

1015F06

PROJECT NO.		DATE		DRAWN BY		CHECKED BY		APPROVED BY	
1015F06									
















DATE		Dwg. No.		Scale		Proj. No.		Part No.	
<p>PARTS LIST</p>									
<p>QTY. PART NO. DESCRIPTION</p>									

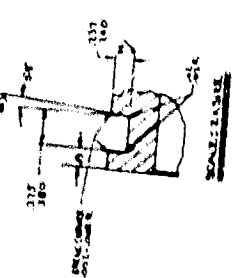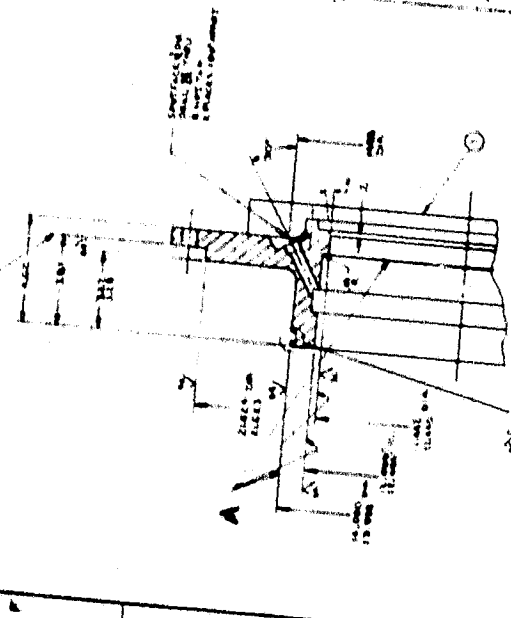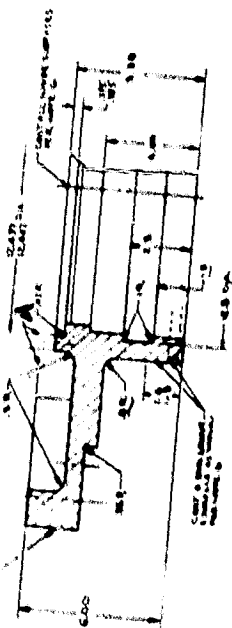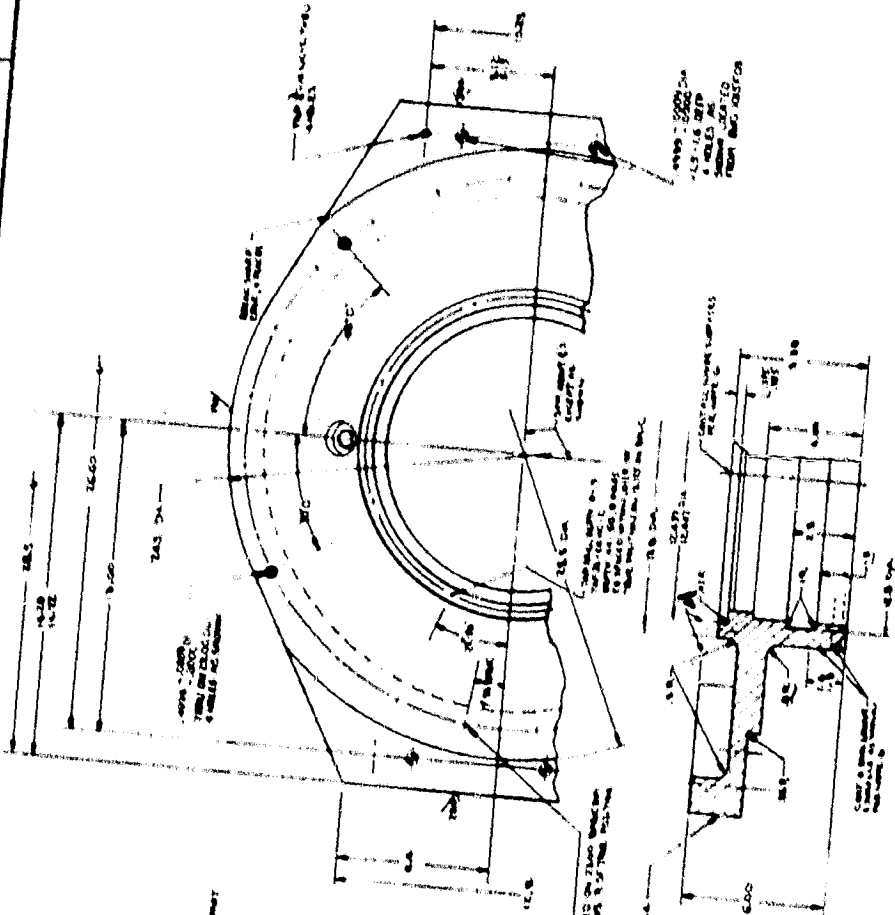


1016709

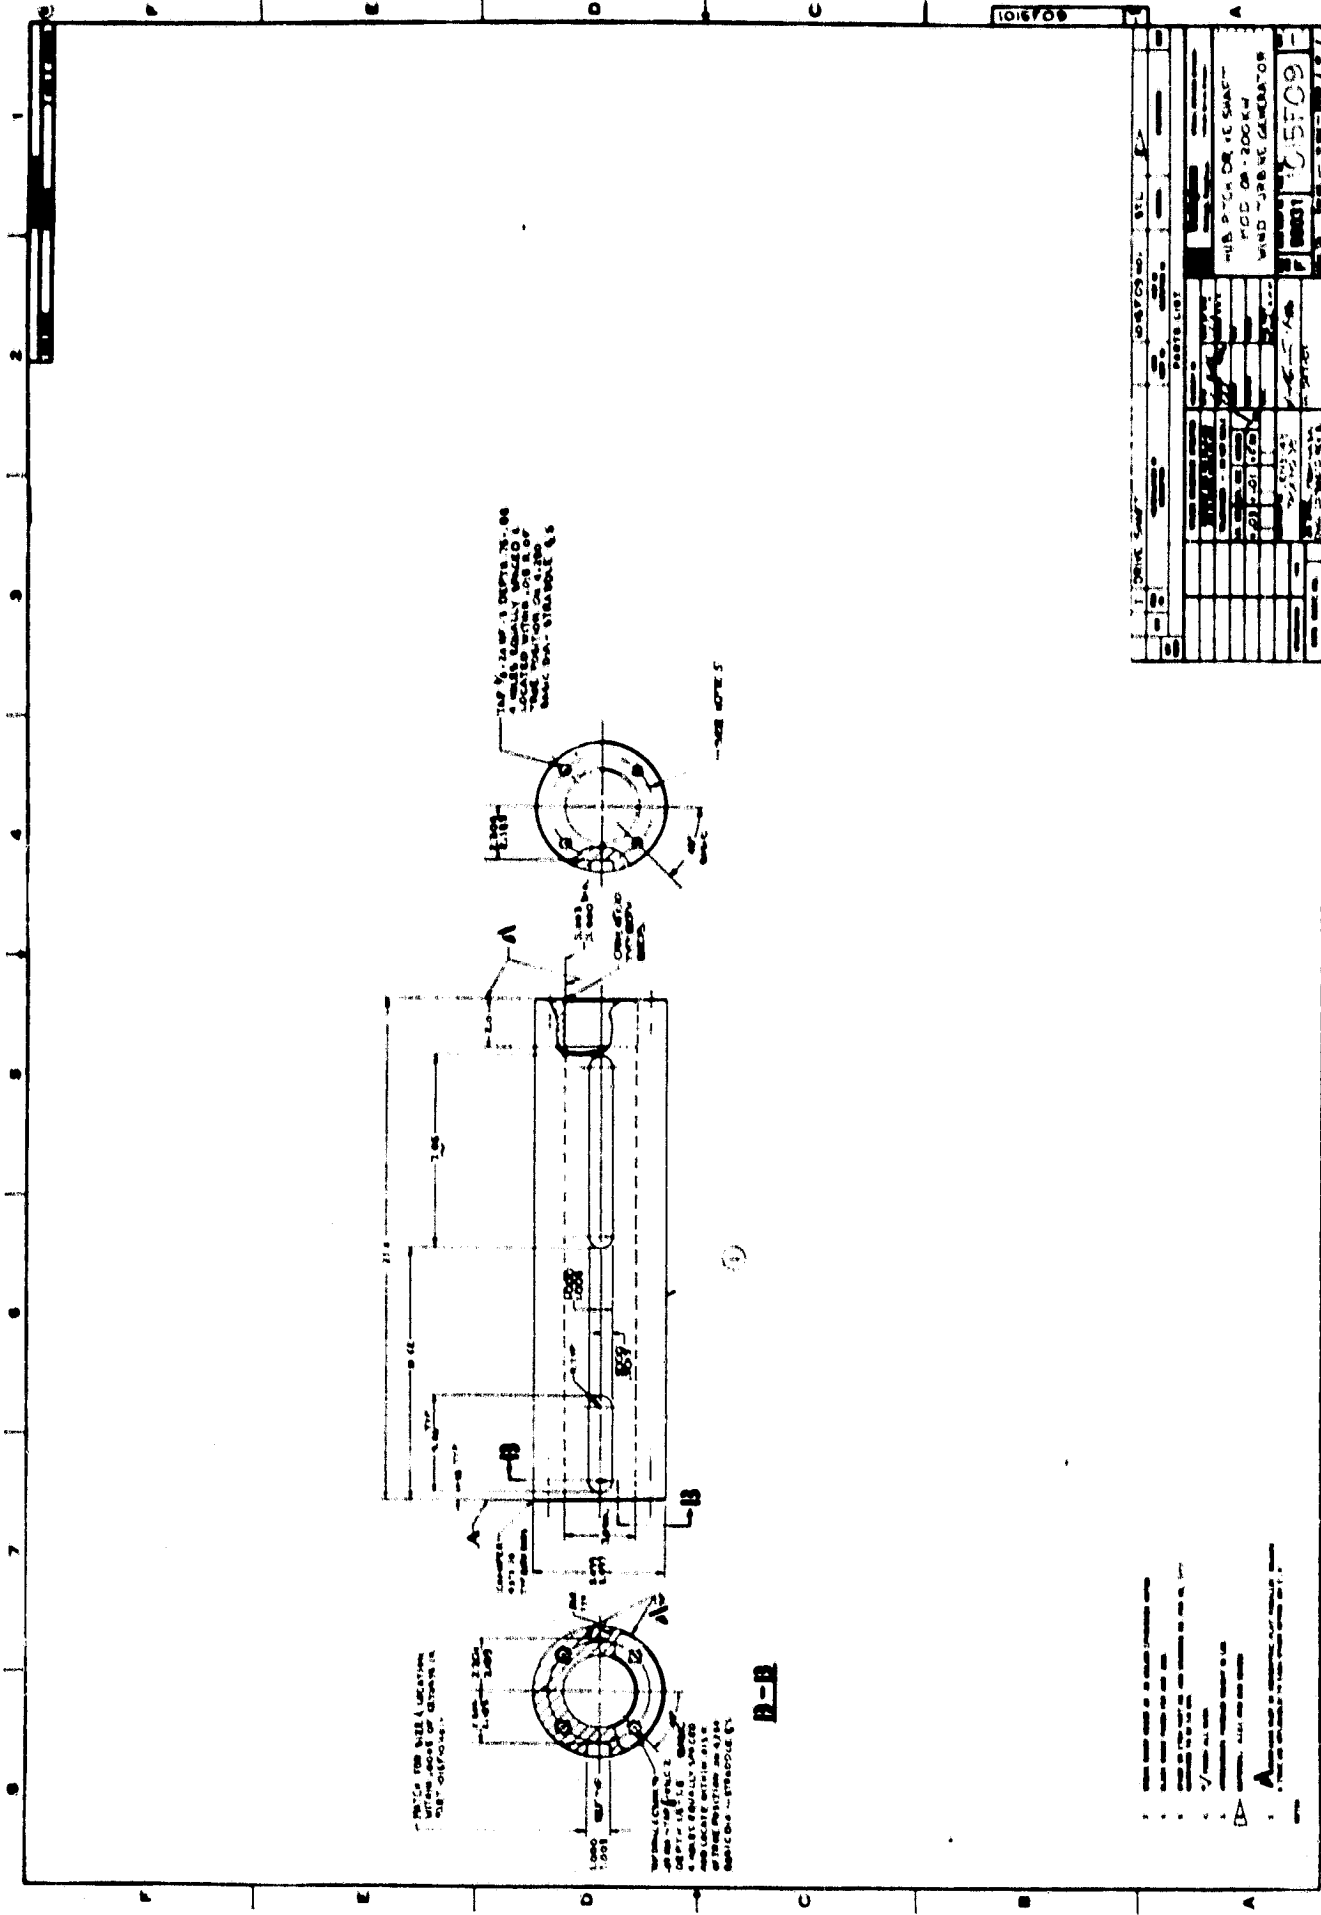

PARTS LIST	
QTY	DESCRIPTION
1	1016709-1
1	1016709-2
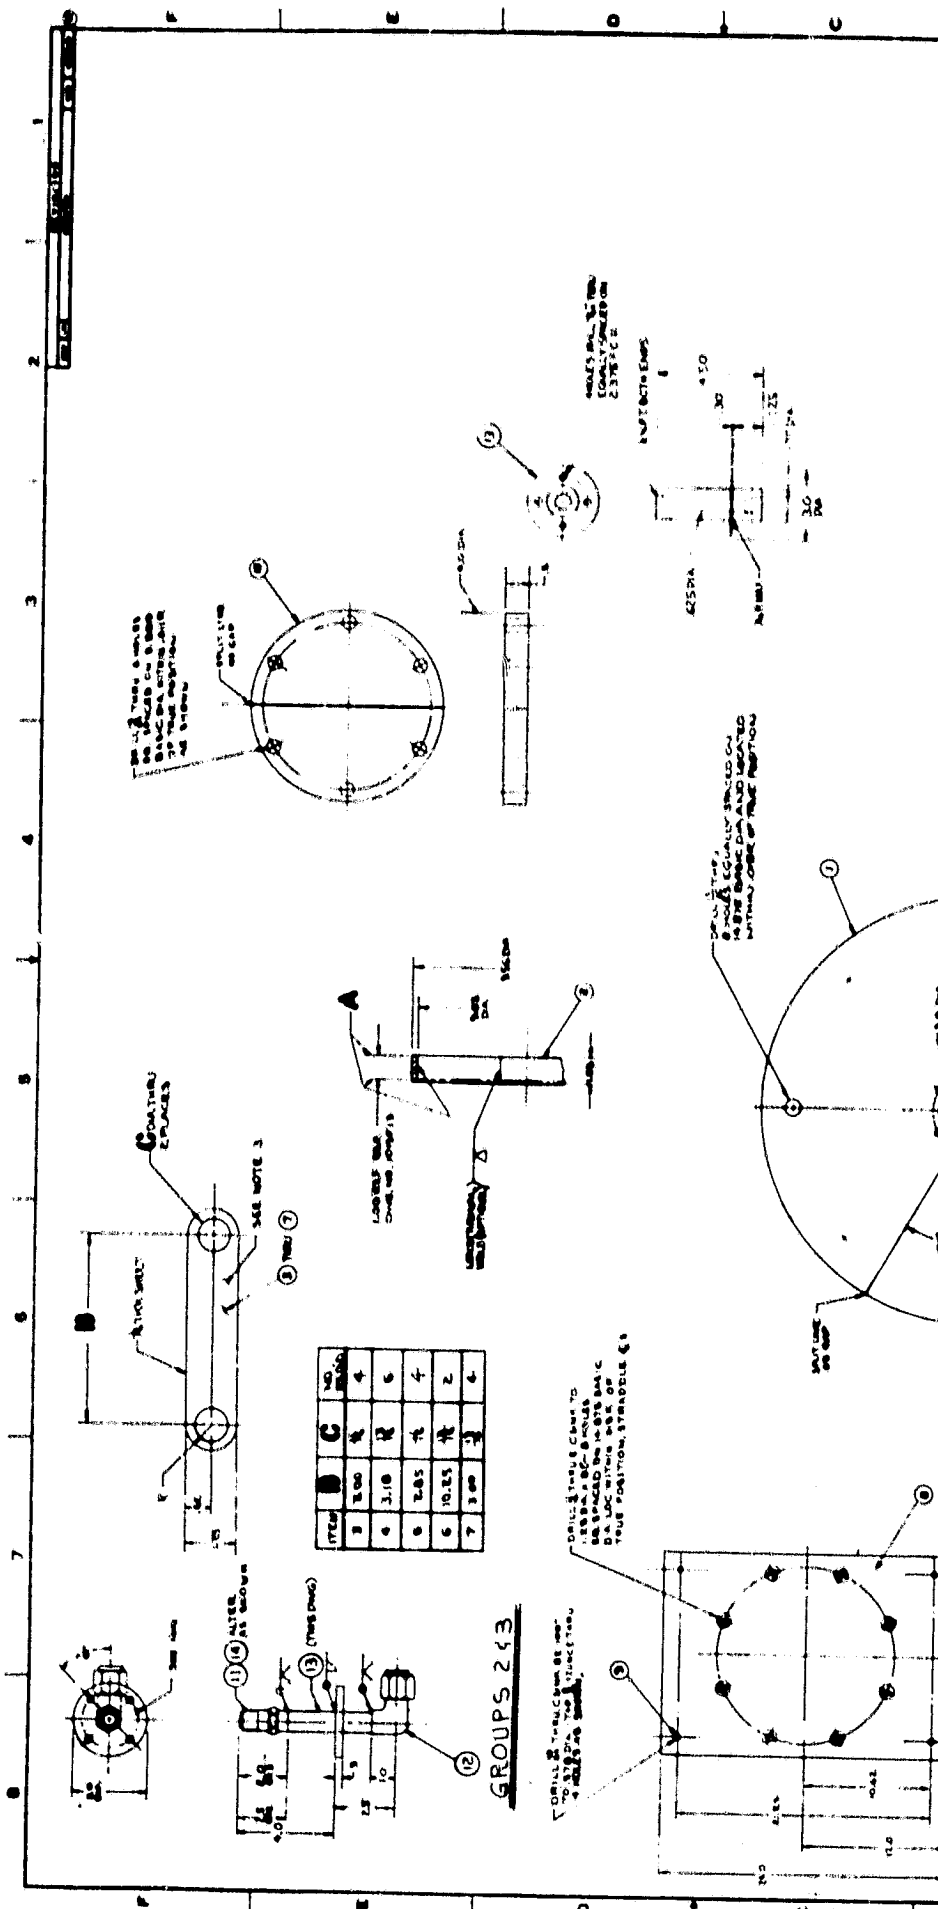






ORIGINAL PAGE IS OF POOR QUALITY

GROUP-1

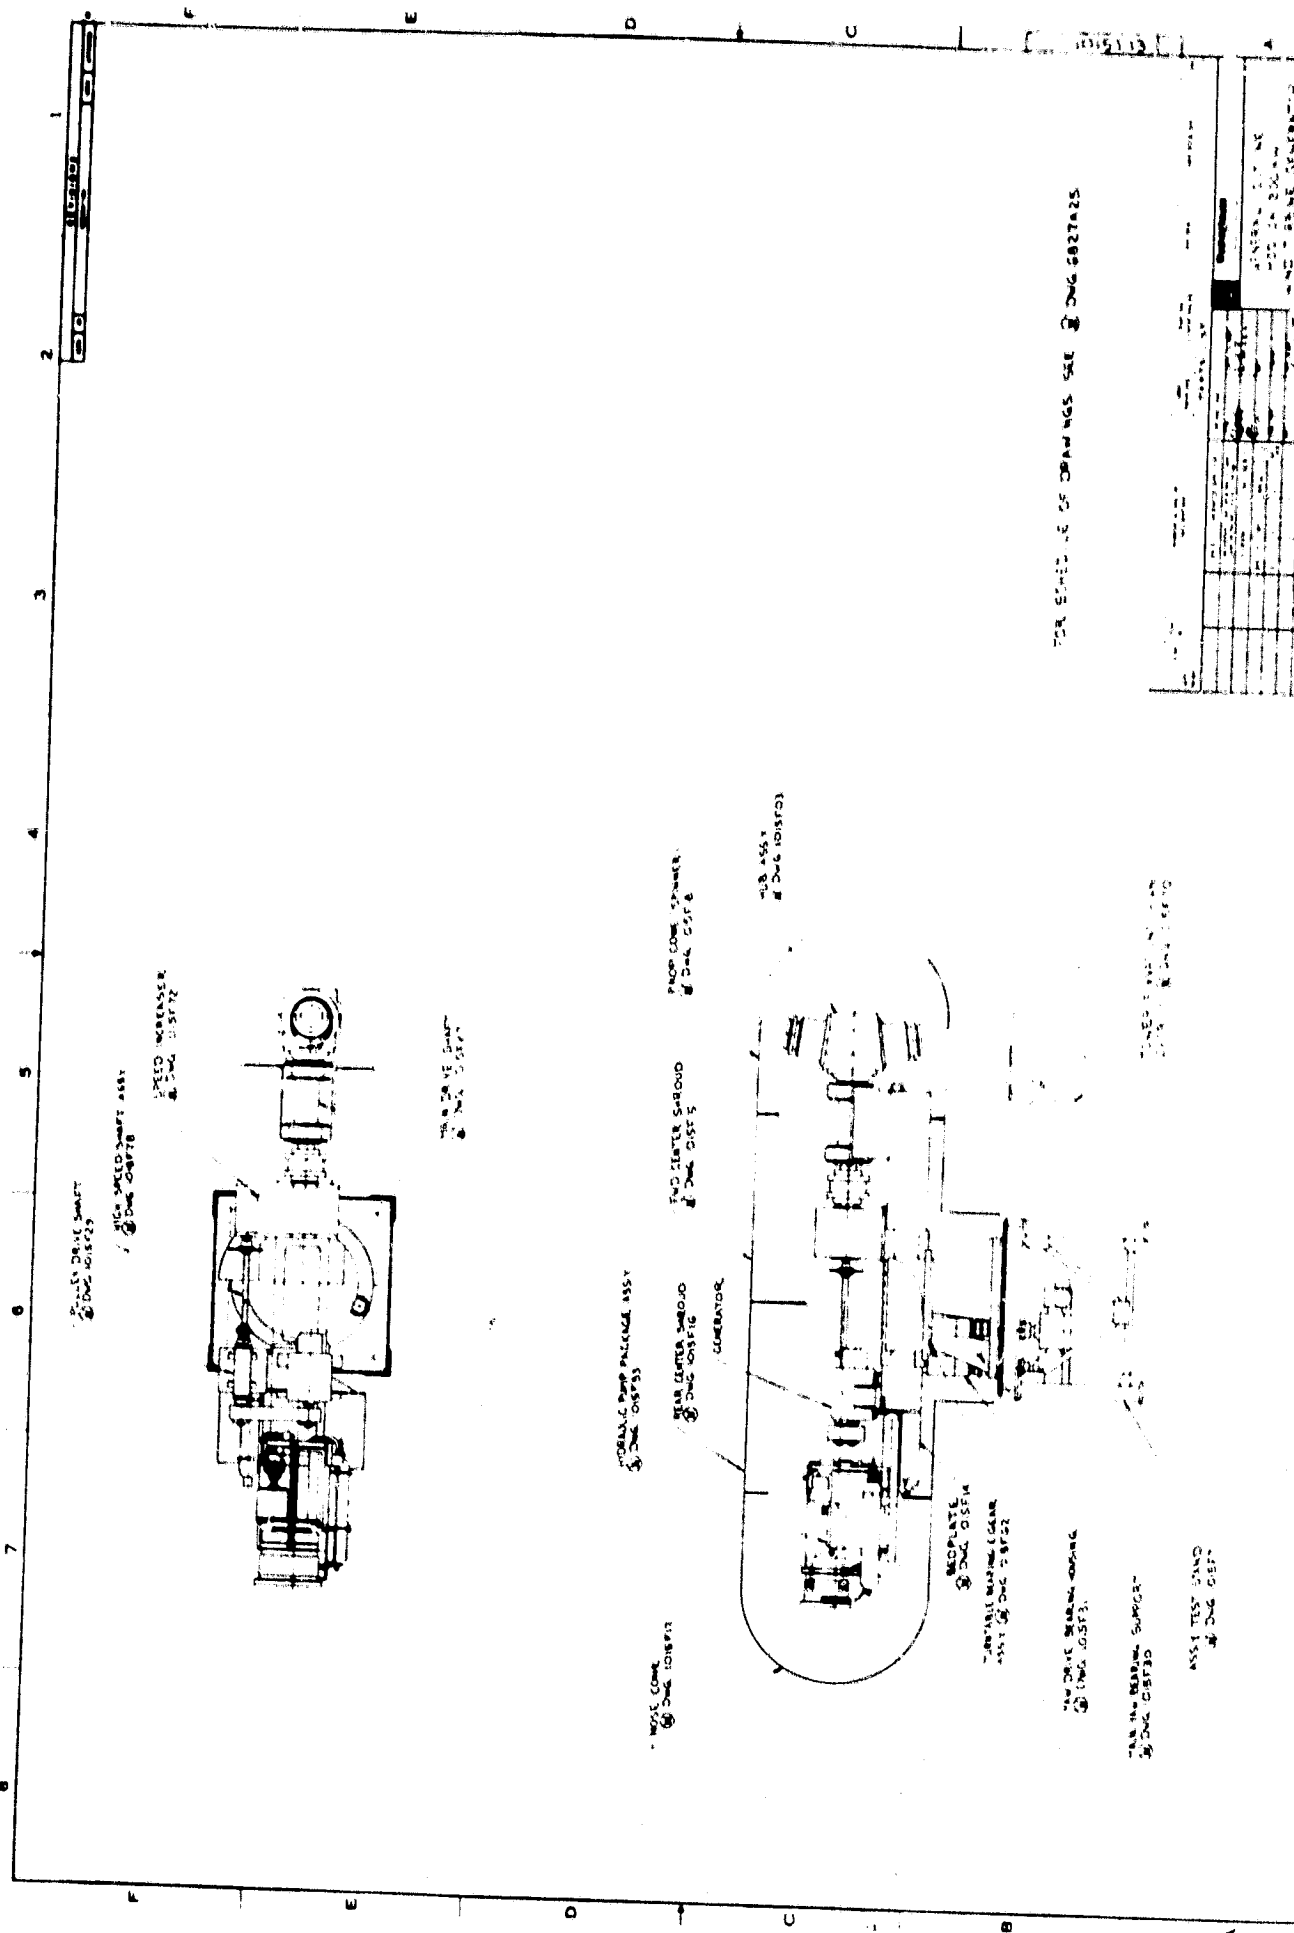


















FOR SCHEDULE OF DRAWINGS SEE Dwg 038722



038722

038723

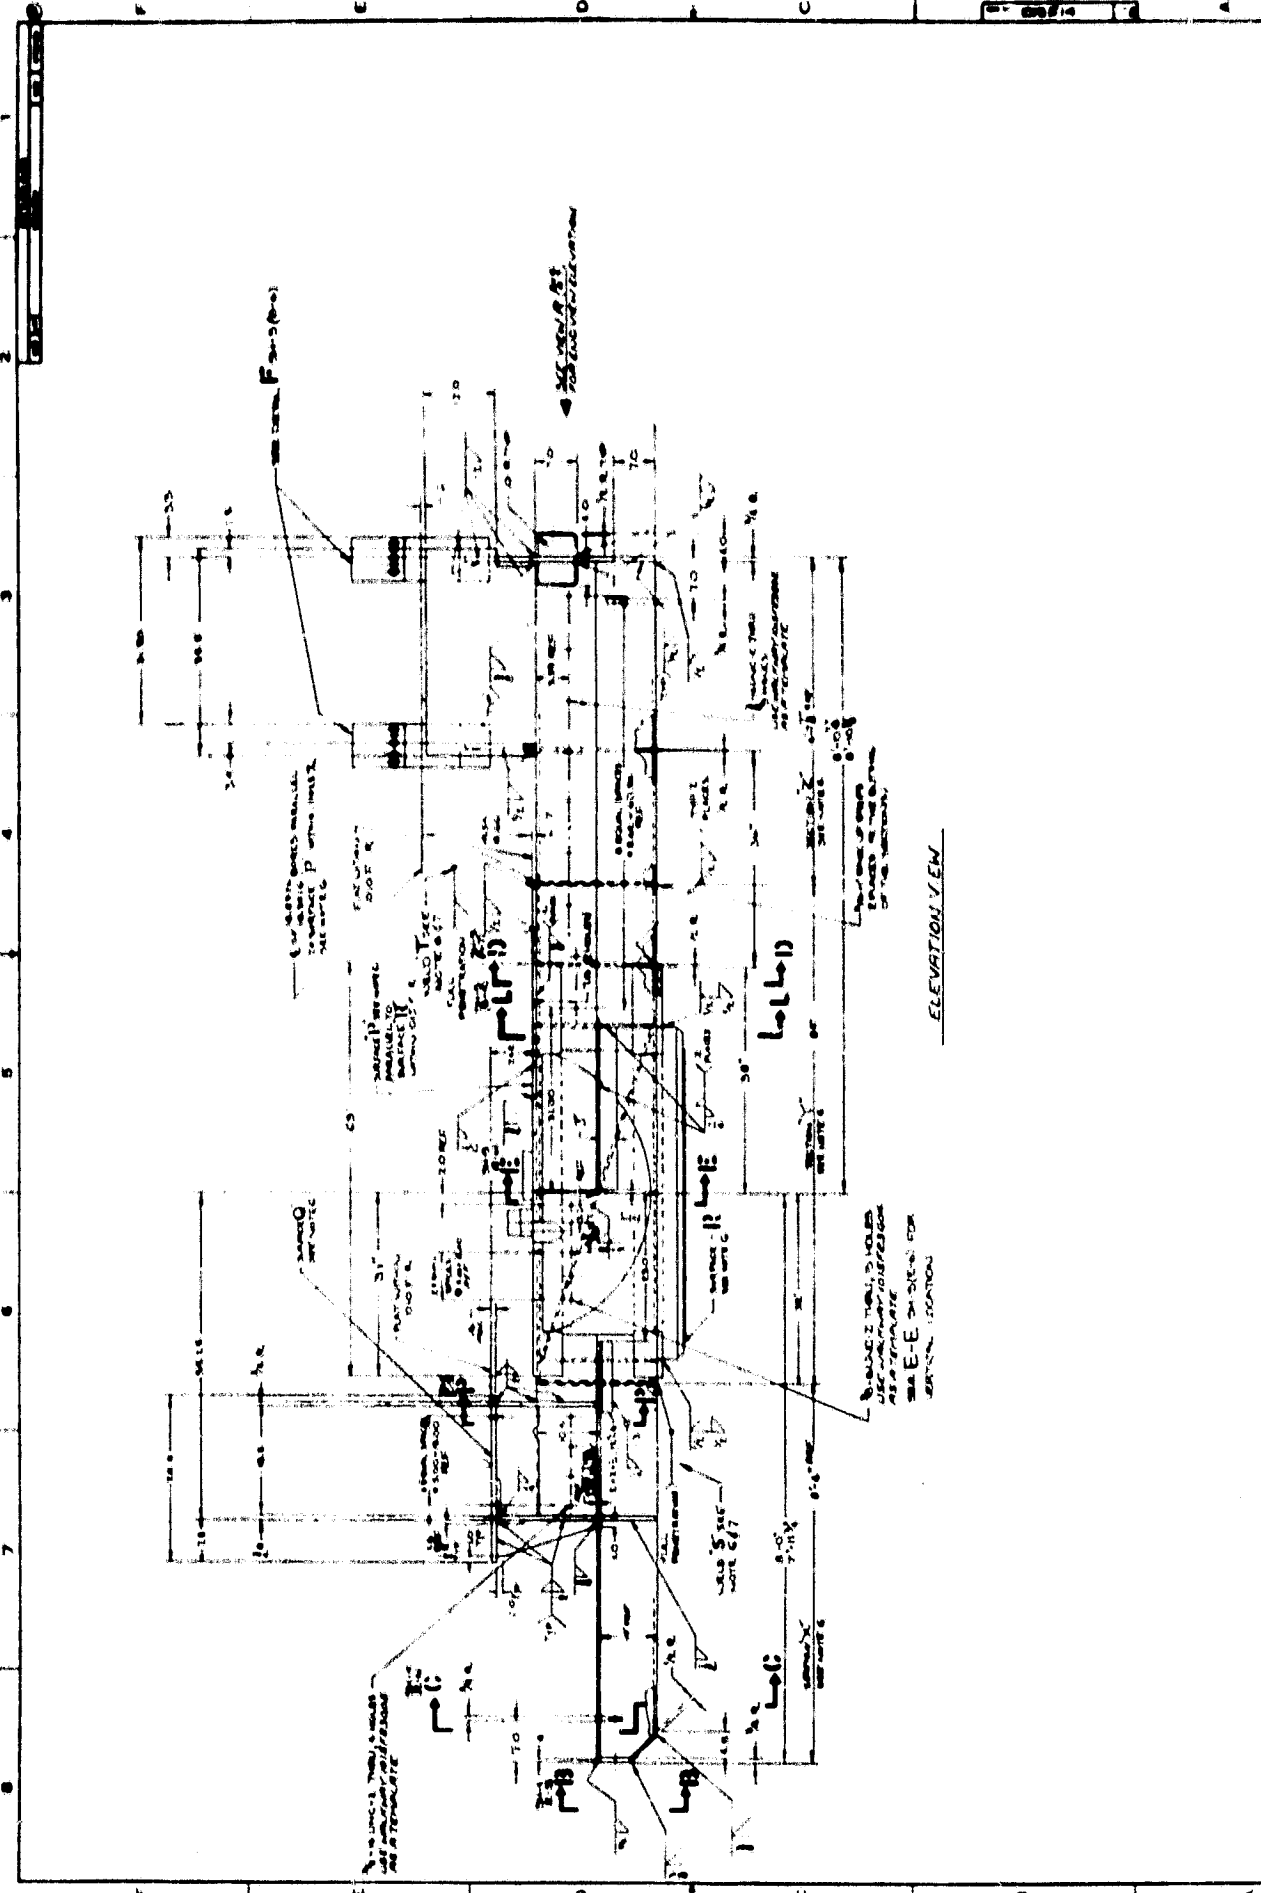

ELEVATION VIEW

SEE PLAN F-3-3(10)
SEE PLAN F-3-3(11)
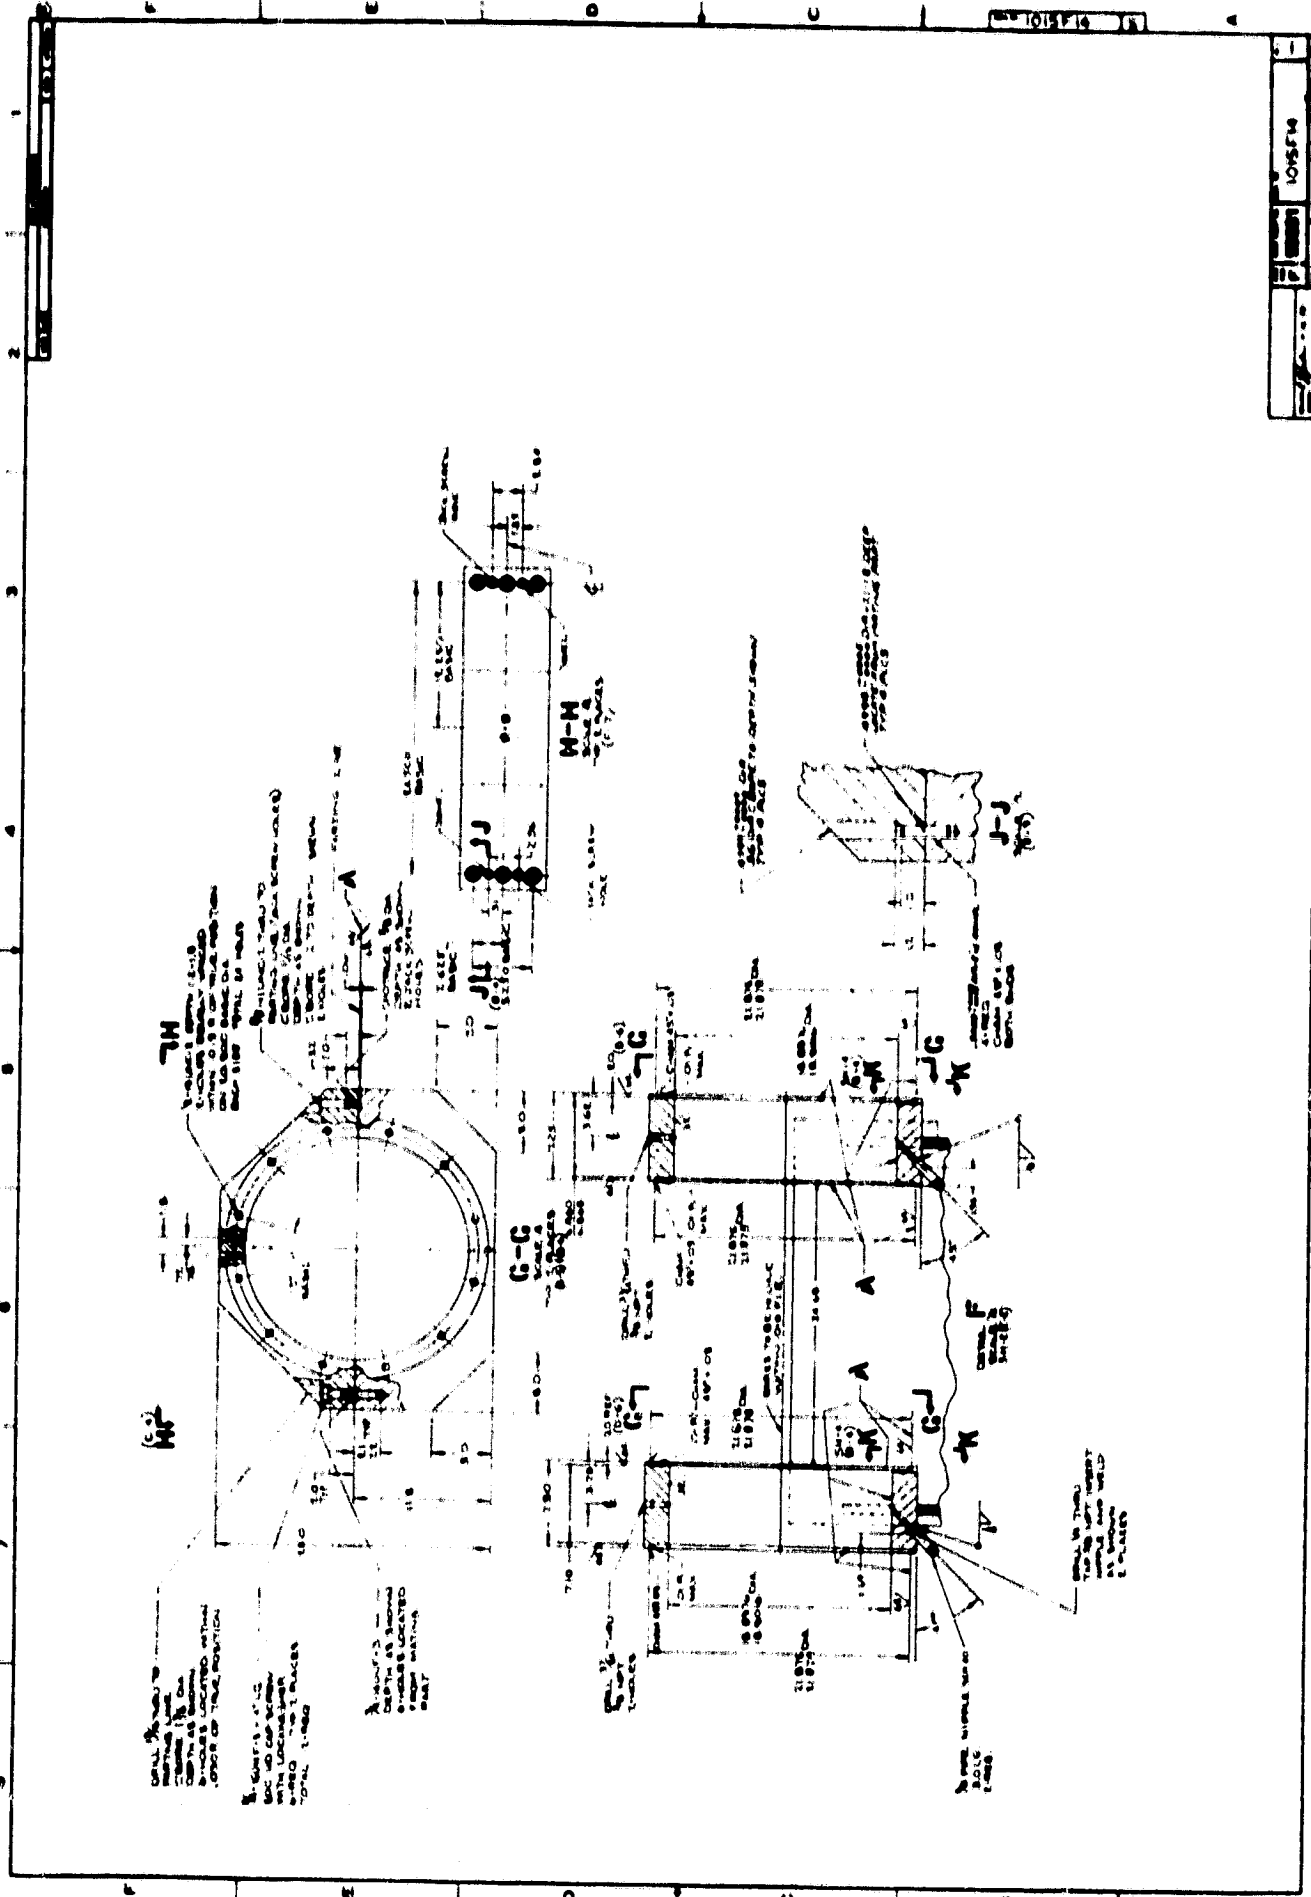

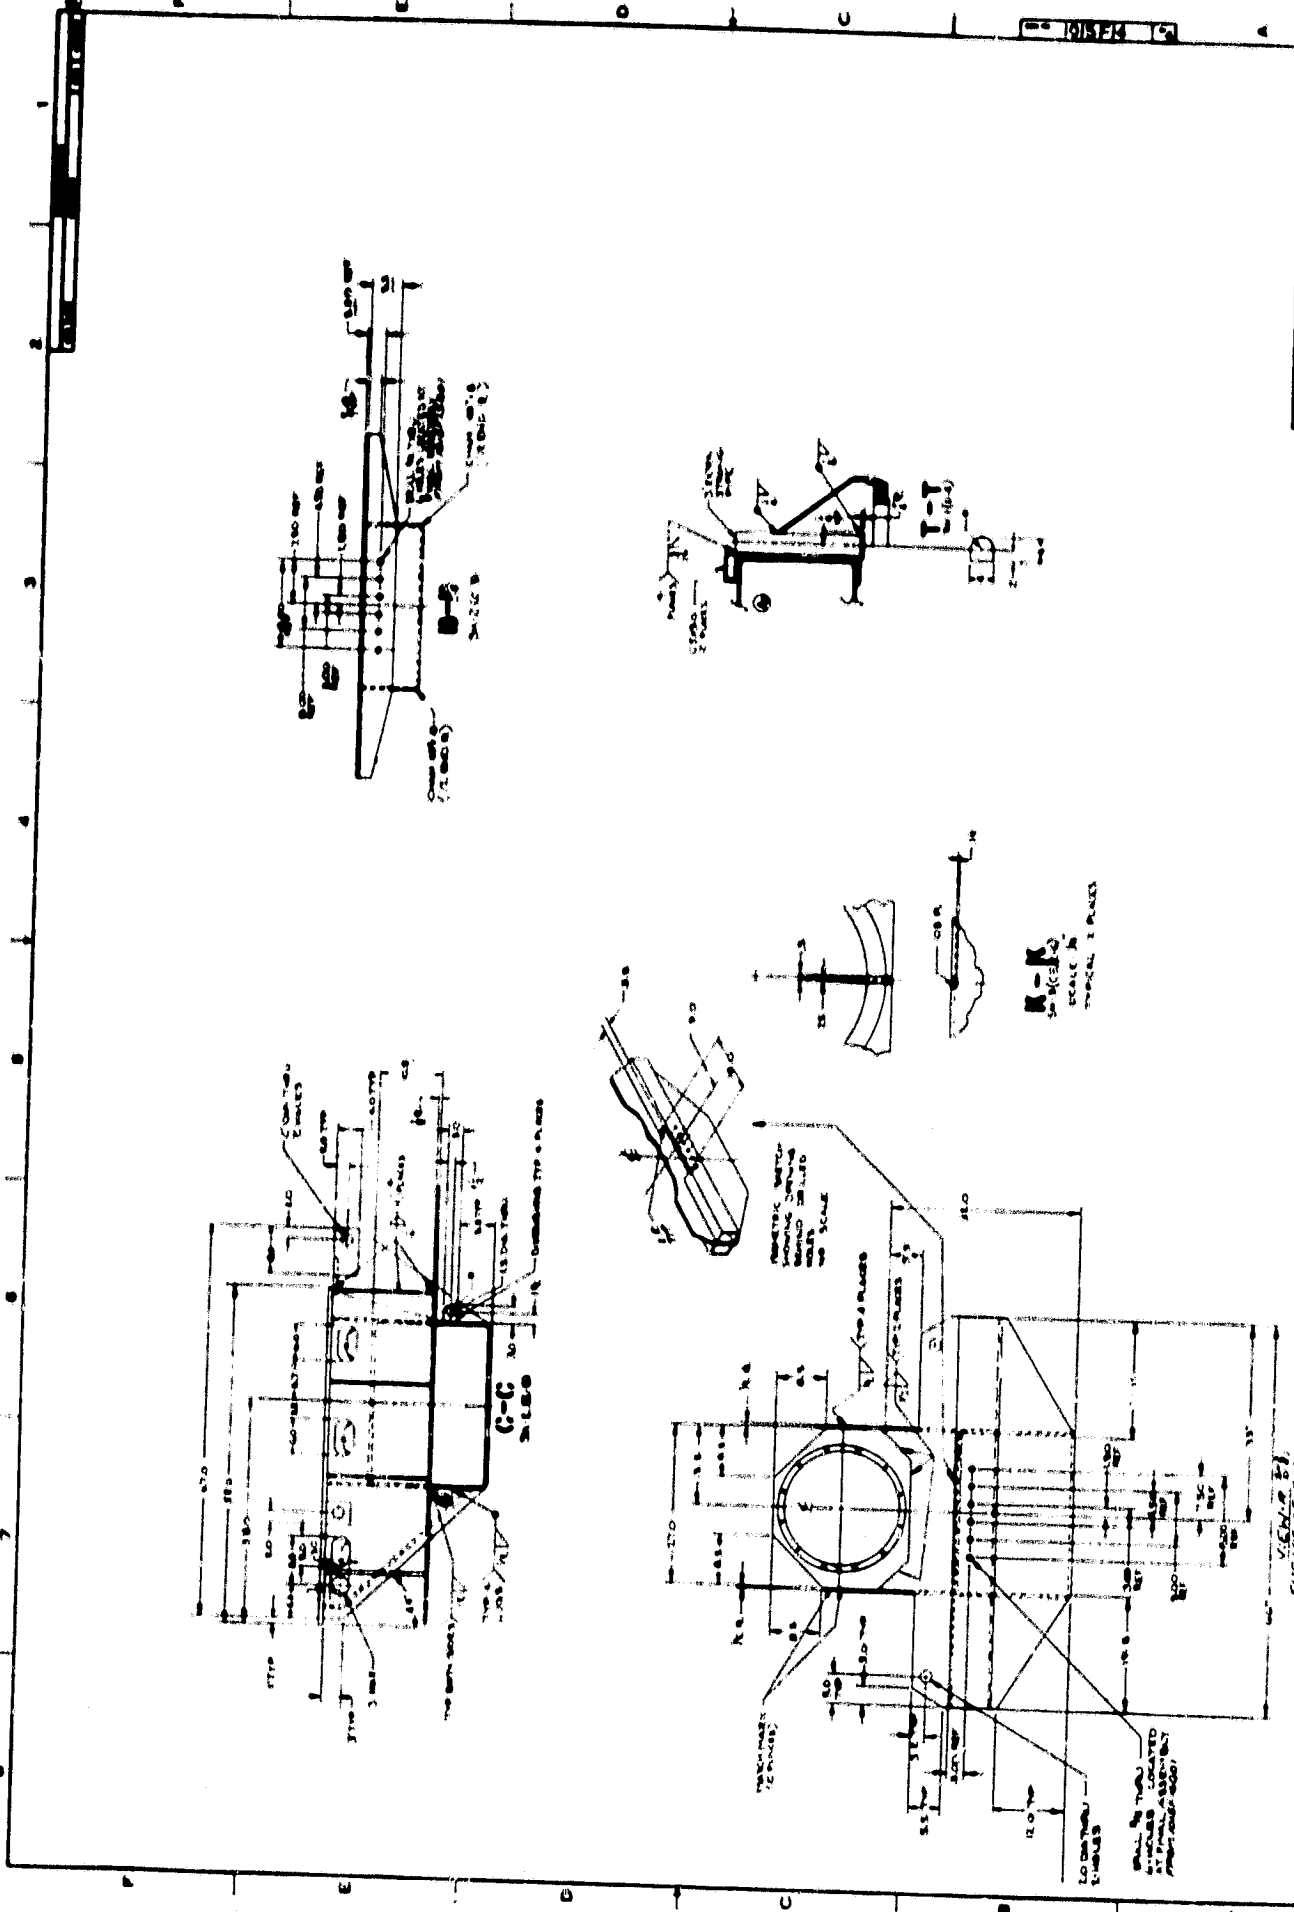


015F14
015F14
015F14
015F14






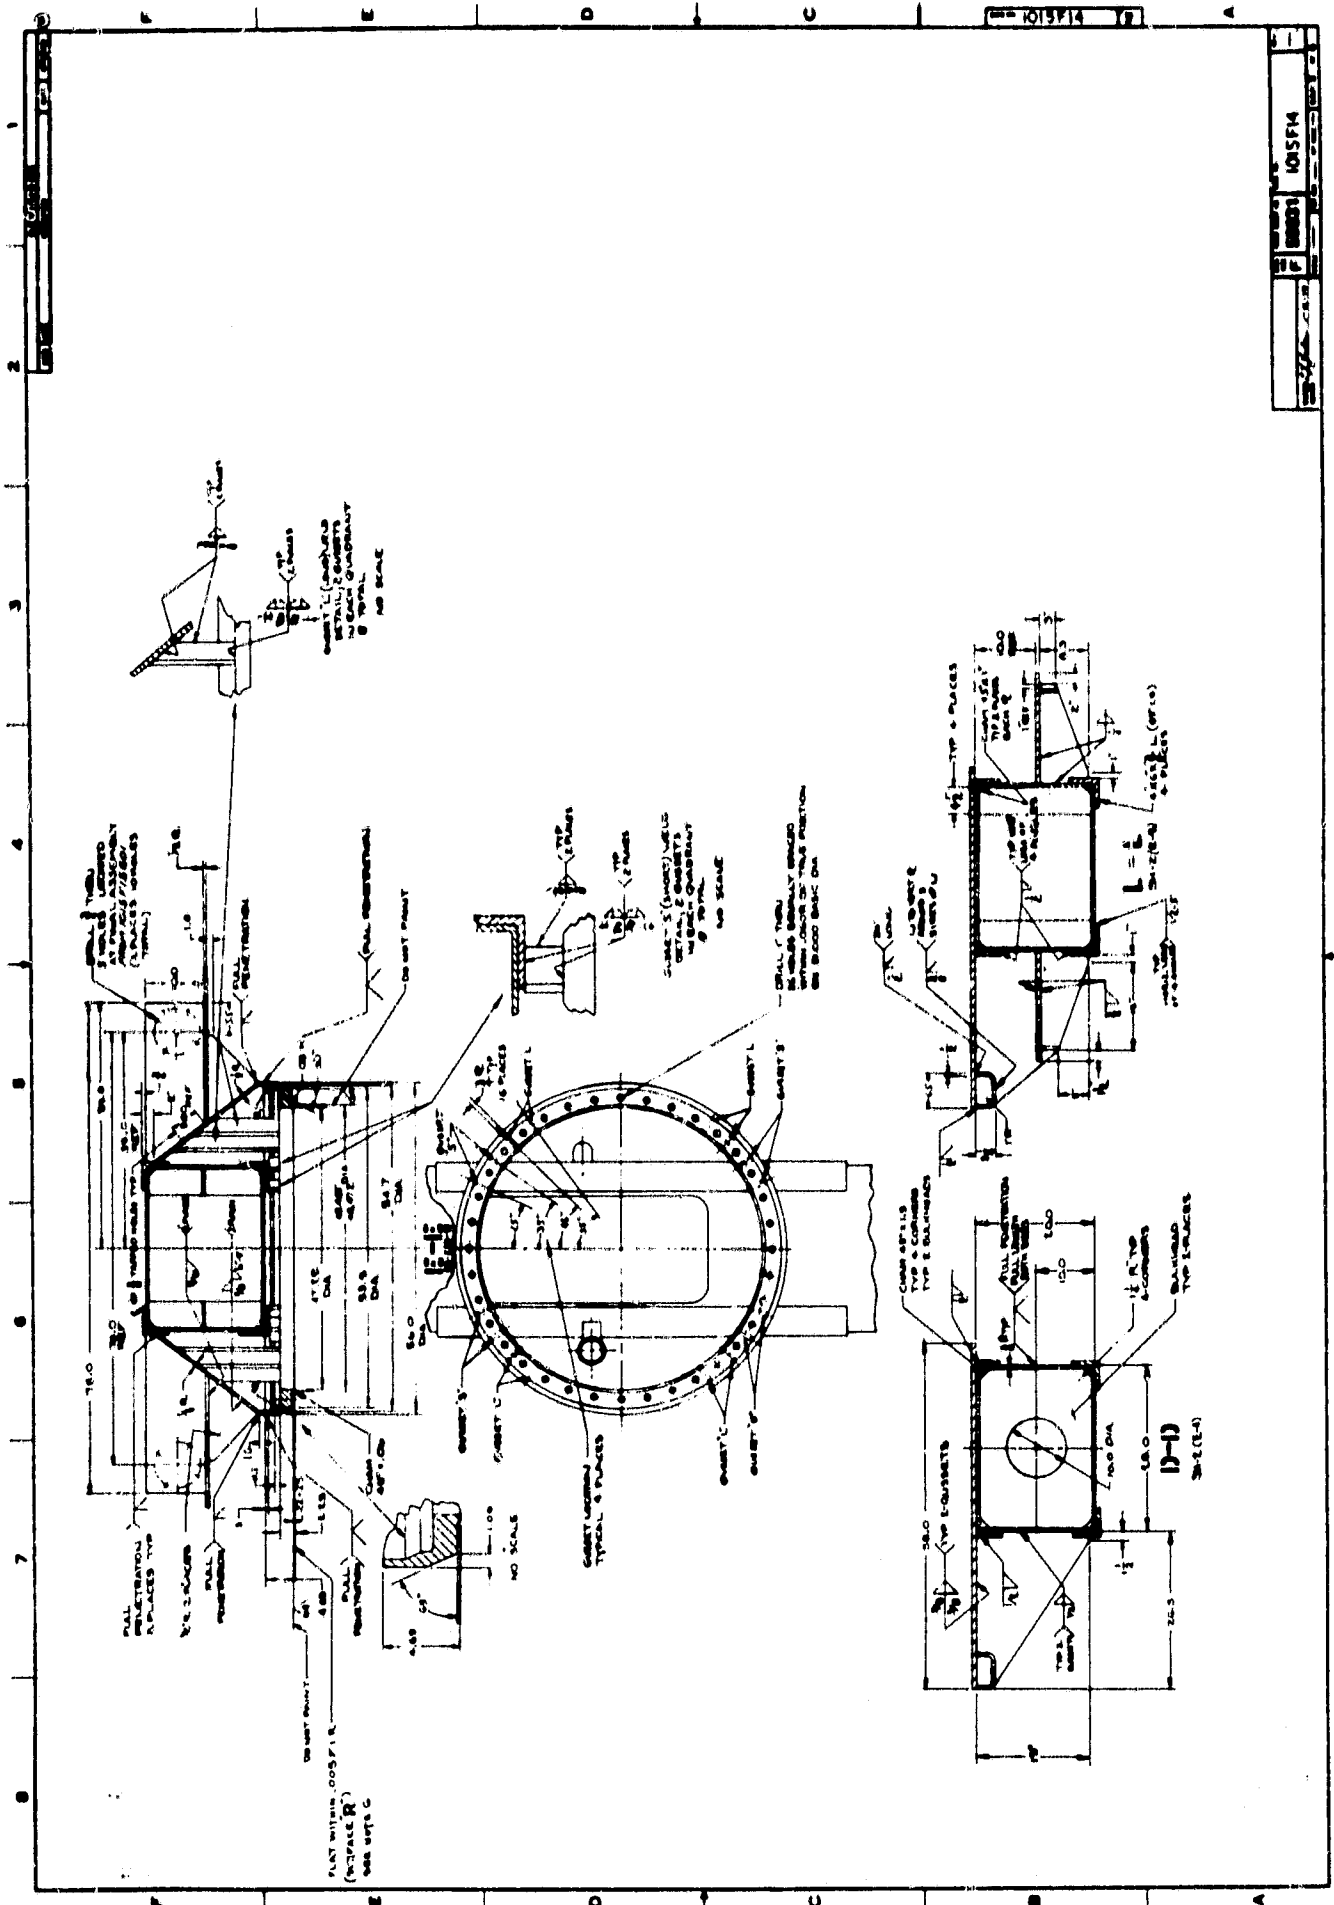

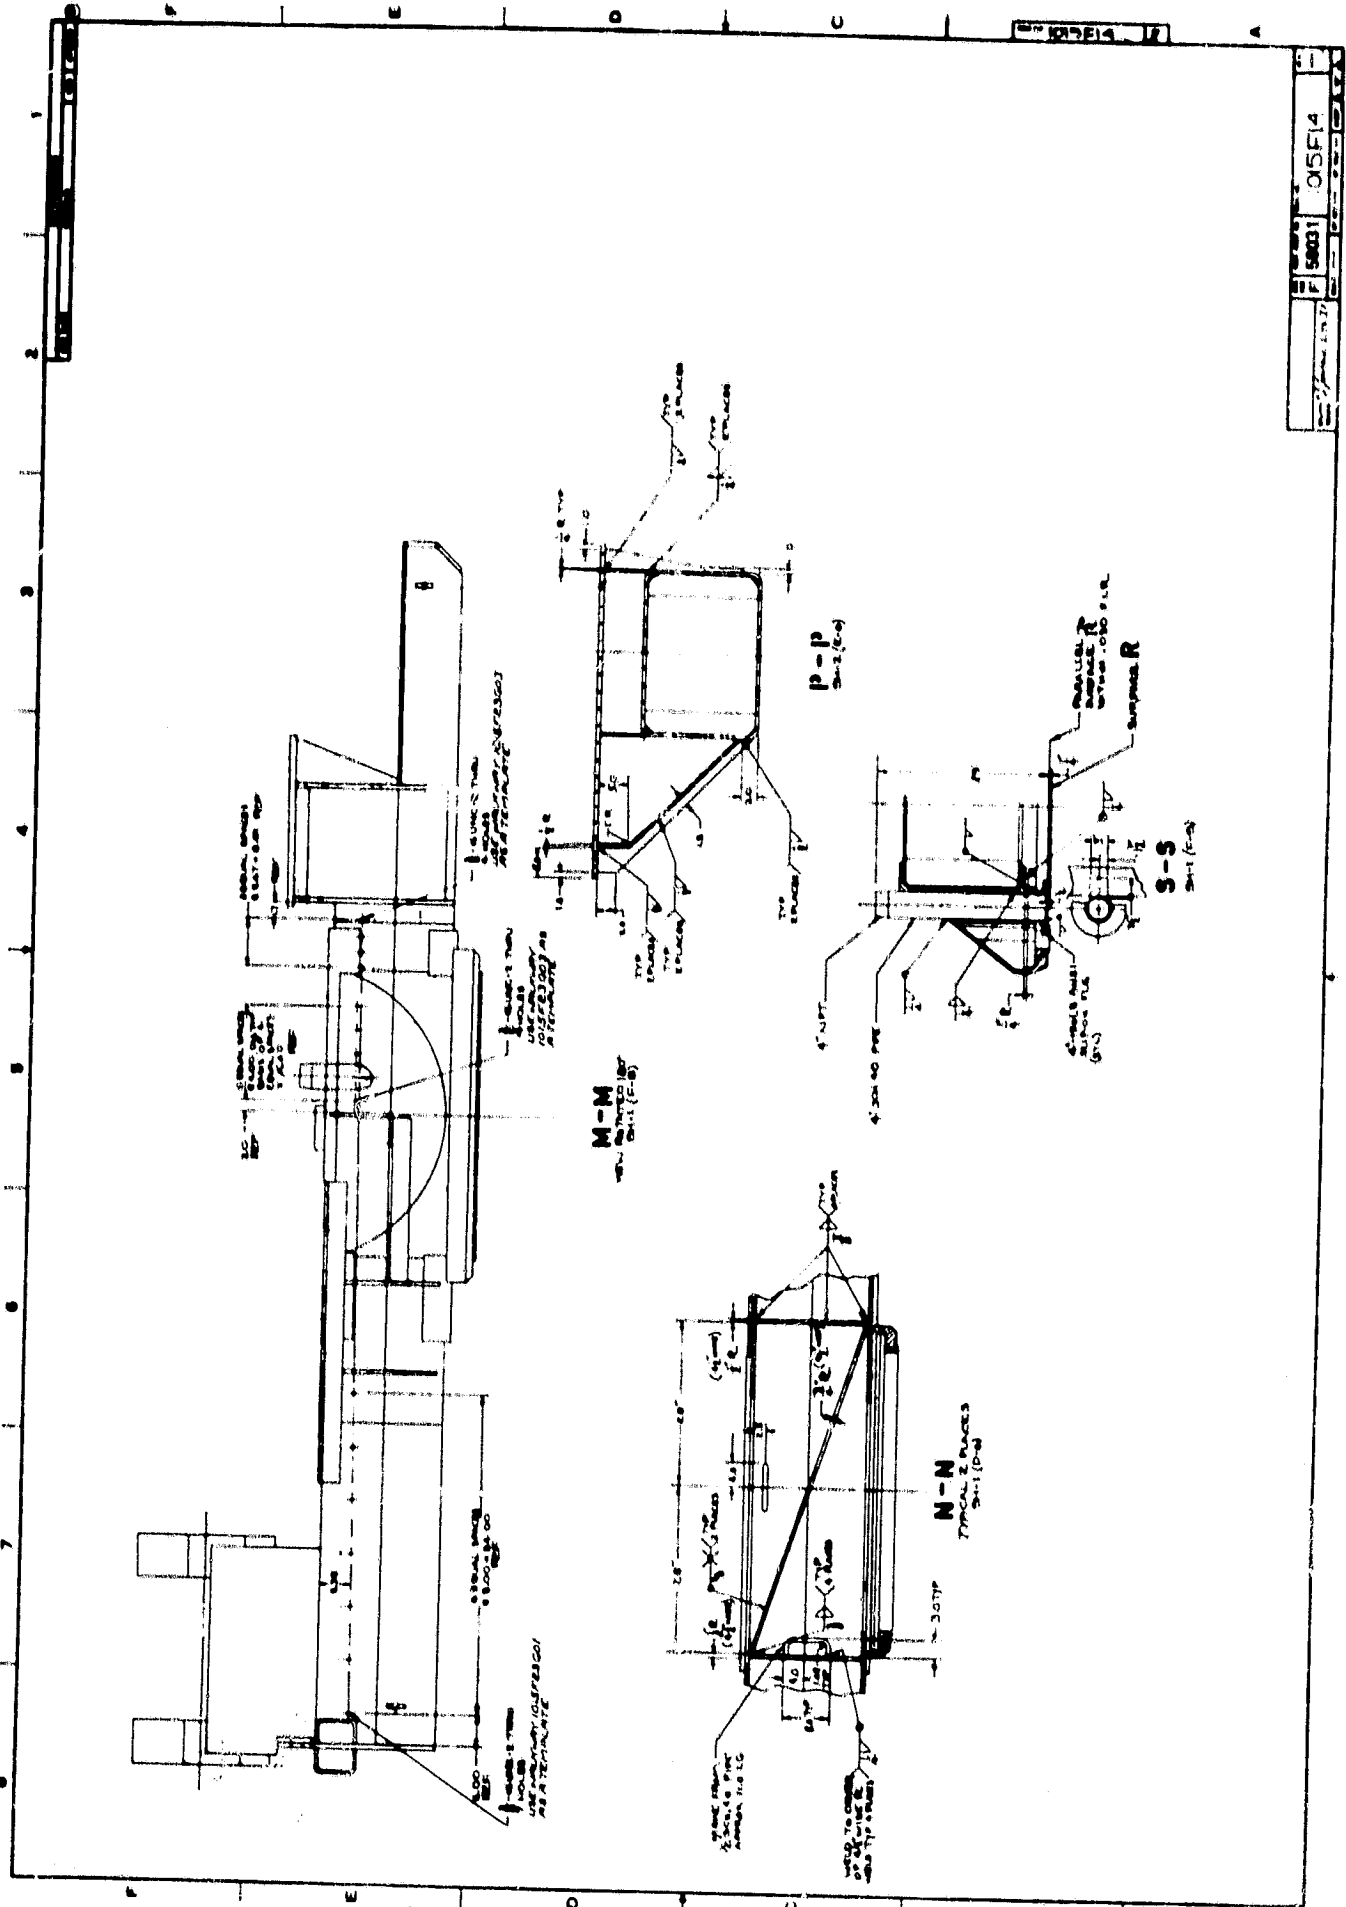

5003 05F14

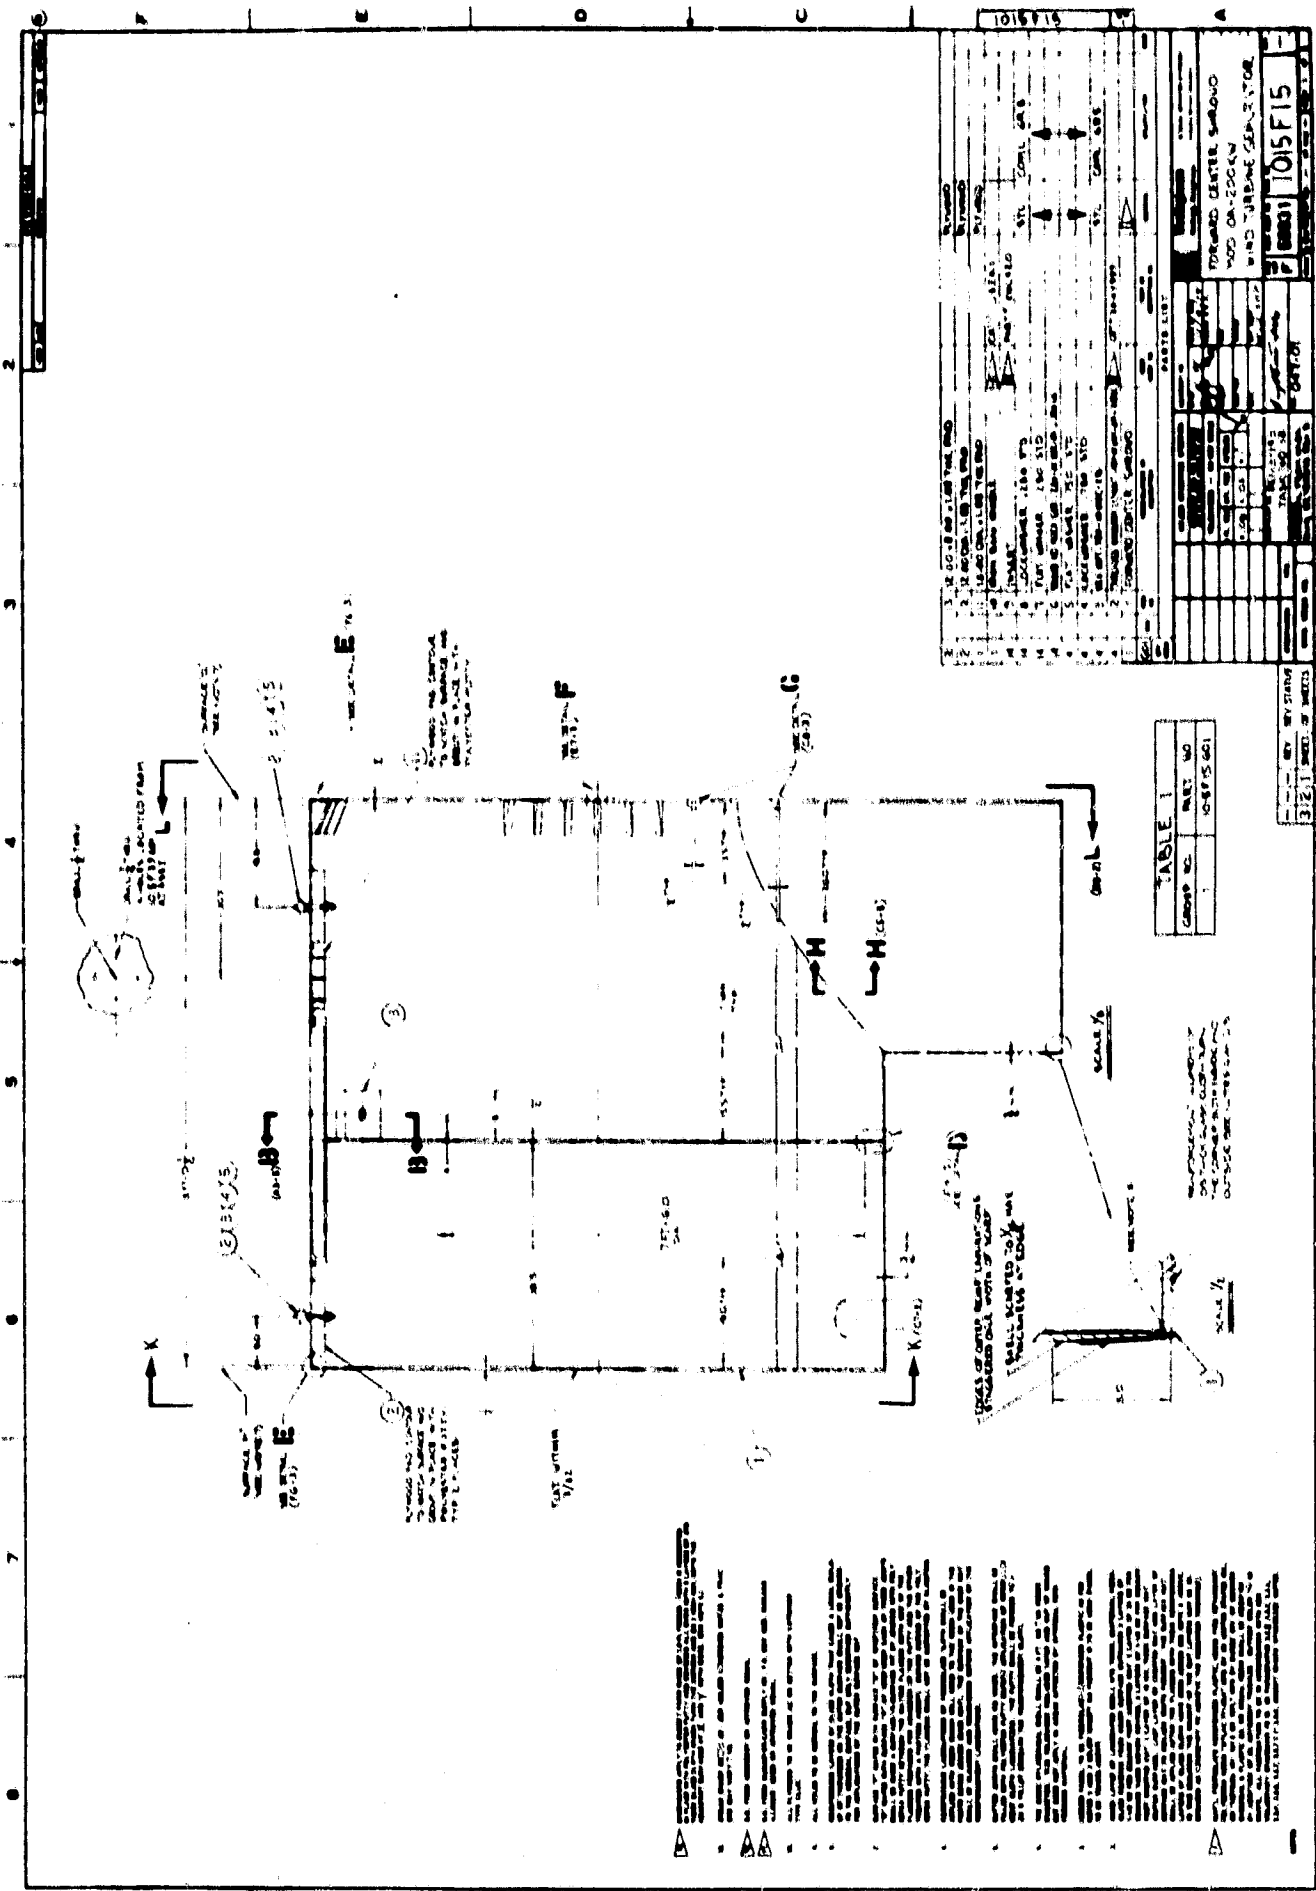


TABLE 1


COMP. NO.	REV.	DATE


REV. STATION
321

NO.	DESCRIPTION	DATE
2	WIND TURBINE GENERATOR	

1015F15


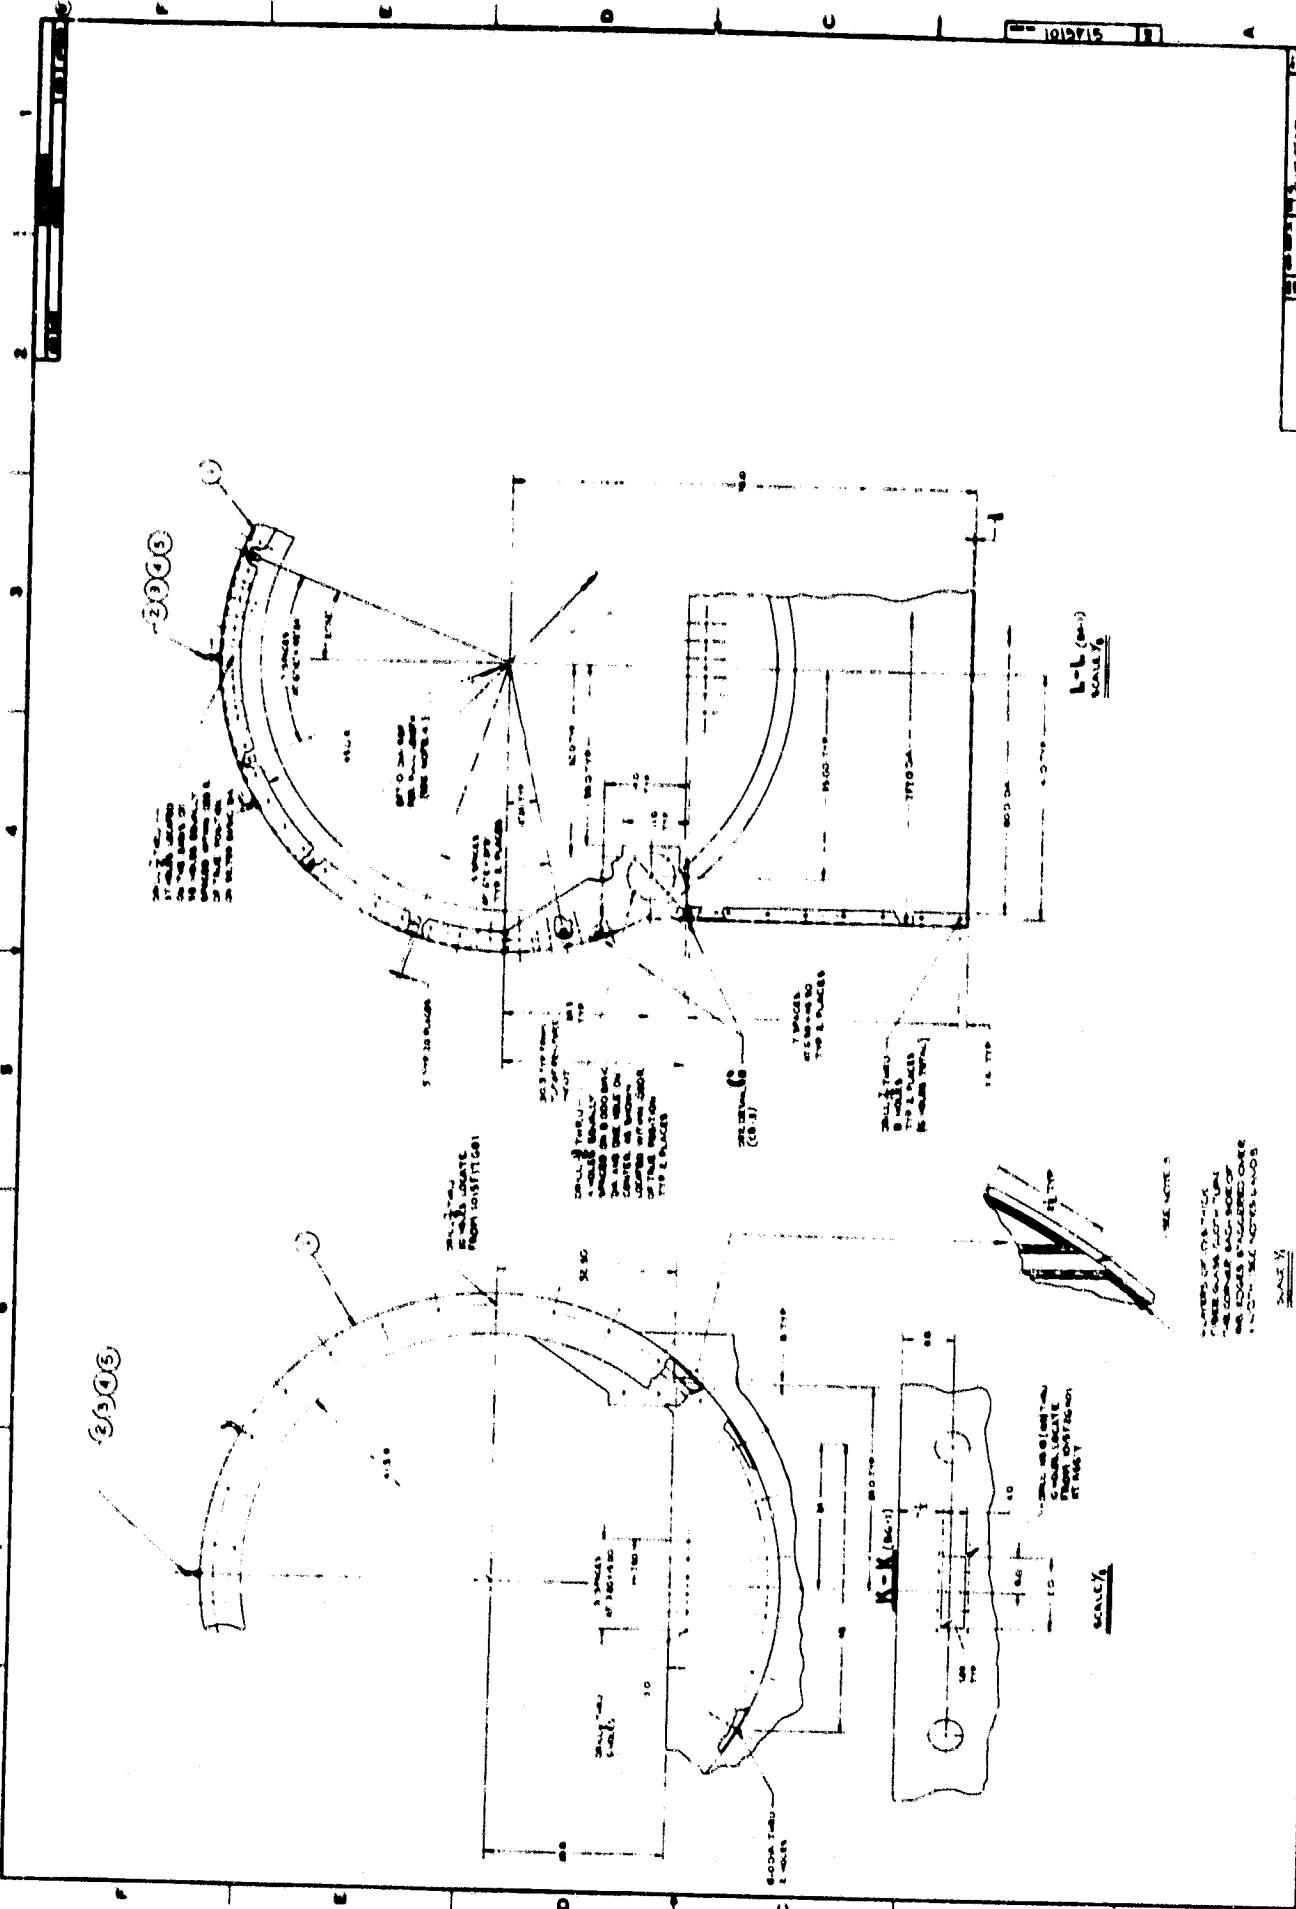

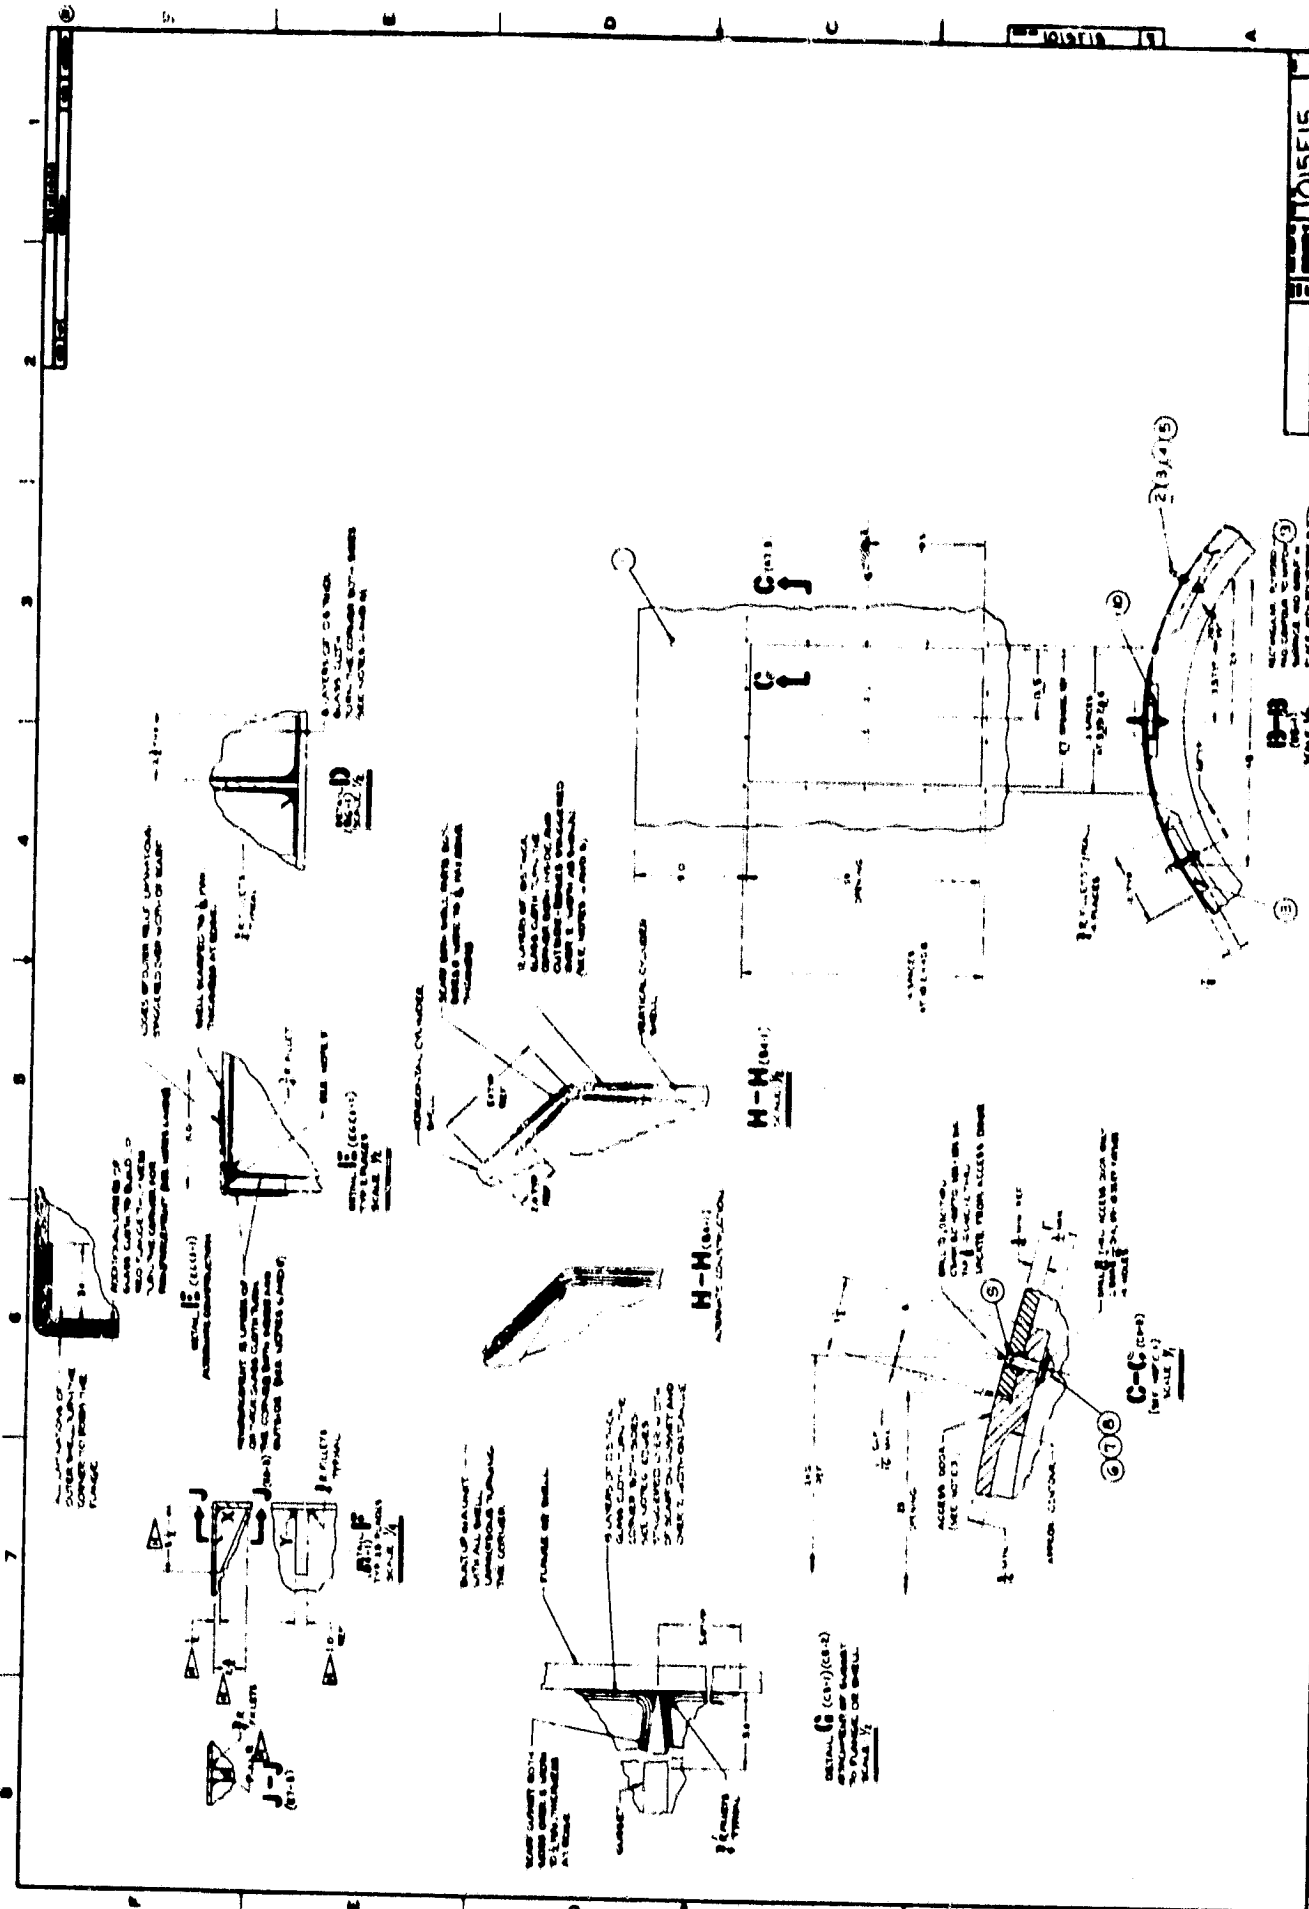

10515
 10515
 SCALE 1/4" = 1'-0"
 DATE 1/15/51

5
C-C (CP-1)
 (SEE NOTES)
 SCALE 1/2" = 1'-0"

6
C-I

H-M (80-1)
 SCALE 1/2" = 1'-0"

H-M (80-2)
 SCALE 1/2" = 1'-0"

6
(CP-1)(C-12)
 SCALE 1/2" = 1'-0"

7
F (CP-1)
 (SEE NOTES)
 SCALE 1/2" = 1'-0"

8
D


















REAR CENTER WIND
 MOD. GA. 200 IN.
 WIND TURBINE GENERATOR


50031 1015 F16

VIEW N (CS-2)
SCALE 1/2

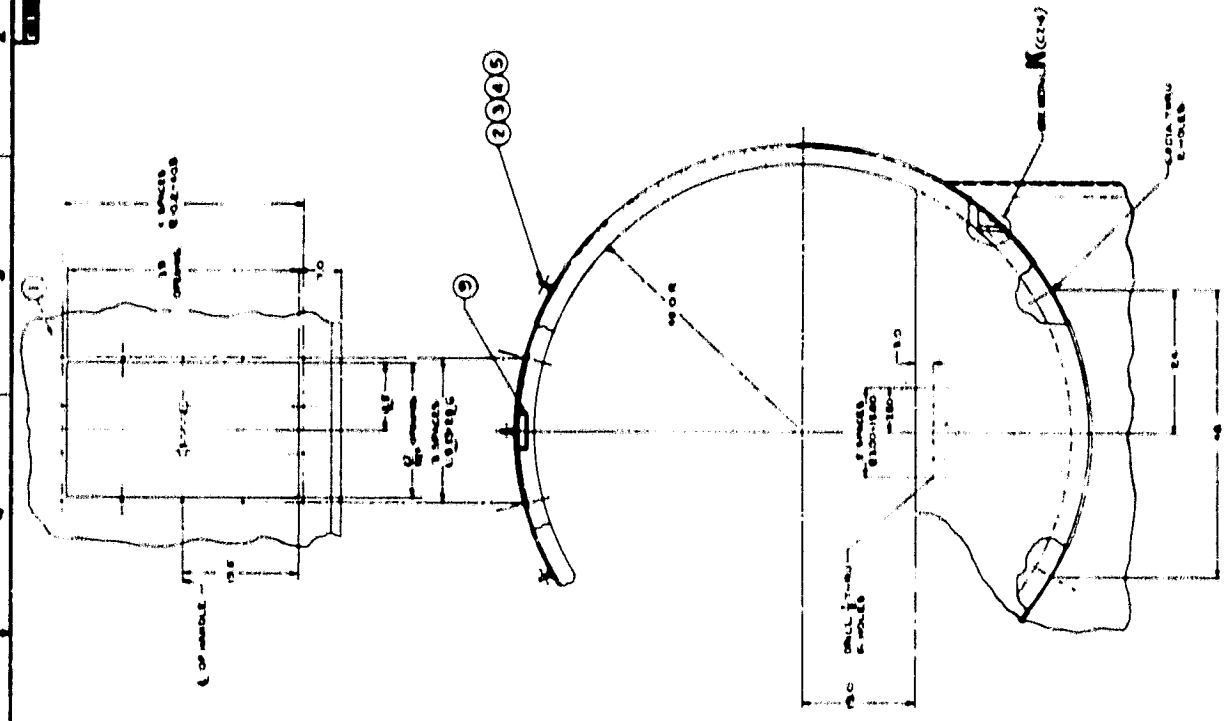

VIEW RP (CS-2)

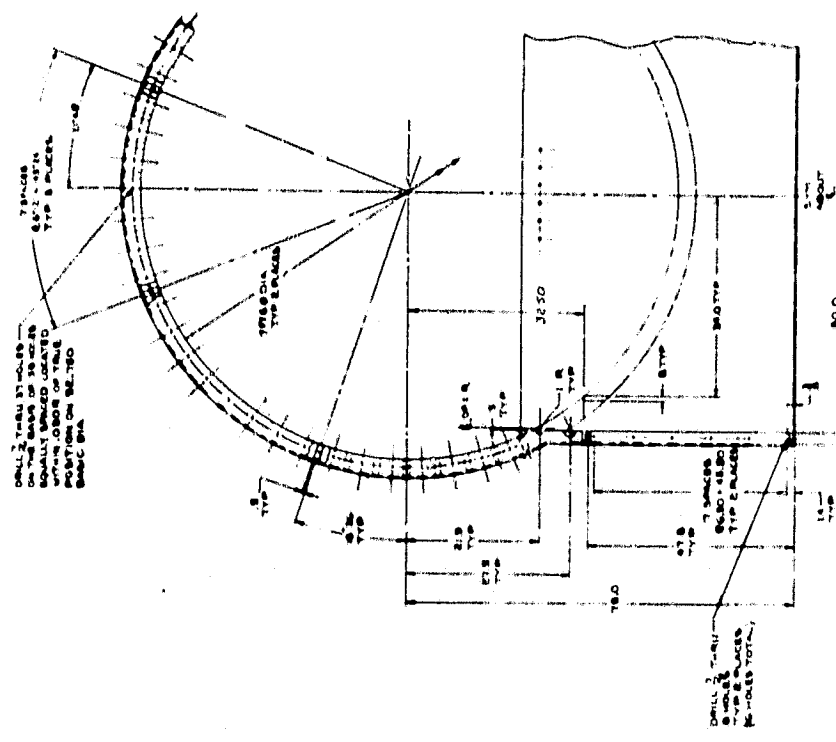

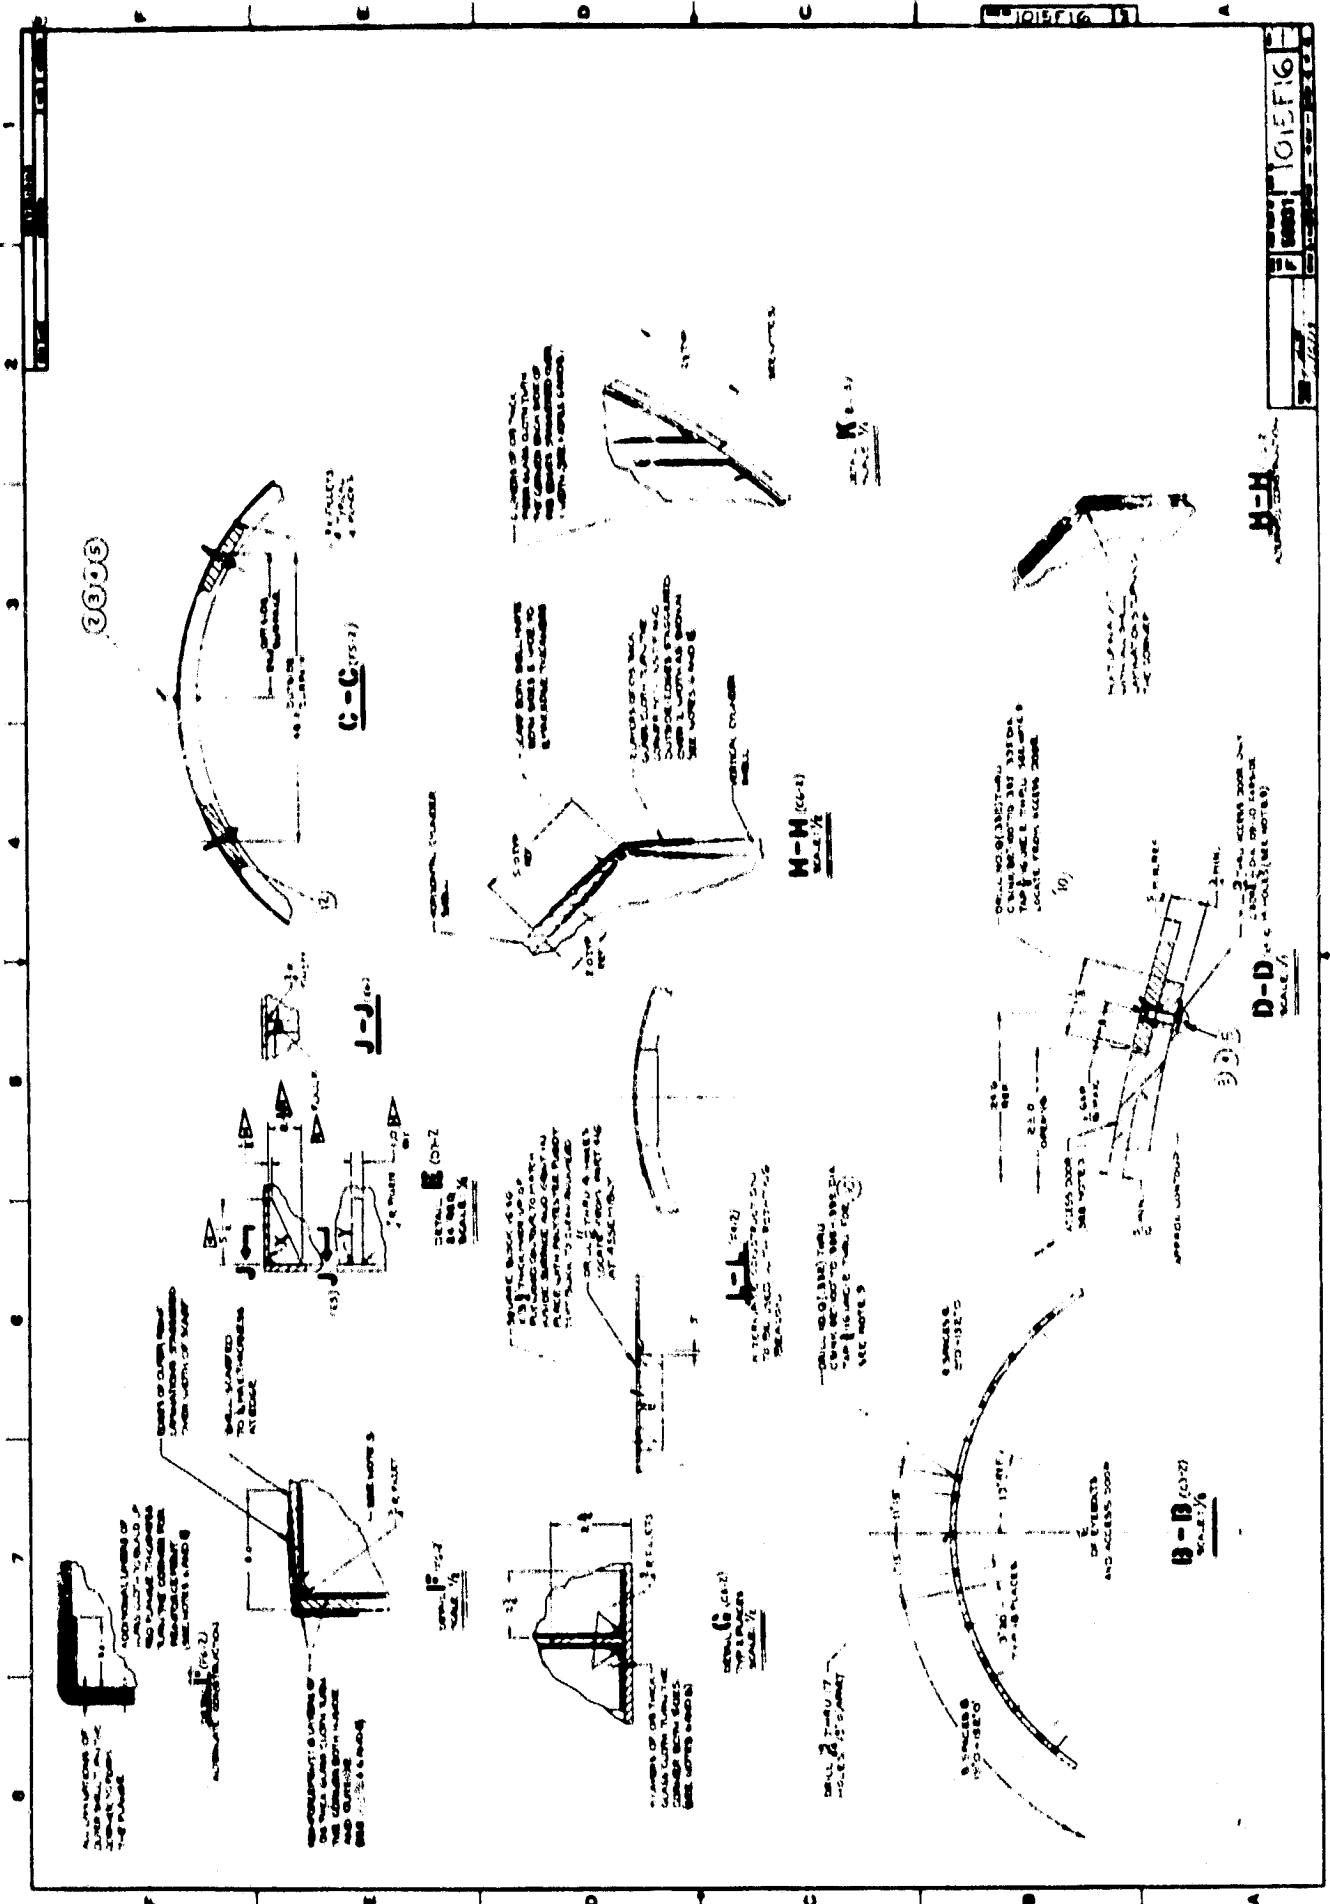


M-H


D-D

B-B

M-M

C-C

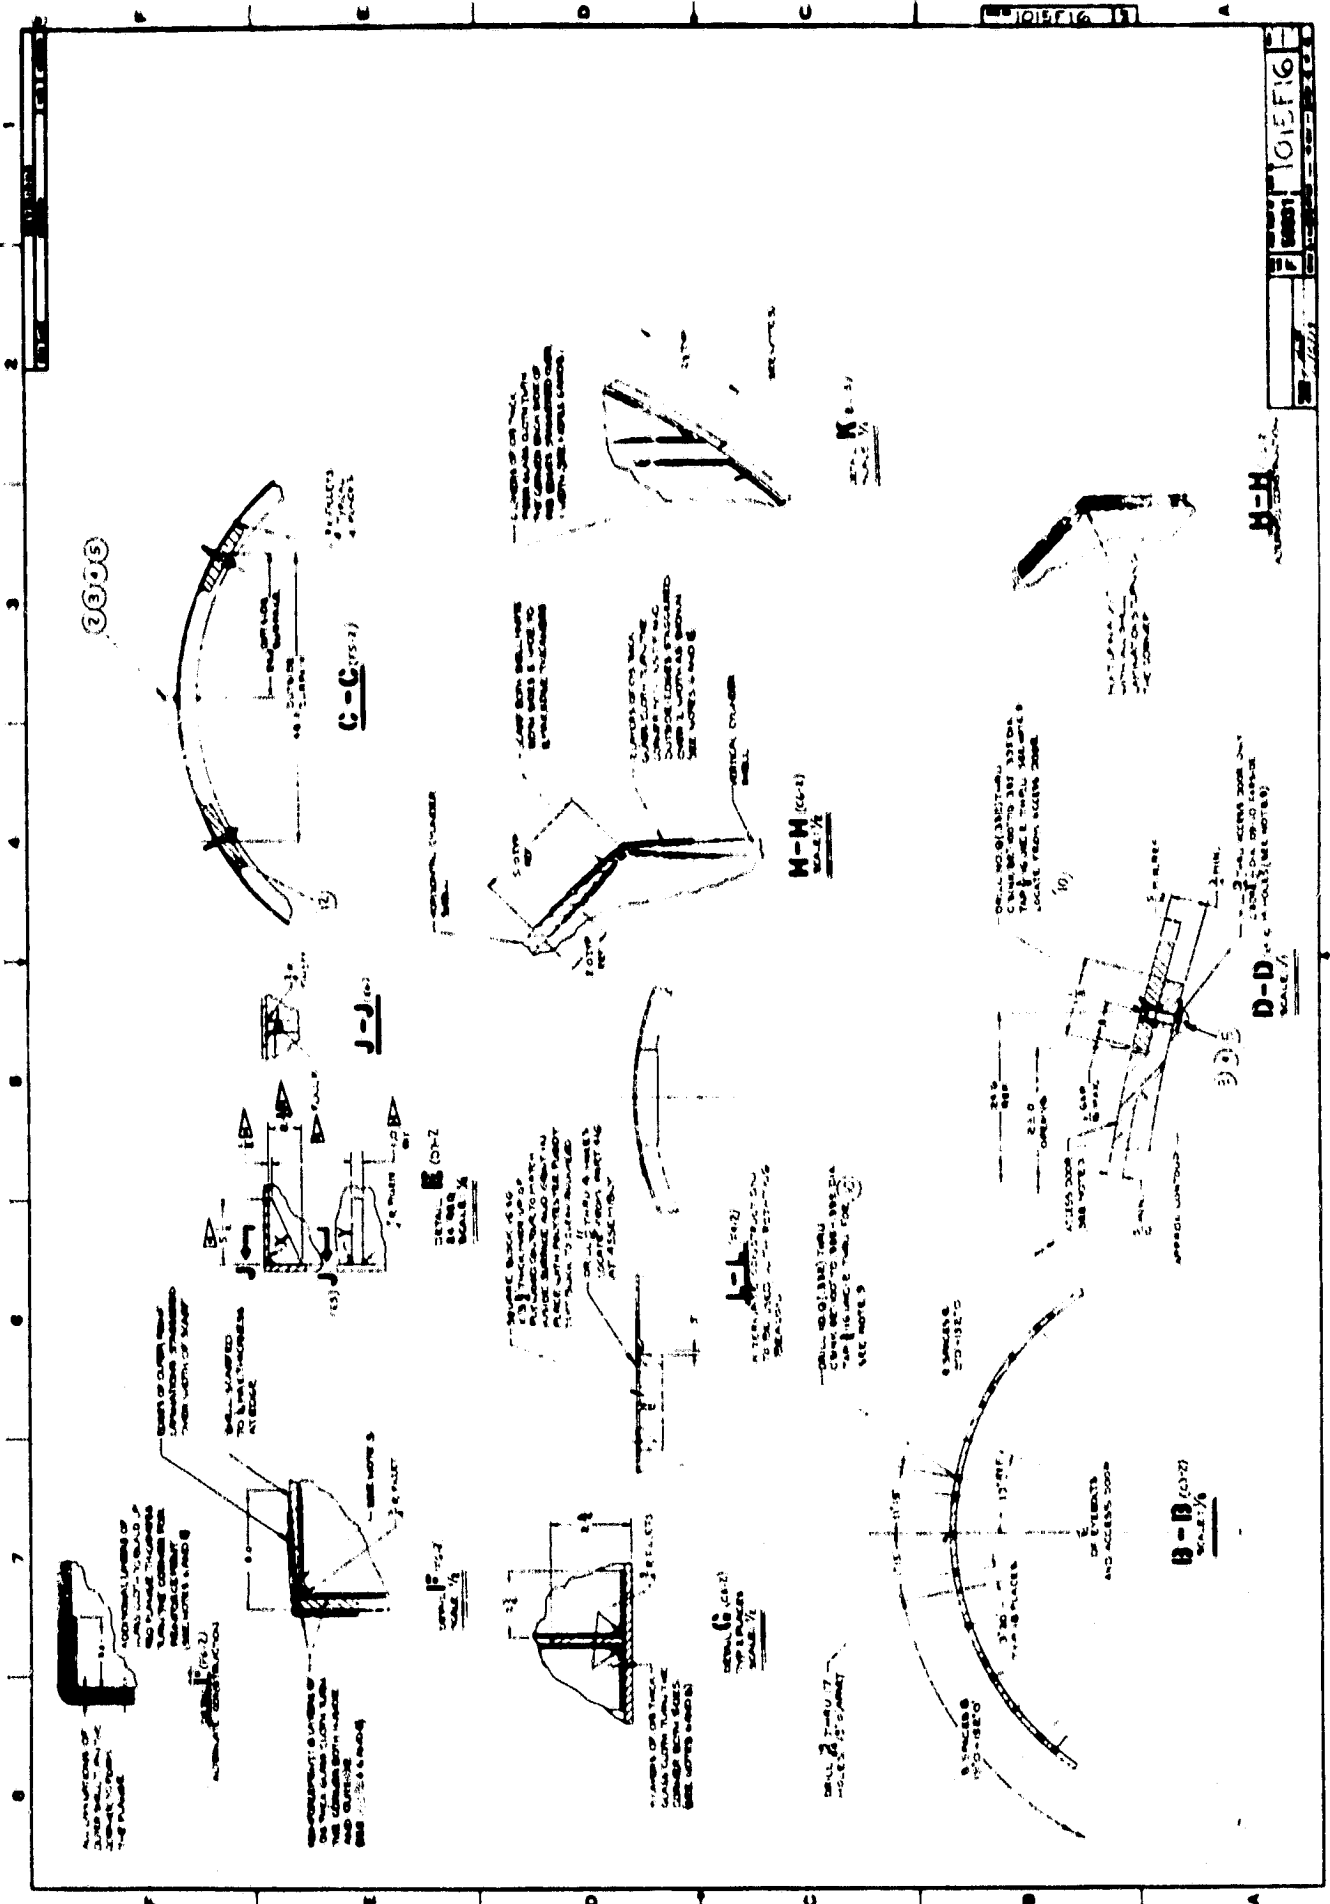

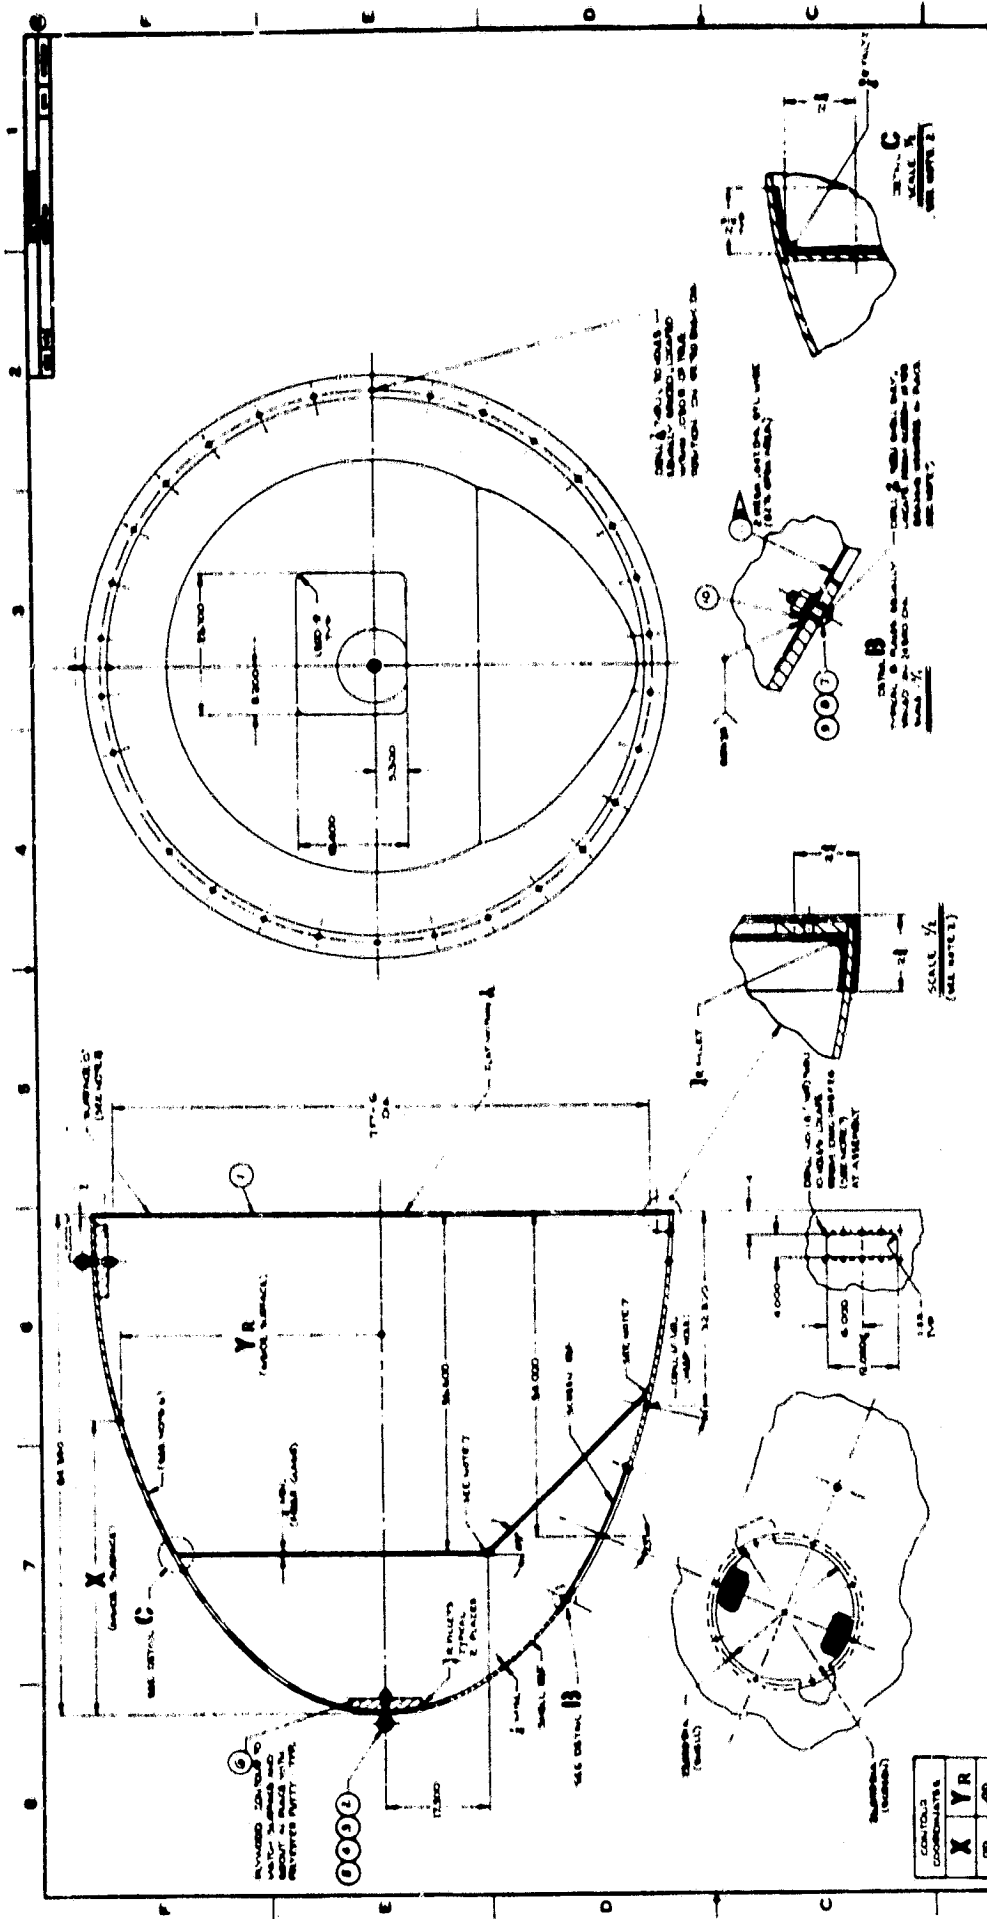

PARTS LIST		QUANTITY		DESCRIPTION	




TABLE 1
GROUP NO. PART NO. QTY.


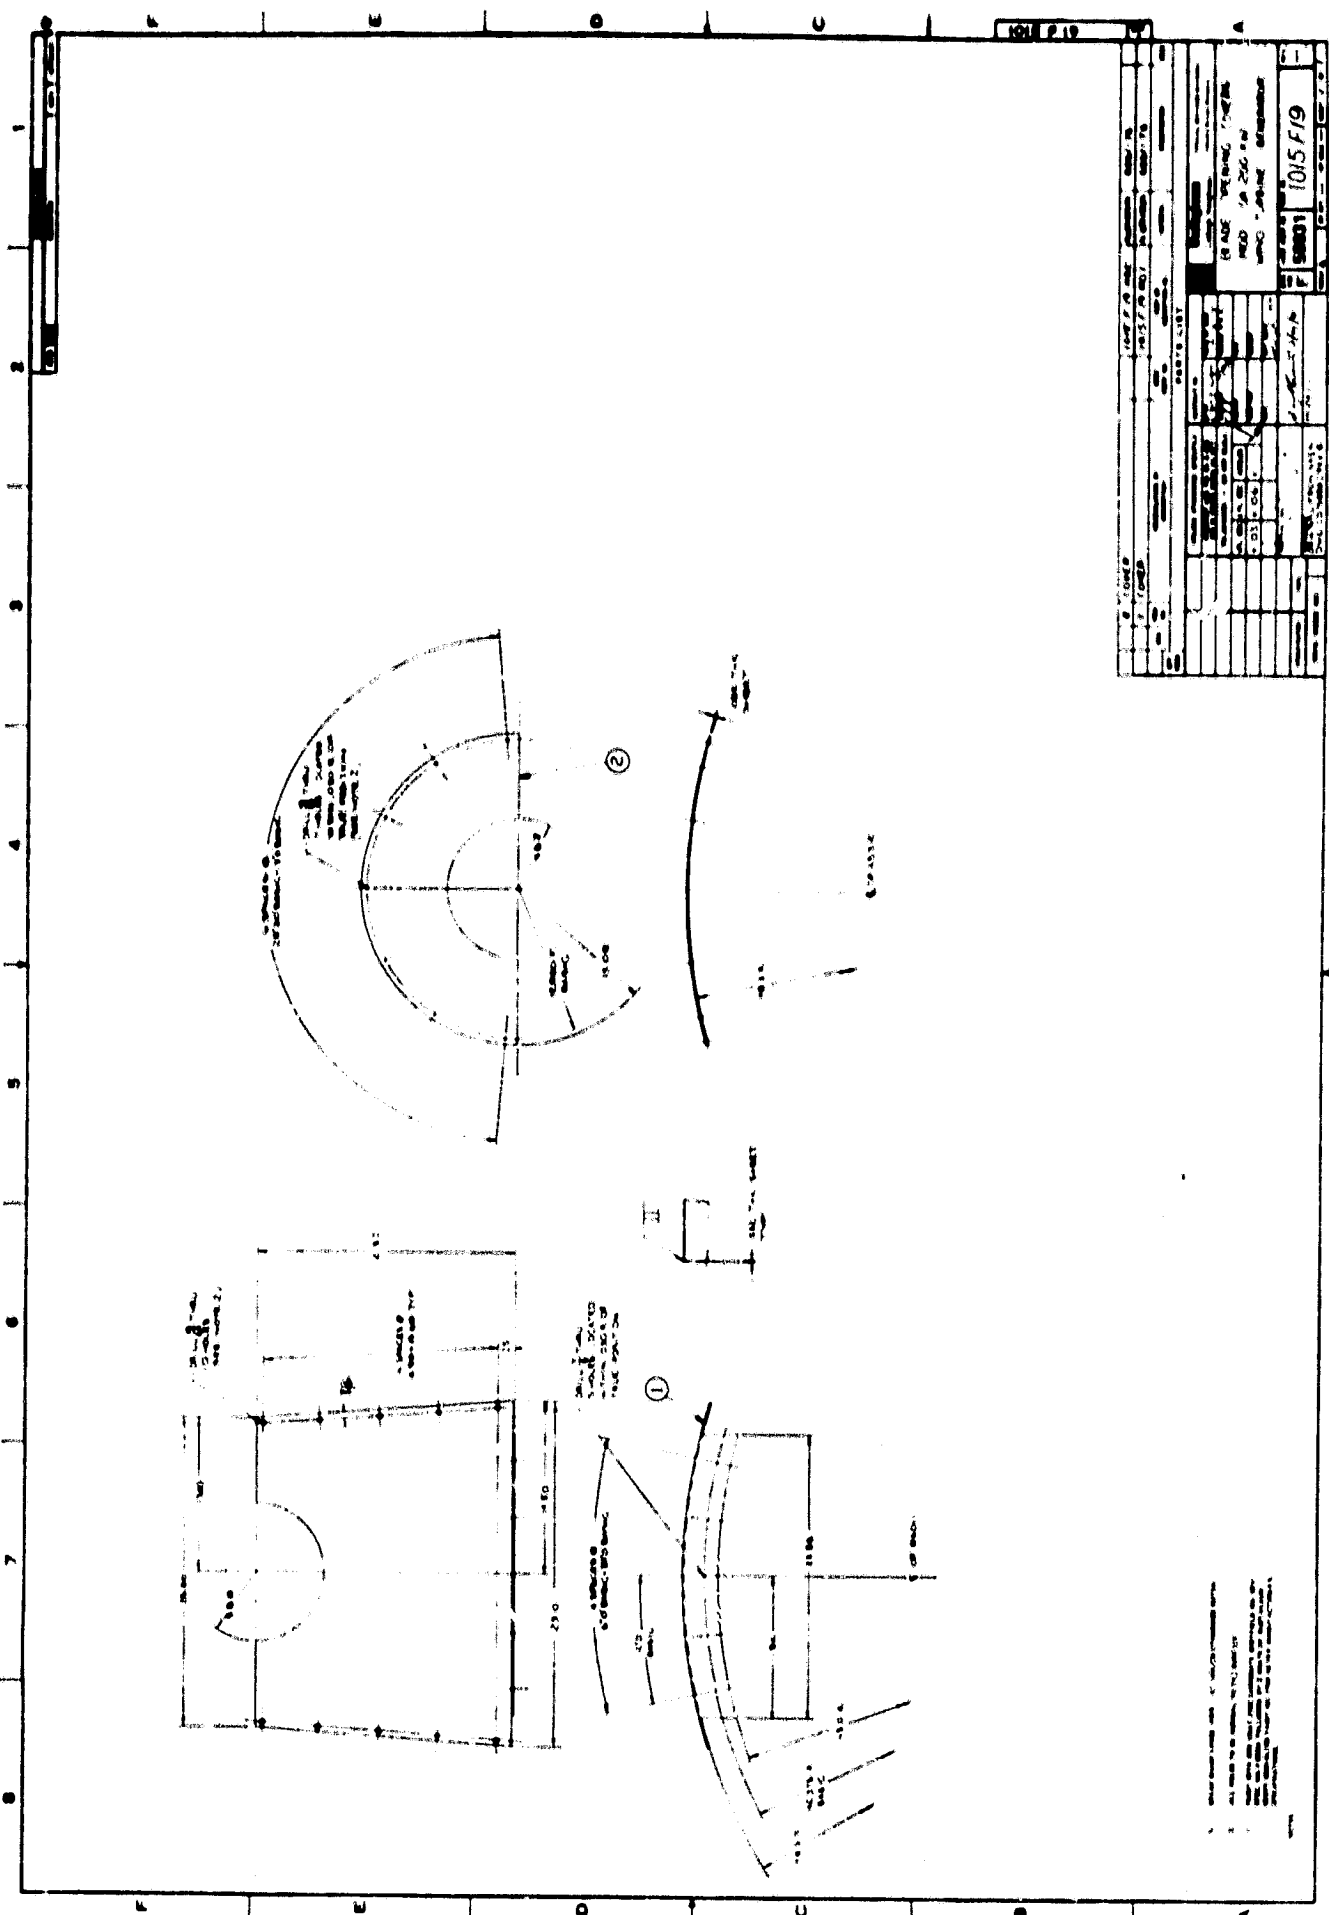




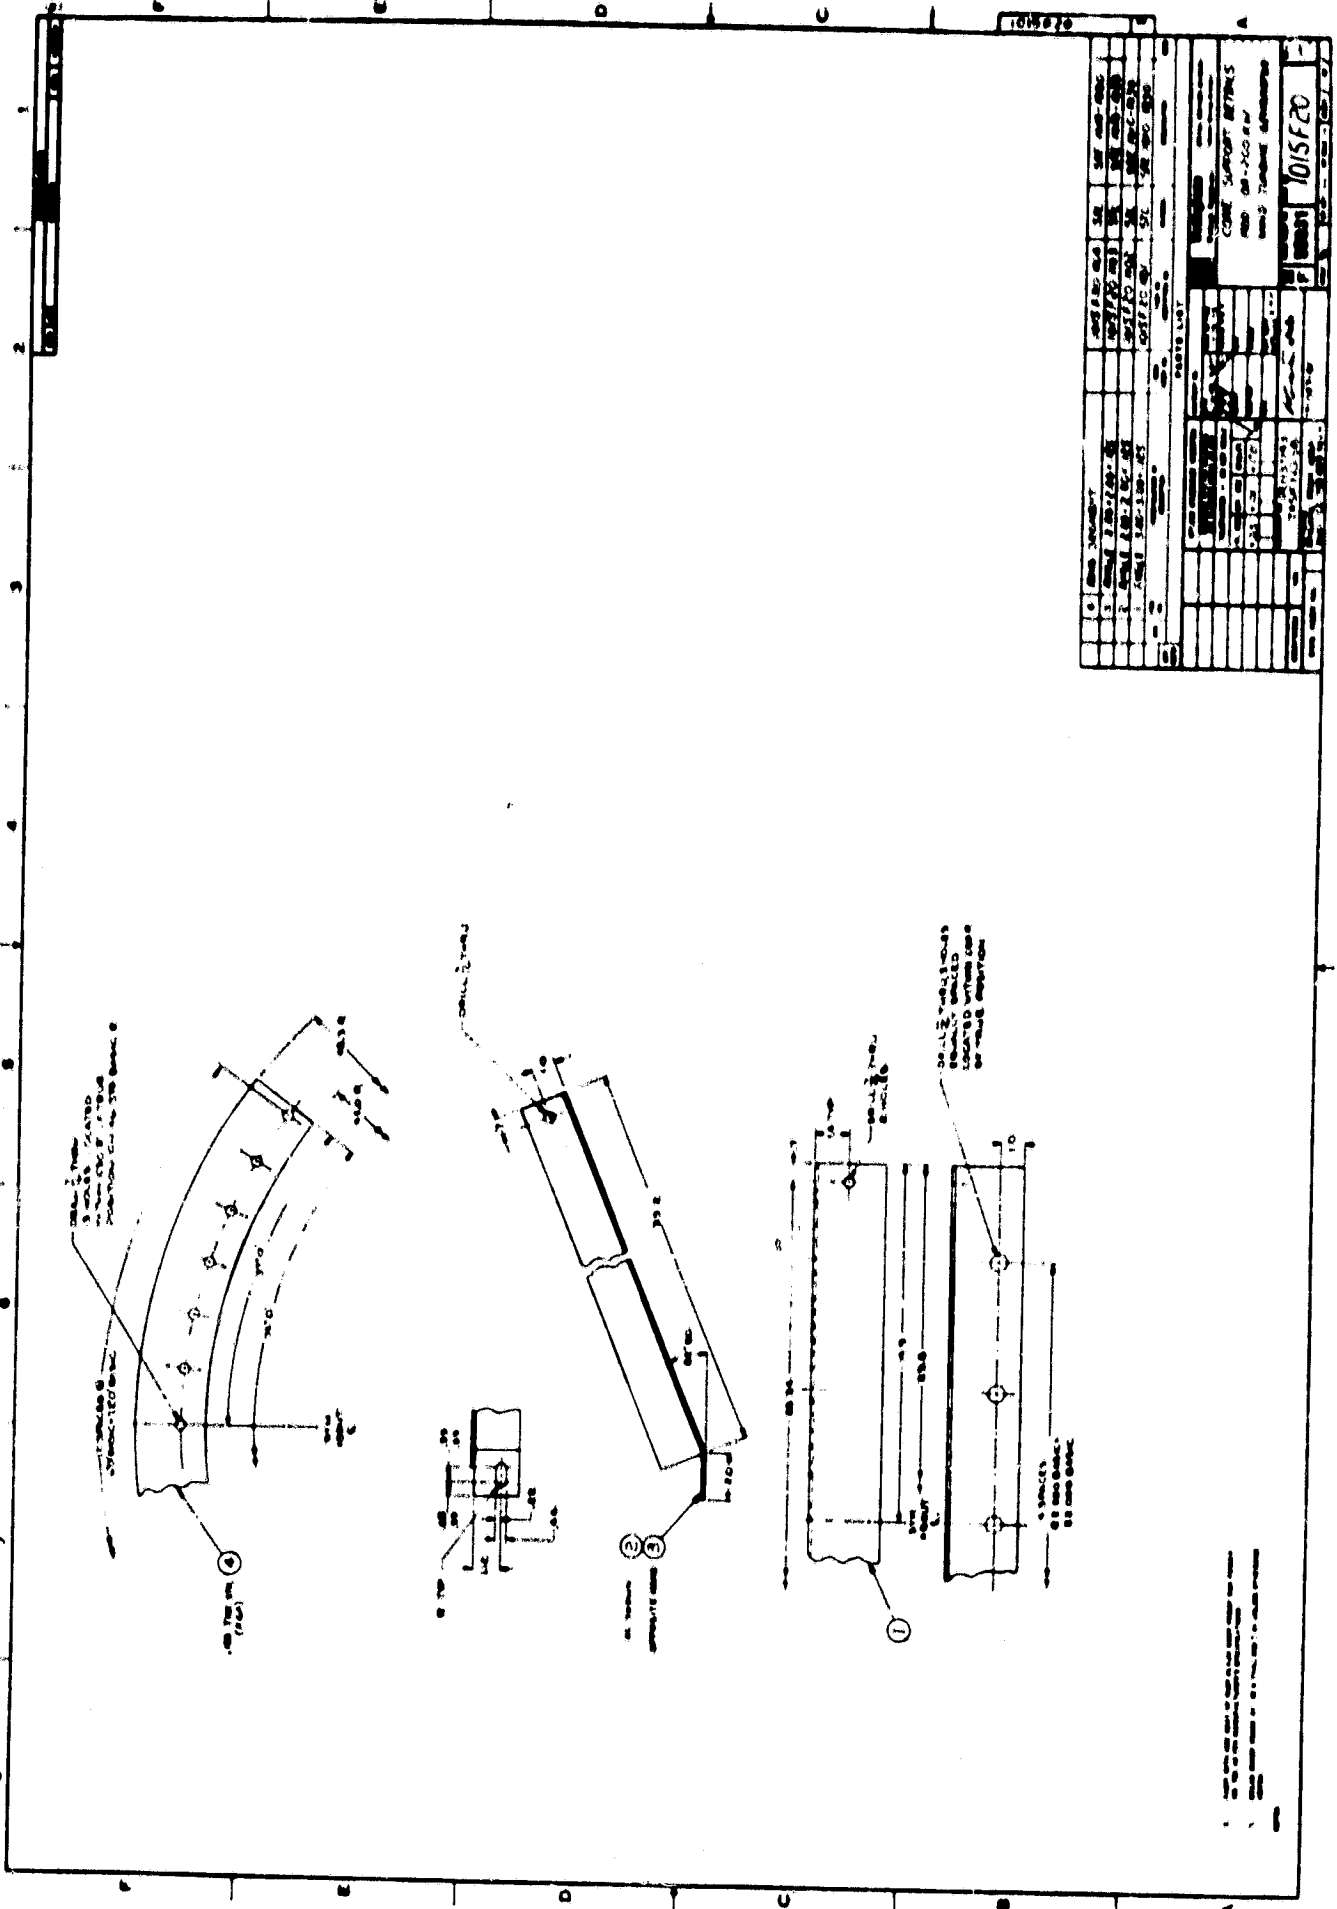


PARTS LIST	
1	...
2	...
1015 F20

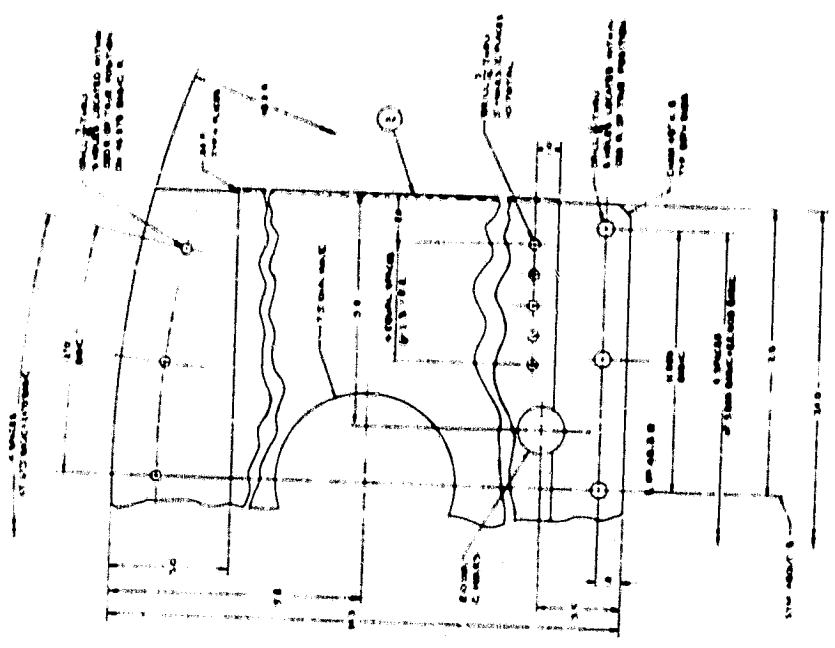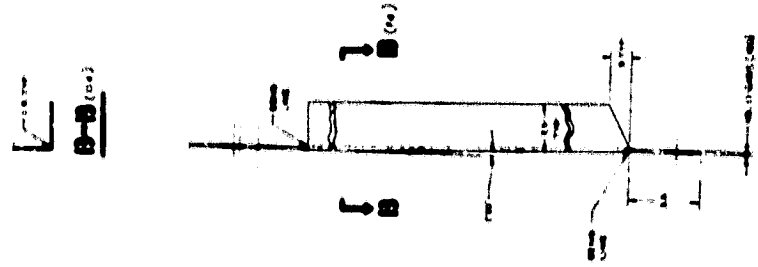


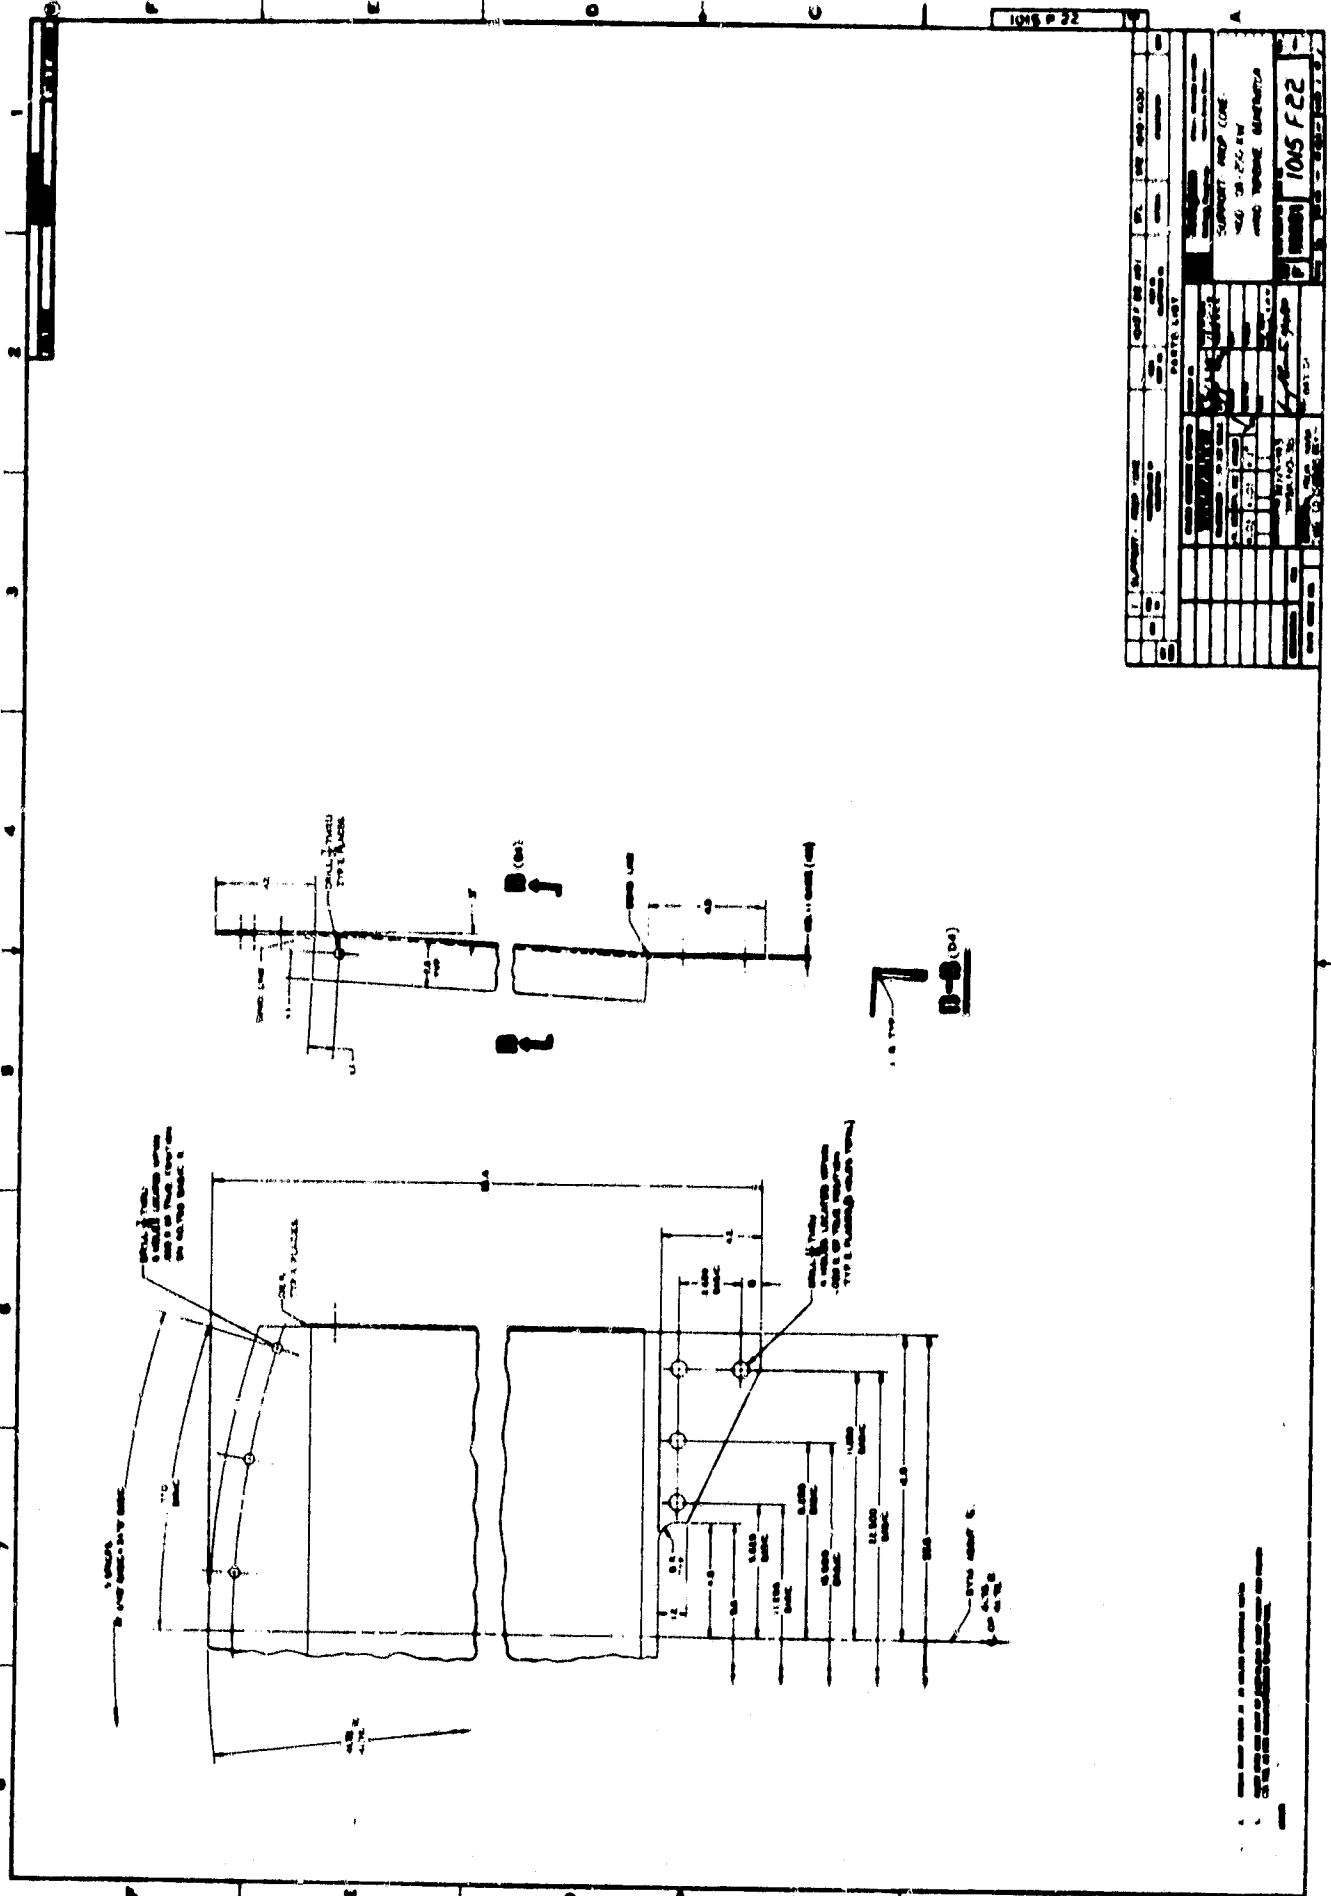


1045 F22

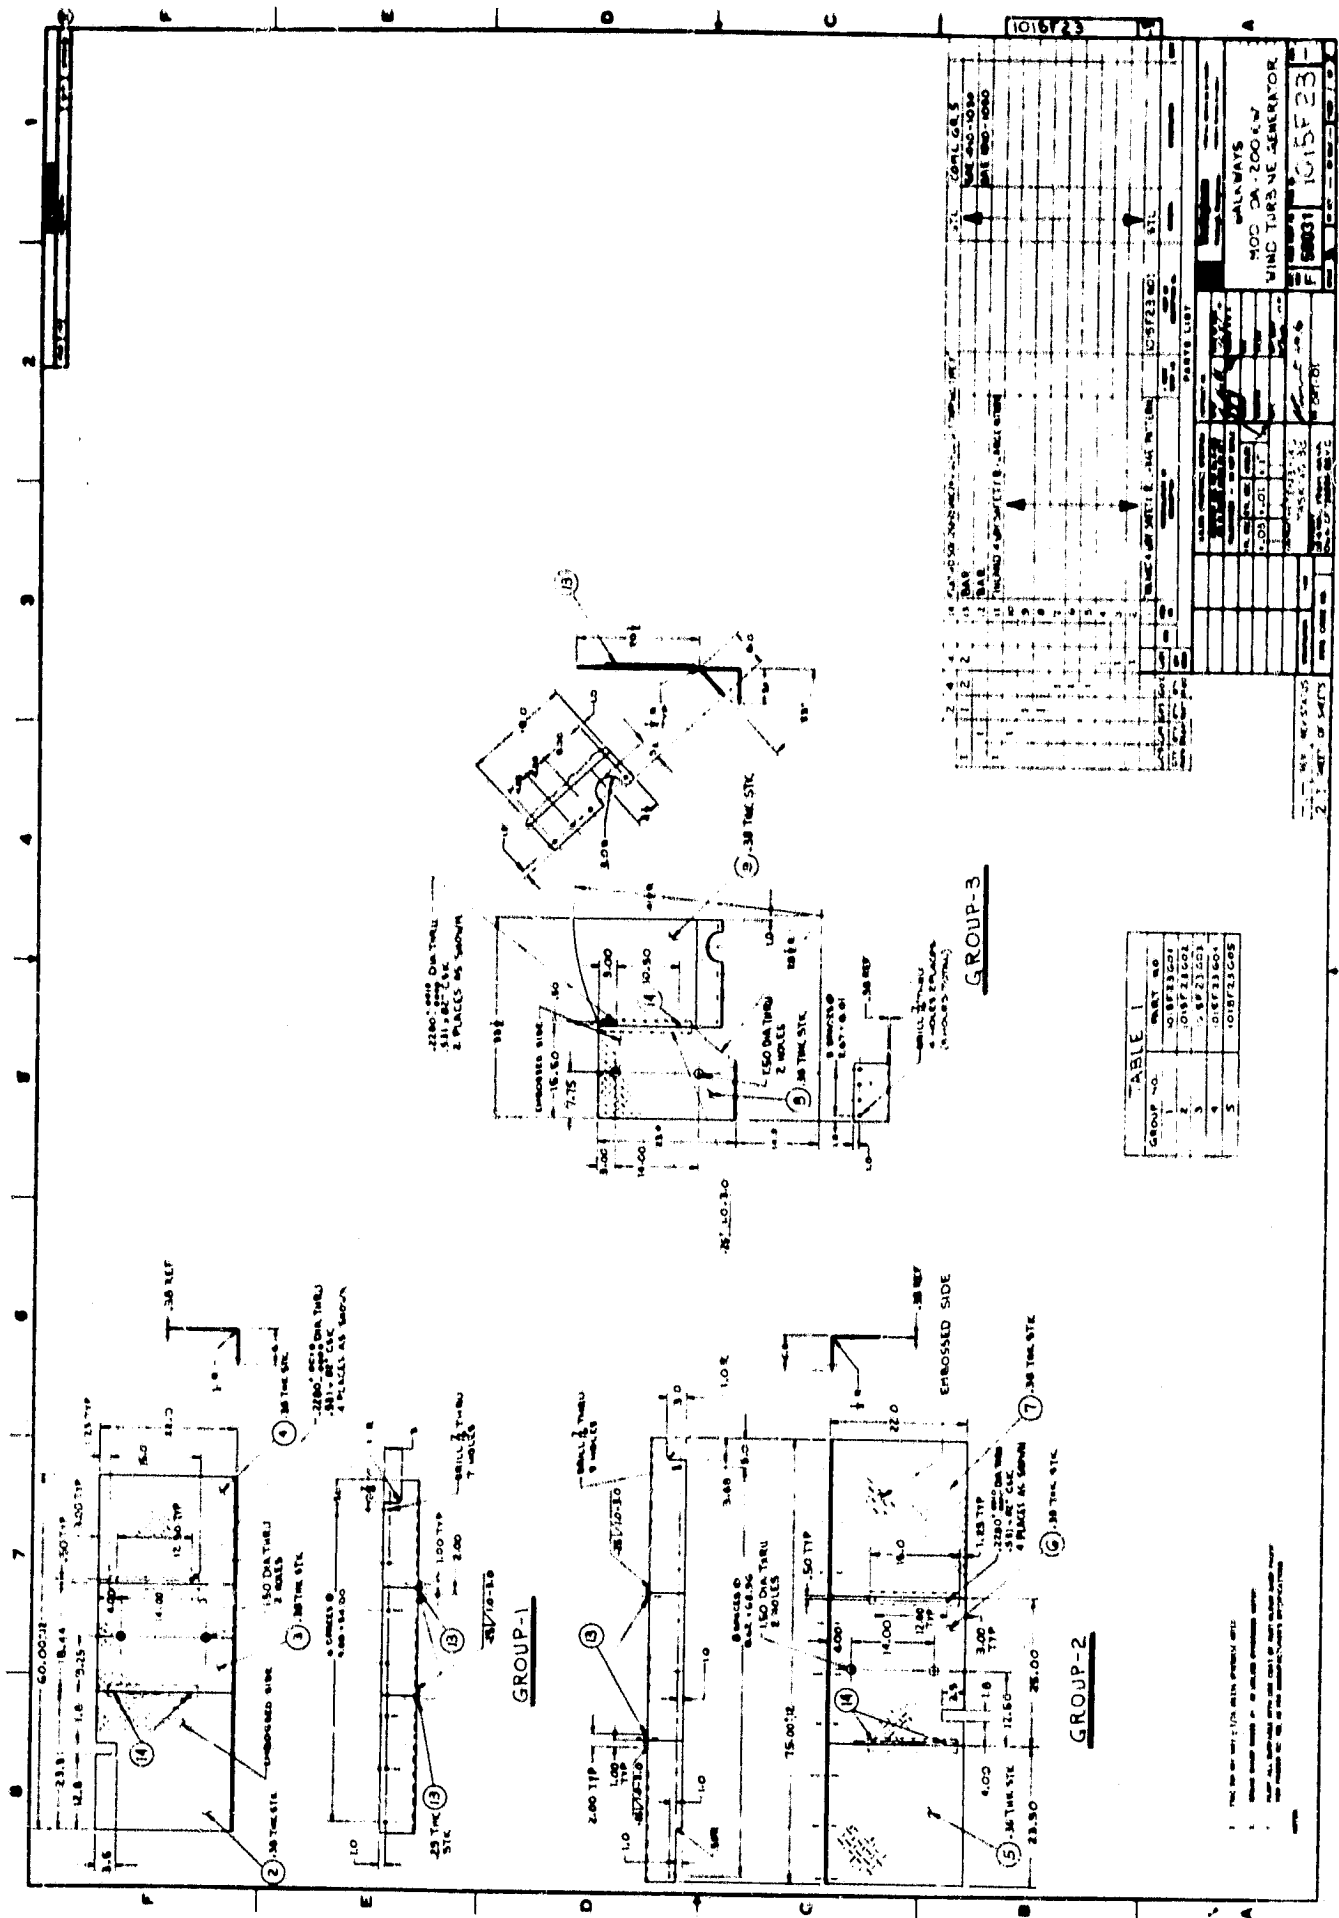



TABLE 1

GROUP NO.	PART NO.

1015F23


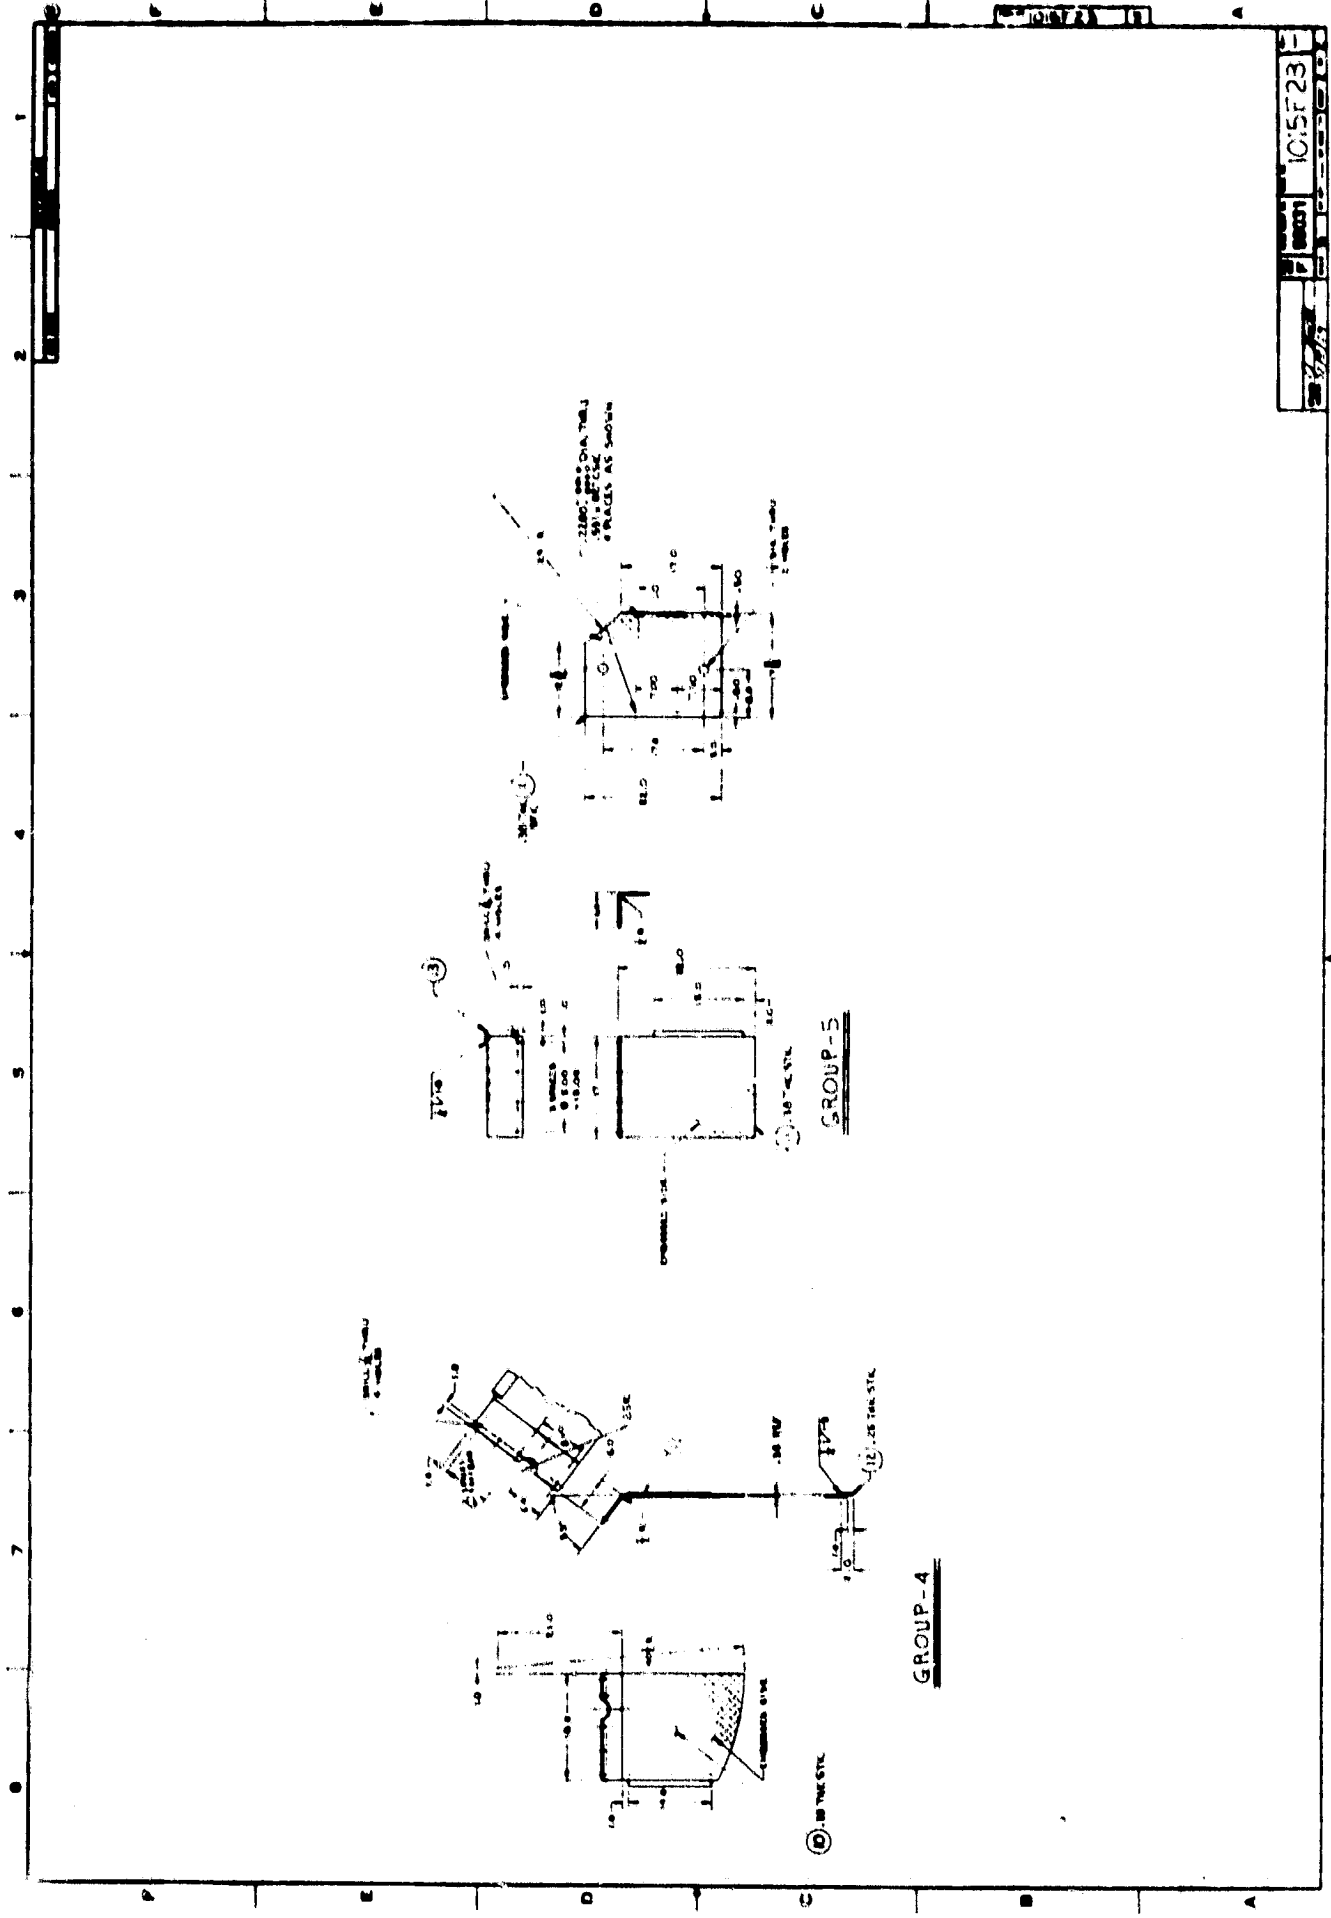

GROUP-4


10' DIA. TUBS

GROUP-5





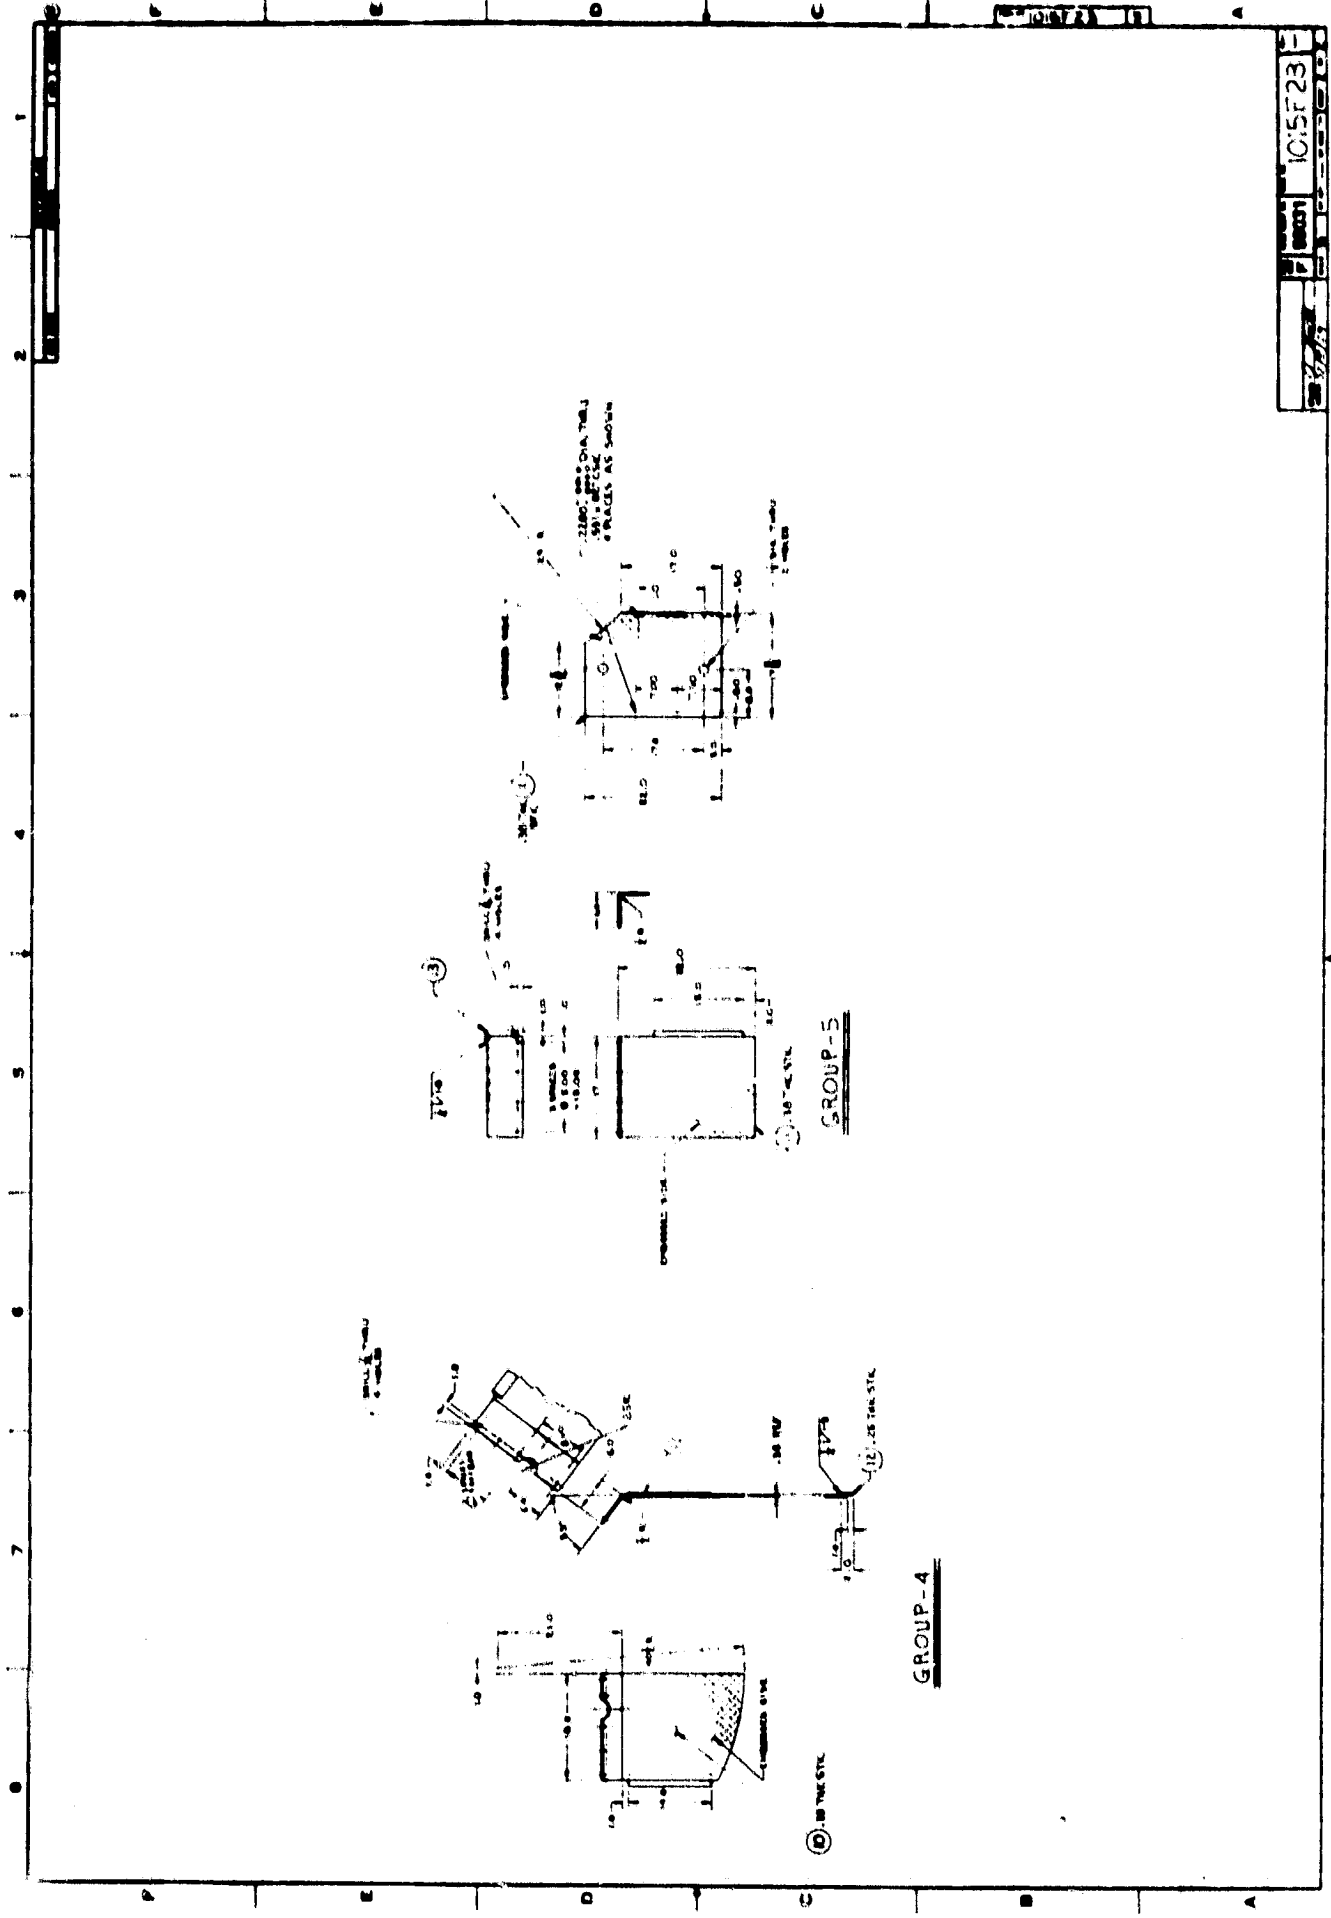

85

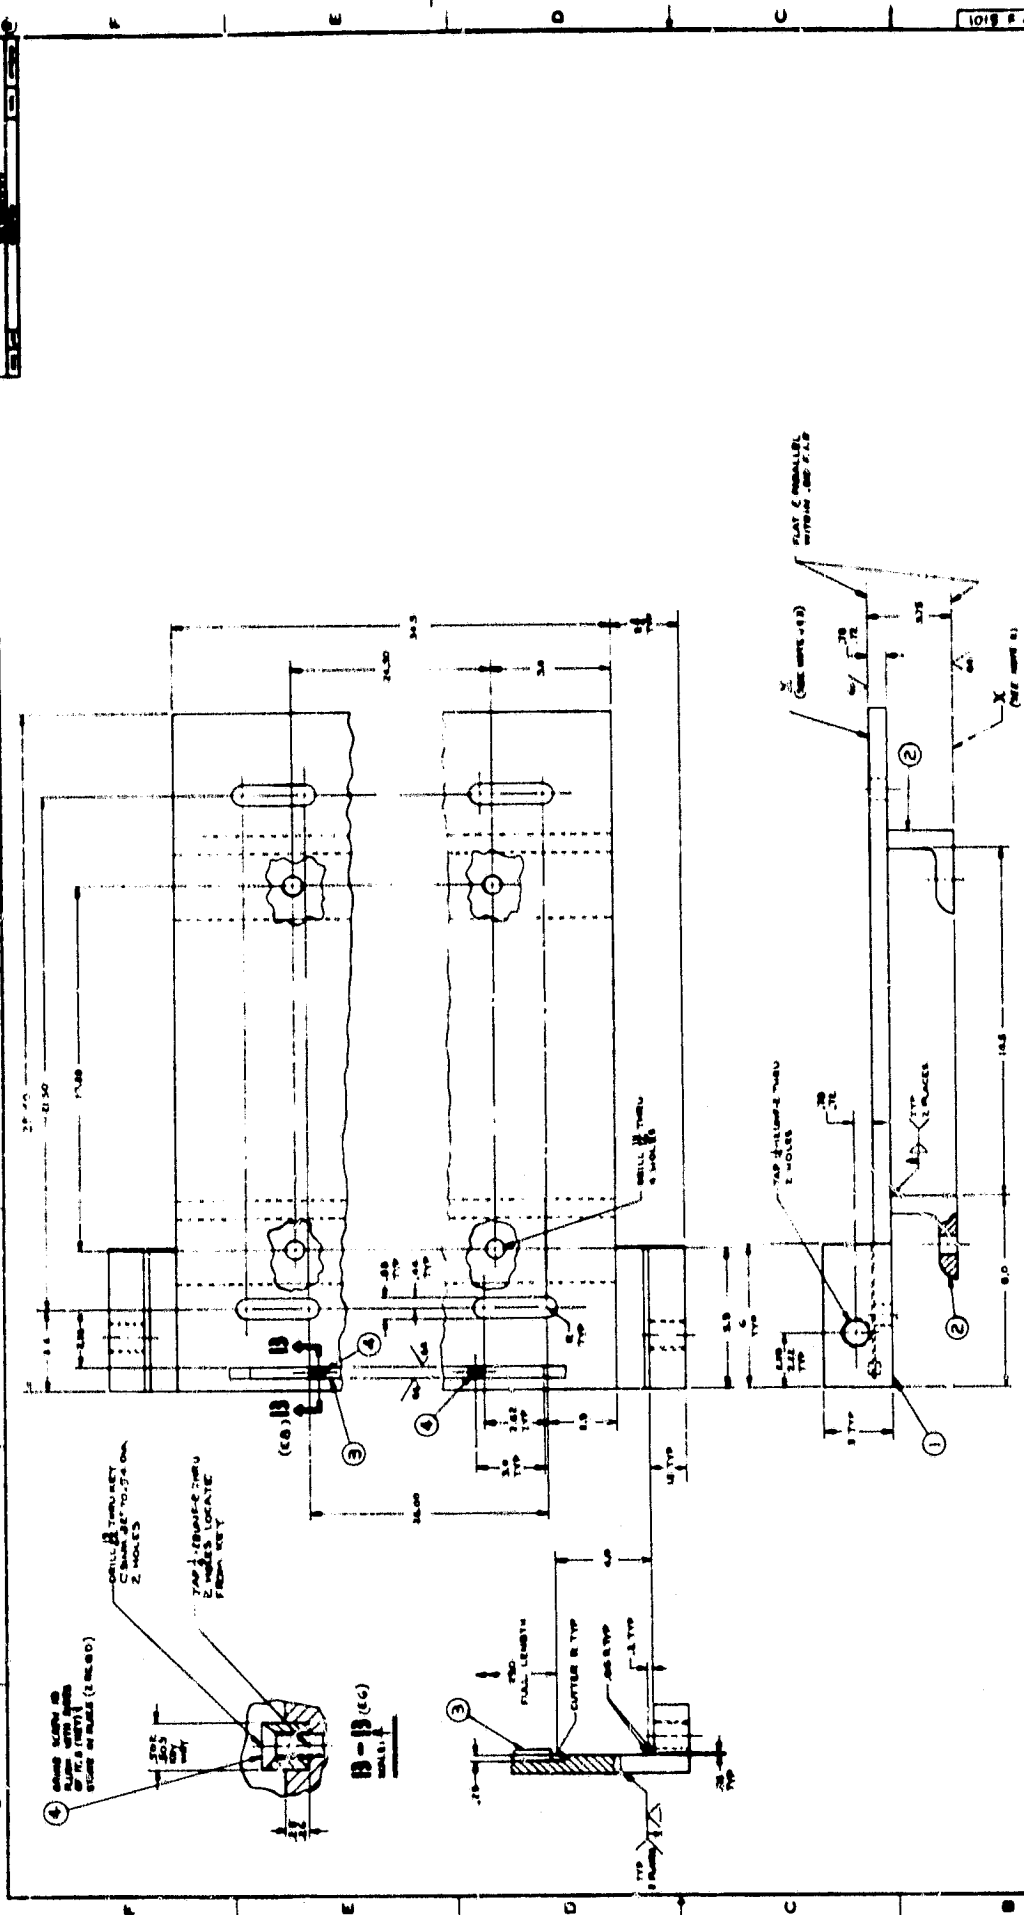

ON ALL TAP KEY
 CHANGE 20 TO 24 ON
 2 HOLES

TAP 2 HOLES THRU
 2 HOLES LOCATE
 FROM KEY

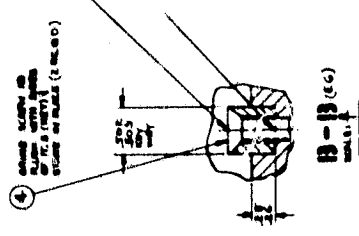


TABLE 1

GROUP NO.	PART NO.	QTY
1	01574201	


PARTS LIST


1	1015 F 24
2	1015 F 24

1015 F 24


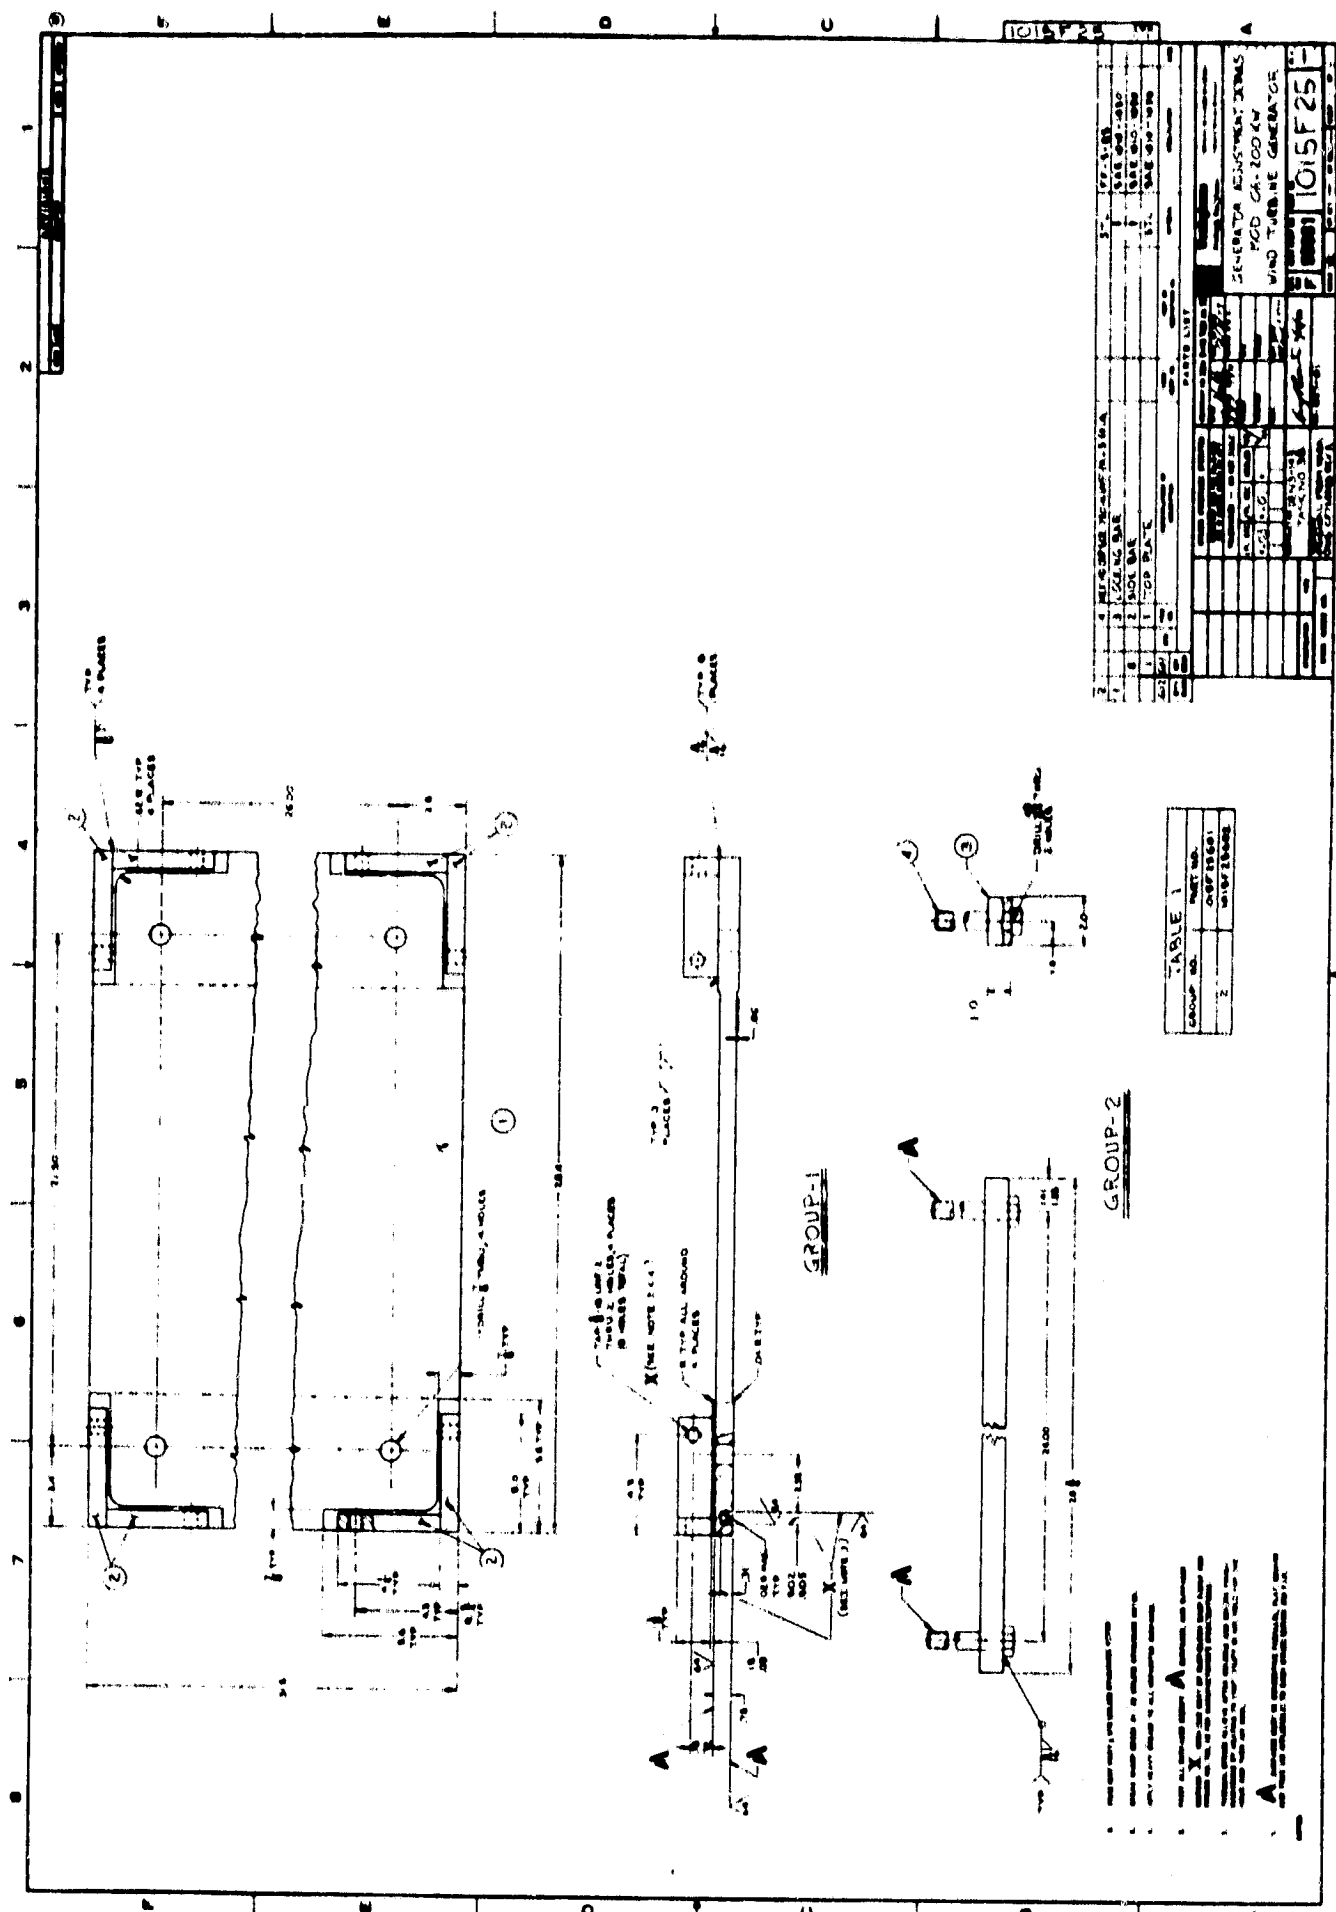

1015F25

PARTS LIST	
3	TOP PLATE
4	...
5	...
TABLE 1

GROUP NO.	PART NO.	DEFINITION	UNITS/PLACES
1			
2			

GROUP-2

1015F25

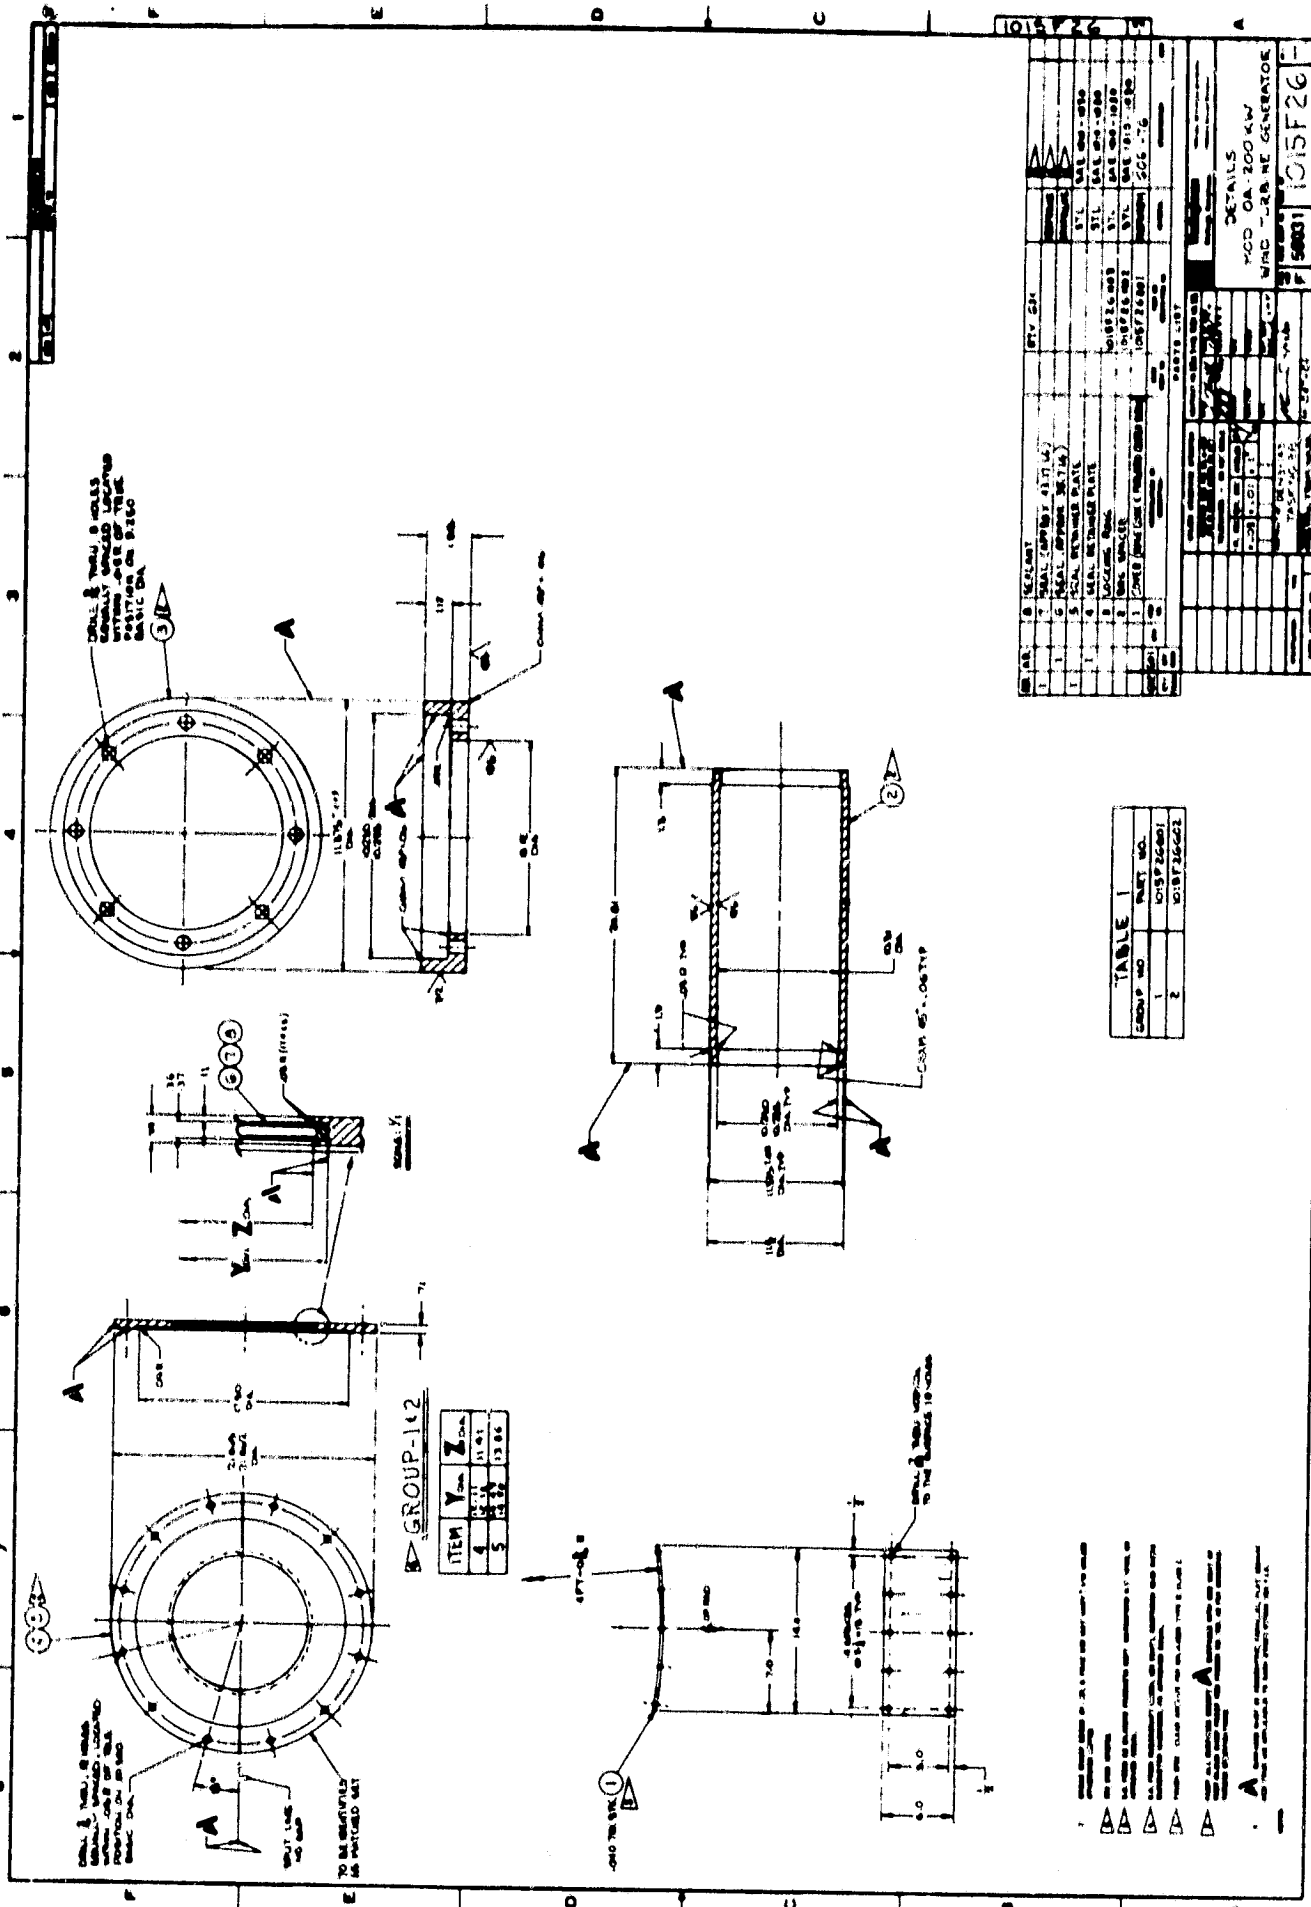

NO	QTY	DESCRIPTION	UNIT	REMARKS
1	1	SEALANT	BTU GA	
2	1	SEAL (MOUNT 4714)		
3	1	SEAL (MOUNT 4714)		
TABLE 1

GROUP NO	PART NO.
1	1015F26001
2	1015F26002




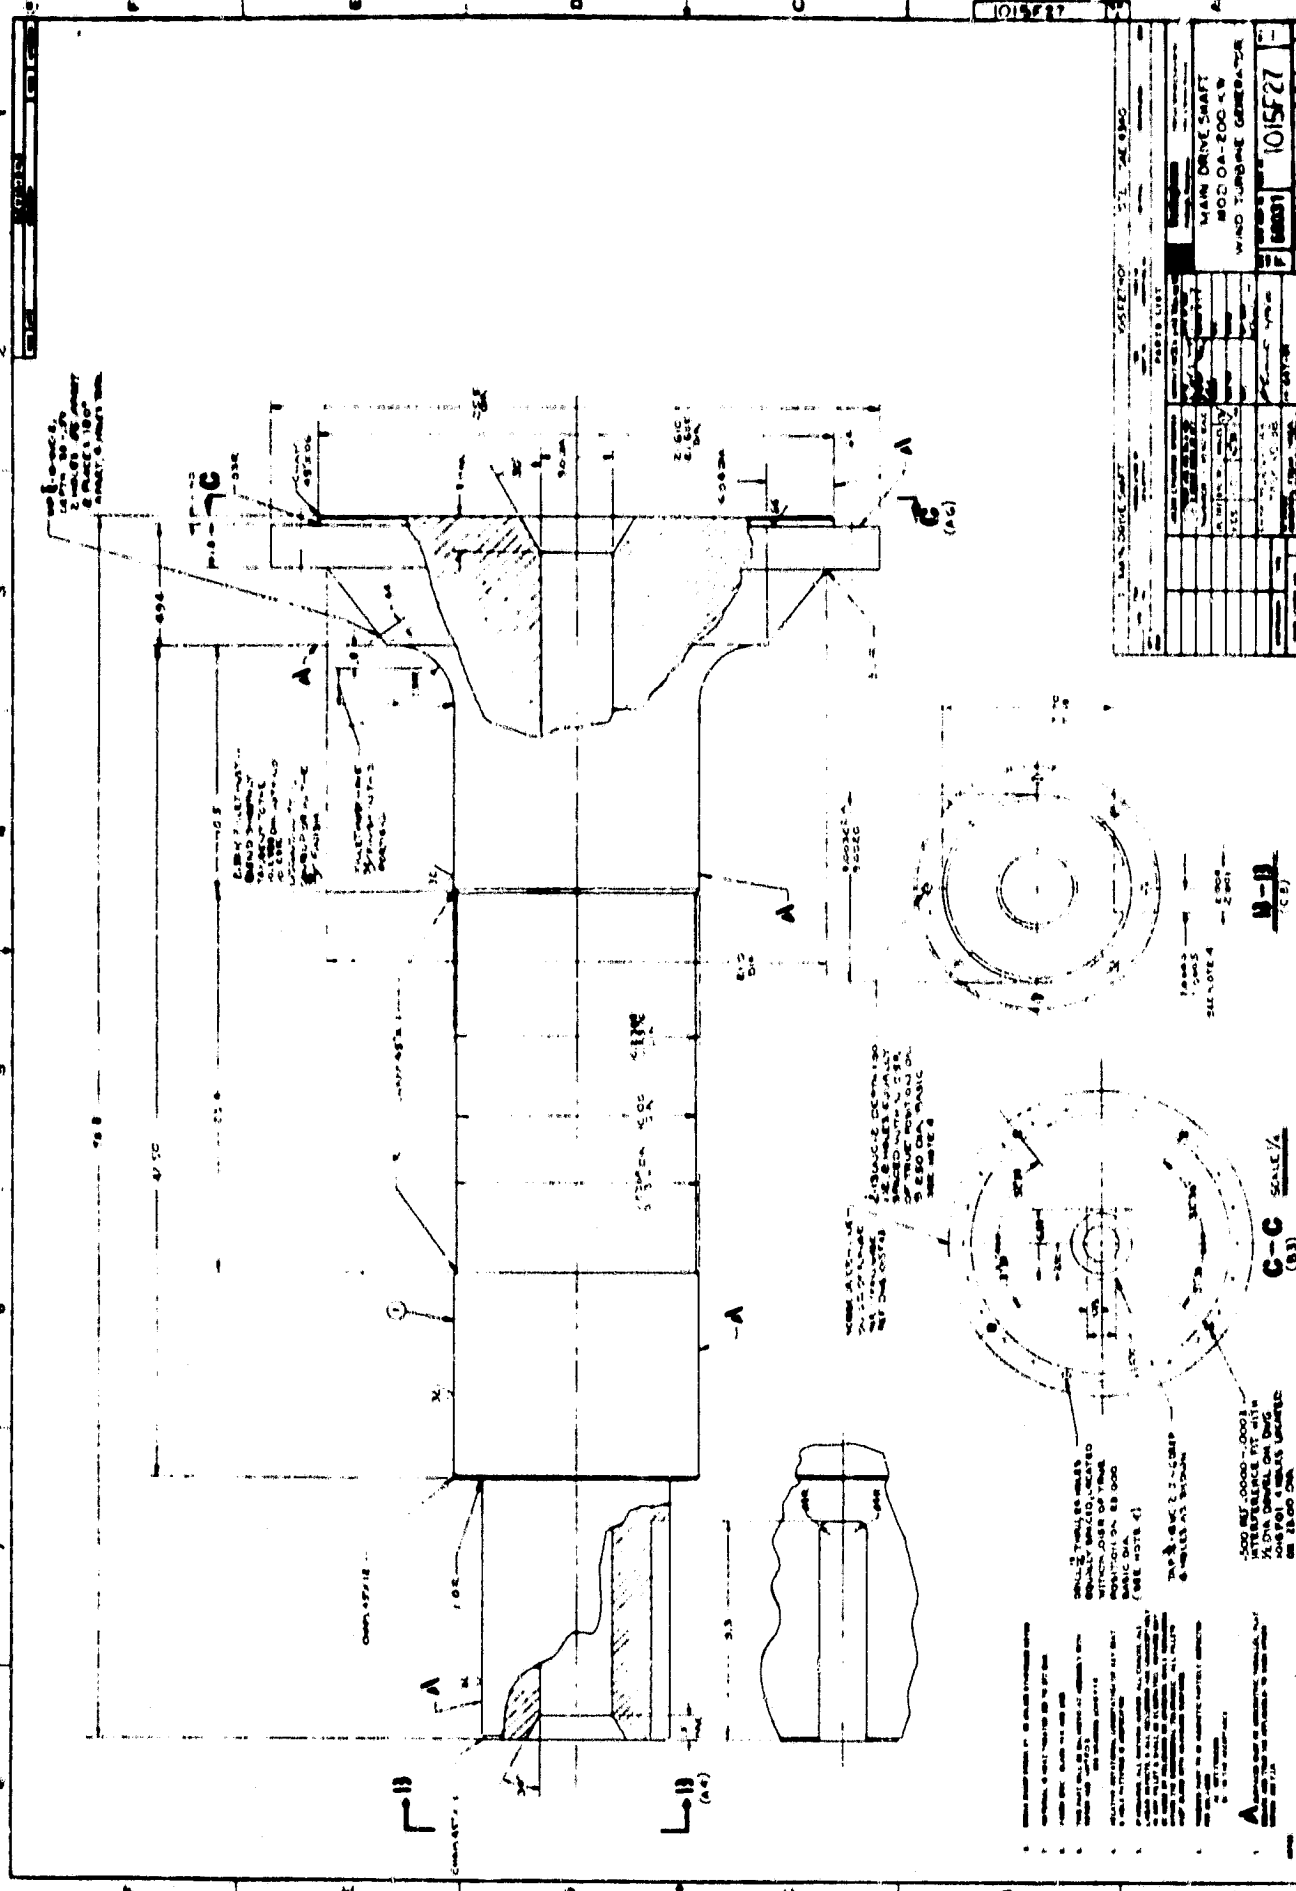


SYSTEM NO. LAL-1390

PARTS LIST

QTY	DESCRIPTION	REF. NO.	UNIT

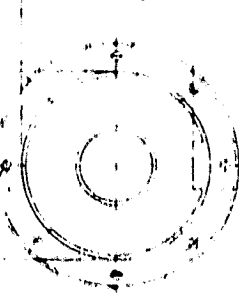


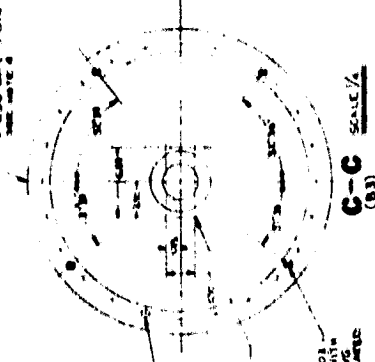

C-C

2.0000 DIA. KEYWAY



A-A

B-B

A

1015 F 28

4	FOOT	SYL	SYL 000-010
3	BASE		
2	BASE		
1	FL		
0	FL		
PARTS LIST			
SEAKE SUPPORT			
MOD OA - 200 KW			
WIND TURBINE GENERATOR			
P 58031 1015 F 28			


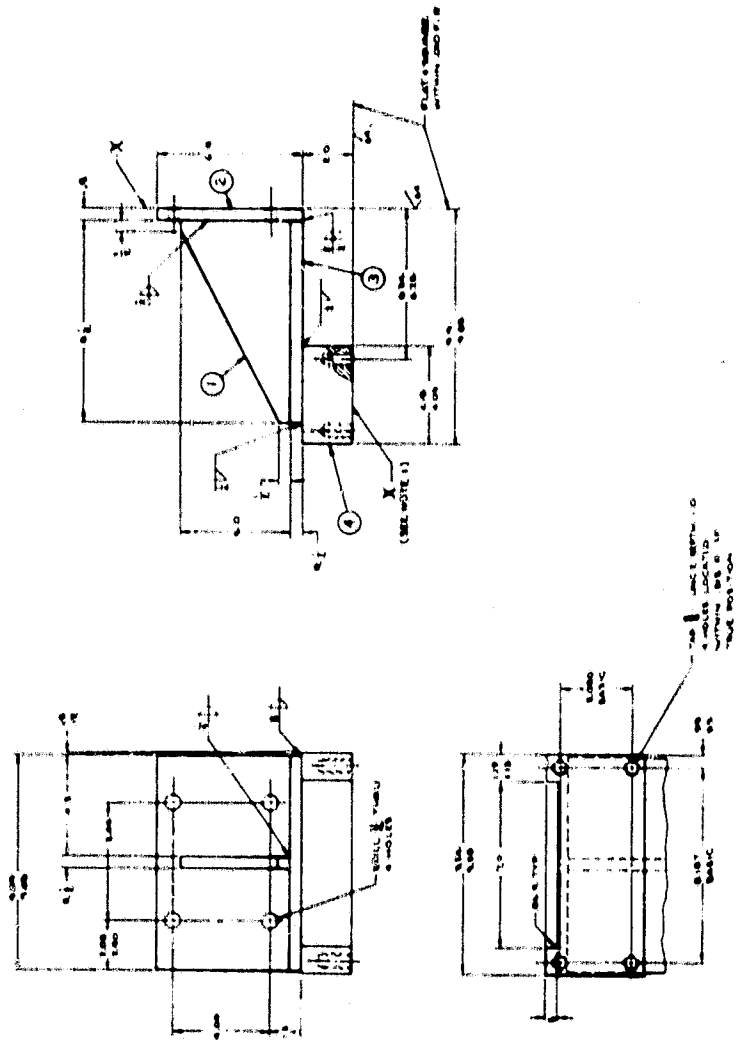



TABLE	REV NO
GROUP NO	051820

1. ALL DIMENSIONS ARE IN INCHES UNLESS OTHERWISE SPECIFIED

2. ALL DIMENSIONS ARE TO CENTER UNLESS OTHERWISE SPECIFIED

3. ALL DIMENSIONS ARE TO CENTER UNLESS OTHERWISE SPECIFIED

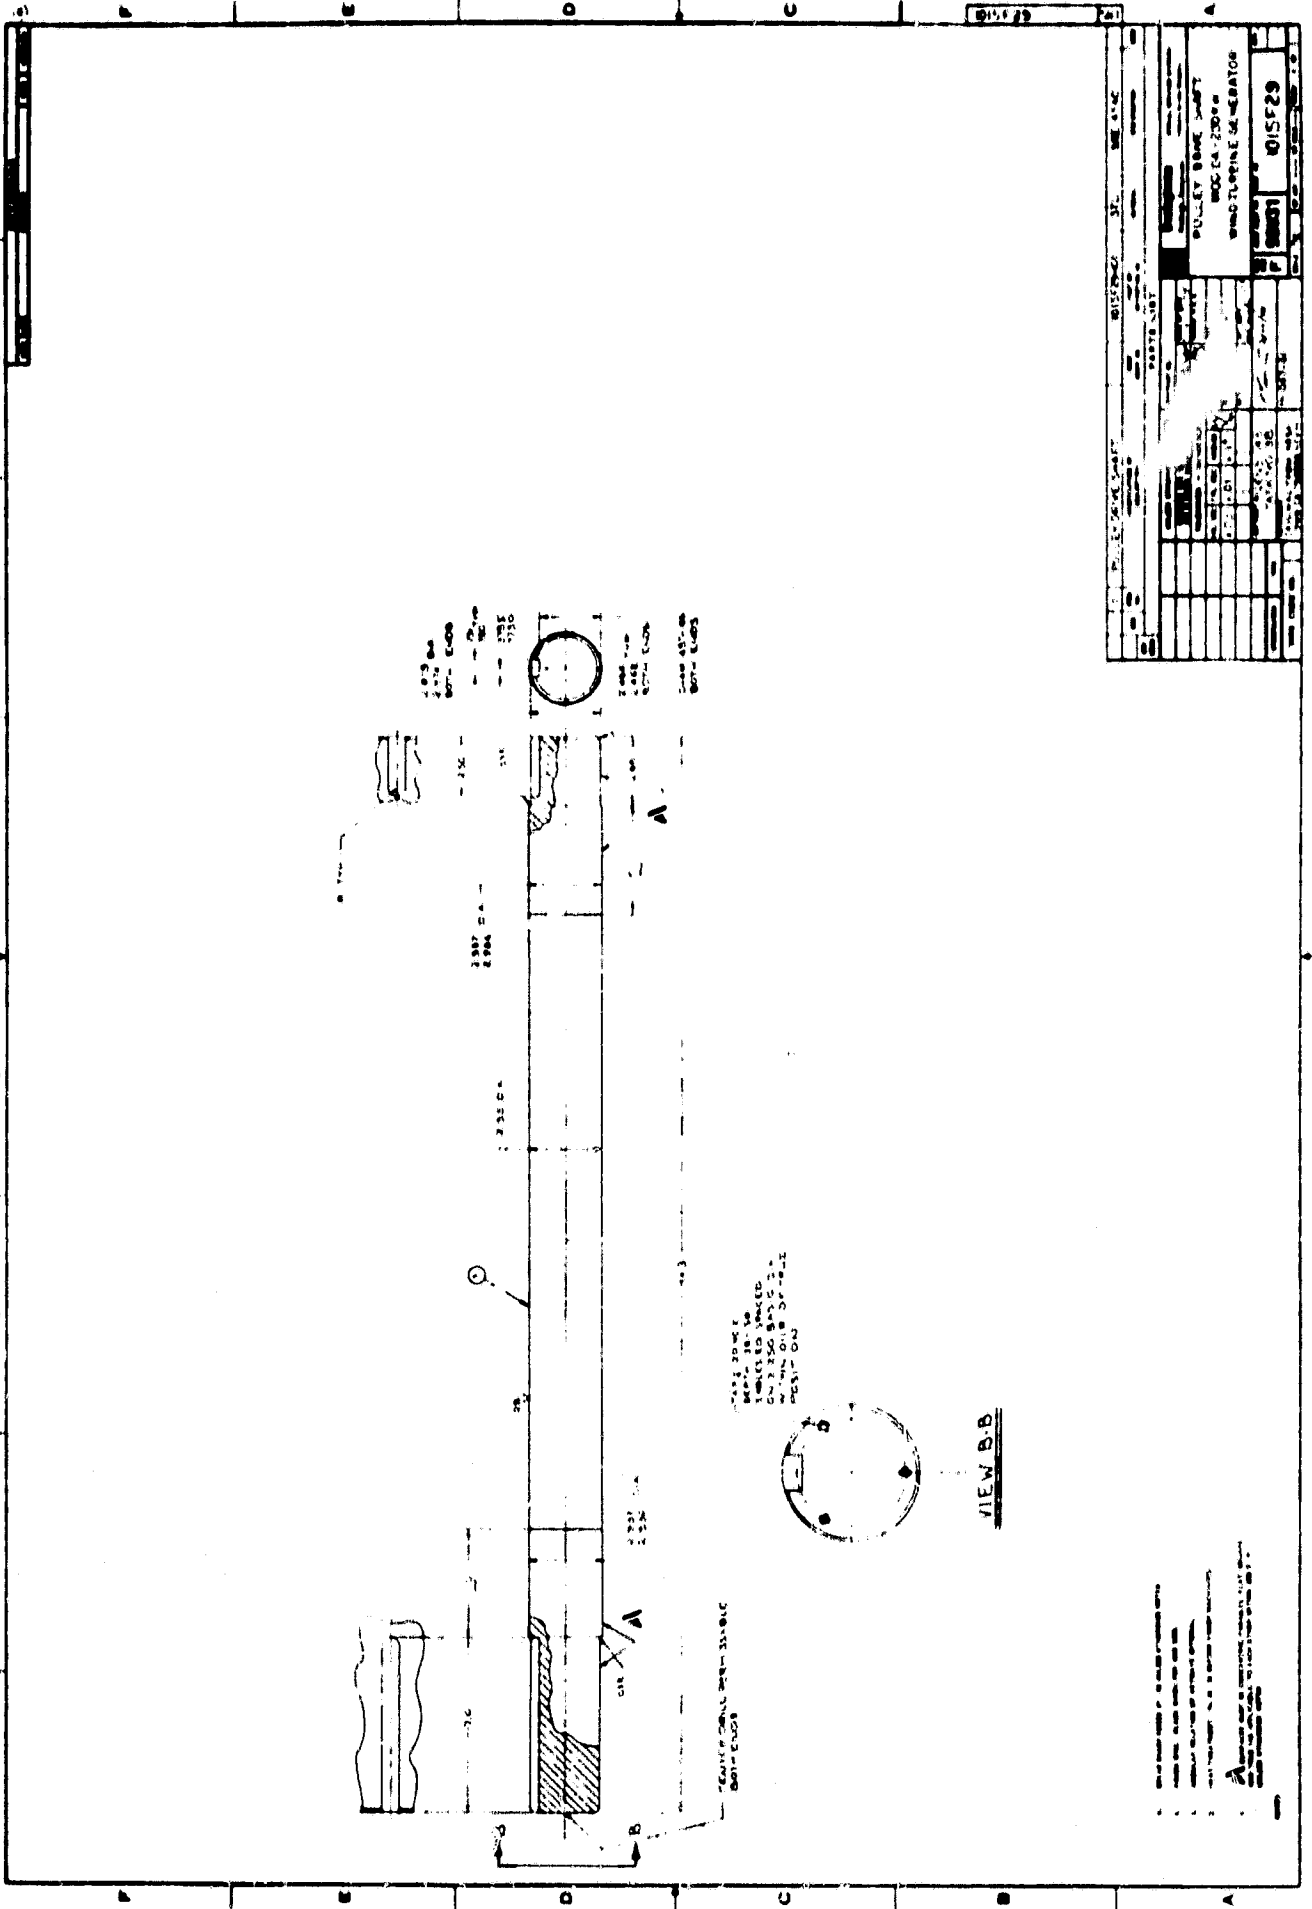

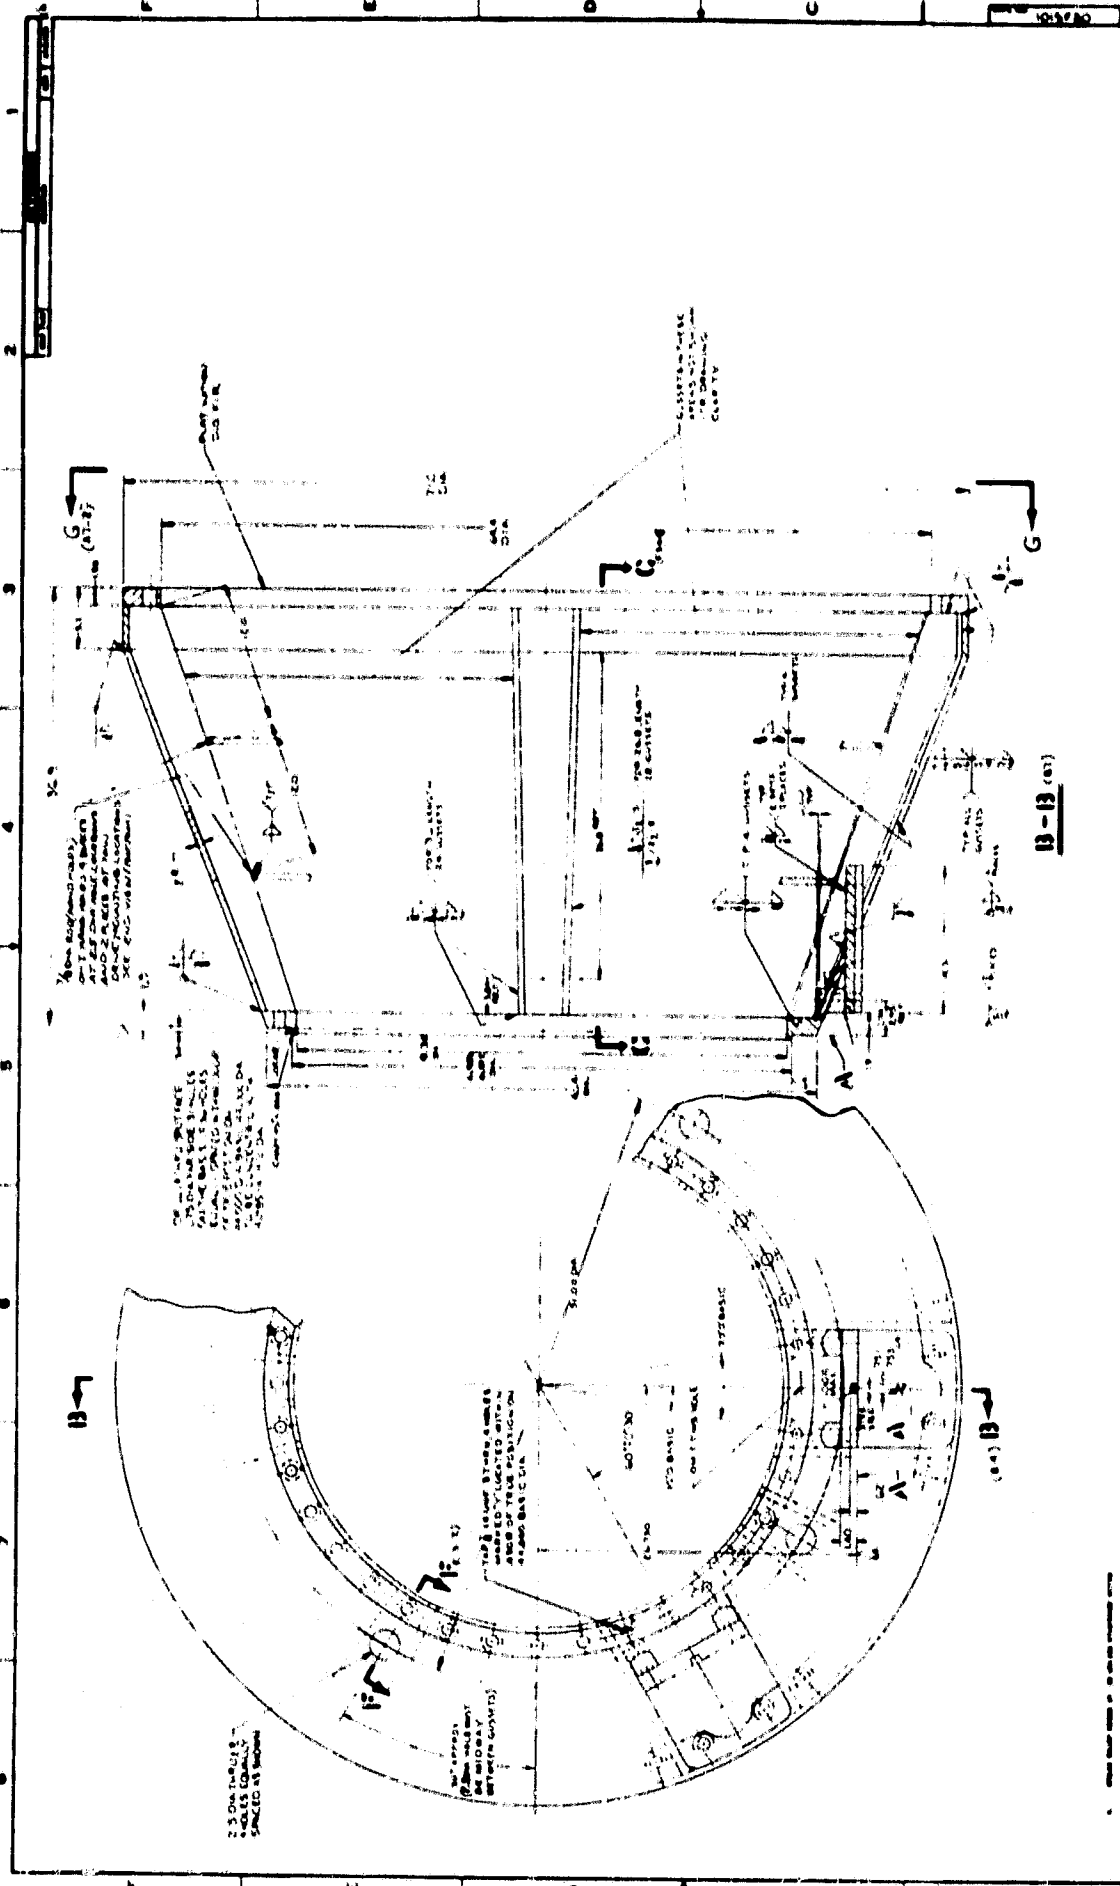

WATER TIGHT BEARING SUPPORT STEEL 316 SS 1015 F30











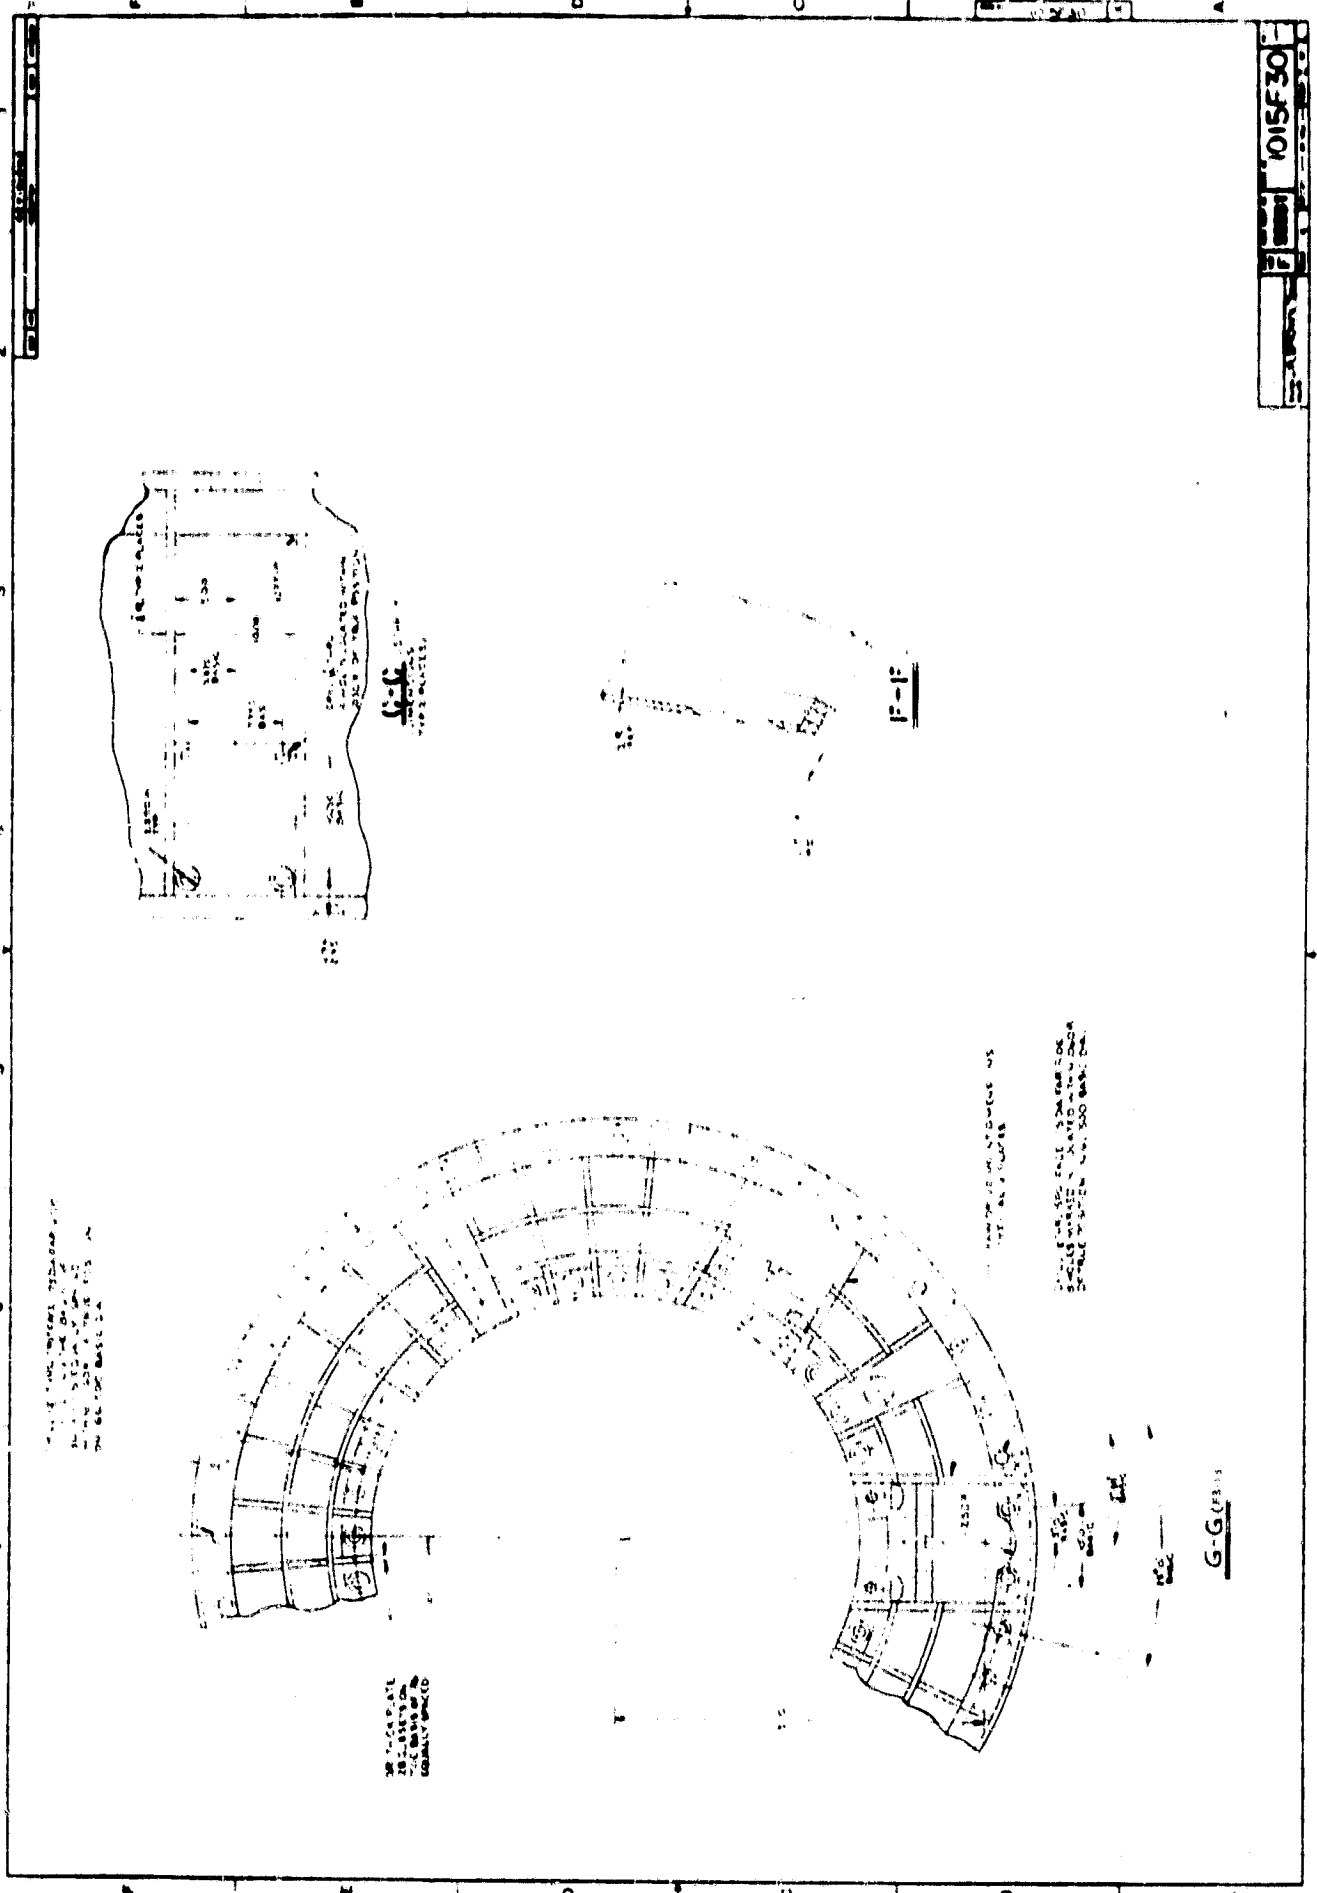

015F30

G-G

16

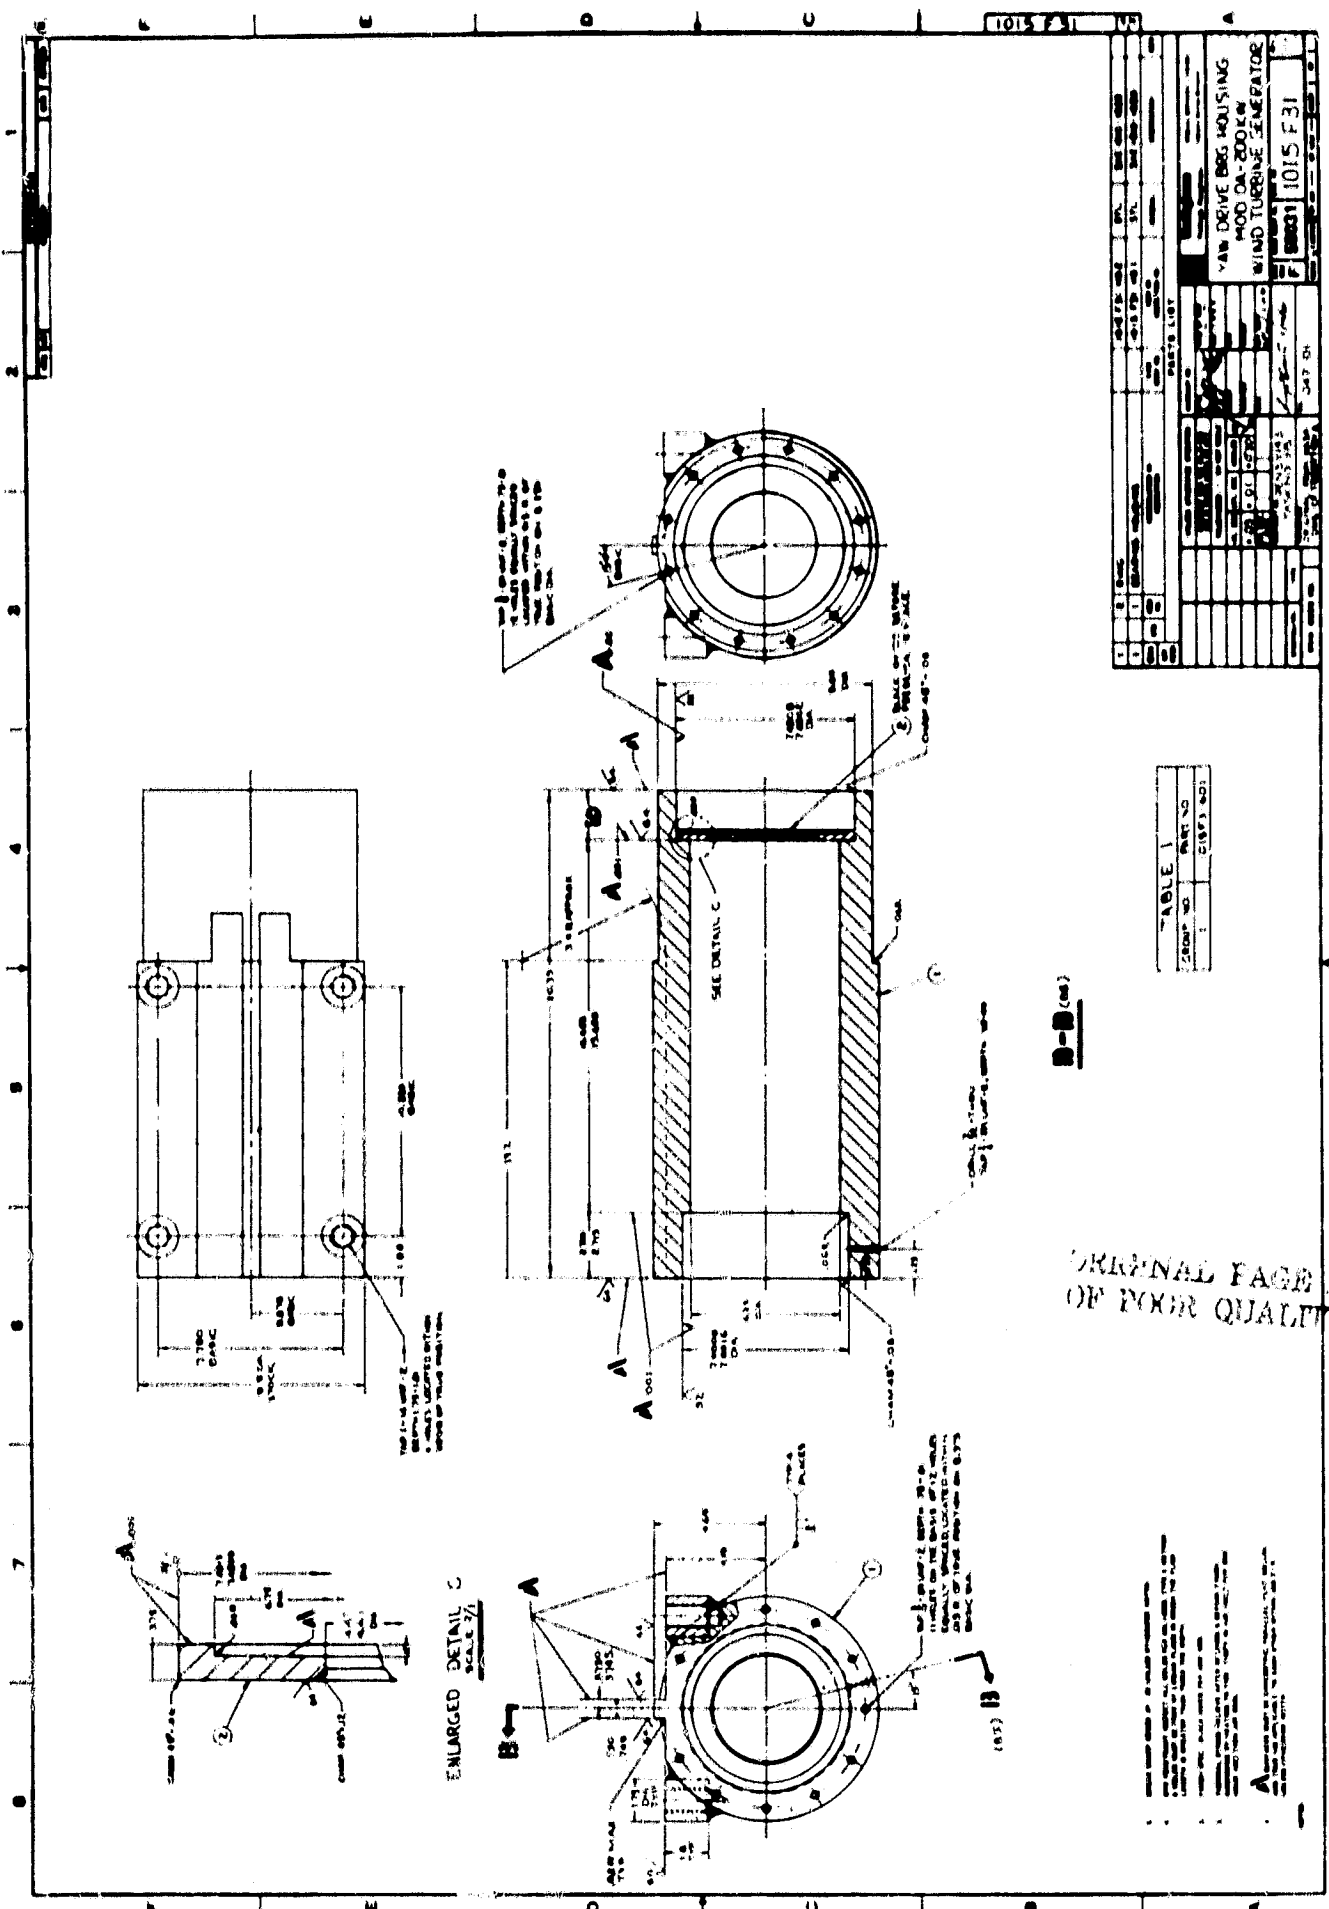

1015 F31

TABLE I

YAW DRIVE HOUSING HOOD ON 200KW WIND TURBINE GENERATOR

1015 F31


















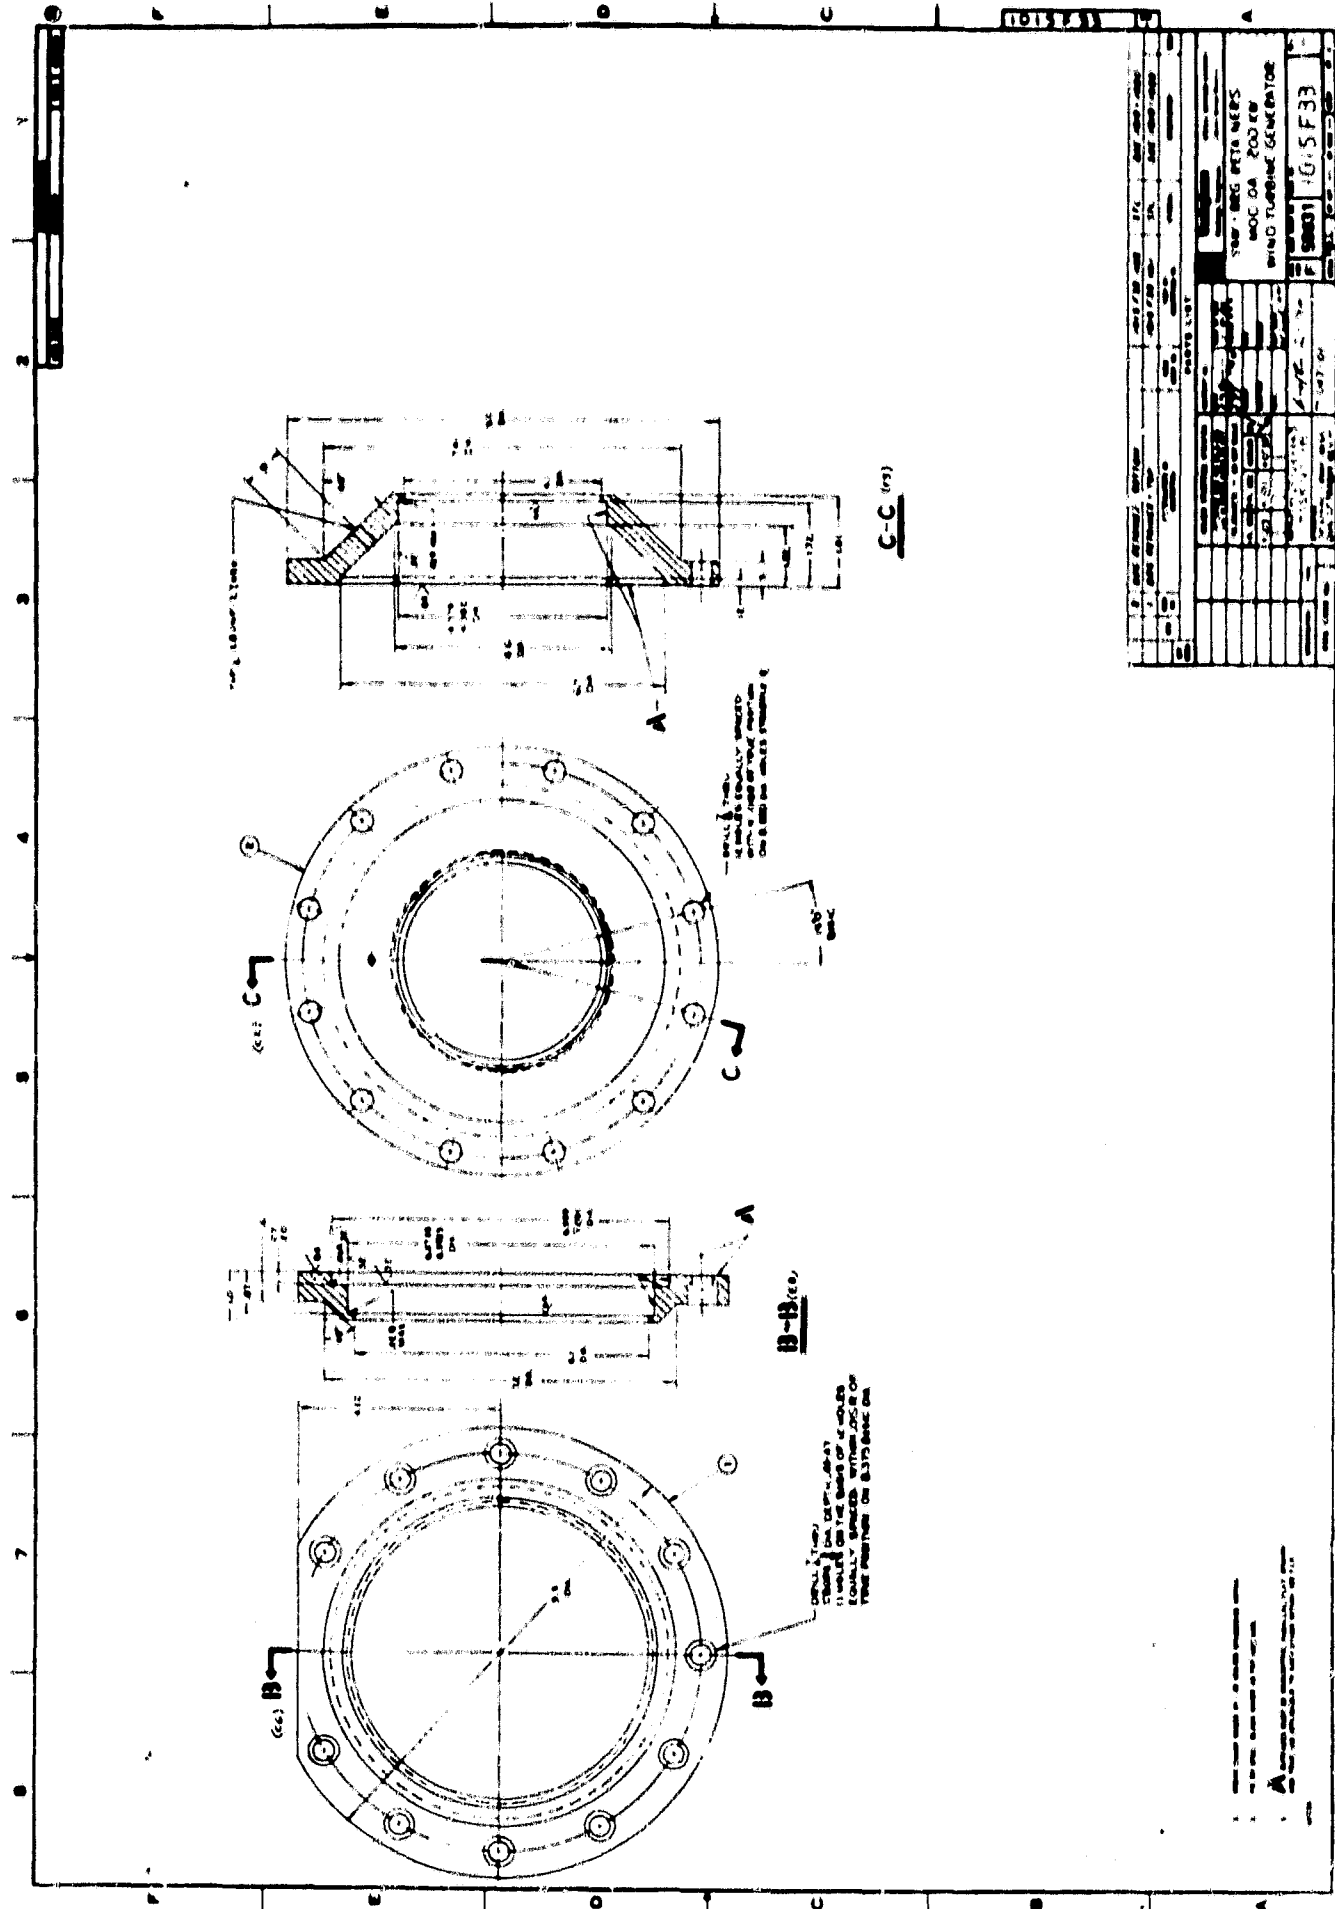


TOP VIEW
SECTION B-B
SECTION C-C




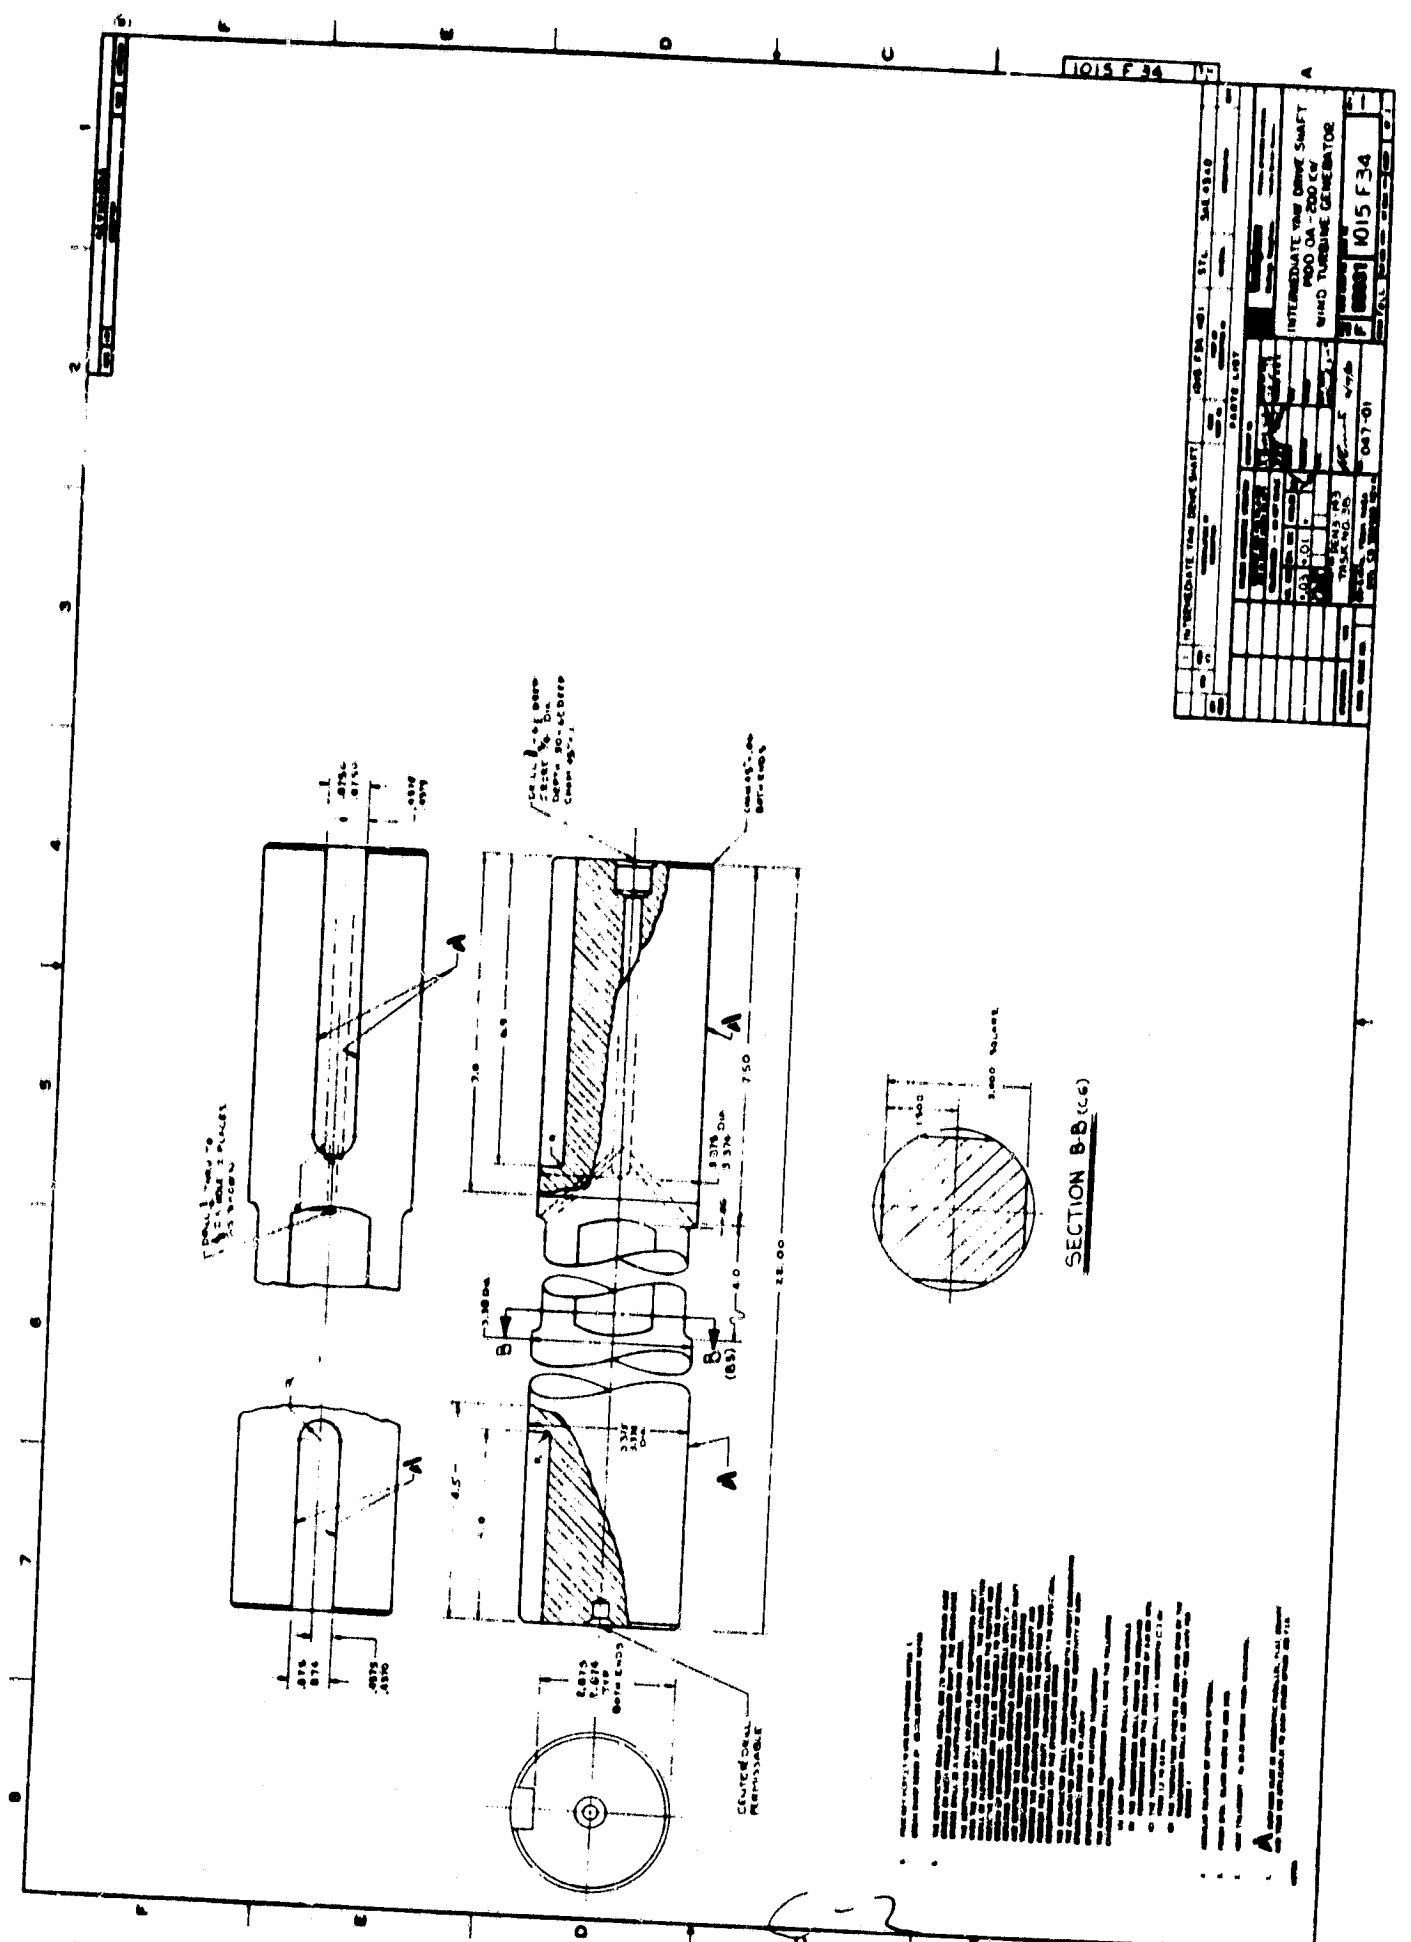

SECTION B-B (CG)

1015 F 34

INTERMEDIATE YAW DRIVE SHAFT			
DESIGN NO.	DATE	REV.	BY
DRAWN BY: [Signature]			
CHECKED BY: [Signature]			
DATE: 08-7-01			
PROJECT: INTERMEDIATE YAW DRIVE SHAFT			
PART NO. 1015 F 34			












6-2

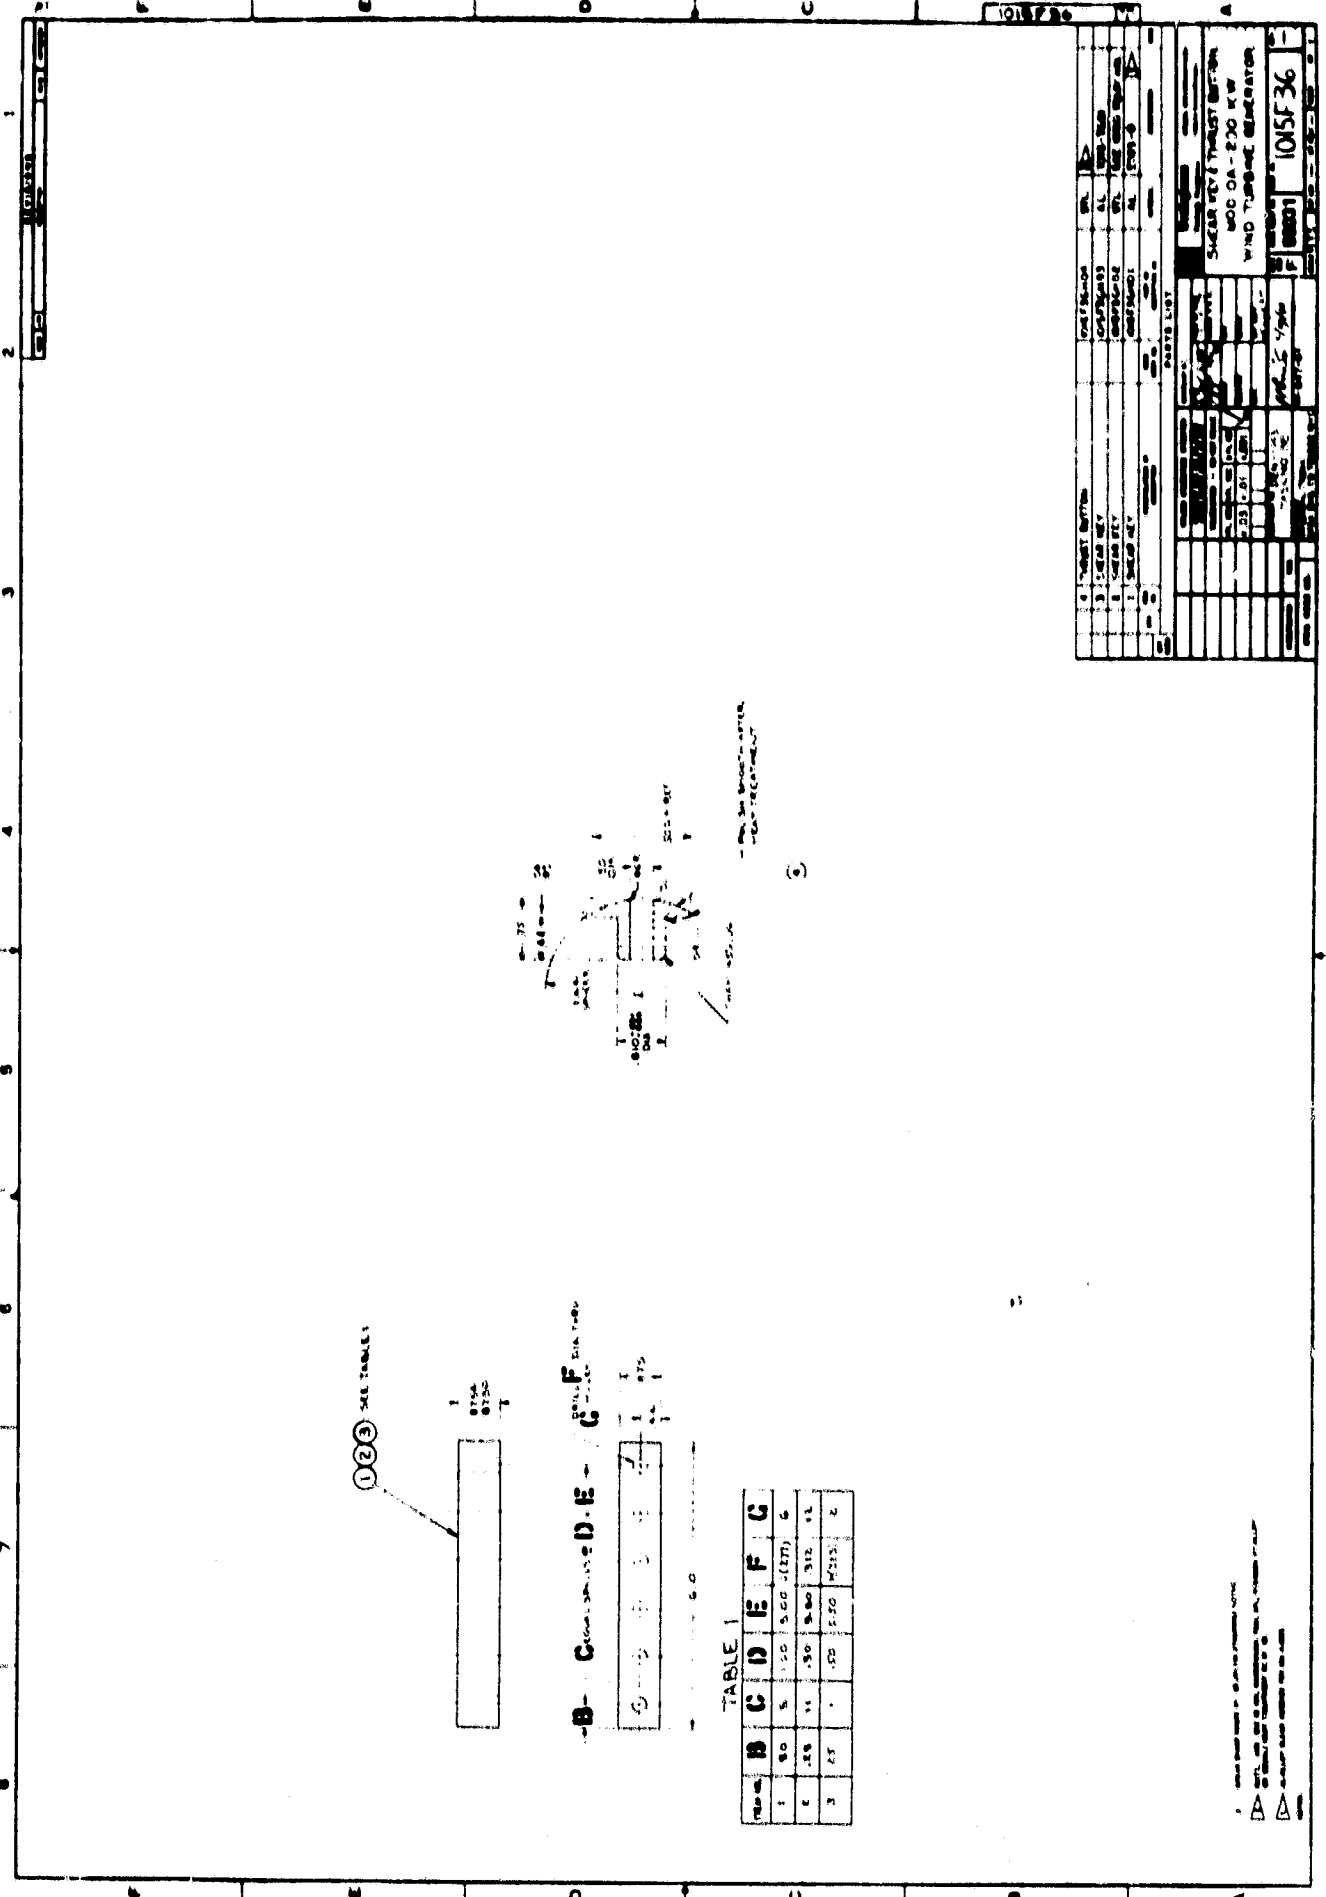

①②③ SEE TABLES




TABLE 1

TABLE	B	C	D	E	F	G
1	80	8	1.50	3.00	(17)	6
2	25	15	.50	3.00	312	61
3	25	1	.50	5.50	4313	6



1015F 36

1015 F37

REVISIONS		DATE	
NO.	DESCRIPTION	BY	DATE

GROUP NO.	1
GROUP NAME	1015 F37

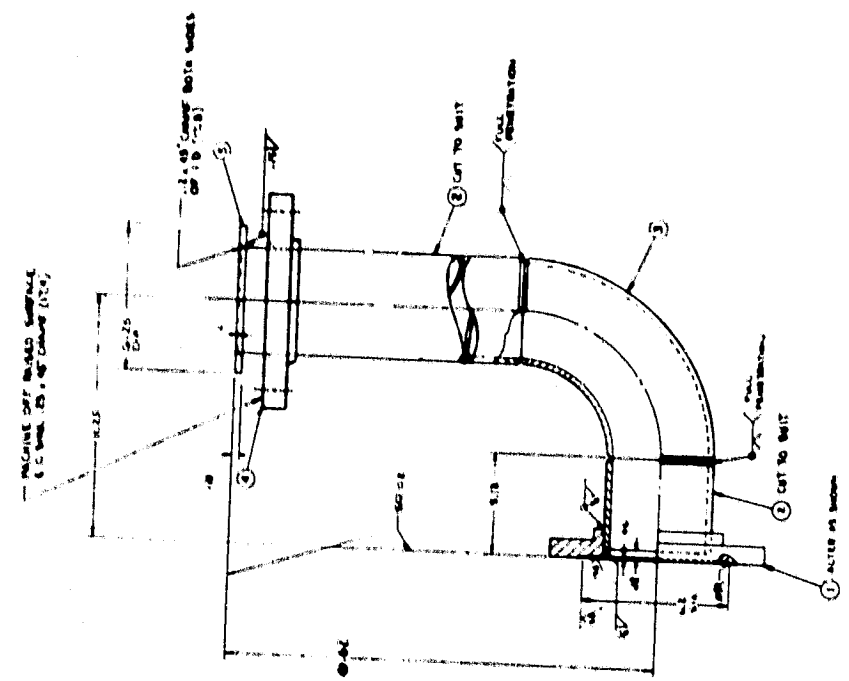

GROUP-1

1. ALL DIMENSIONS ARE IN INCHES UNLESS OTHERWISE SPECIFIED.

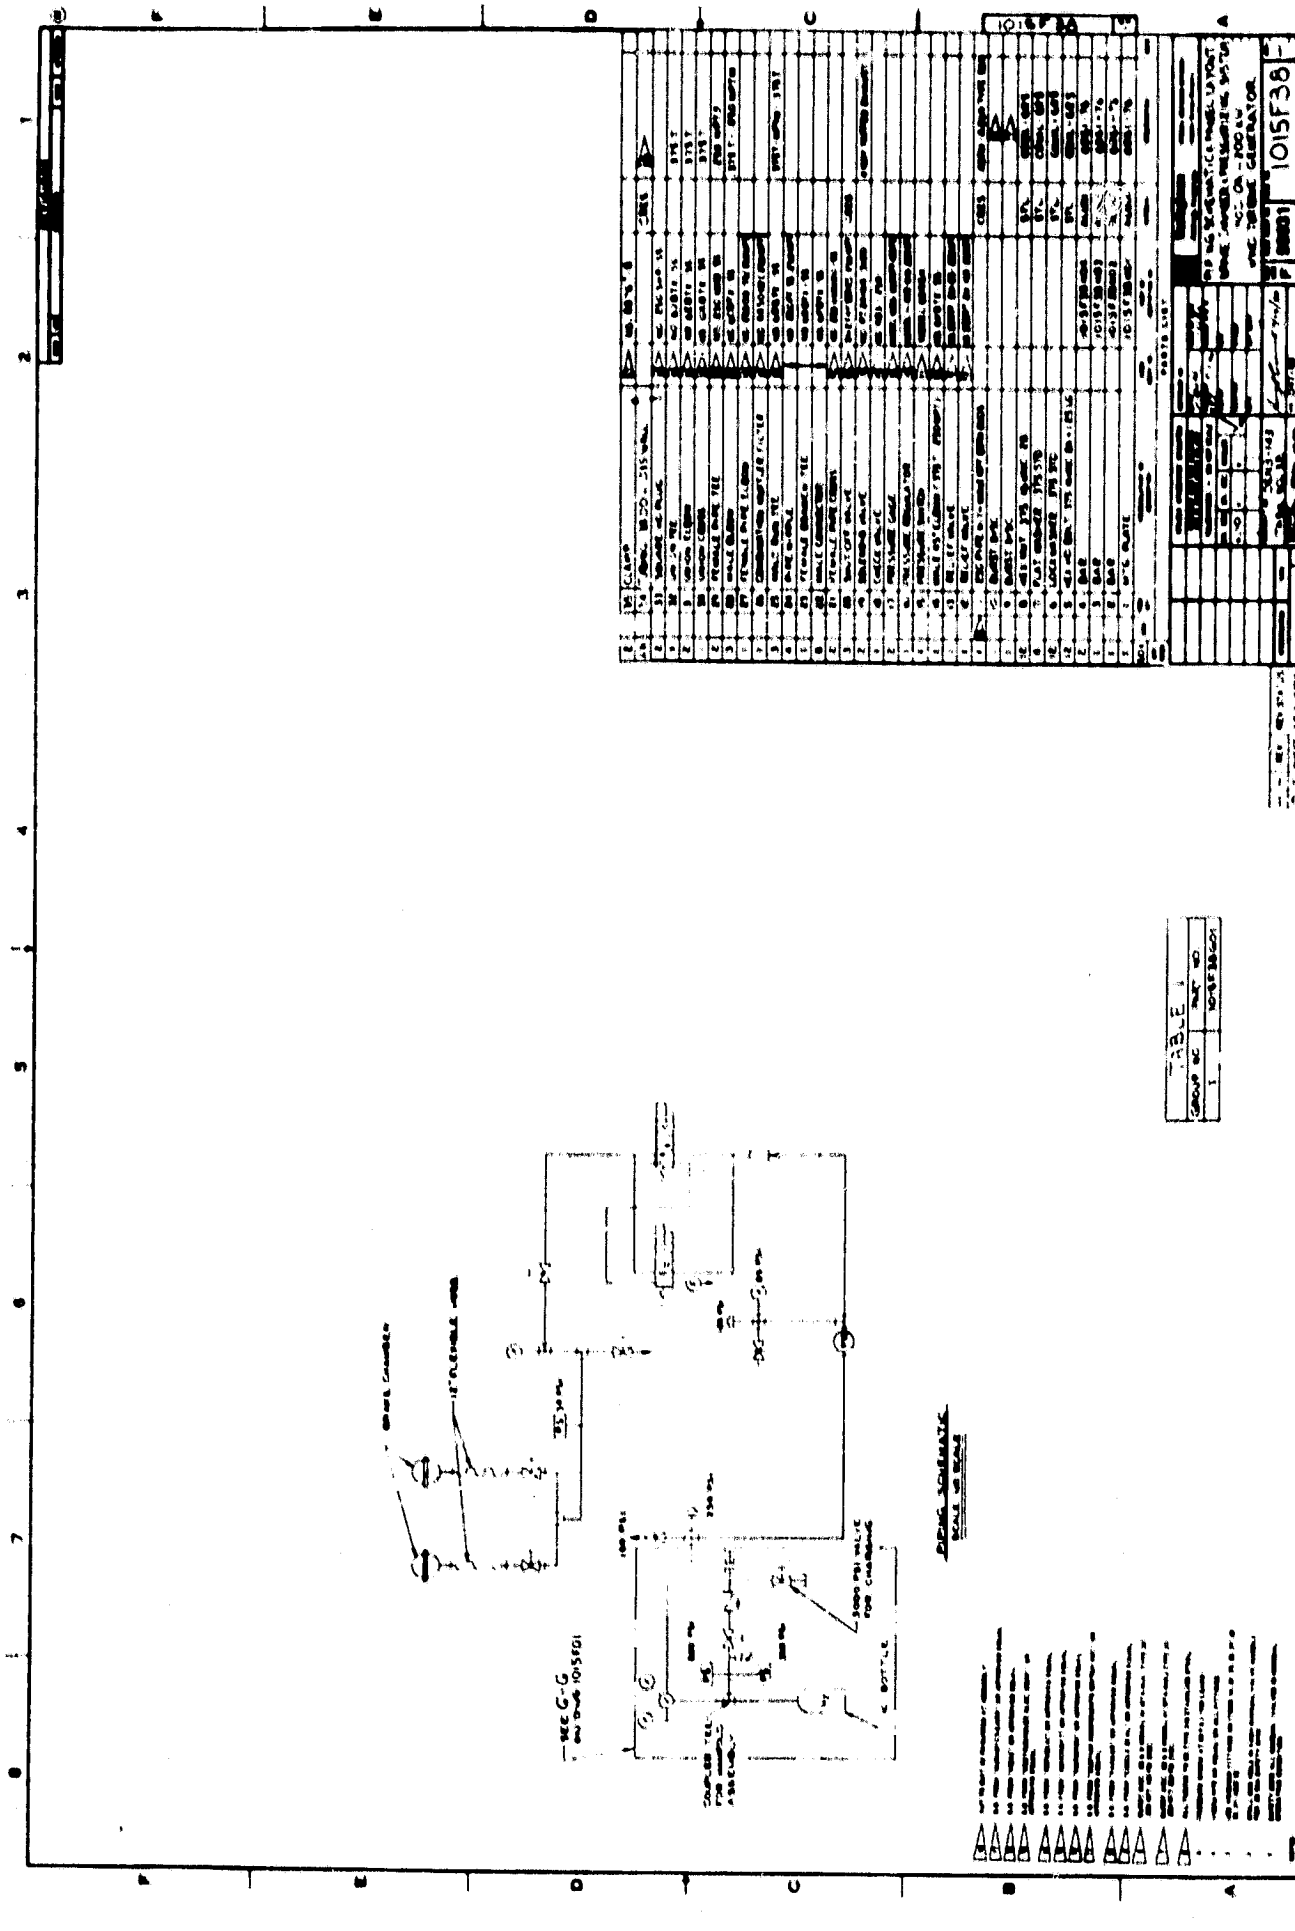





TABLE 1
GROUP NO. 1
REV. 1
DATE 10/15/50

1015F38


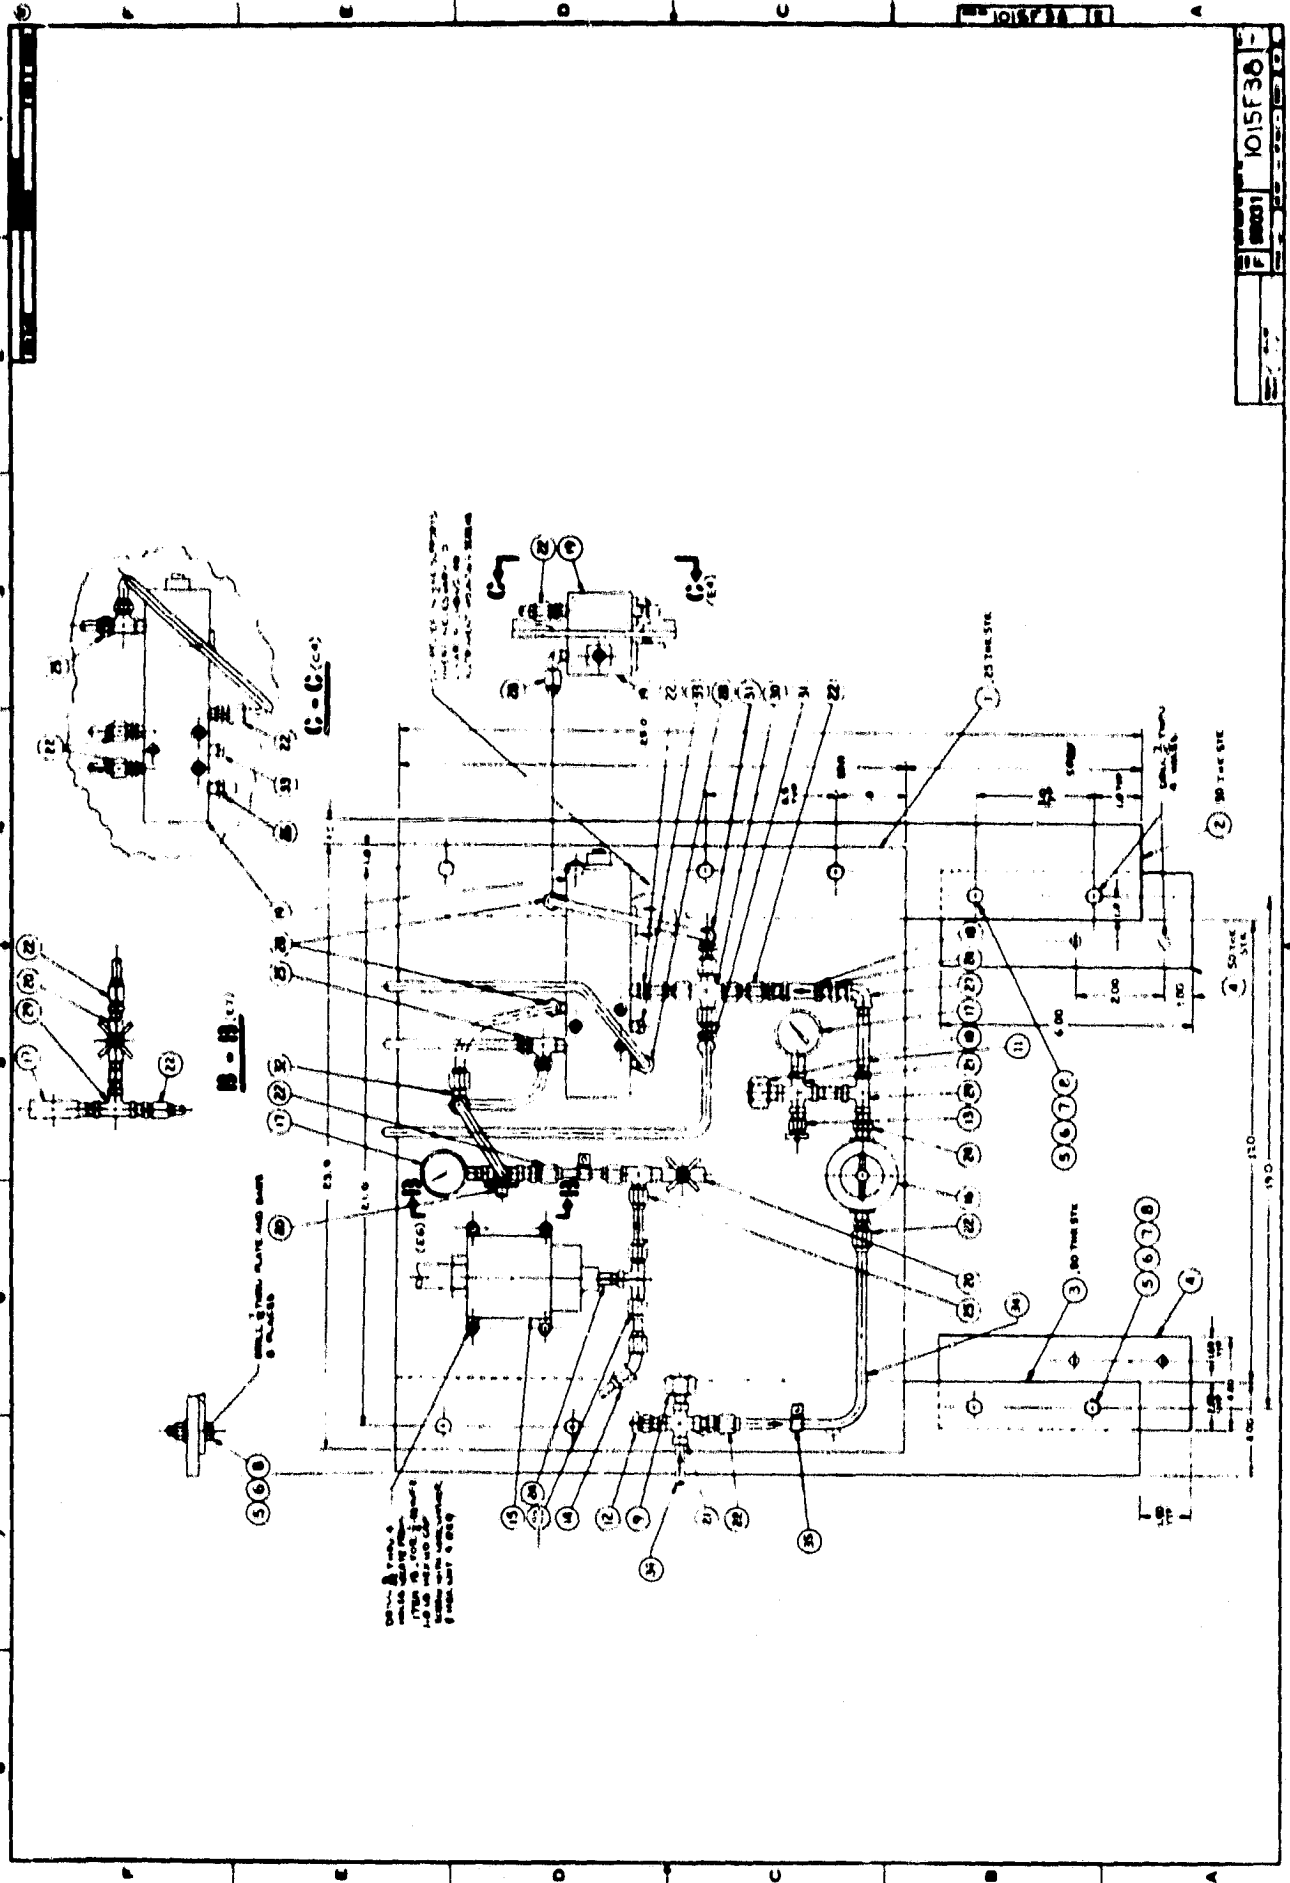

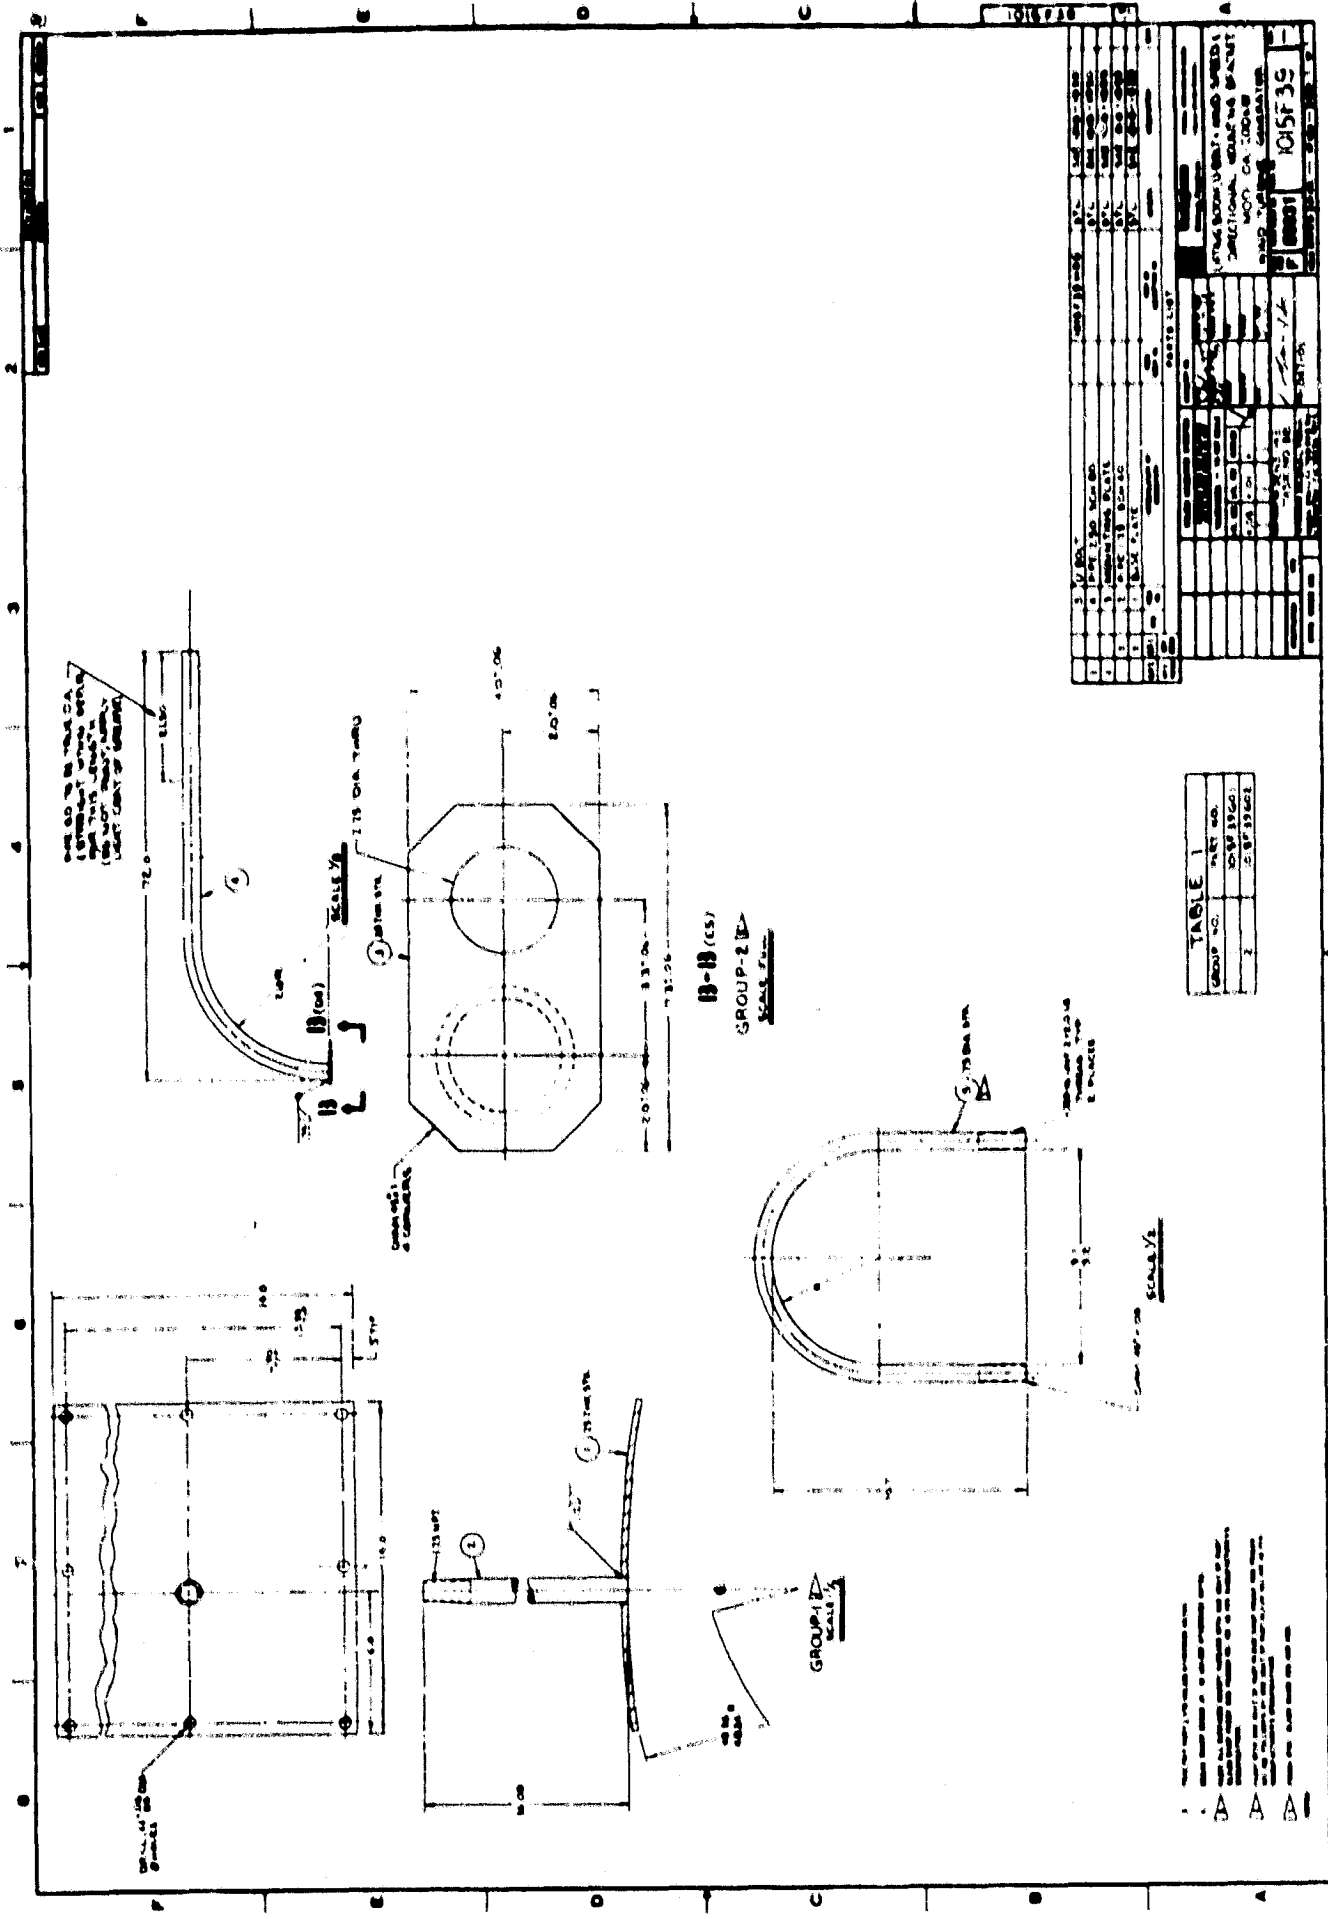

TABLE 1		
GROUP NO.	PART NO.	


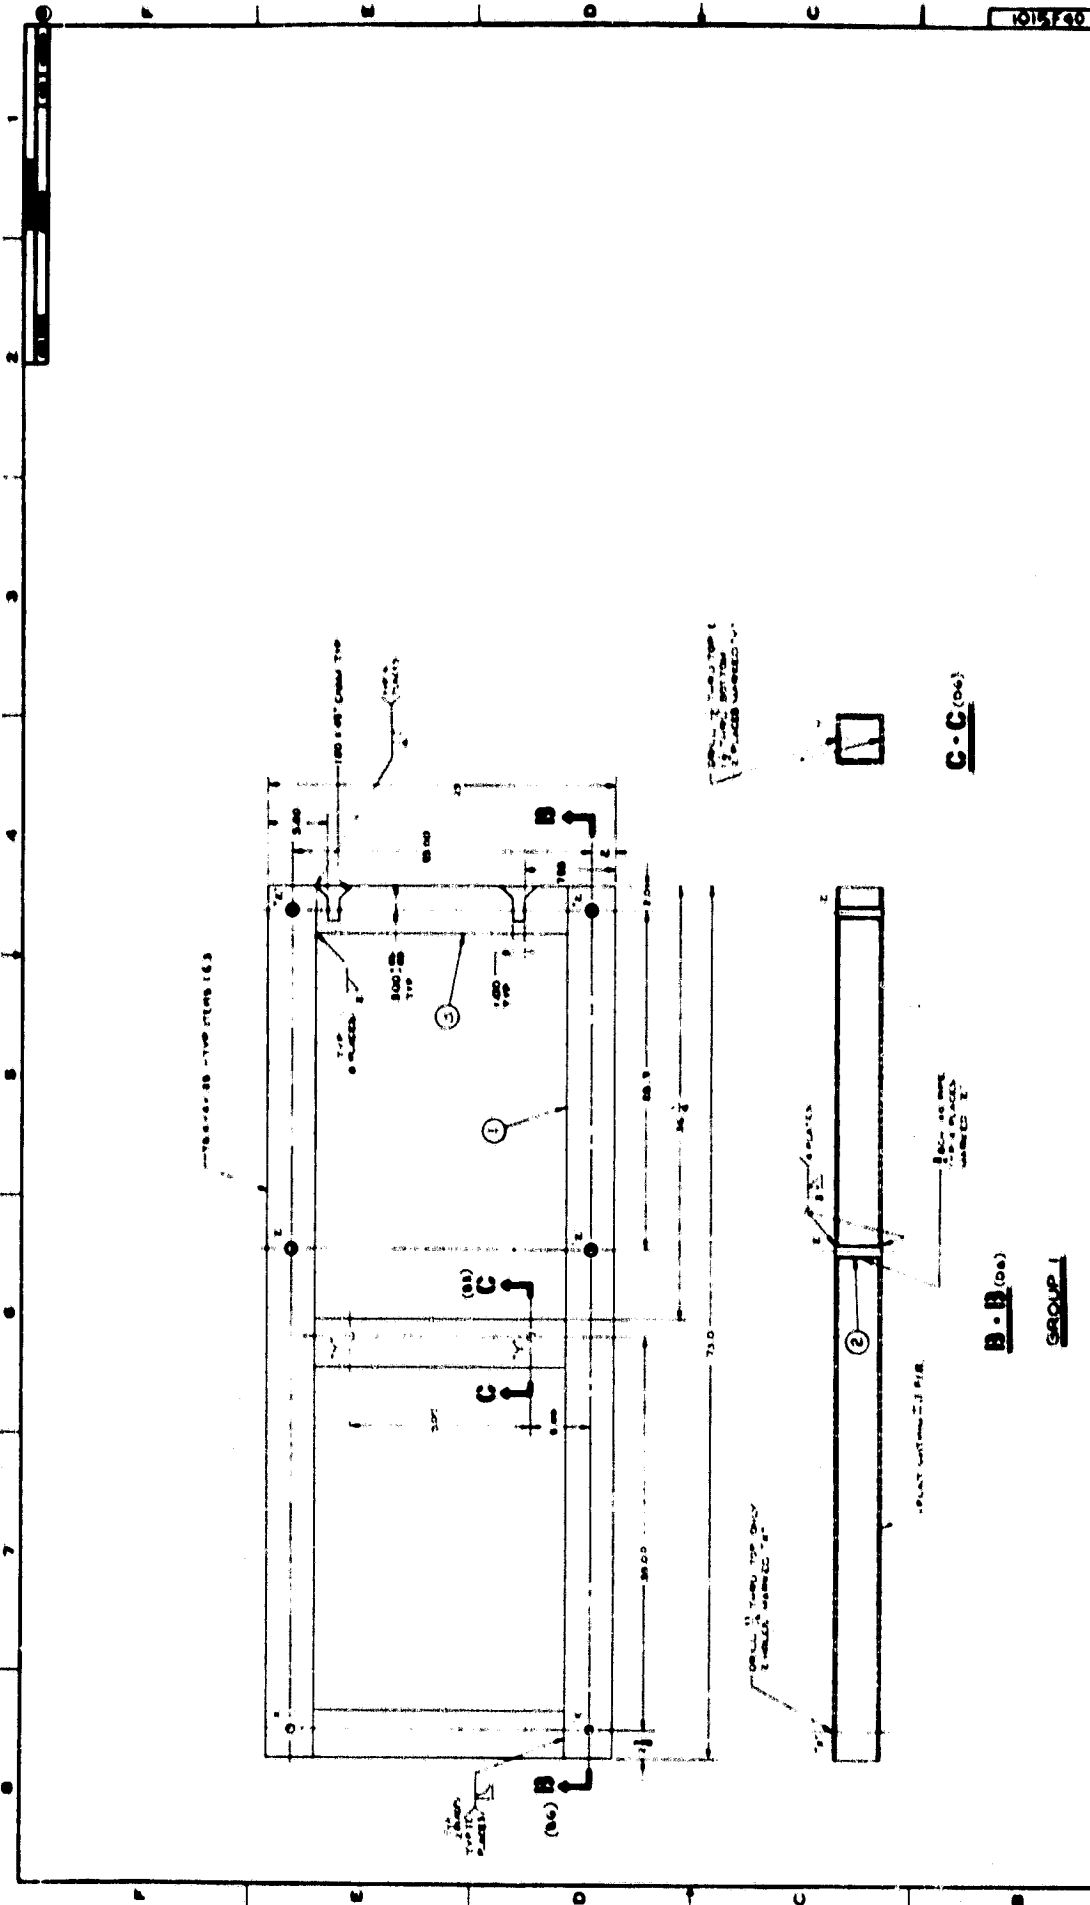






C-C (06)

B-B (06)

GROUP 1

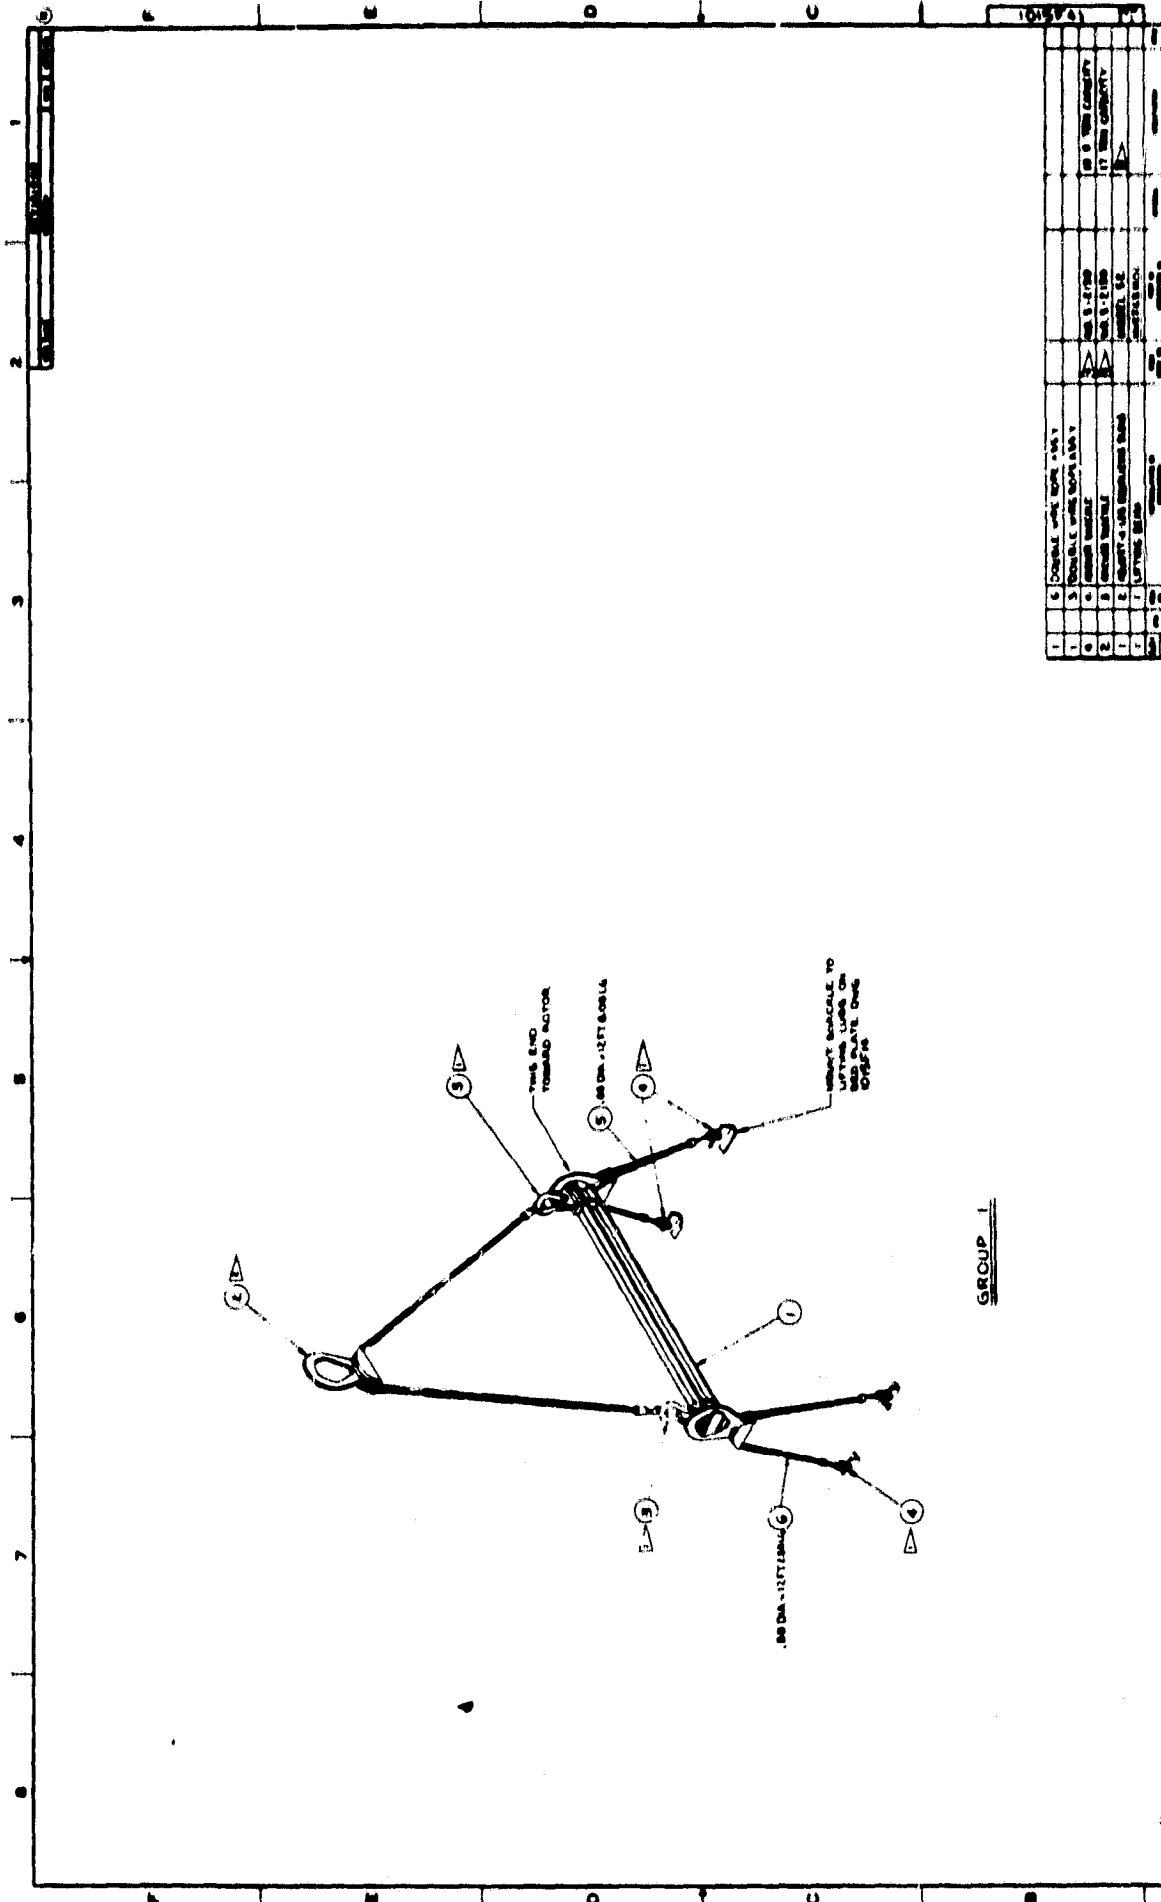


GROUP 1




		1000 OH - 200 KW WIND TURBINE GENERATOR	
		101541	

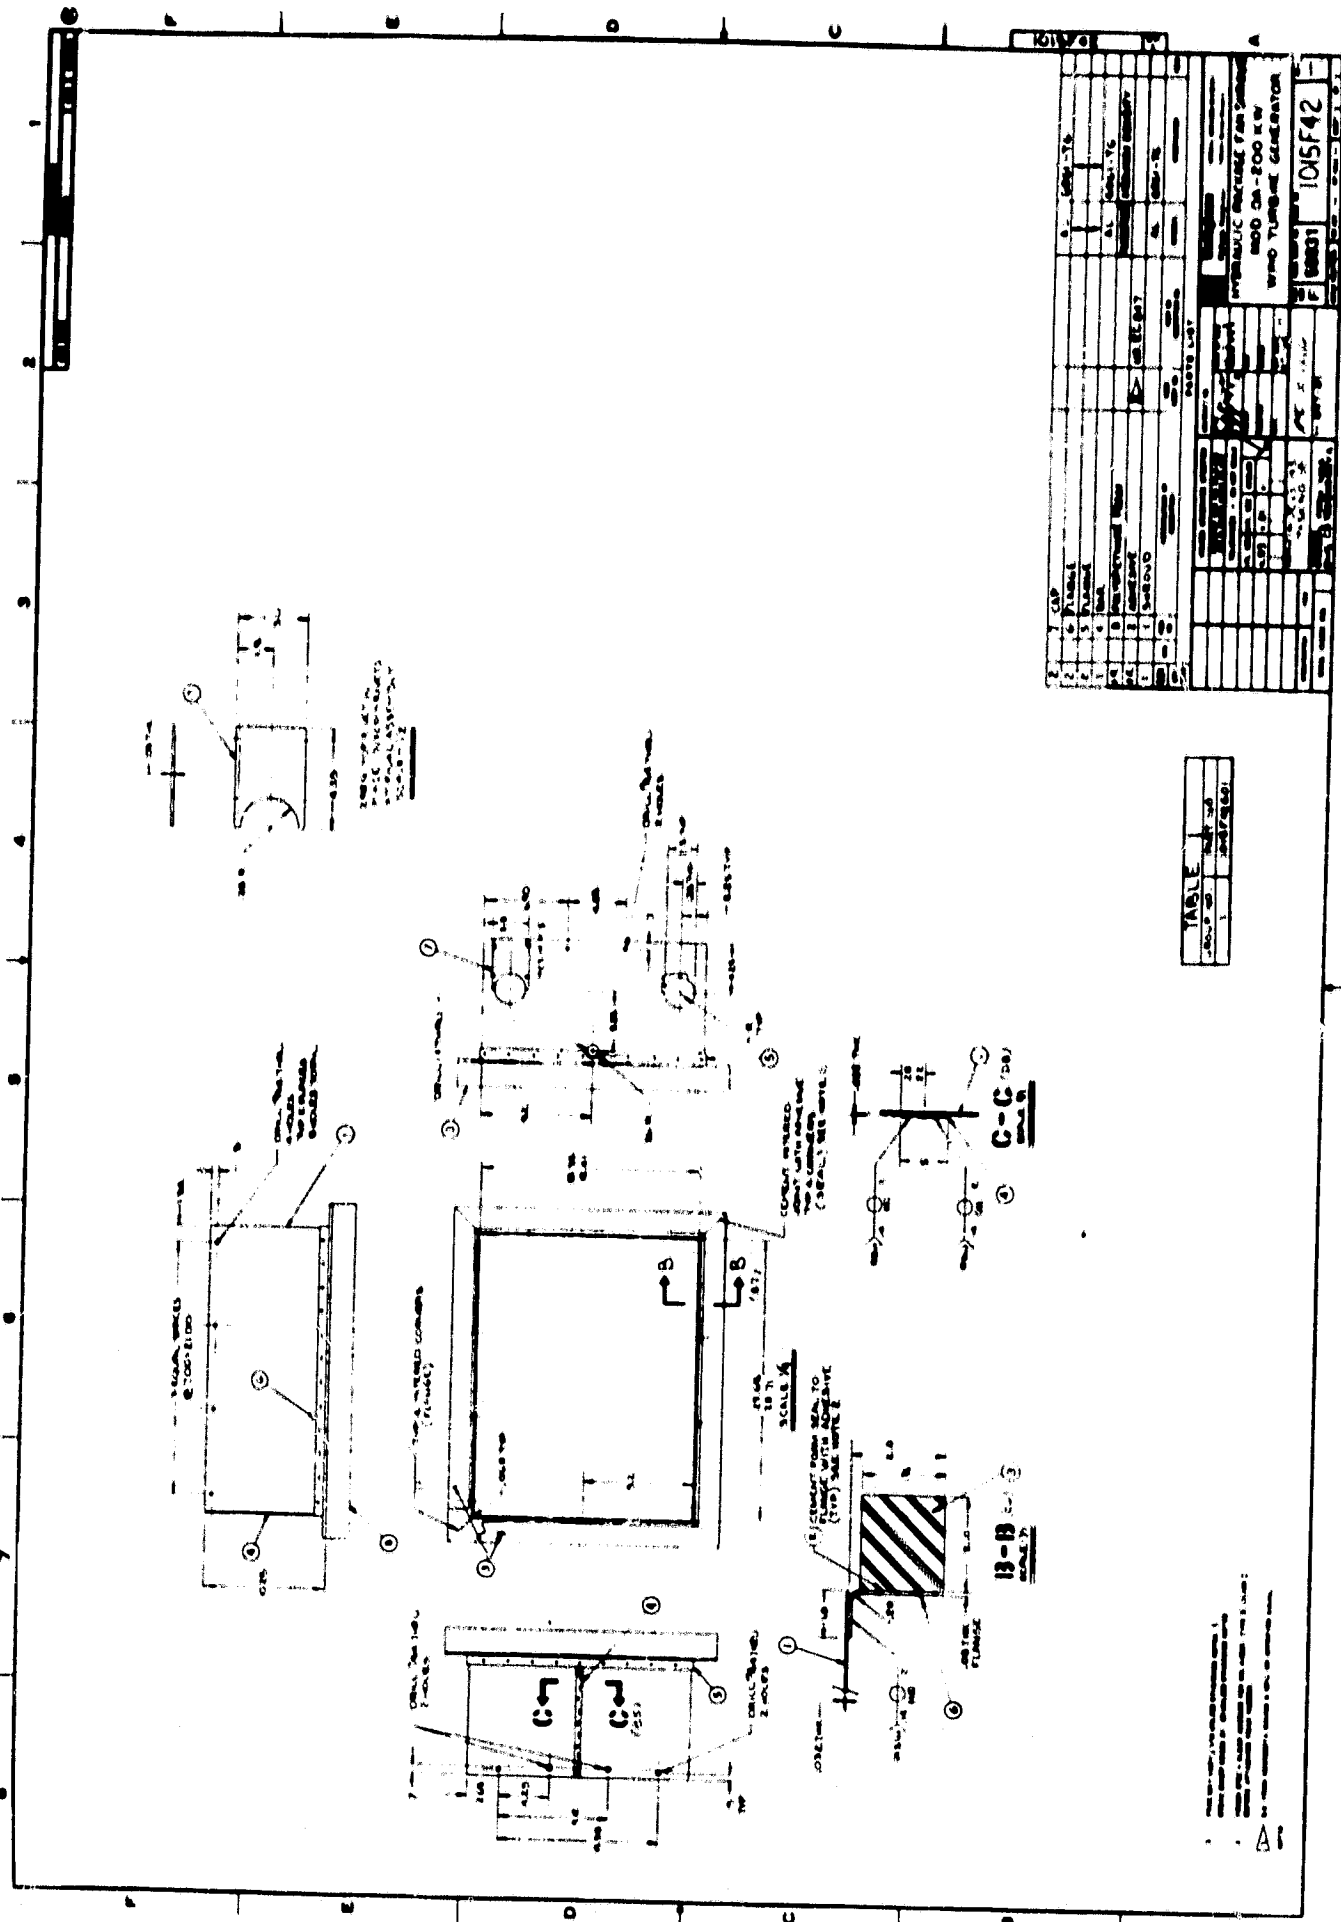

AB

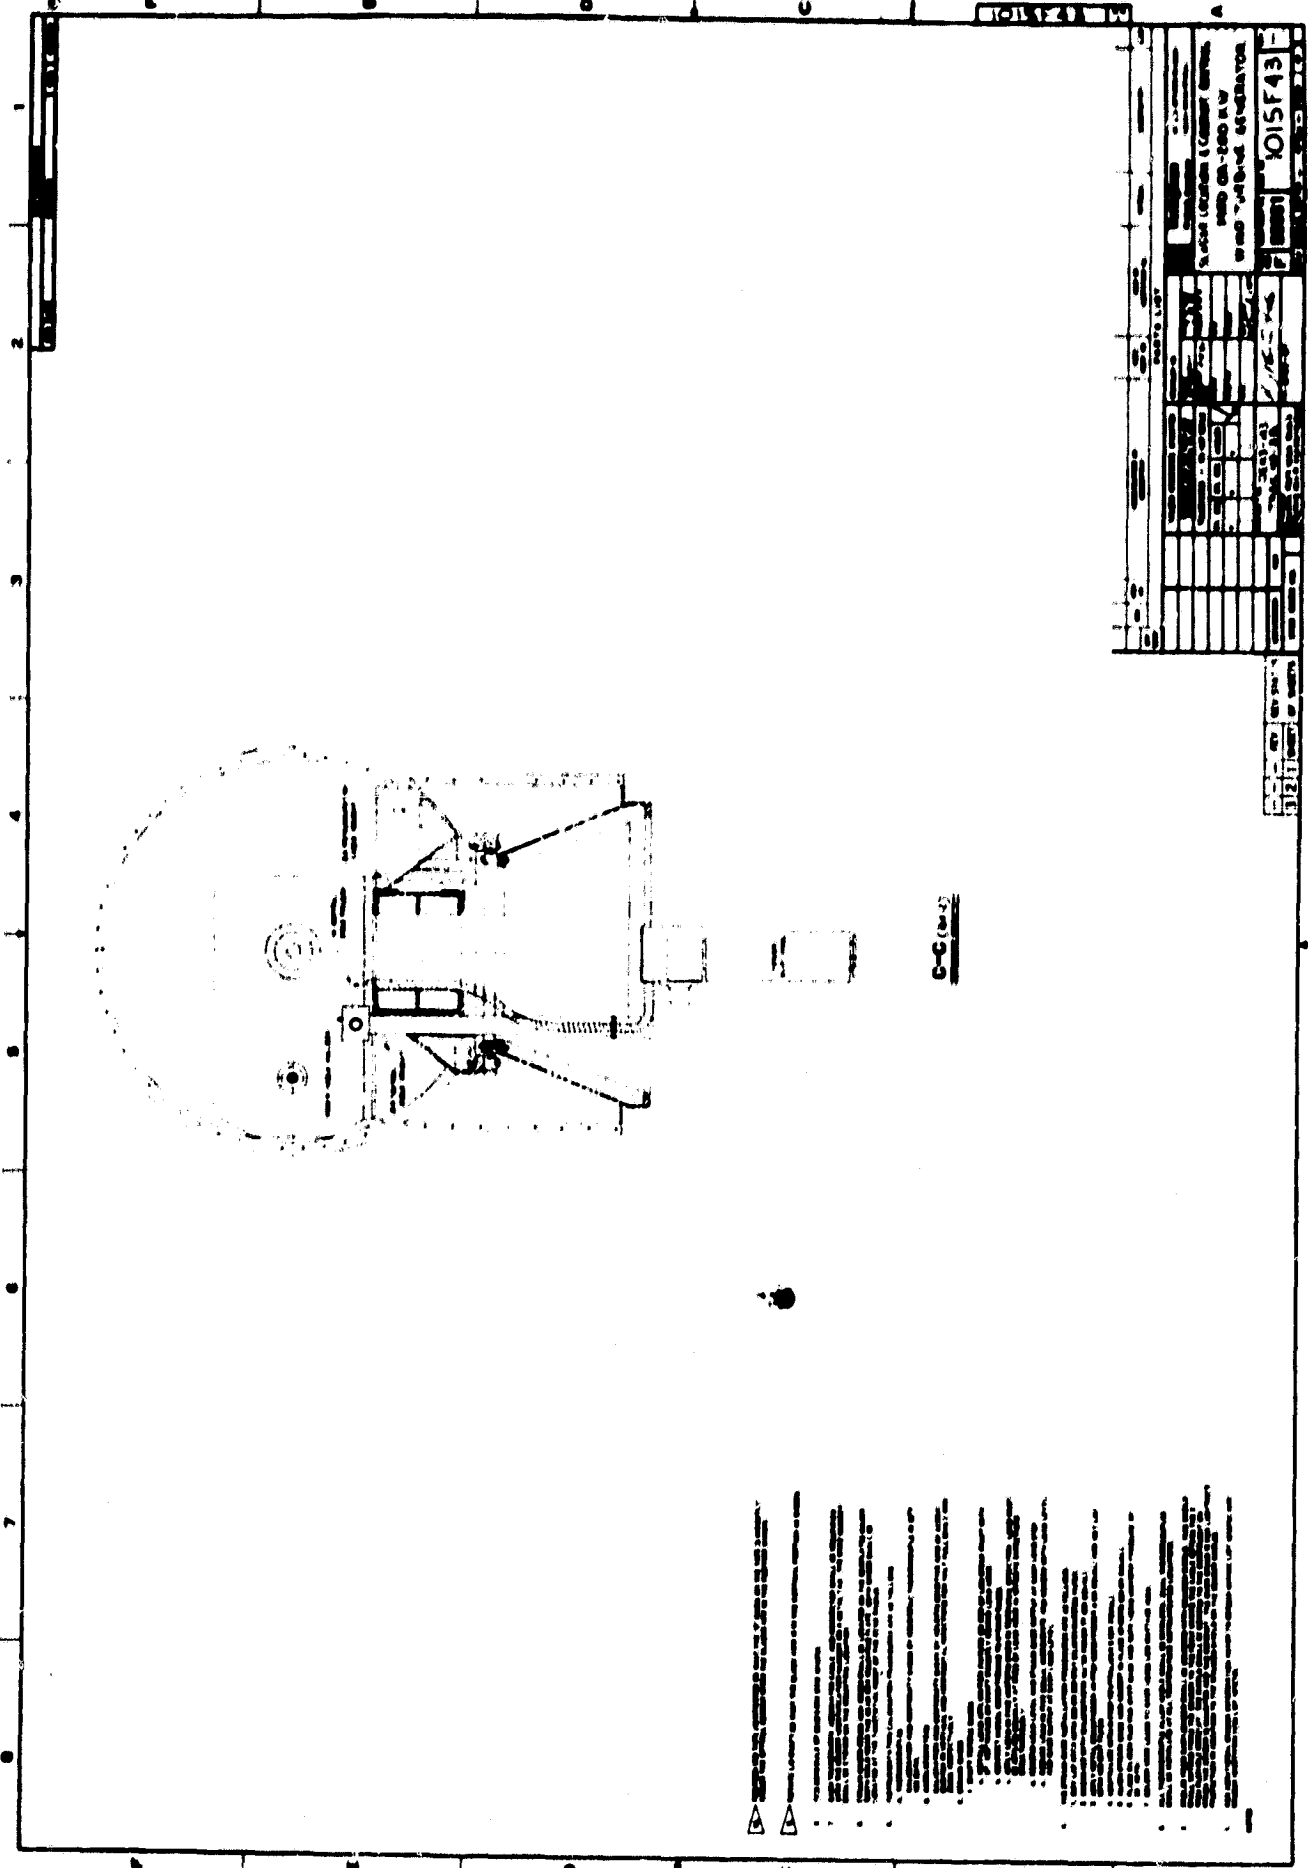



C-C (Rev. 2)




1015F43

1015F43

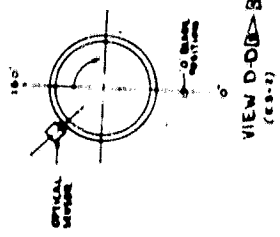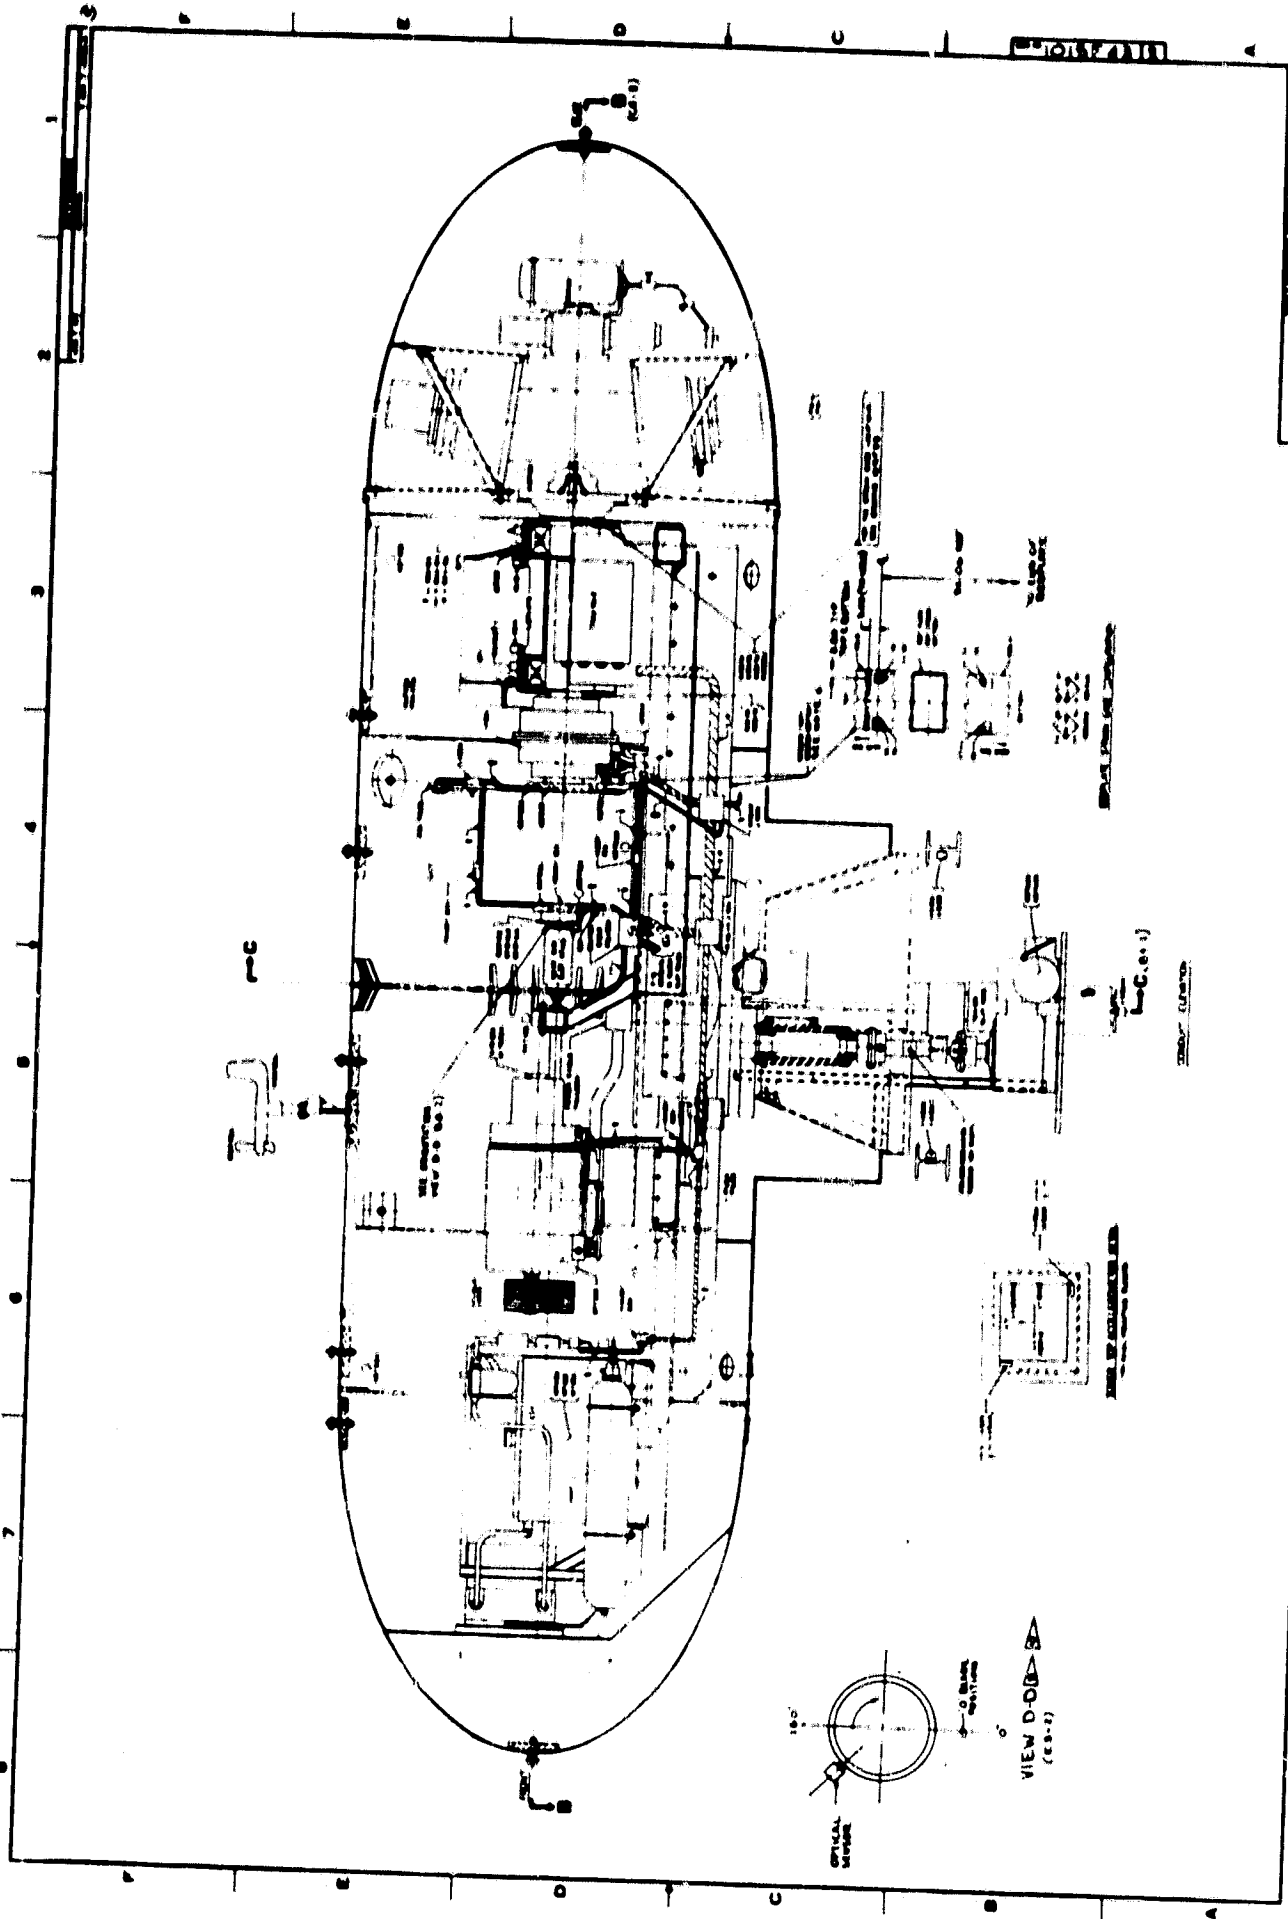

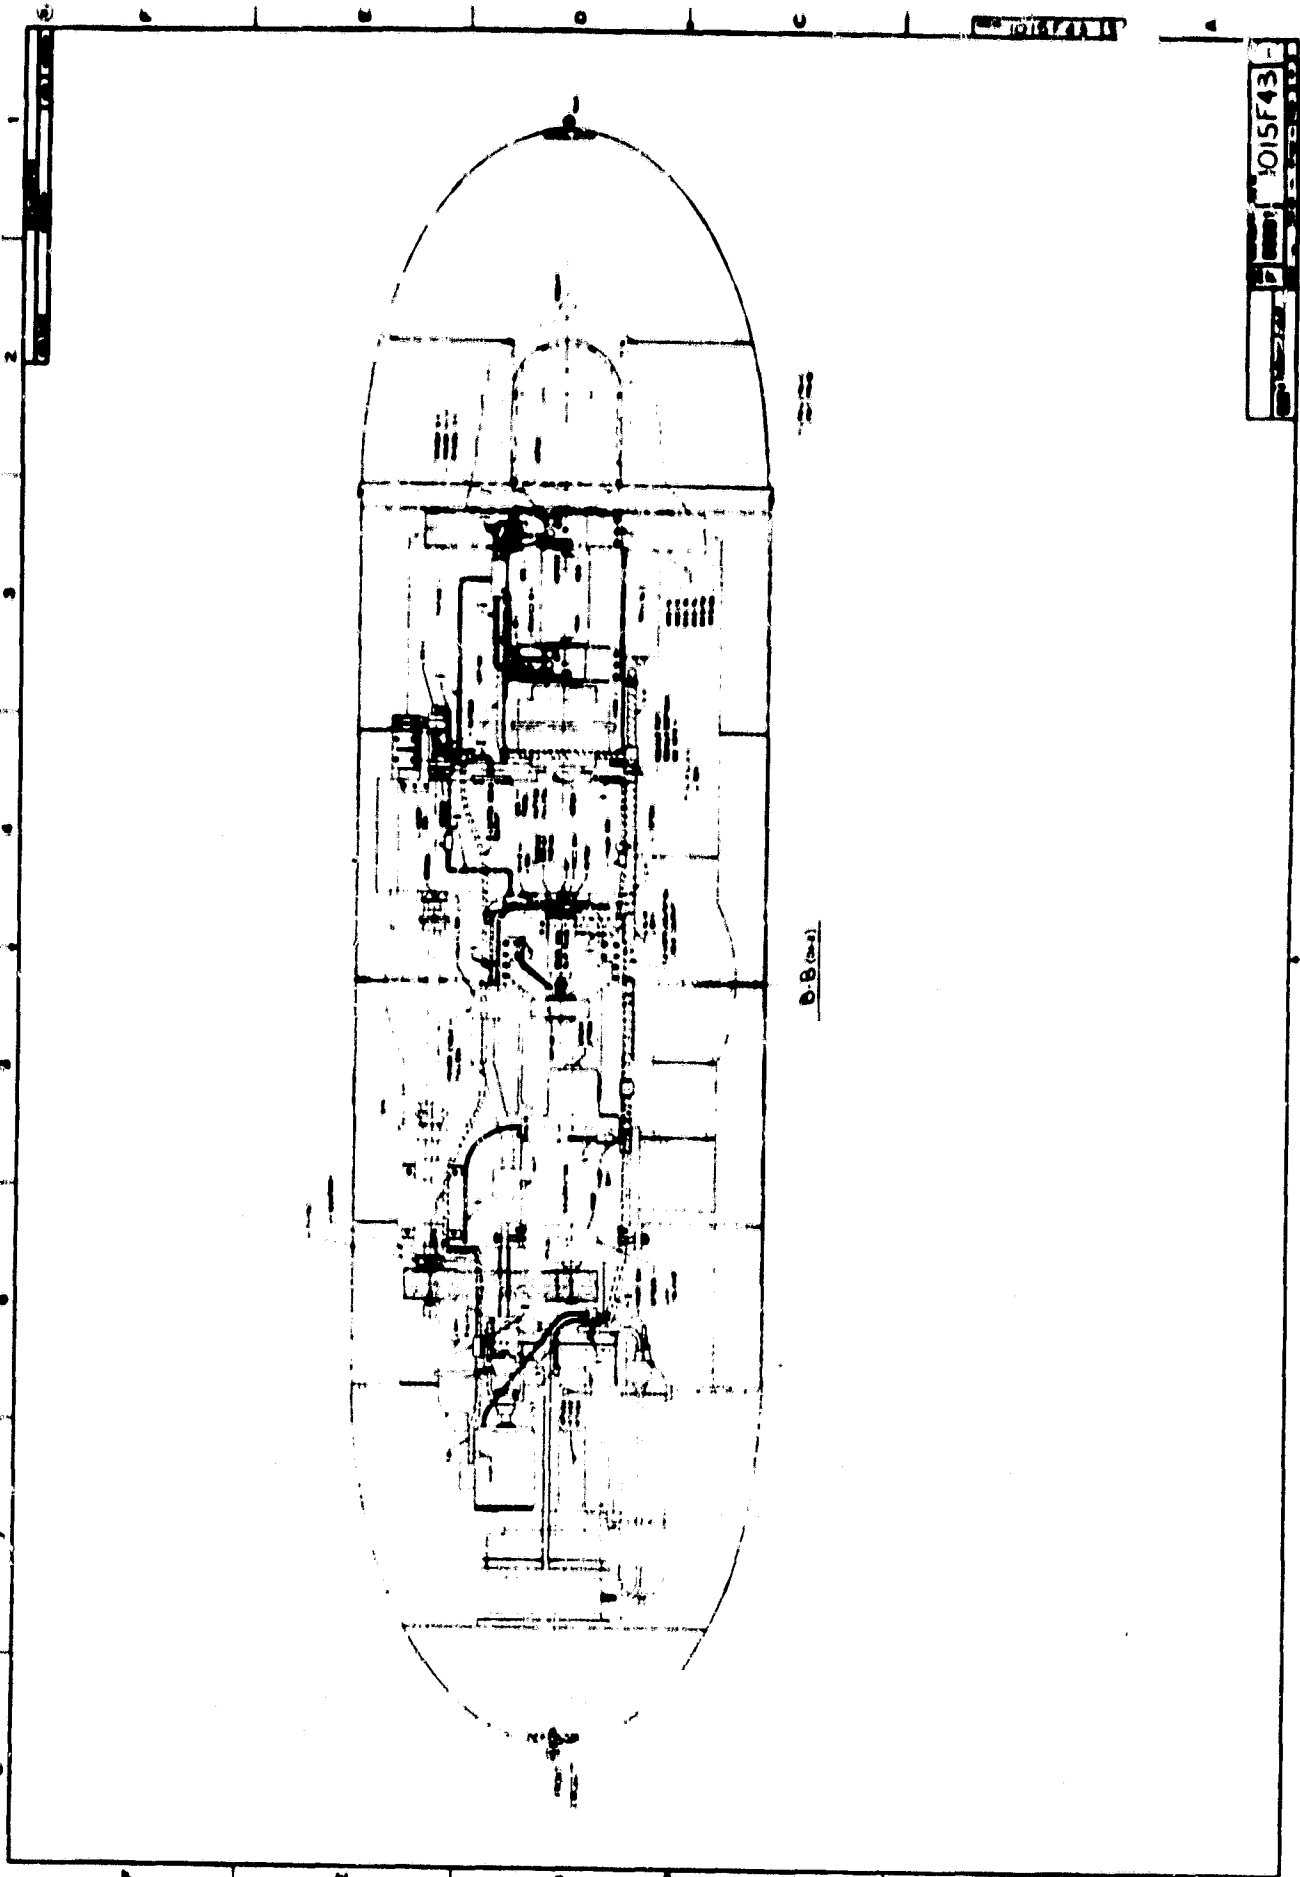

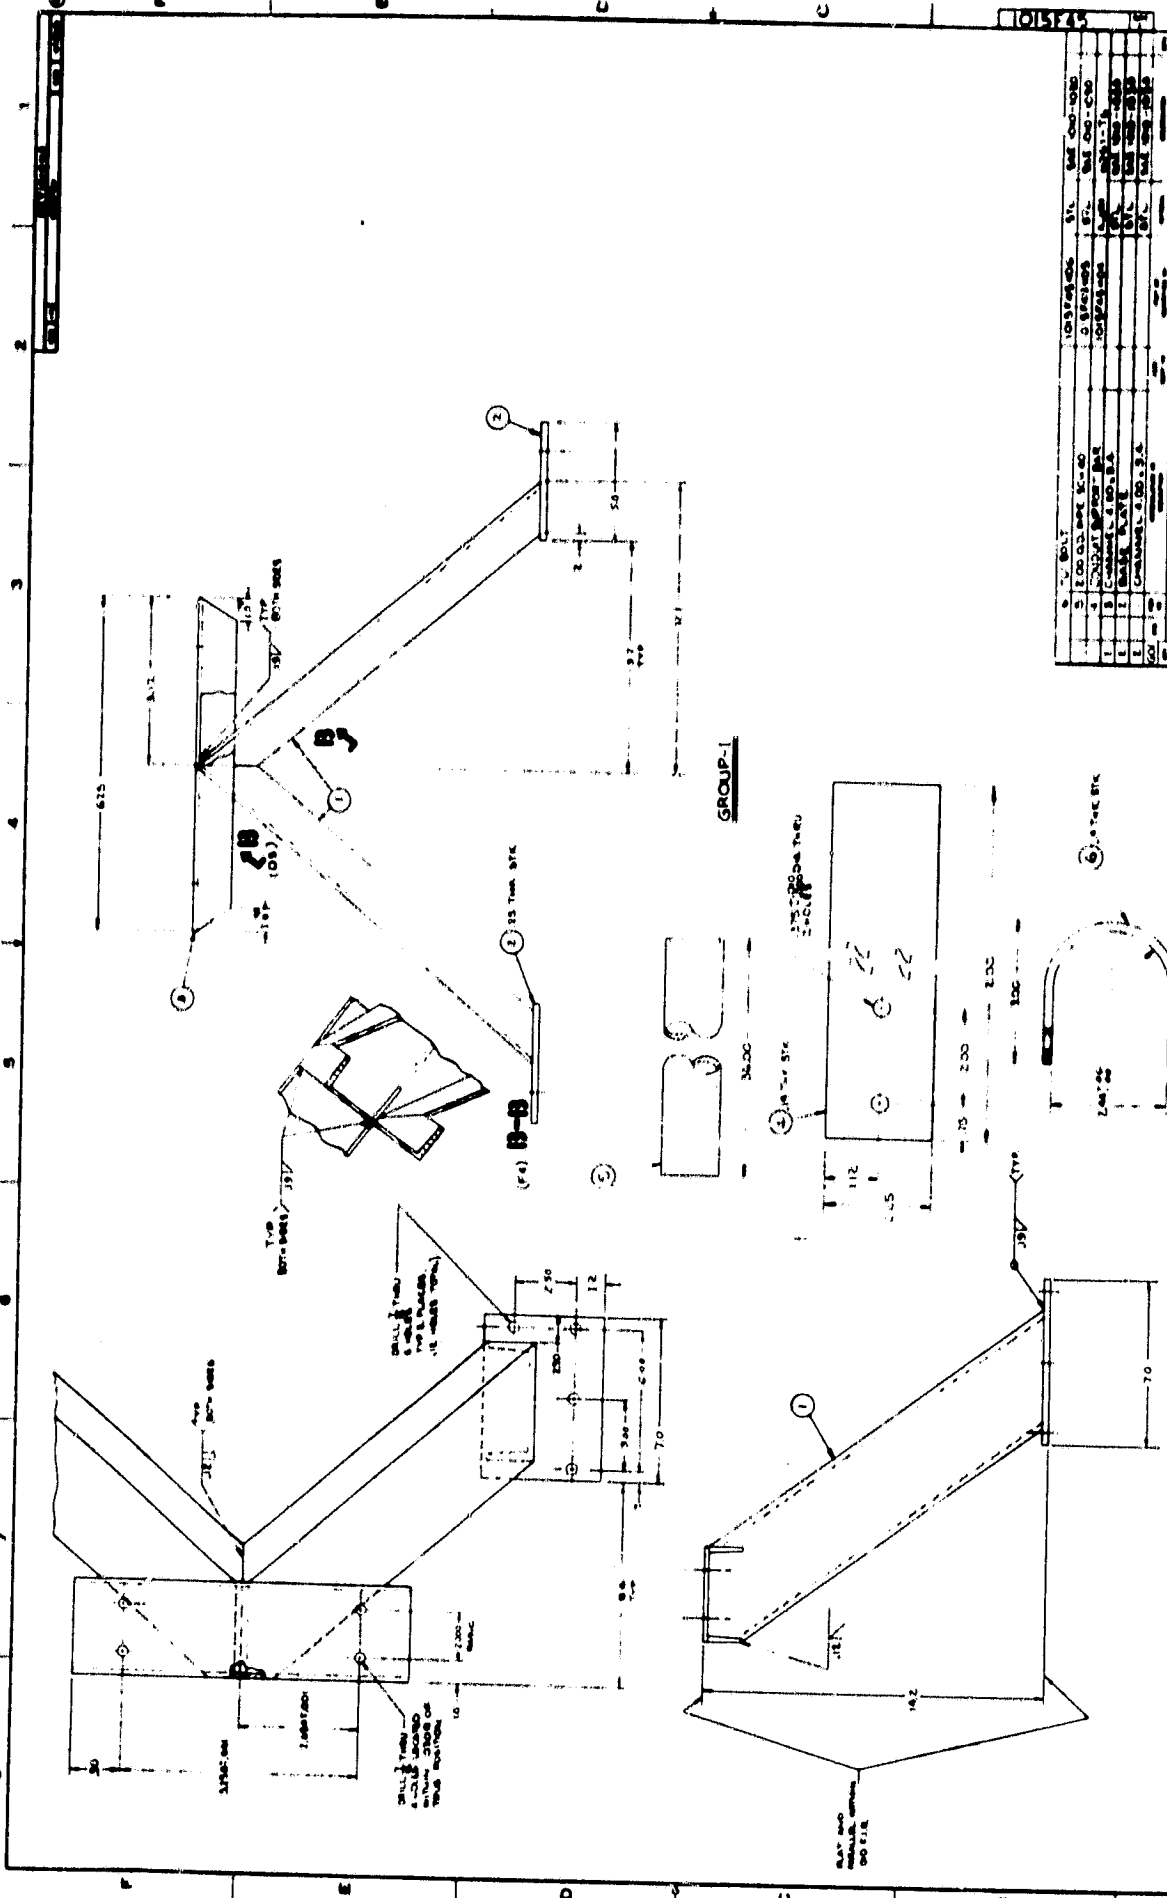


GROUP NO.	PART NO.
1	1015745




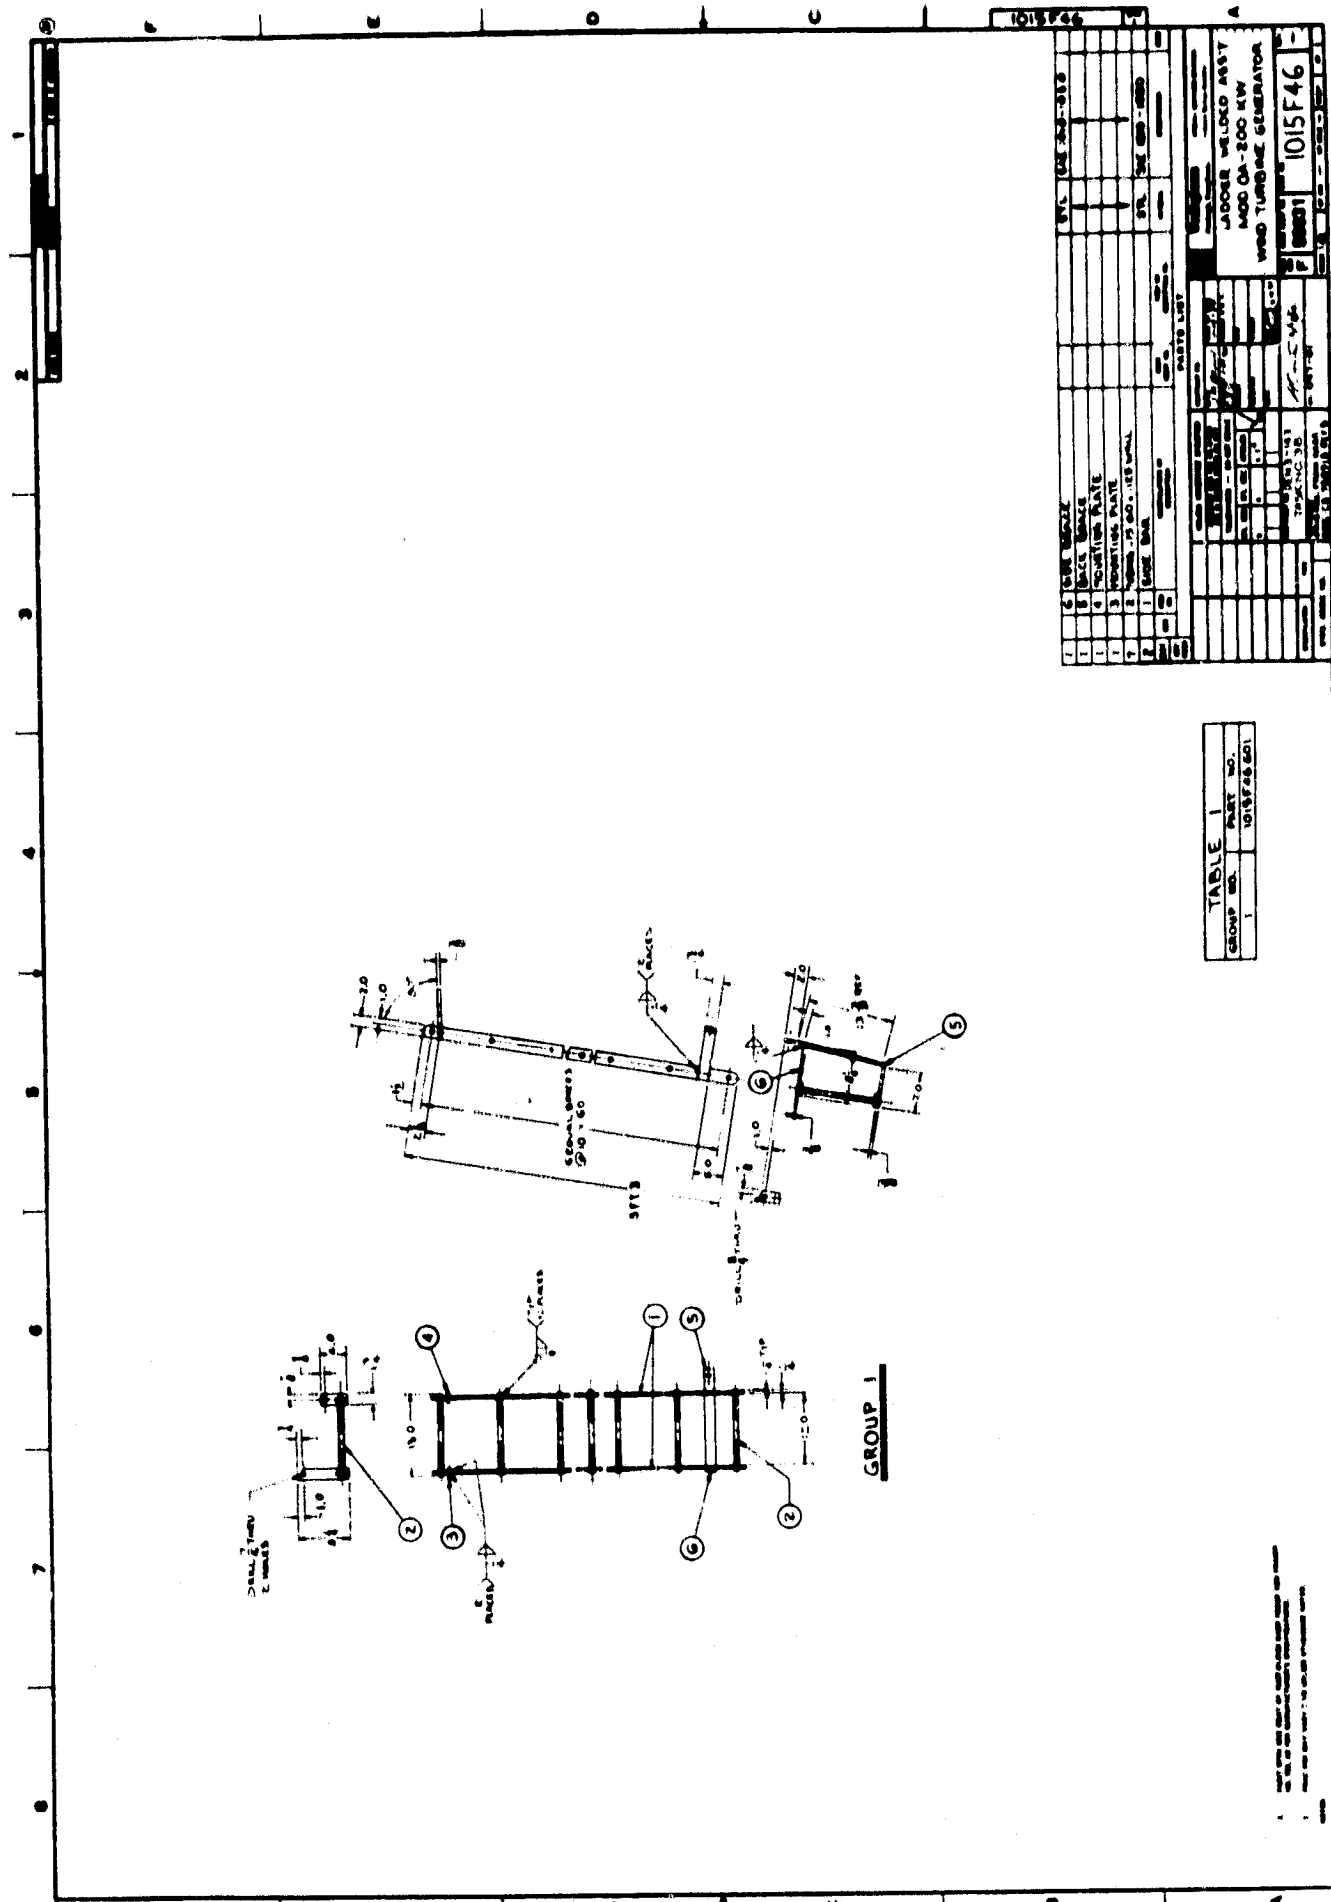



TABLE 1
 GROUP NO. 1
 PART NO. 1015F46 201

PARTS LIST		REV. NO. 200-000	
1	COVER PLATE		
2	BACK PLATE		
3	SCREWING PLATE		
4	SCREWING PLATE		
JACOBS WELDED ASST
 1400 GA - 200 KW
 WIND TURBINE GENERATOR


1015F46	1015F46
---------	---------


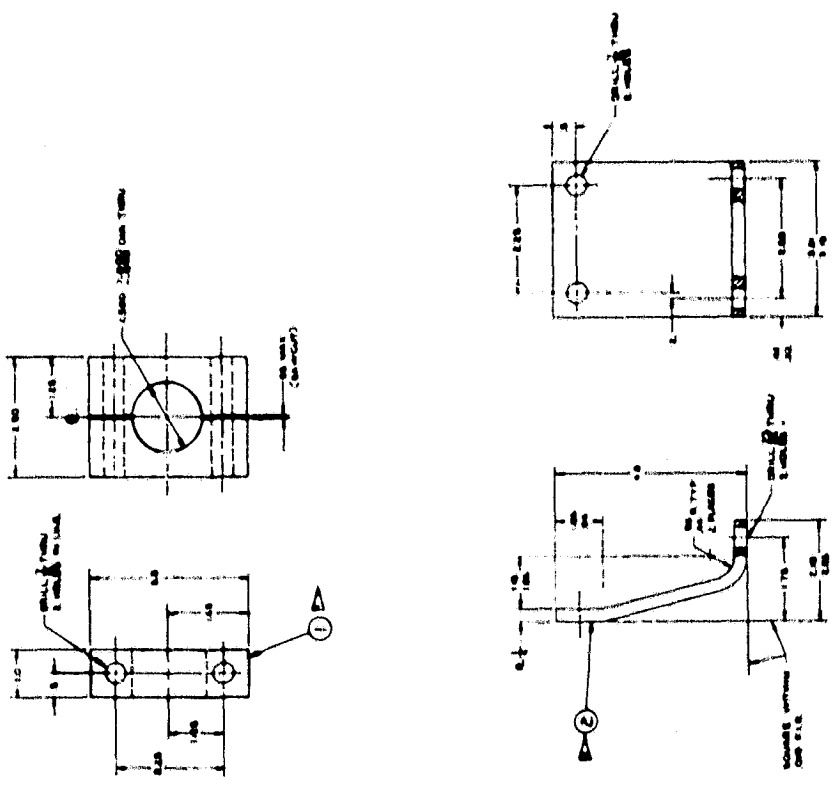

ORIGINAL PAGE IS
OF POOR QUALITY

1. 101574
 2. 101574
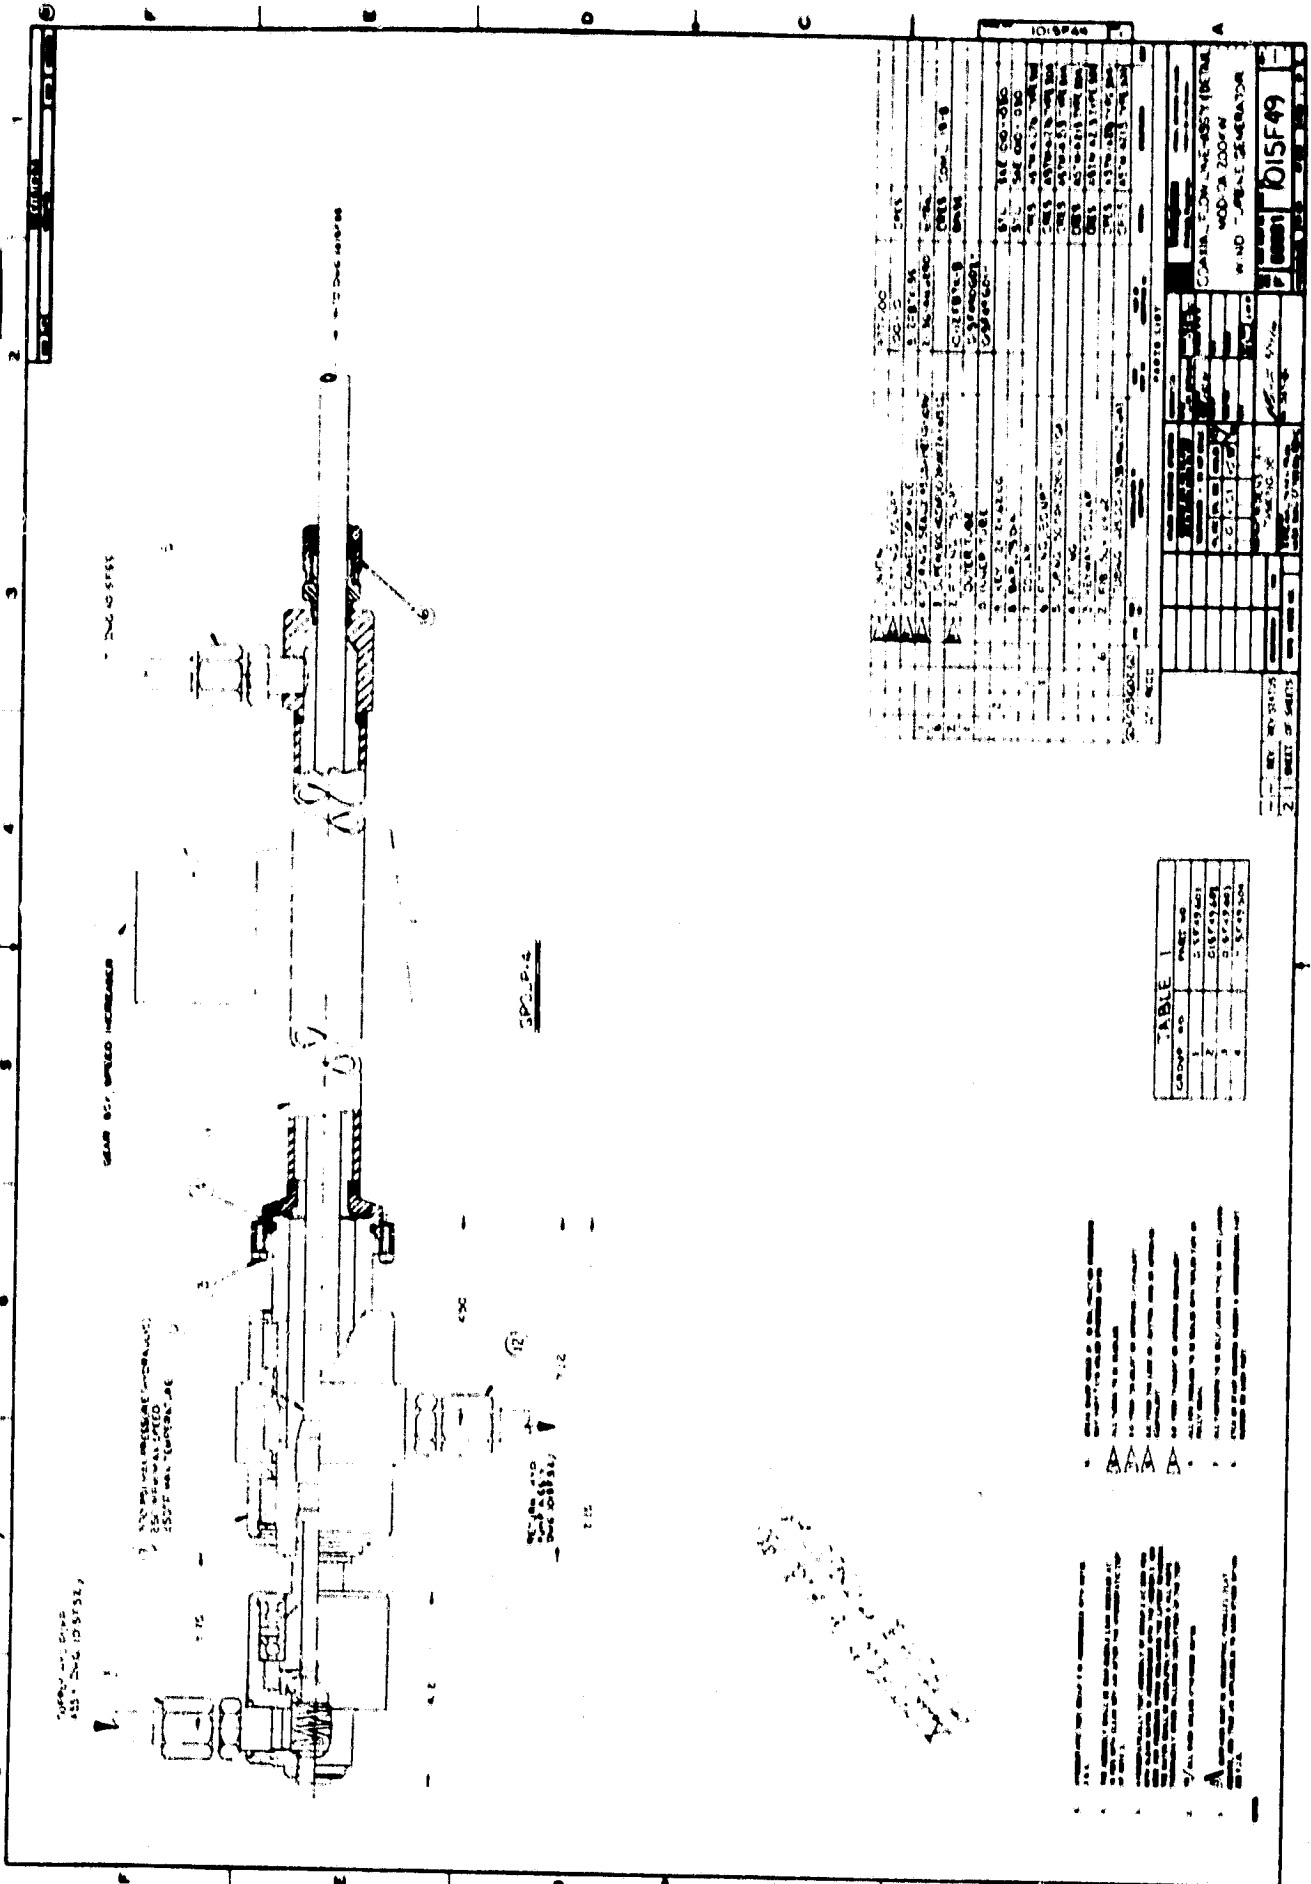

APPROXIMATE DISK
457-200 1057532


GEAR BOX SPEED INCREASES

2 INCH DISK SPEED

SPC-P-4

2 INCH DISK SPEED



1015740	
1	DISK
2	DISK
WIND TURBINE GENERATOR




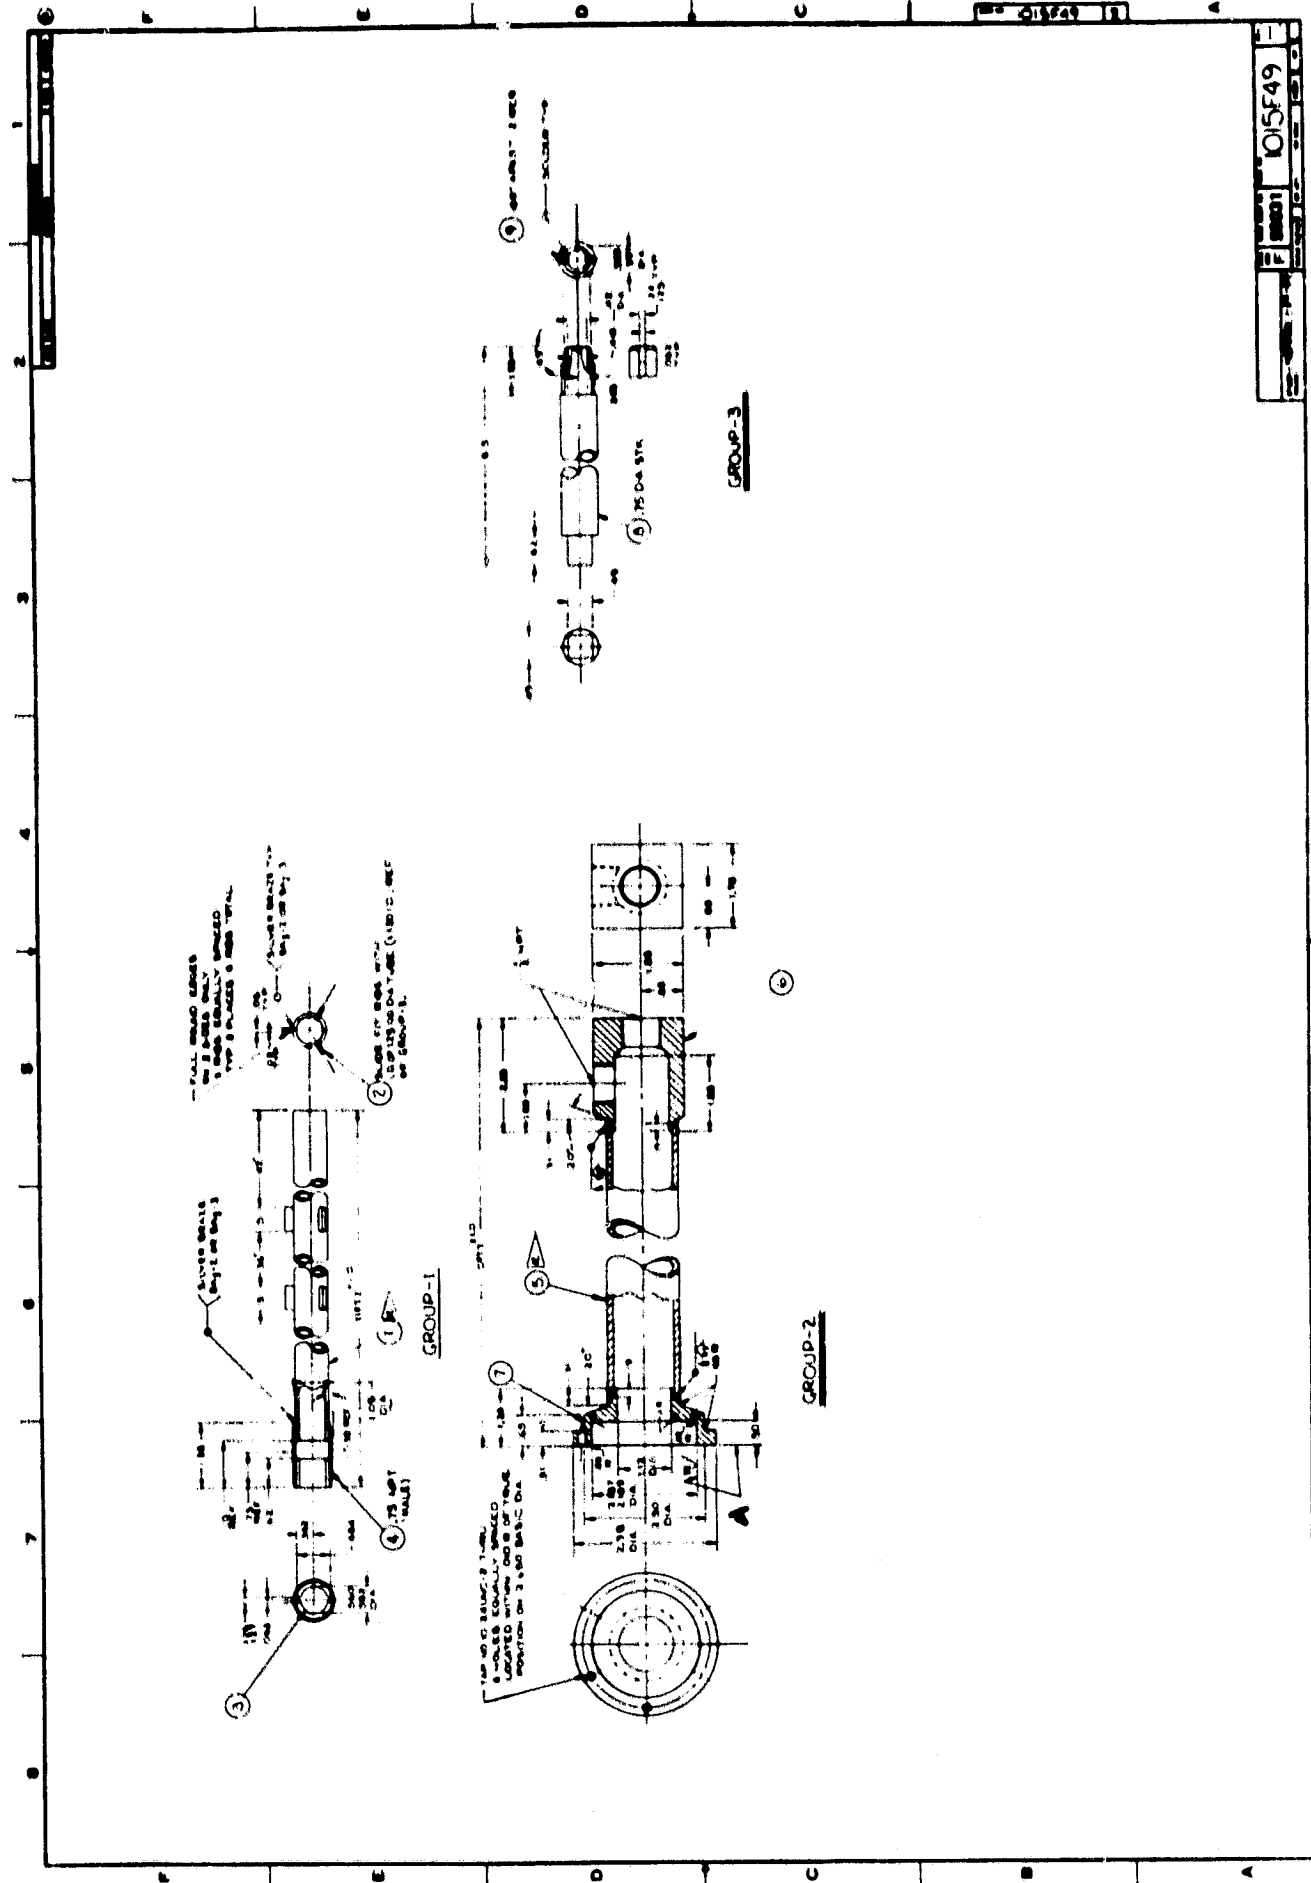





F 105F49
105F49



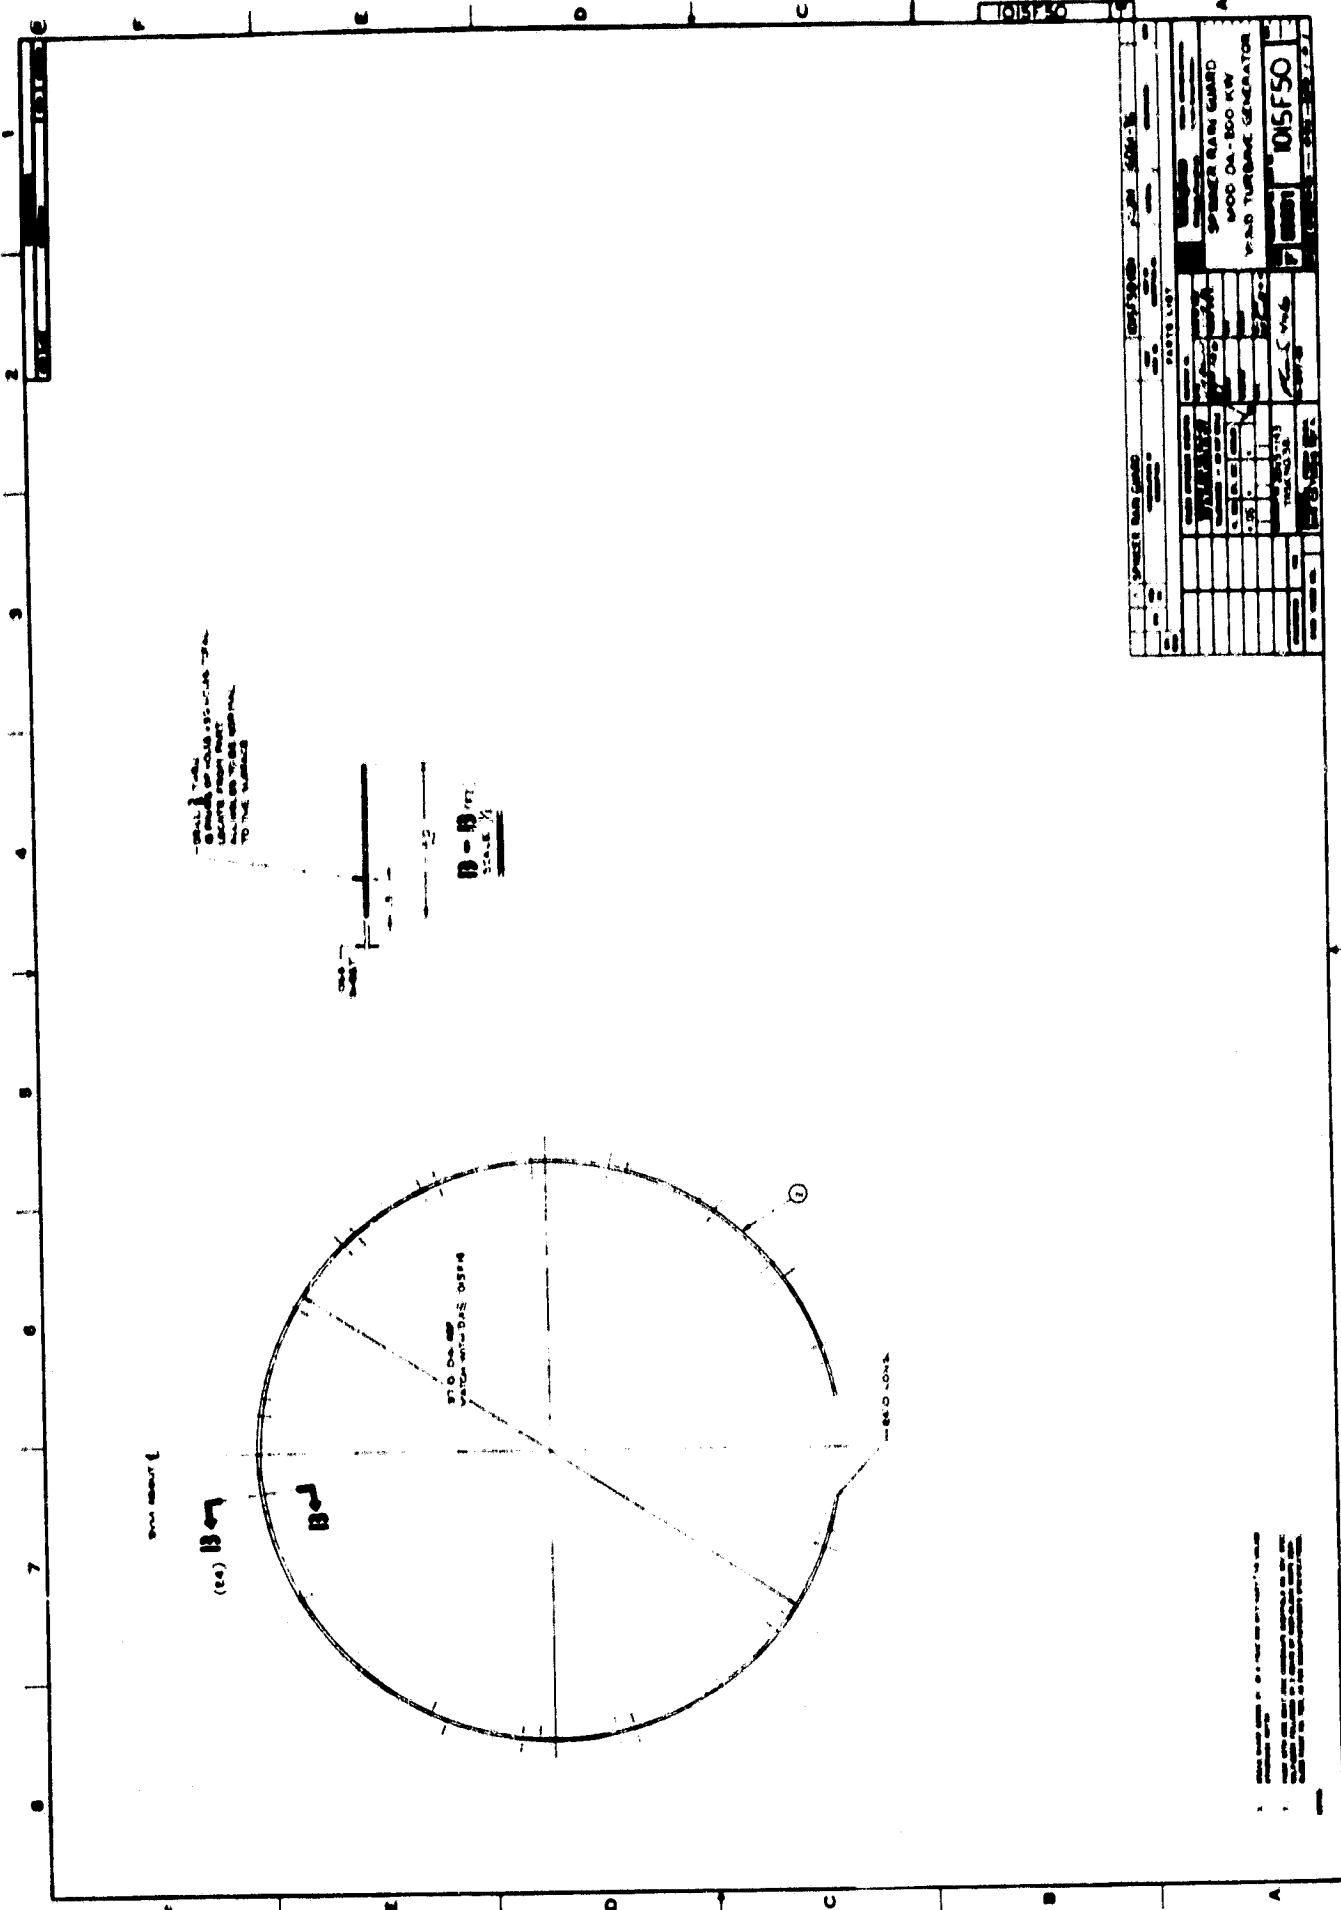


4	FINISHING	01/01/51	01/01/51	MOUNTING		1015F51	

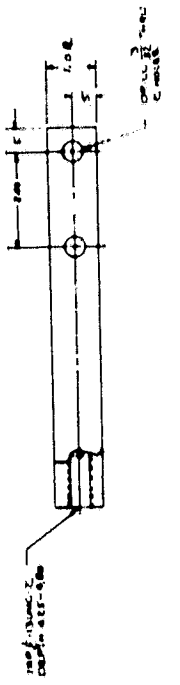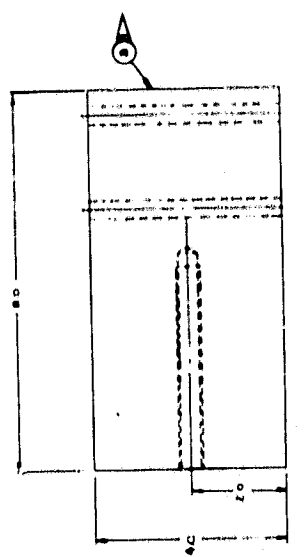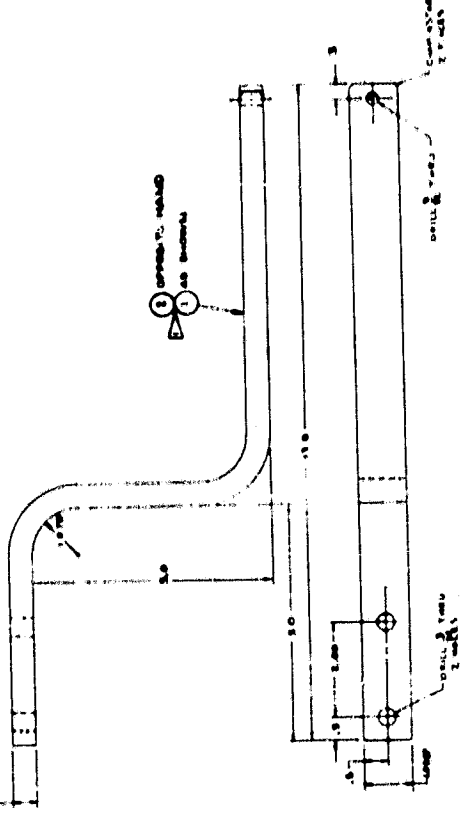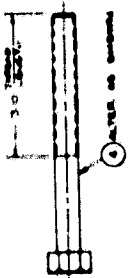

MADE IN U.S.A.
ALL DIMENSIONS IN INCHES
UNLESS OTHERWISE SPECIFIED












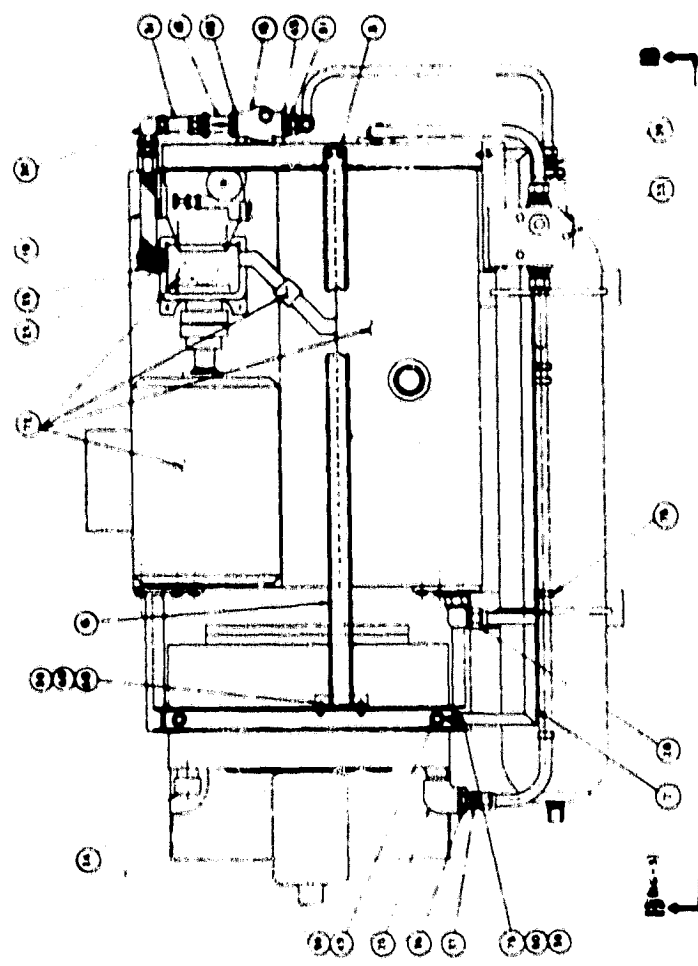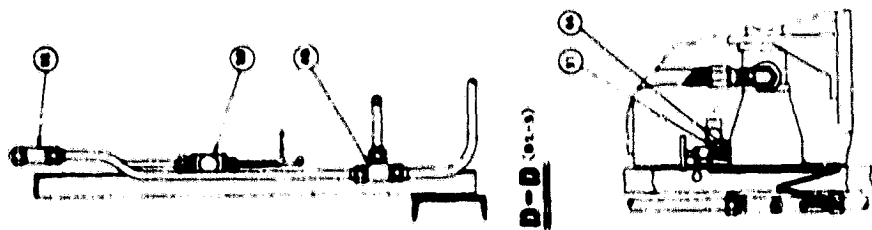

ORIGINAL PAGE IS OF POOR QUALITY

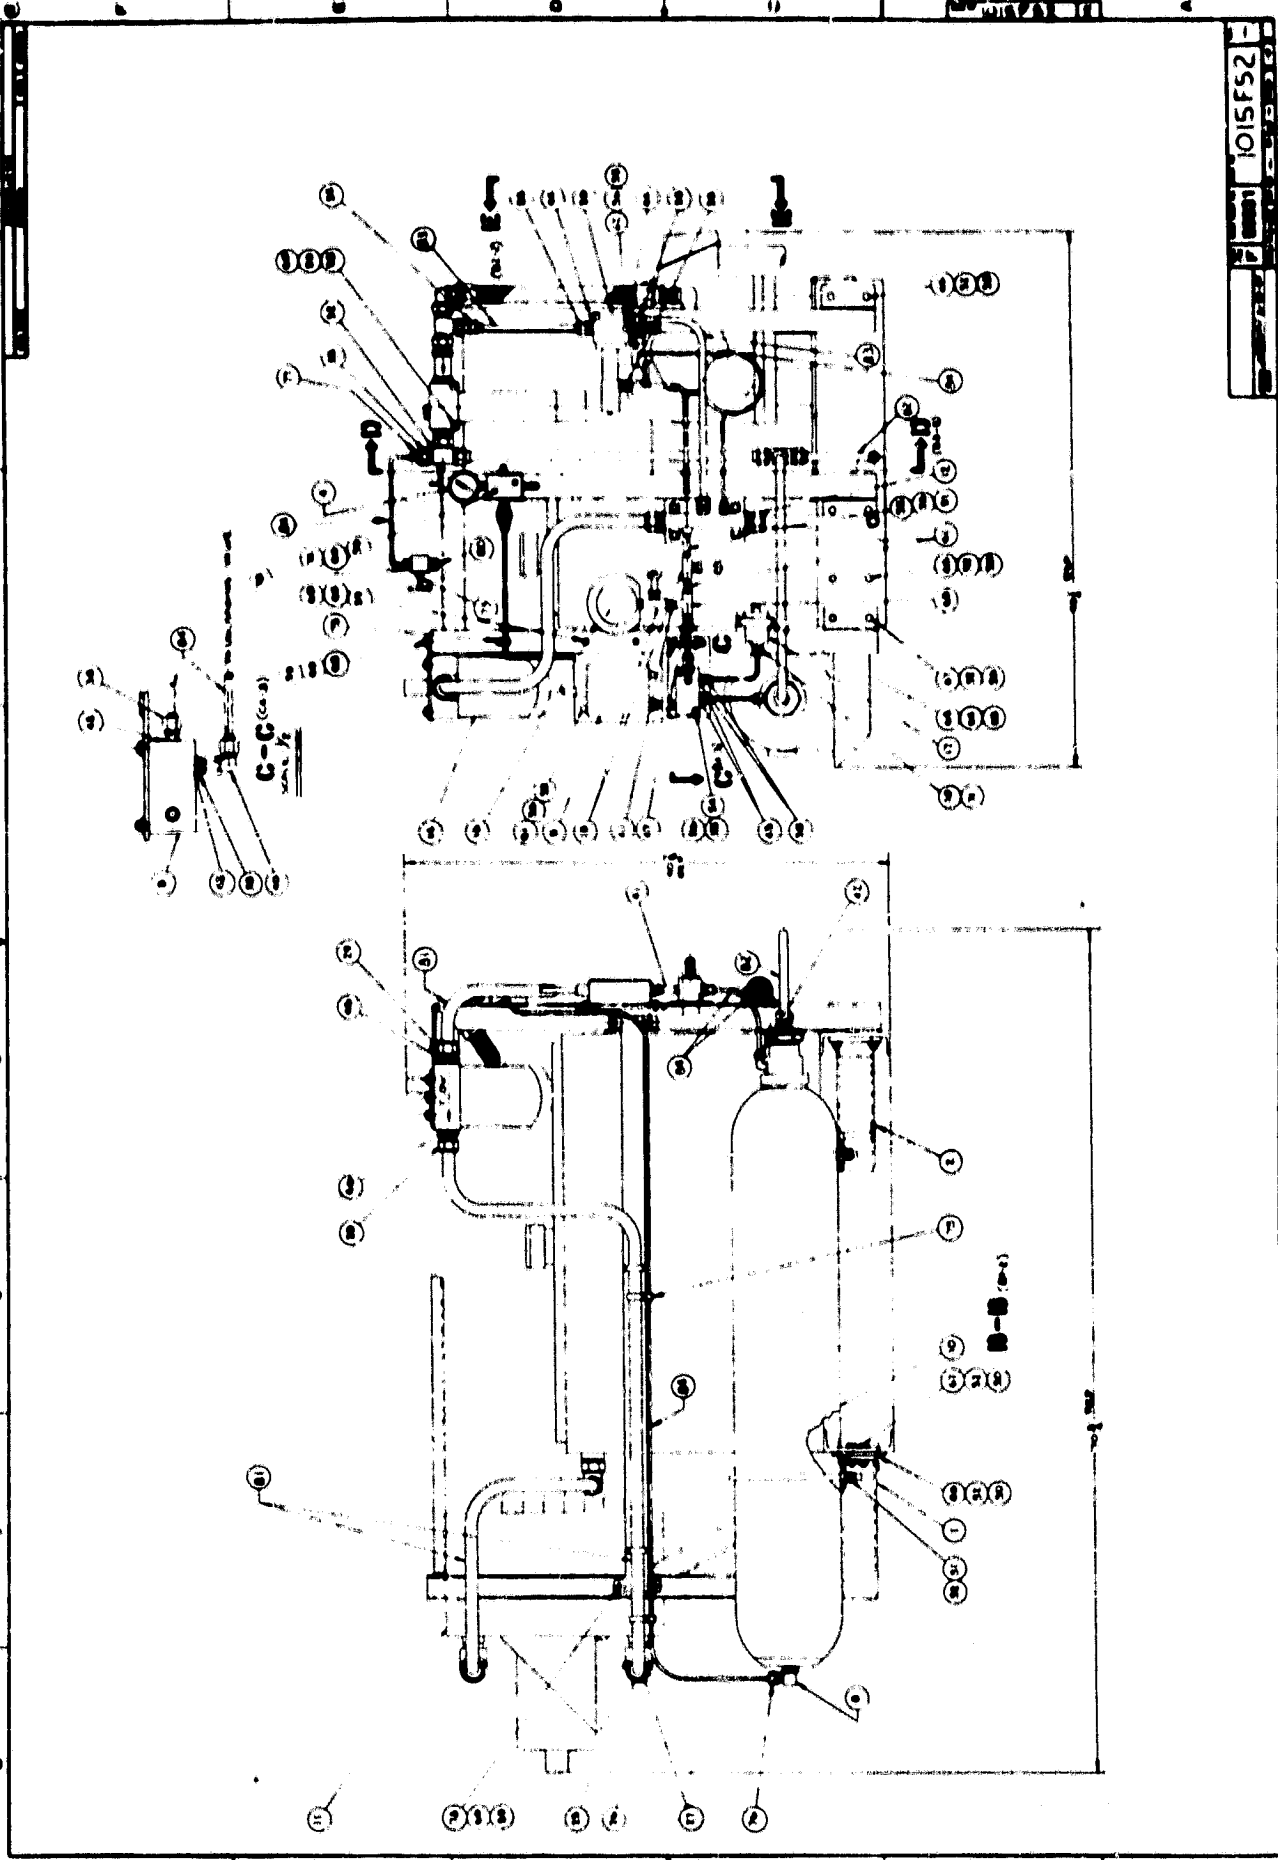

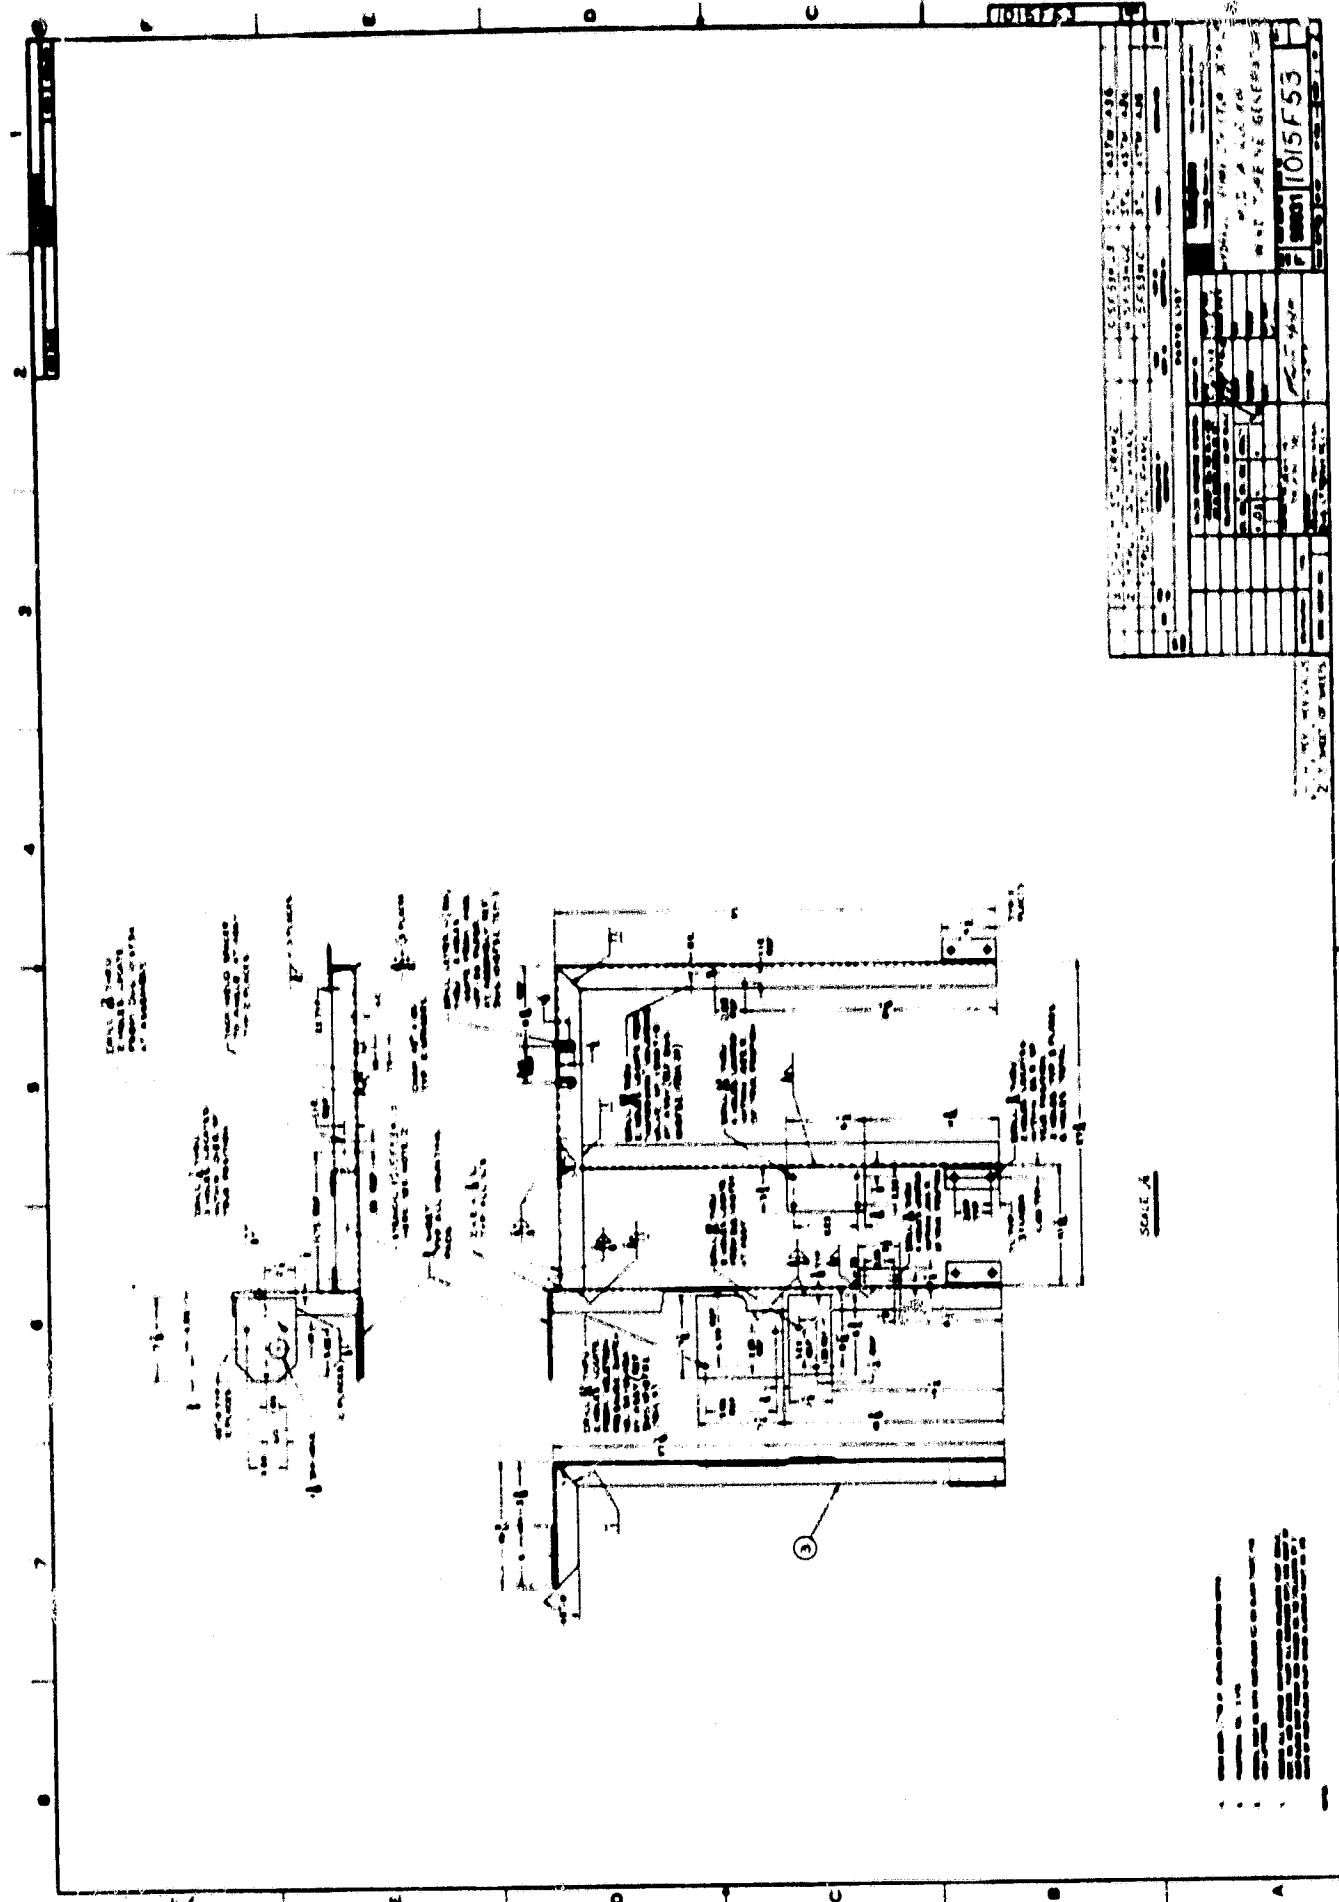


SCALE A


NOT TO SCALE

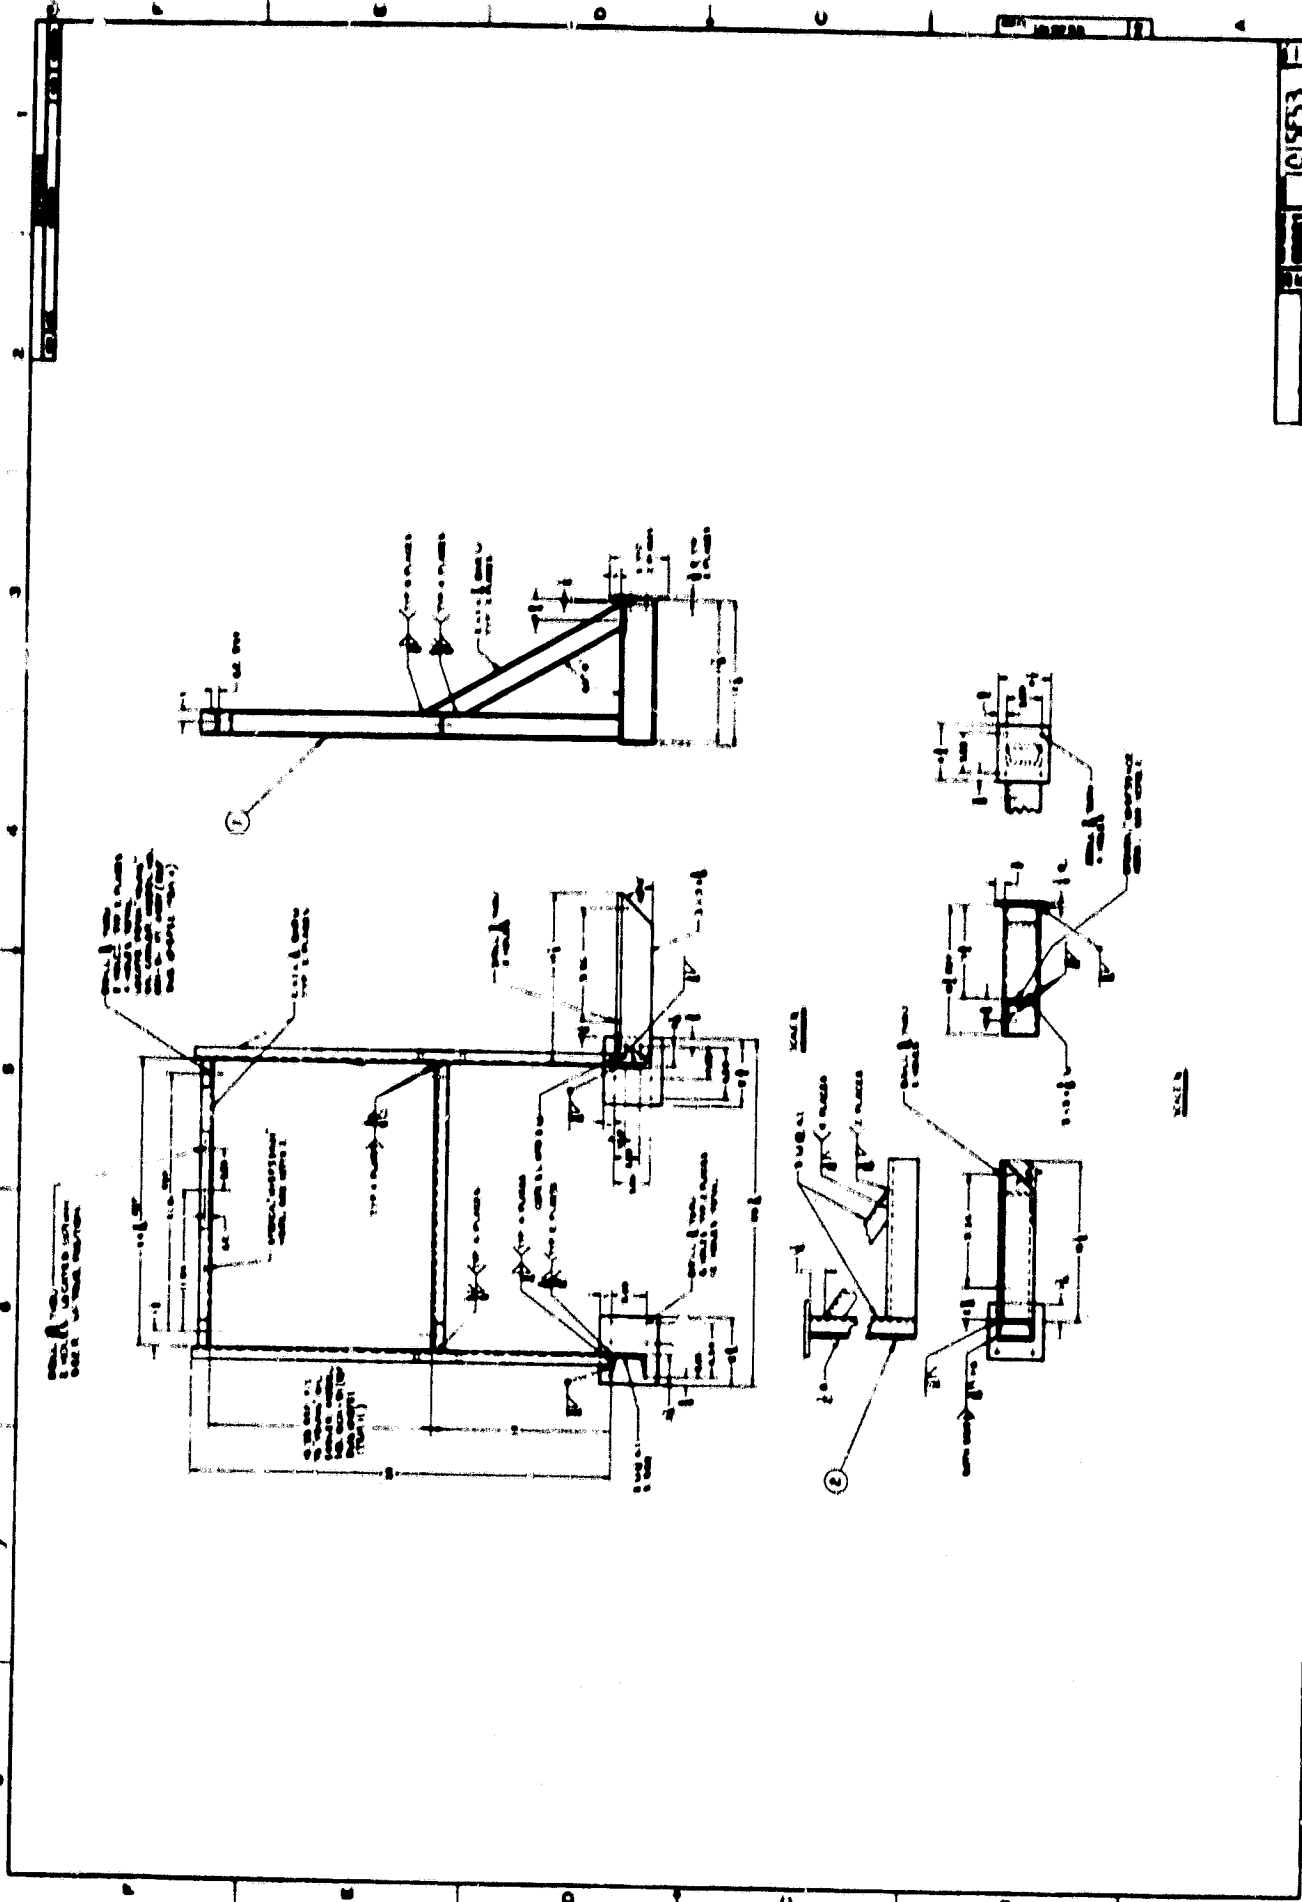

1015754

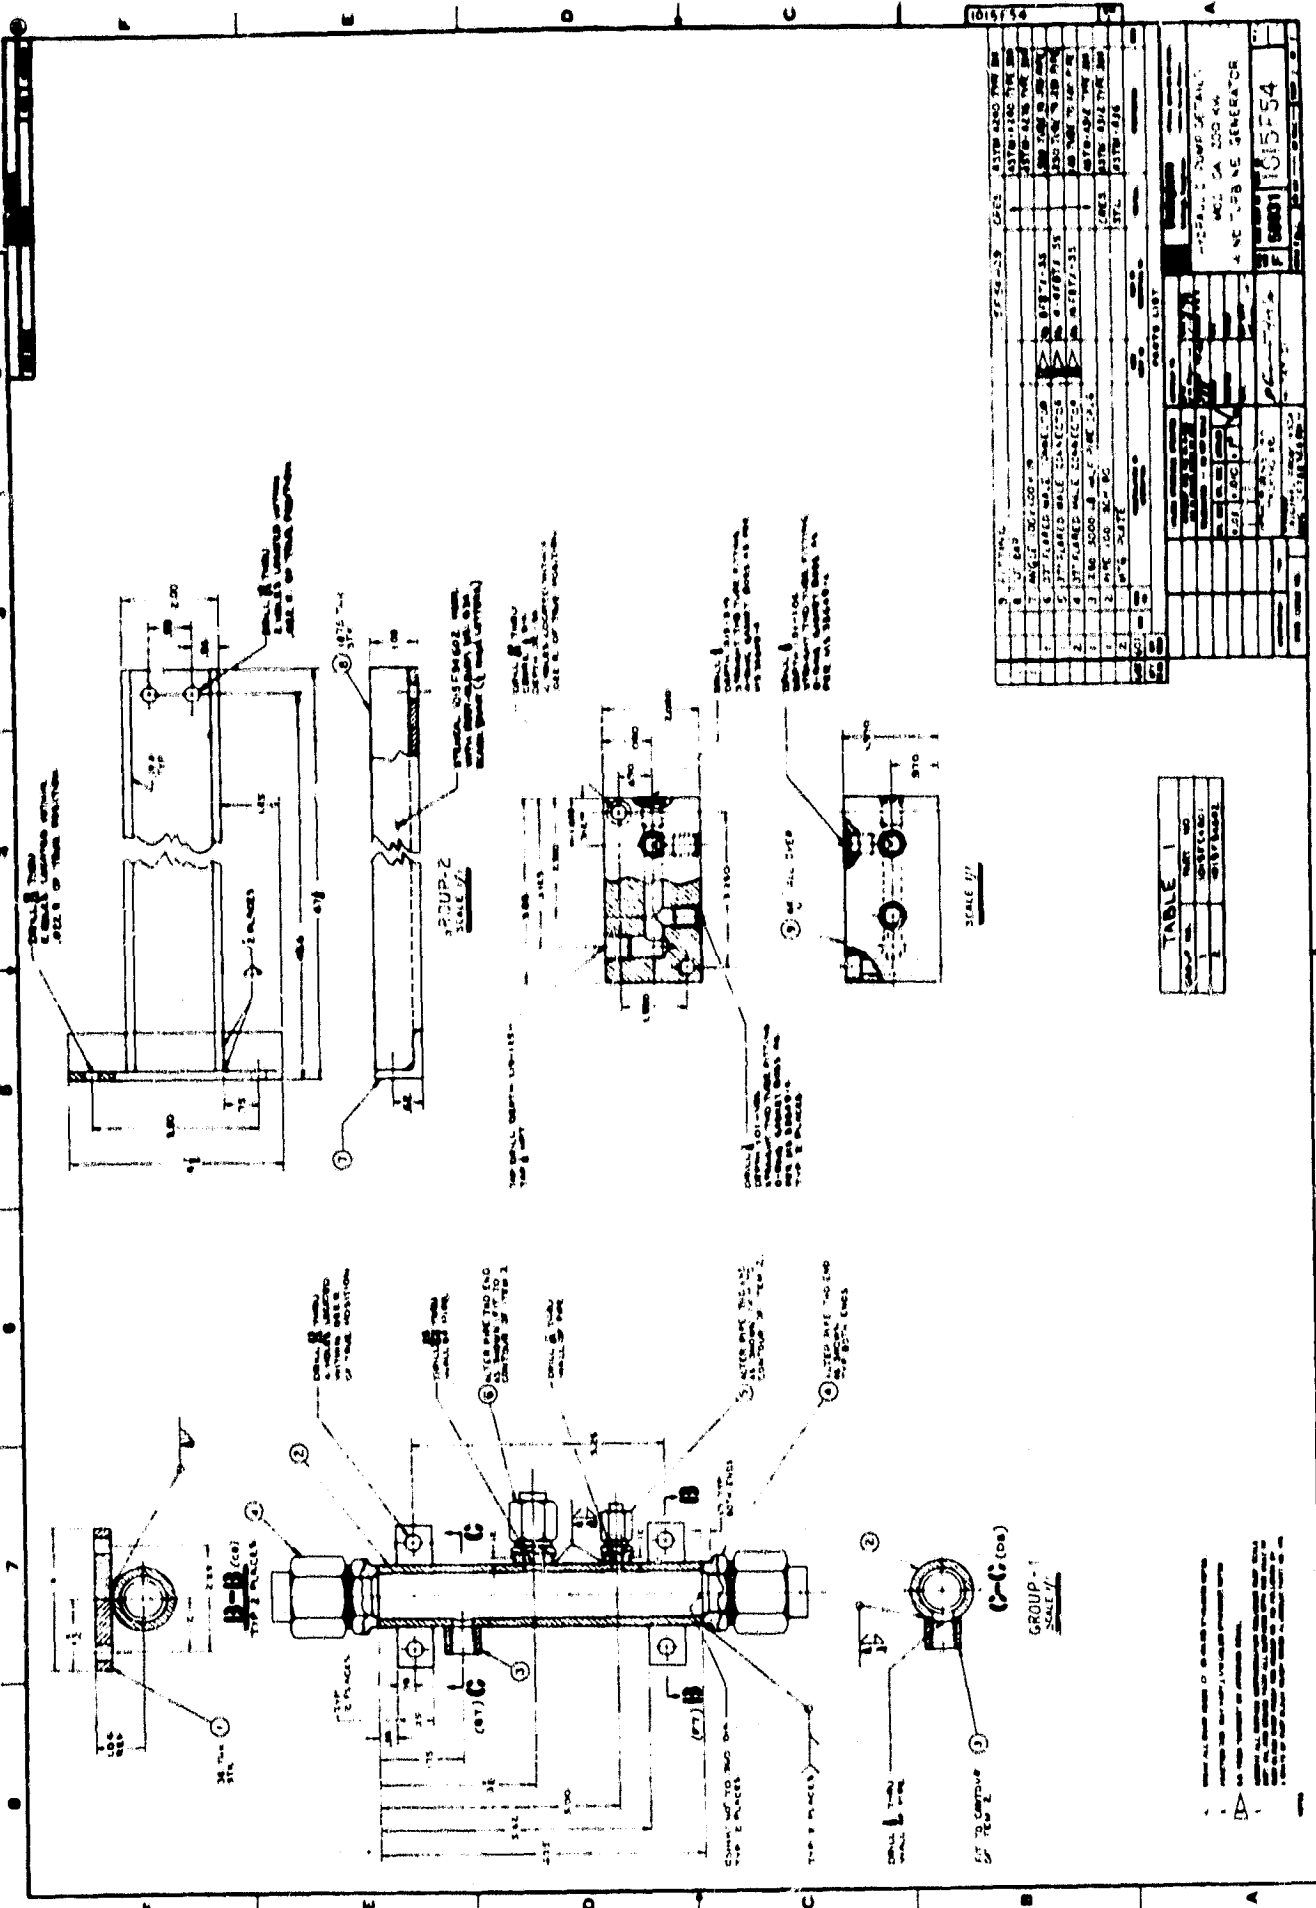



TABLE 1
GROUP NO.
REV.
DATE
BY
CHECKED
APPROVED

1015754

GROUP-1
 SCALE 1/2"

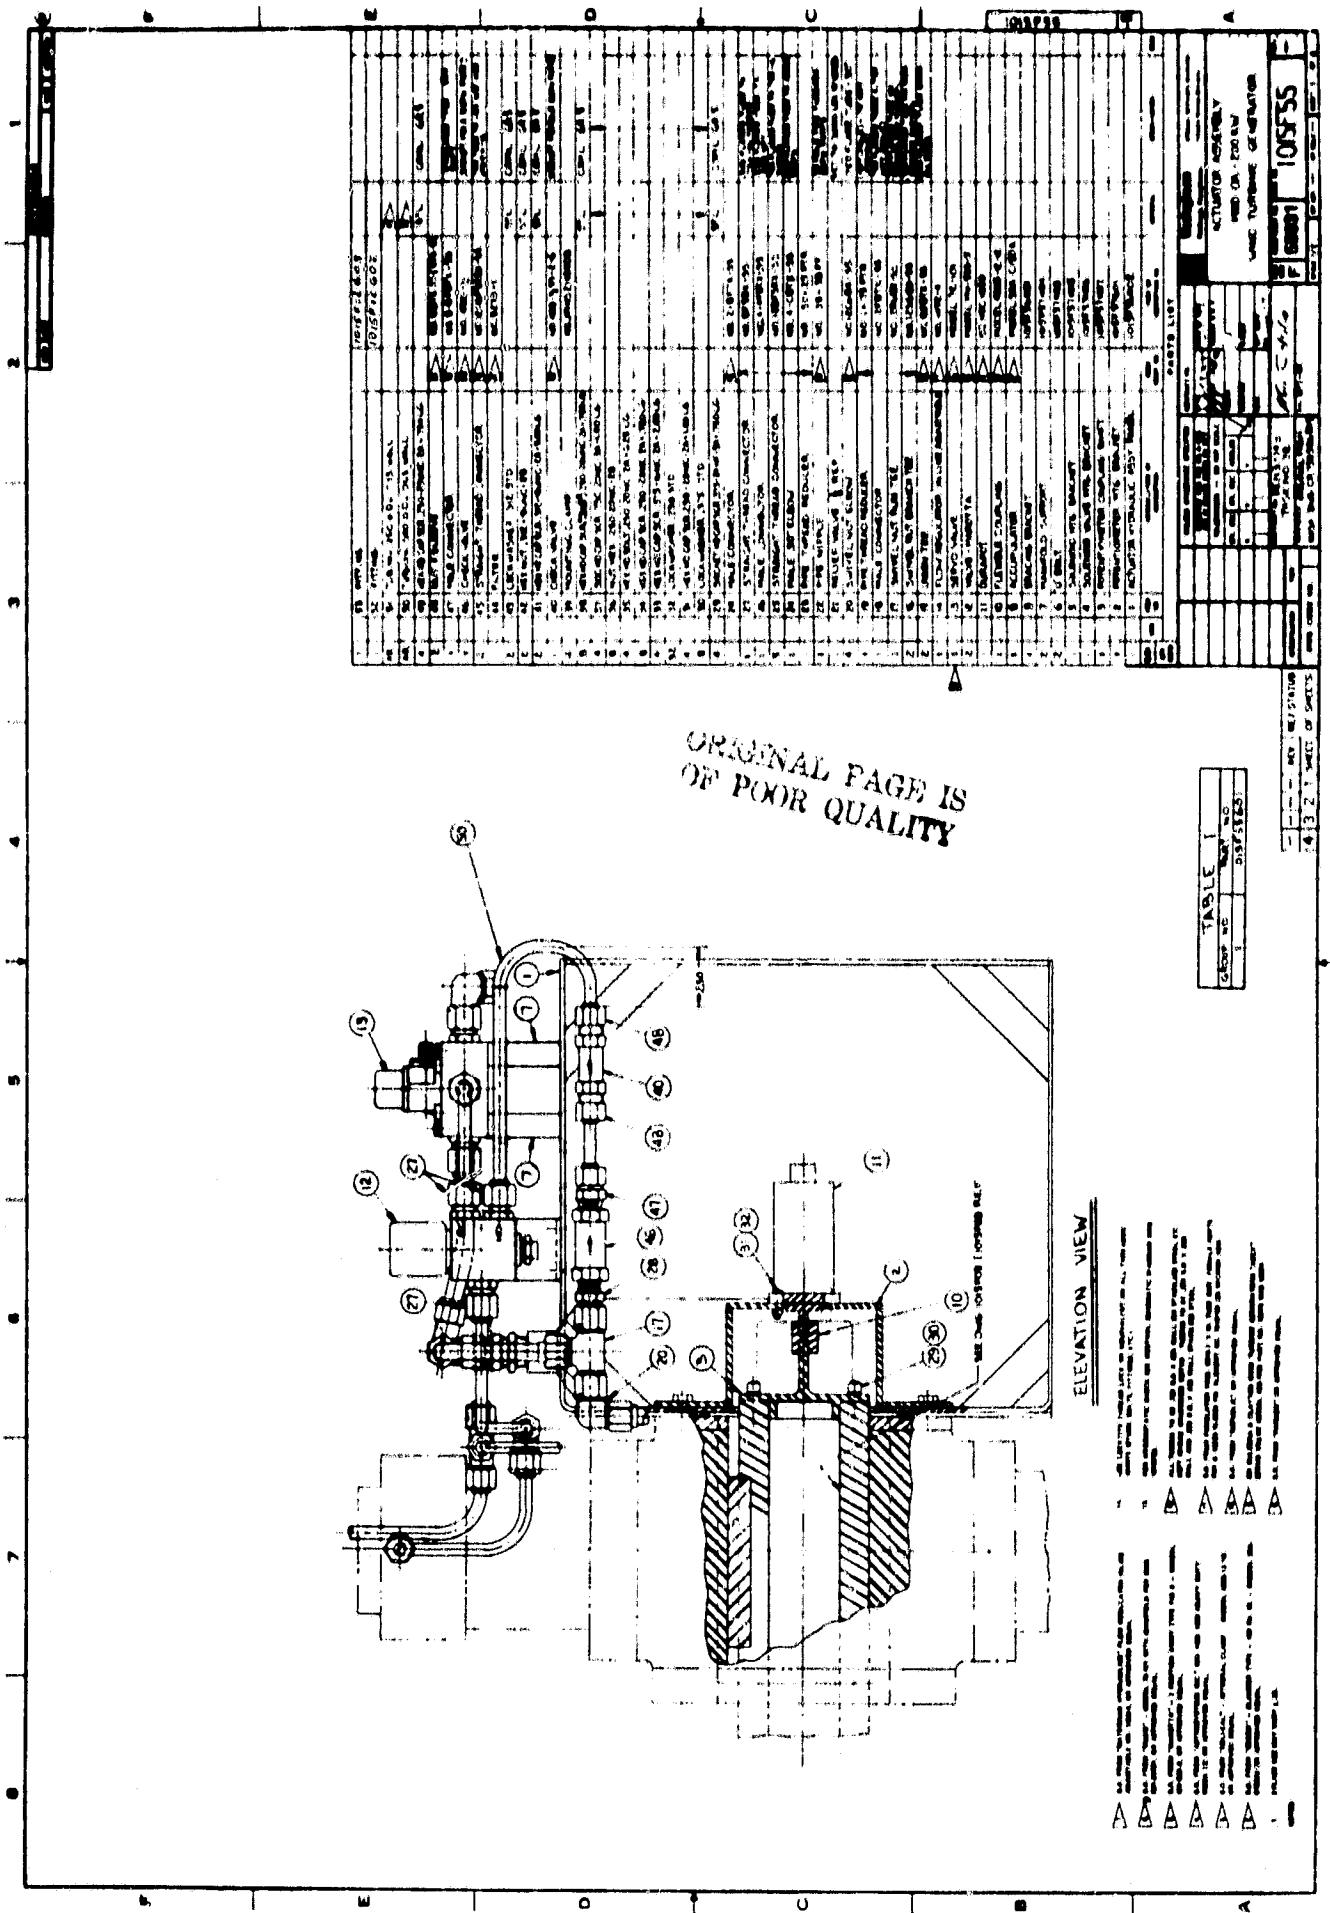

ORIGINAL PAGE IS
OF POOR QUALITY

ELEVATION VIEW


- ▲ ALL DIMENSIONS UNLESS OTHERWISE SPECIFIED ARE IN INCHES

GROUP NO.	TABLE NO.	REV. NO.	DATE
1	1		




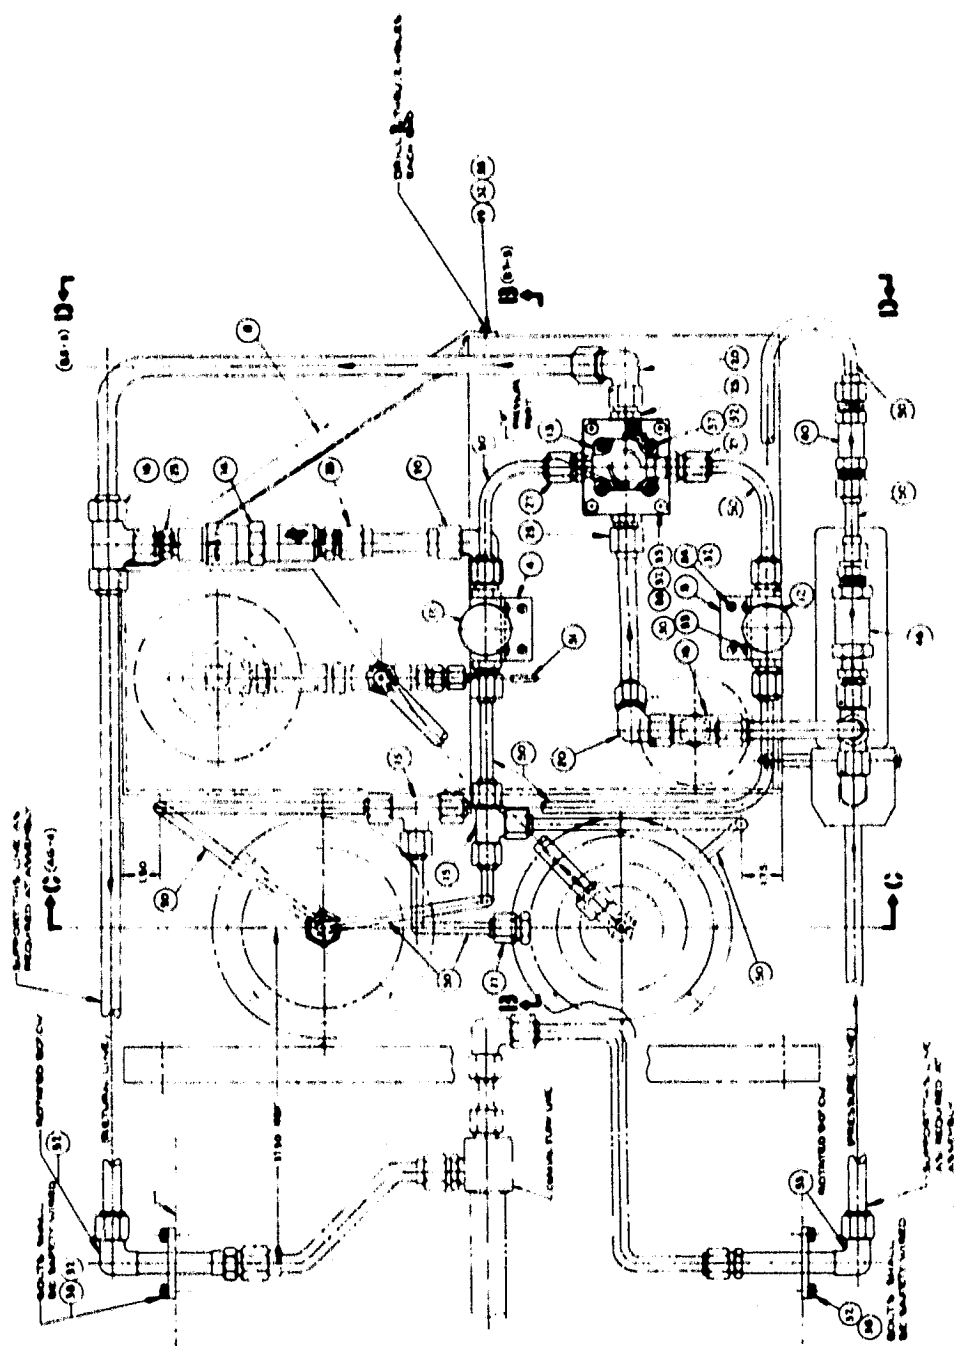


PLAN VIEW

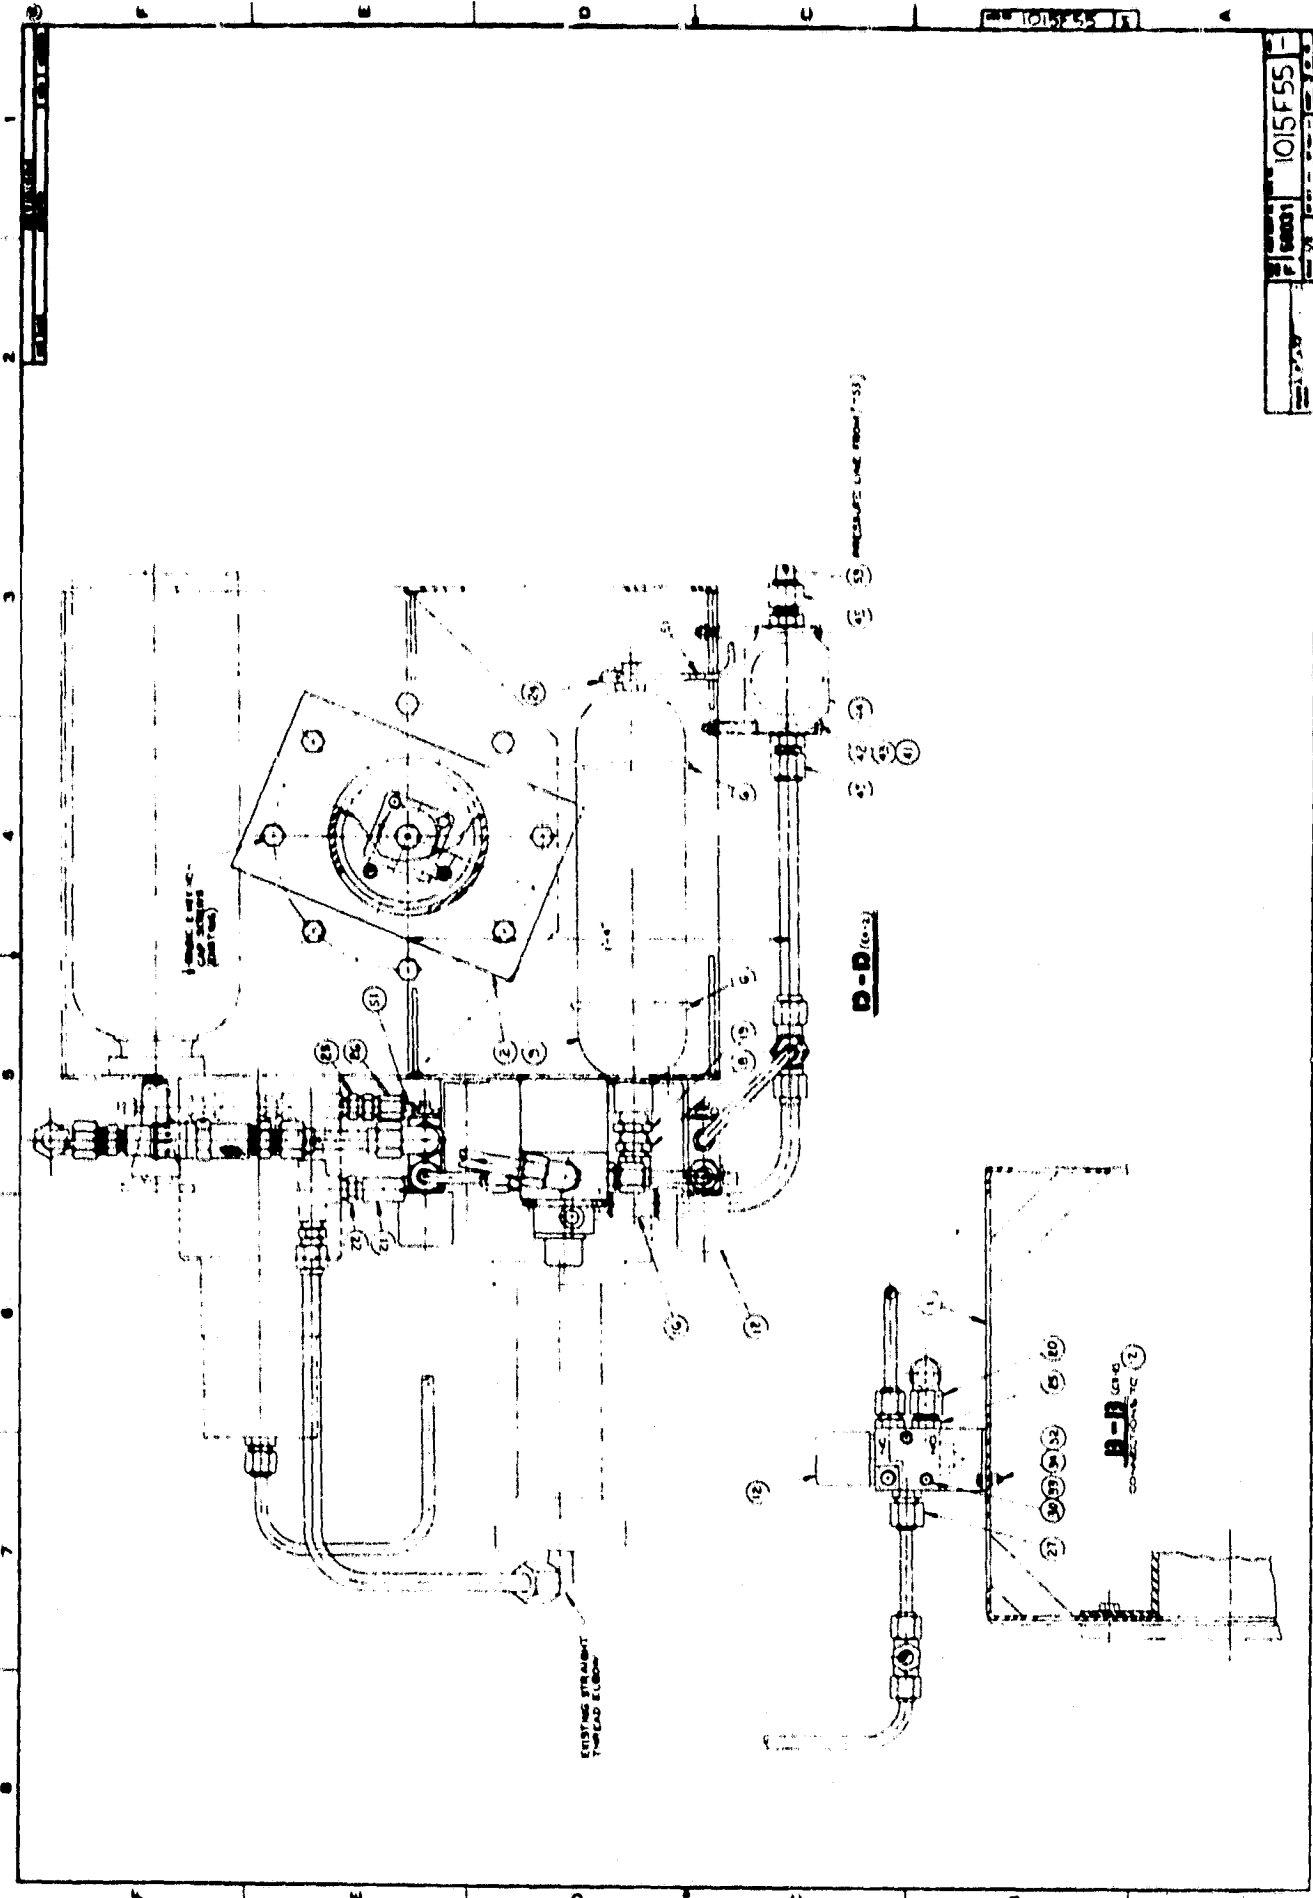

1015-55



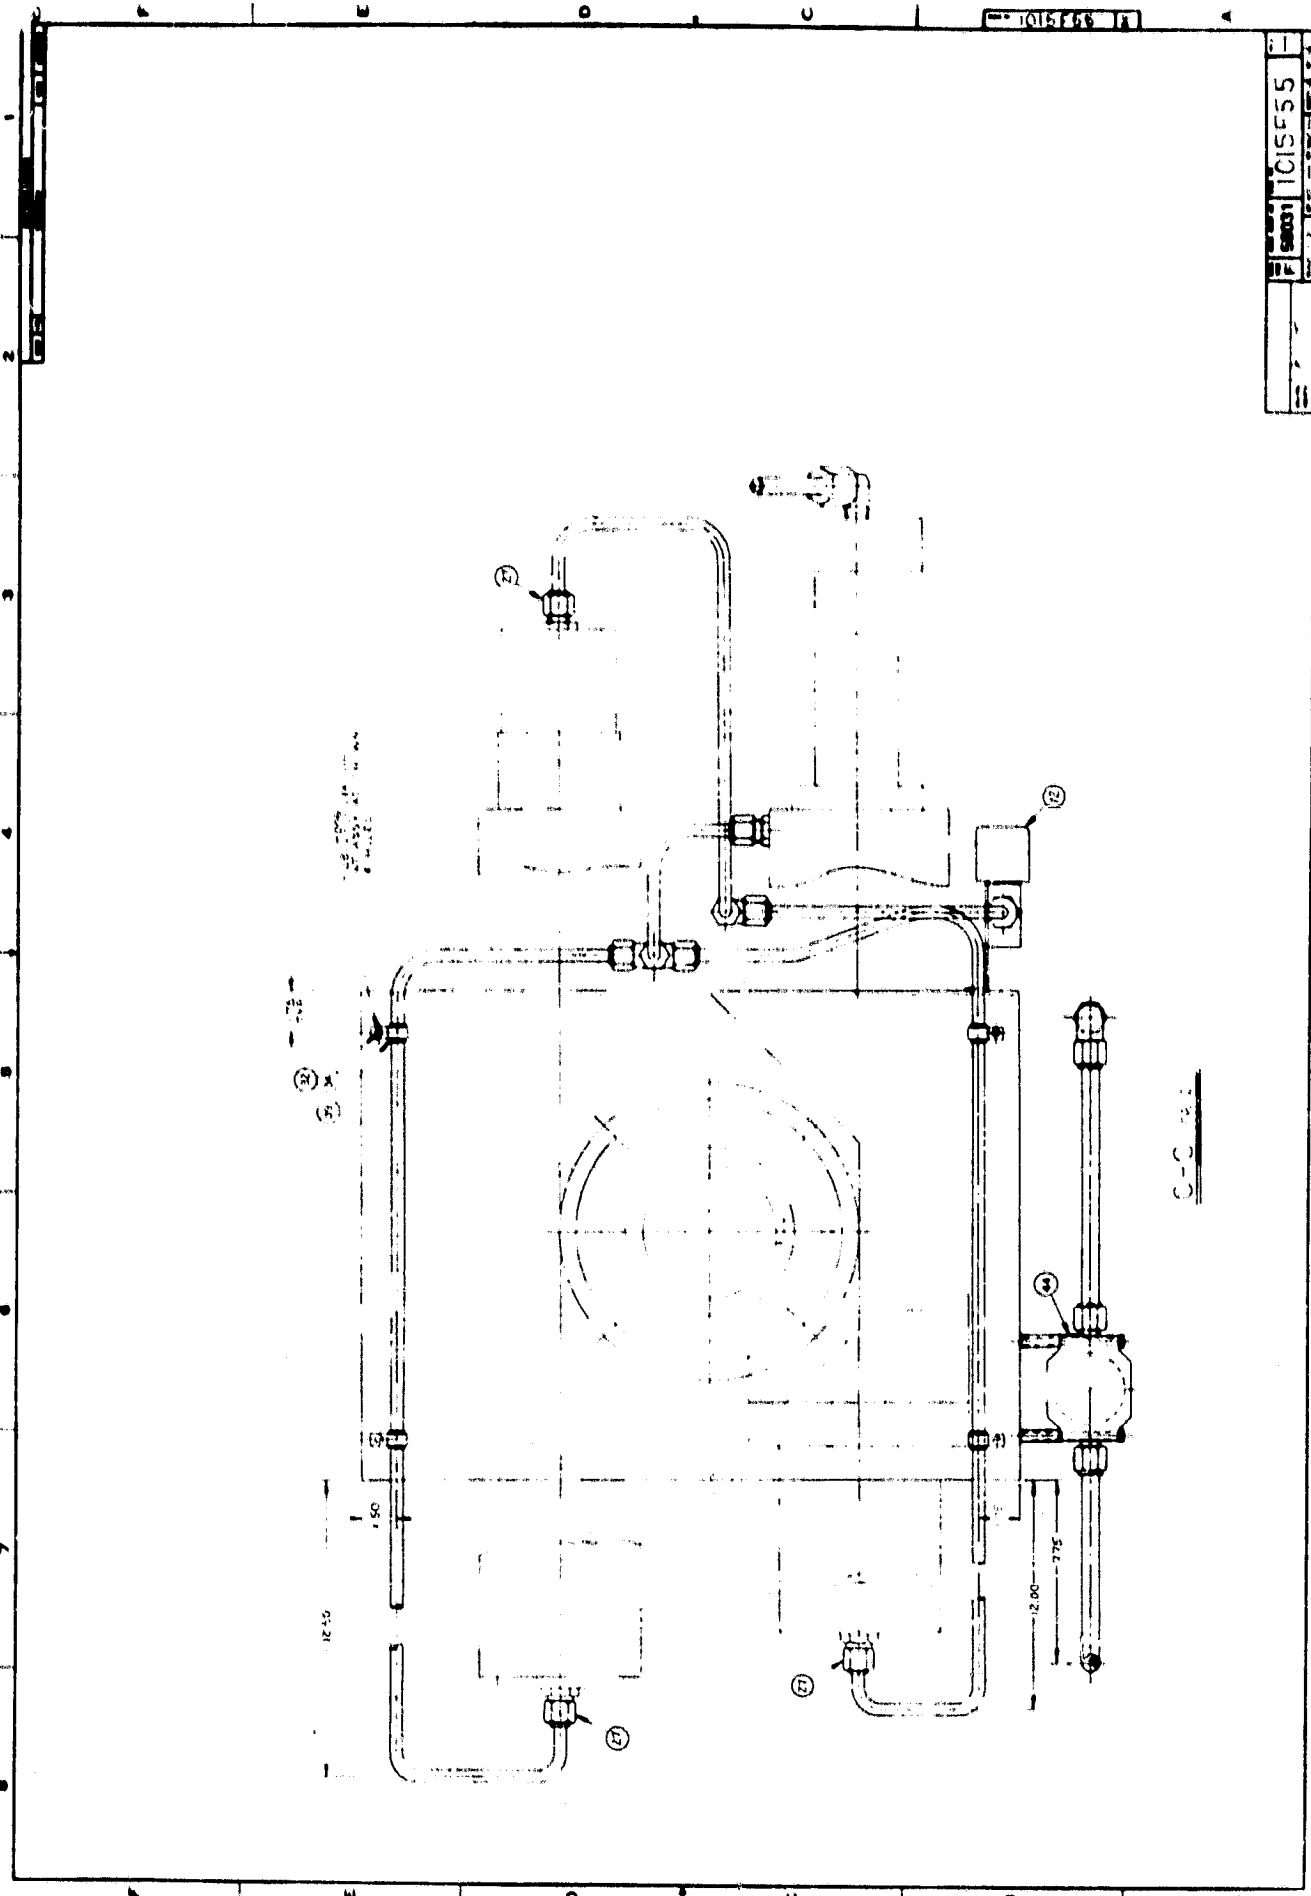


C-C



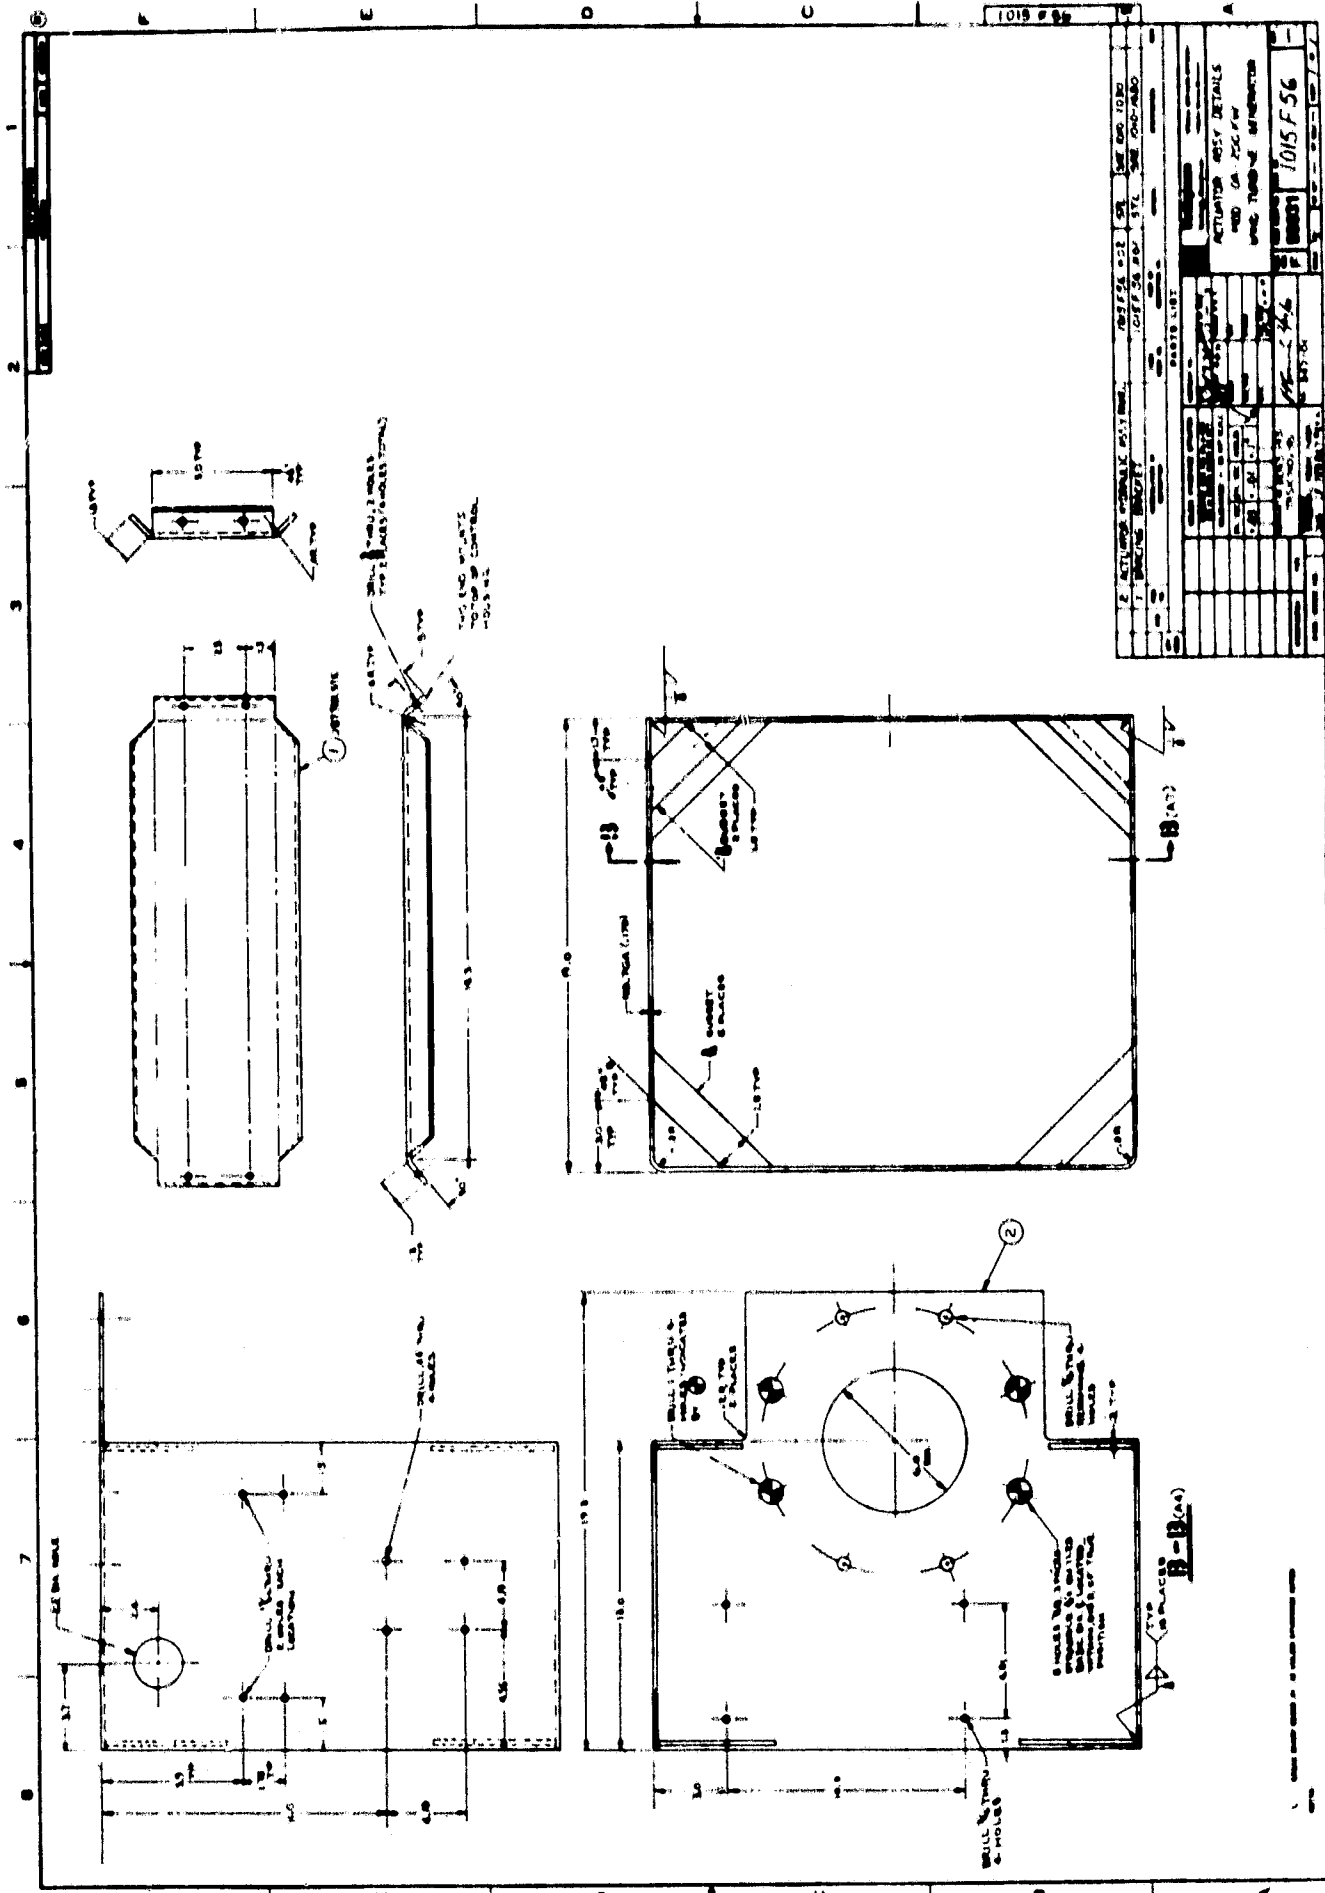

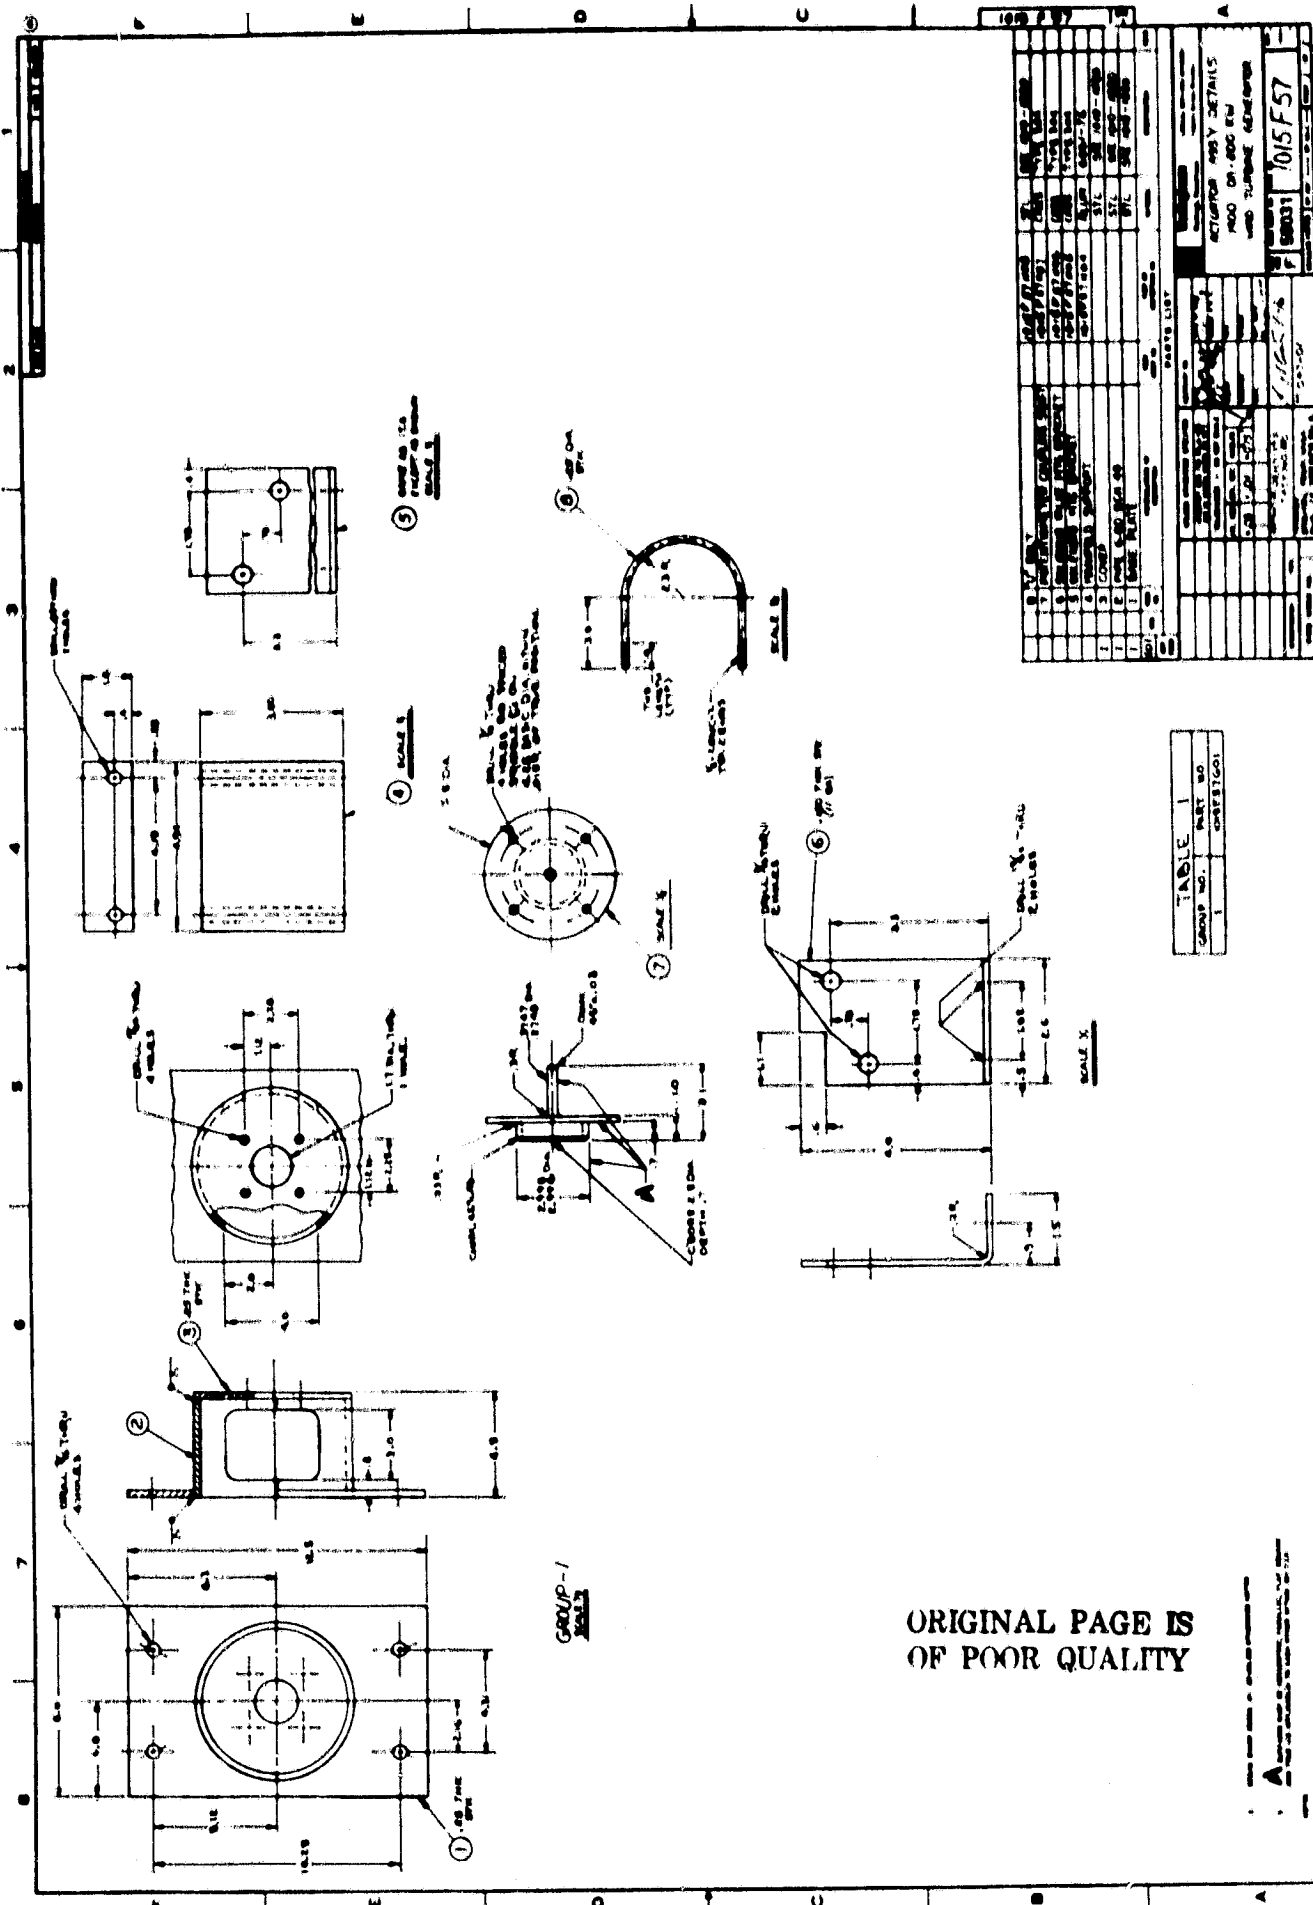





PROJECT	ACTUATOR ASSEMBLY DETAILS
DRAWING NO.	1015F57

ORIGINAL PAGE IS
OF POOR QUALITY

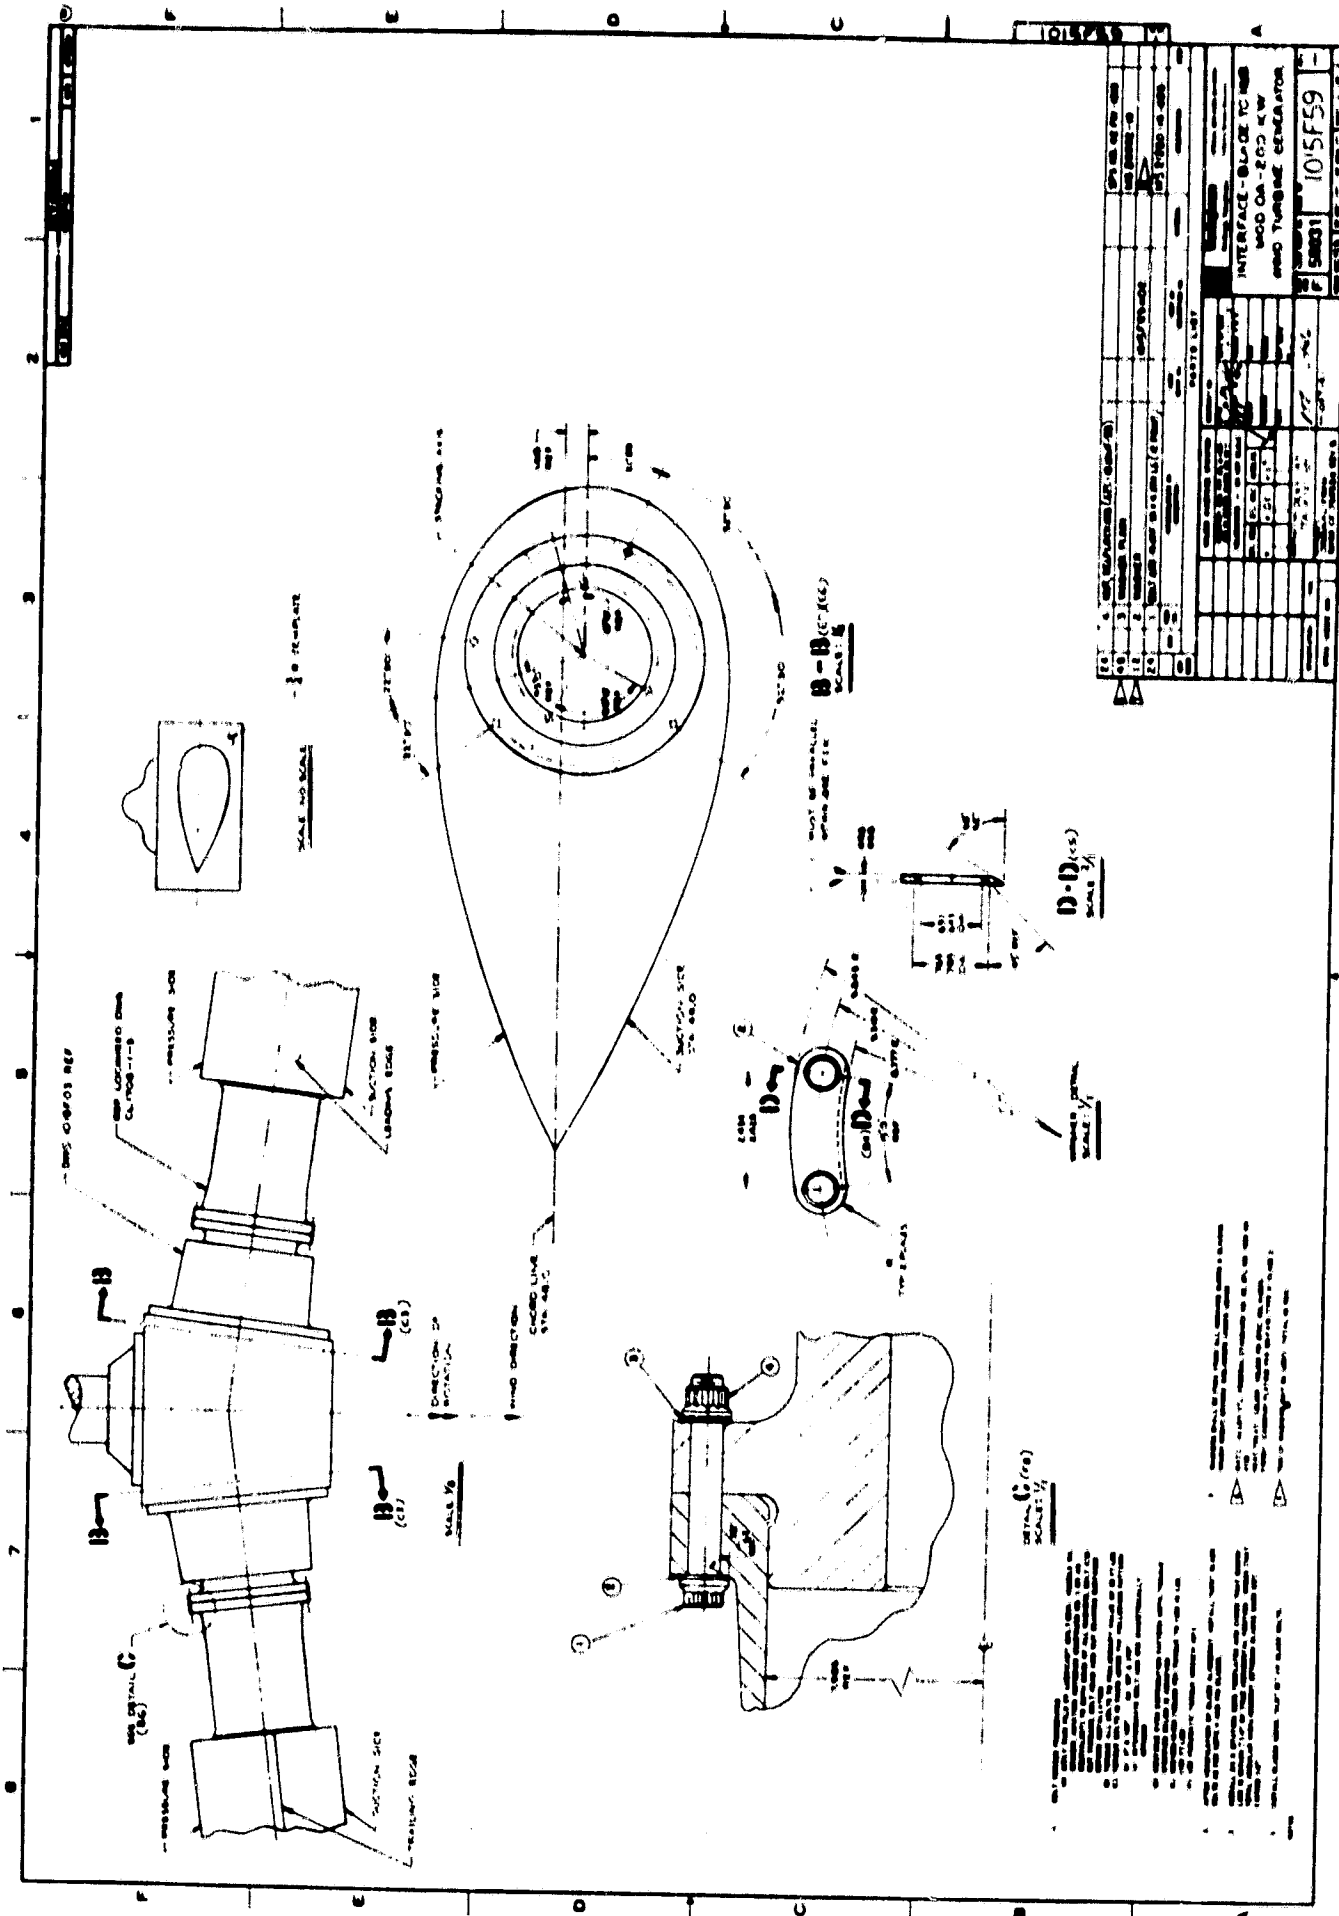

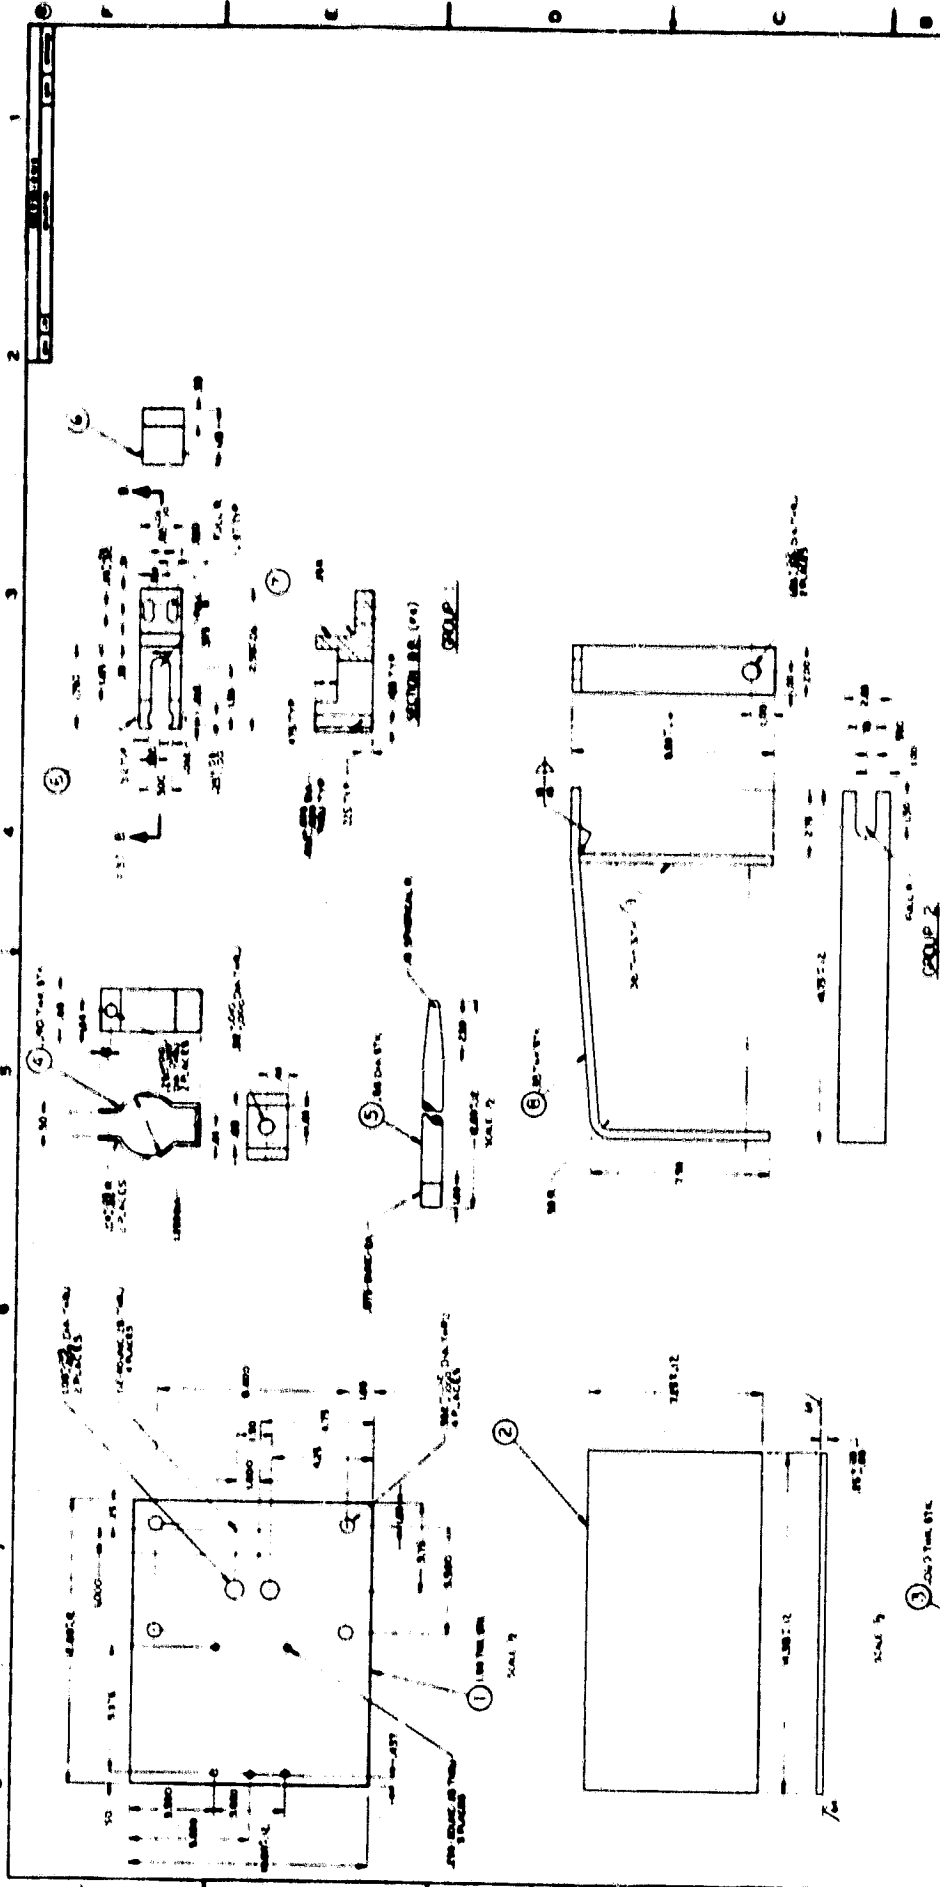





SECTION A-A

1015F60

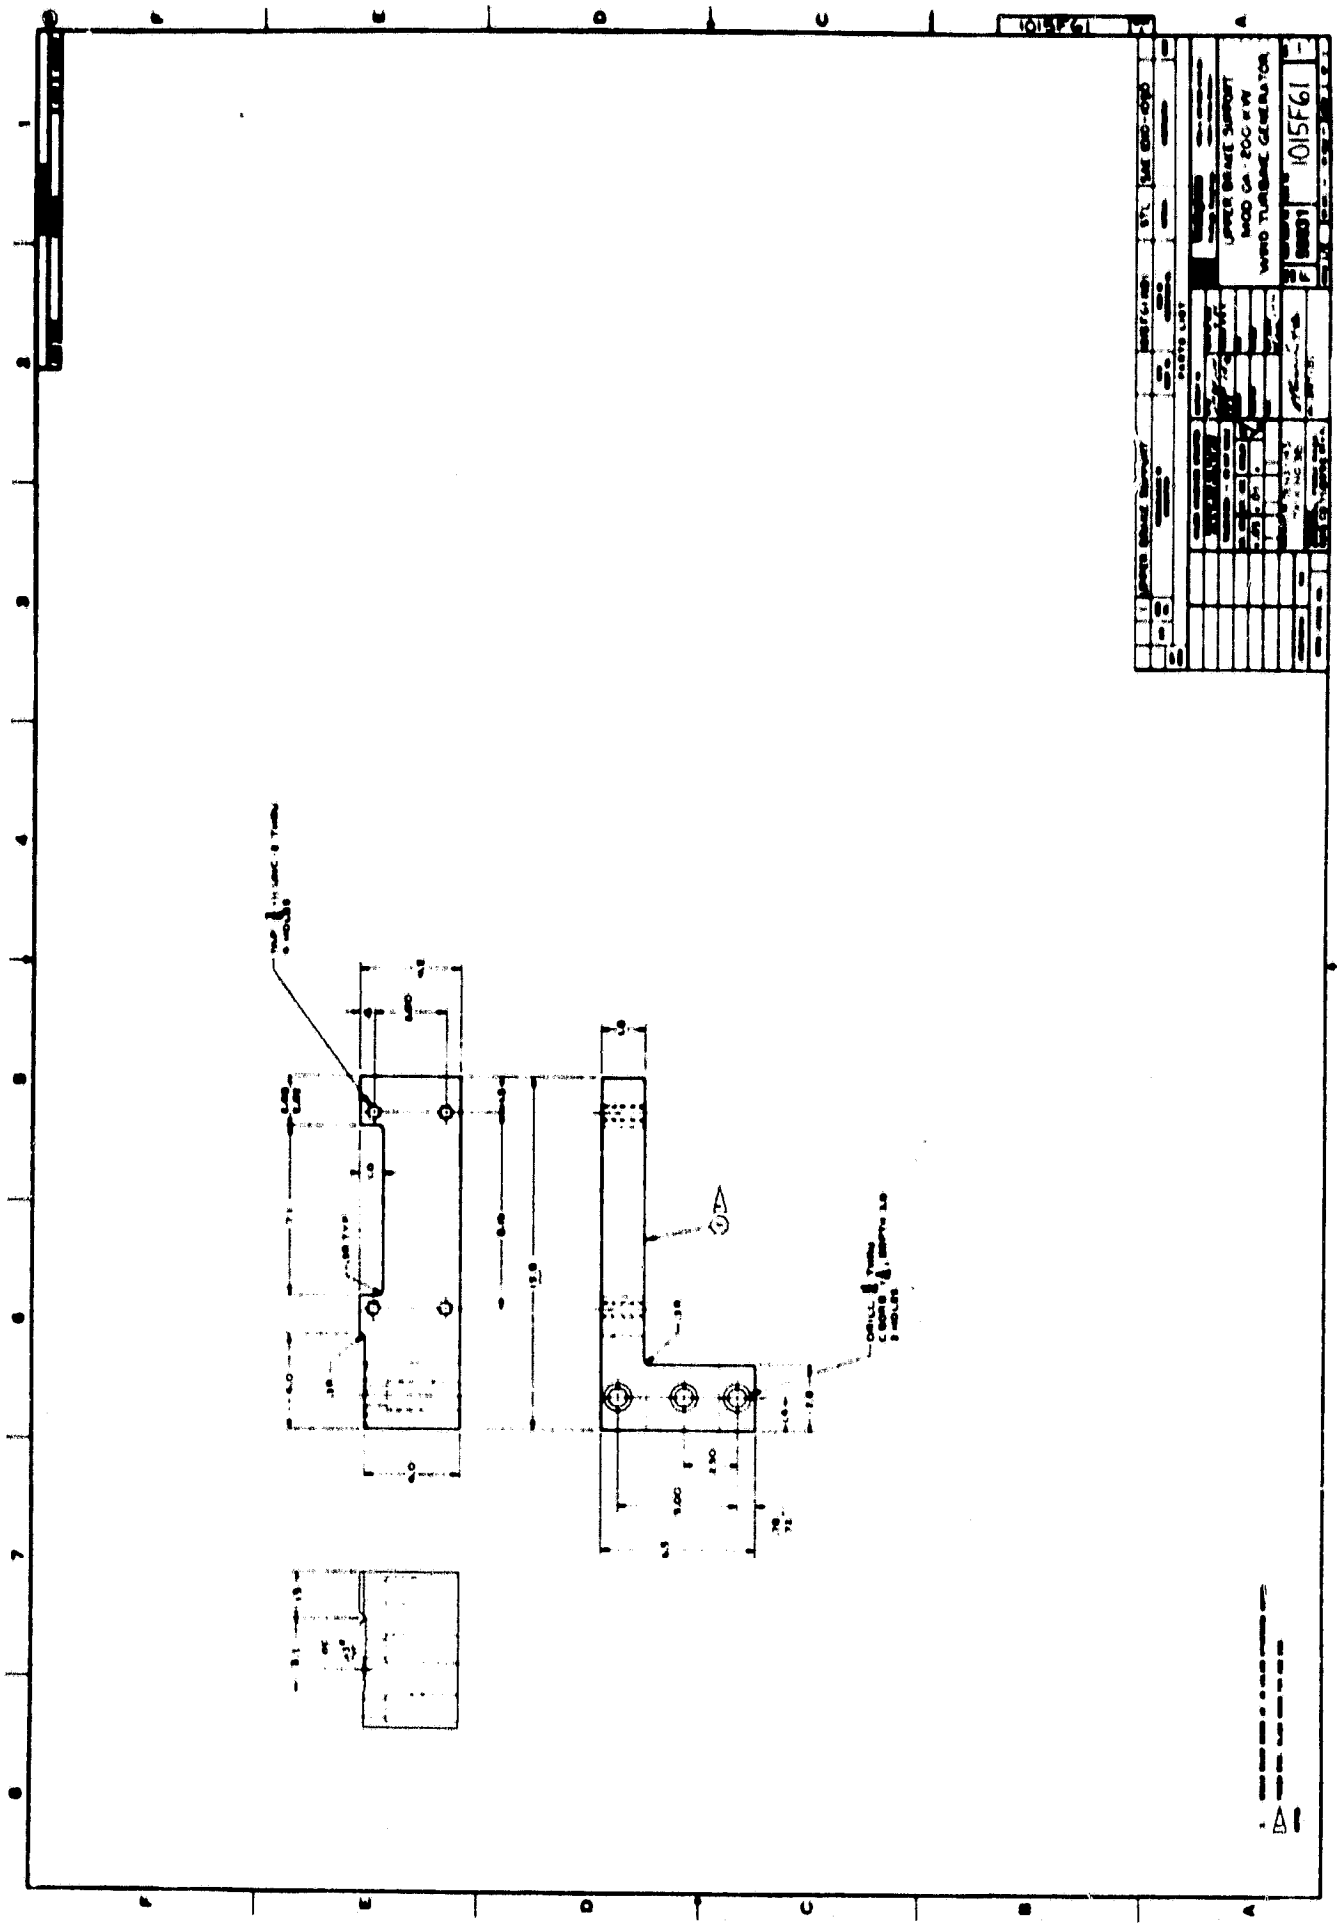


1015F61		REV. DATE	BY	CHKD
UPPER BRACE SUPPORT		NO.	DATE	BY
WIND TURBINE GENERATOR		NO.	DATE	BY
1015F61		NO.	DATE	BY


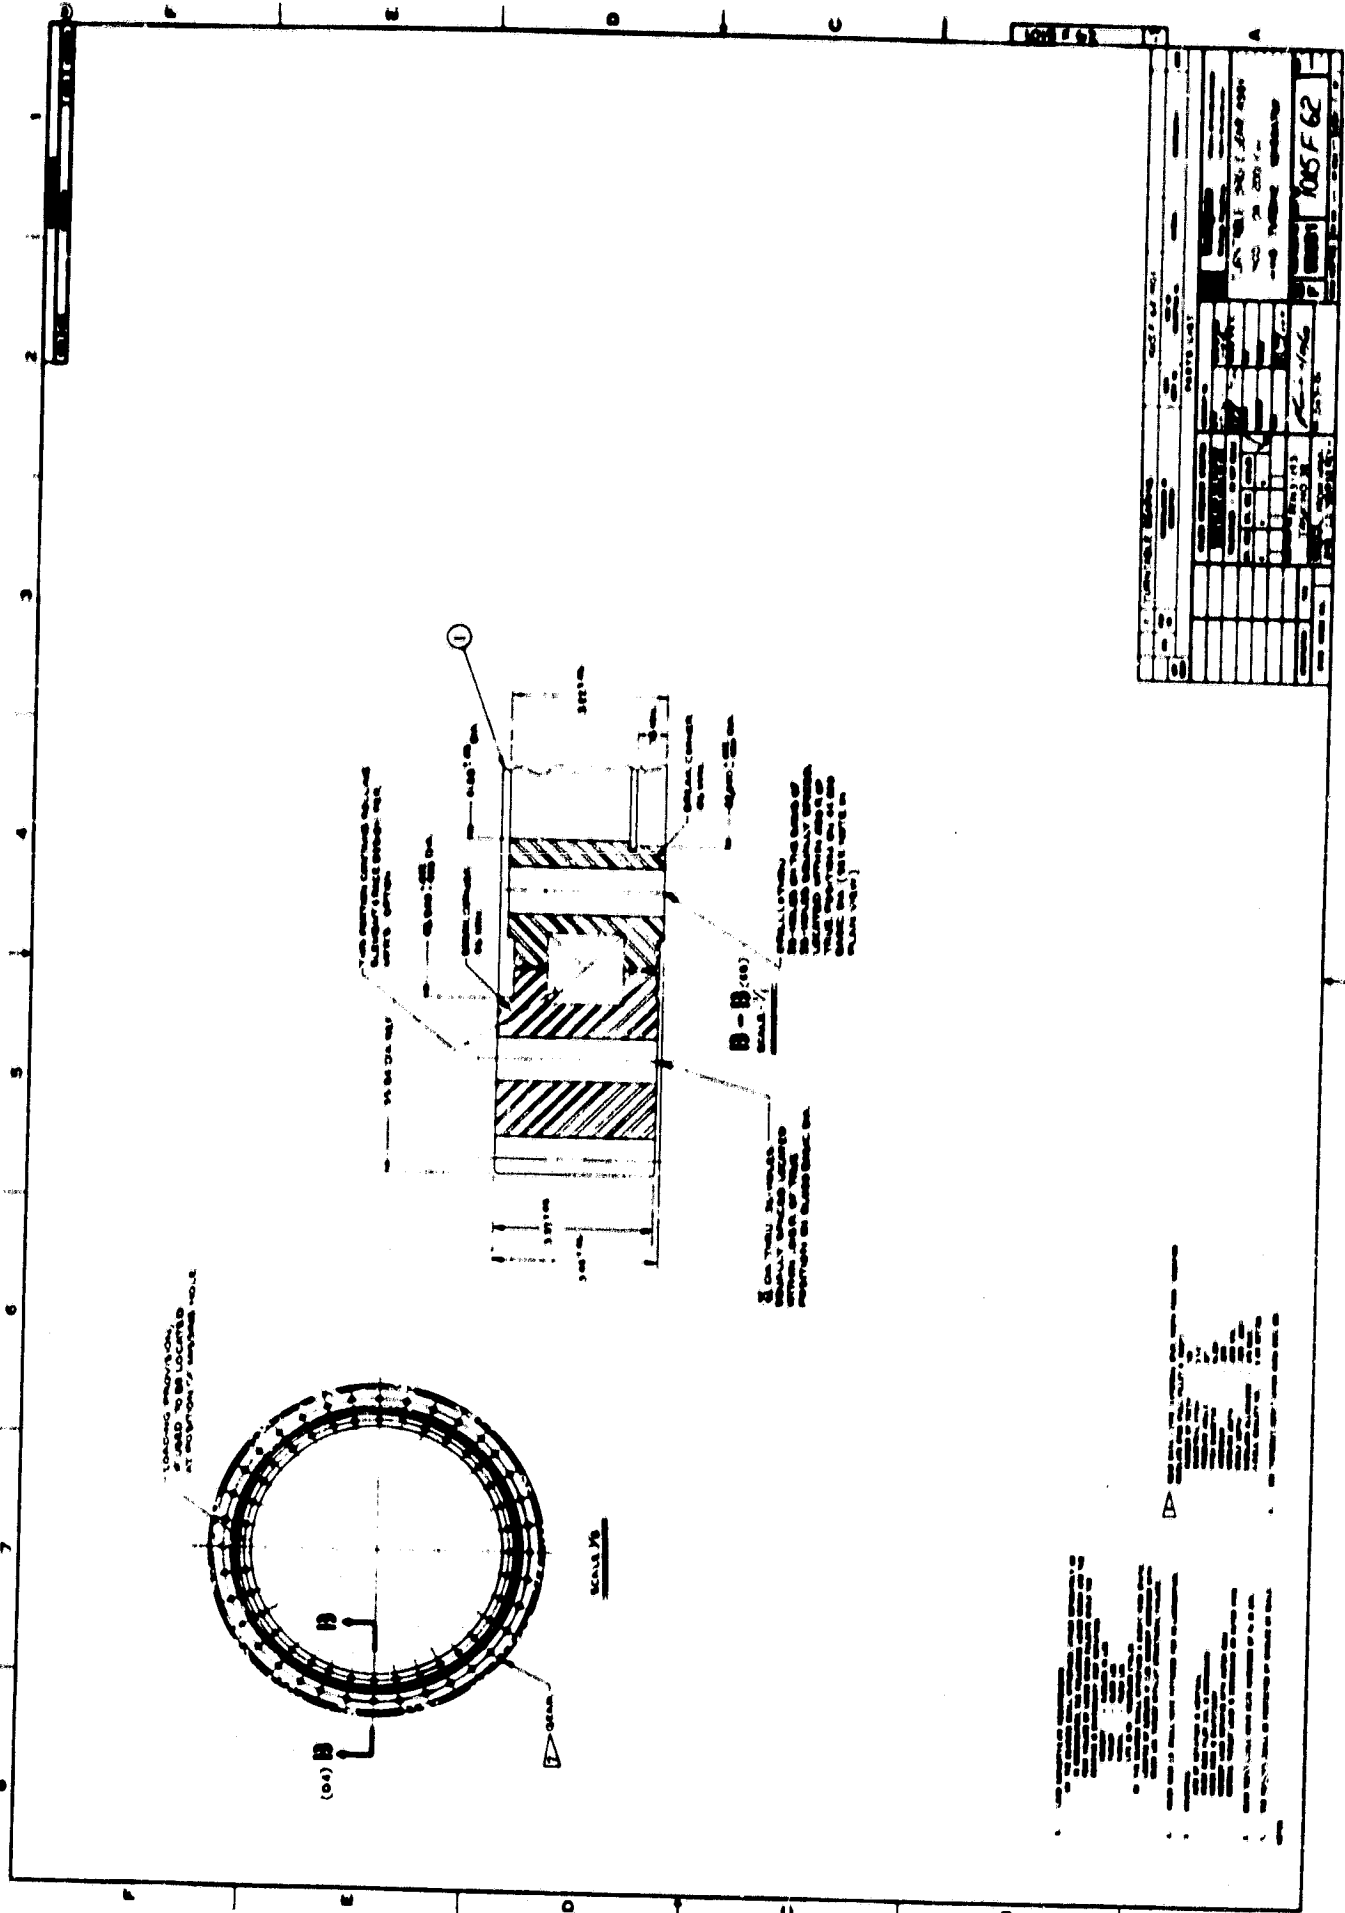




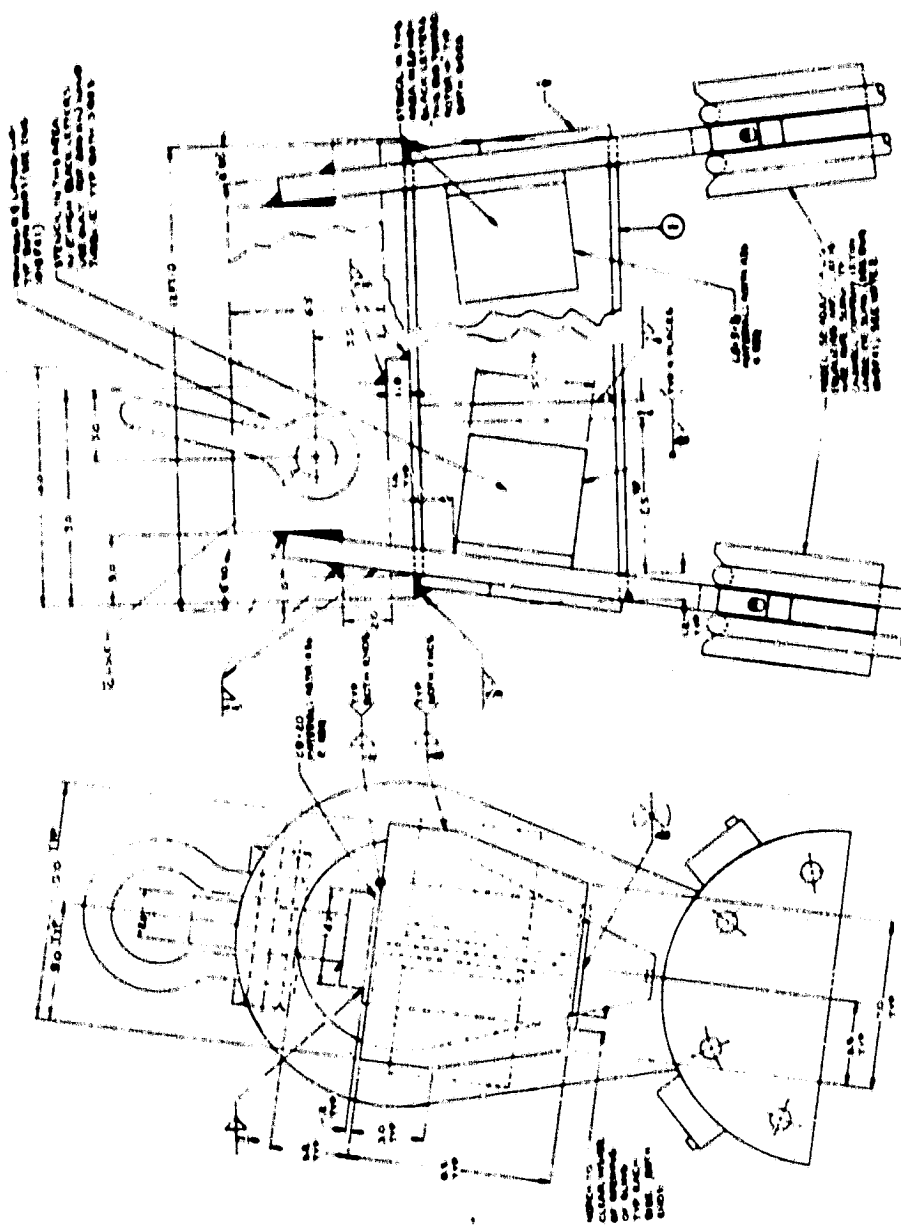



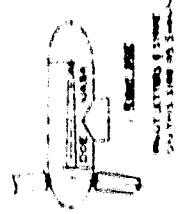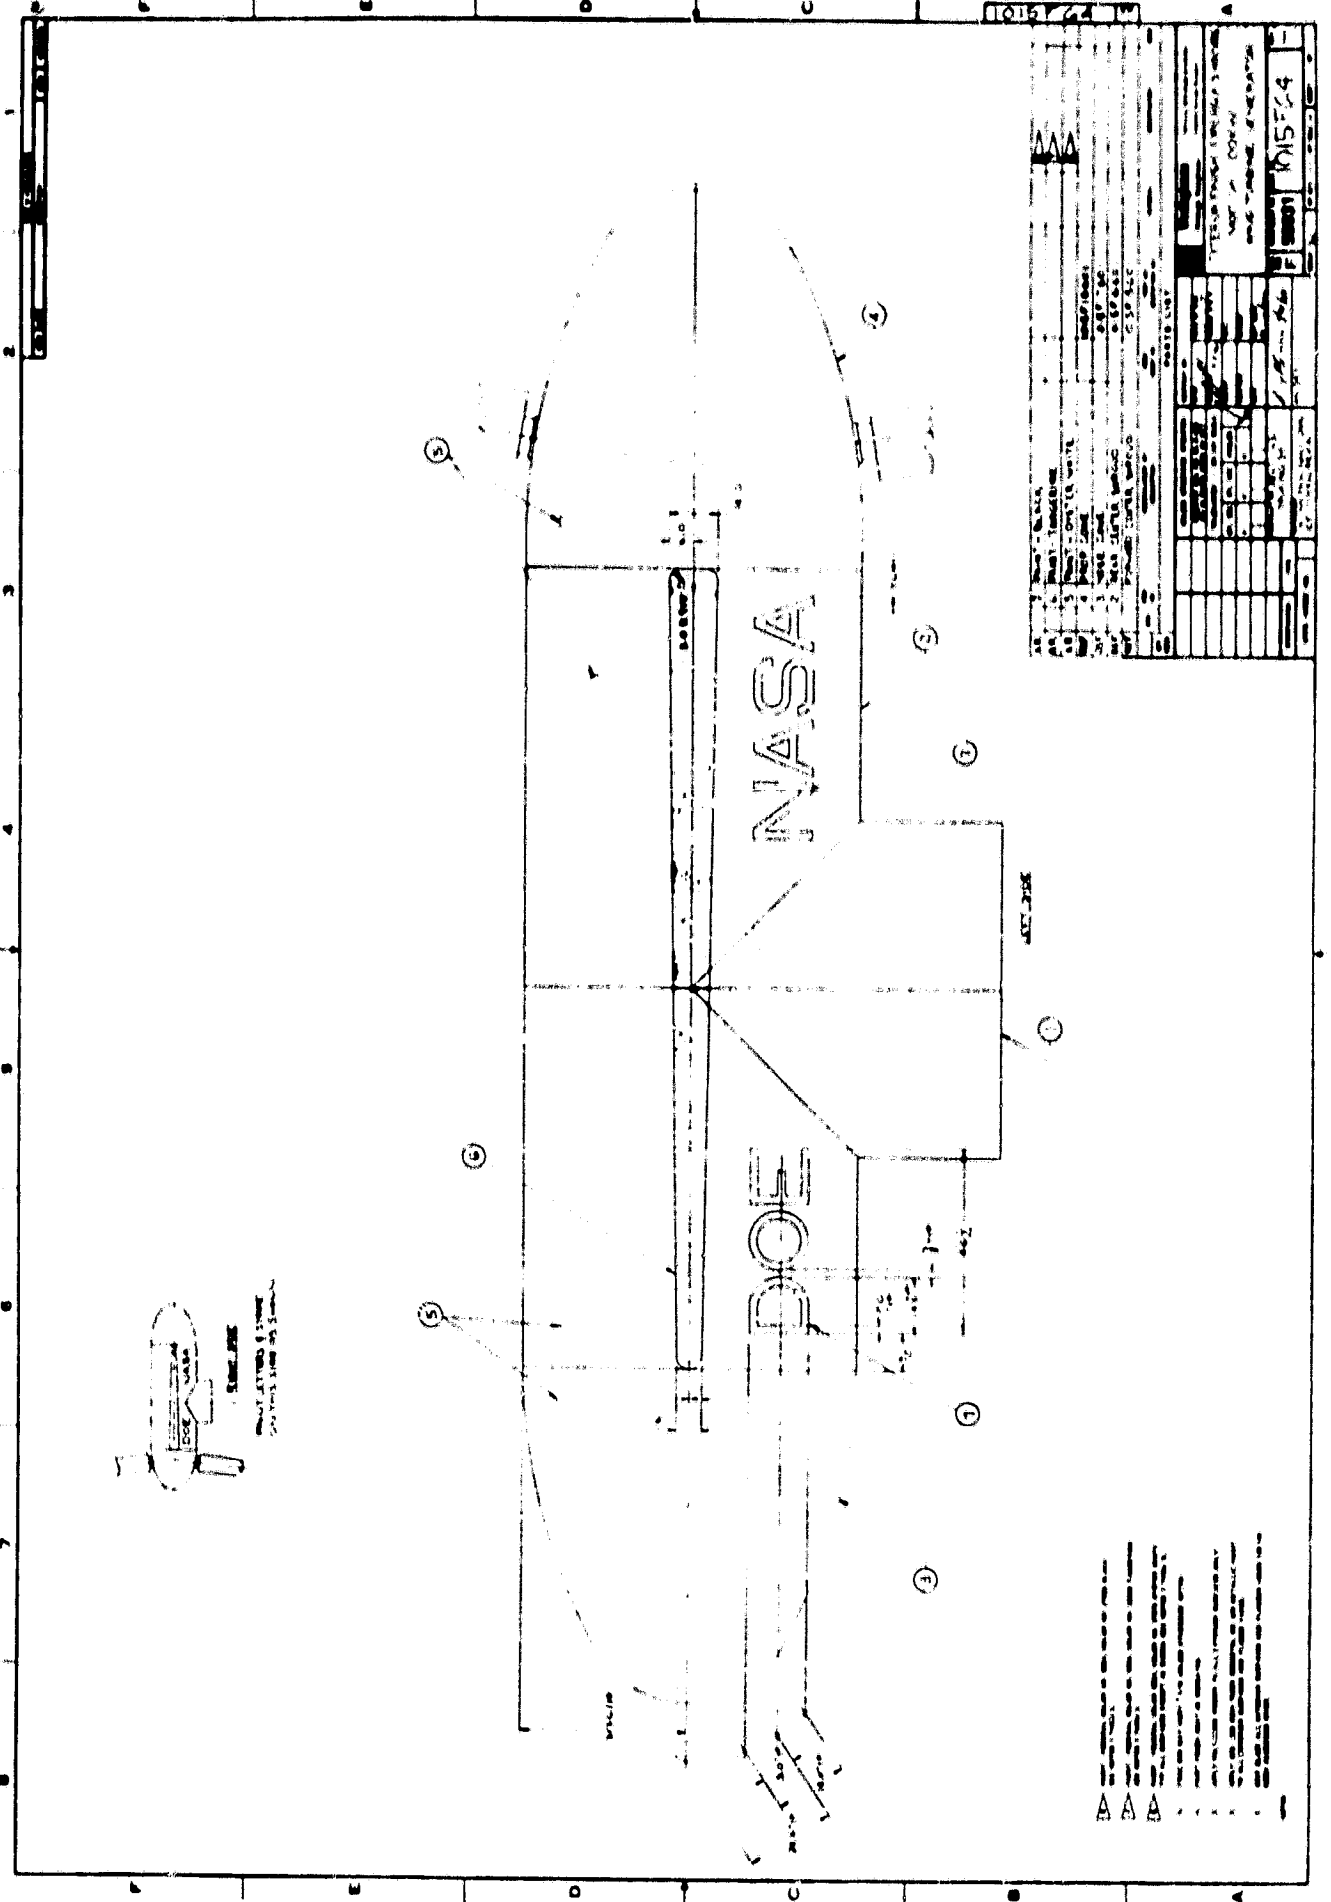




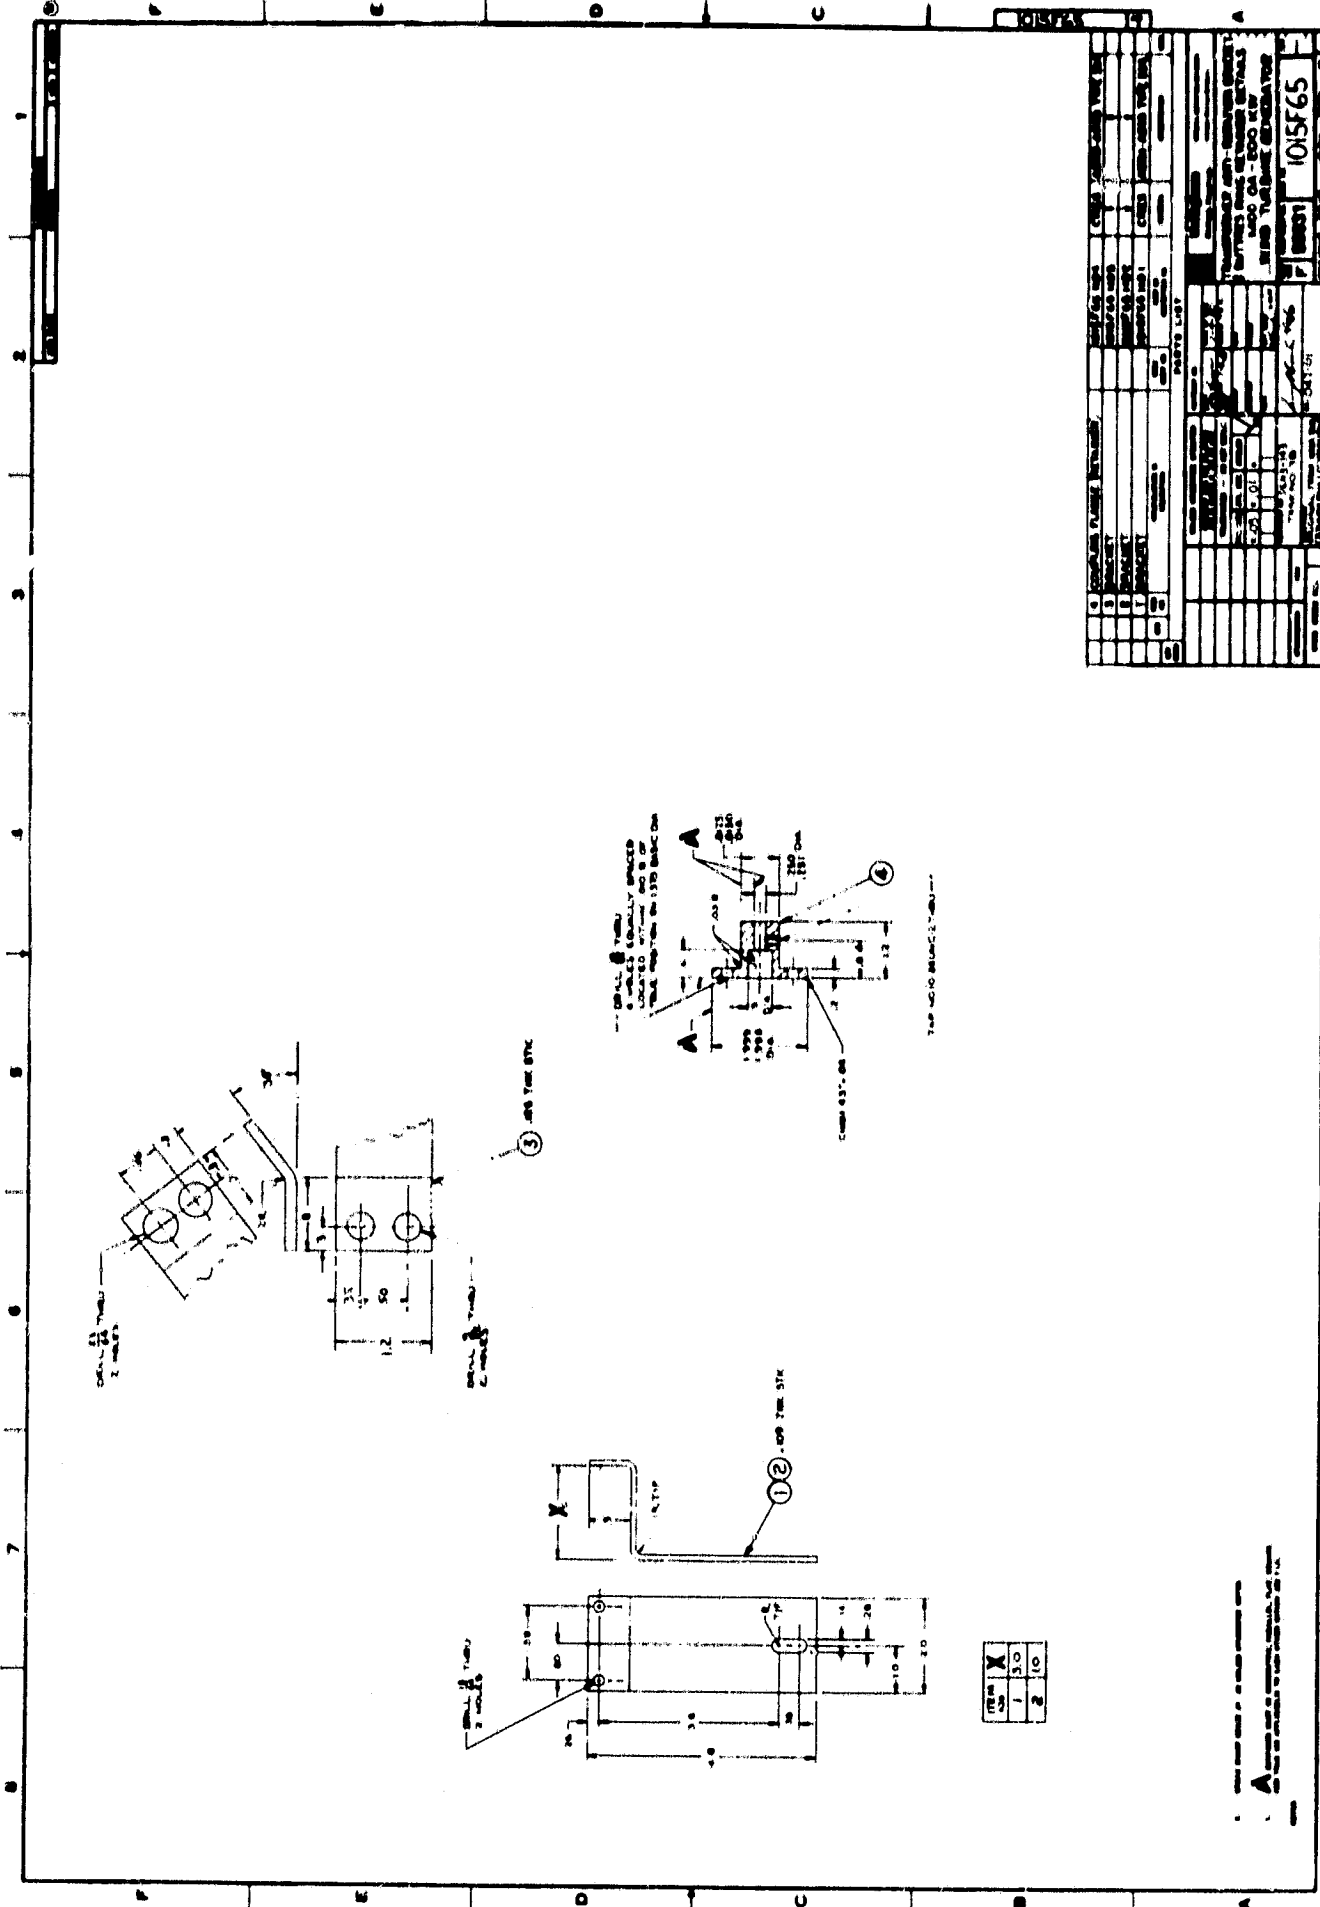




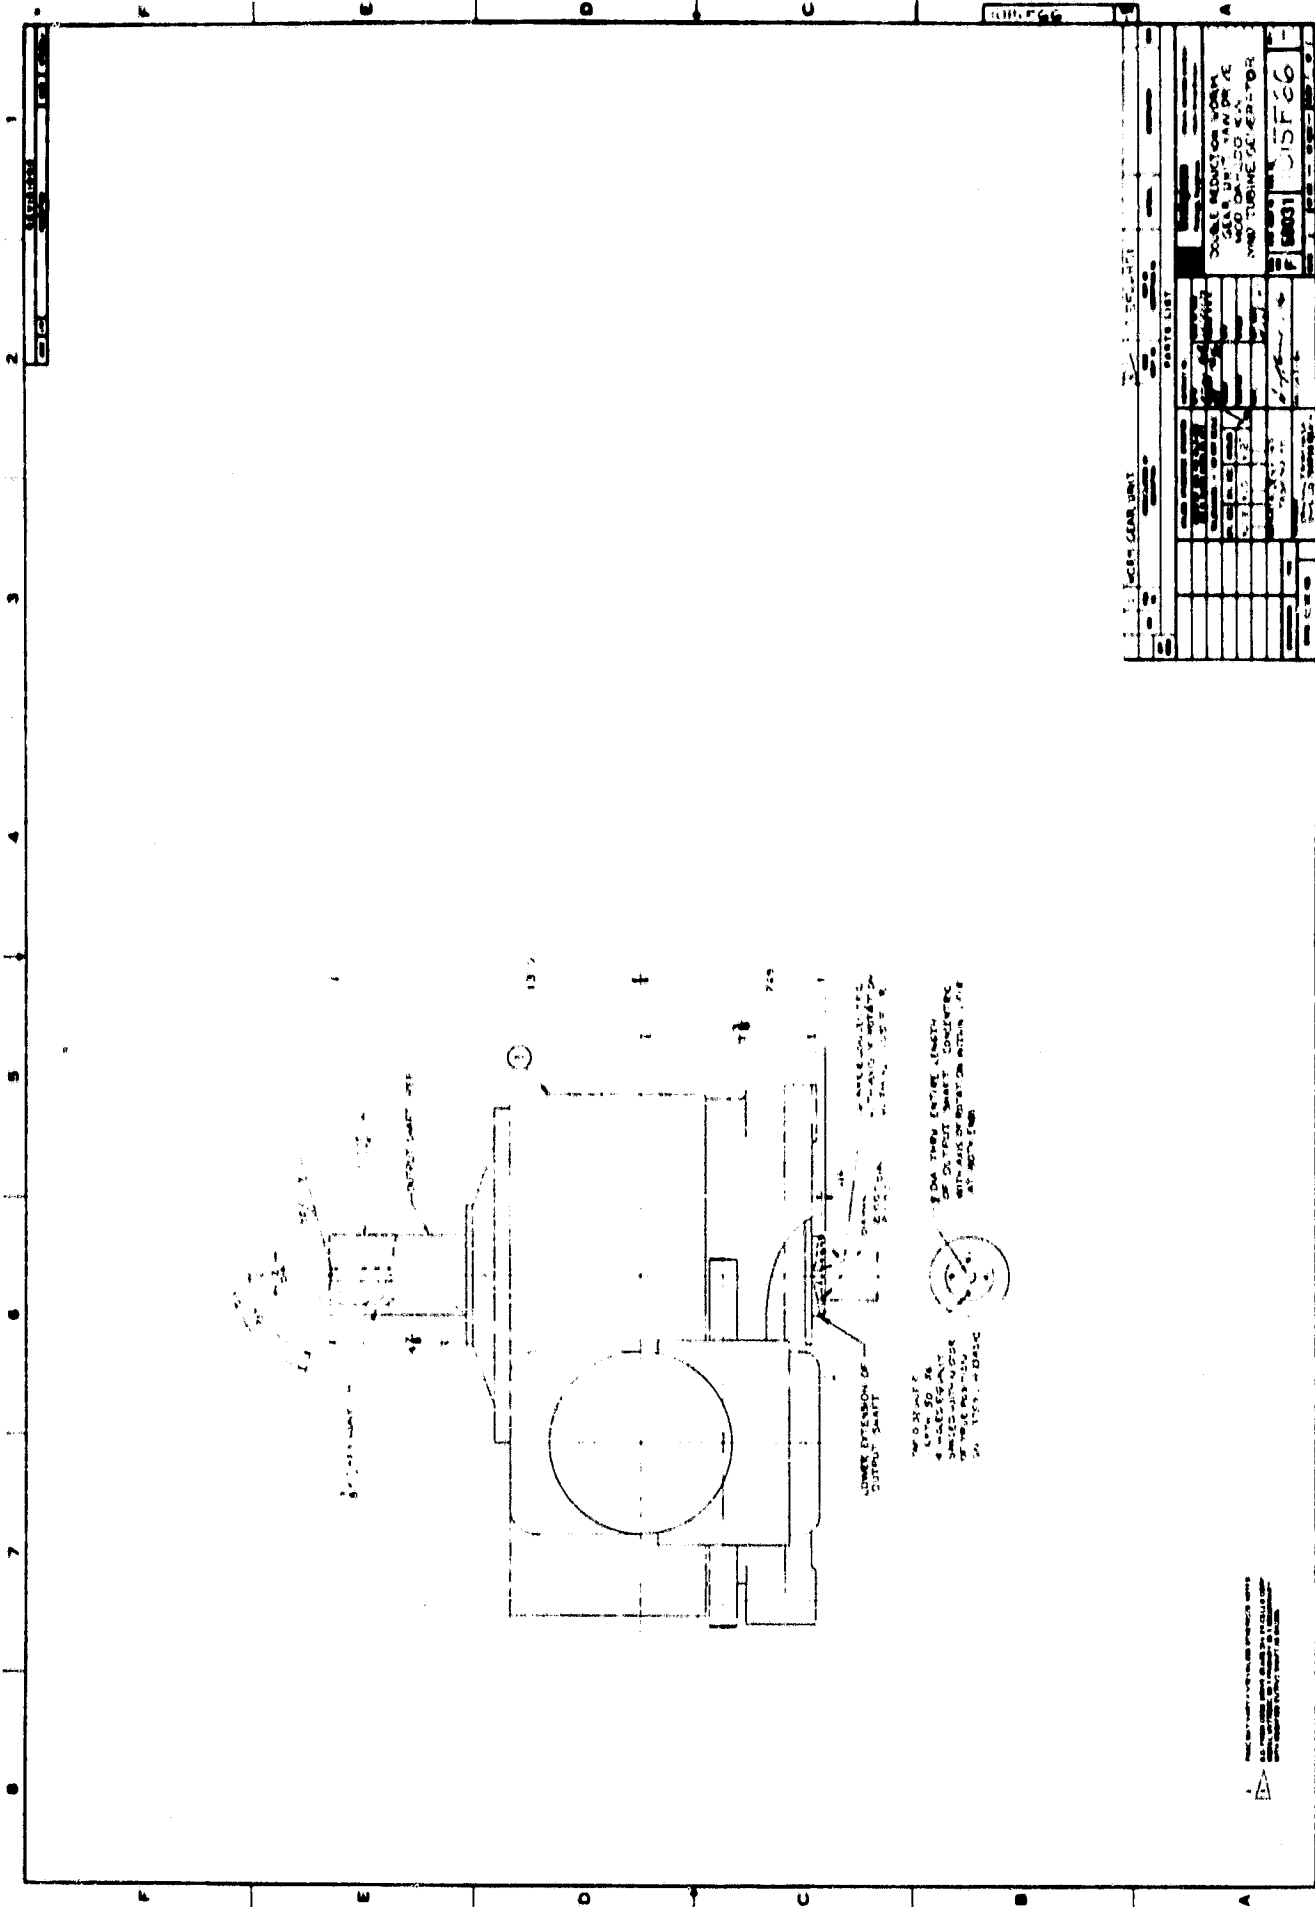

1
2
3
4
5
6
7
8






PARTS LIST	

DOUBLE REDUCTION WORK
GEAR UNIT FOR THE
NEW TUBINE GENERATOR

10001 015F66



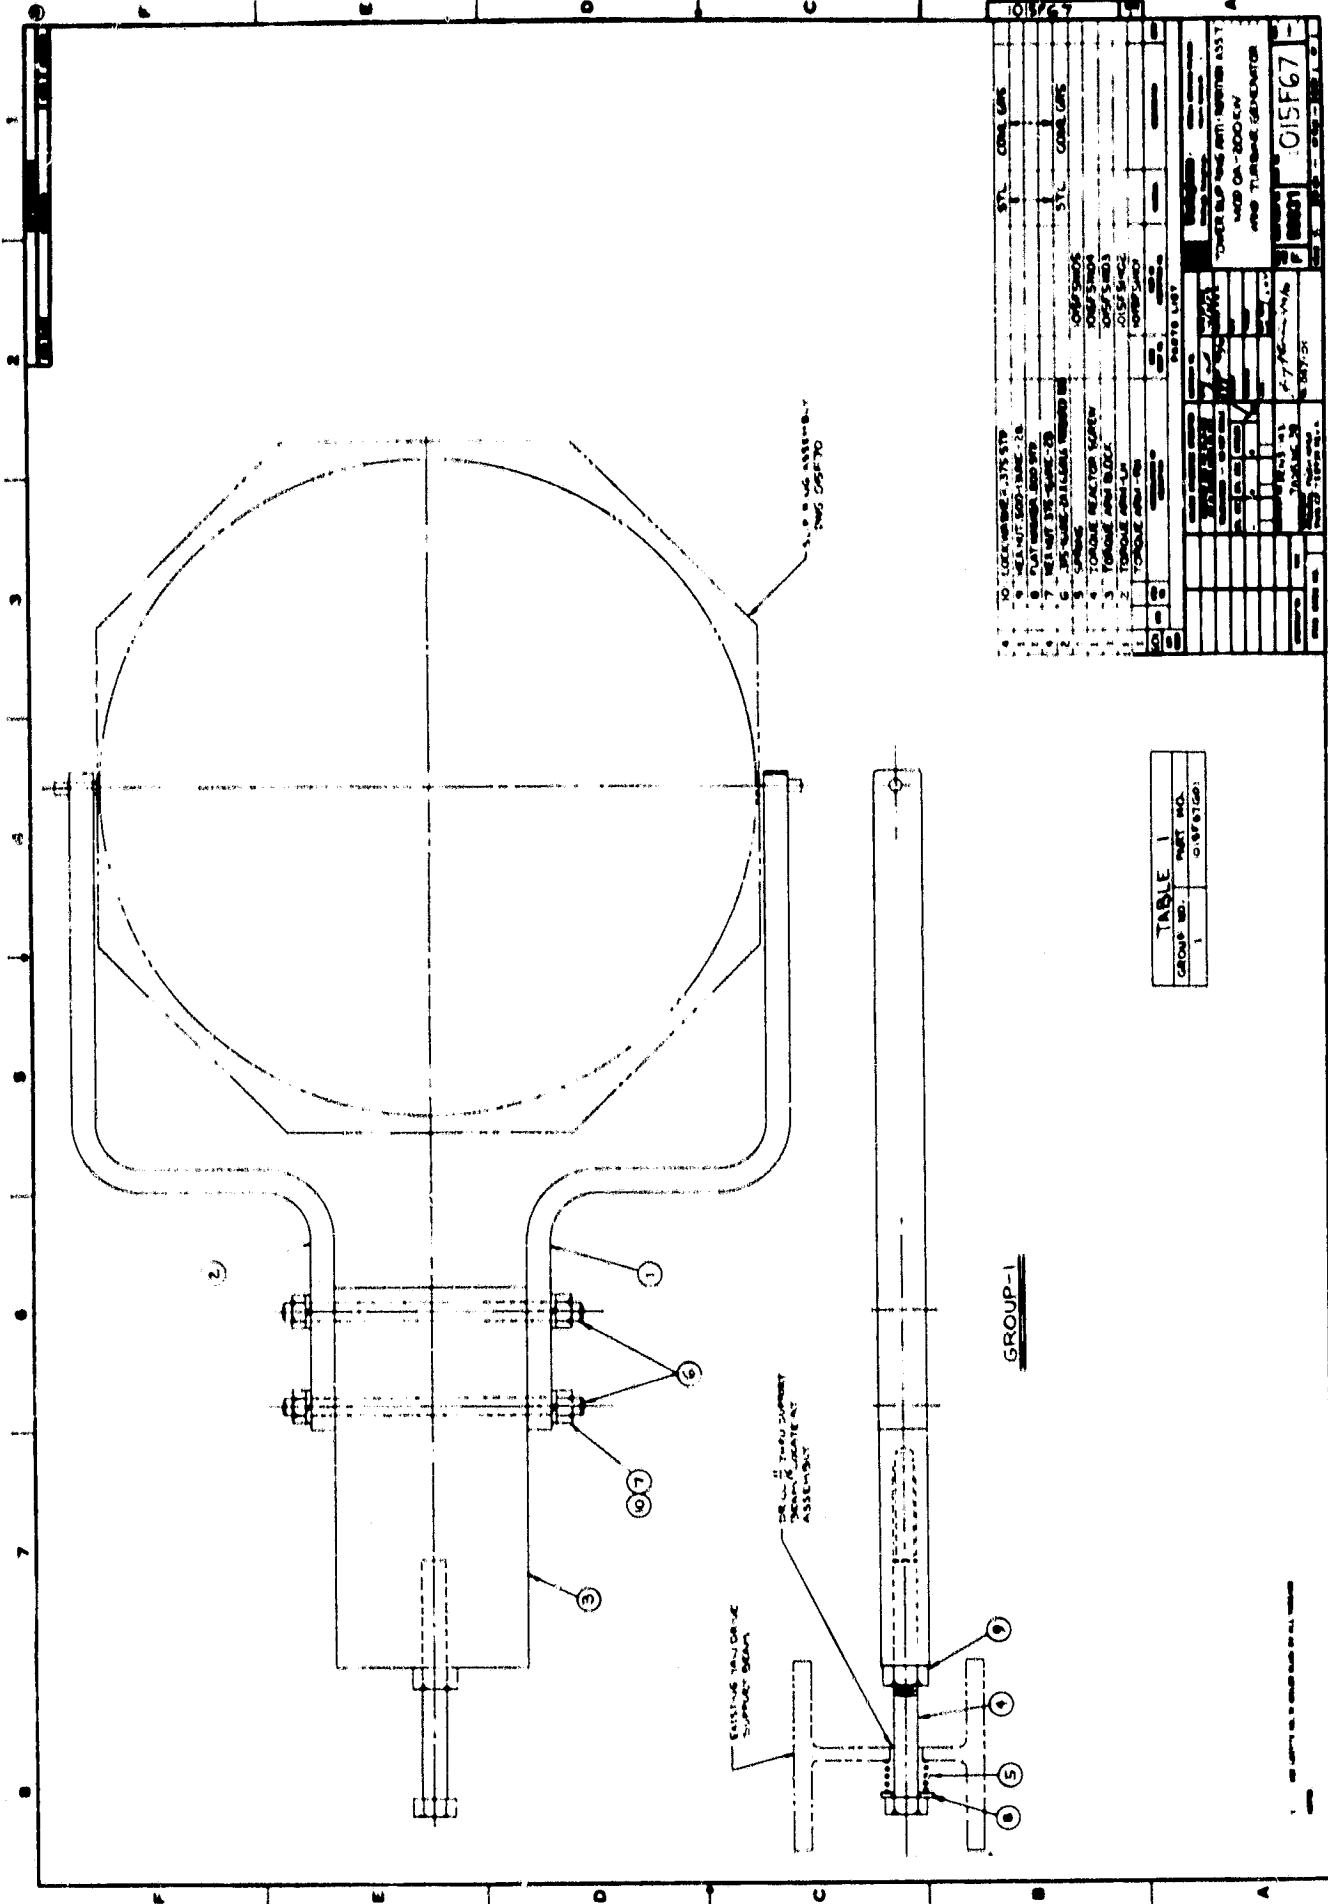


TABLE 1	
GROUP NO.	PART NO.
1	015F67

PARTS LIST				
NO.	DESCRIPTION	QTY.	UNIT	REF. DES.

015F67
 AND TURBINE GENERATOR


1. ALL DIMENSIONS ARE IN INCHES UNLESS OTHERWISE SPECIFIED.

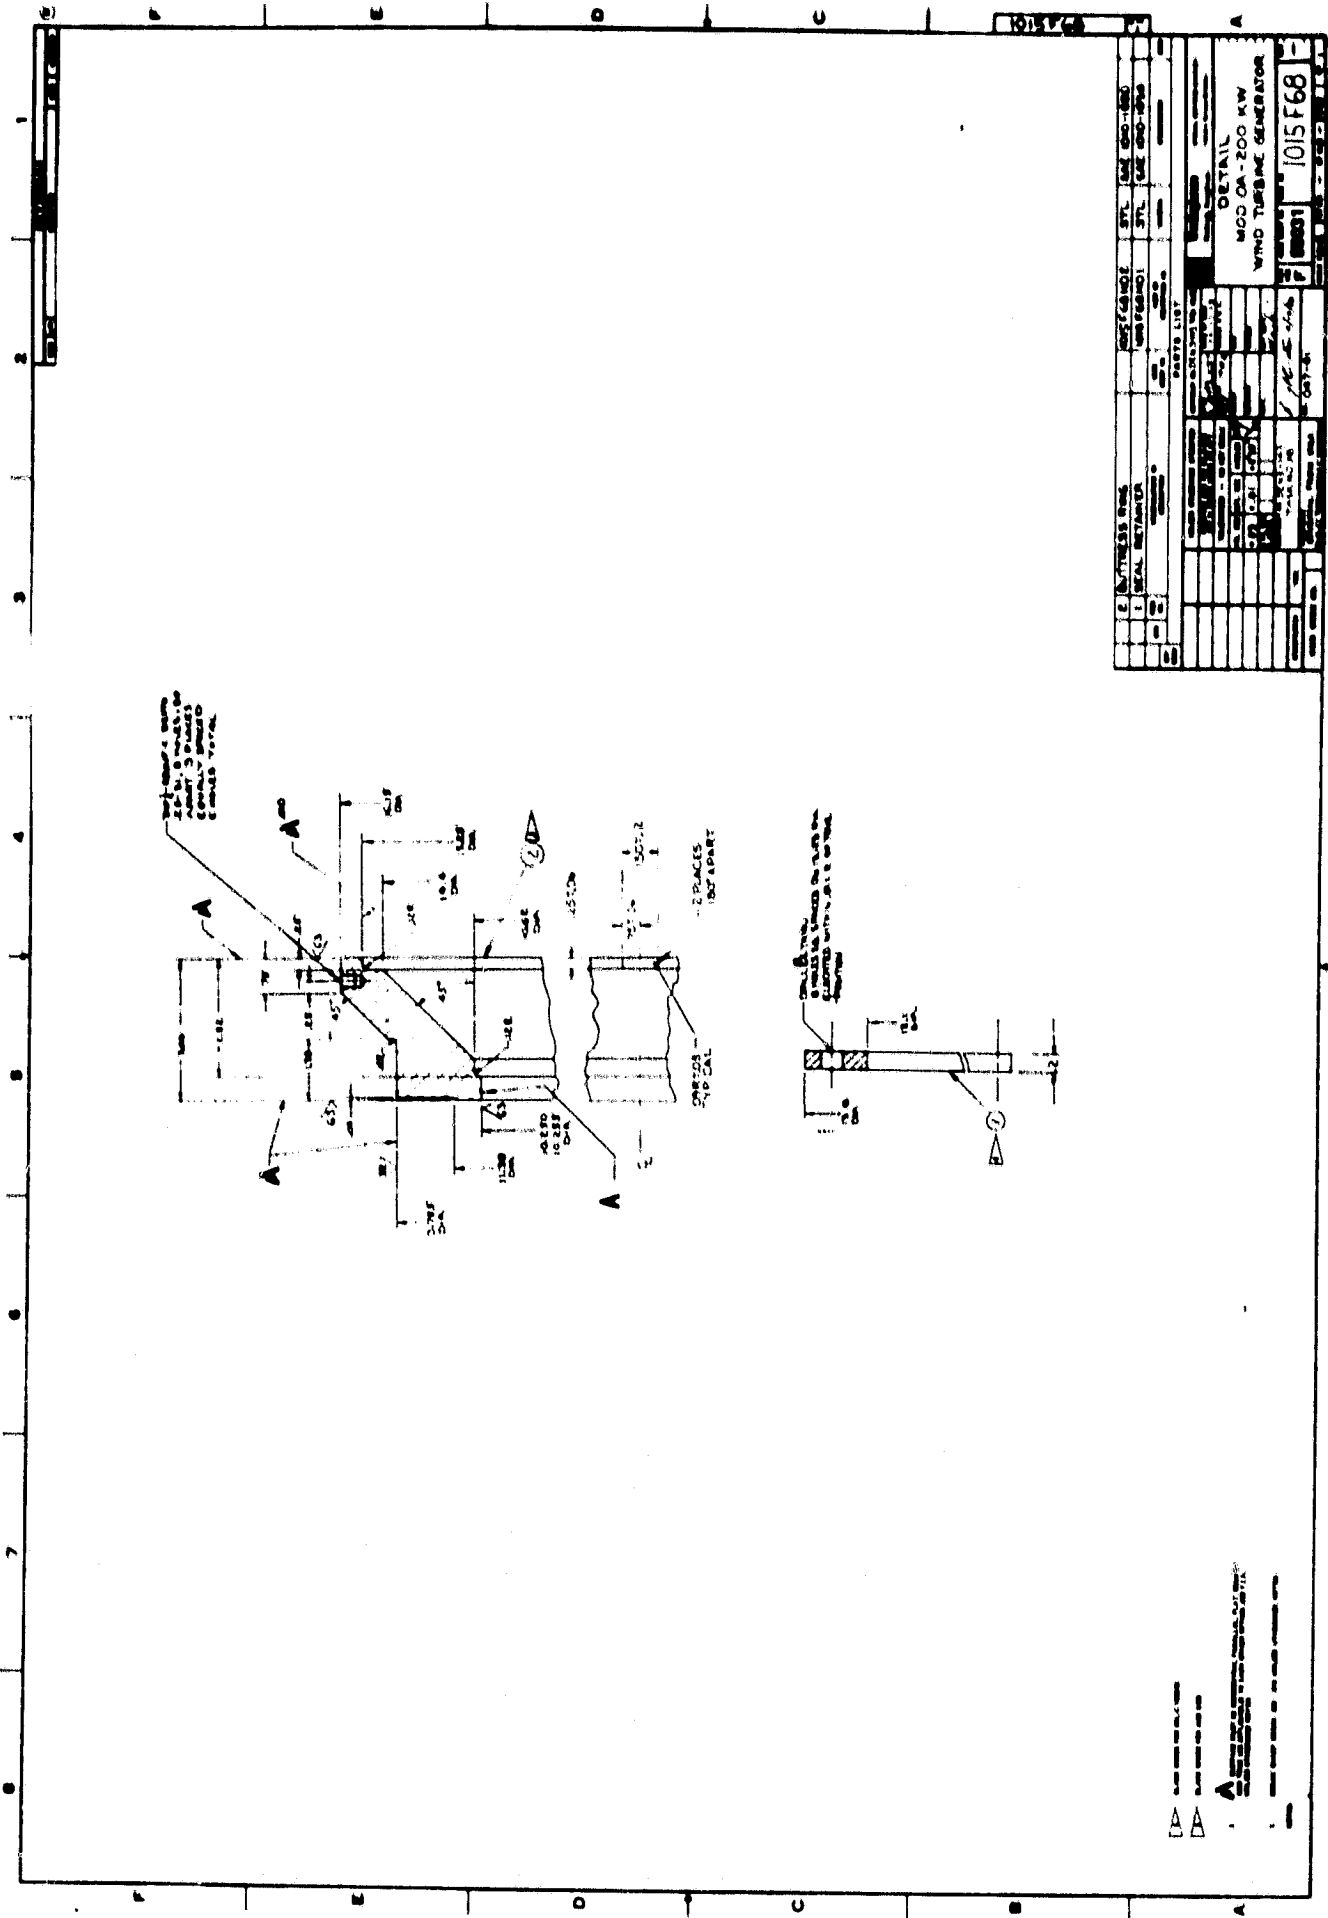


E		S		R		E	
2	1	1	1	1	1	1	1
1	1	1	1	1	1	1	1
1	1	1	1	1	1	1	1
DETAIL							
MCD OA-200 KW							
WIND TURBINE GENERATOR							
1015 F68							



DATE	10/15/79
BY	[Signature]
CHECKED BY	[Signature]
SCALE	AS SHOWN
PROJECT NO.	
DRAWING NO.	
DESIGNED BY	
ENGINEER	
DATE	
CHECKED BY	
DATE	

 

SITE PLAN
105169

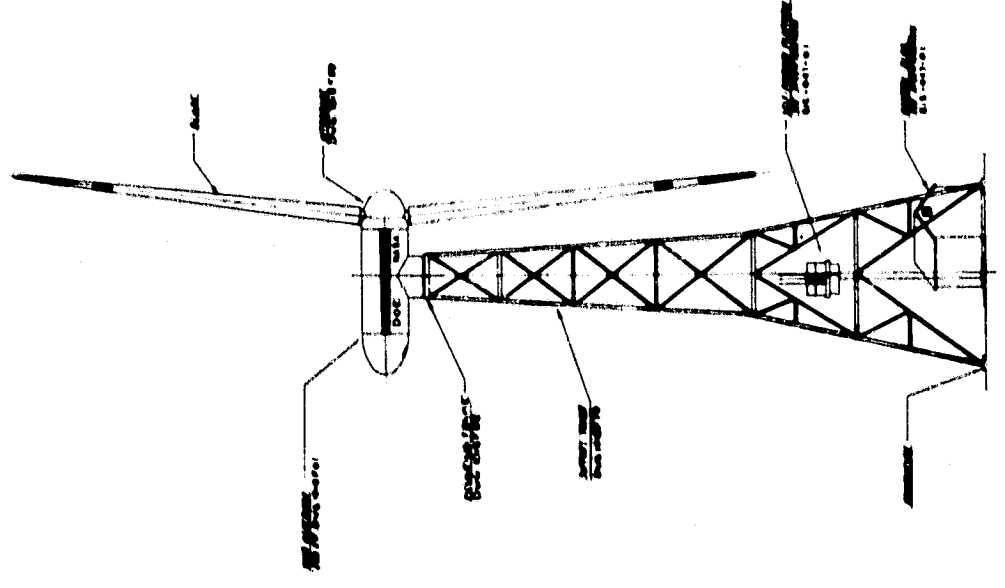

ELEVATION
105169

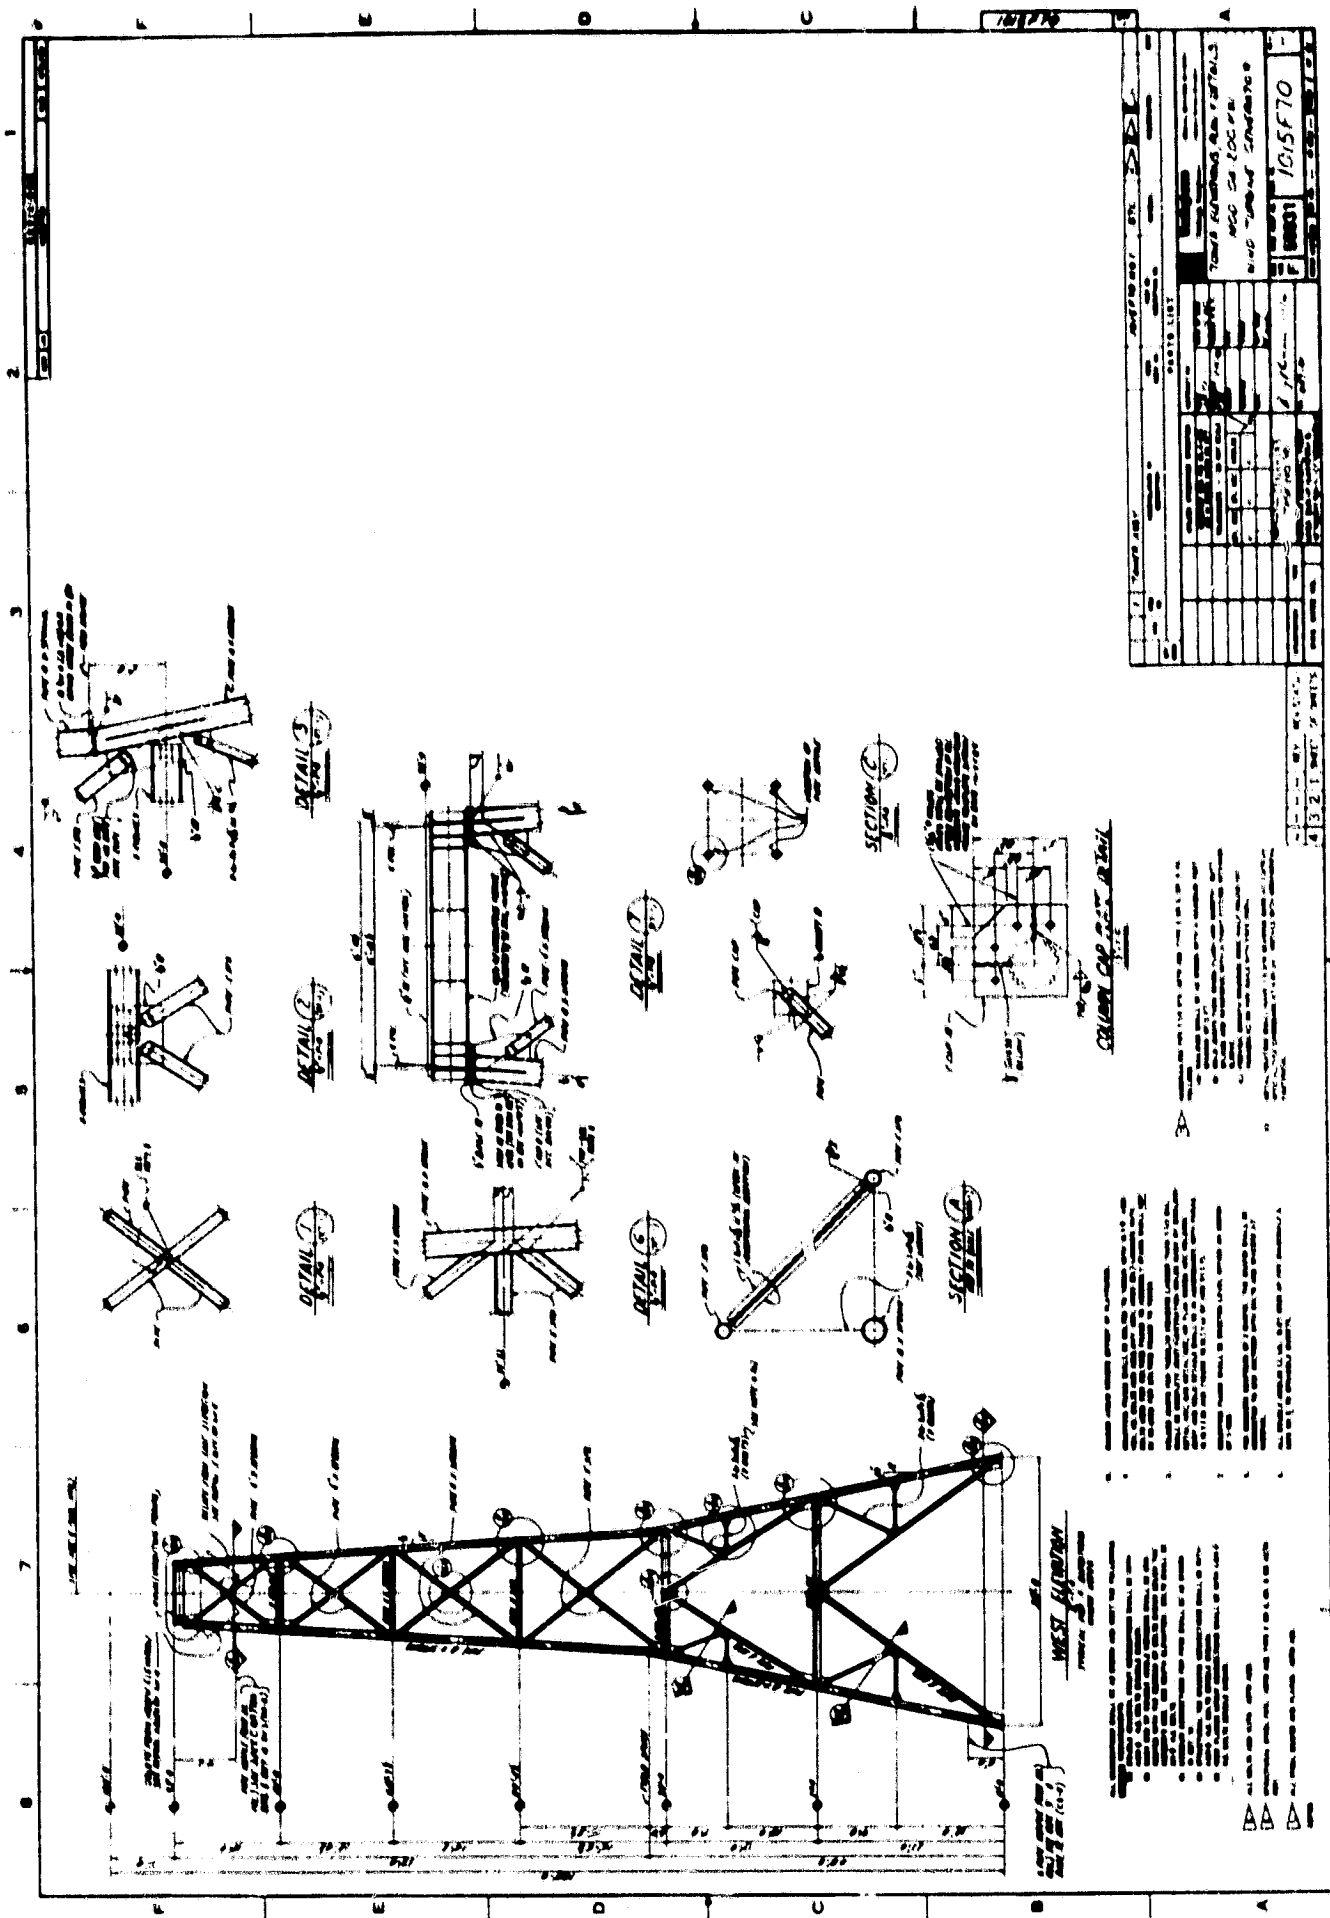

DATE LIST	
NO.	DATE
1	10/15/70
2	
3	
WEST ELEVATION

SECTION C












COLUMN END DETAIL





ORIGINAL PAGE IS
OF POOR QUALITY

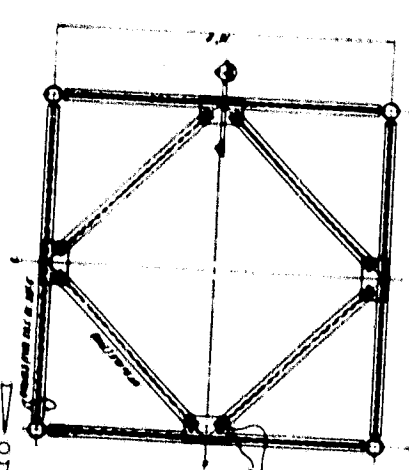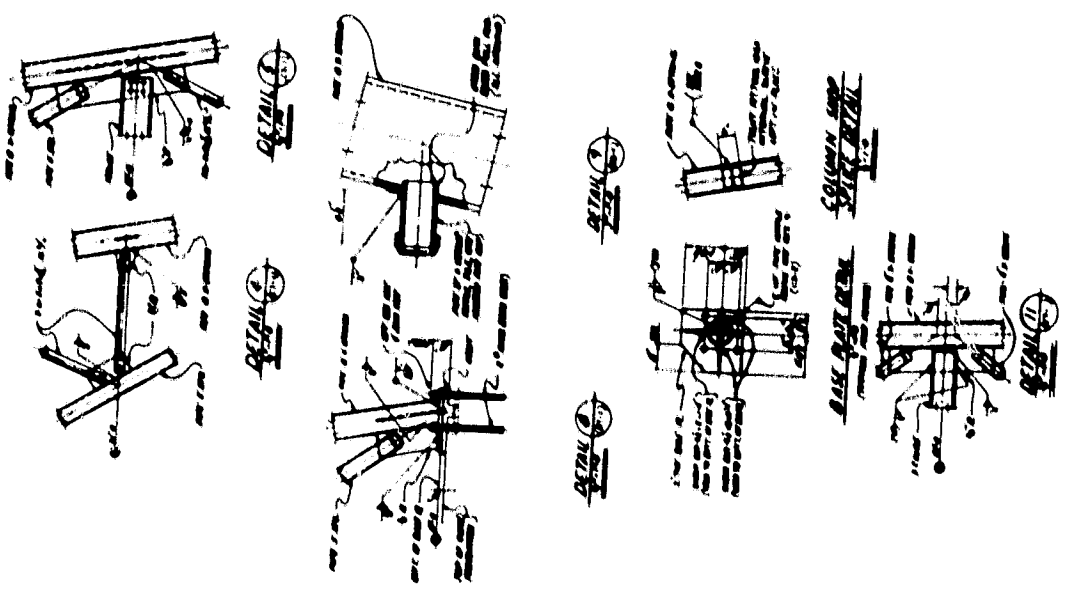

PLAN AT SECTION 2-2

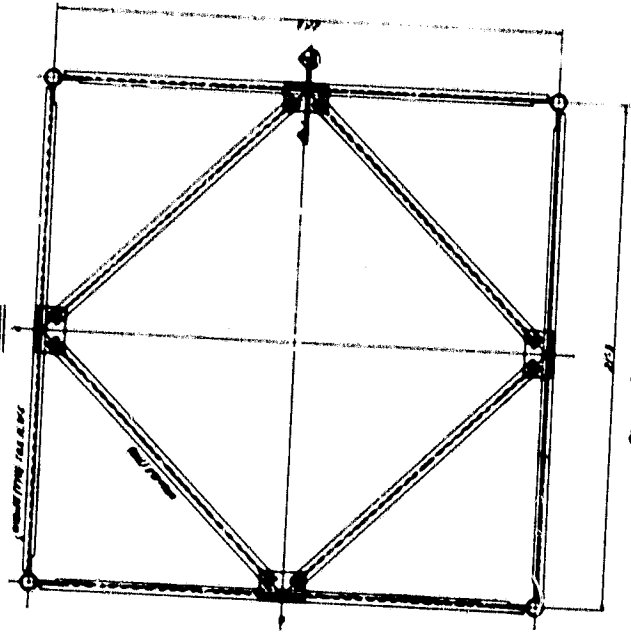

PLAN AT SECTION 2-2

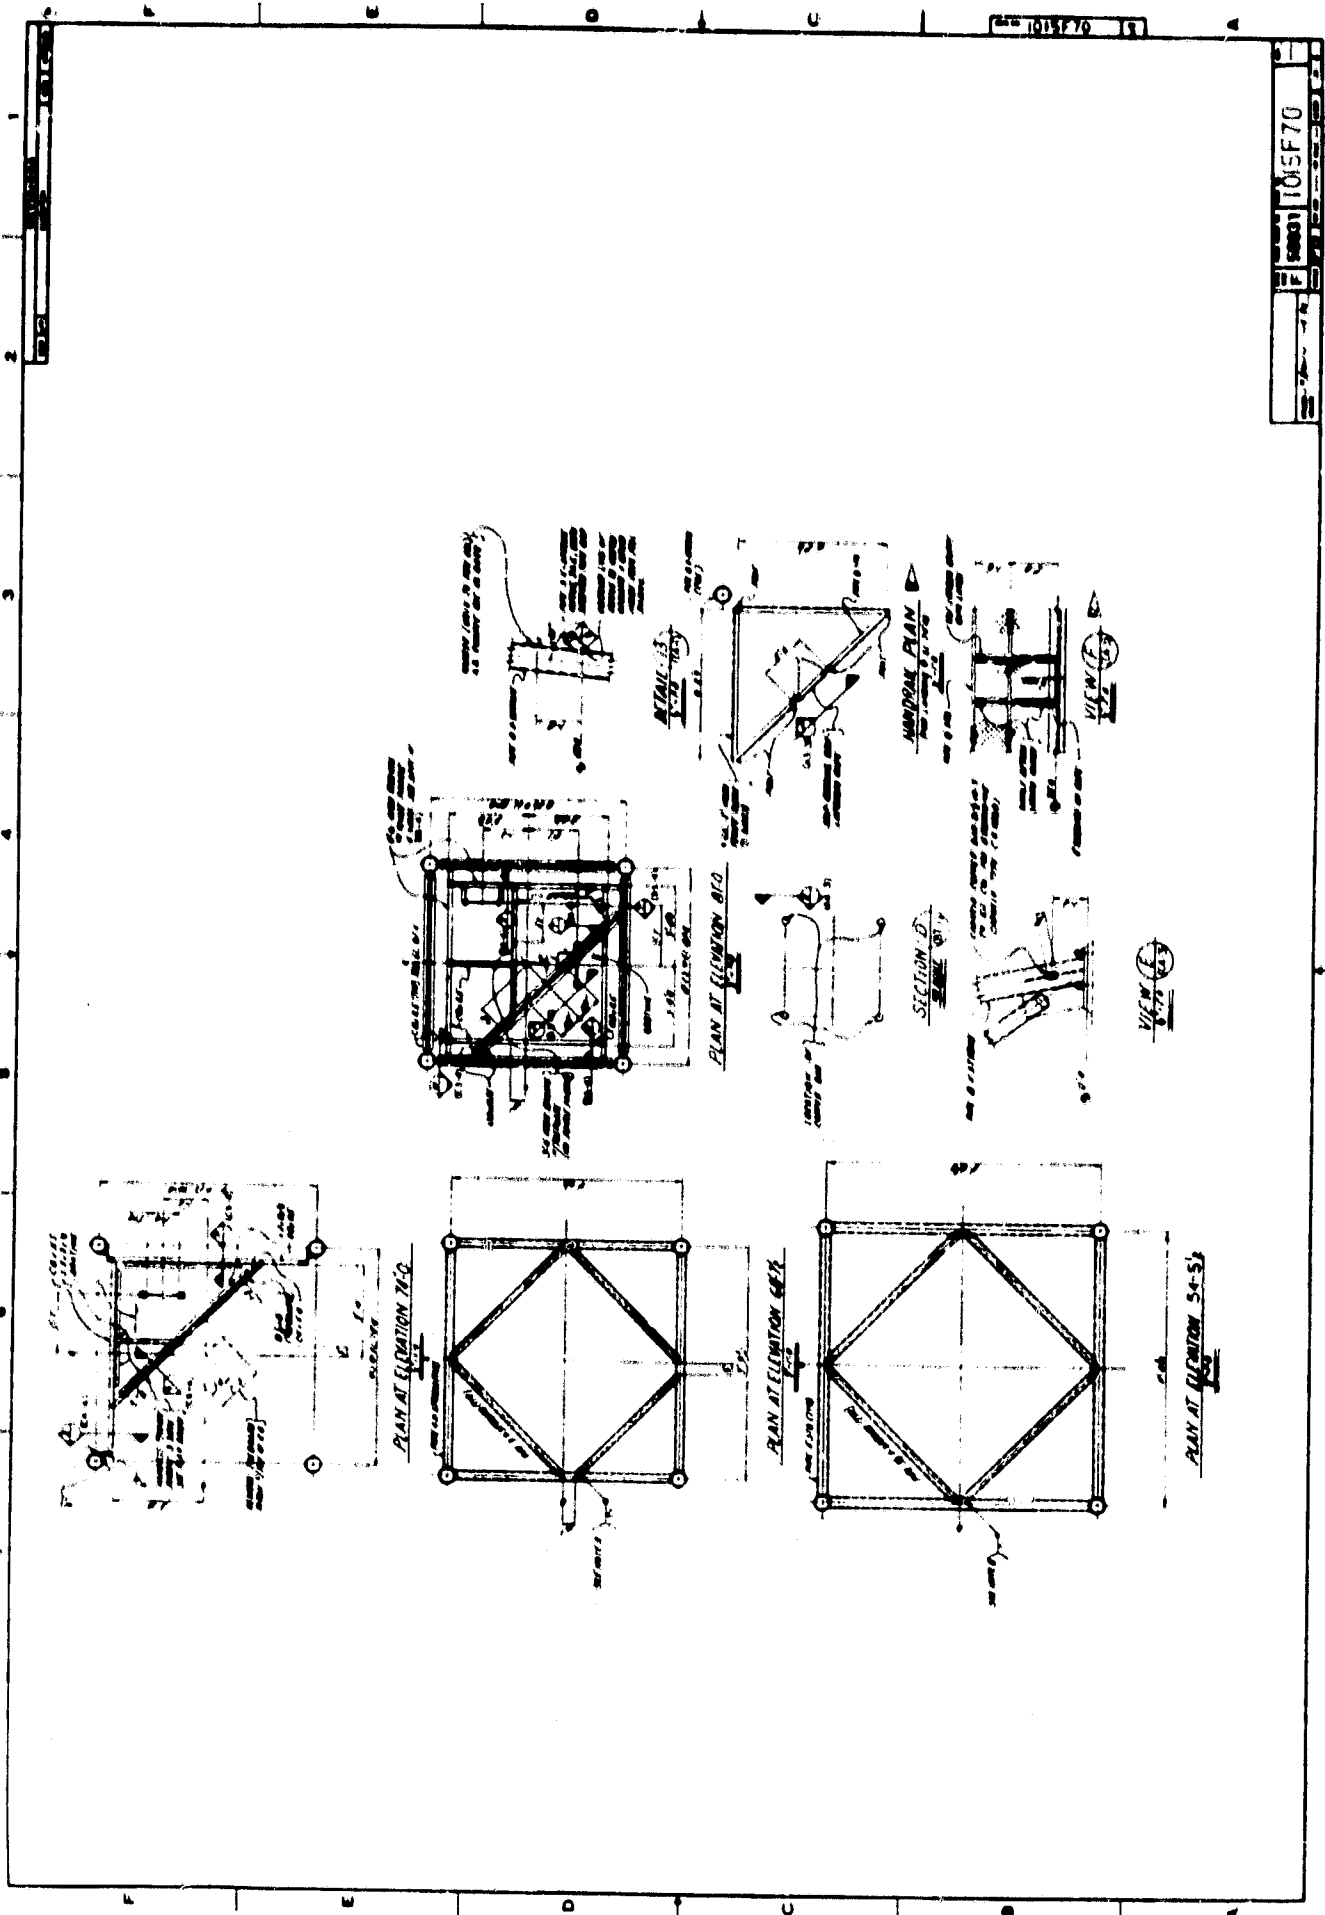



1015F70

1015F70

 SECTION D-D
 VIEW E
 VIEW F

PLAN AT ELEVATION 74'-0"
 PLAN AT ELEVATION 66'-0"
 PLAN AT ELEVATION 61'-0"
 PLAN AT ELEVATION 54'-5"

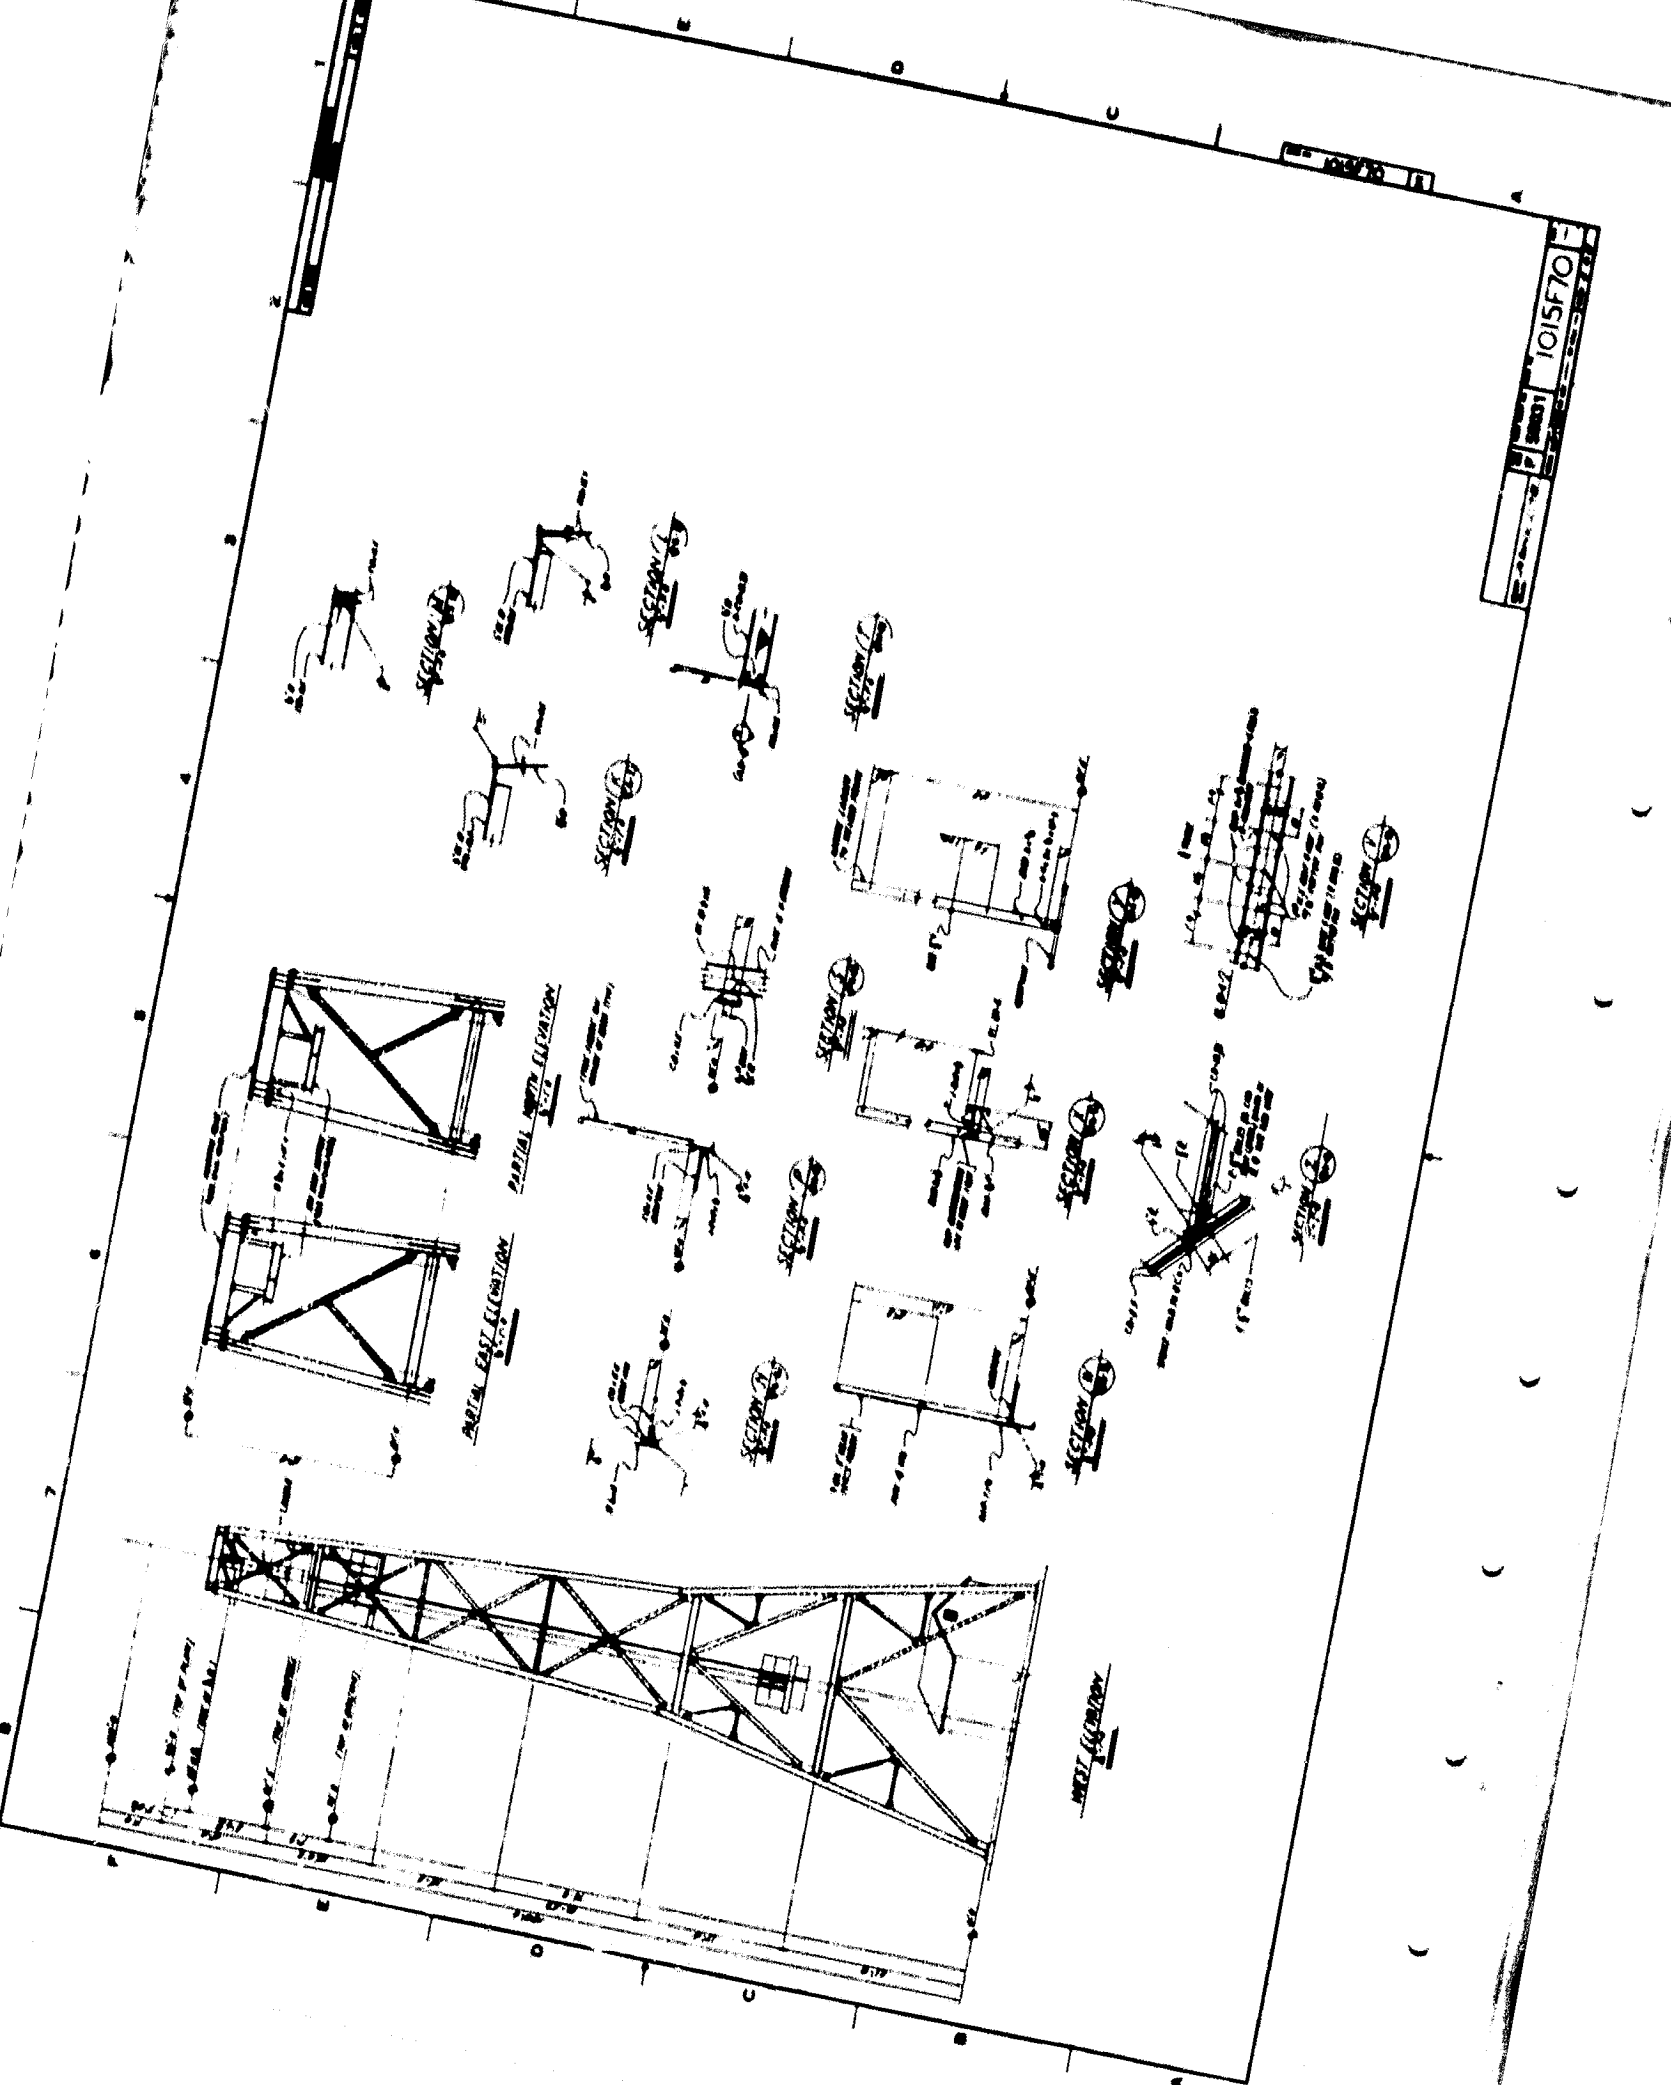


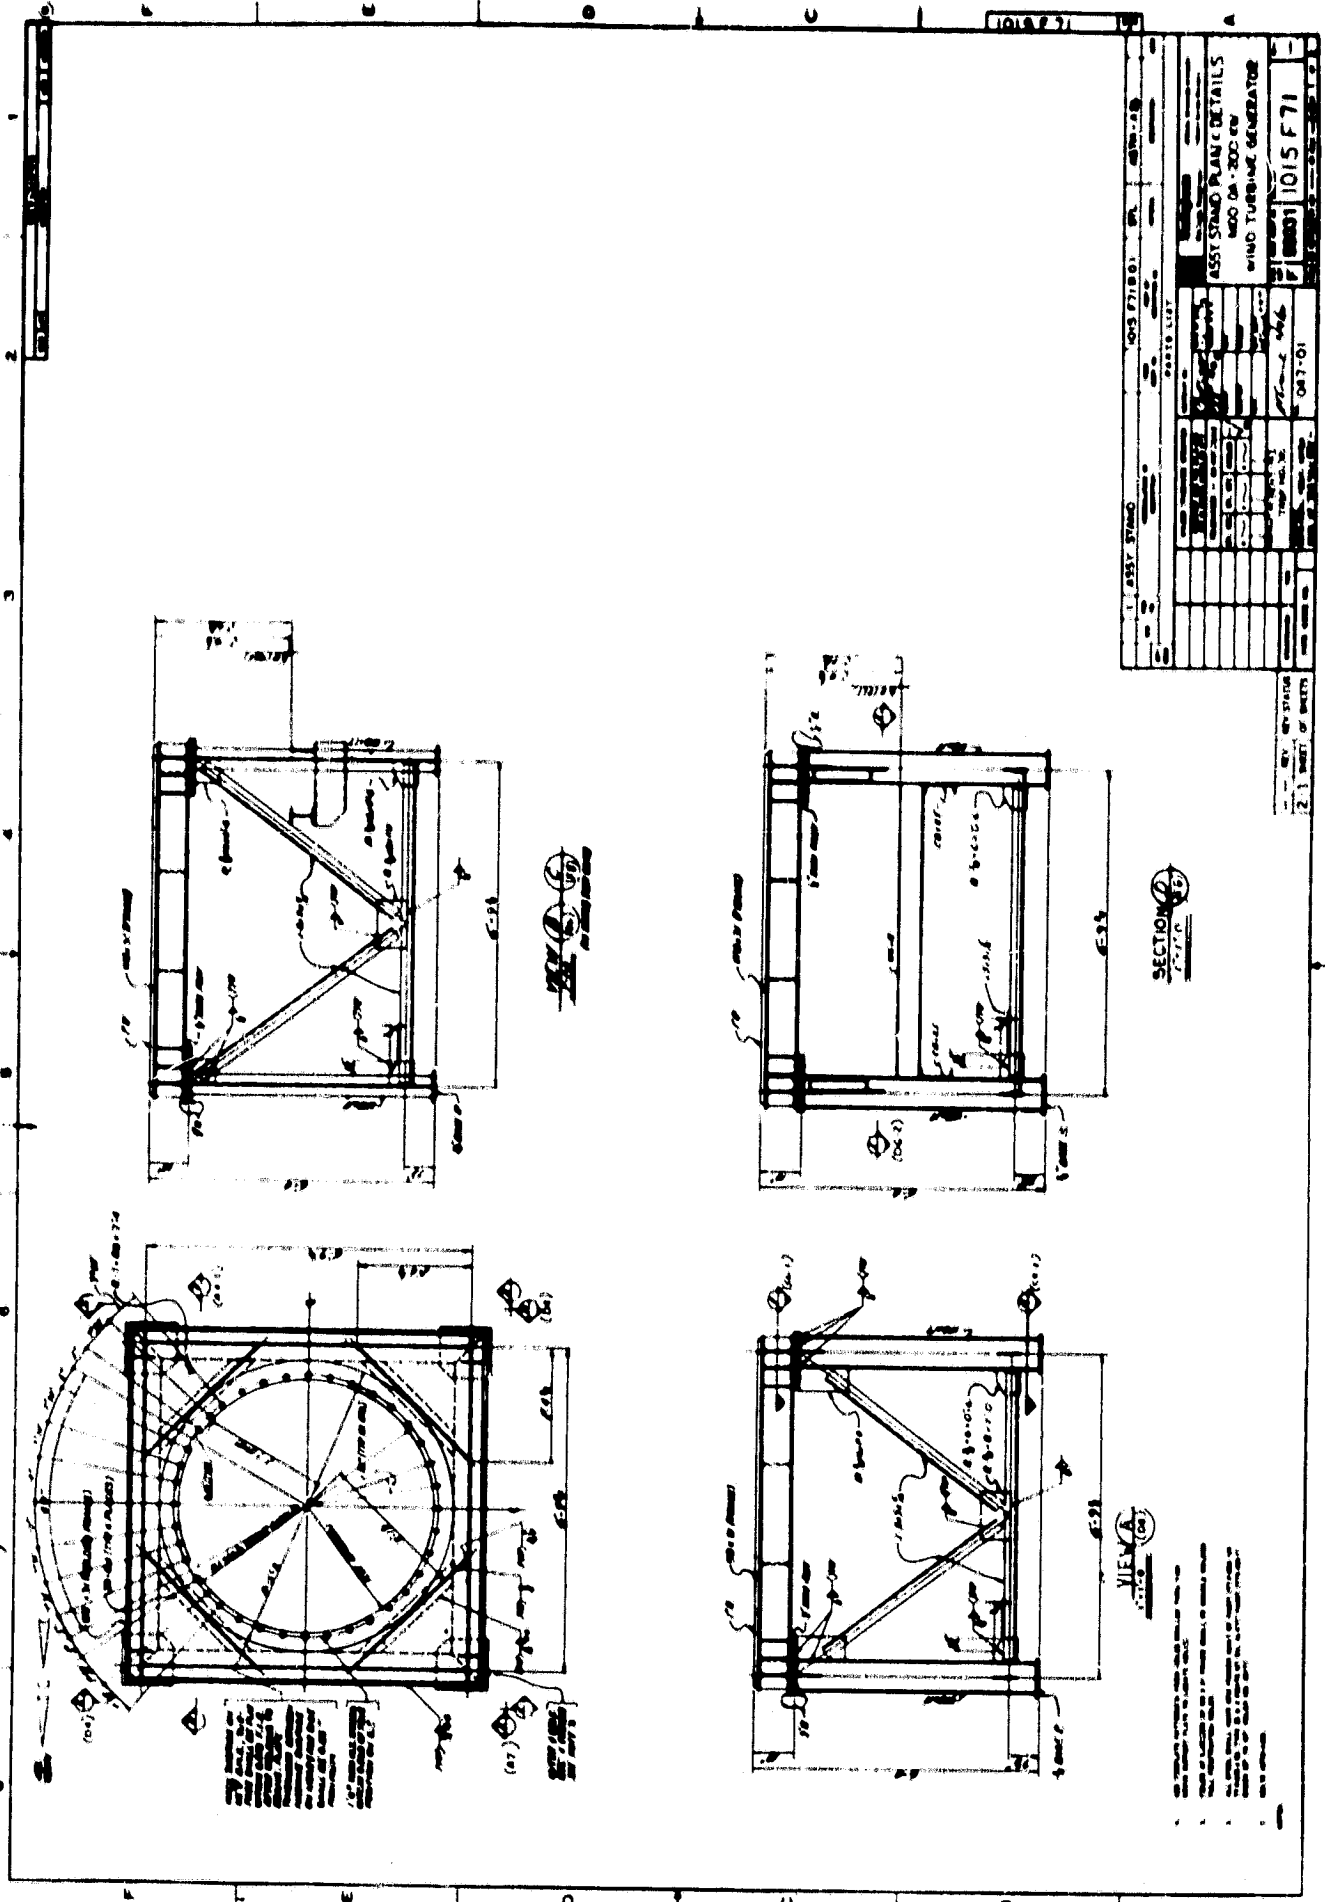


1. ASST. STND.		005 271801	DL	08-11-01
2. REV.		BY	DATE	
3. SHEET		OF	SHEETS	
ASST STND PLANT DETAILS				
WIND TURBINE GENERATOR				
PROJECT NO.		1015 F71		
DATE		08-11-01		

1015 F 71

9000 ICIS F 71

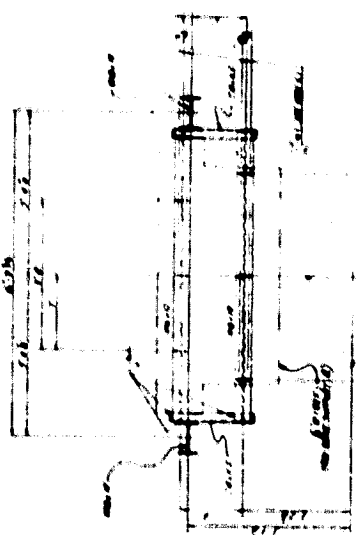

SECTION (1)

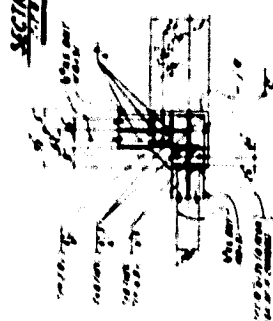


SECTION (2)


SECTION (3)



SWIM DETAIL

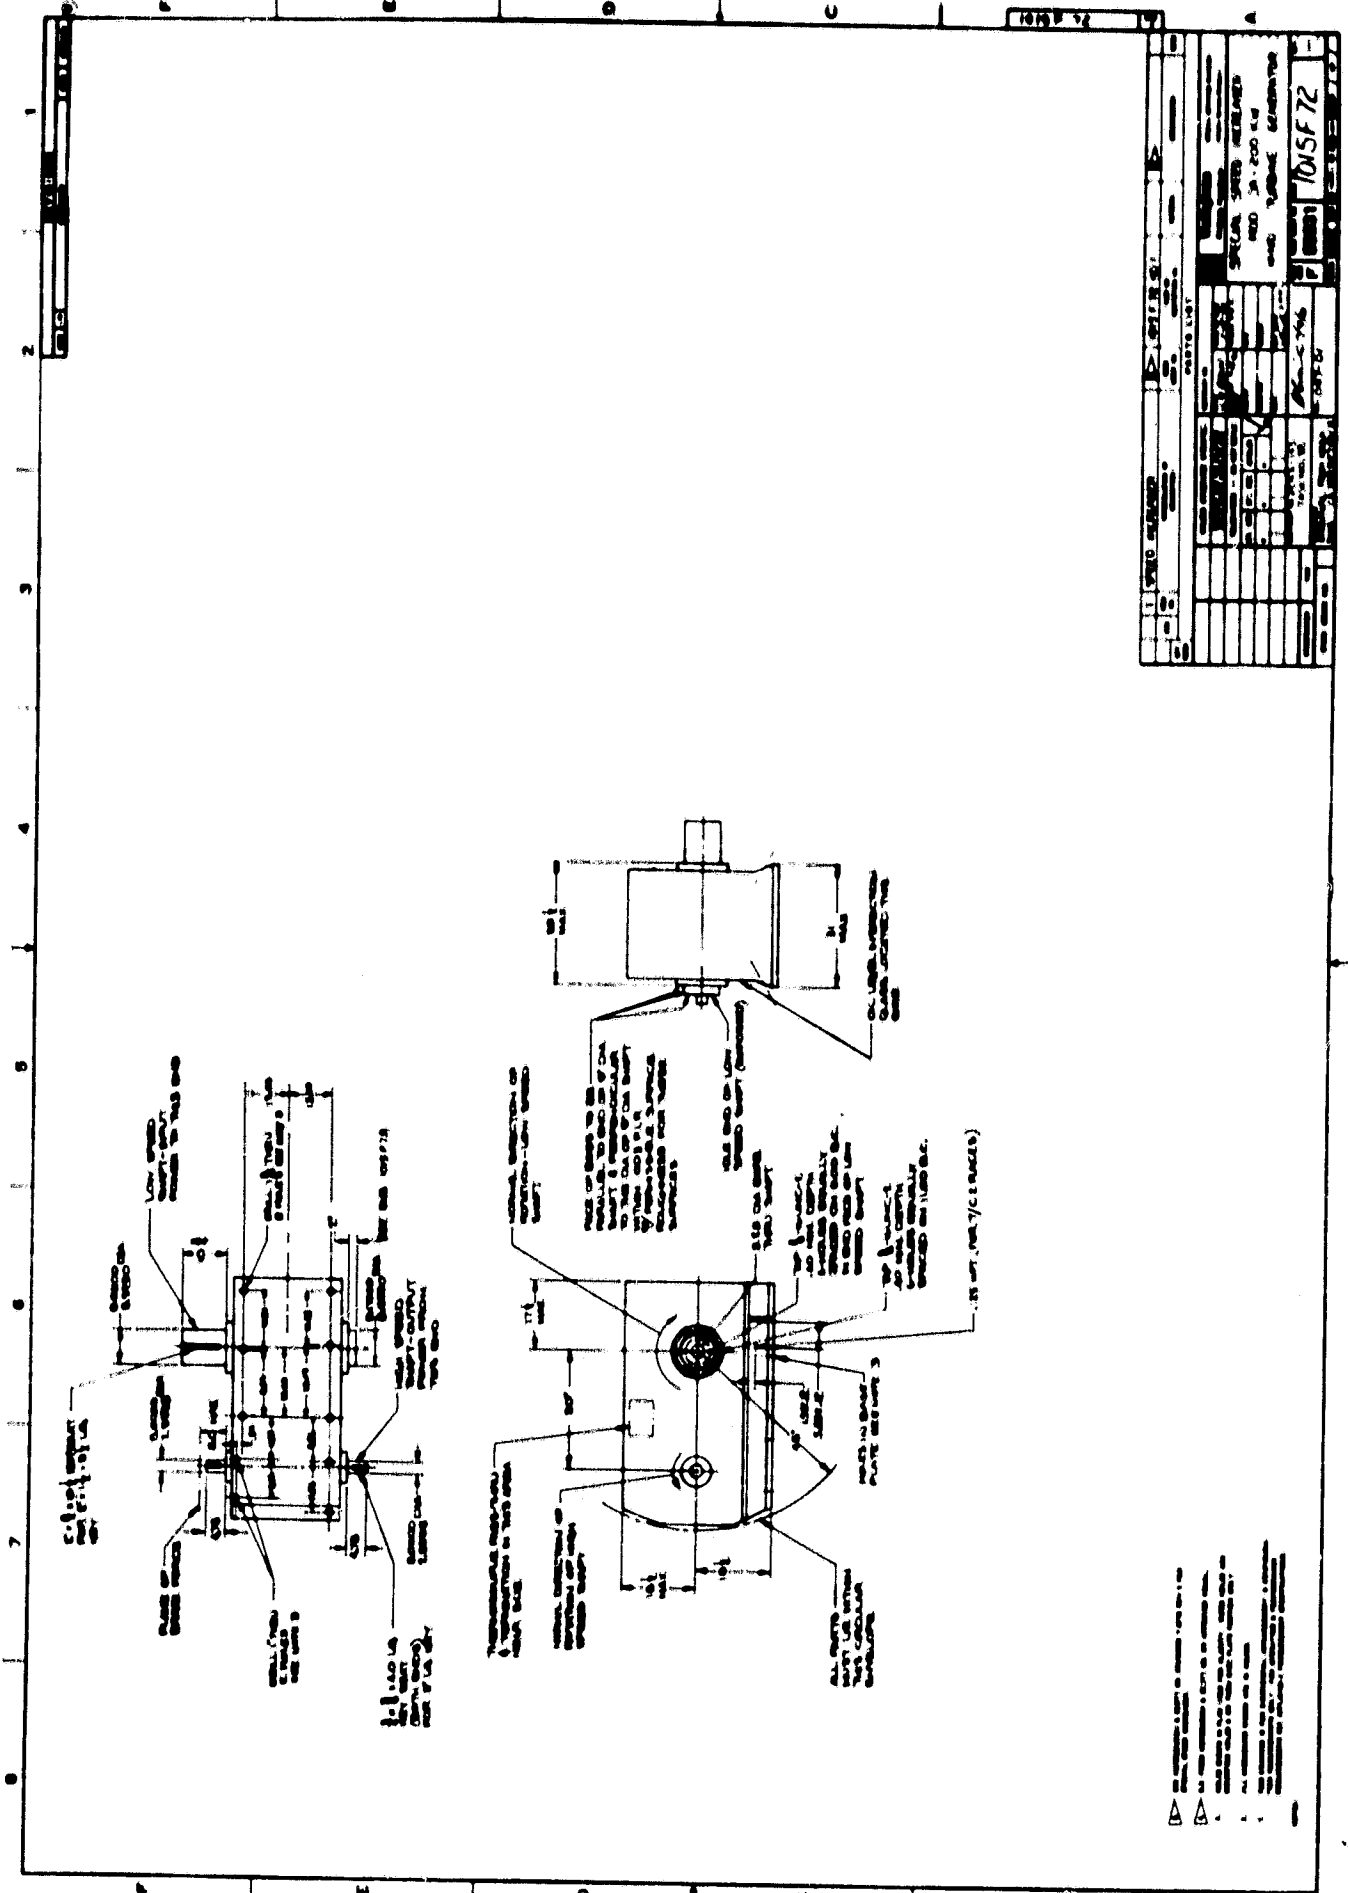


PART NO.		REV.		DATE		BY		CHKD.	

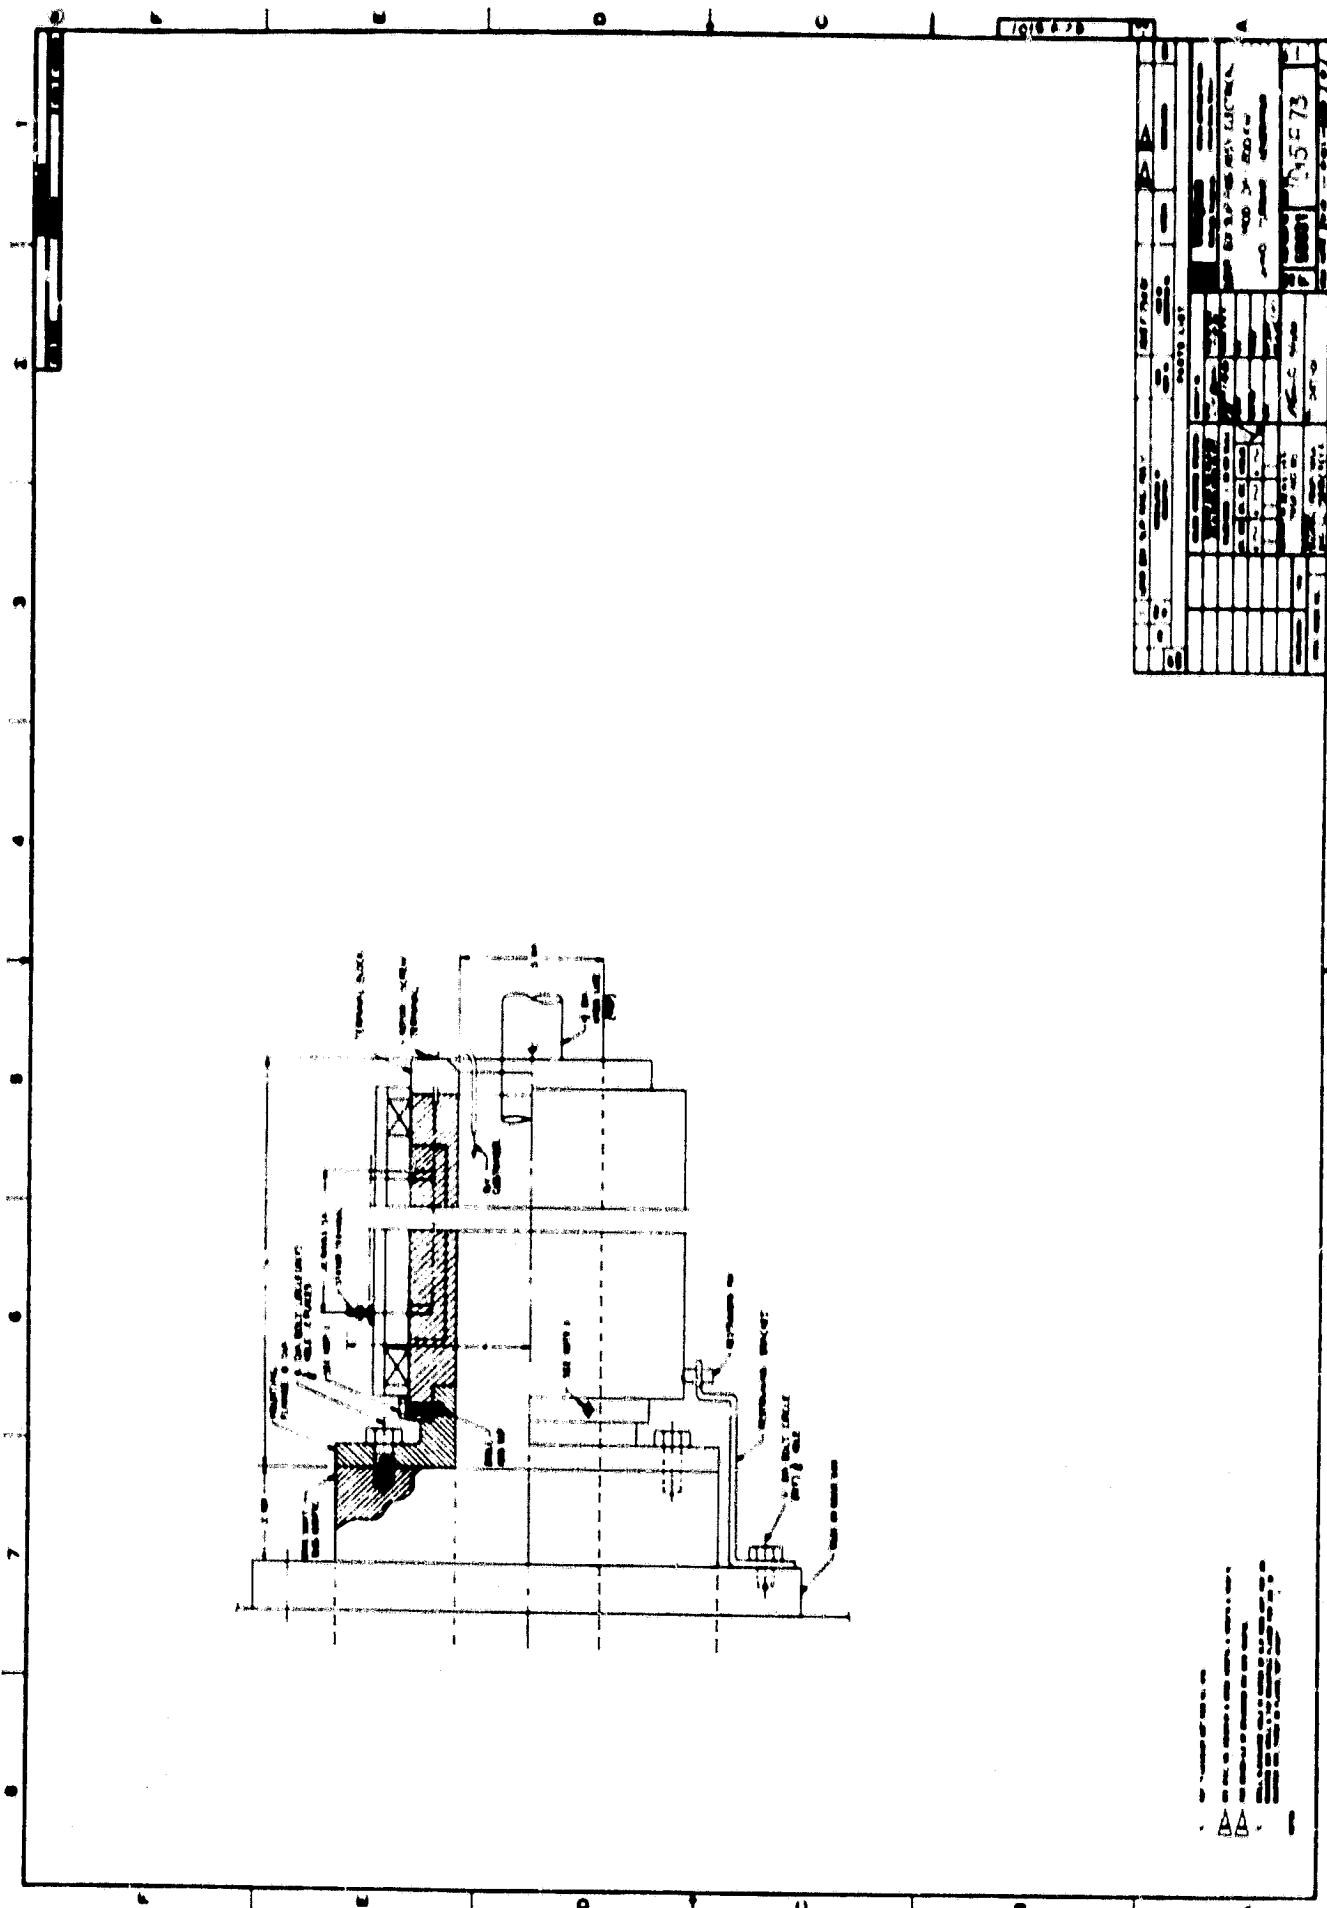


ALL DIMENSIONS ARE IN INCHES
 UNLESS OTHERWISE SPECIFIED
 FINISHES AND TOLERANCES AS SHOWN
 MATERIALS AND TREATMENTS AS SPECIFIED

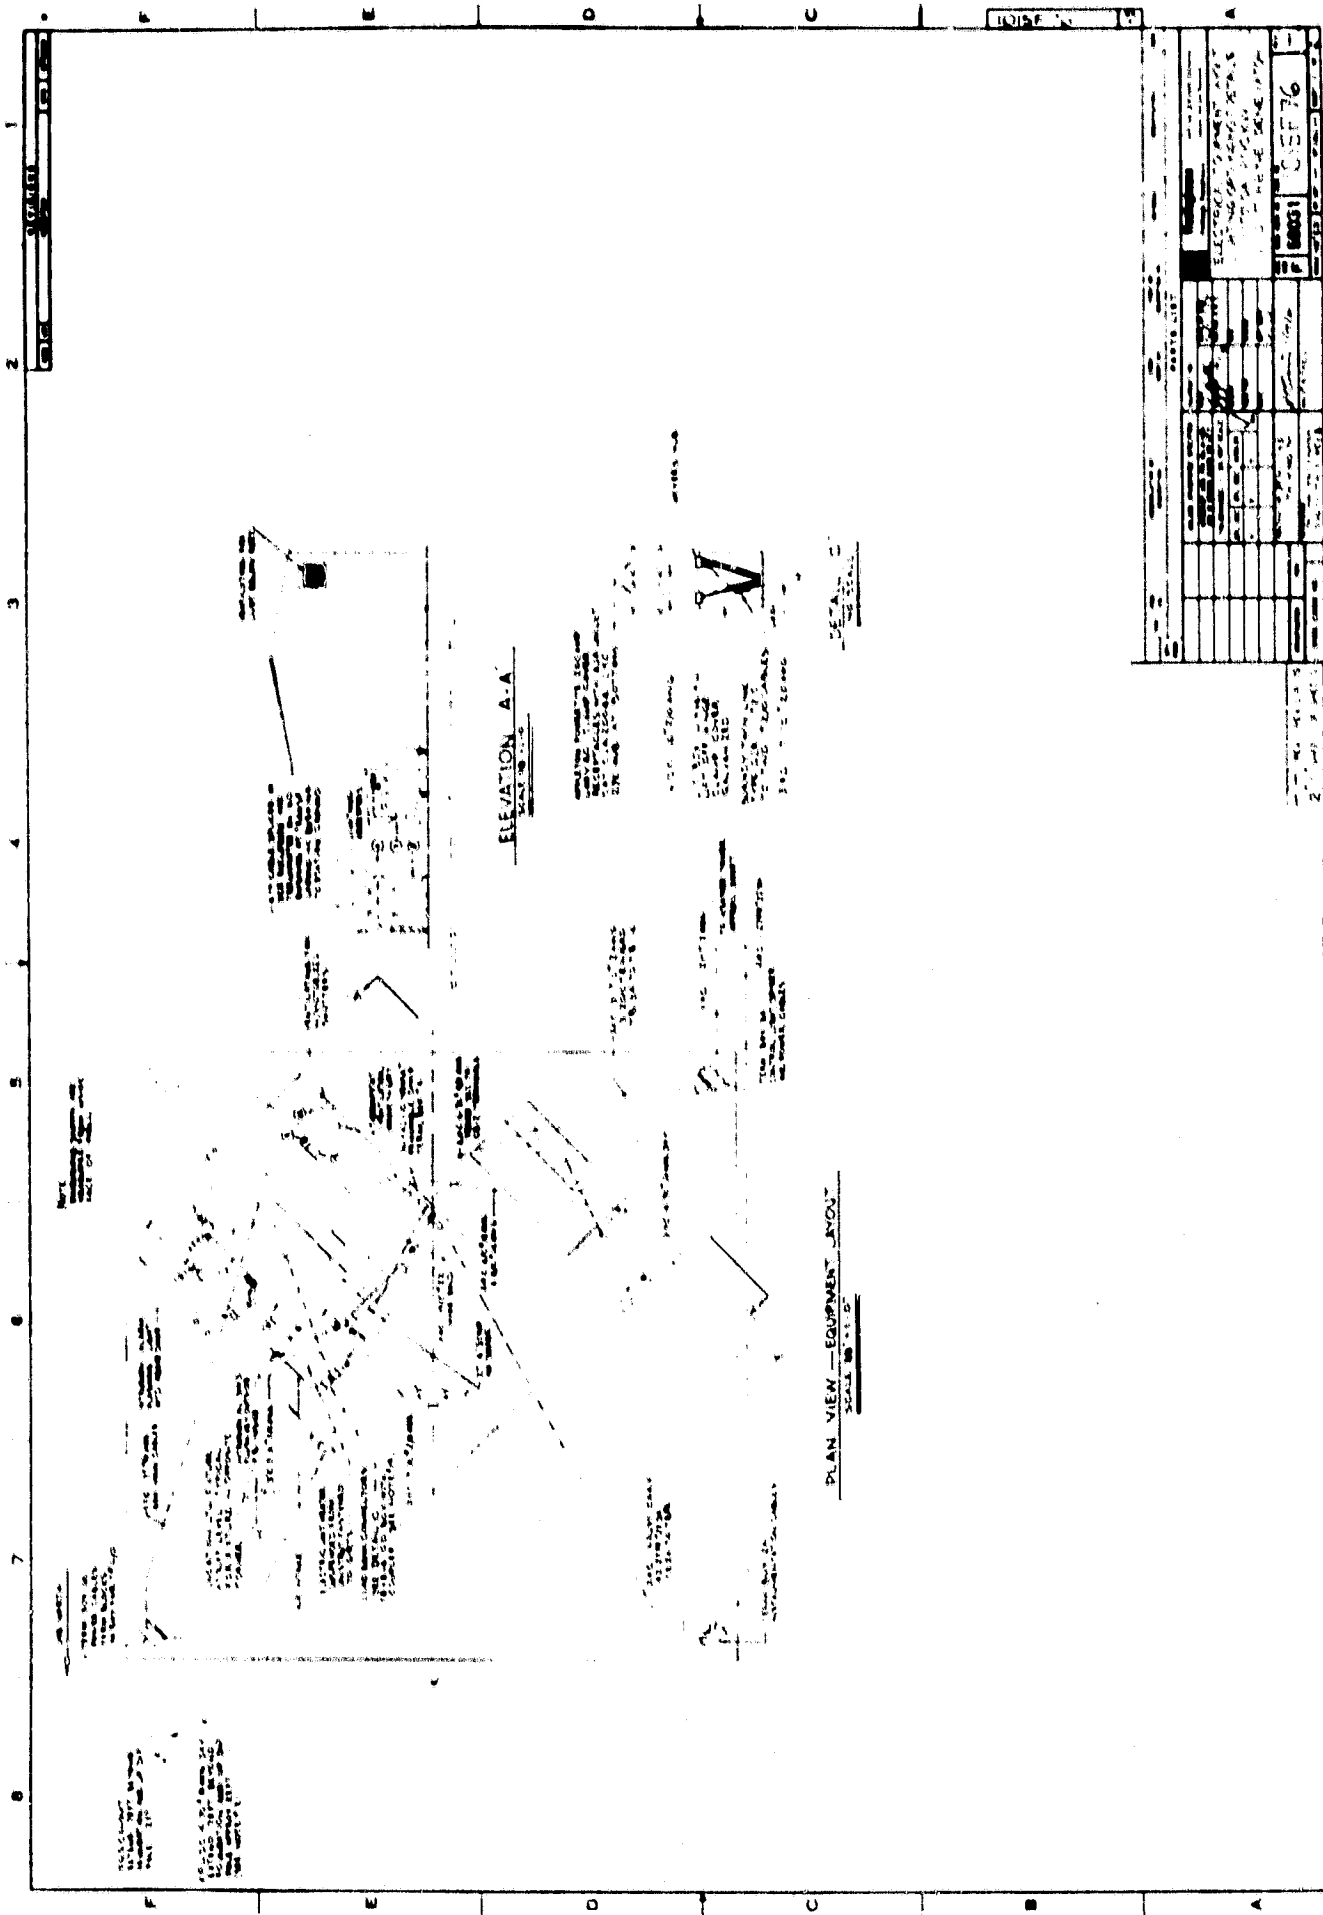


ELEVATION A-A
SCALE 1/8\"/>

PLAN VIEW - EQUIPMENT LAYOUT
SCALE 1/8\"/>

PROJECT NO. 10001
DATE 01/27/76

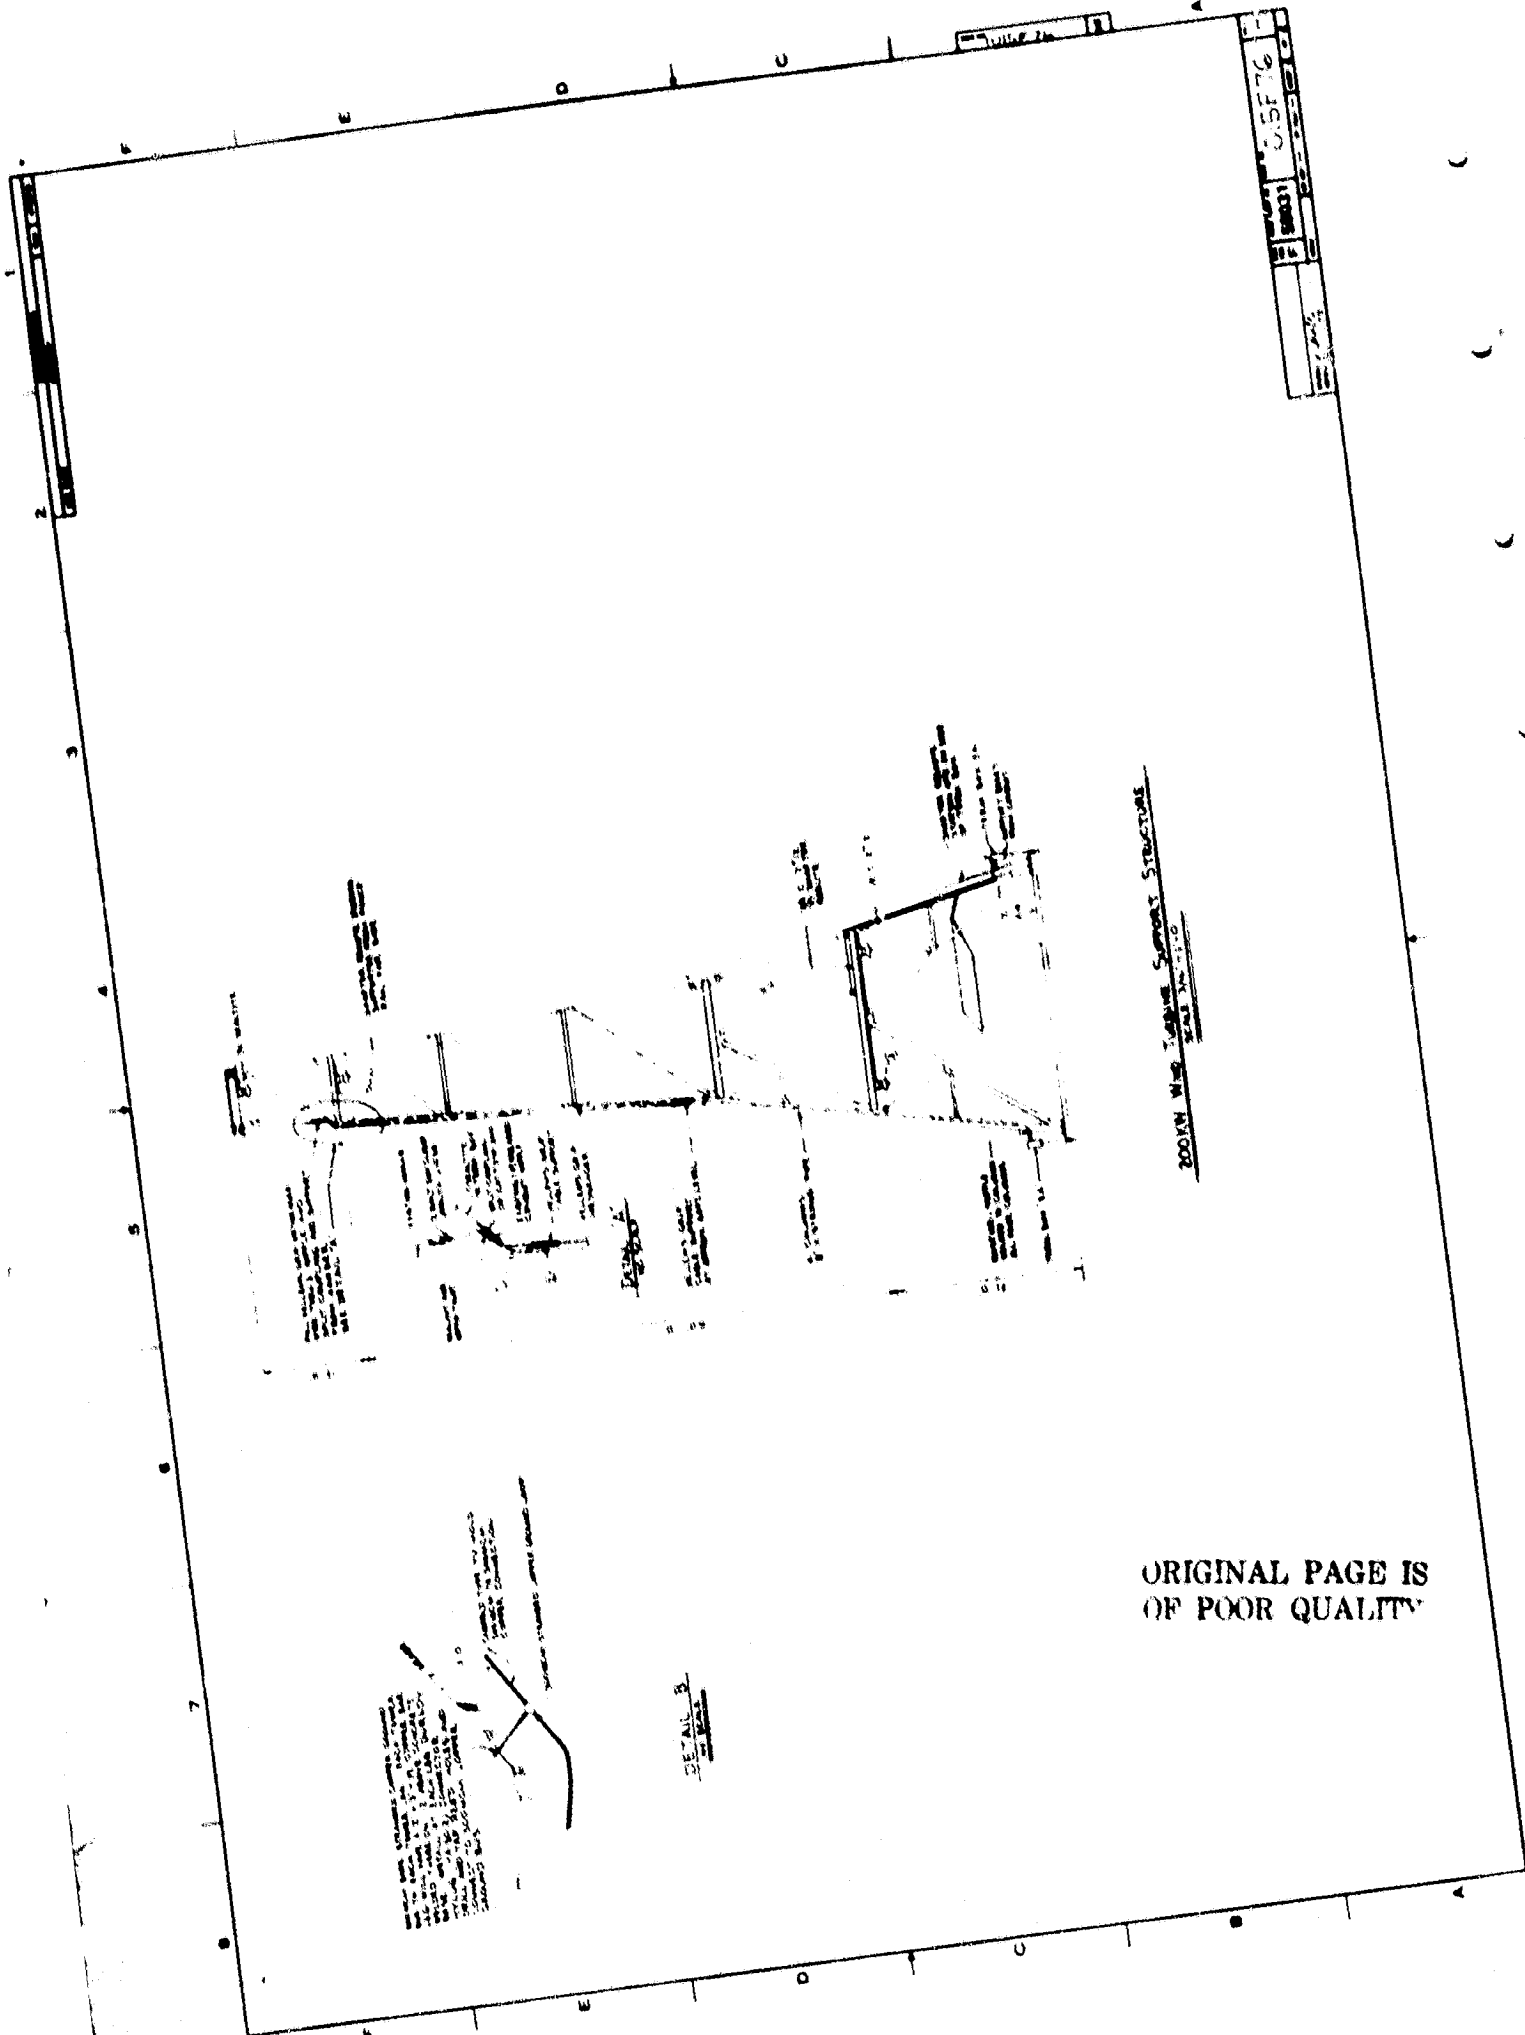




SCALE 1/8" = 1'-0"

DETAIL B


ORIGINAL PAGE IS
OF POOR QUALITY

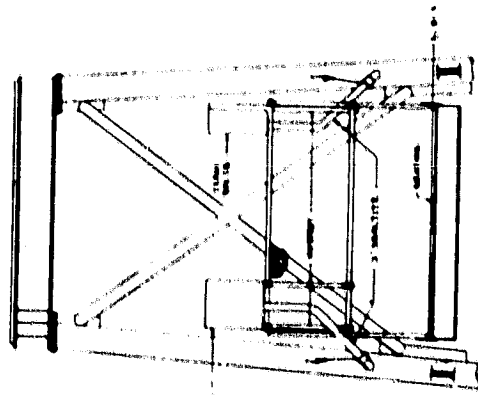


SECTION A-A
SCALE 1/2\"/>

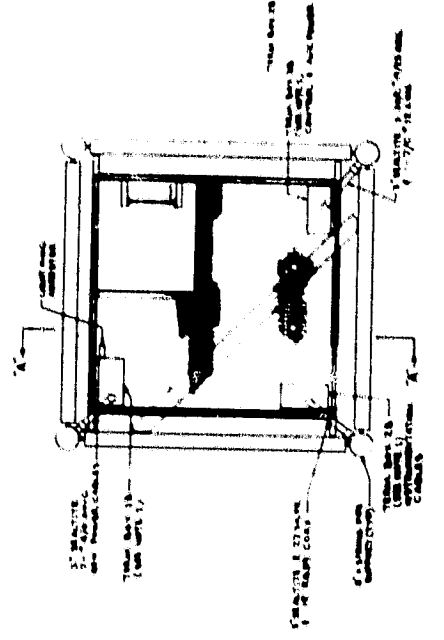

PLAN AT ELEVATION B-B
SCALE 1/2\"/>

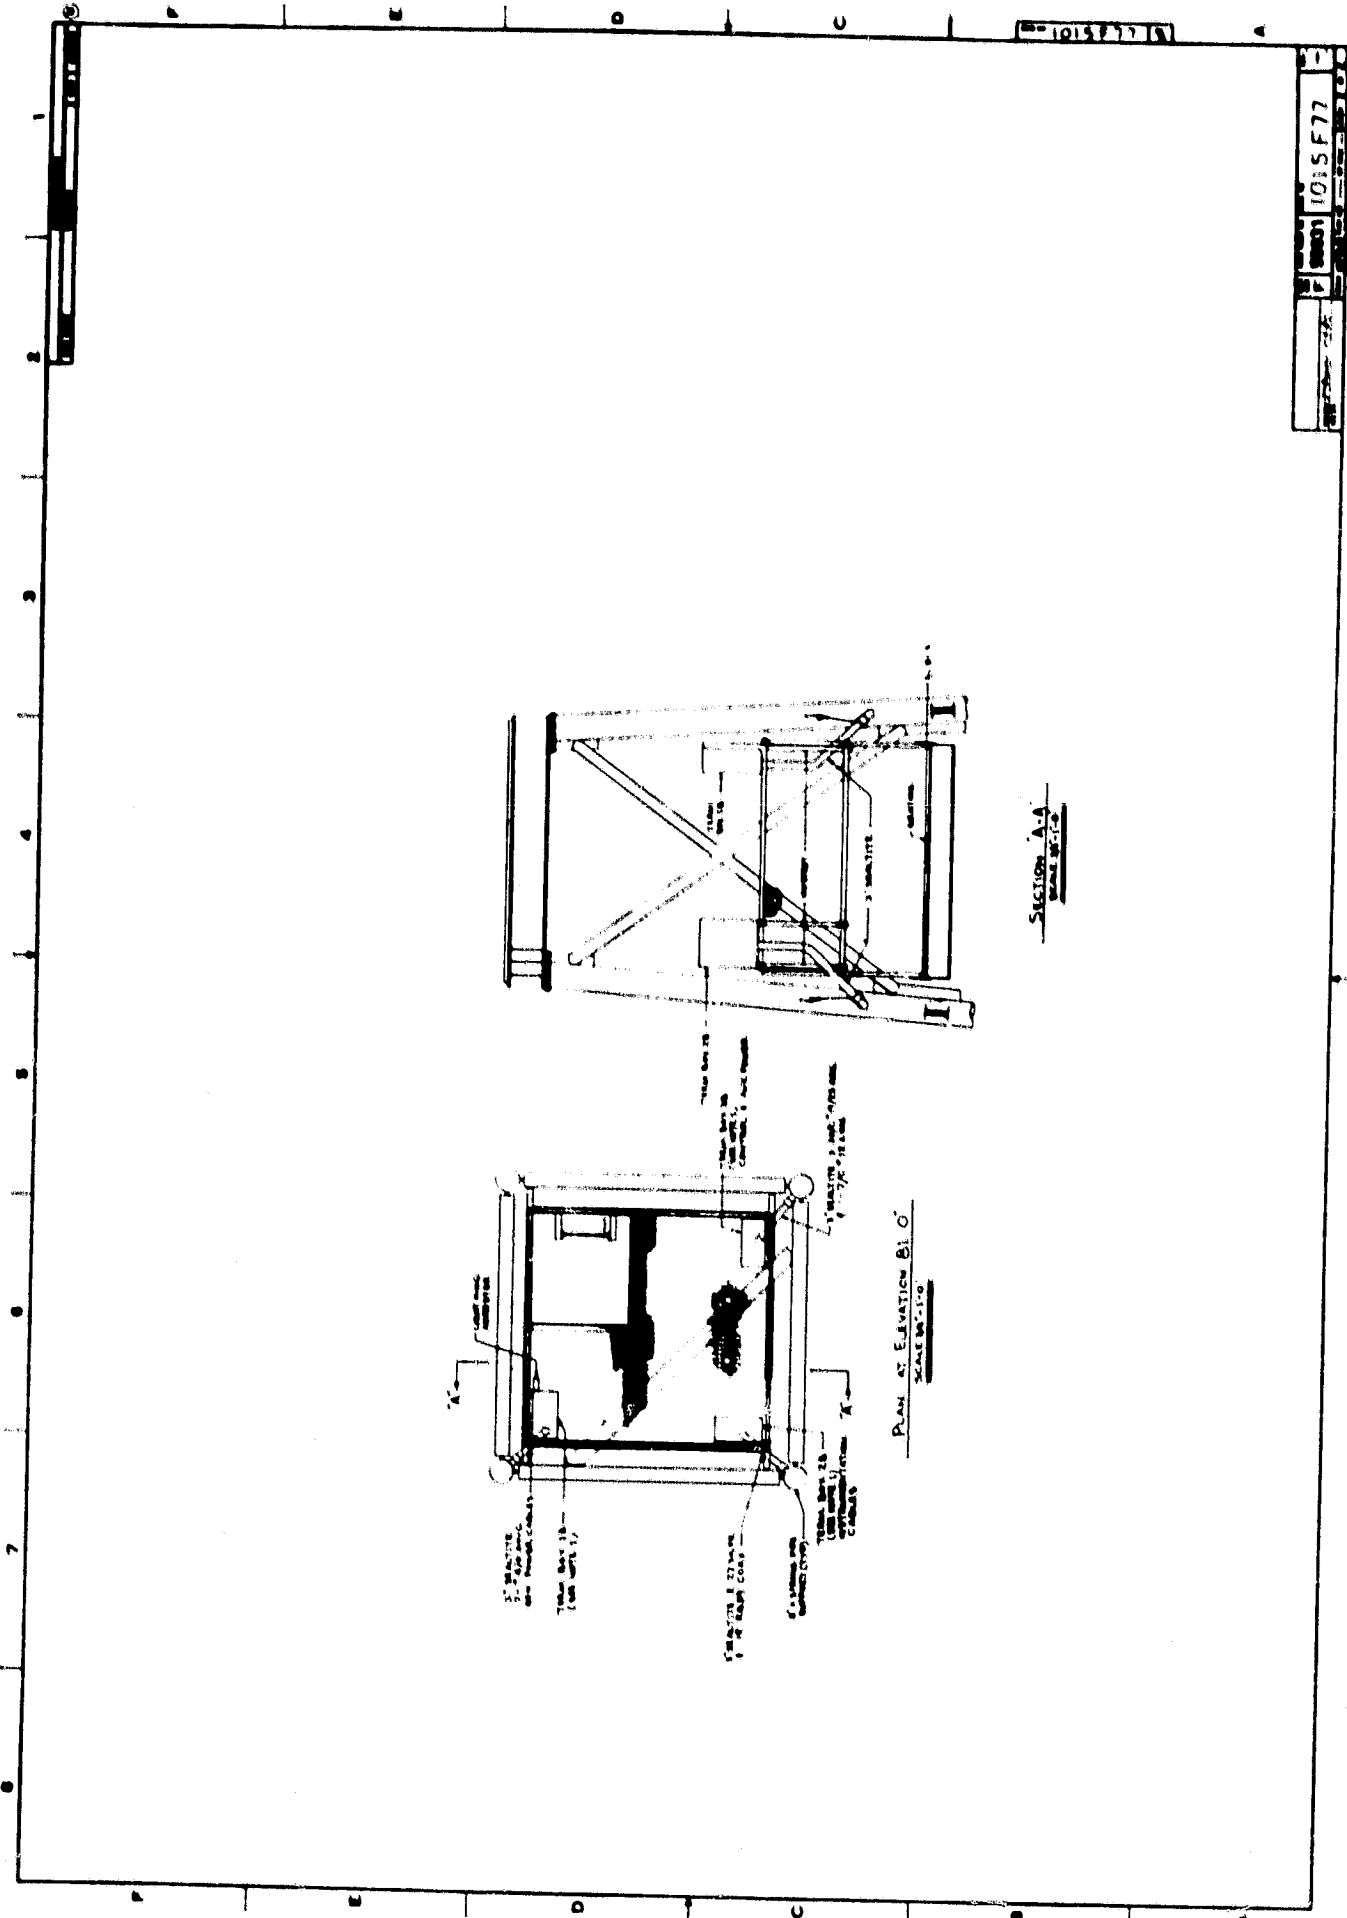

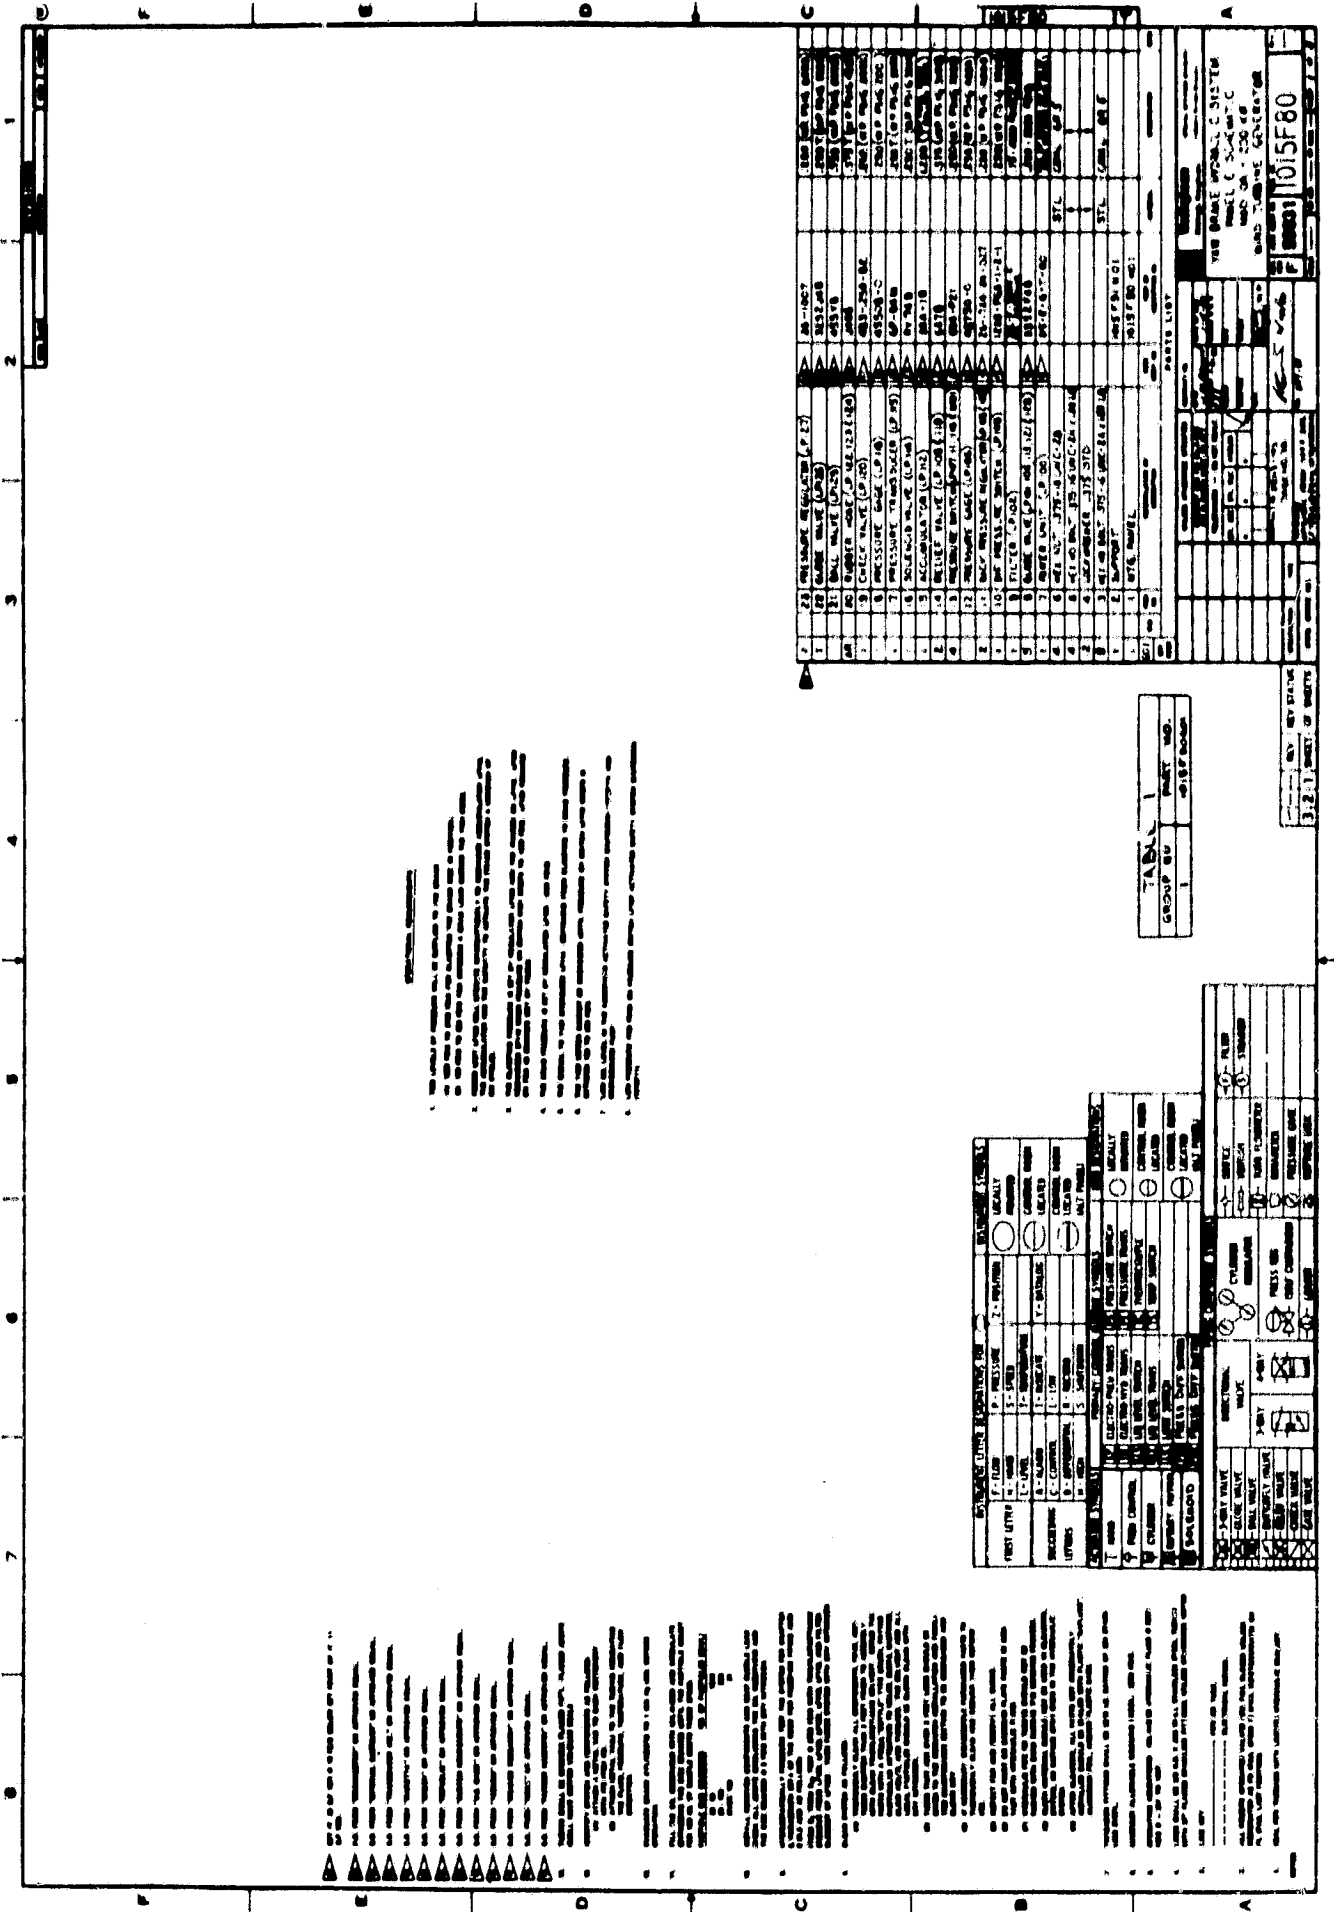
























TABLE 1	
GROUP NO.	PART NO.
1	015F80





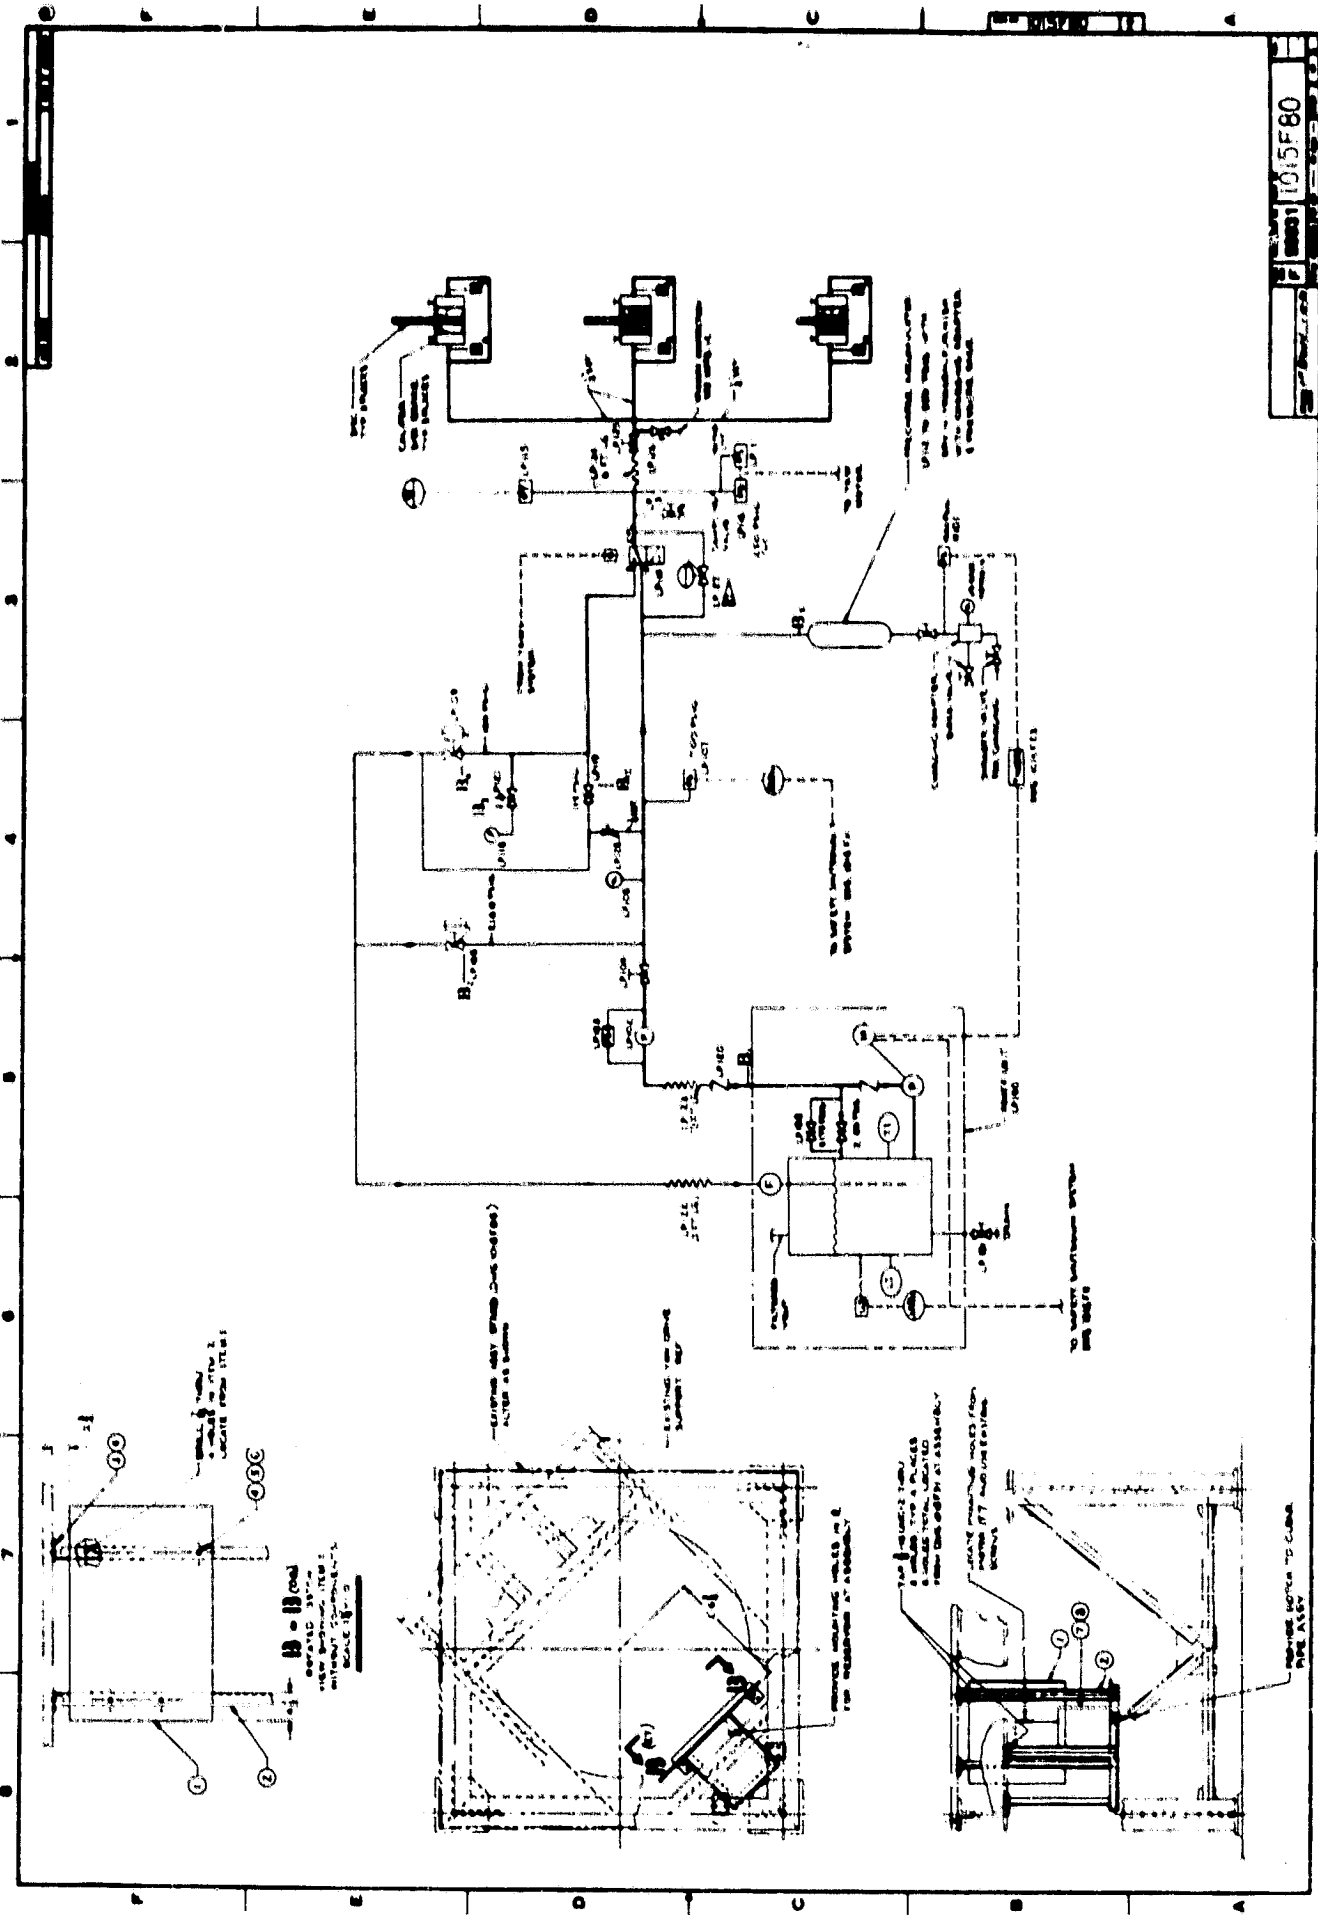



1 2 3 4 5 6 7 8

9 10 11 12 13 14 15 16 17 18 19 20

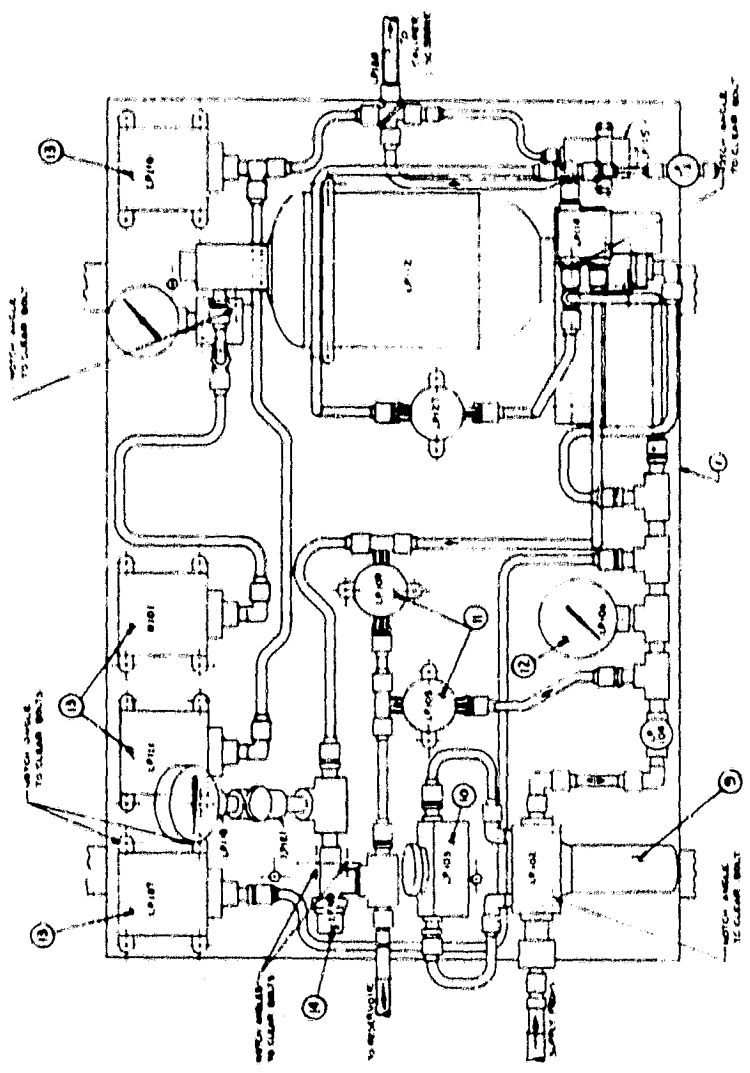

PANEL ASSEMBLY
SCALE 1/4"

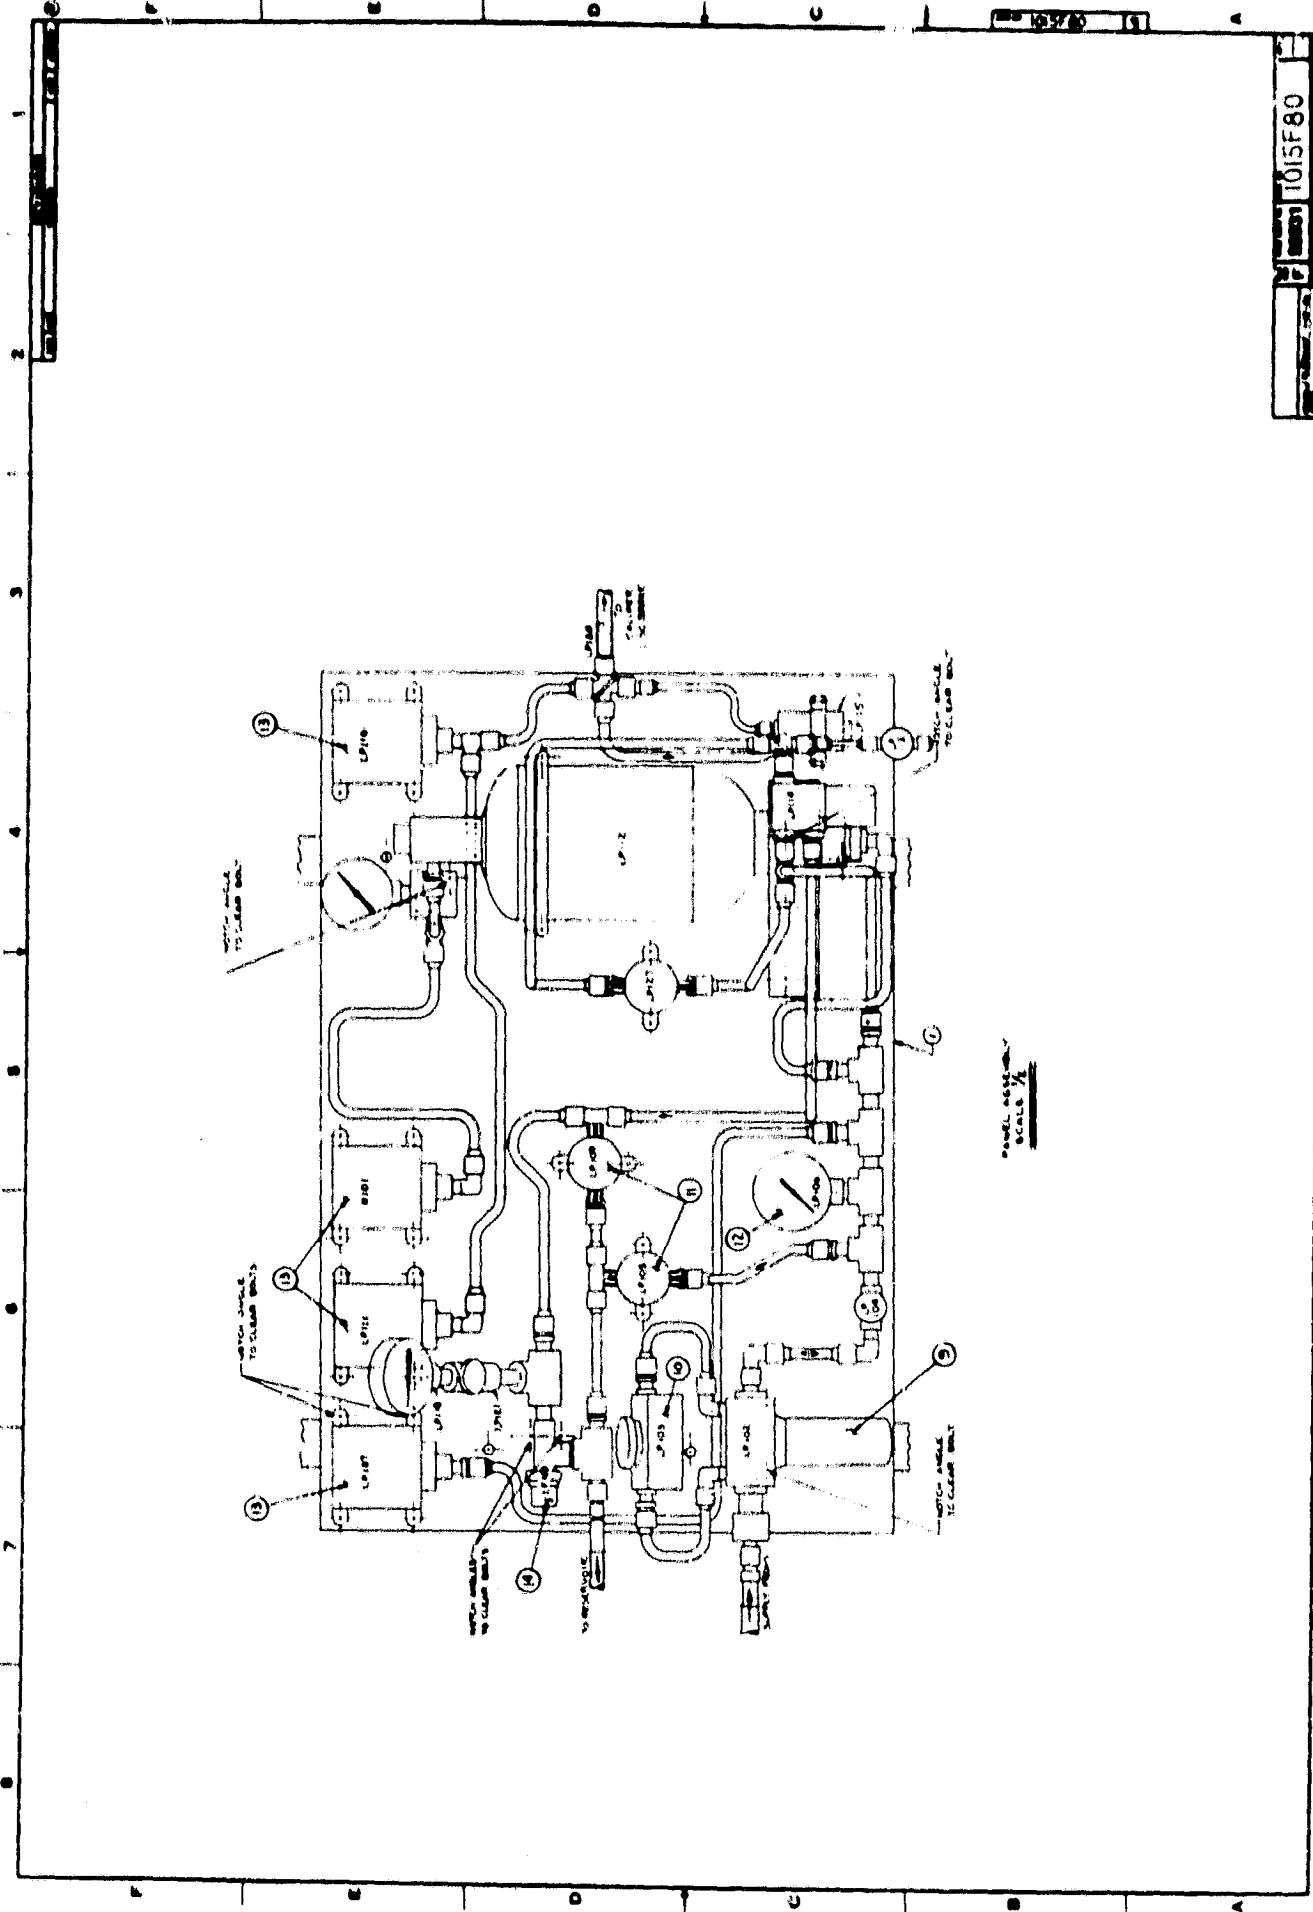


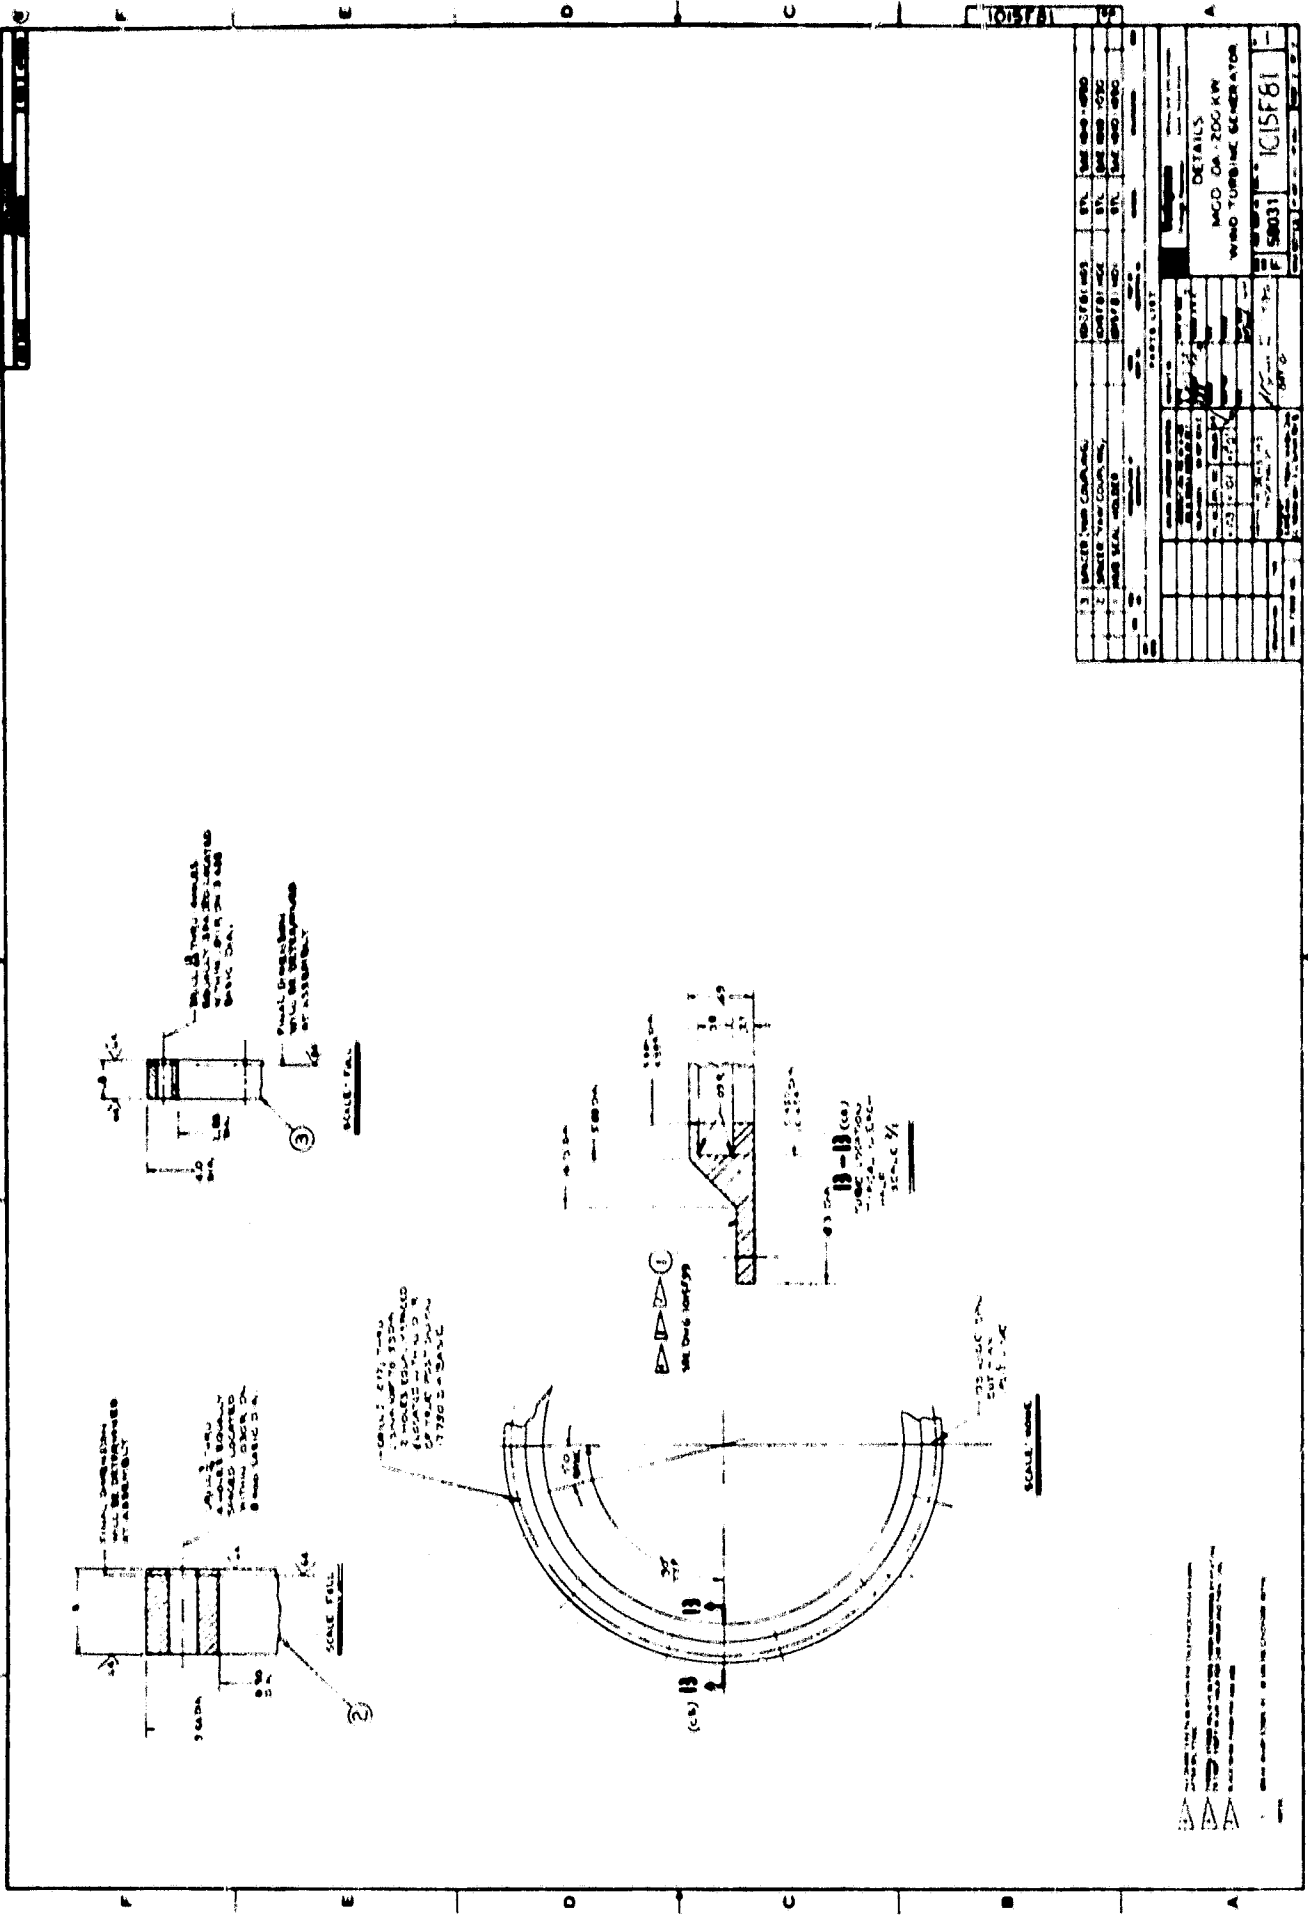


PARTS LIST	
QTY	DESCRIPTION

DETAILS	
MCD OR 200KW WIND TURBINE GENERATOR	
REV.	1
DATE	
BY	
CHKD.	

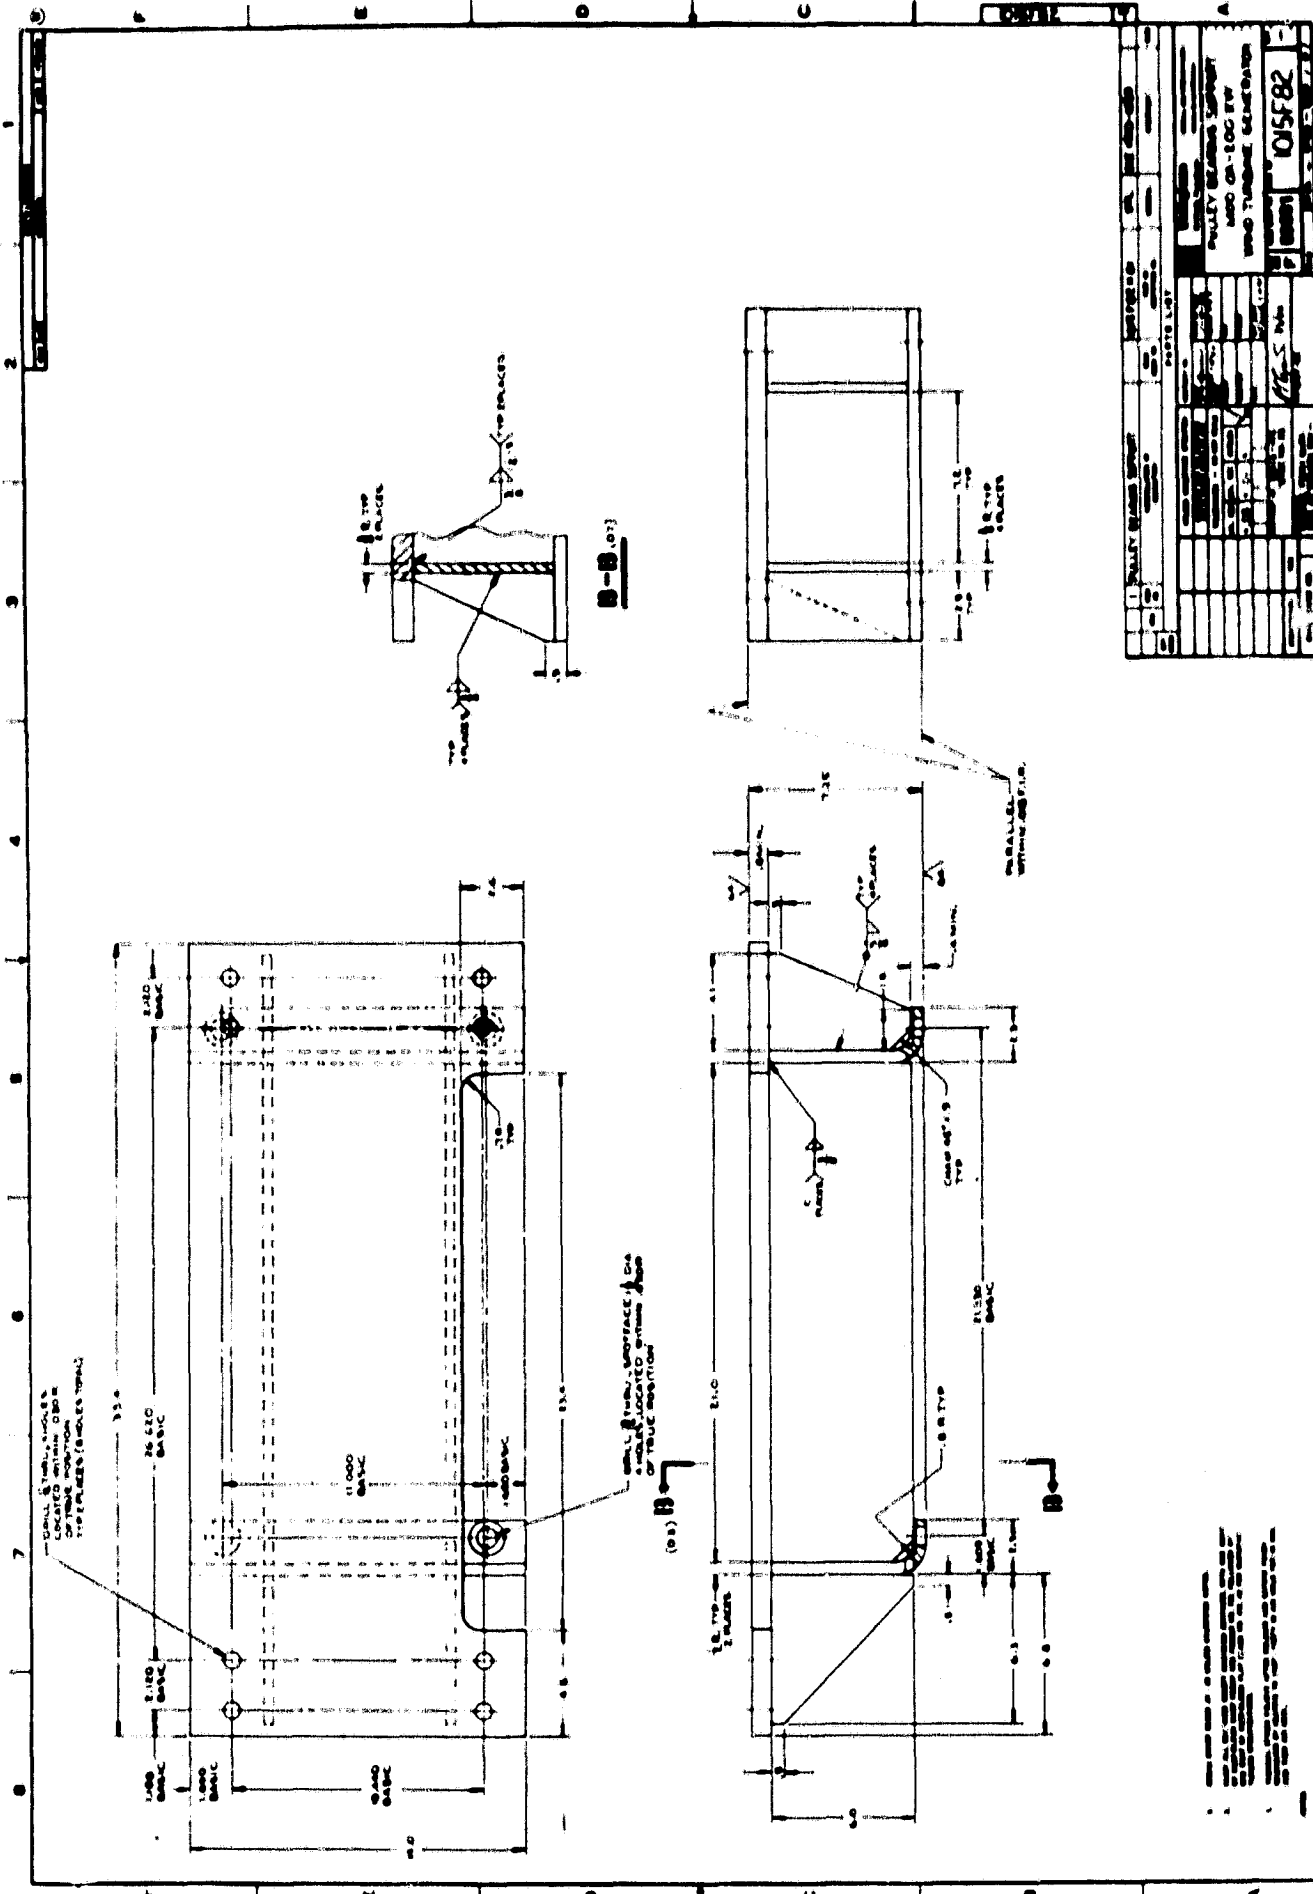



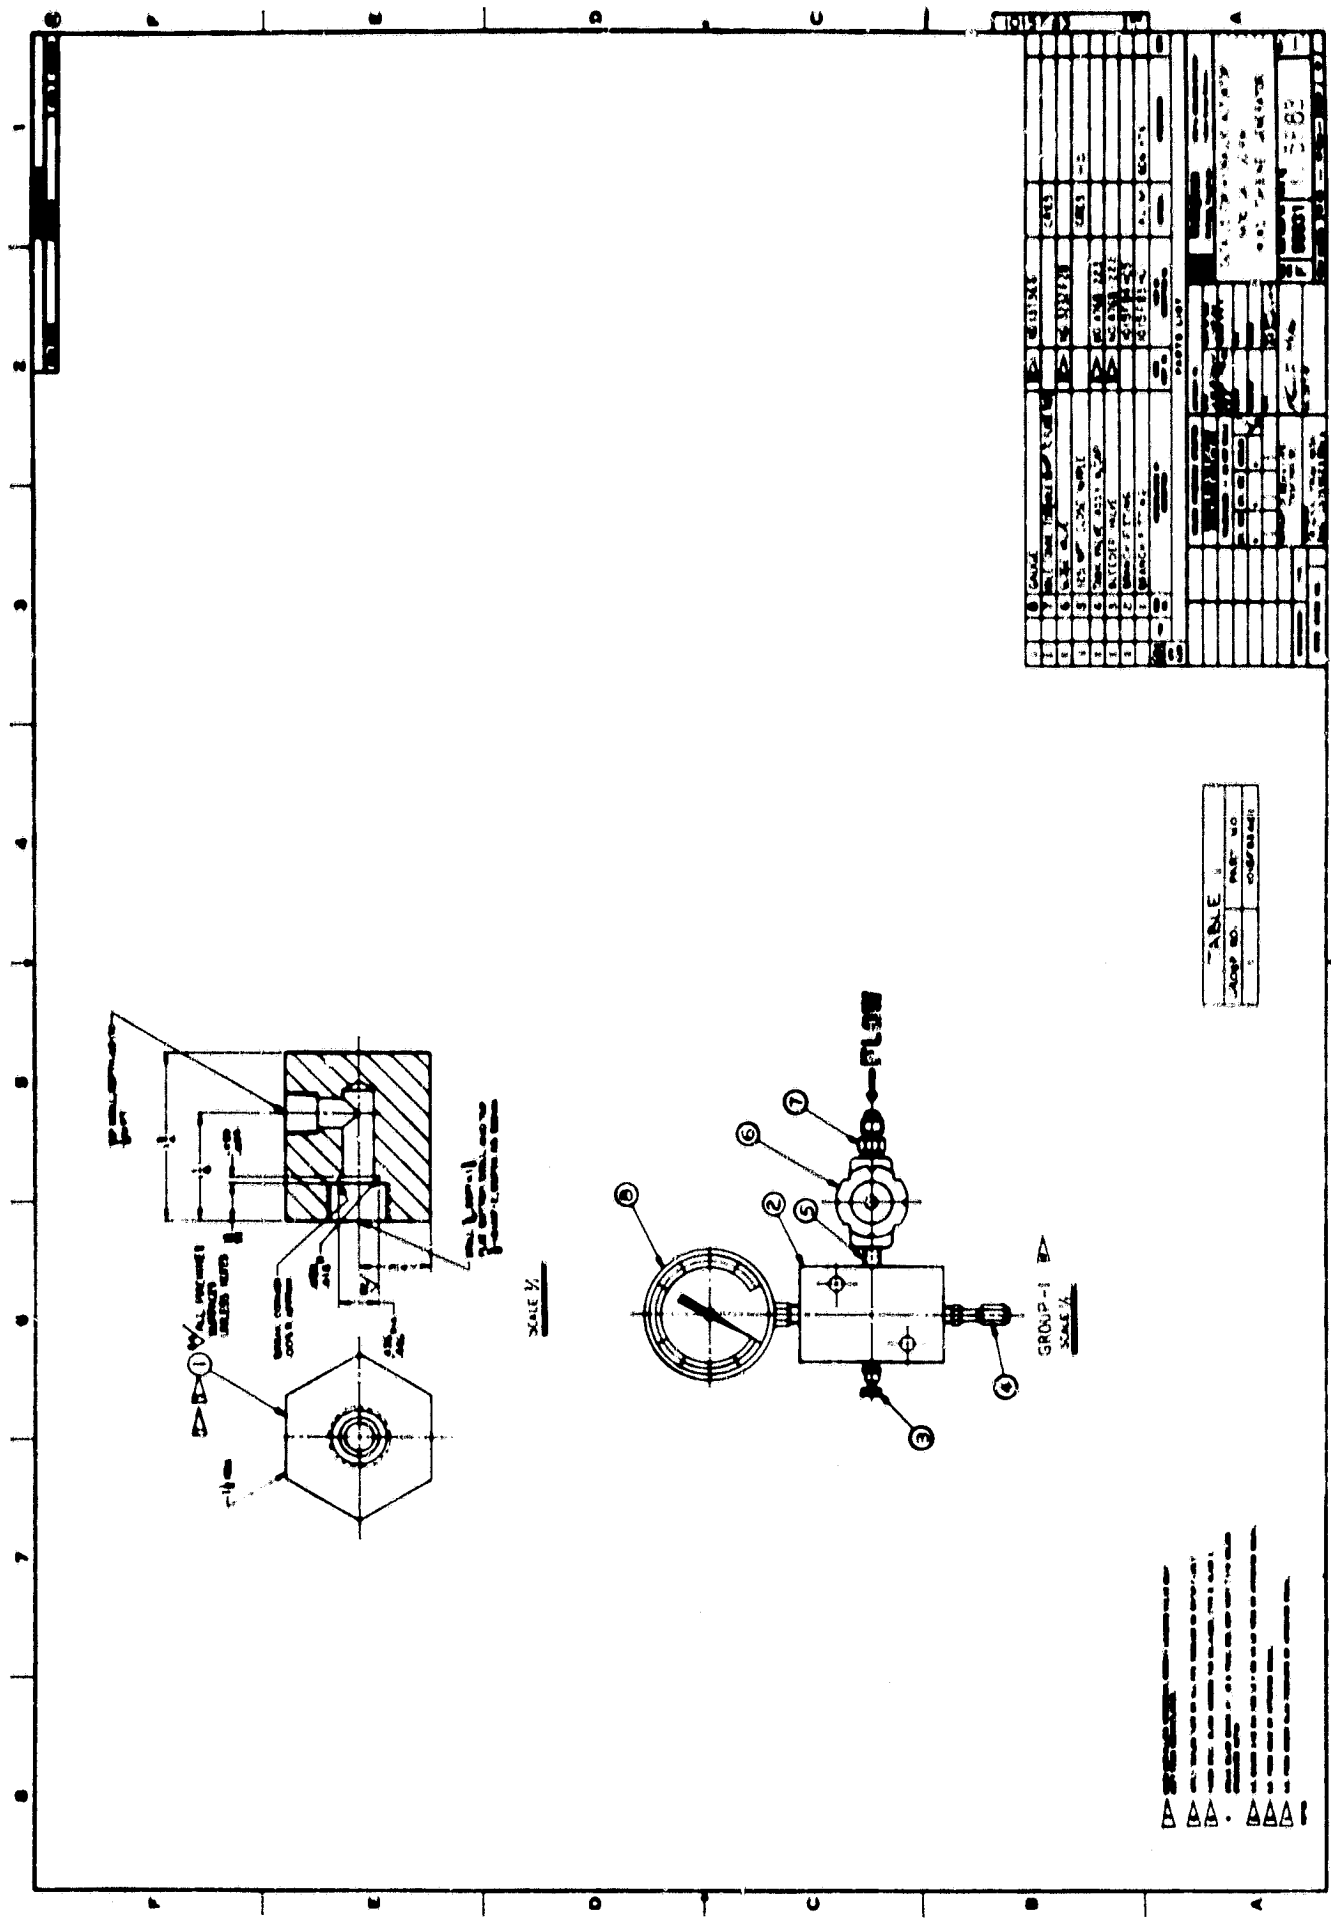


TABLE 1		
JOB NO.	FILE NO.	COMPONENT

PARTS LIST			

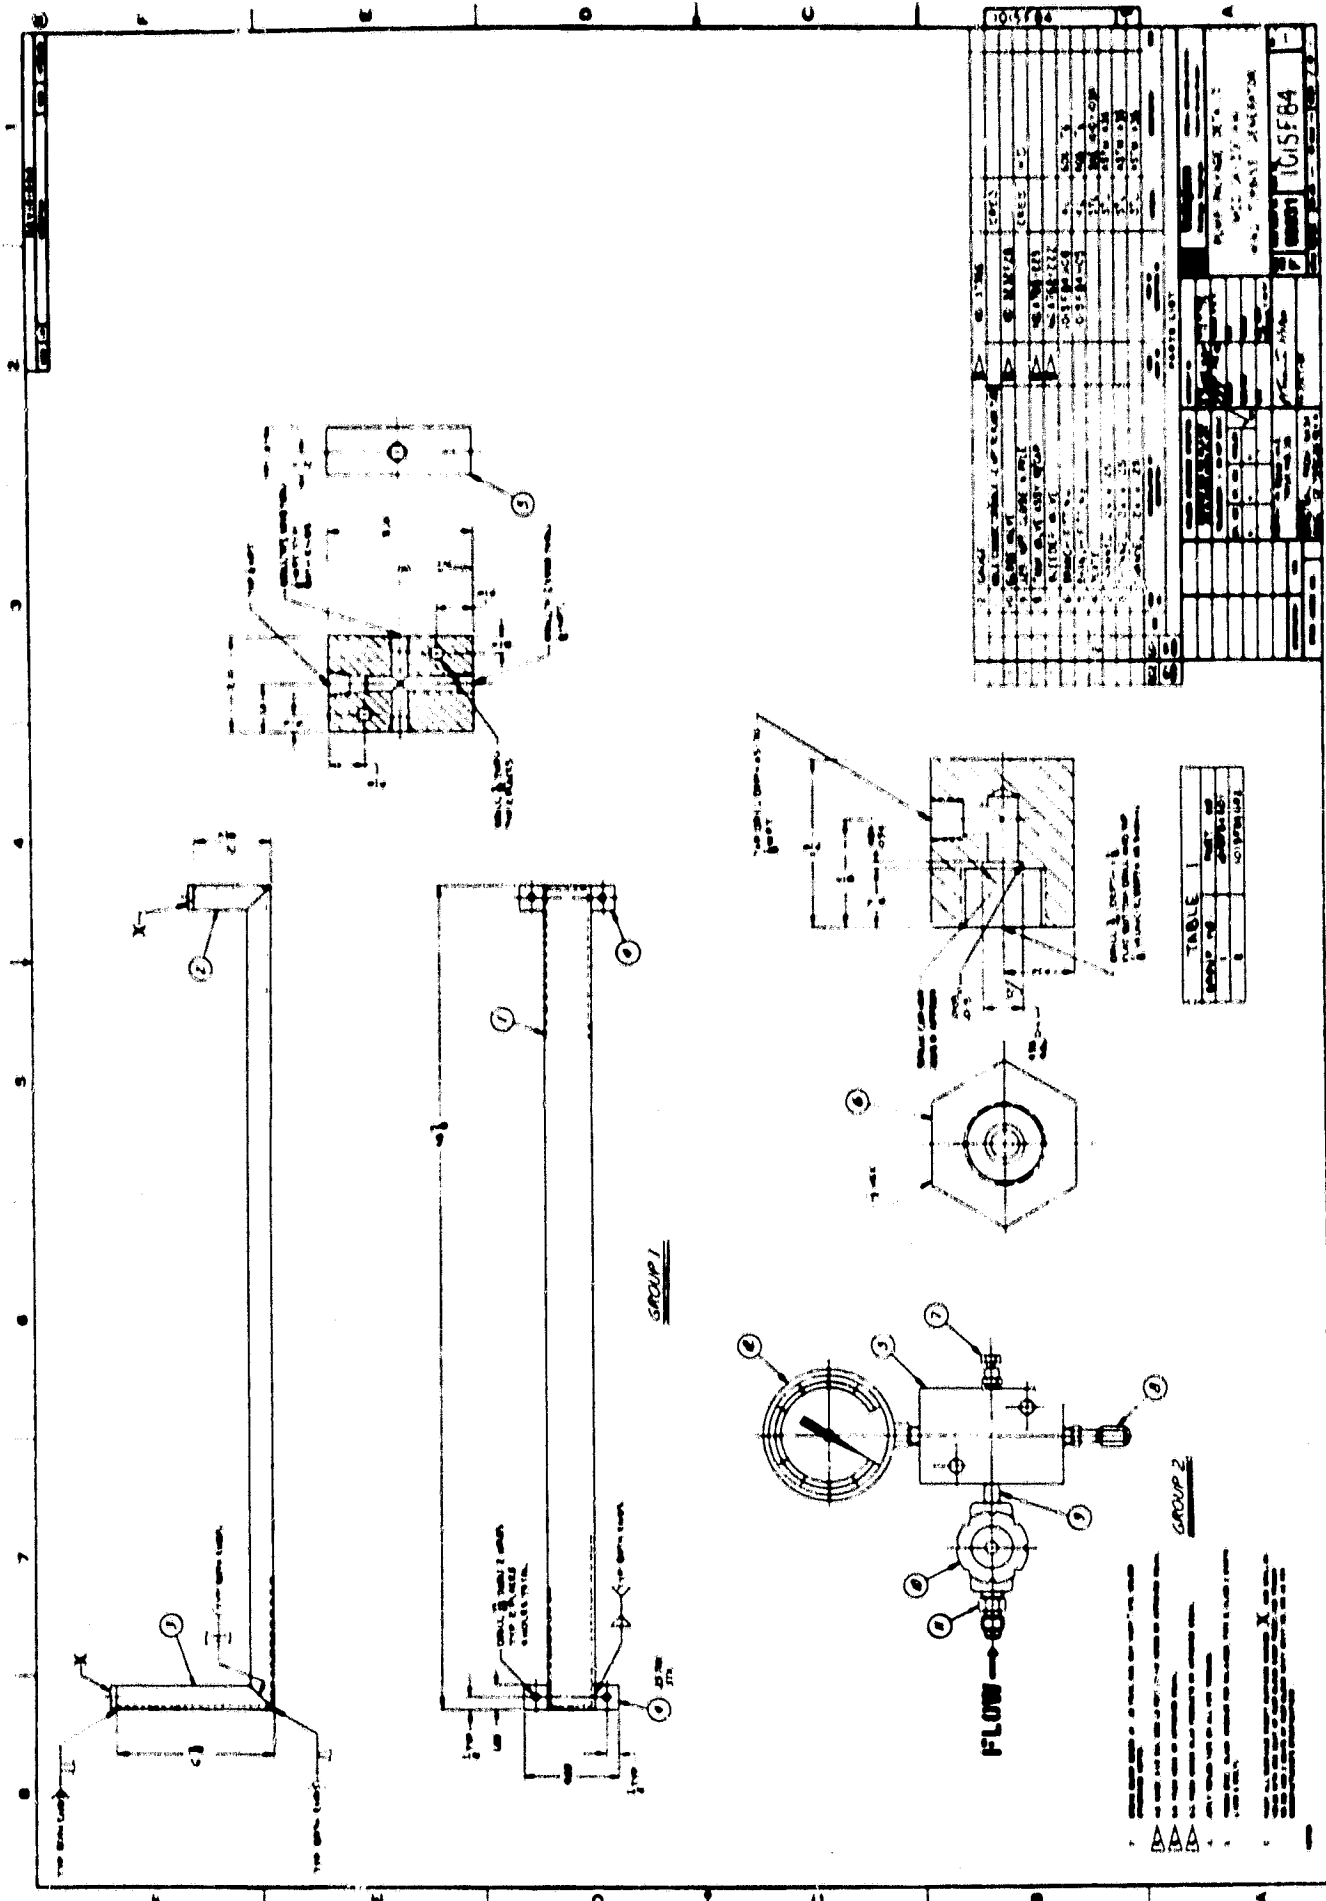

1	2	3	4	5	6	7	8
---	---	---	---	---	---	---	---



GROUP 1

GROUP 2




















































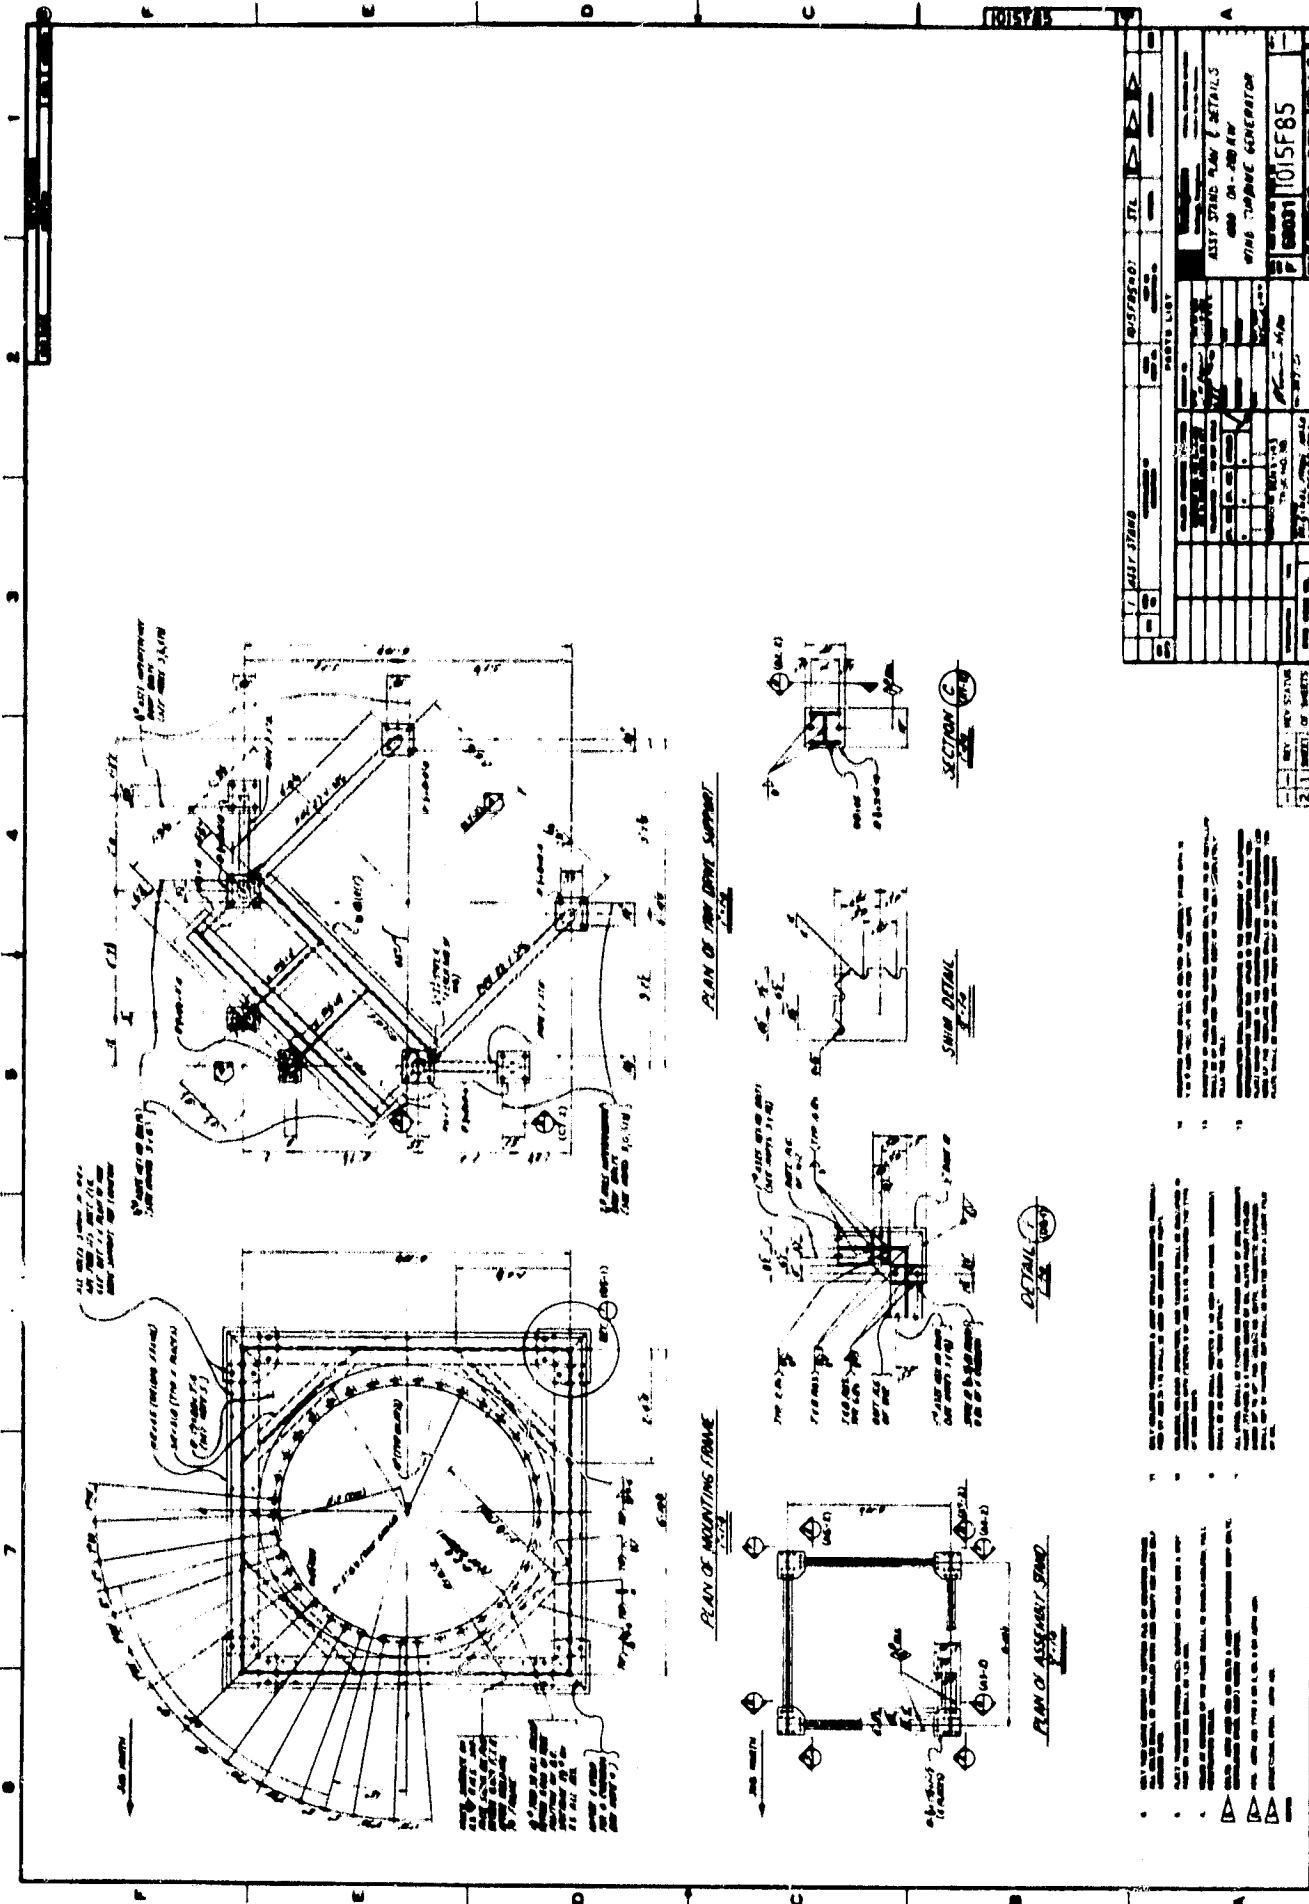

ALL DIMENSIONS TO FACE UNLESS OTHERWISE SPECIFIED. ALL DIMENSIONS TO BE CHECKED BY THE FABRICATOR.

MEASUREMENTS TAKEN FROM THE CENTER OF THE FRAME TO THE CENTER OF THE ENGINE SUPPORT.



PLAN OF MOUNTING FRAME

PLAN OF ASSEMBLY STAND

SECTION C

SHIM DETAIL

DETAIL D






PLAN OF ASSEMBLY STAND






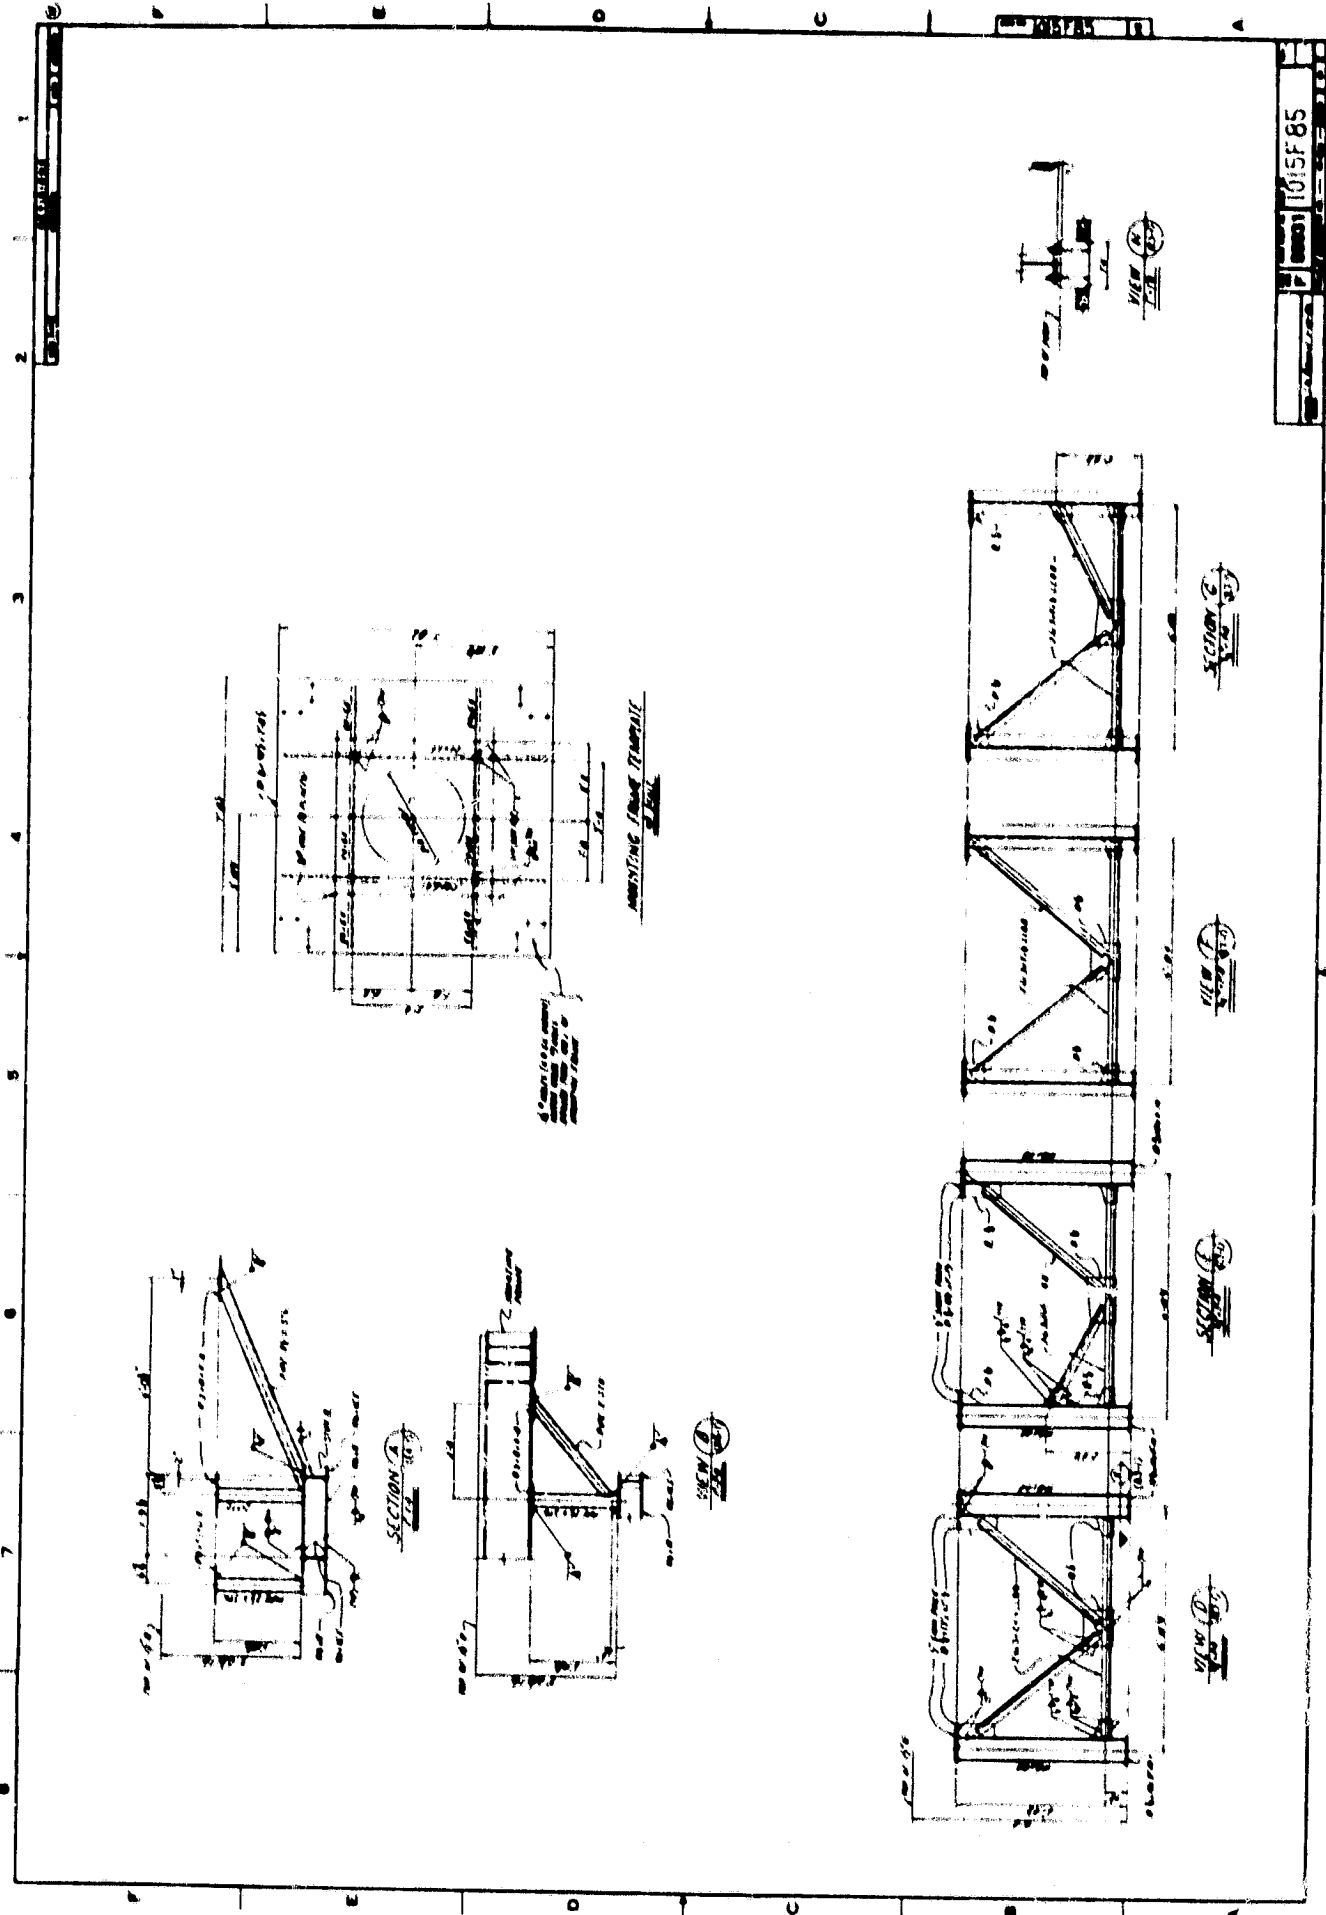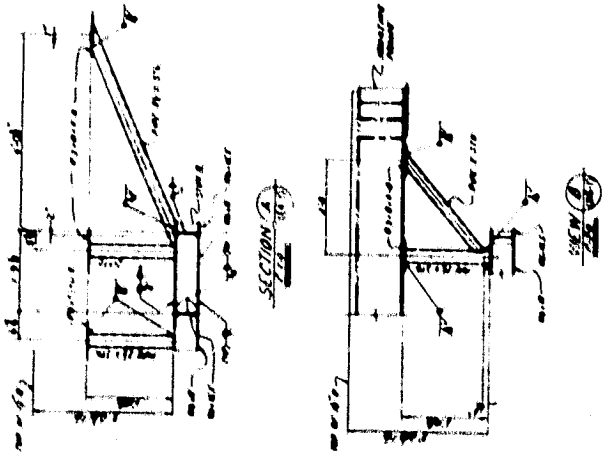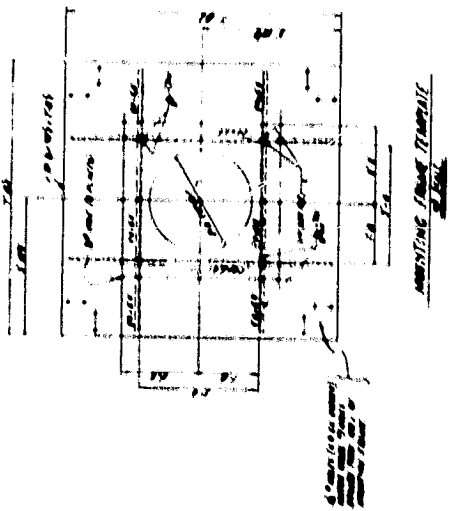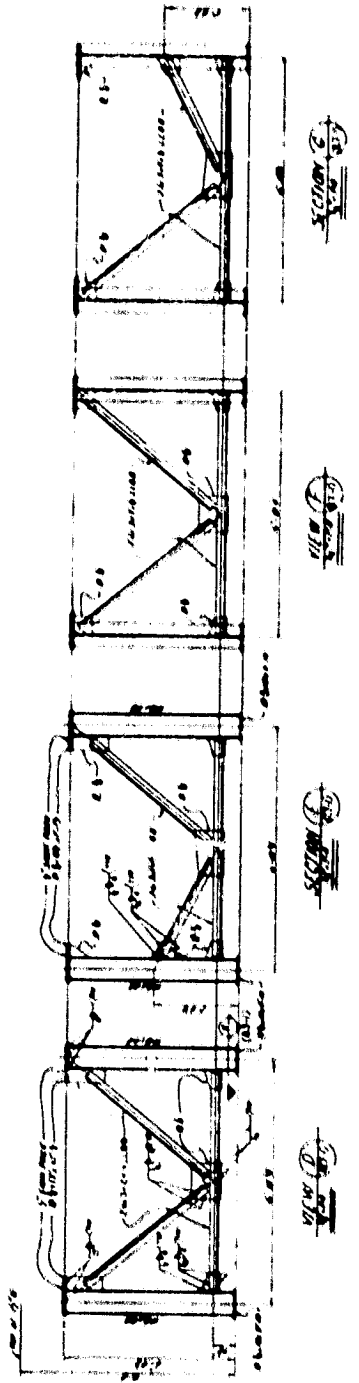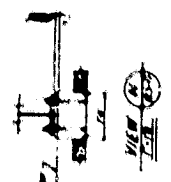

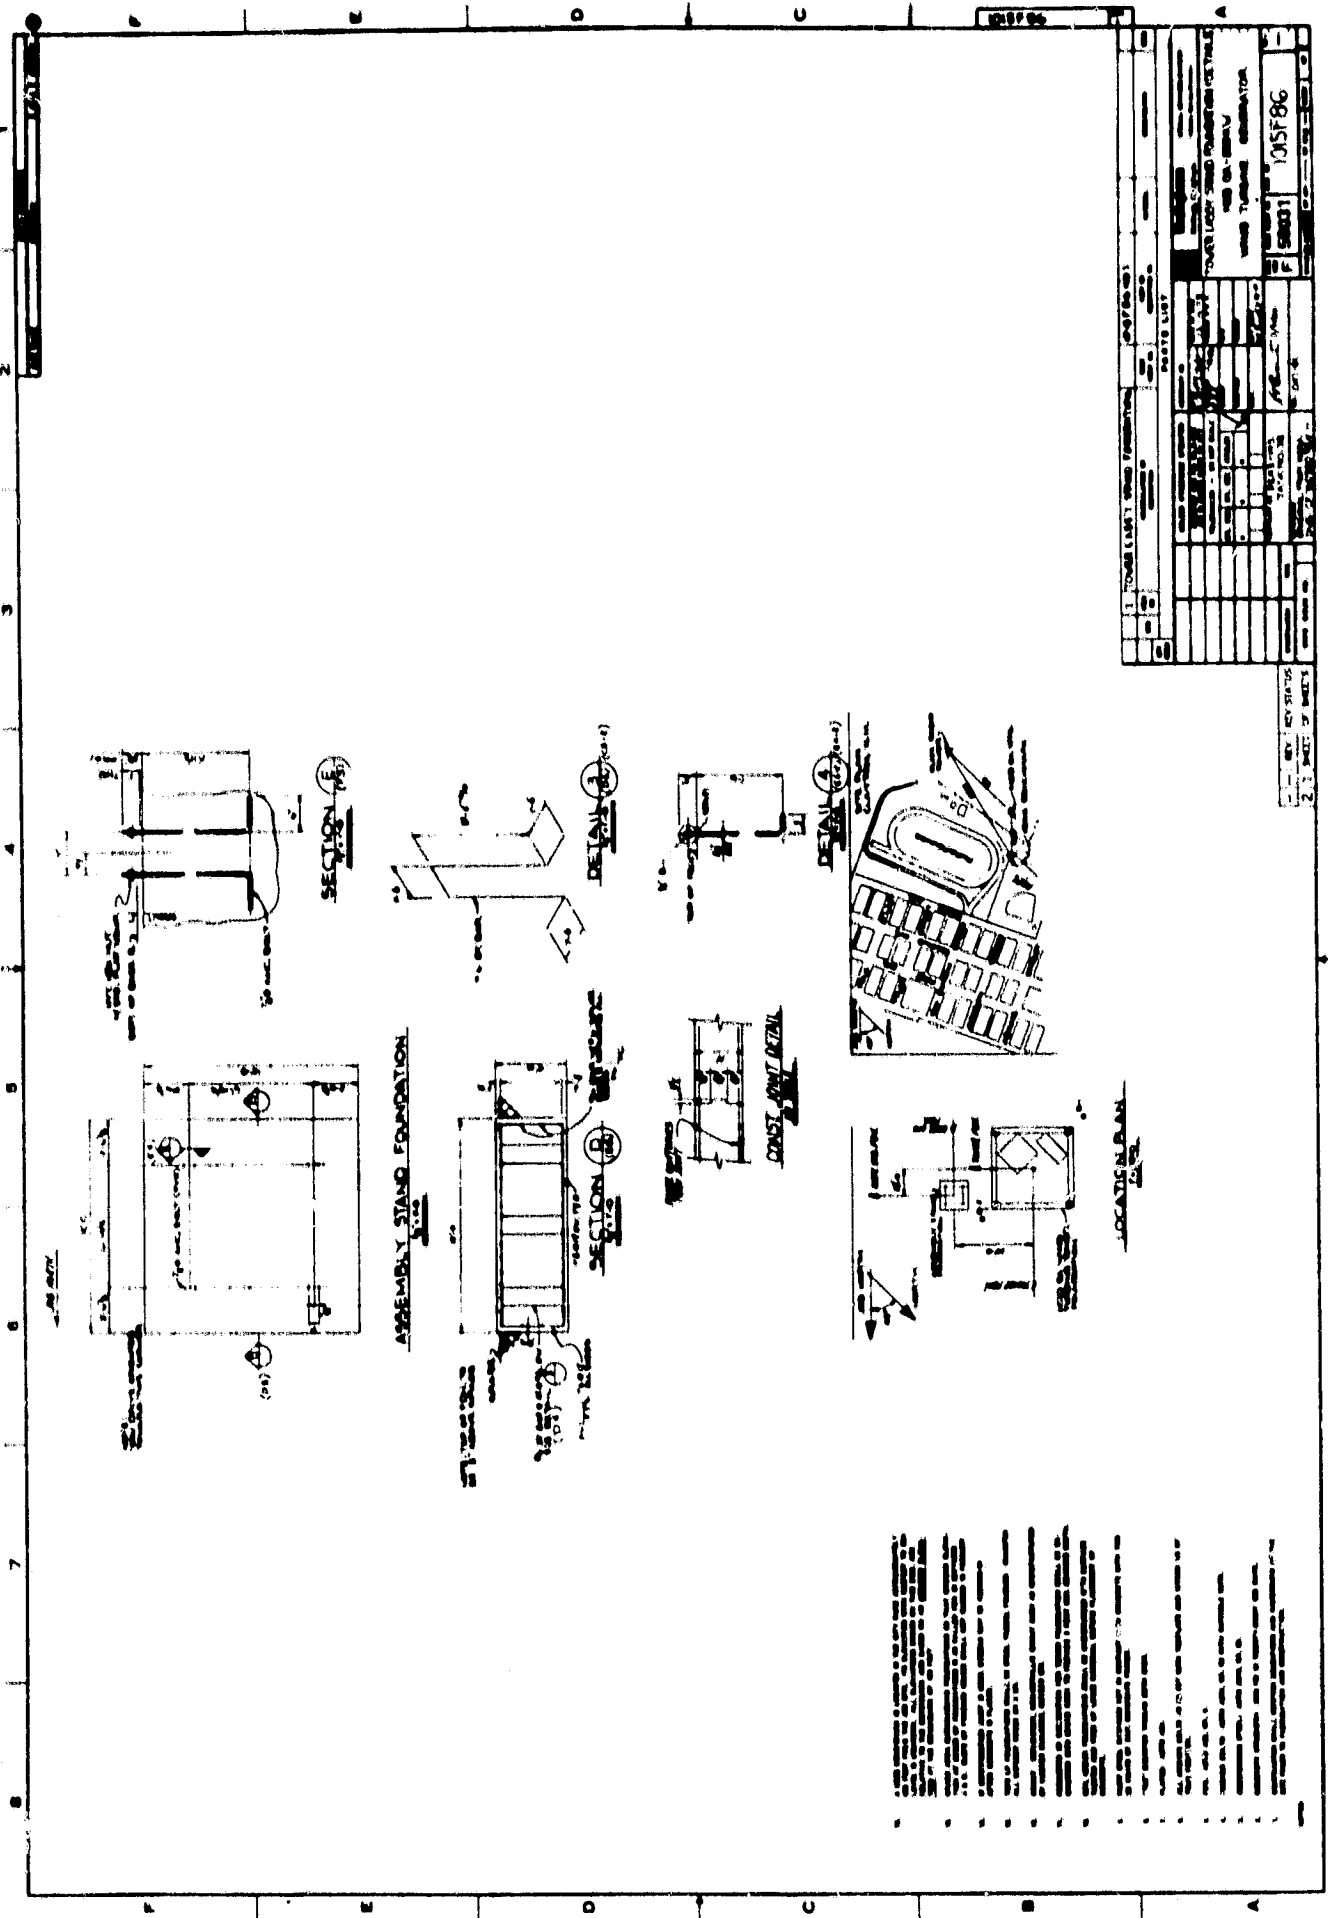


TOWER LIGHT STAND FOUNDATION		DATE LIST	
NO.	DESCRIPTION	DATE	BY
1	TOWER LIGHT STAND FOUNDATION		

2. SHEET OF 105F86

1. THE FOUNDATION SHALL BE CONSTRUCTED IN ACCORDANCE WITH THE FOLLOWING SPECIFICATIONS:


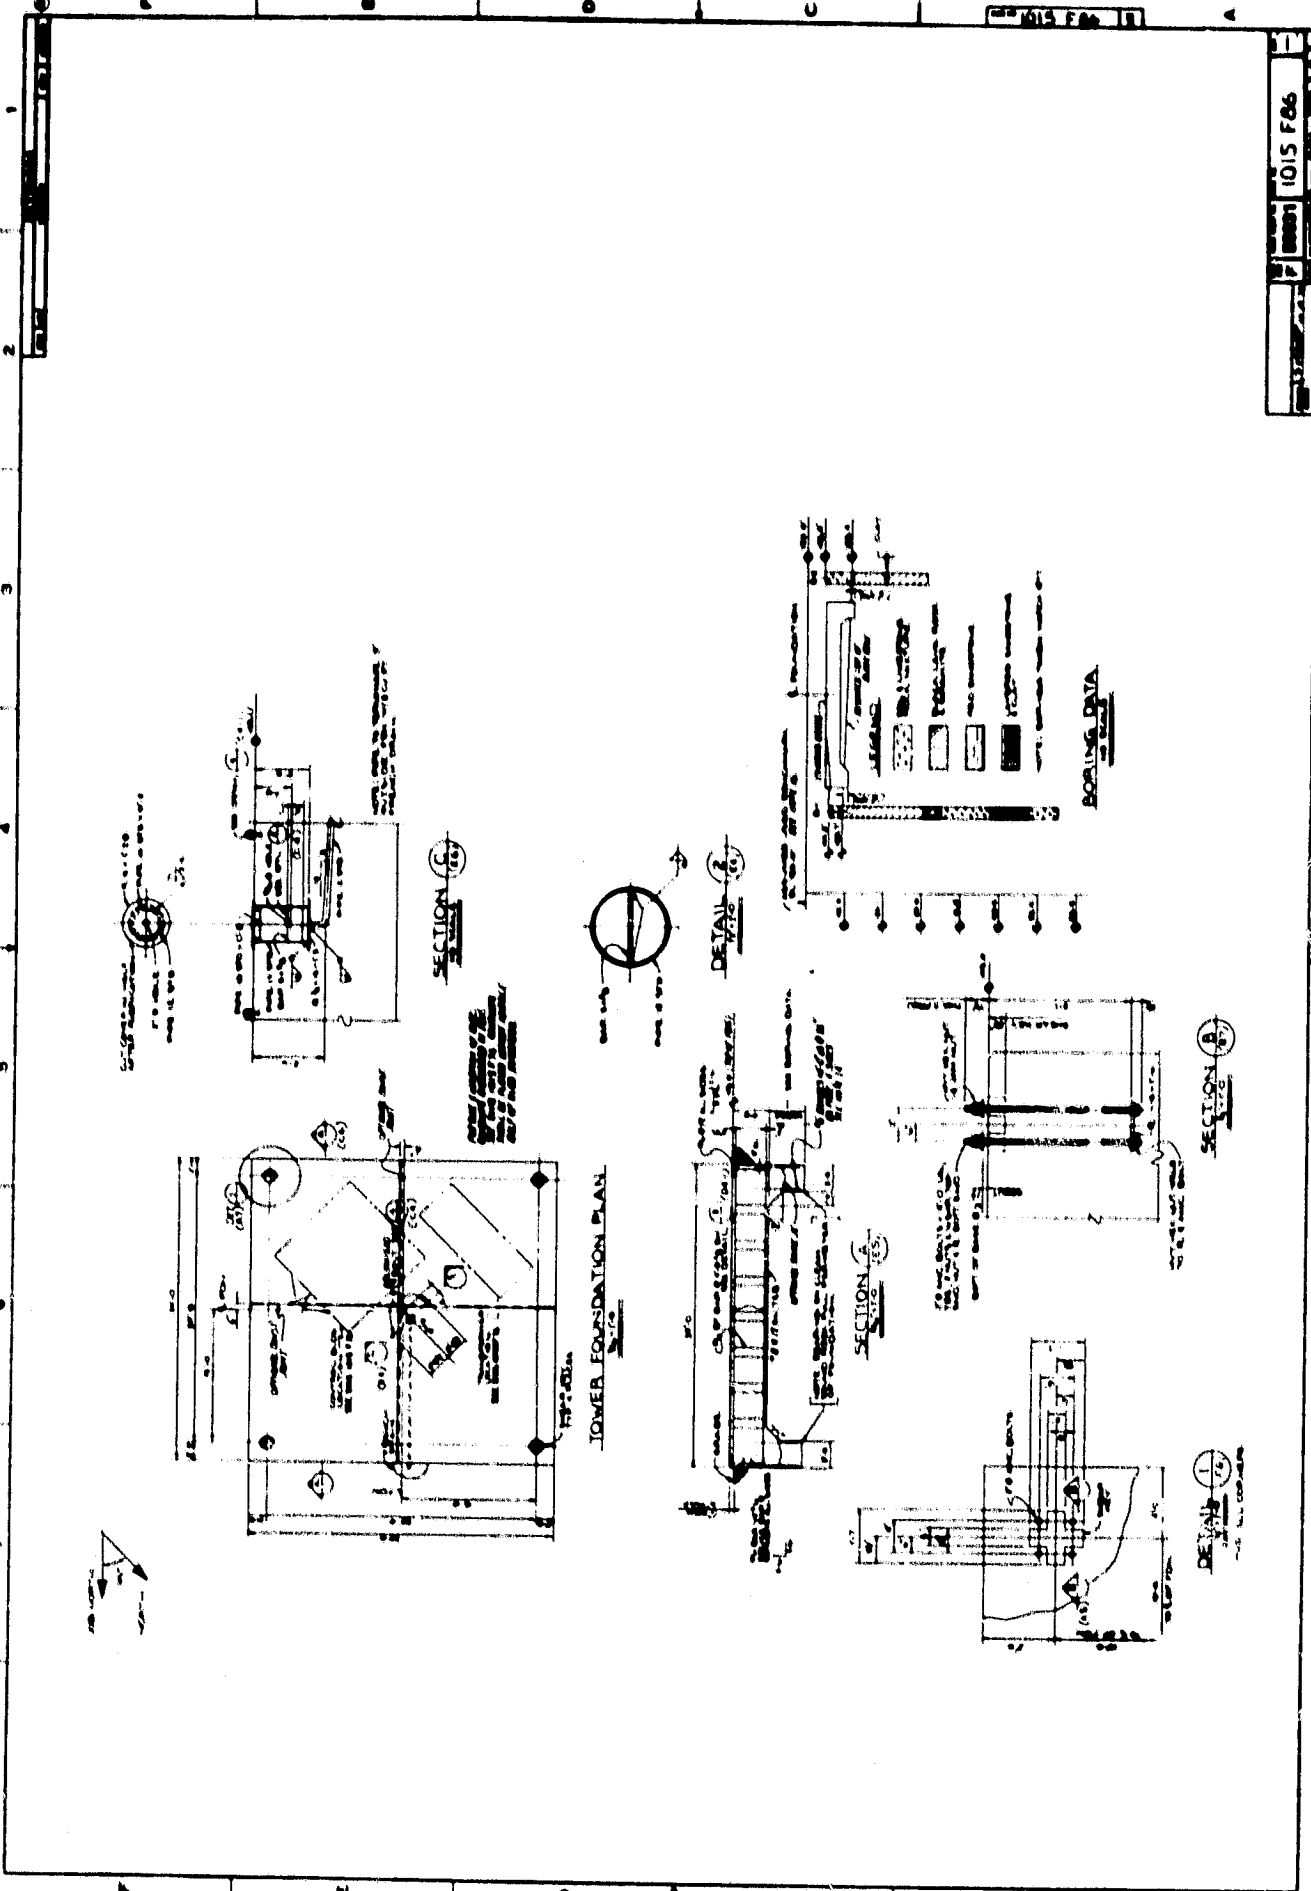

LOWER FOUNDATION PLAN

BORING DATA



SECTION A-A

DETAIL 1

SECTION B-B

SECTION C-C

DETAIL 2

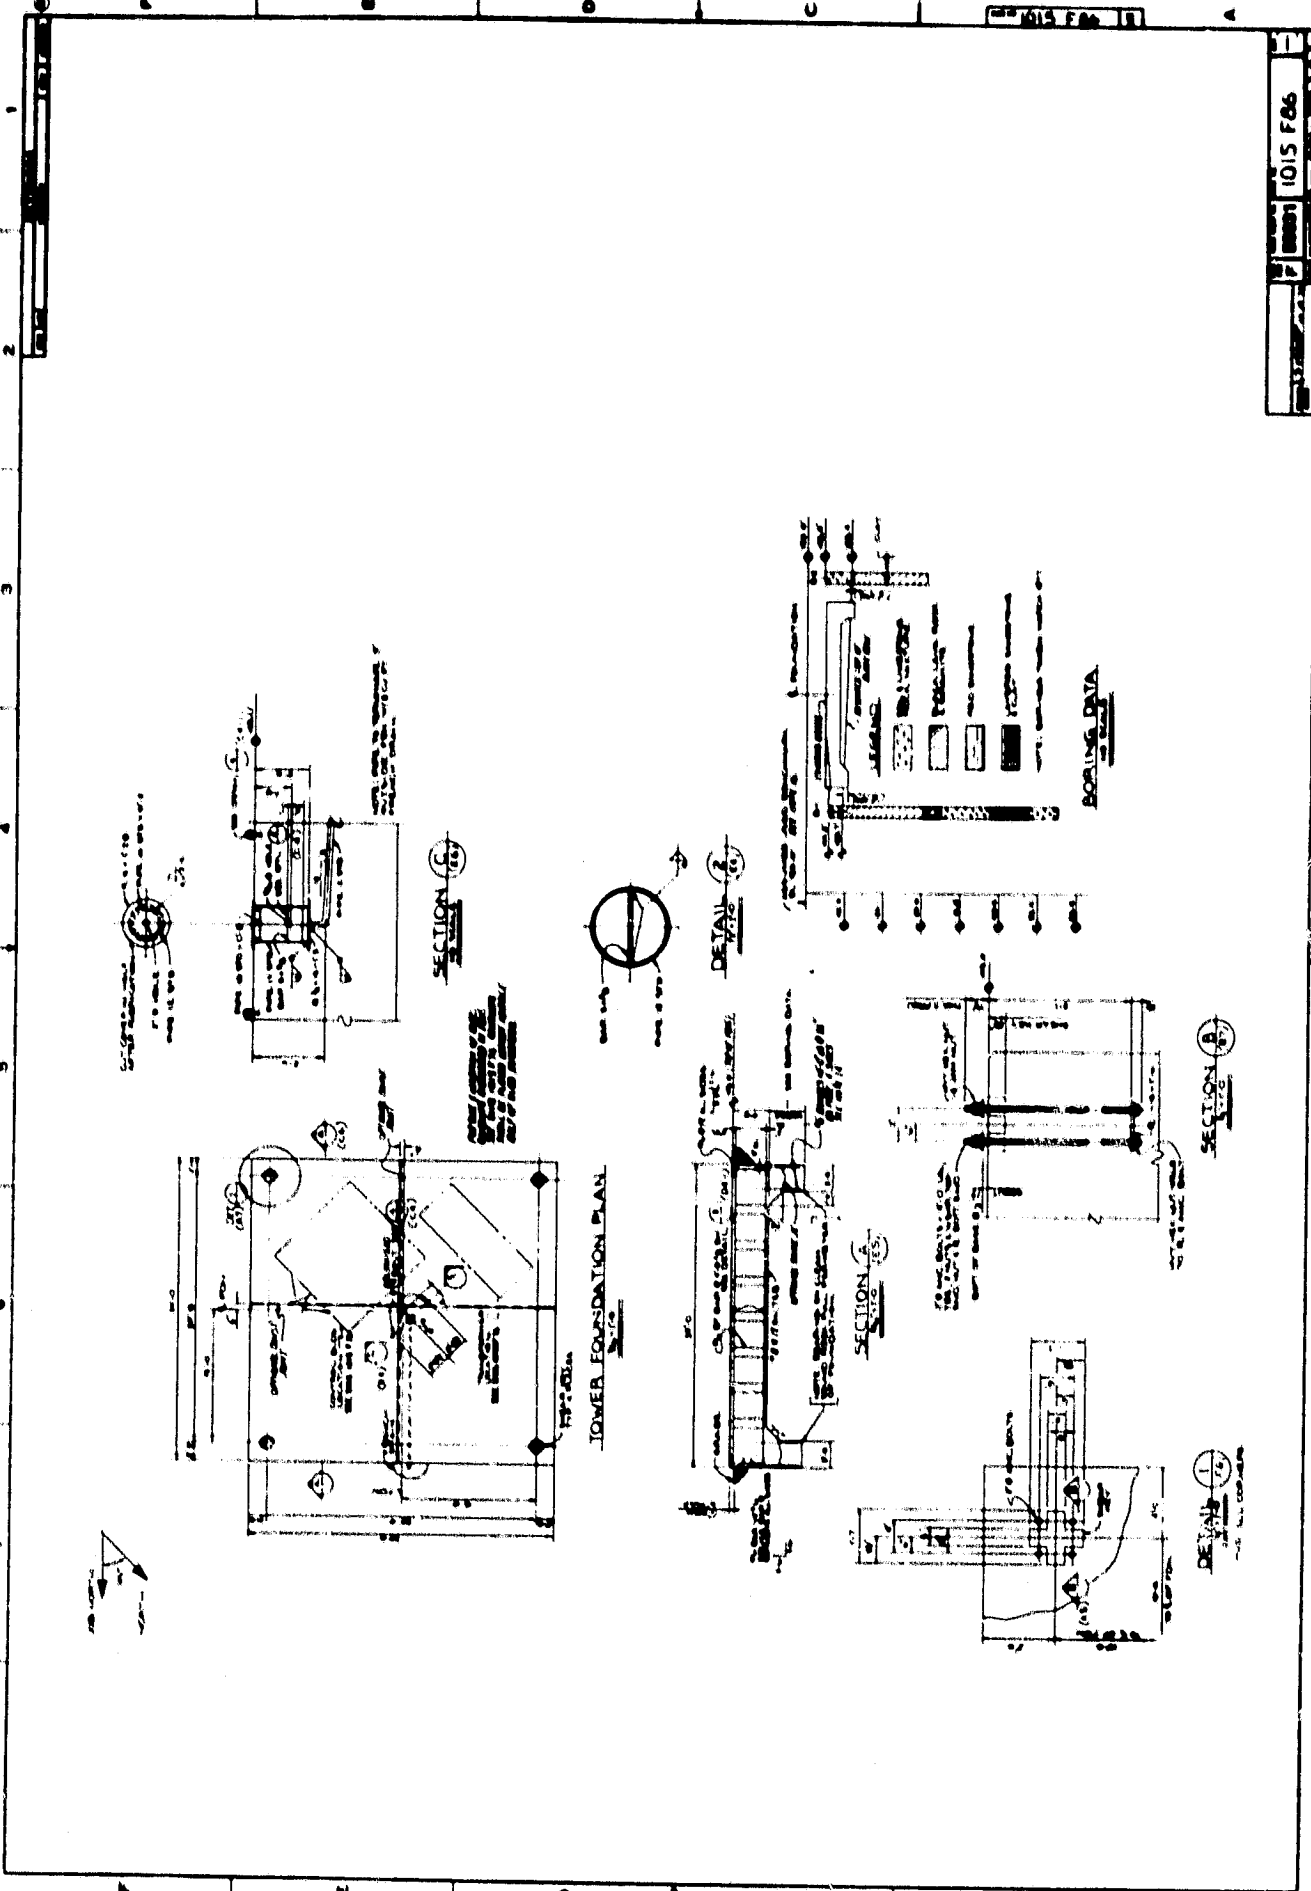

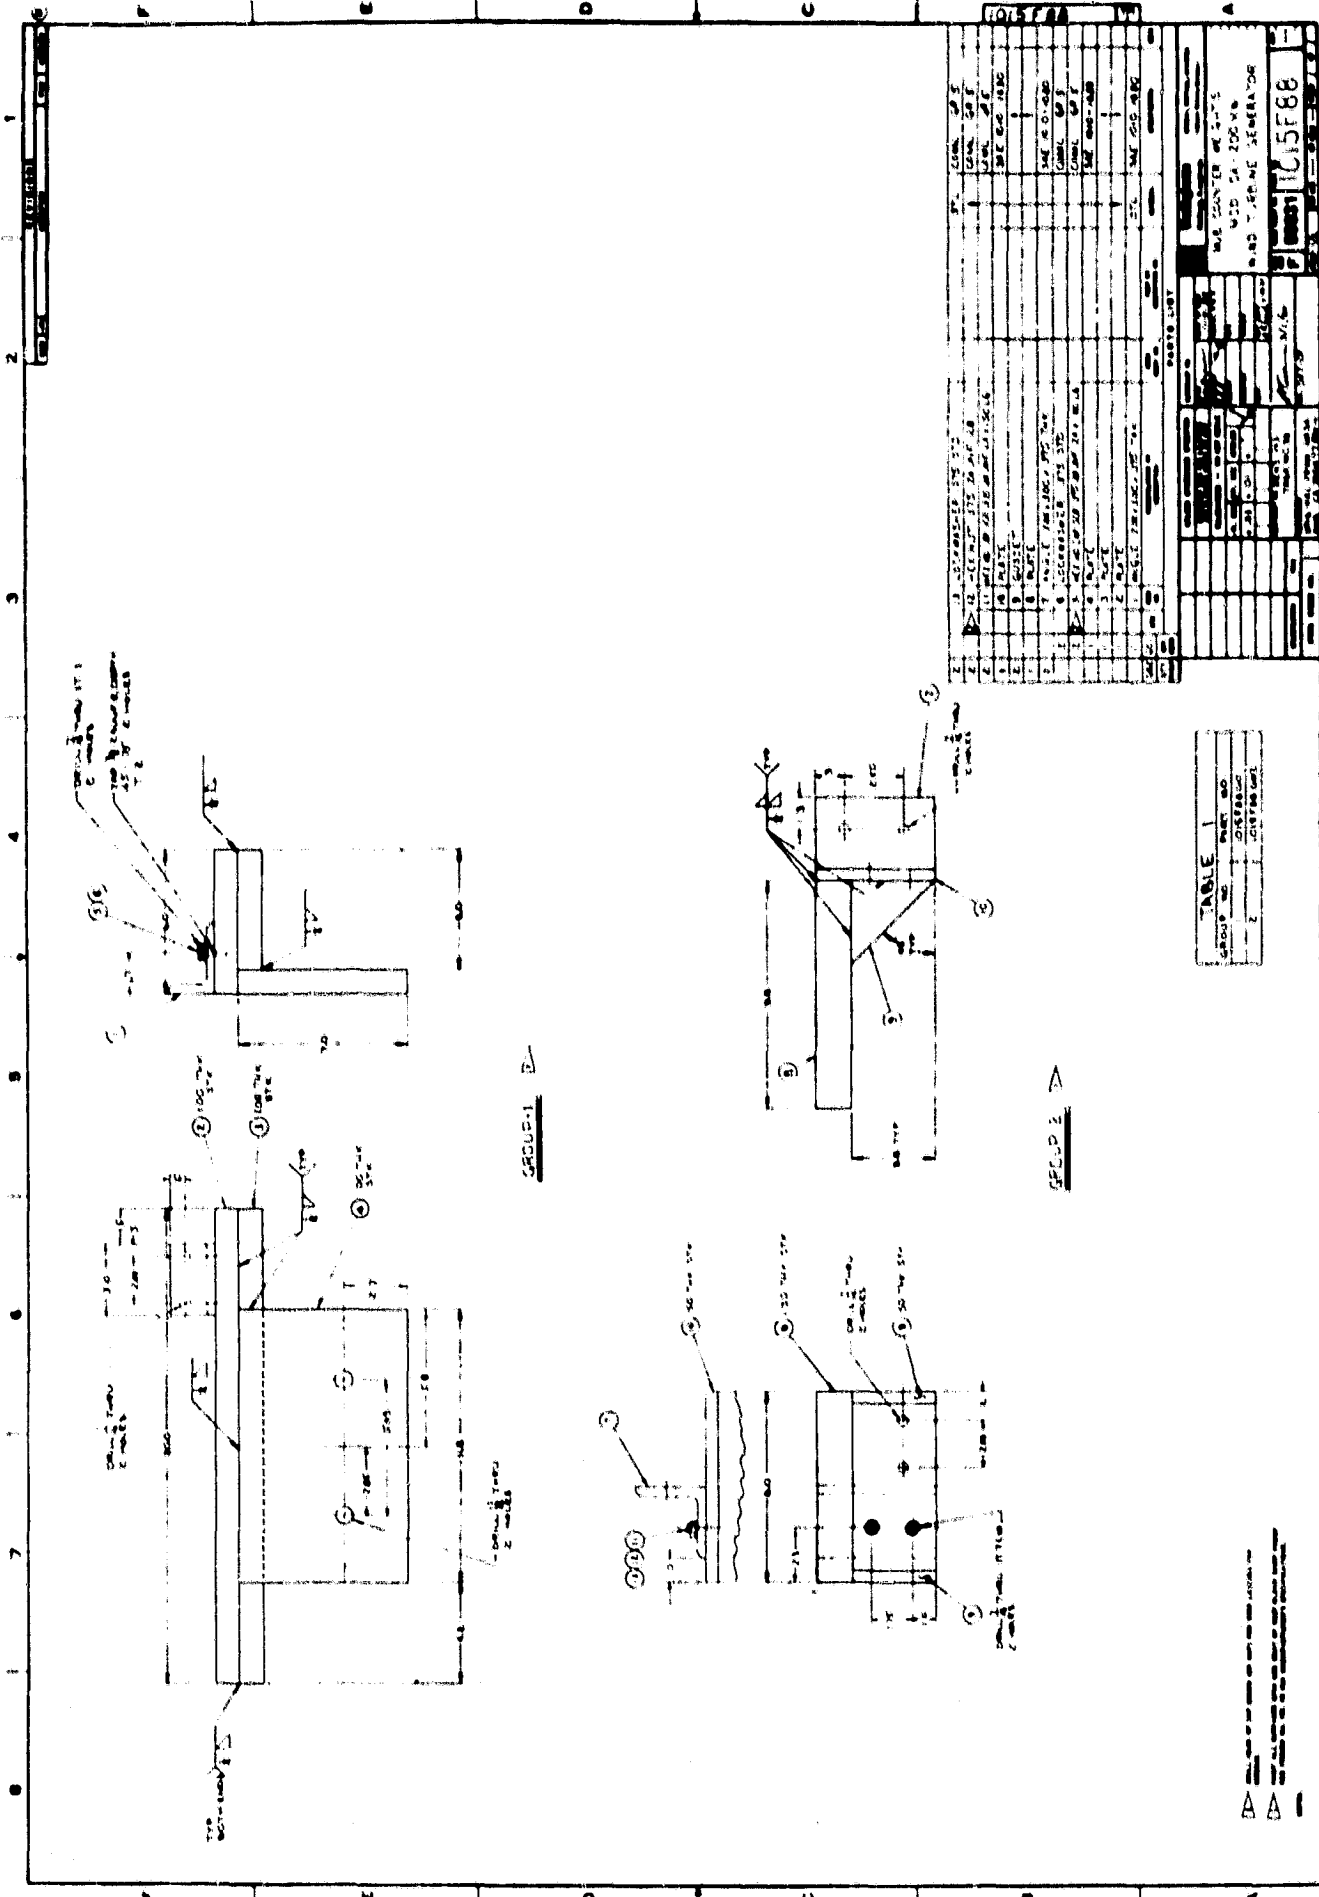


TABLE 1

GROUP NO	DESCRIPTION	QUANTITY	UNIT
1
2

APPROVED BY: _____


DATE: _____

SCALE: _____

WIND TURBINE GENERATOR

105F88

NO	DESCRIPTION	QTY	UNIT
1
2
3
4
5
6
7
8
9
10
11
12
13

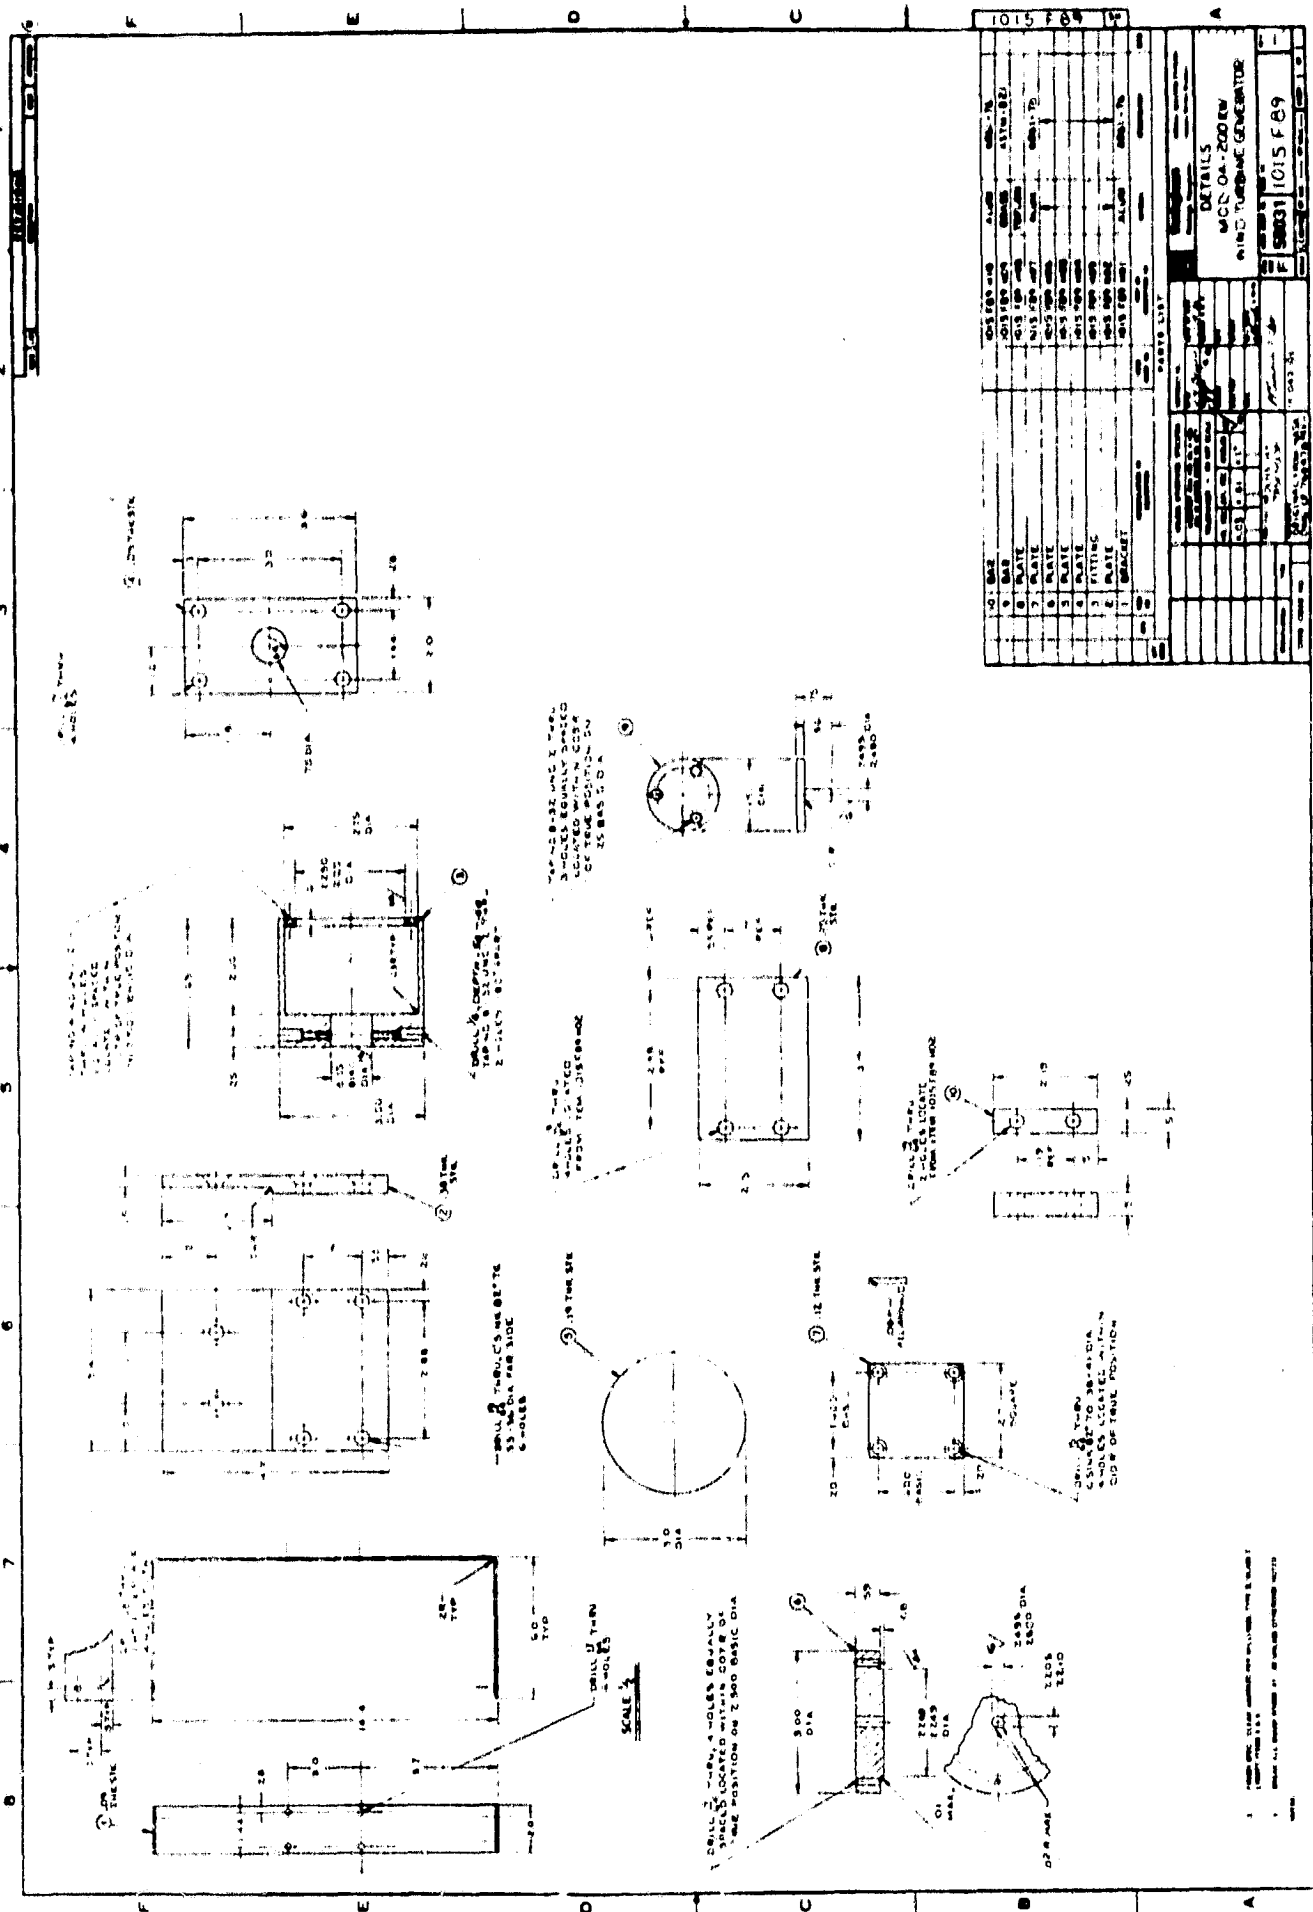


PARTS LIST	
1	BASE
2	PLATE
3	PLATE
4	PLATE
5	PLATE
6	PLATE
7	PLATE
8	BRACKET




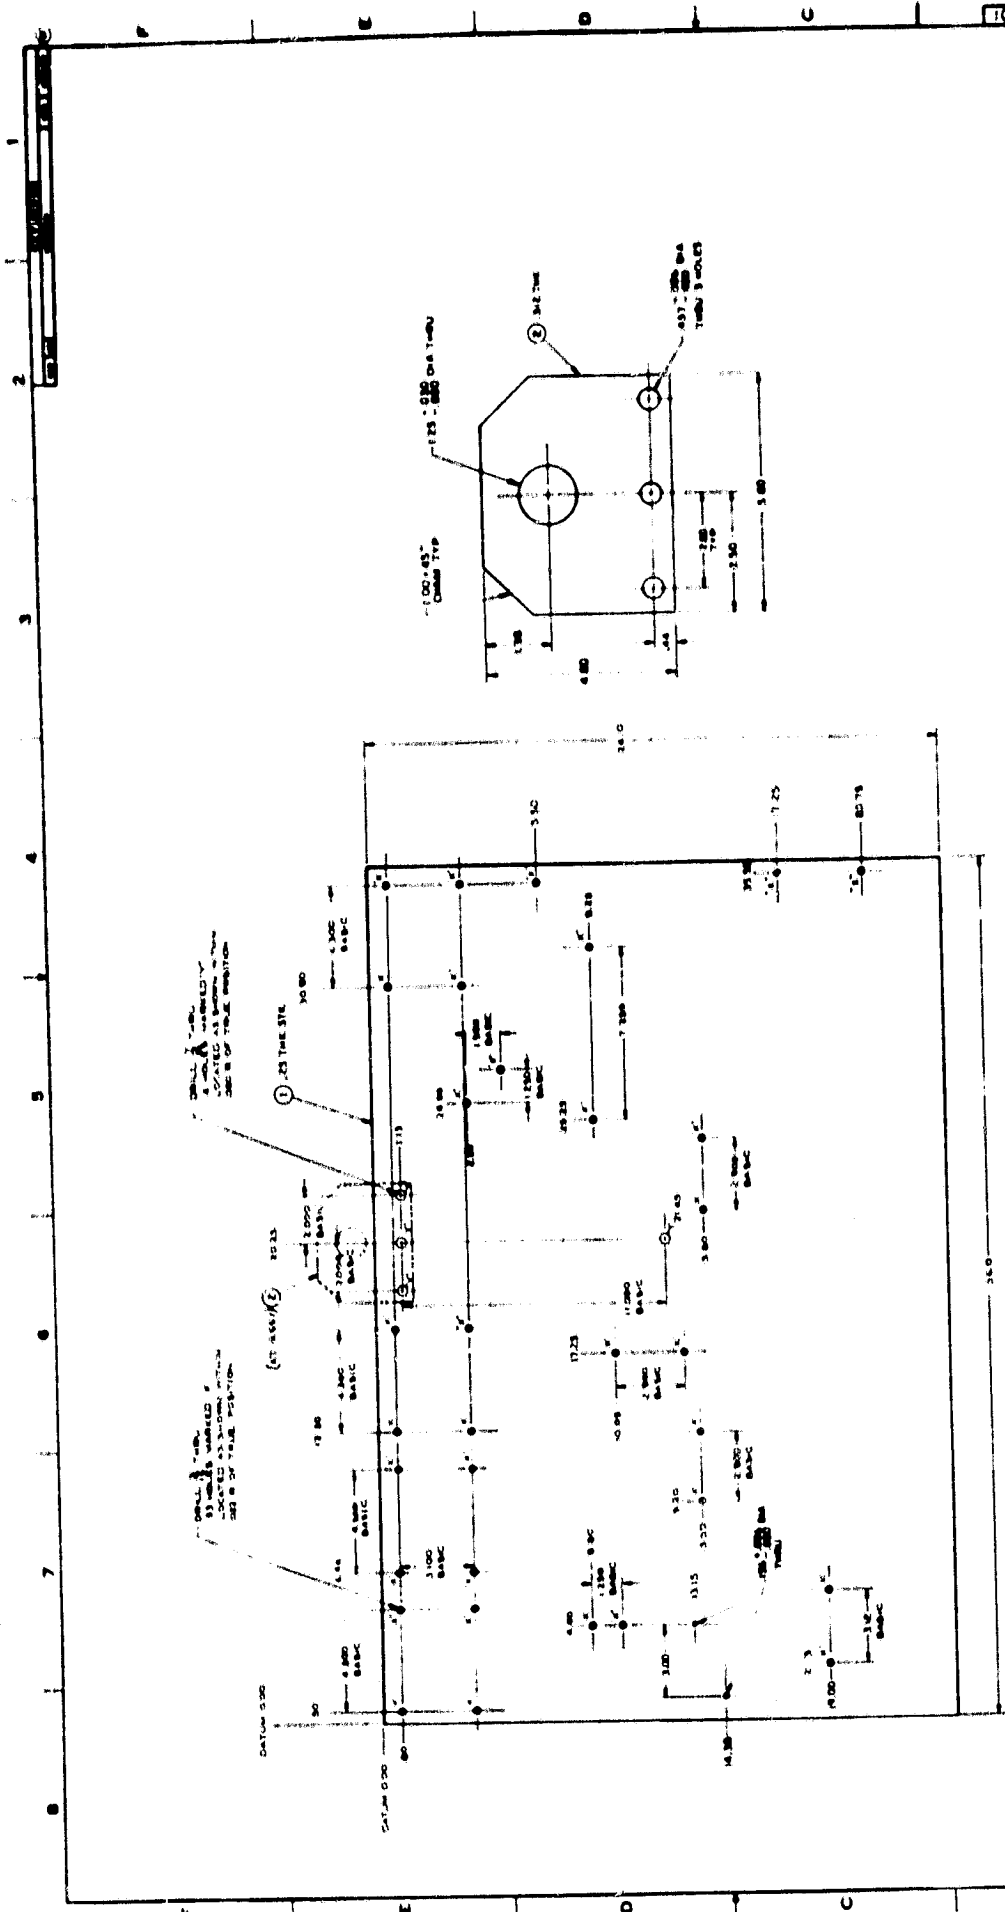


ORIGINAL PAGE IS
OF POOR QUALITY

1015 F 90	

1015 F 91




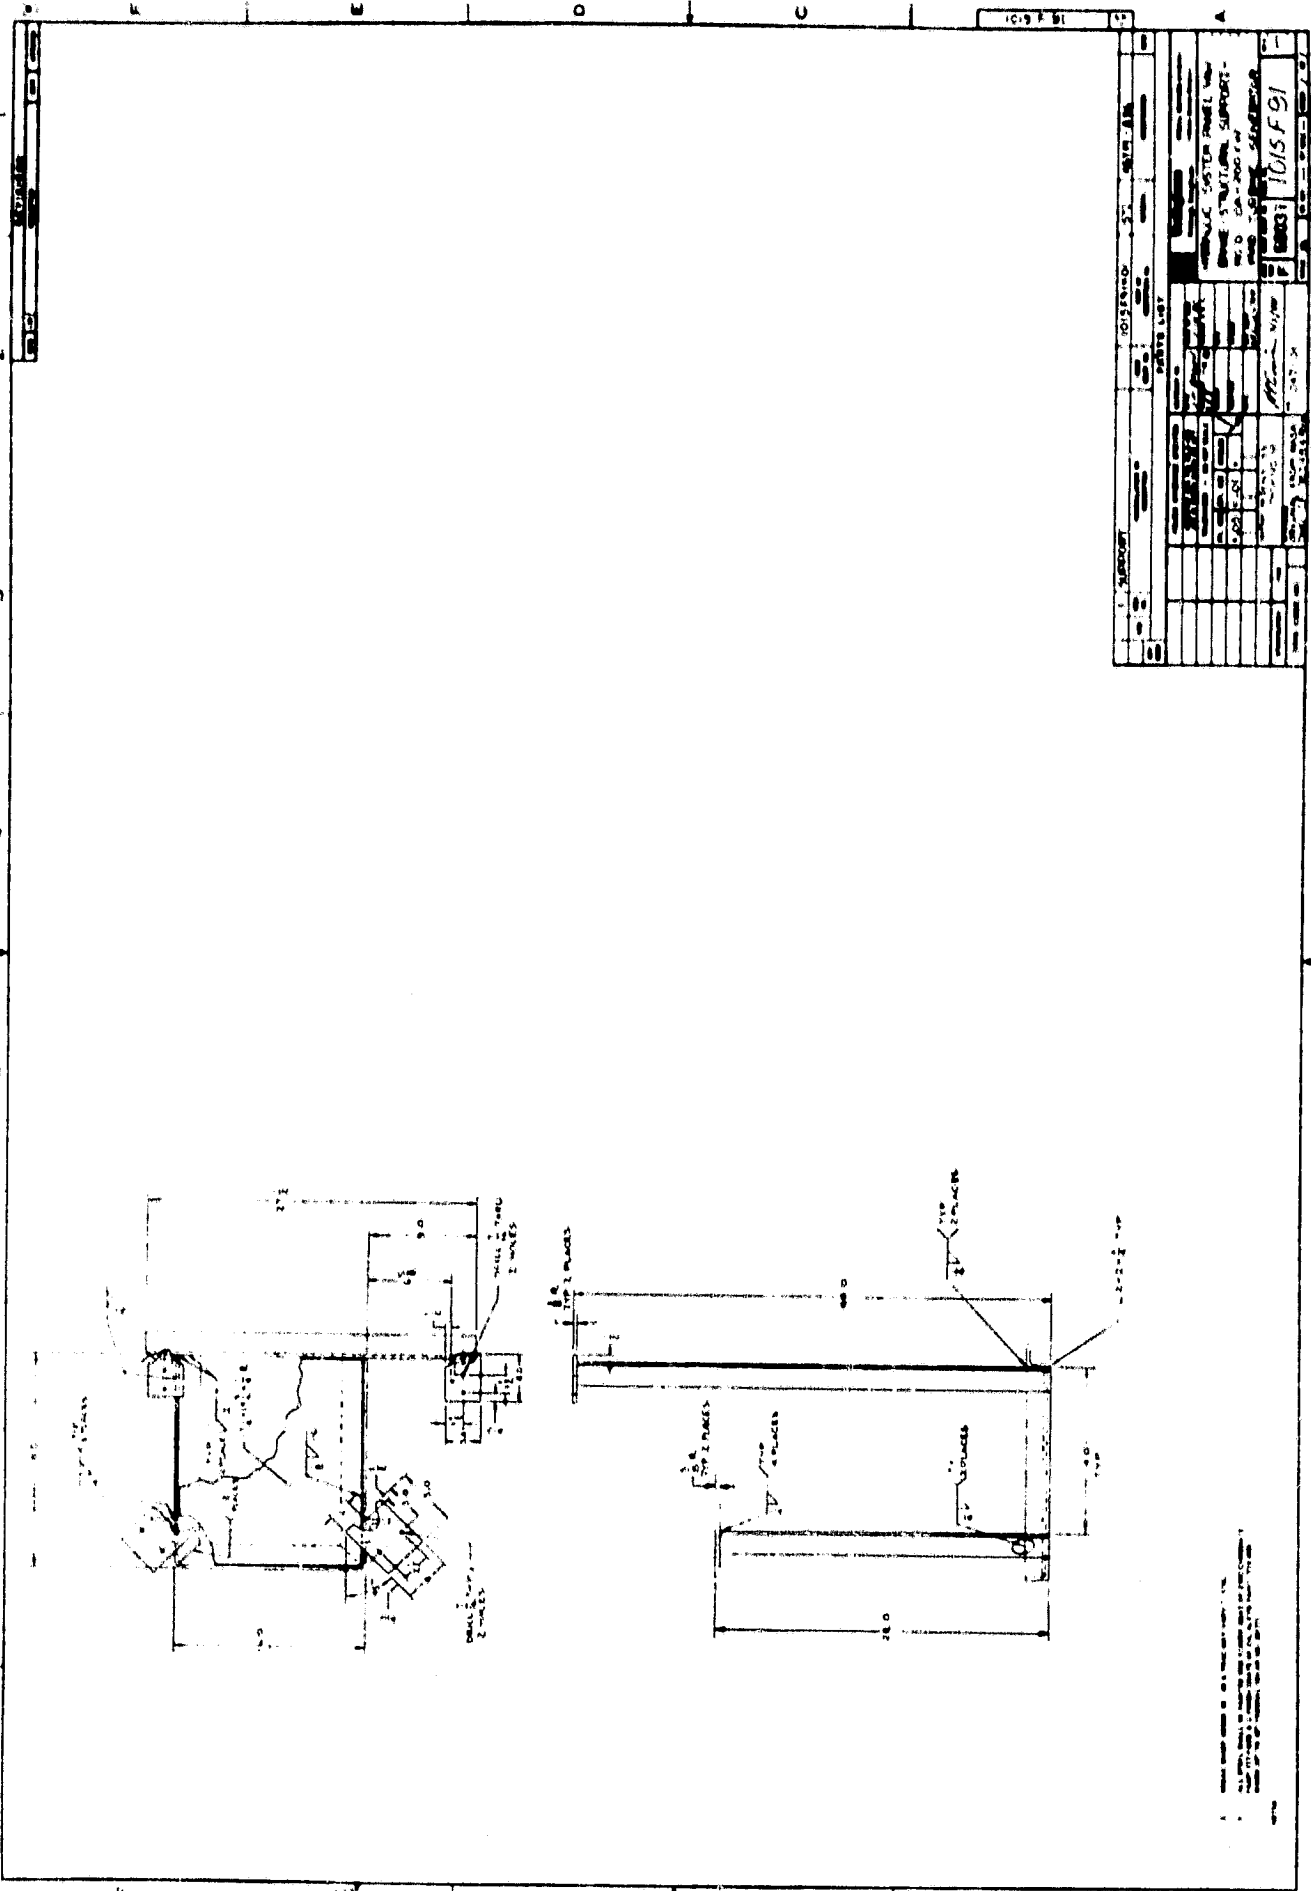

1 2 3 4 5 6 7 8

A B C D E F


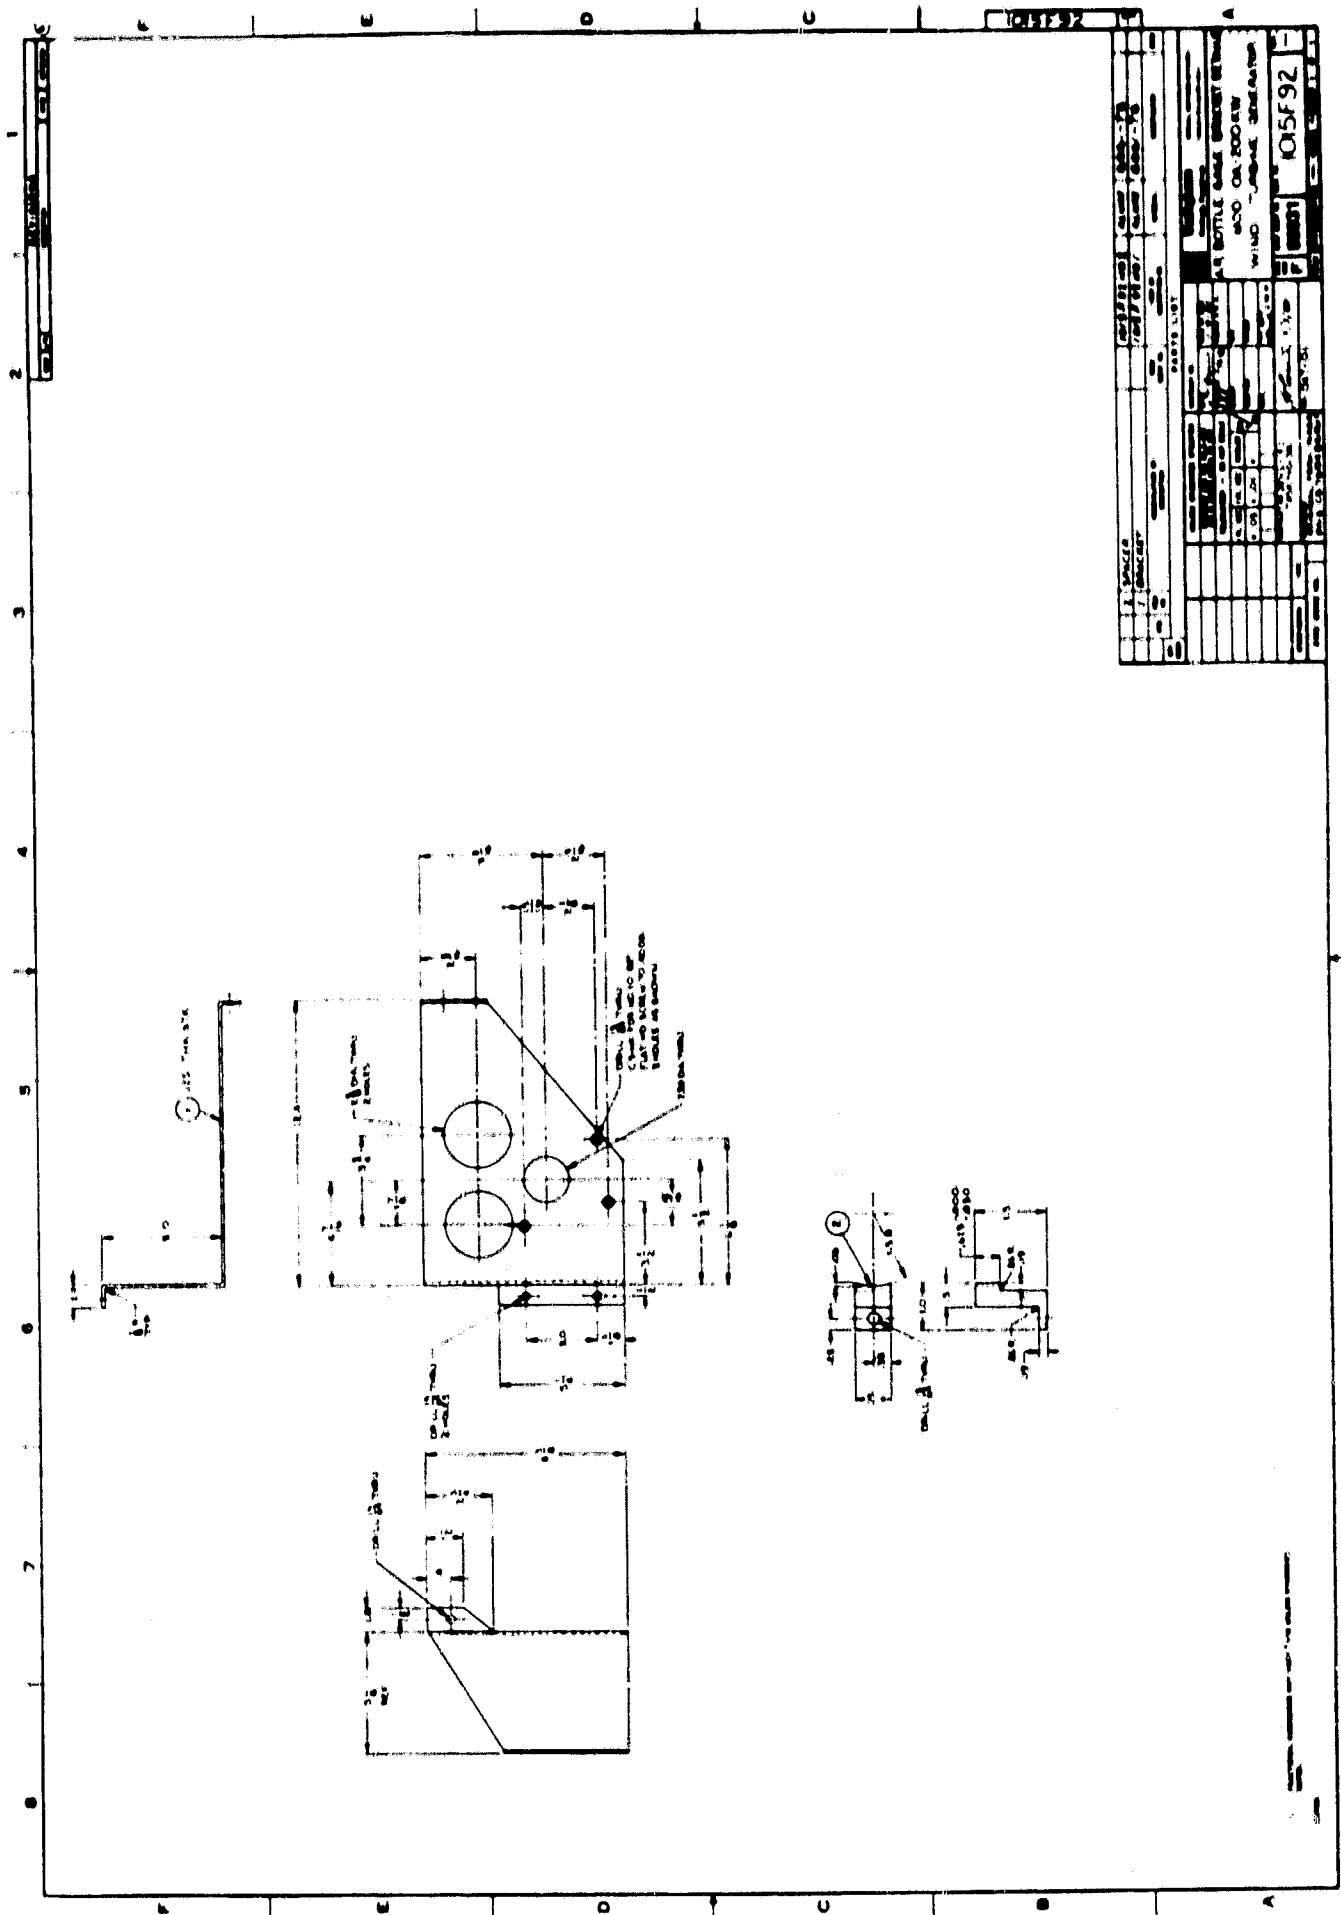



015F33


PARTS LIST	
No.	Description
1	CURVED PLATE




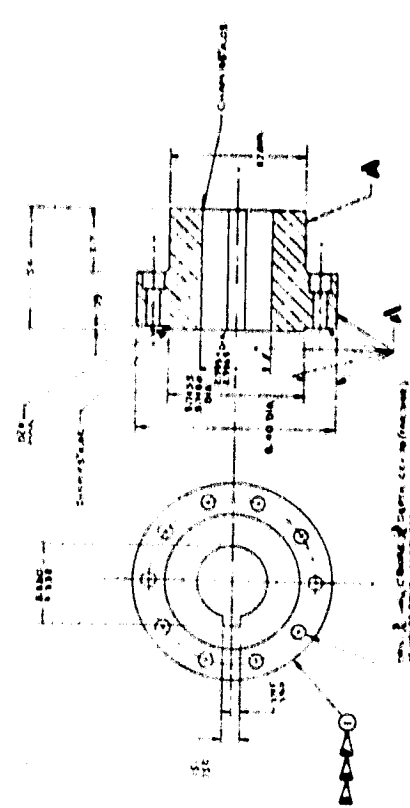

SEE DRAWING OF CURVED PLATE FOR DIMENSIONS AND DETAIL. ALL DIMENSIONS ARE IN INCHES UNLESS OTHERWISE SPECIFIED.

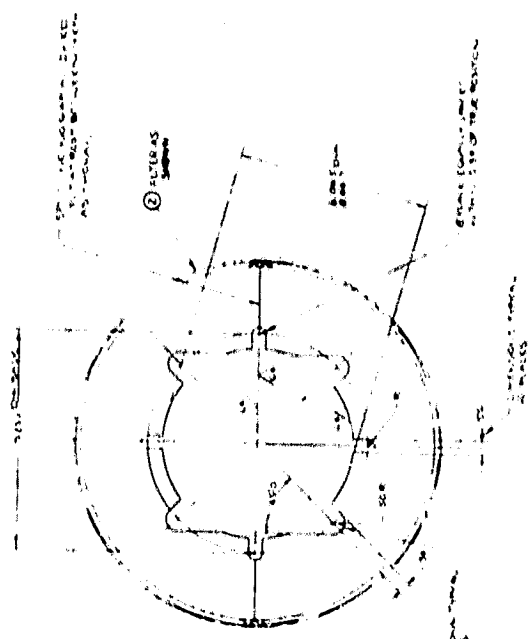

WIND TURBINE GENERATOR

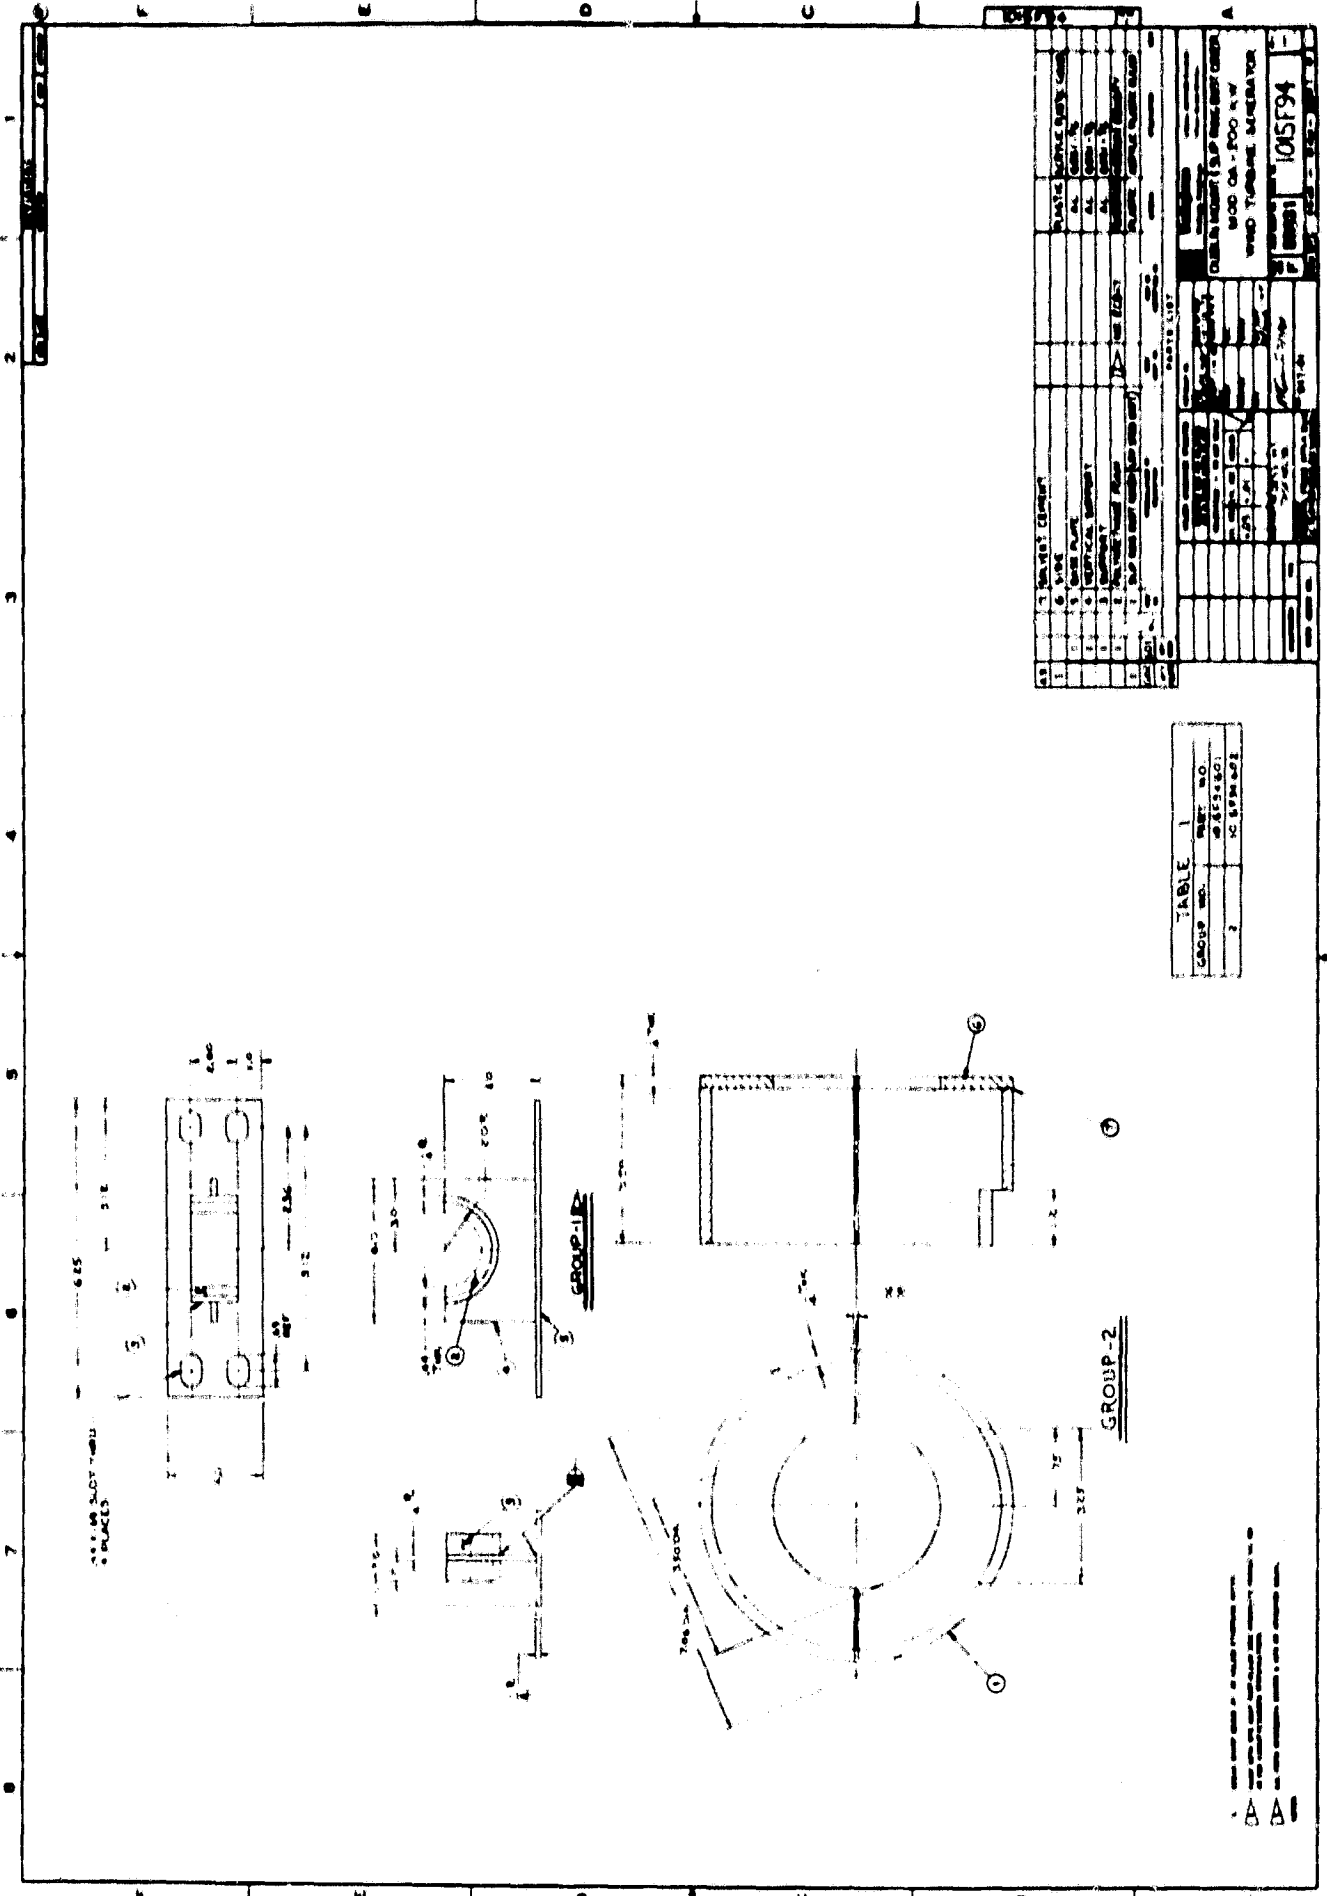


GROUP NO.	TABLE NO.	REV. NO.
1	1	1
2	2	1



AA

1015 F 45

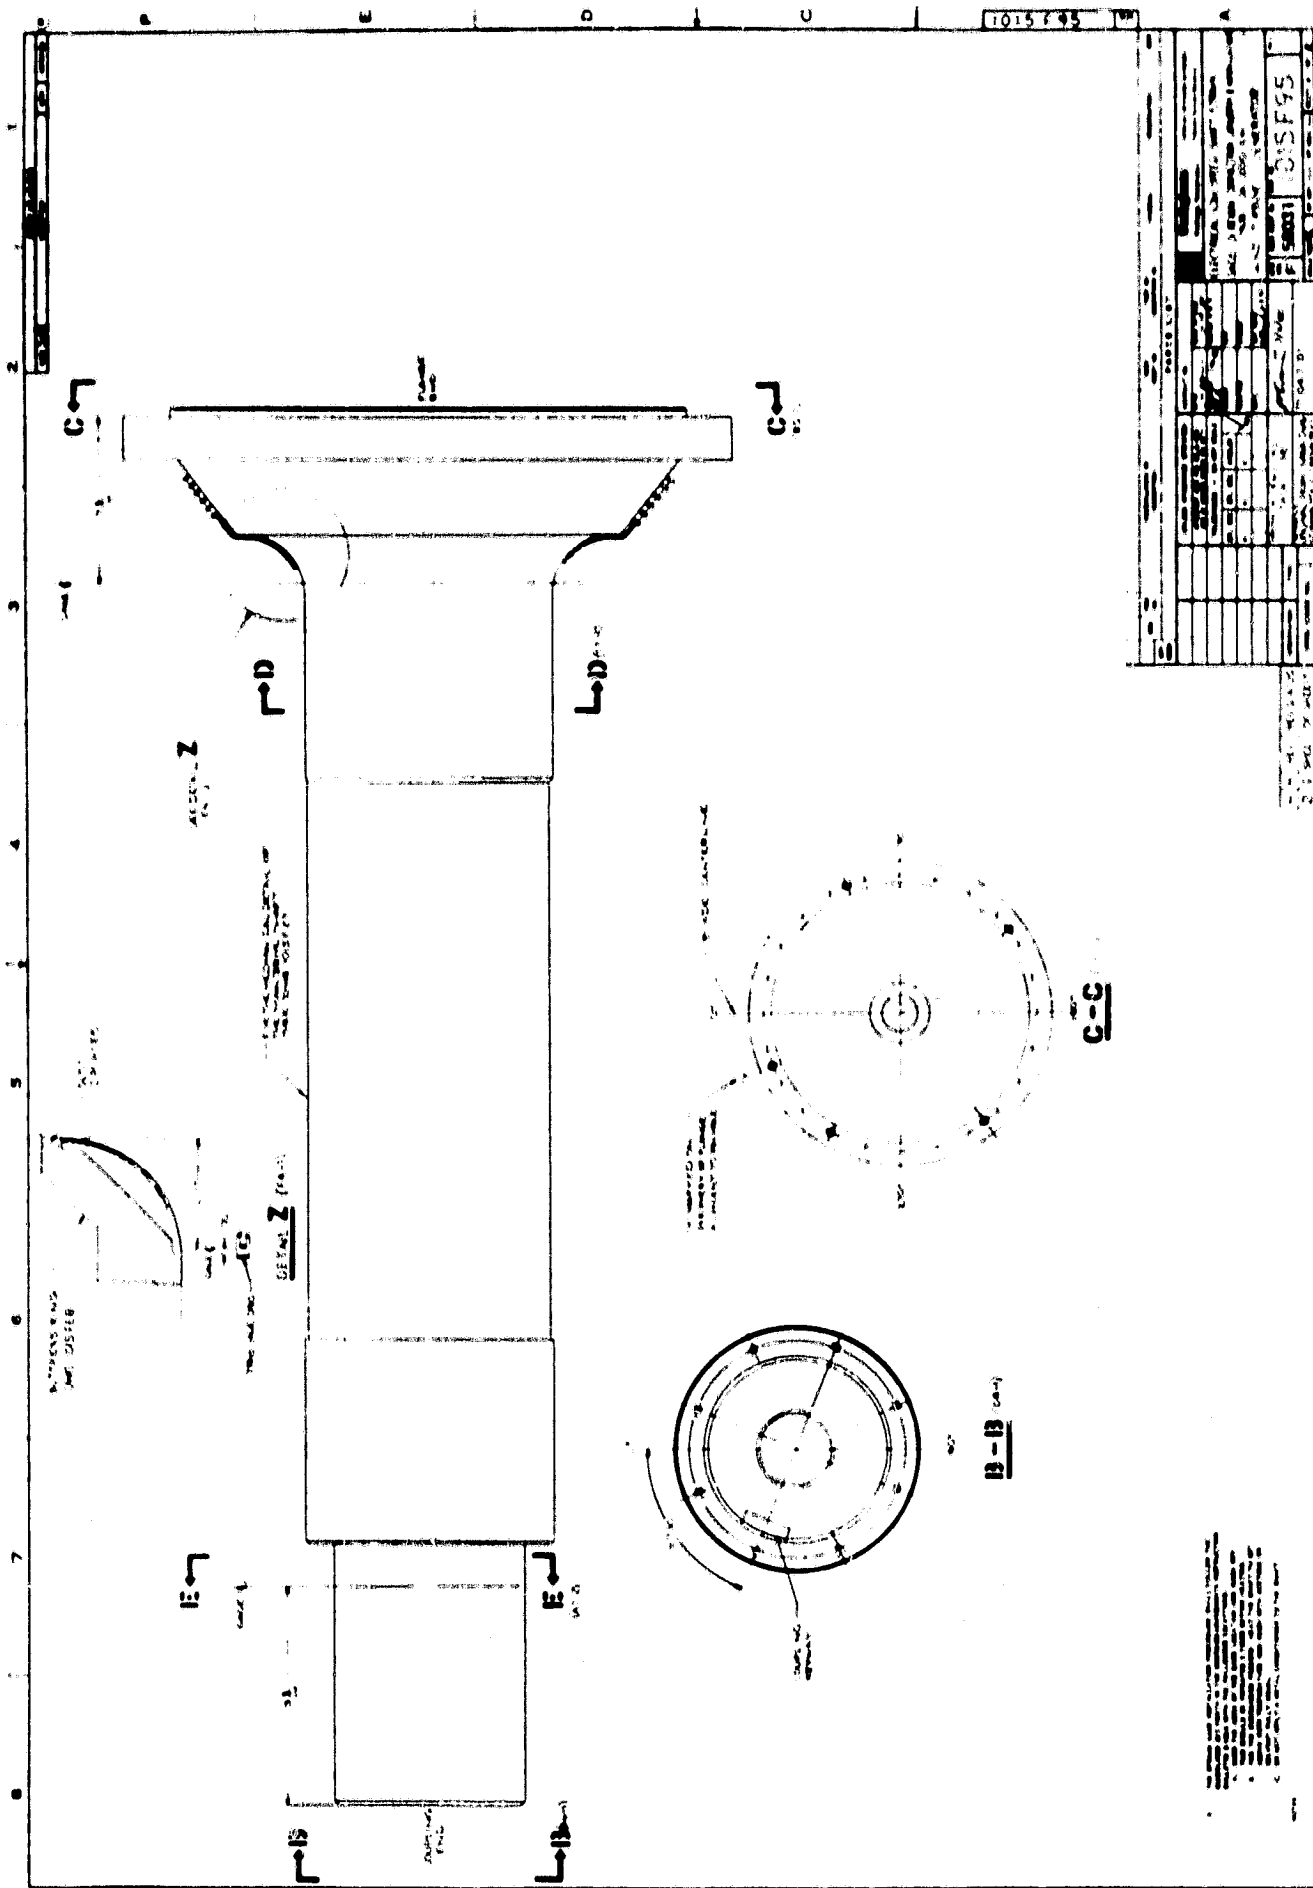


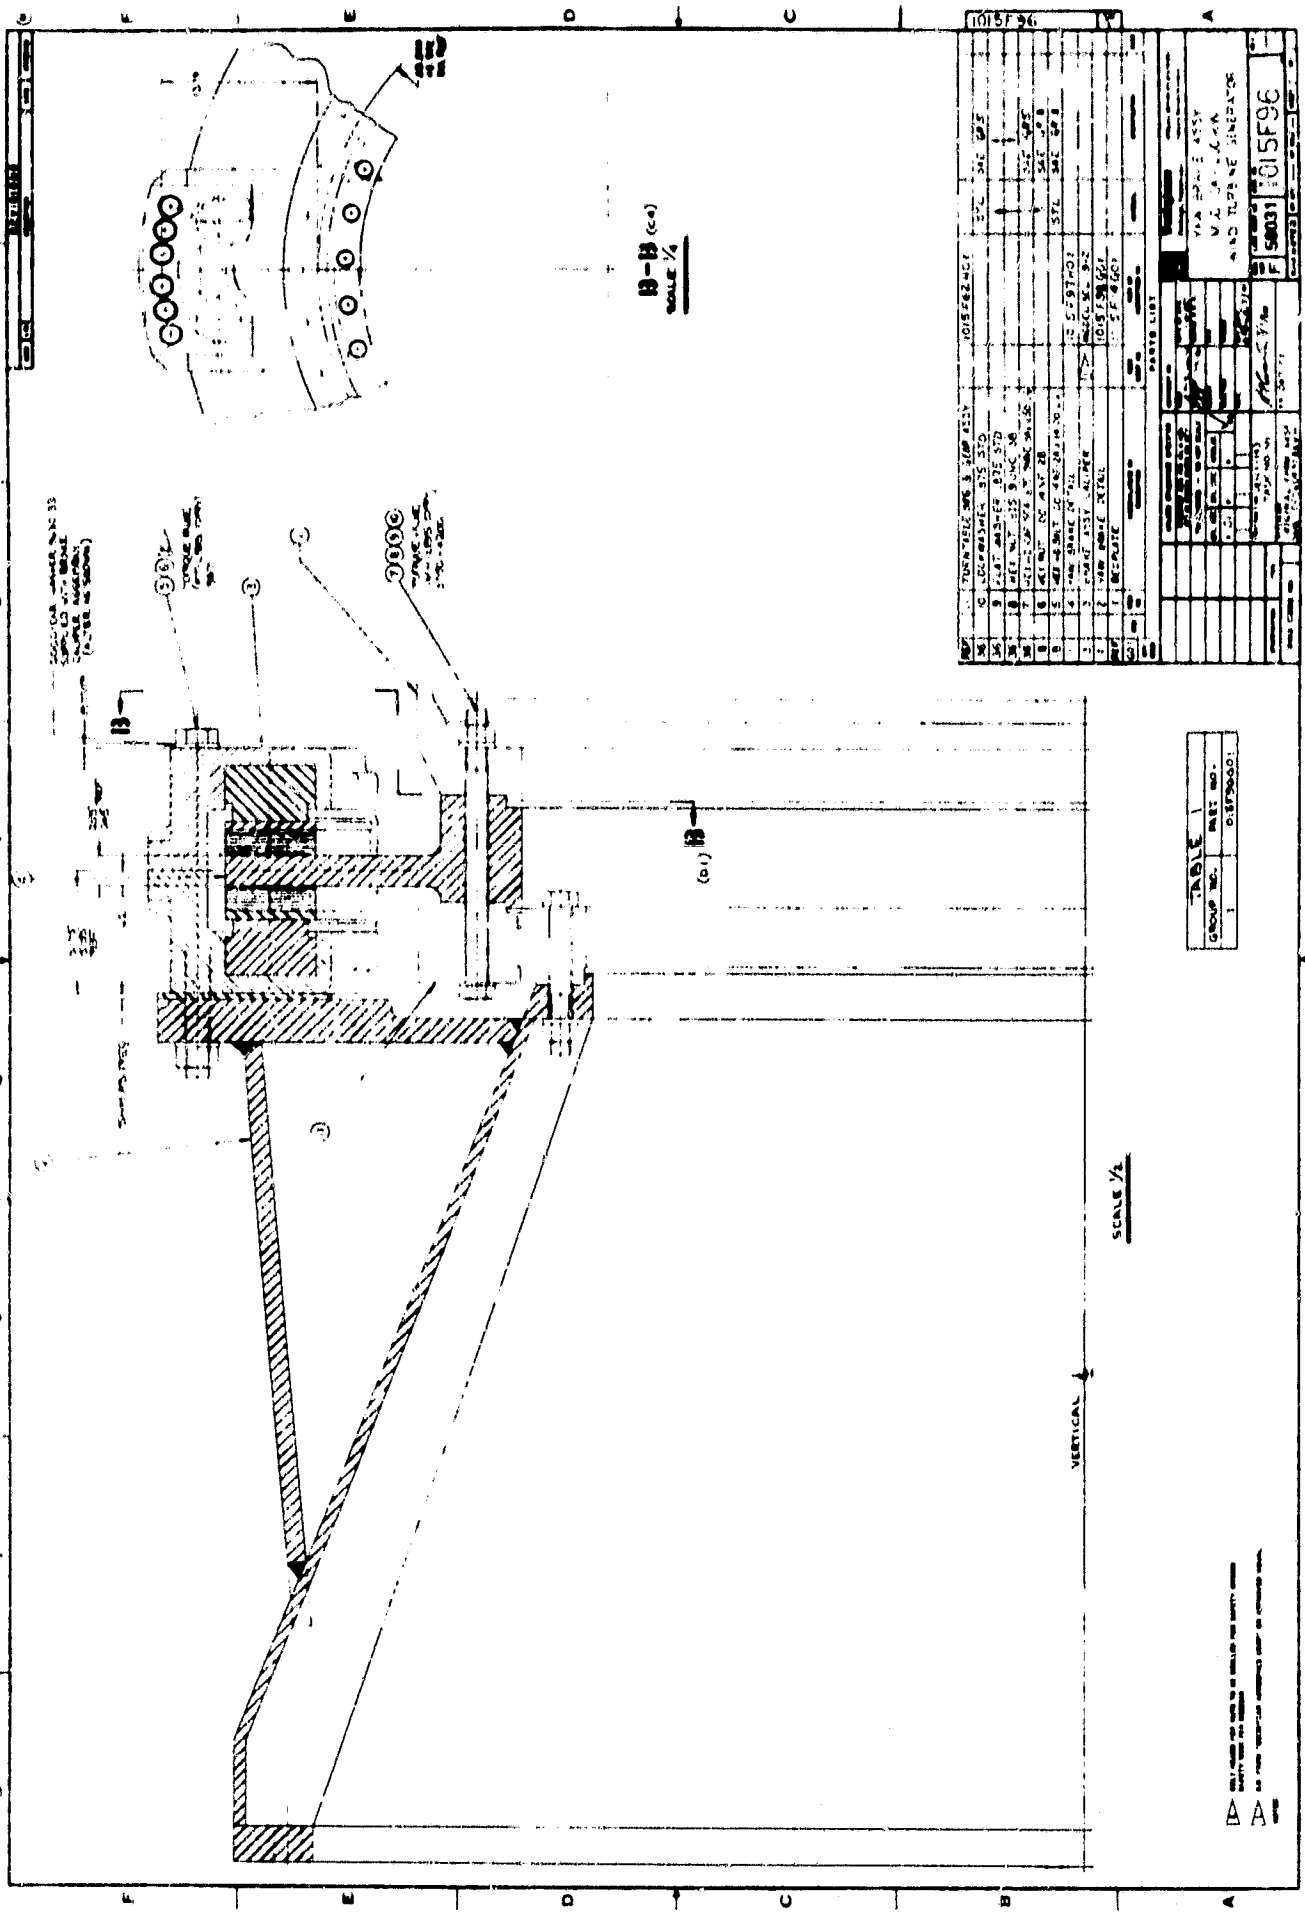

13-13 (c-a)
SCALE 1/4


SCALE 1/4

VERTICAL

TABLE	REV. NO.	DISP. NO.
1		

PARTS LIST		1015F96	
1015F96
F 58031 1015F96

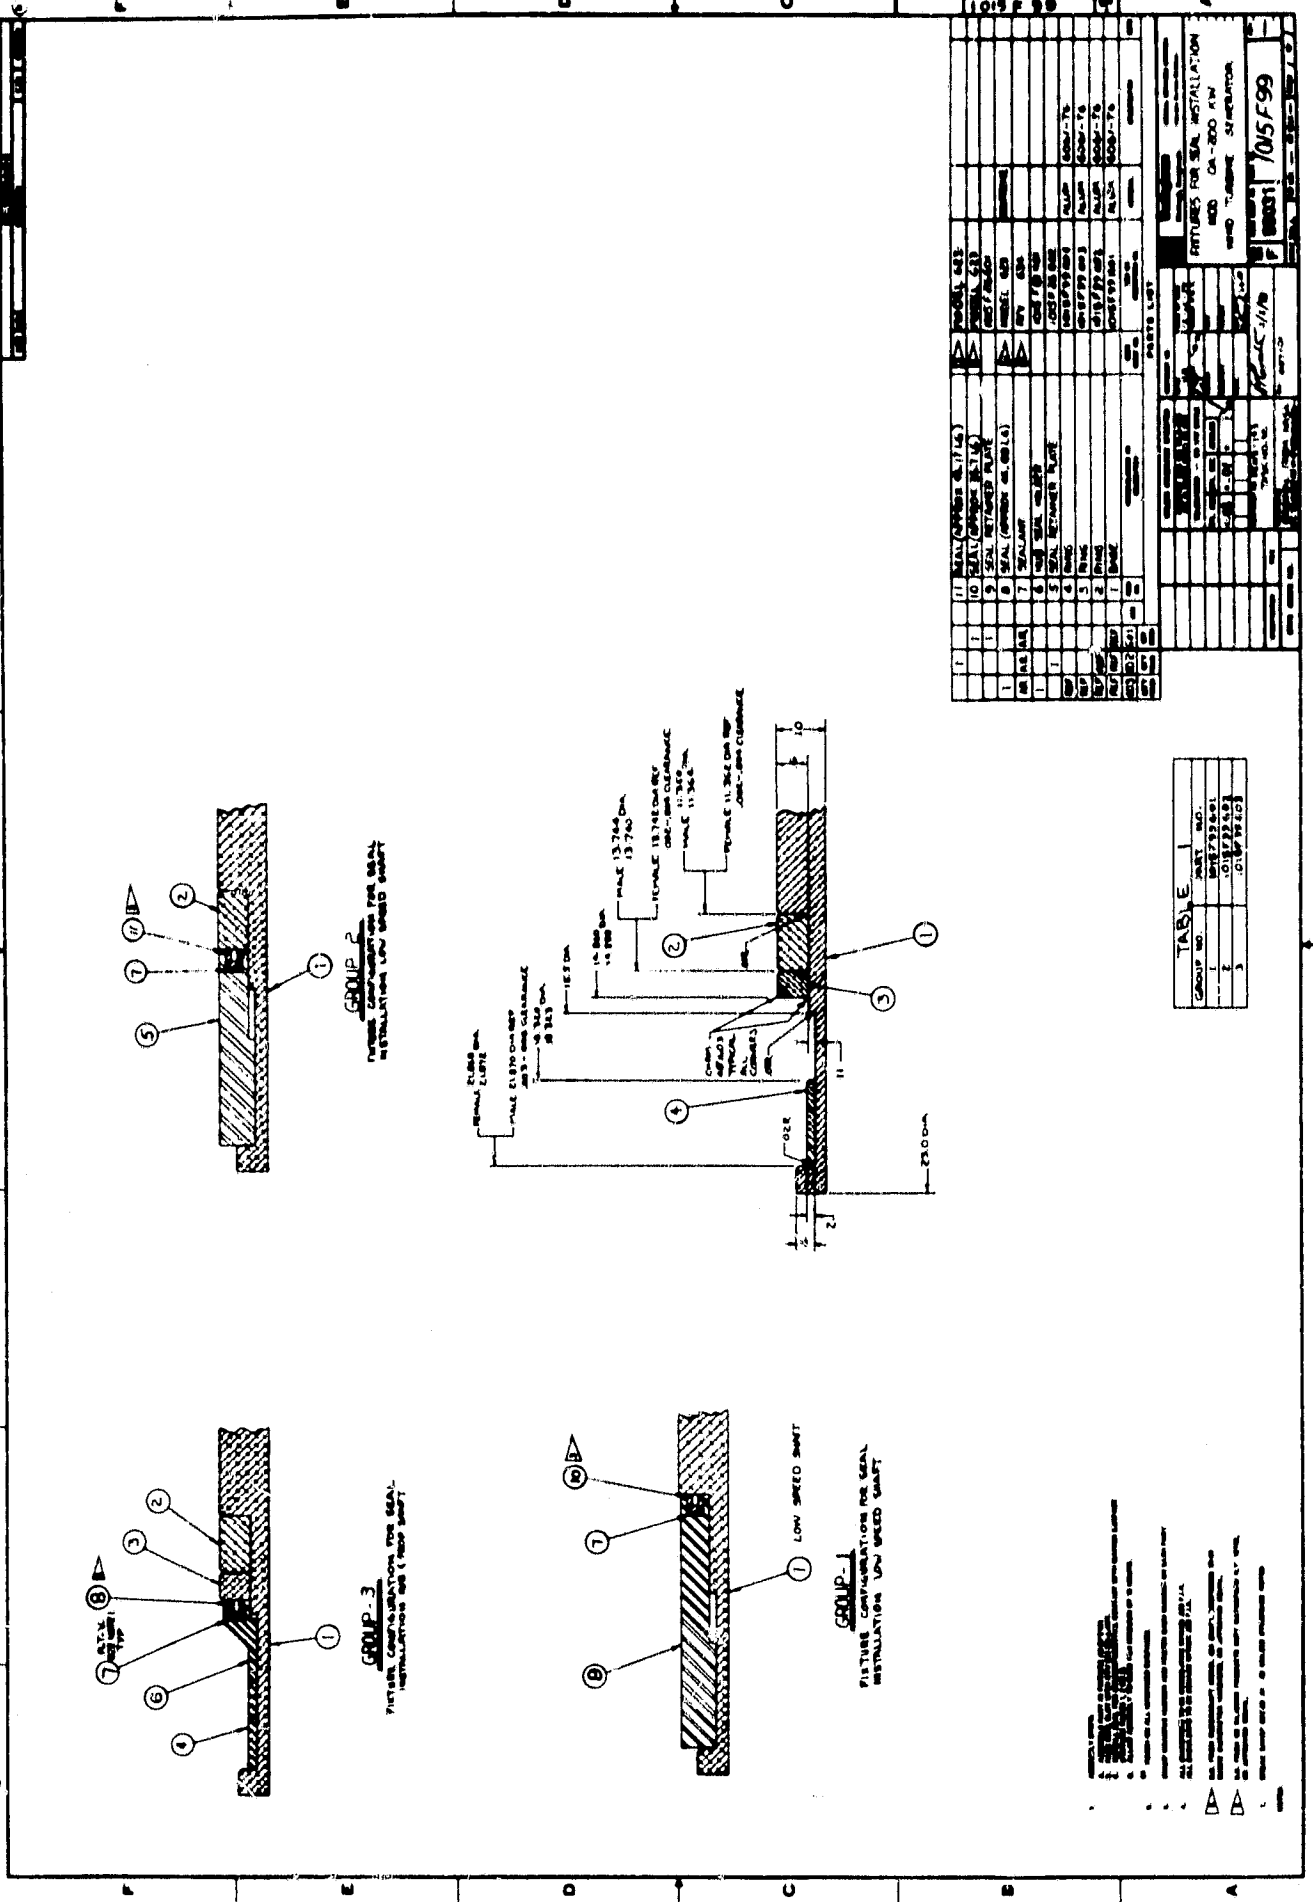

105F99

NO	DESCRIPTION	QTY	MATERIAL	REMARKS

PARTS LIST

FITURES FOR SEAL INSTALLATION
















PRECEDING PAGE BLANK NOT FILMED

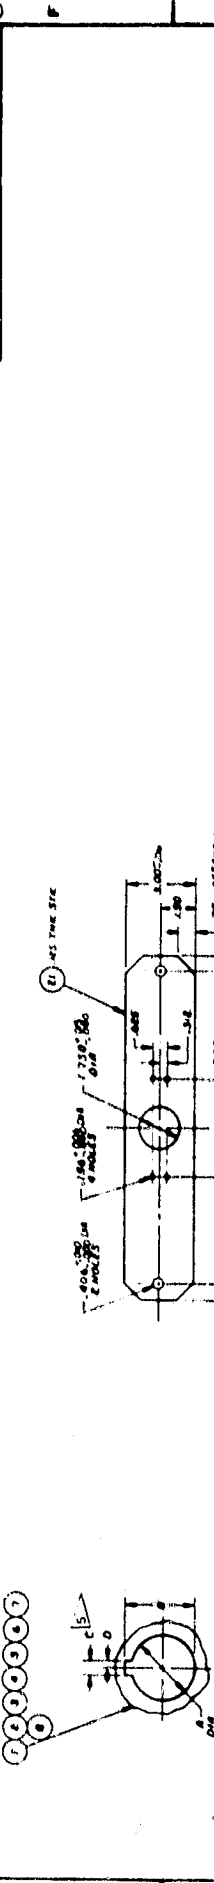


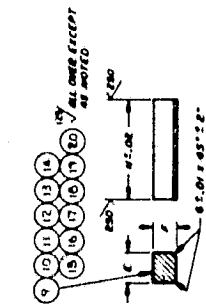


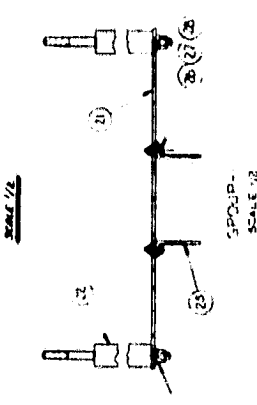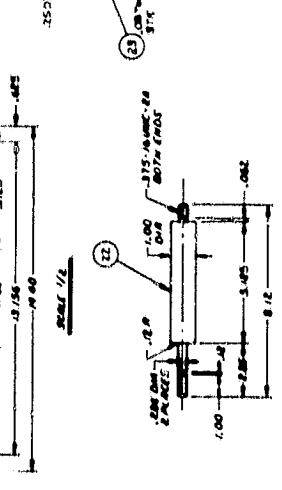

1017F02

GENERATOR TACH-MOUNT ASSY
WITH KEYS AND DETAILS
MOO CA-2004-W
WIND TURBINE GENERATOR


1017F02

GROUP NO. 1
PART NO. 1017F02


SCALE: 1/2

1017F02

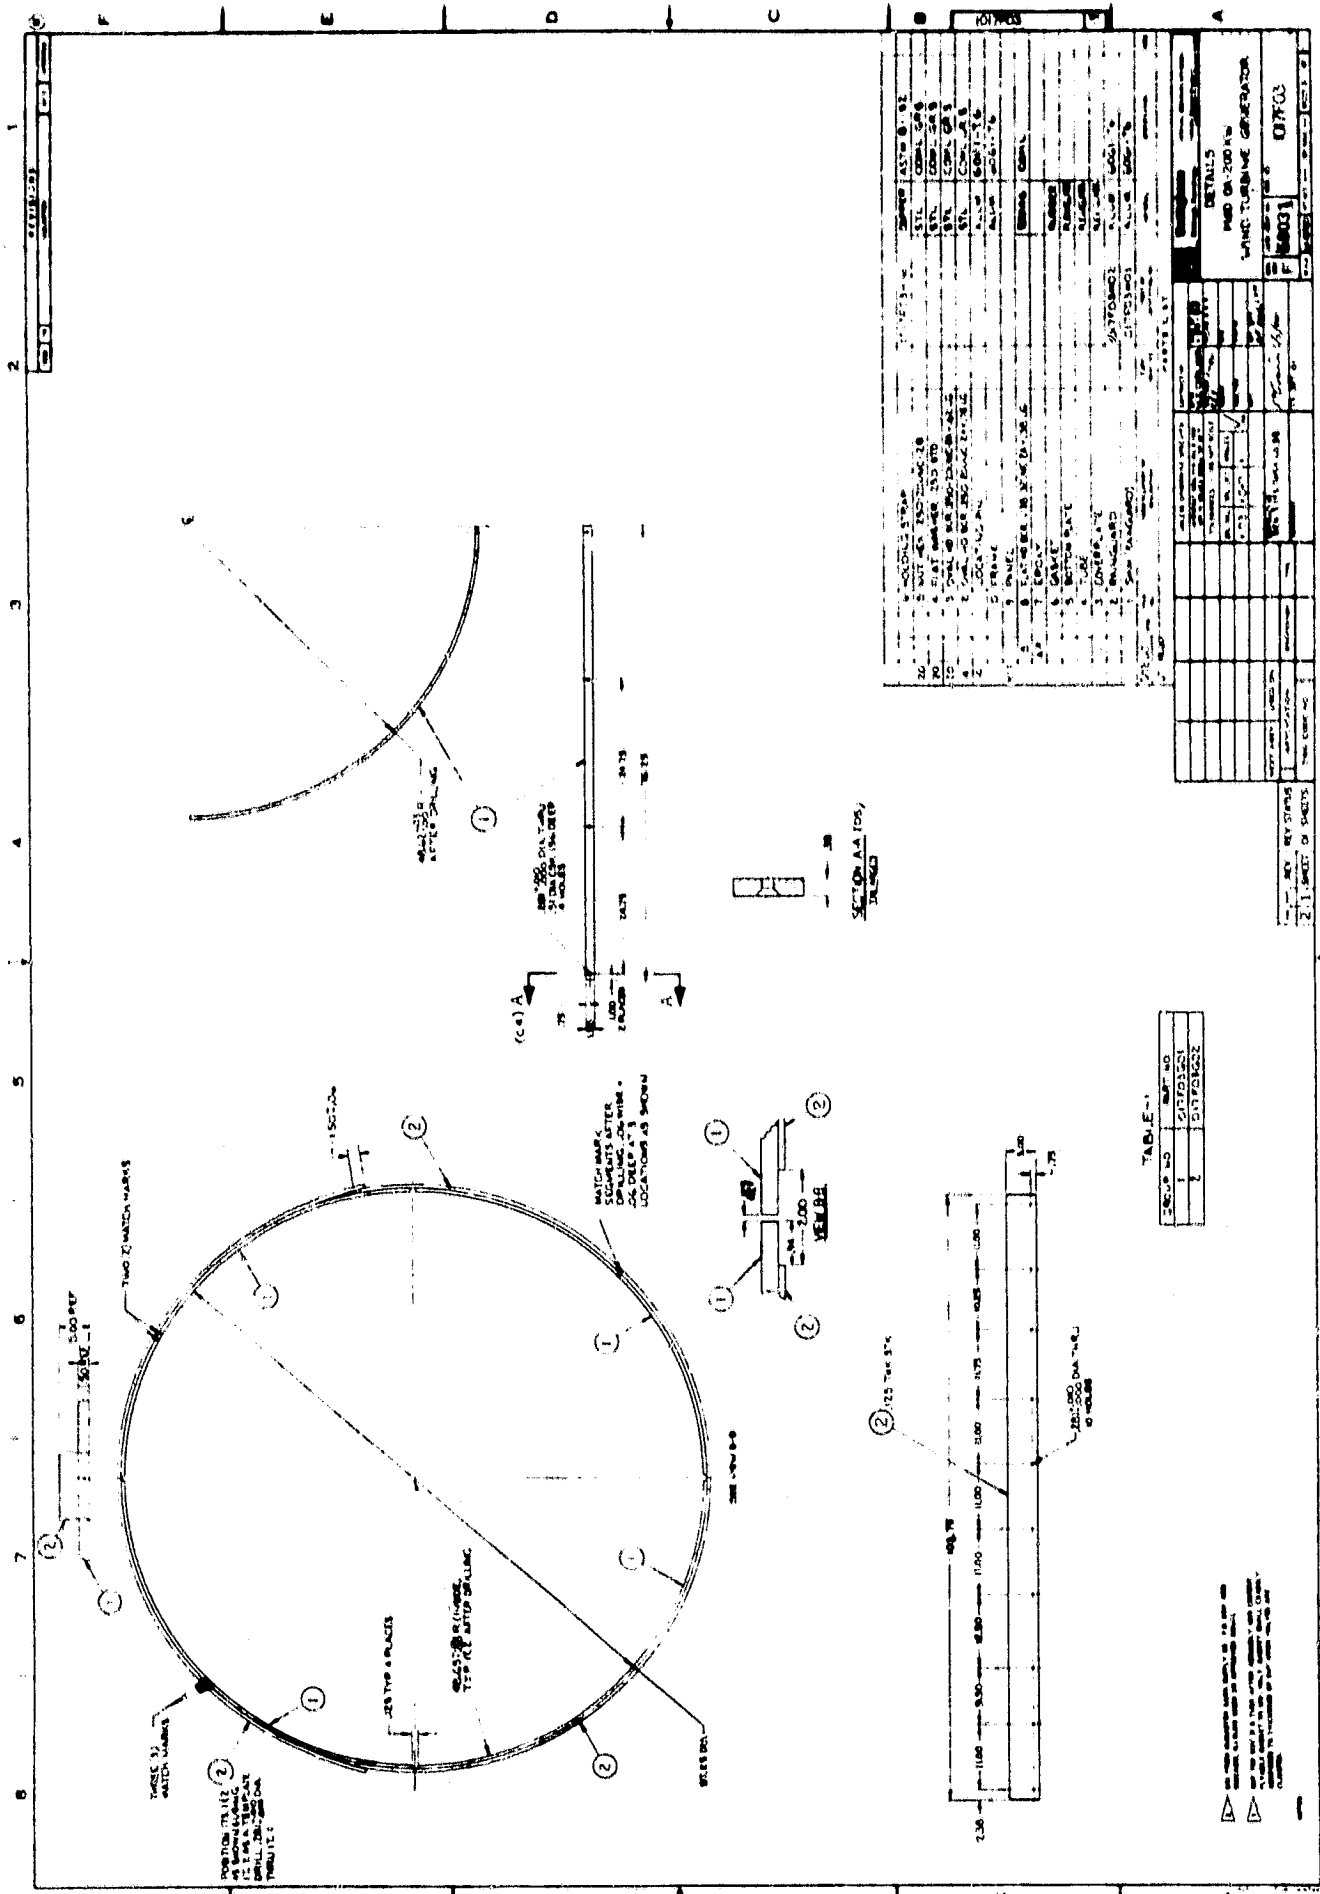






TABLE 1

SHEET NO.	TOTAL SHEETS
1	1

REVISIONS

NO.	DATE	DESCRIPTION

ORIGINAL PAGE IS
OF POOR QUALITY

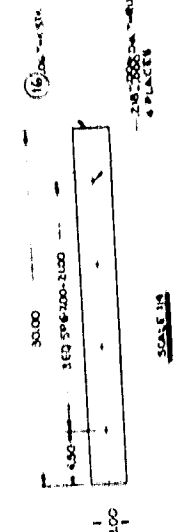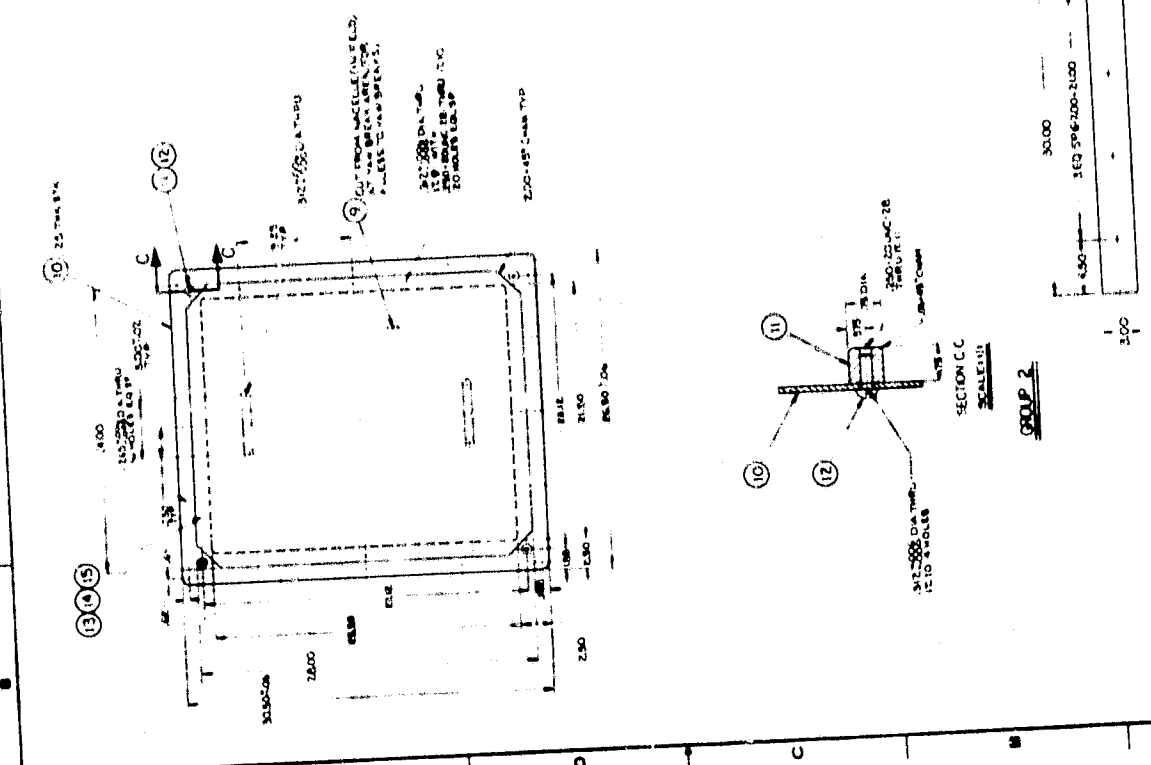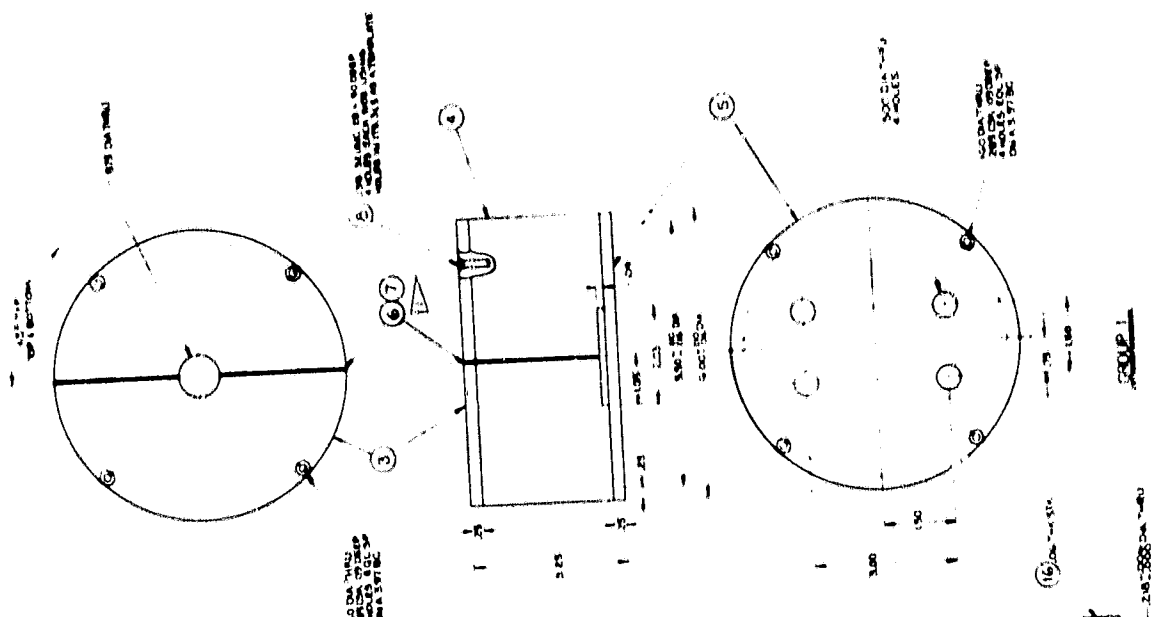

SCALE 1:1

SCALE 1:2

SCALE 1:1

SCALE 1:2

1 2 3 4 5 6 7 8

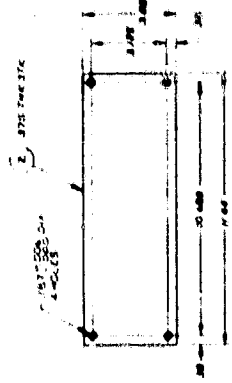

SCALE 1/2

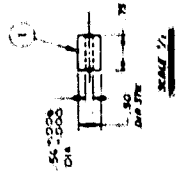

SCALE 1/2


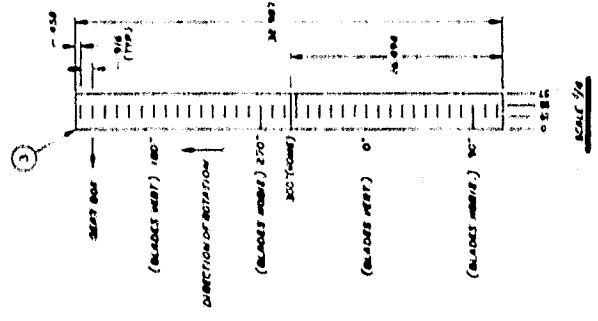


TABLE-1

GROUP NO.	REV. NO.
1	1 (ORIGINAL)

1. ALL DIMENSIONS ARE IN INCHES UNLESS OTHERWISE SPECIFIED.
 2. DIMENSIONS ARE TO CENTER UNLESS OTHERWISE SPECIFIED.
 3. DIMENSIONS ARE TO CENTER UNLESS OTHERWISE SPECIFIED.

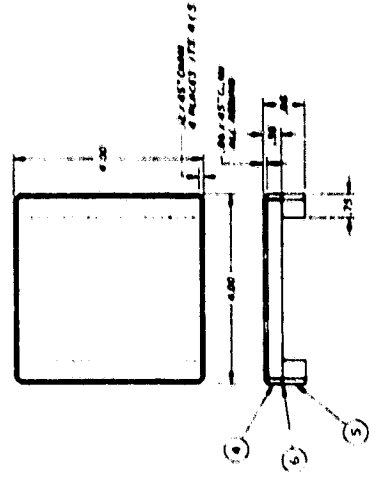

GROUP 1
SCALE 1/2

REV.	DATE	BY	CHKD.
1	10/17/64	W. J.

DETAILS	
GROUP NO.	1017F04
REV. NO.	1
DATE	10/17/64
BY	W. J. ...
CHKD.	...
TITLE	WIND TURBINE GENERATOR

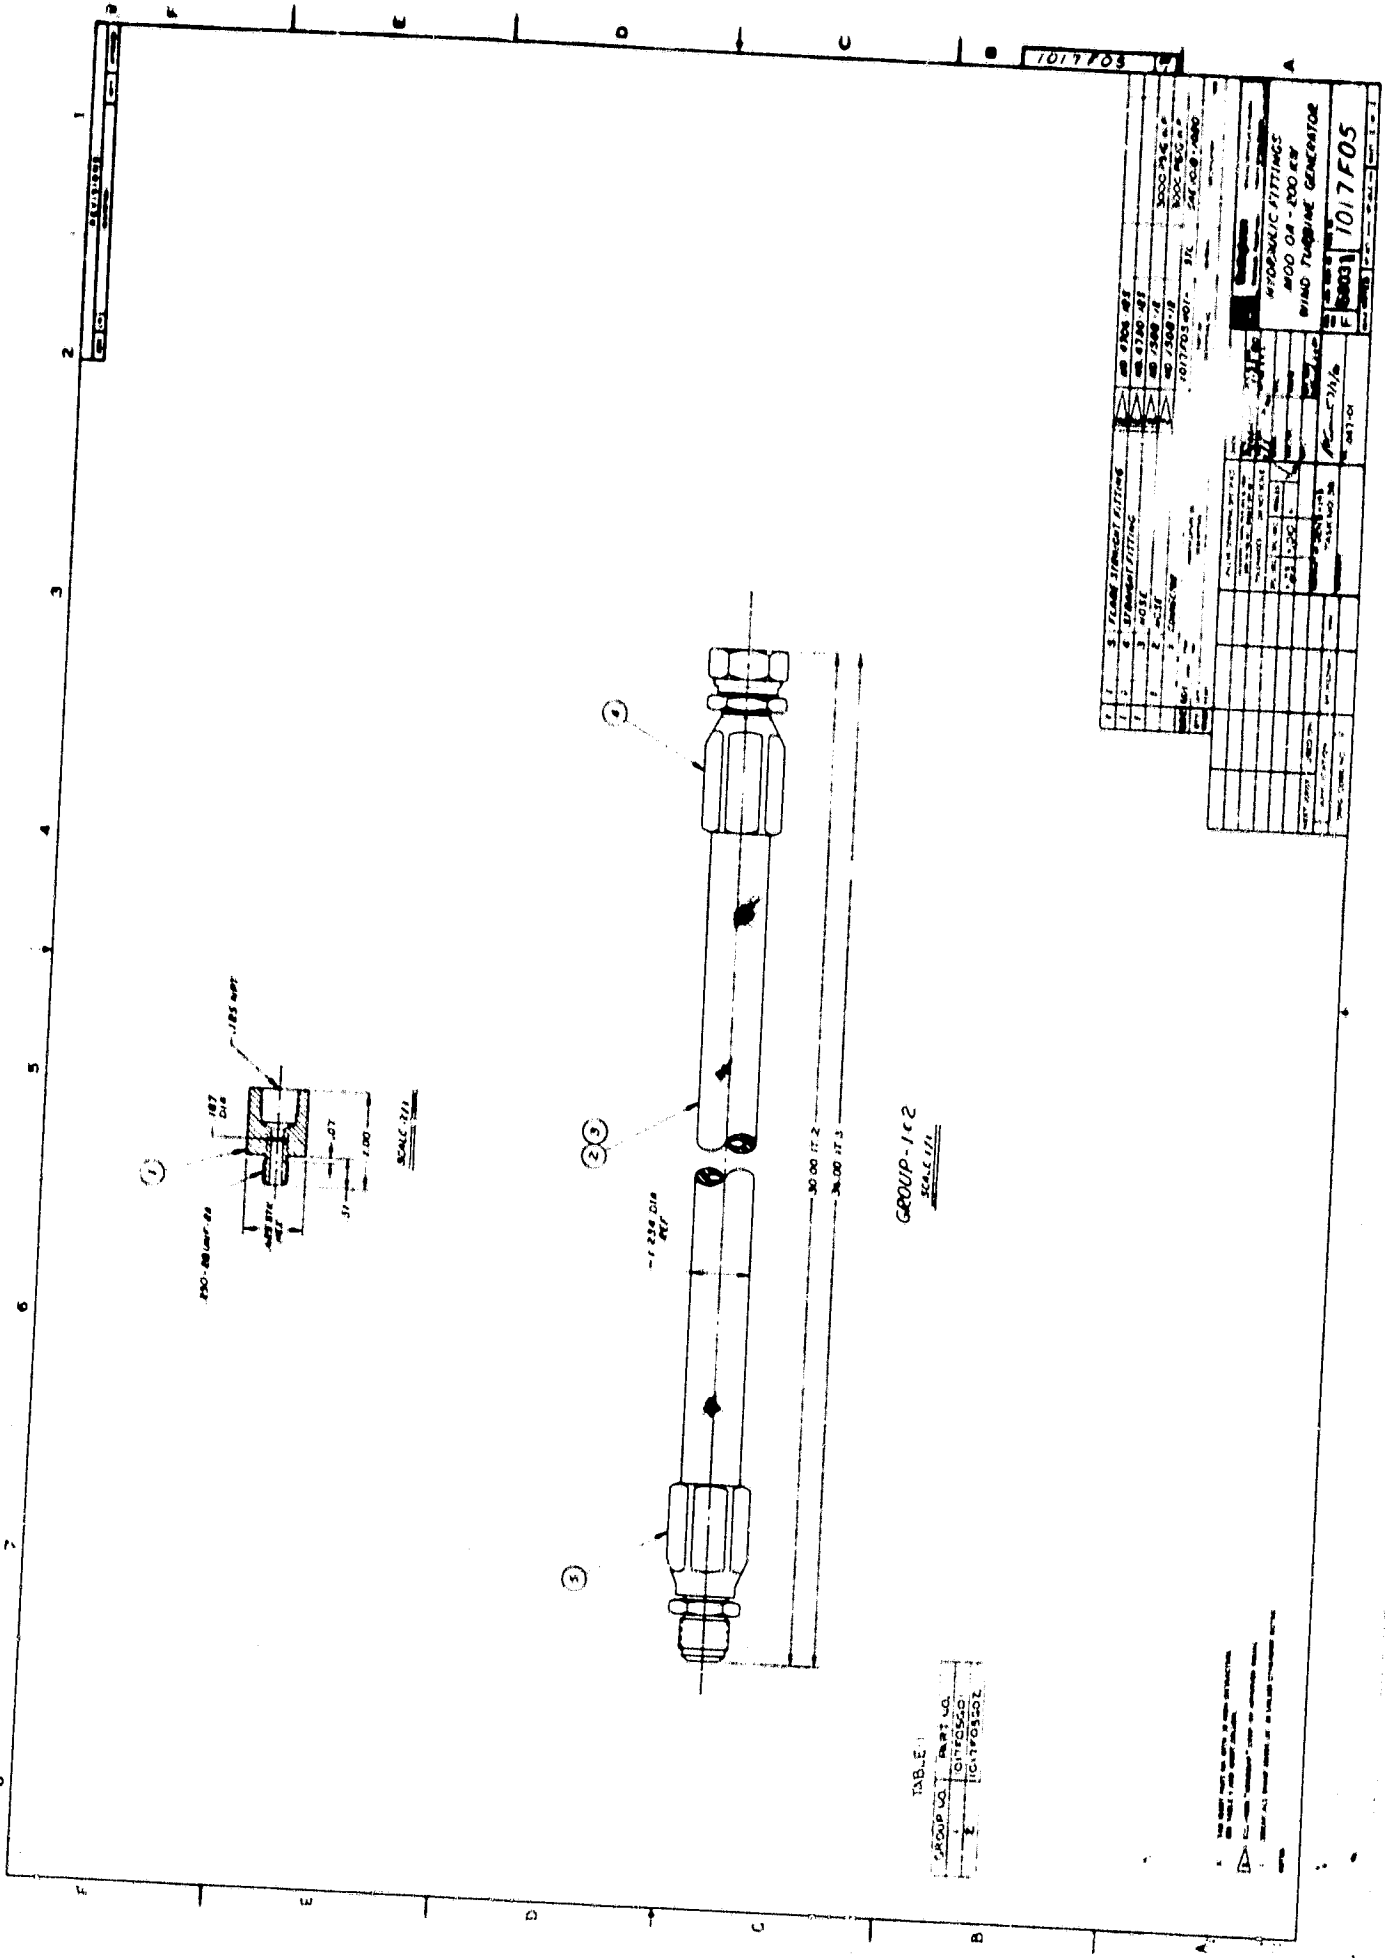


TABLE 1


GROUP NO.	1
PART NO.	1017F05
REV.	1

1017F05

HYDRAULIC FITTINGS
WIND TURBINE GENERATOR

1017F05

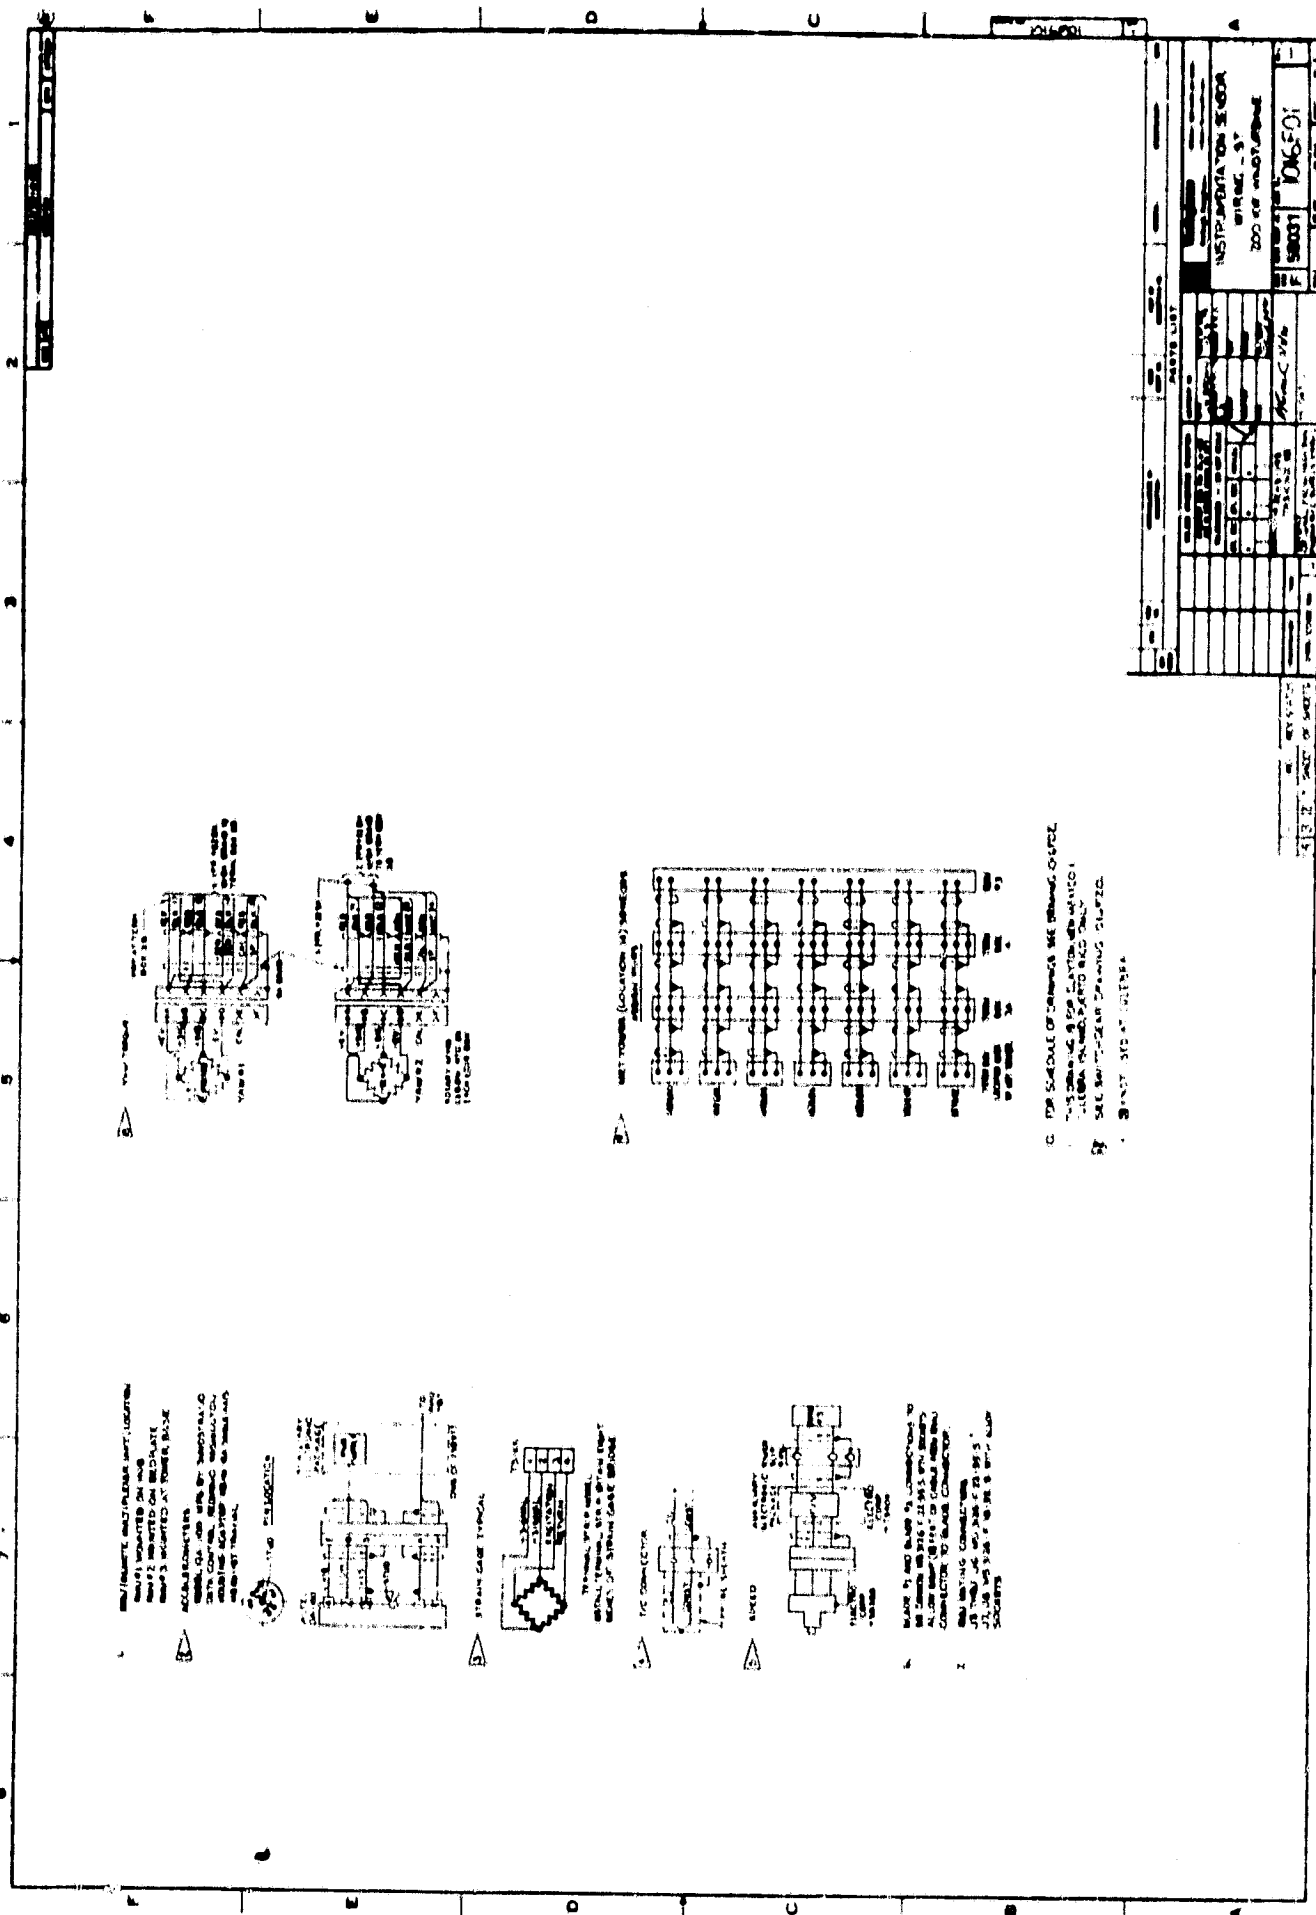

1. ALL TRAYS, MULTIPLES, SUPPORTS, LOCATIONS, AND CONNECTIONS SHALL BE AS SHOWN AND SHALL BE INSTALLED IN ACCORDANCE WITH THE FOLLOWING NOTES:

2. ALL TRAYS SHALL BE INSTALLED AT POWER BASE.








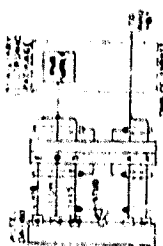

STRAIN GAGE TYPICAL



TFC CONNECTOR



SHIELD



CABLE CONNECTION








00001

INSTRUMENTATION SYSTEM

WIRING - 37

200 OF 200

198001

00001






1
2
3
4
5
6
7
8

1016501




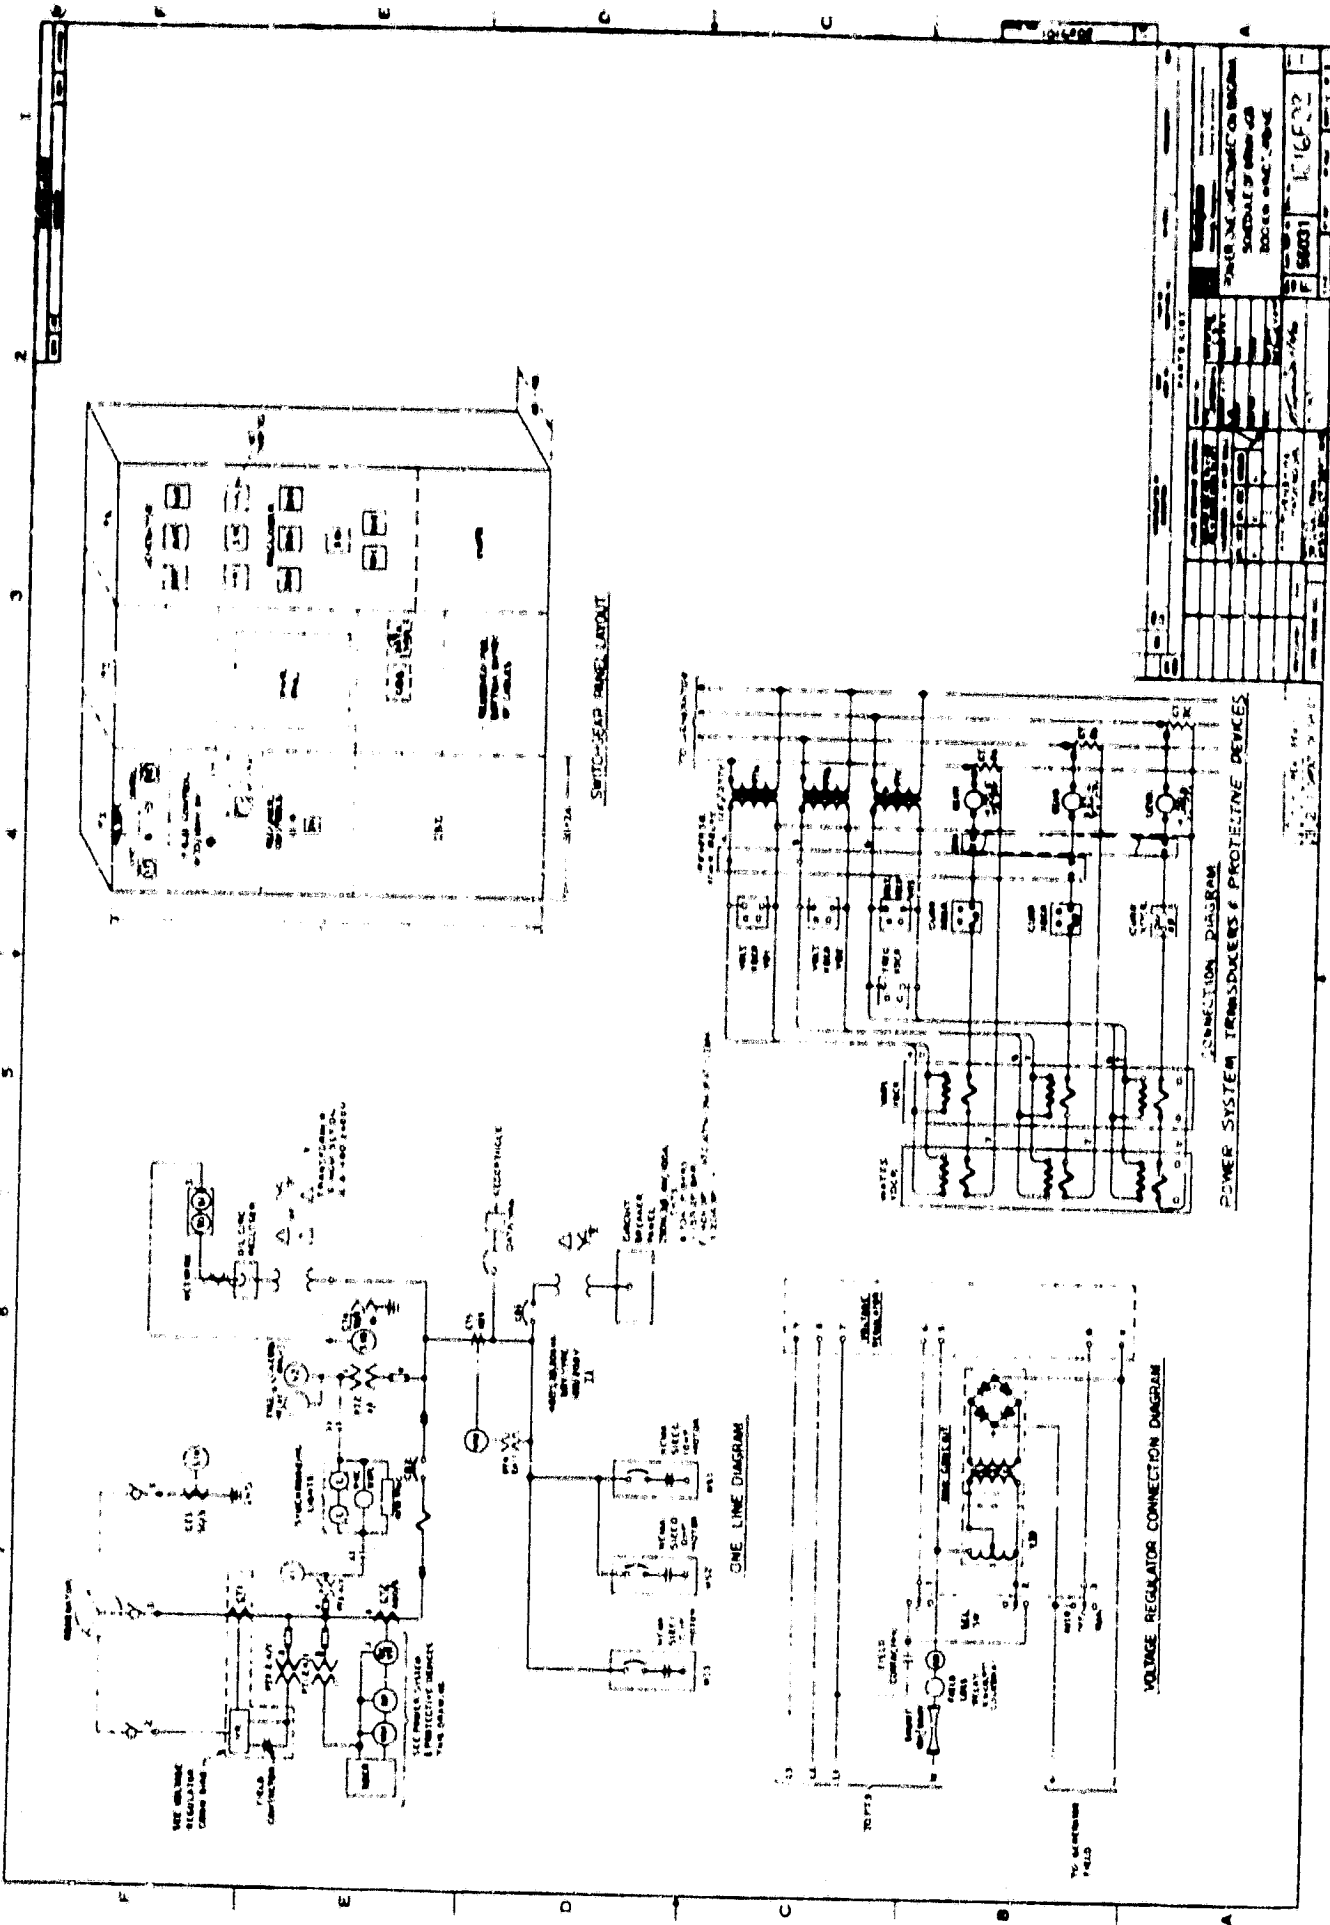




VOLTAGE REGULATOR CONNECTION DIAGRAM

ONE LINE DIAGRAM

SWITCHGEAR ASSEMBLY LAYOUT

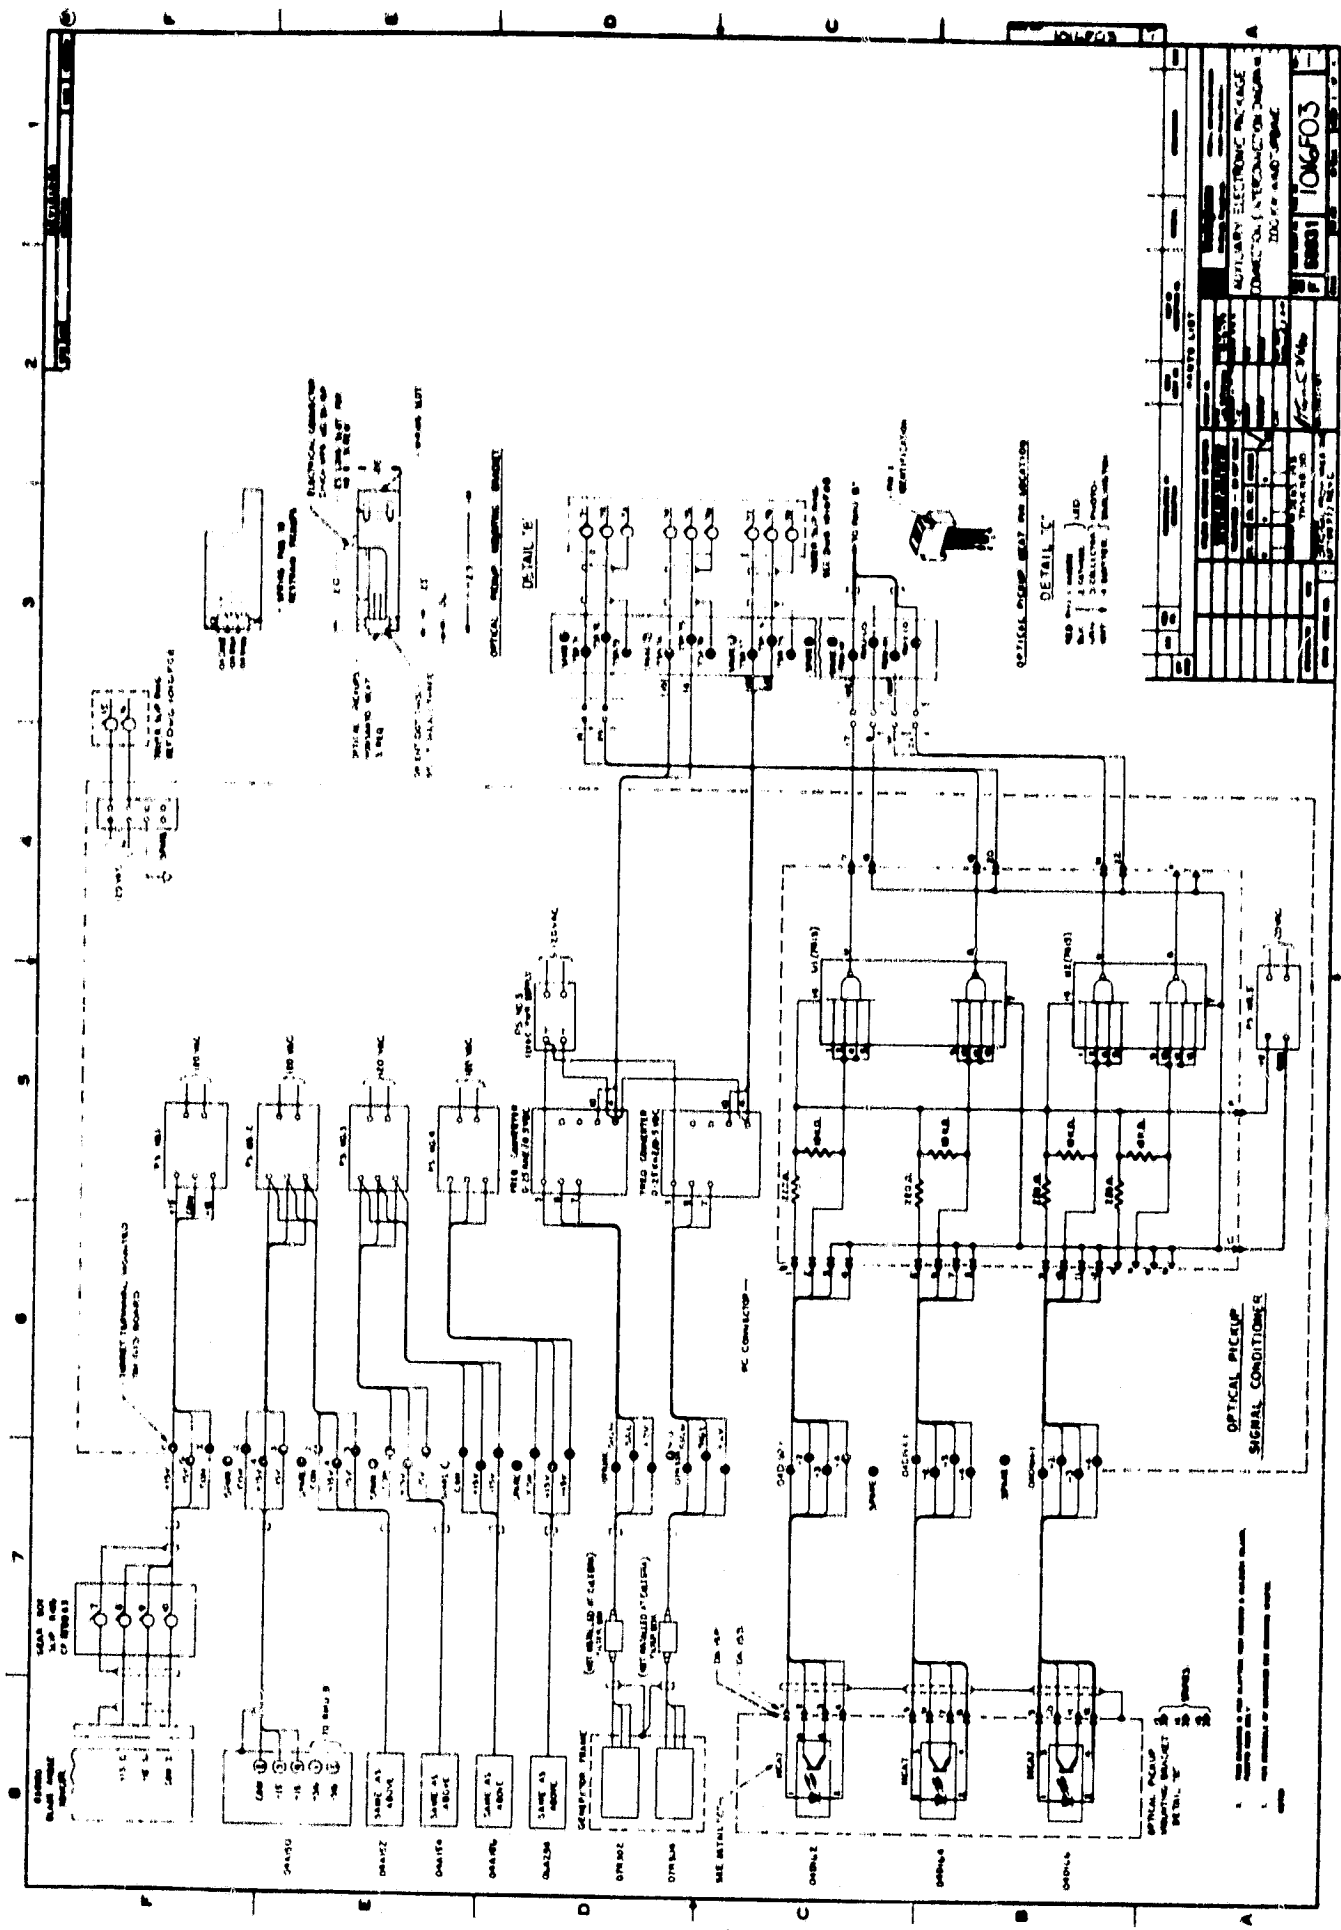

PARTS LIST	




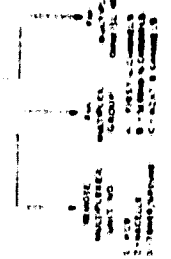





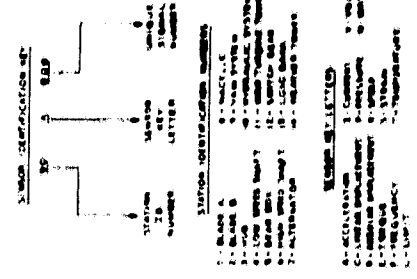

REVISIONS		DATE		BY	
1	REVISED	10/15/60	J. J.
2
3
4
5

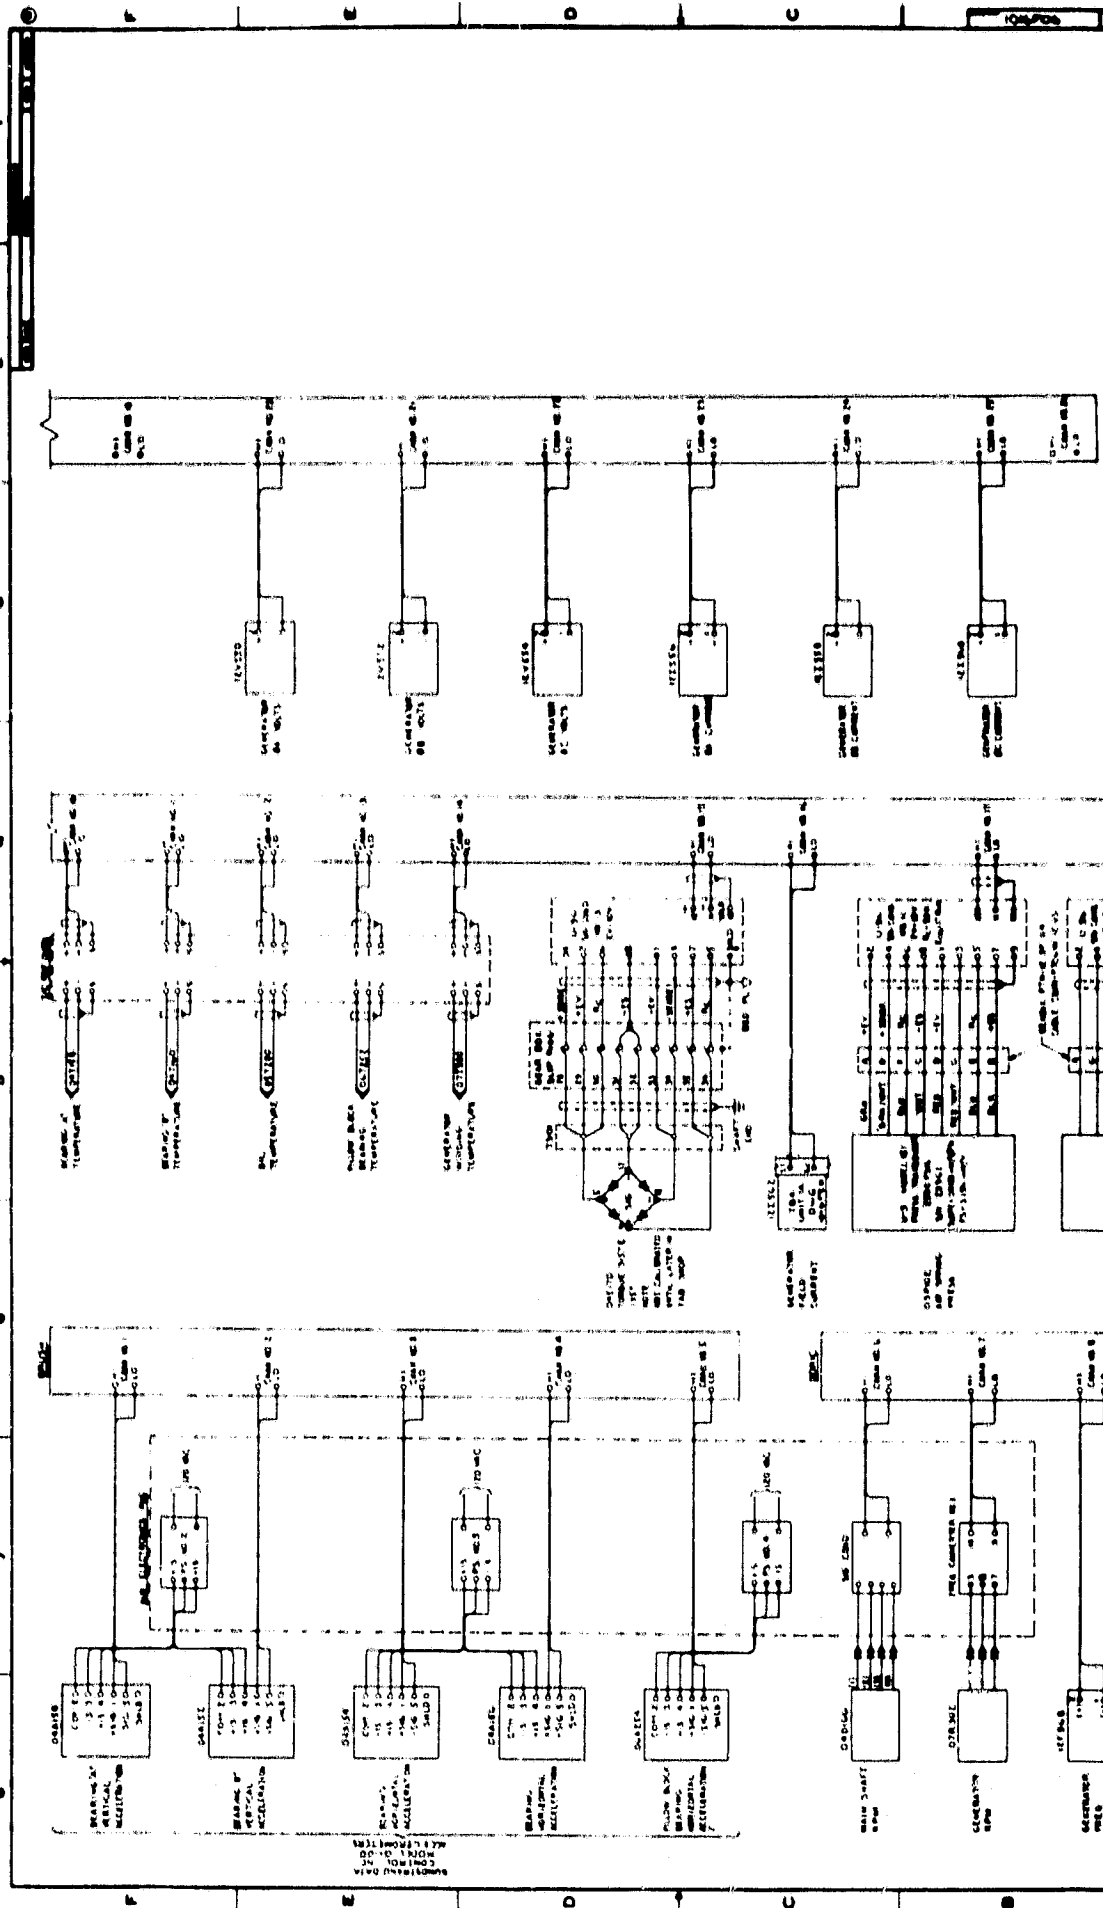



1
2
3
4
5
6
7
8

A
B
C
D
E
F


101-2107

1016F07

REV	1	REVISED	
REV	2	REVISED	
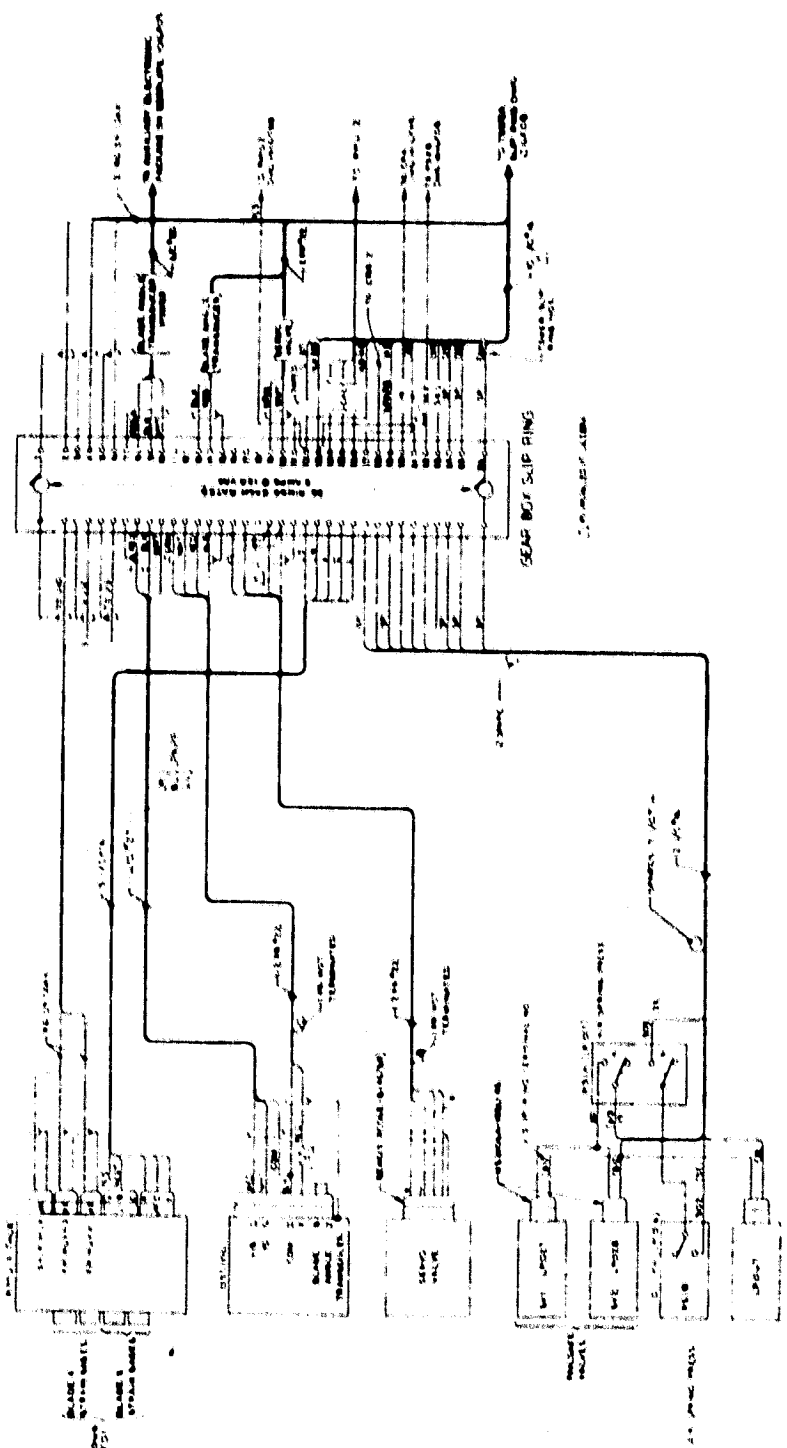



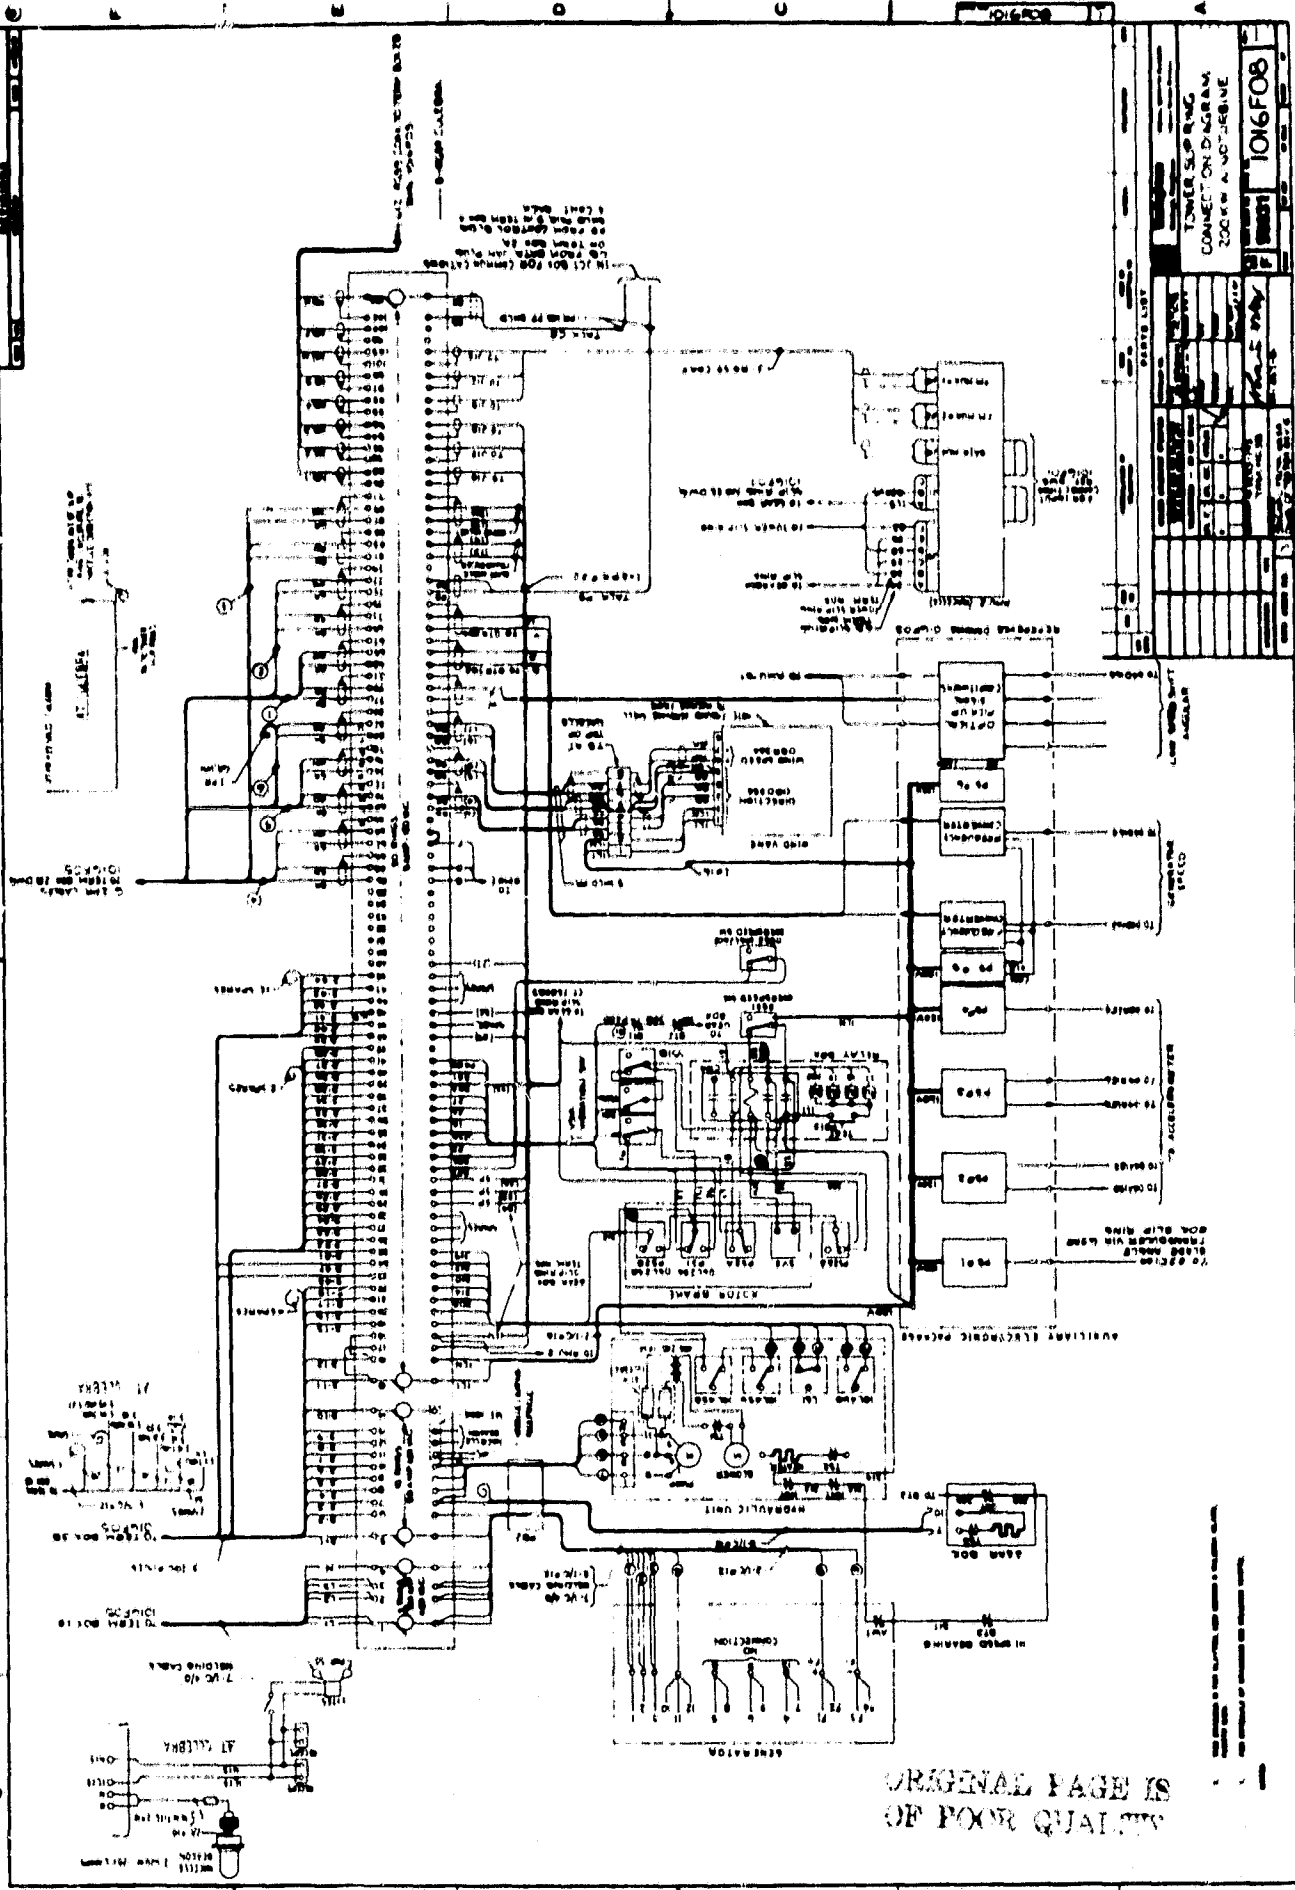

1016 F08	

ORIGINAL PAGE IS OF POOR QUALITY

ORIGINAL PAGE IS
OF POOR QUALITY

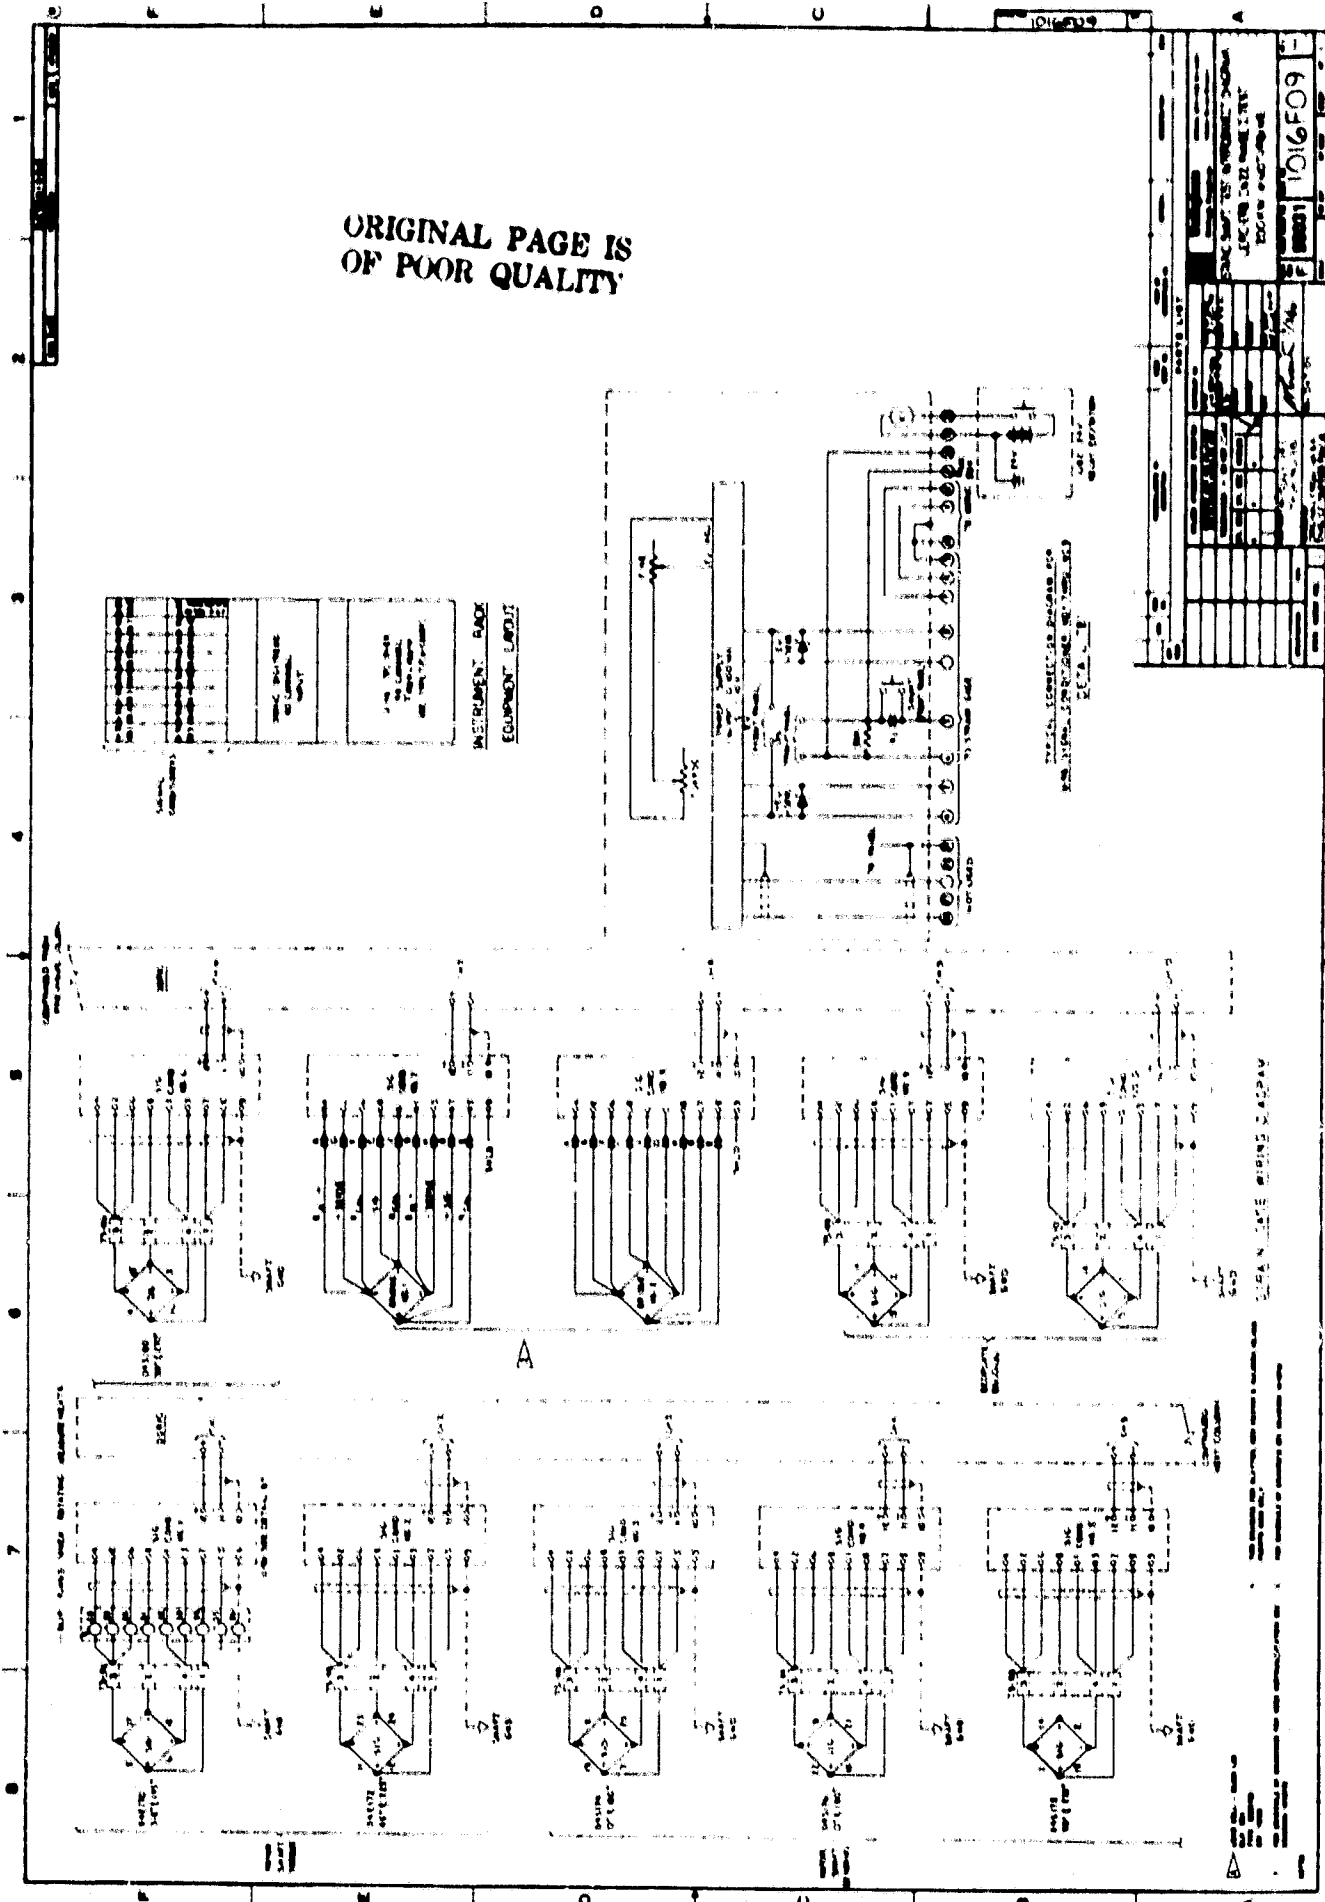









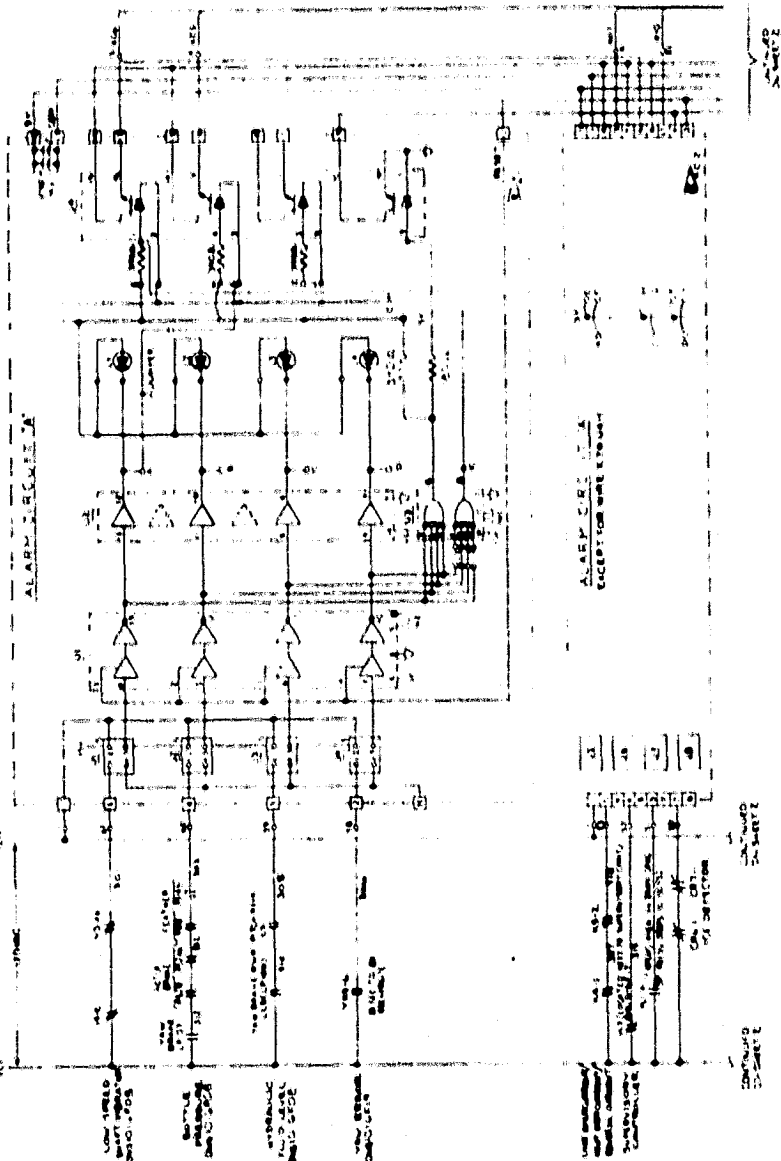





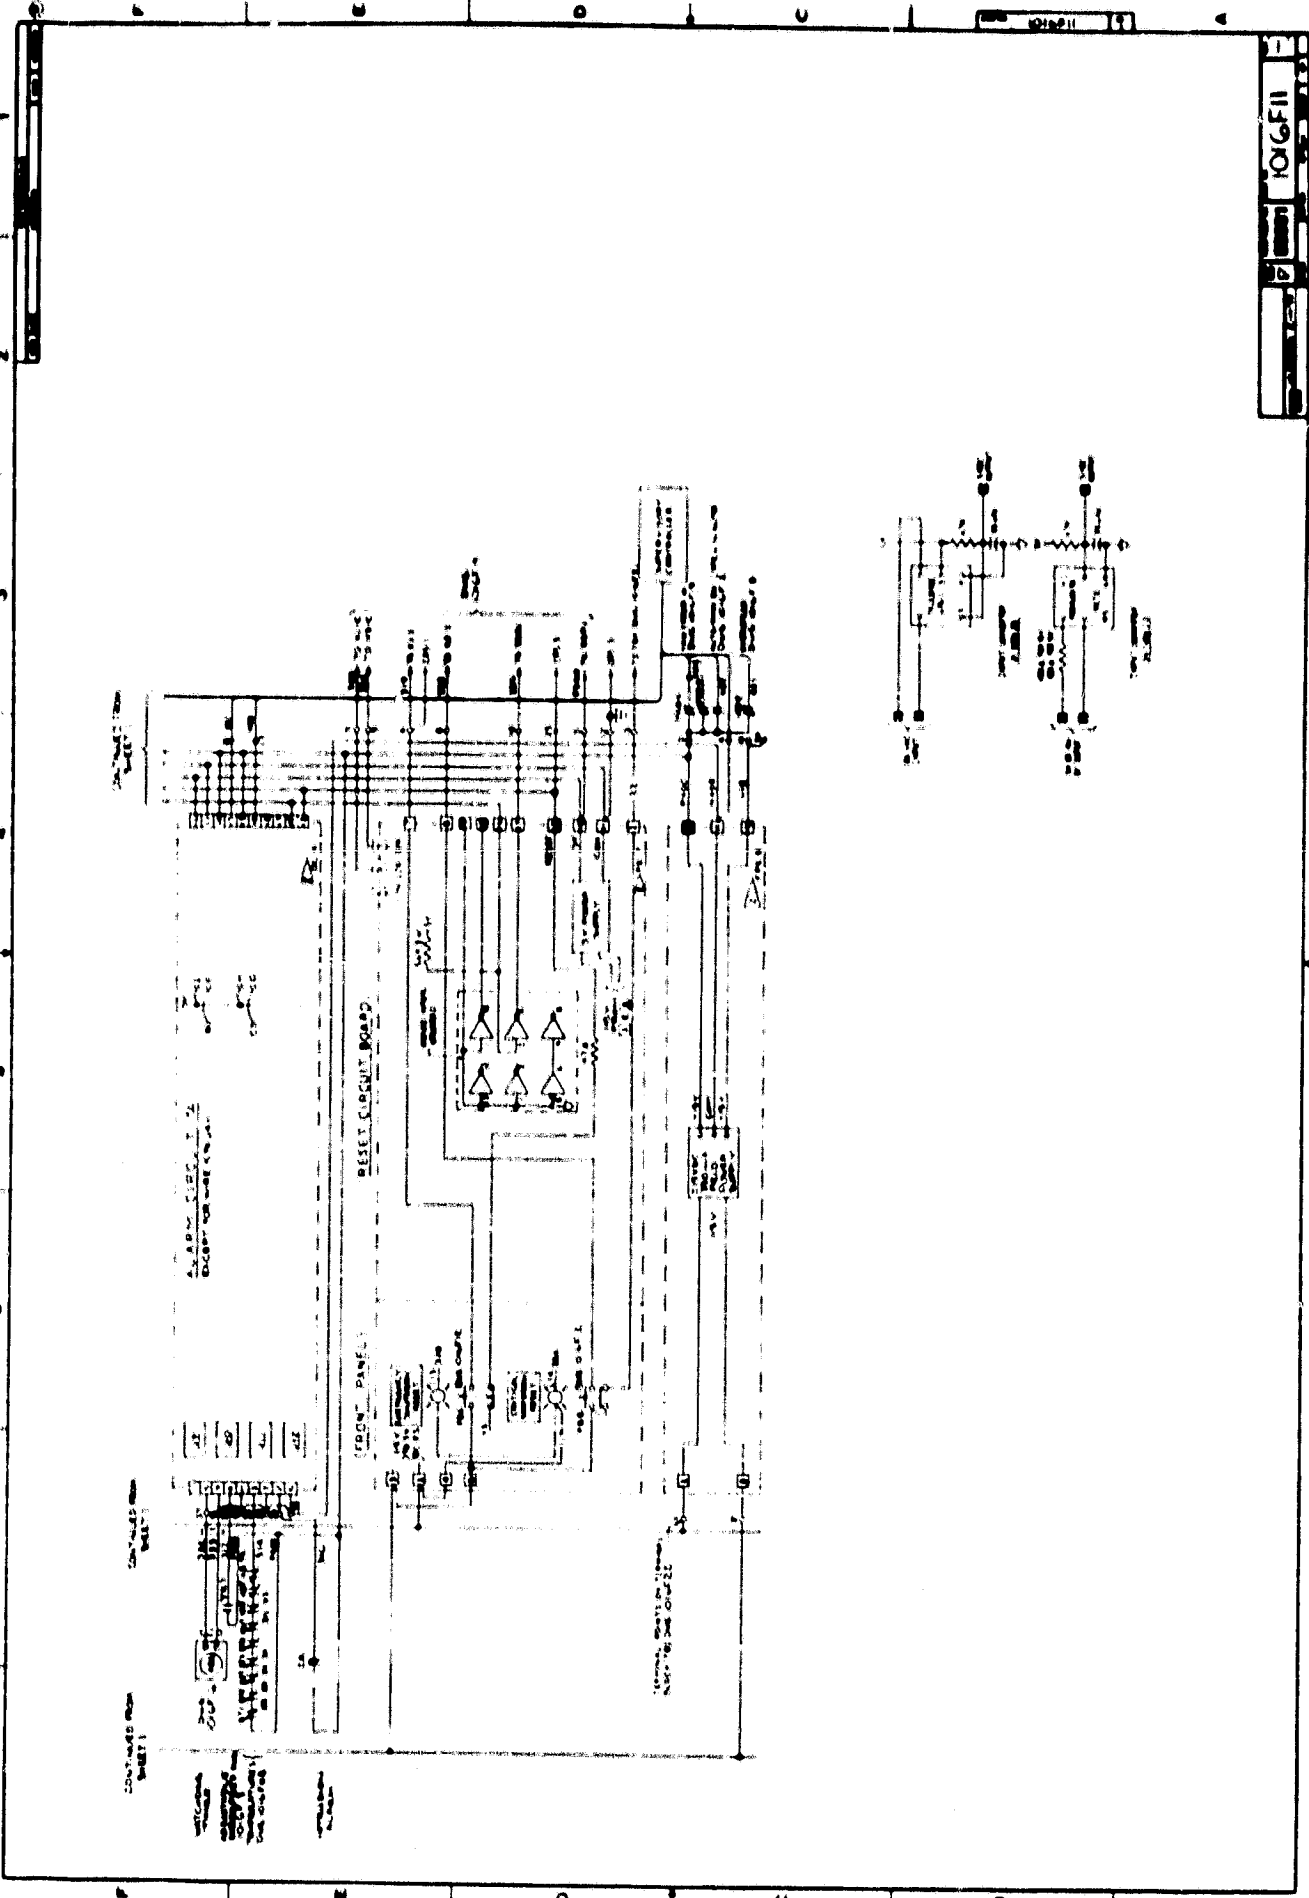

106FIL

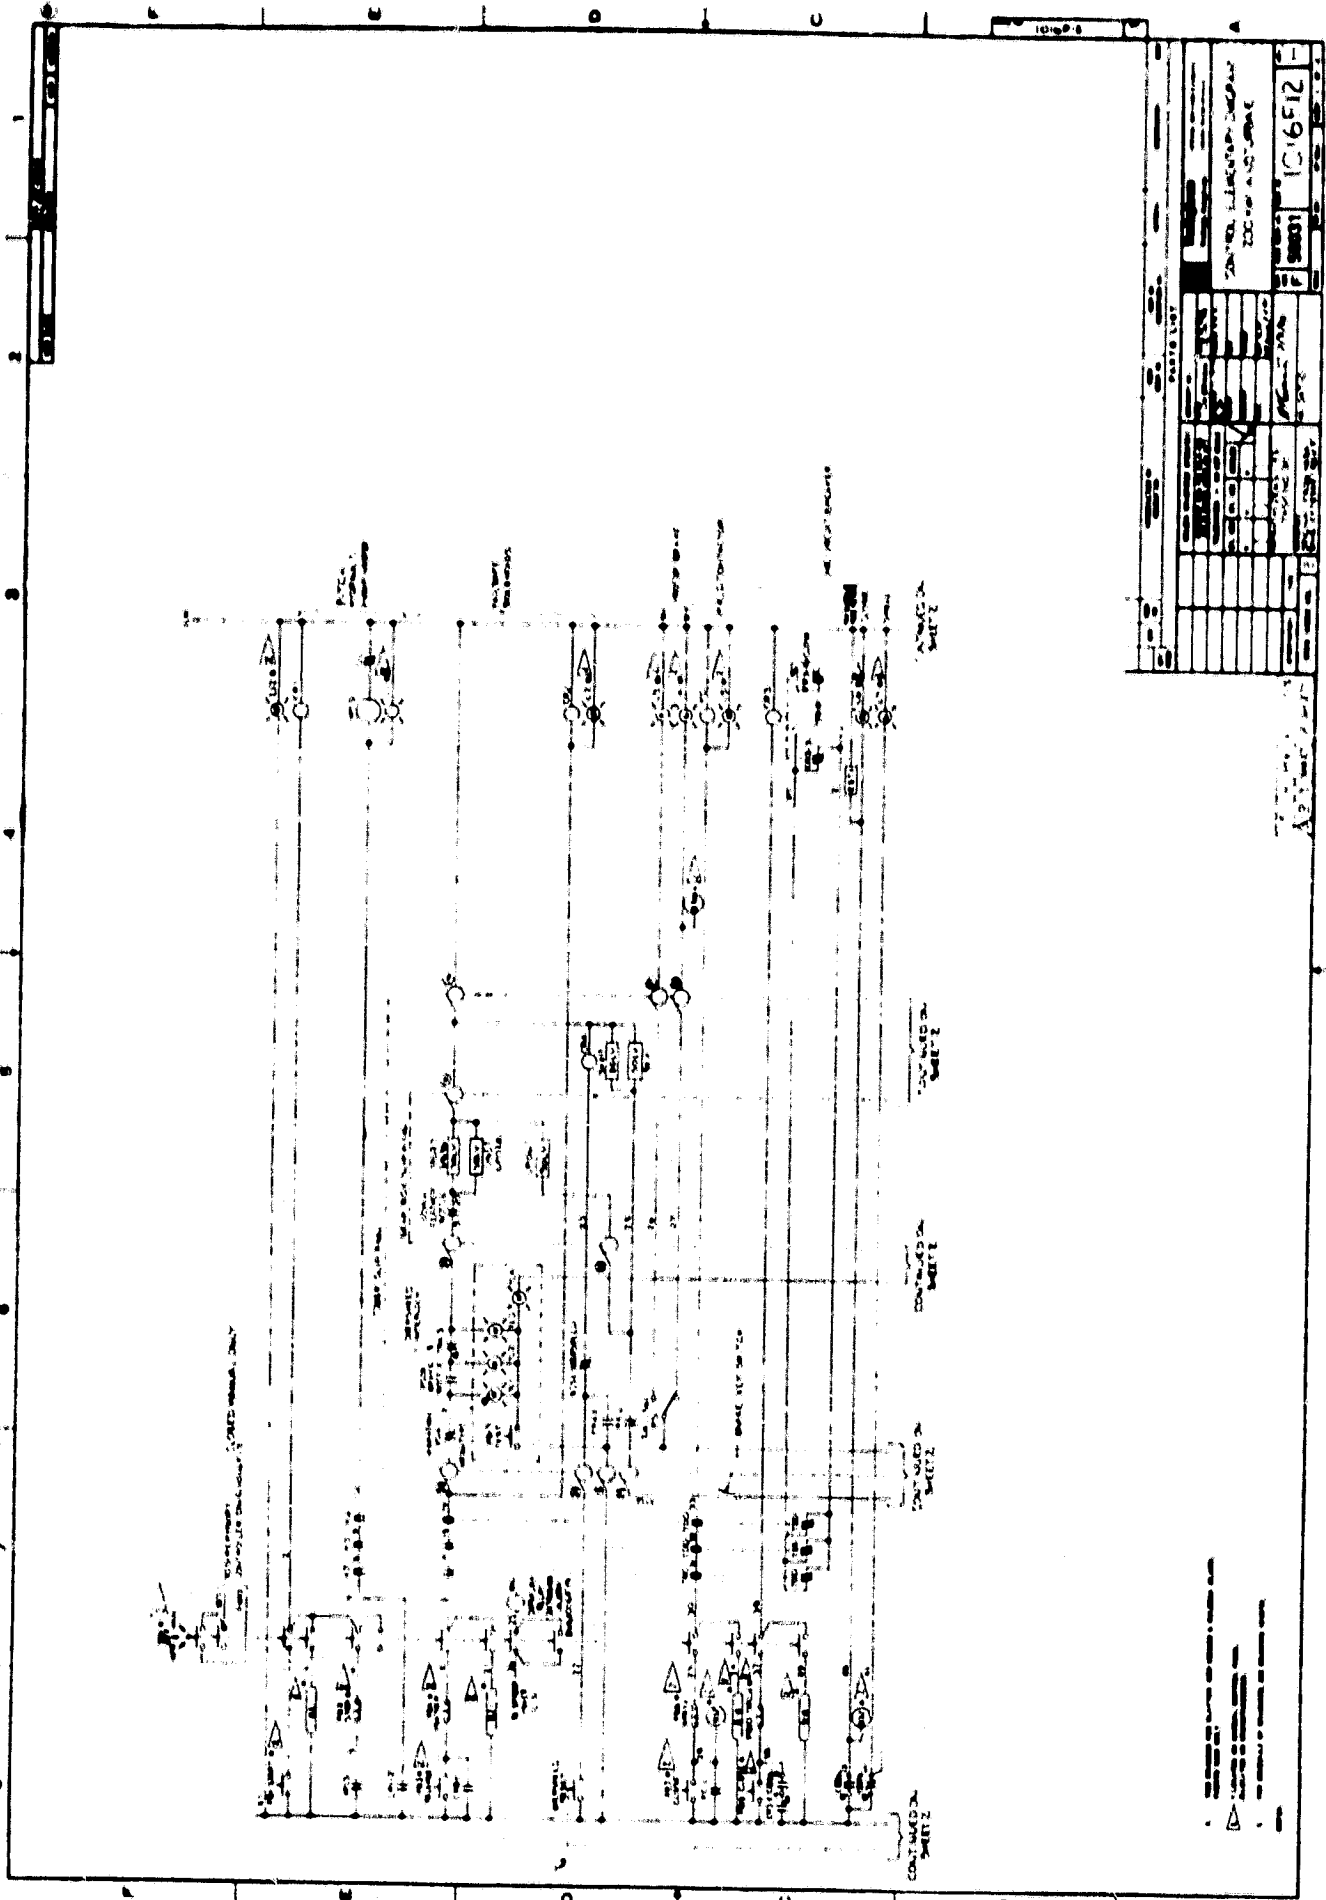

DATE LIST		1016P-8	
NO.	DESCRIPTION	DATE	BY
1016P-8

























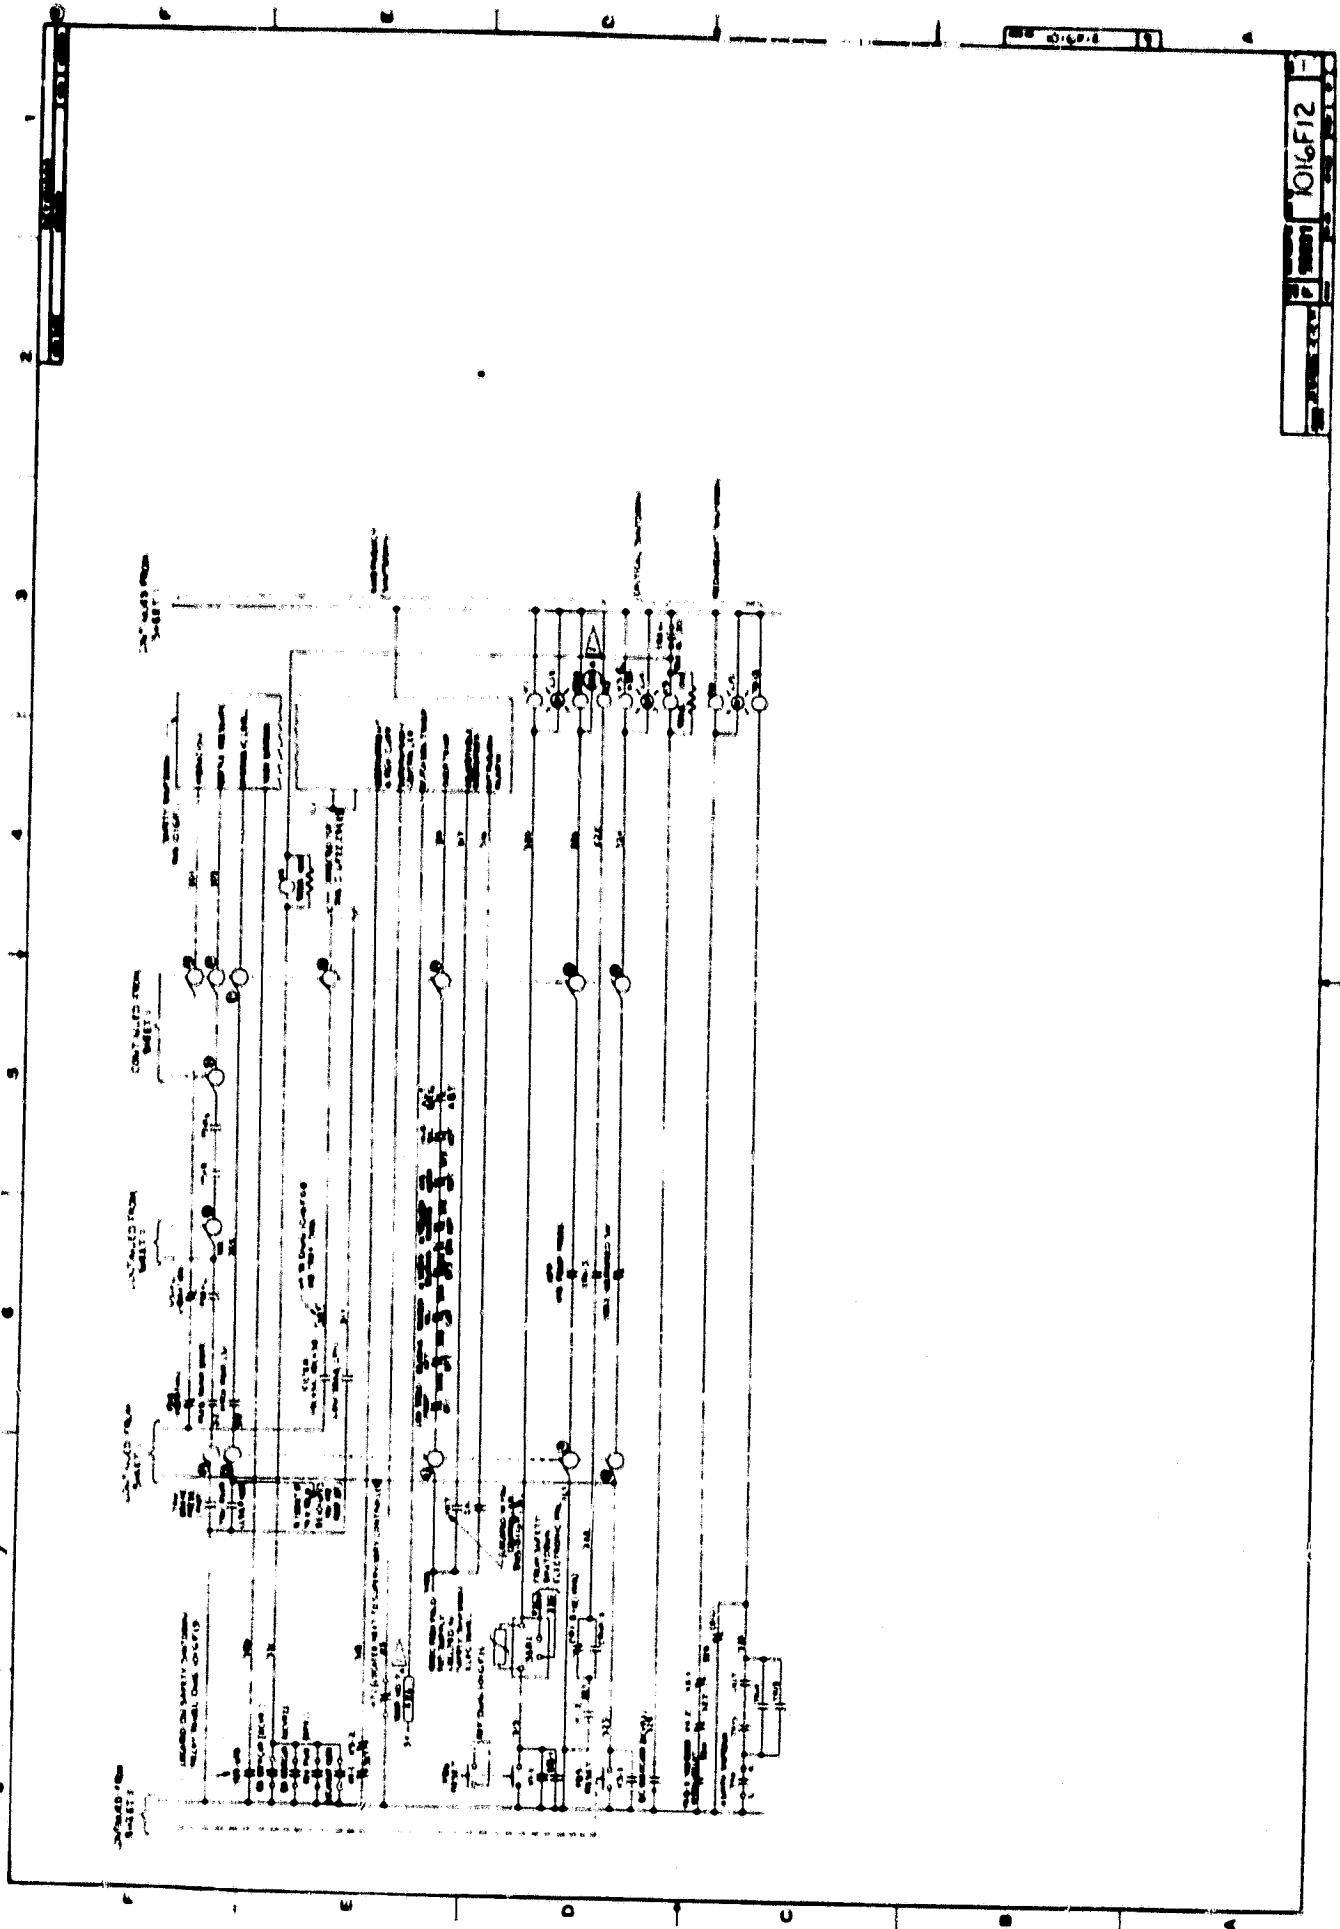


1016F12

1.2

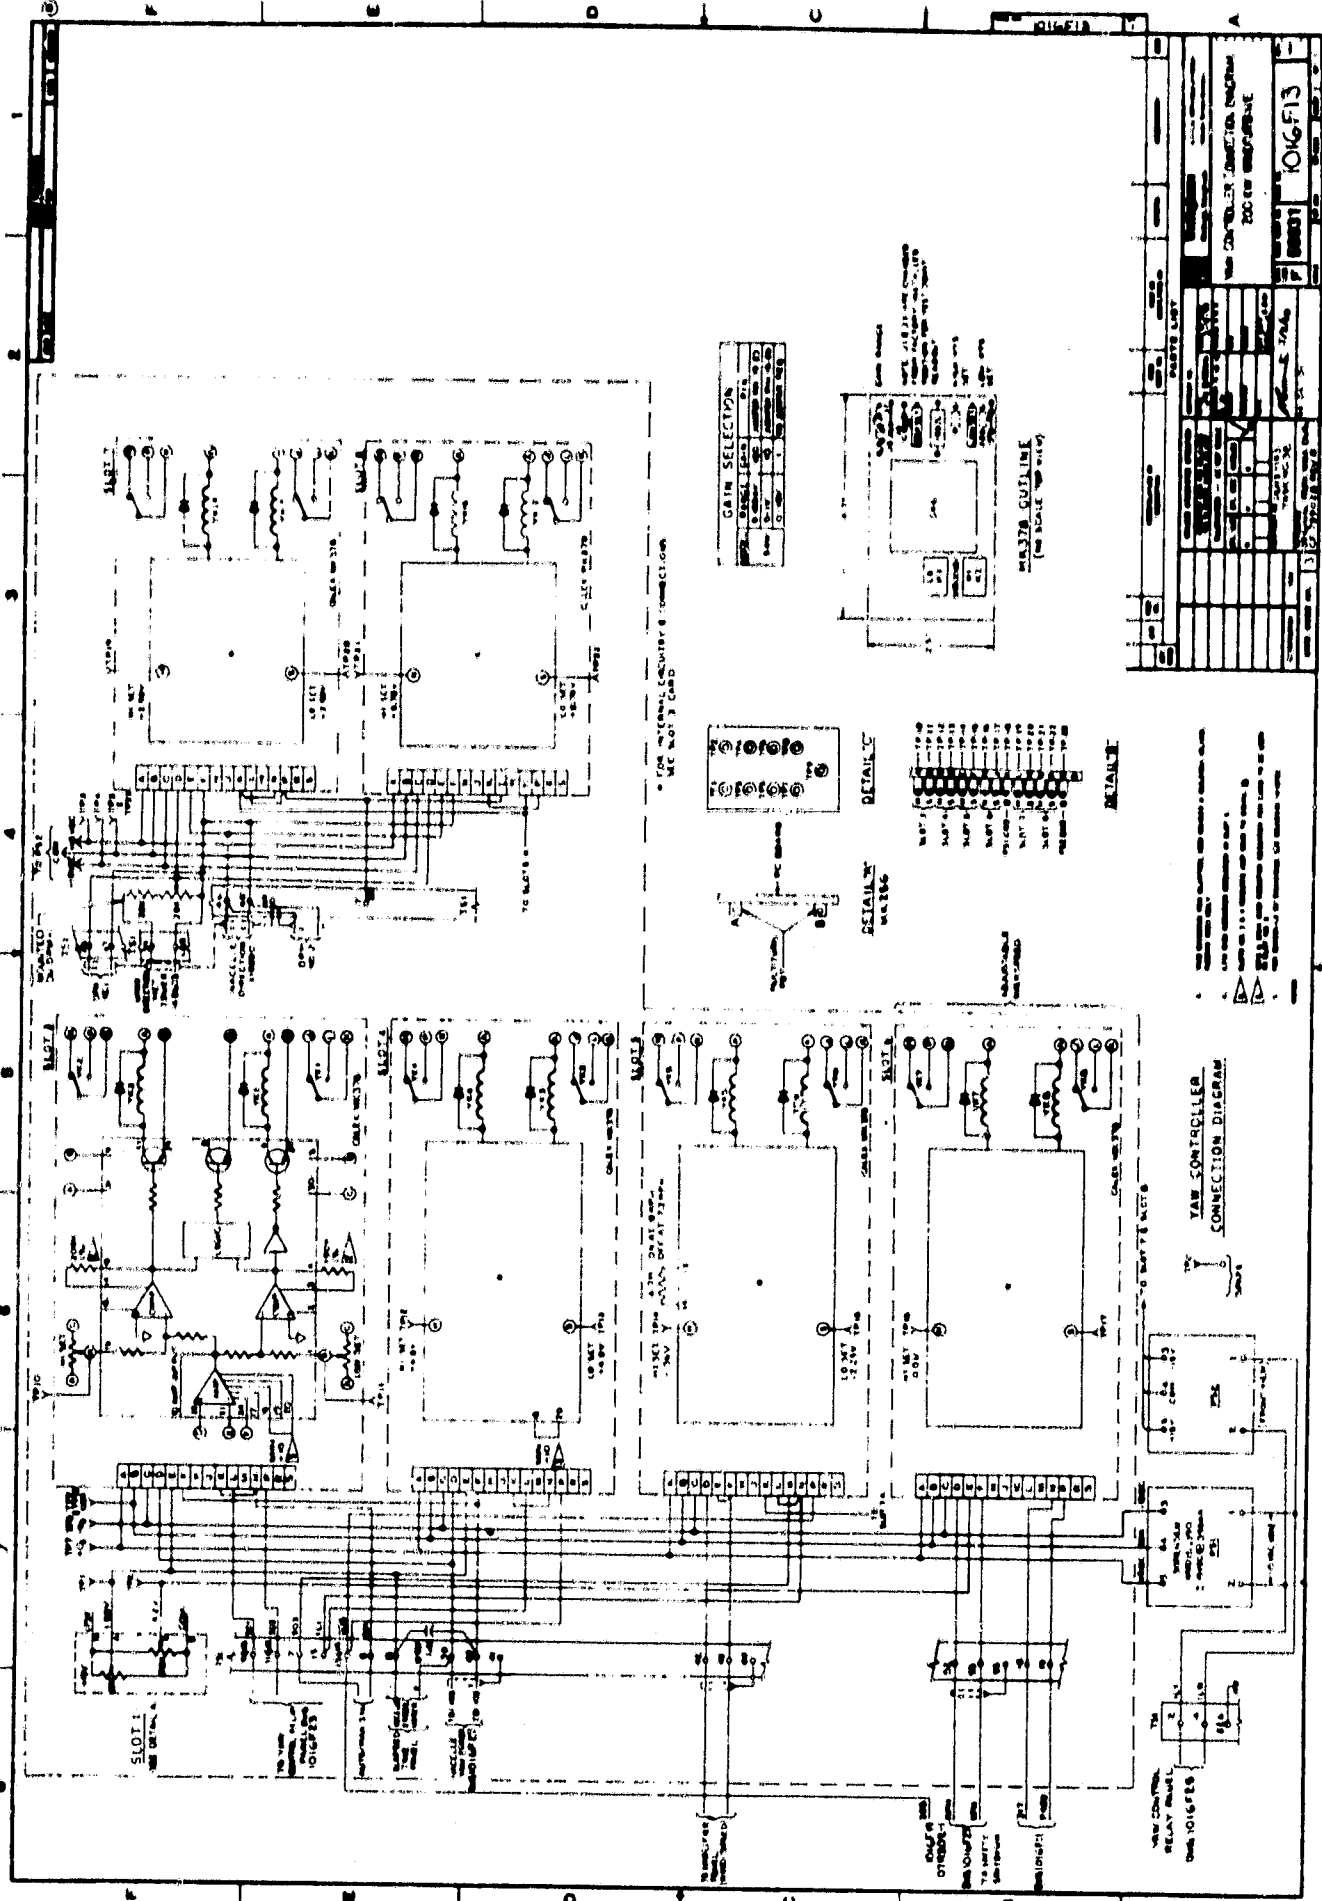

GAIN SELECTION


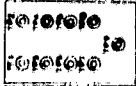


- 1. THE RELAY CONNECTIONS ARE IDENTICAL TO THOSE SHOWN IN THE CONNECTION DIAGRAM.

YAW CONTROLLER CONNECTION DIAGRAM

1016F13

REV	DATE	BY	CHKD	APP'D
1				

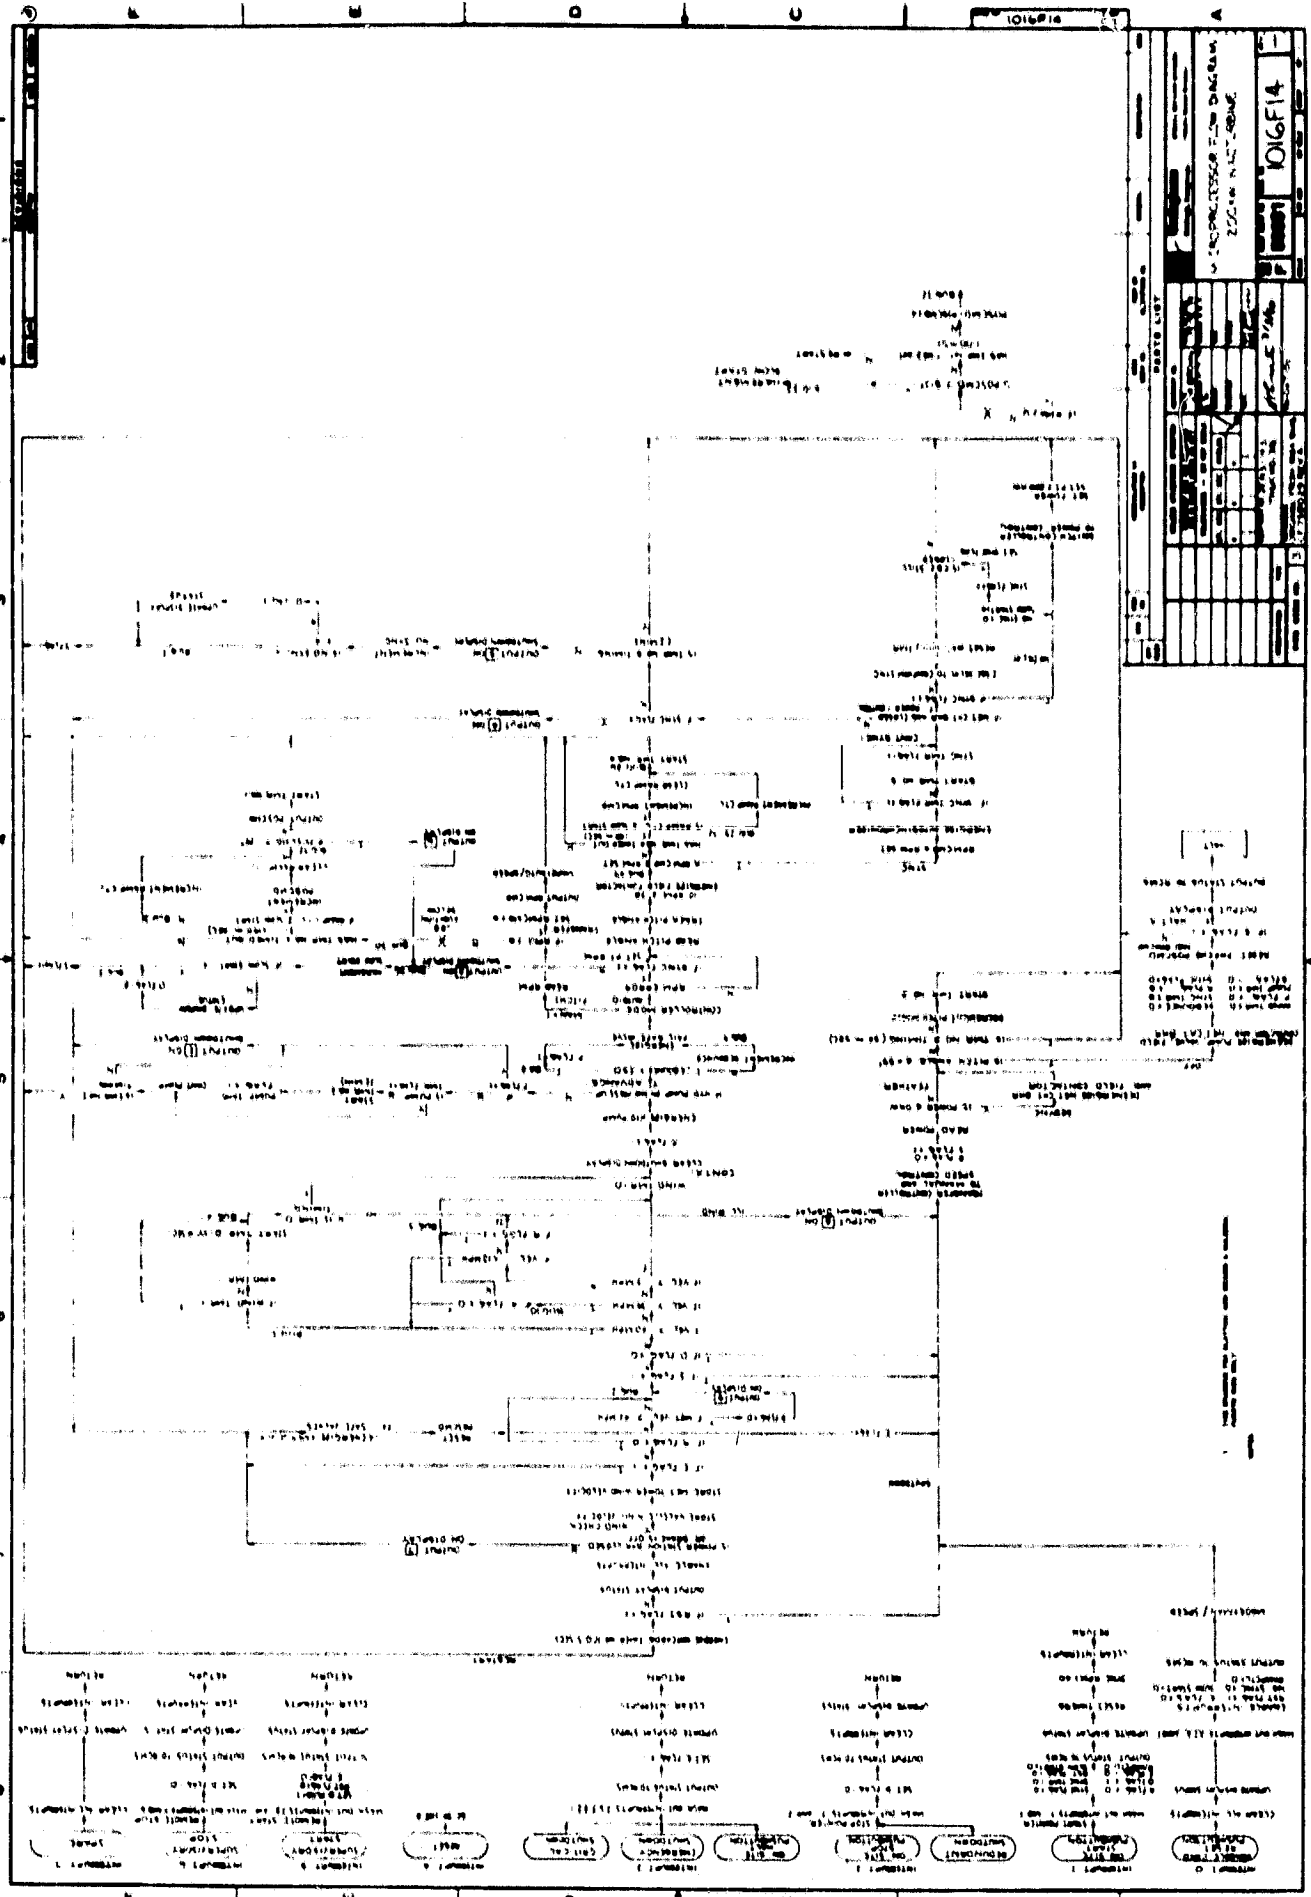


101614


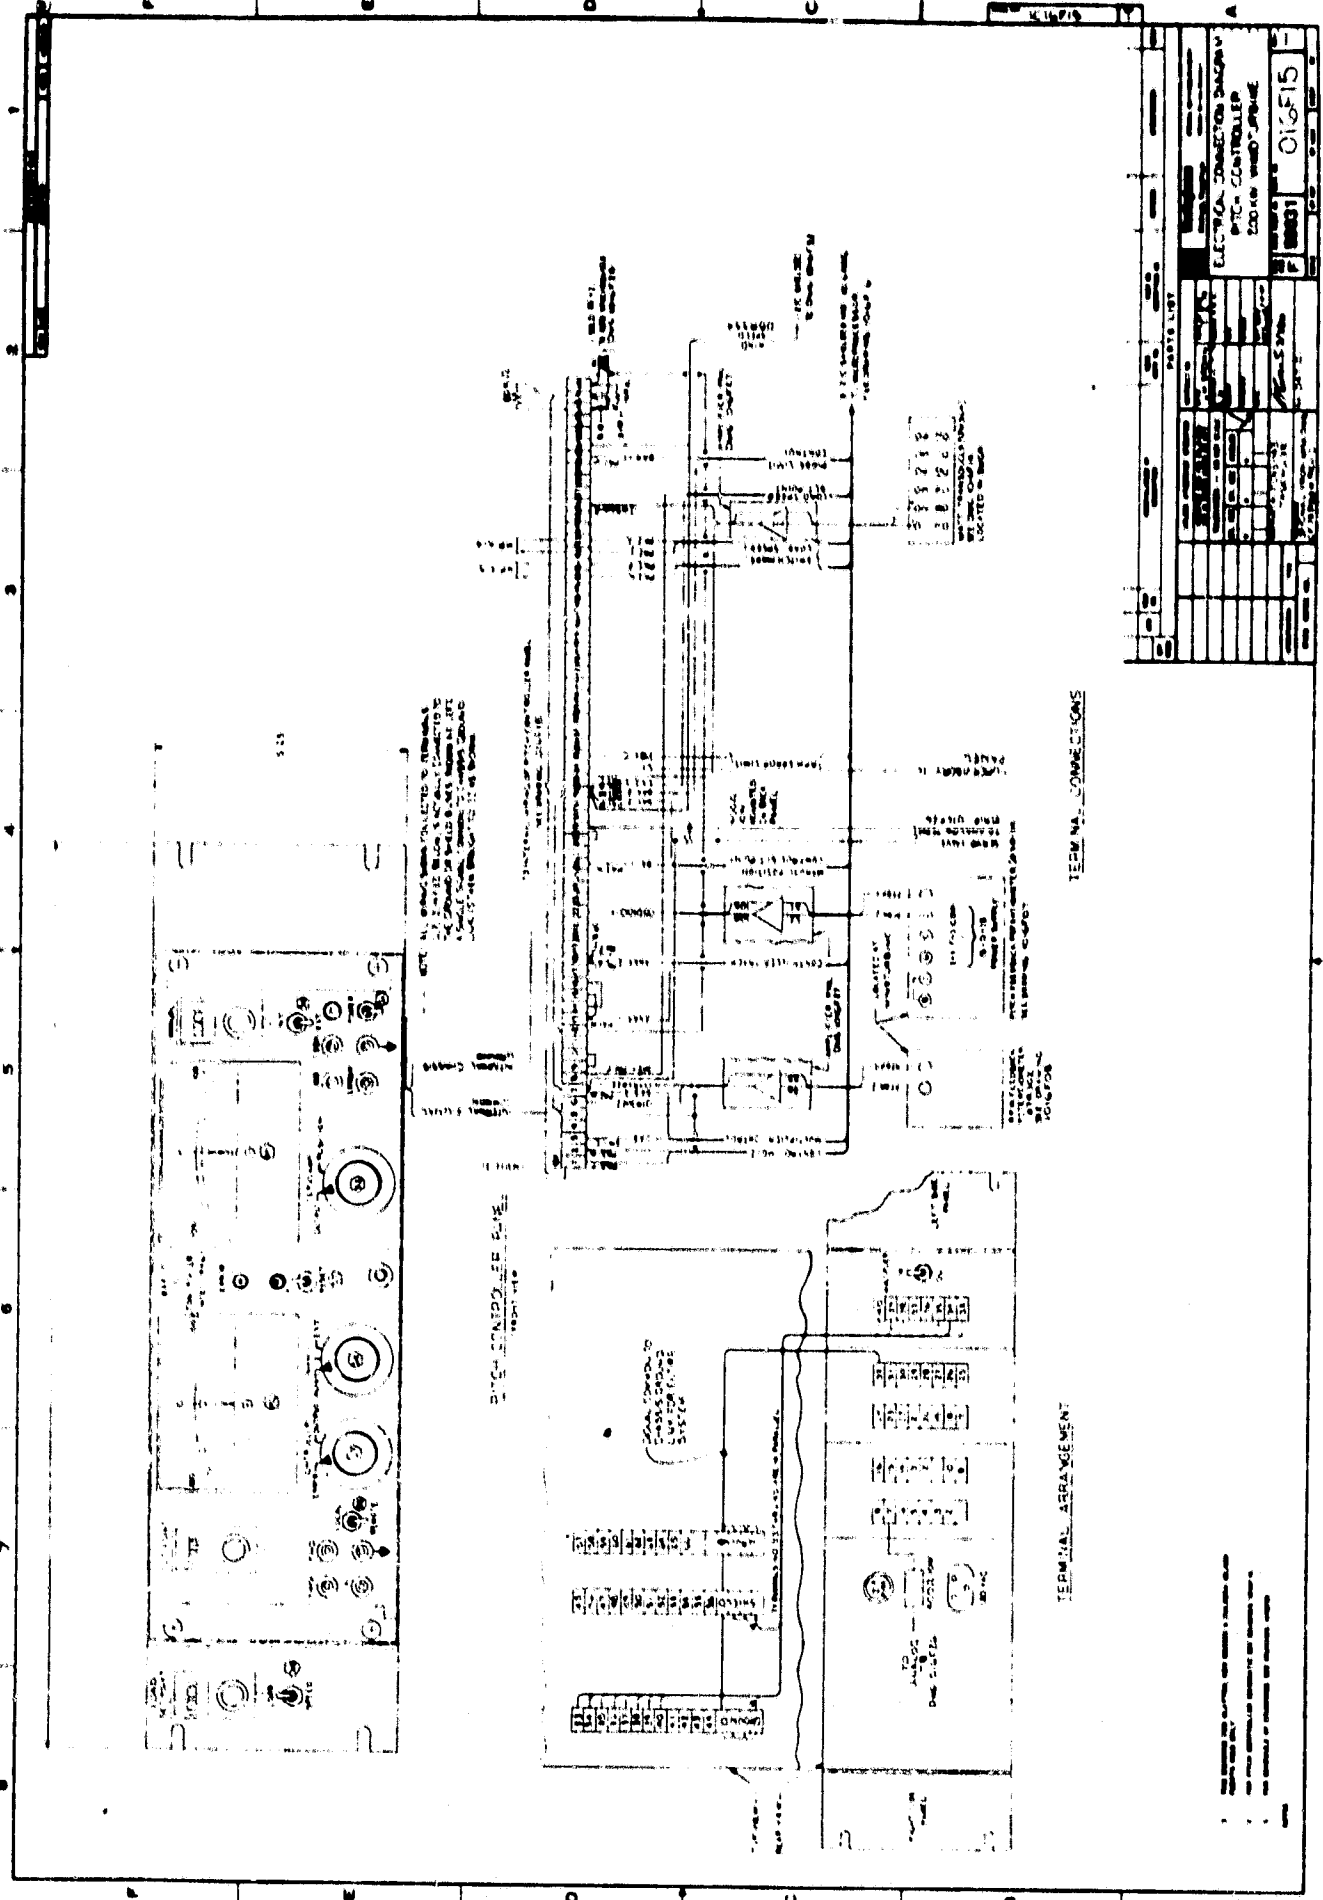


PARTS LIST	
TERM. NO. CONNECTIONS

TERMINAL ARRANGEMENT


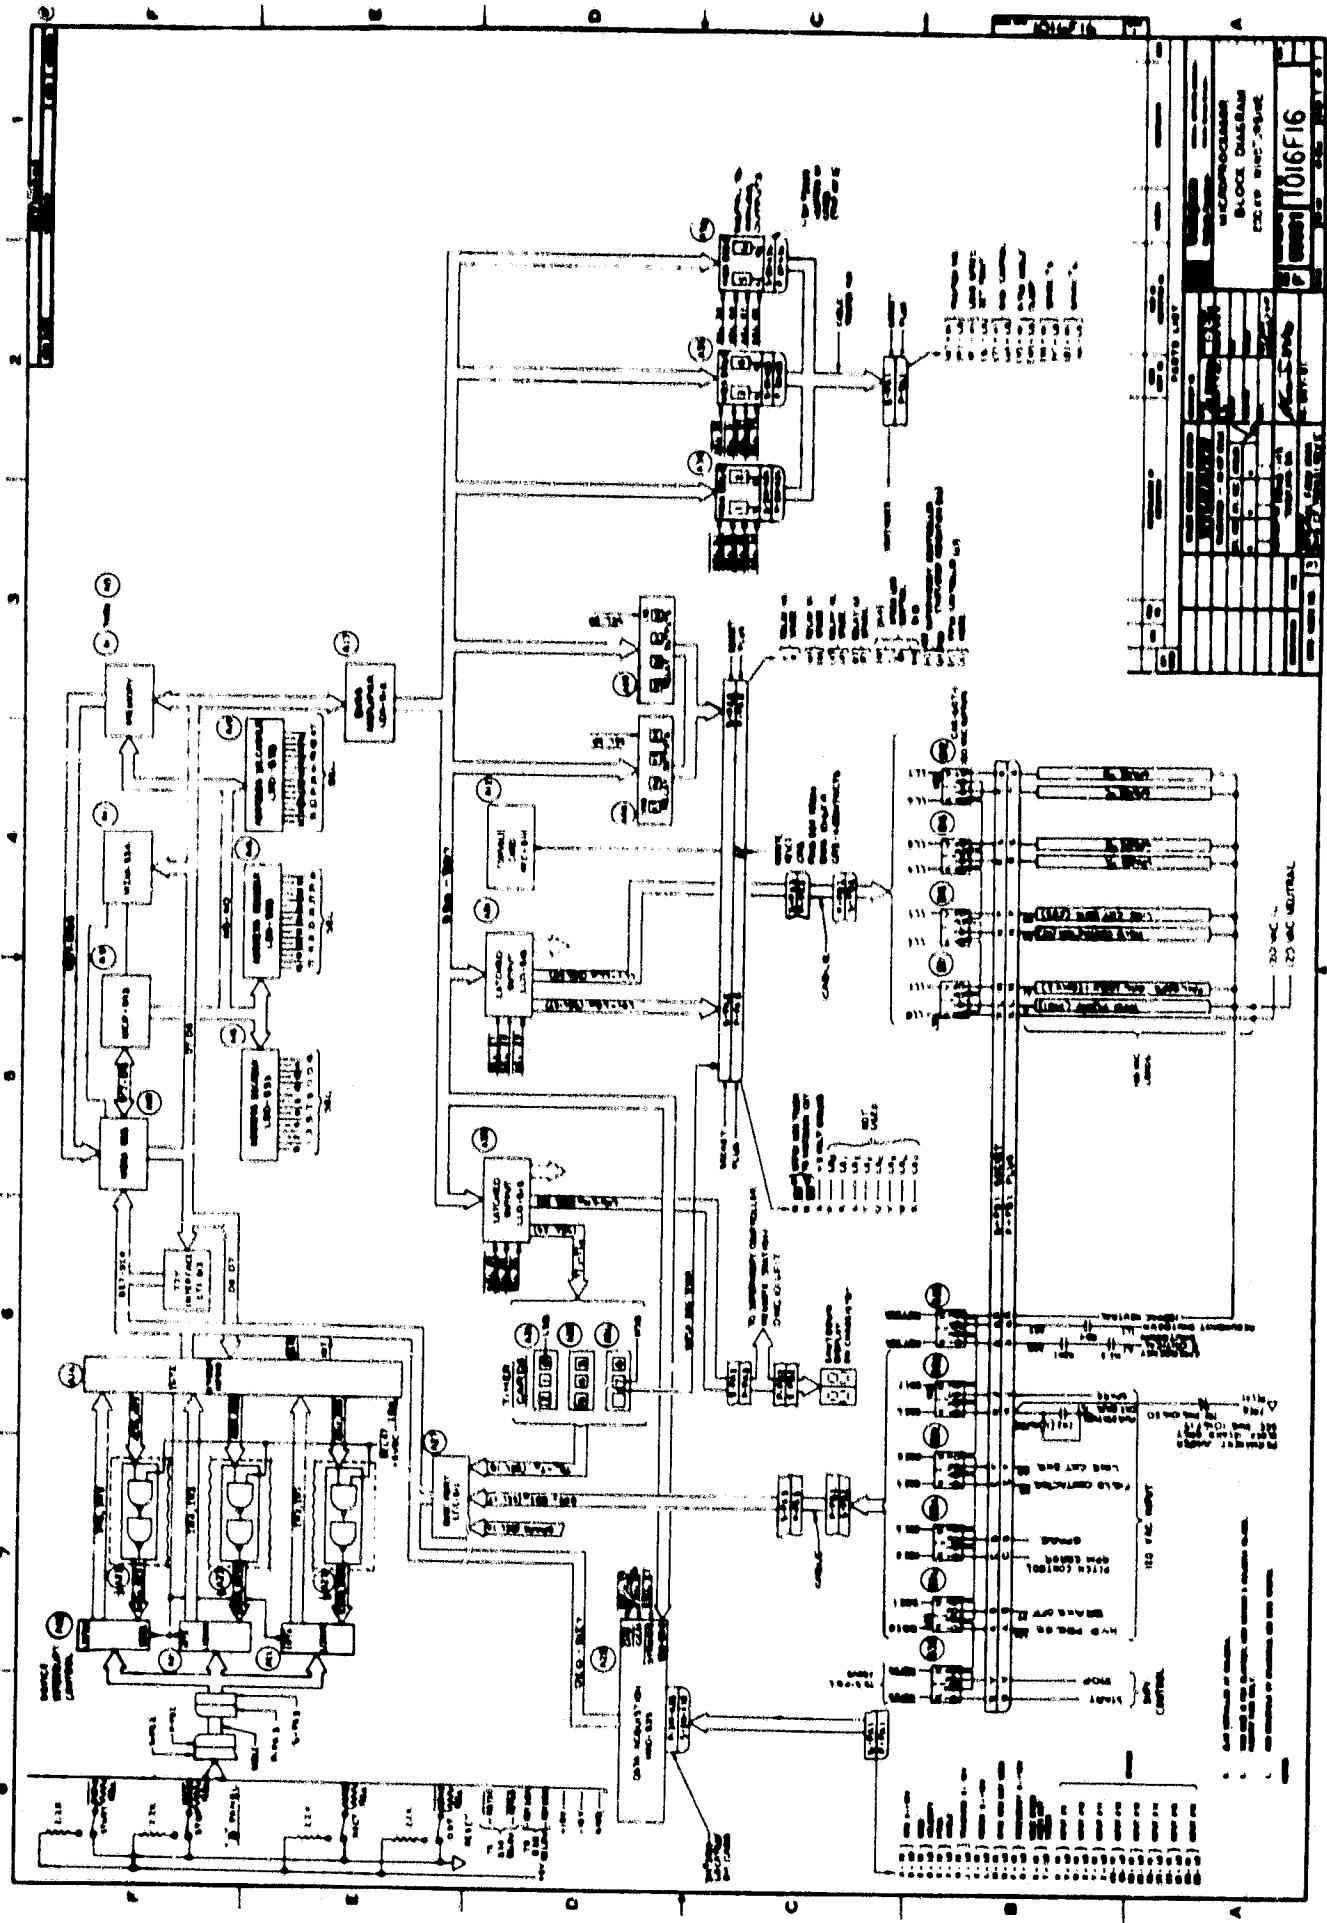

PARTS LIST	
1	MICROPROCESSOR
2	BLOCK DIAGRAM
3	IC 1016F16









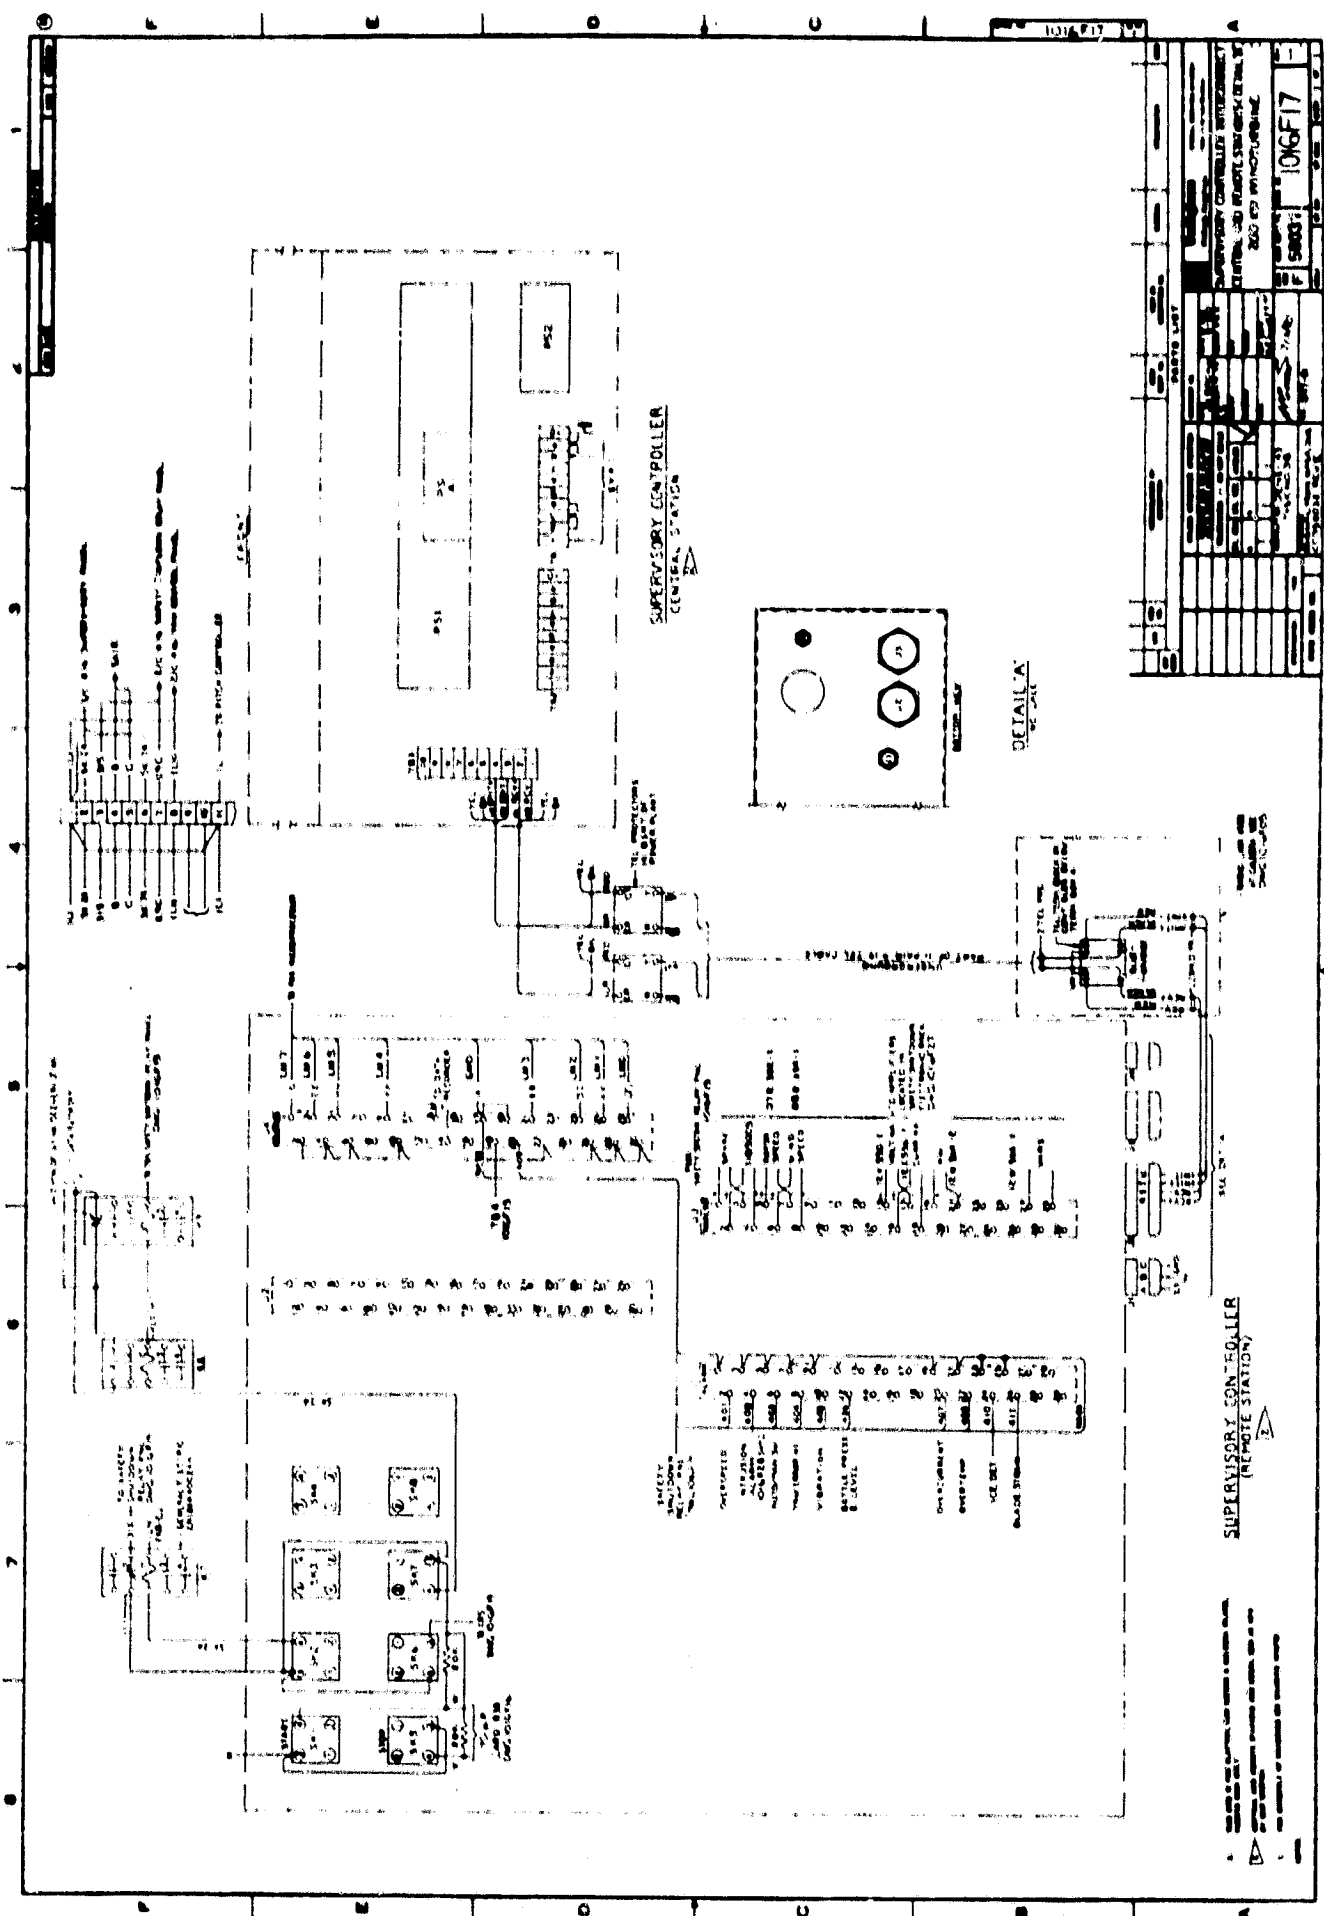


DETAIL A



ORIGINAL PAGE IS
OF POOR QUALITY

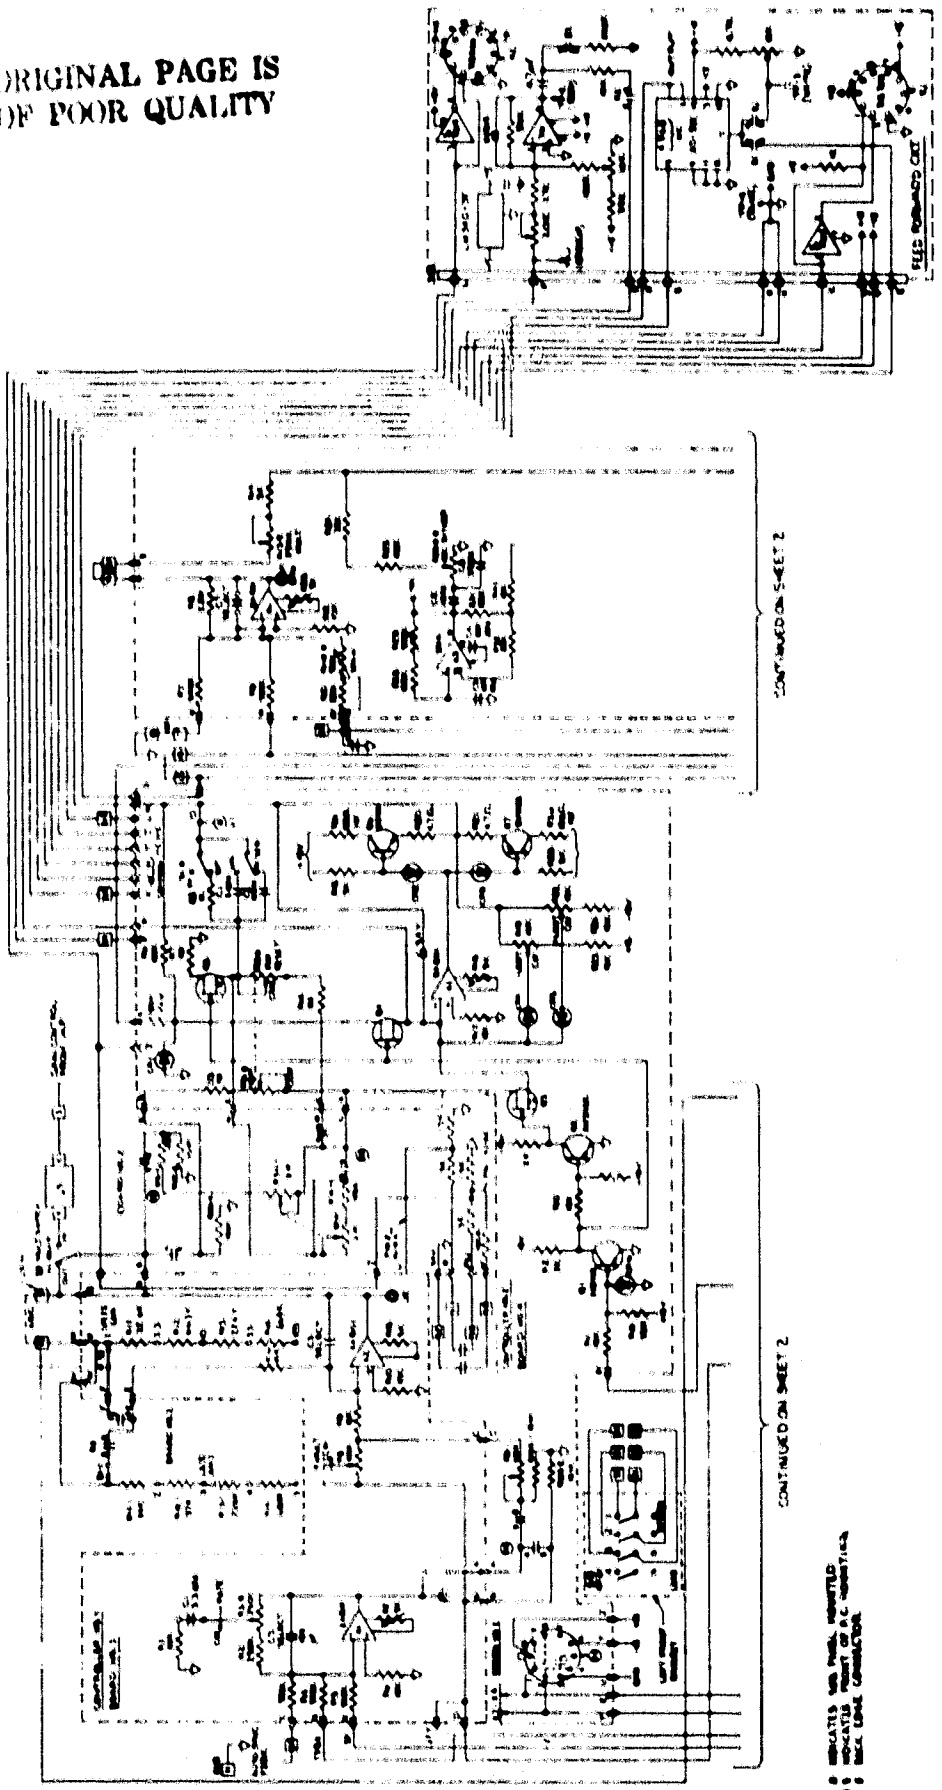



REV	DATE	BY	CHKD


REV	DATE
1	10/17/78


10/17/78

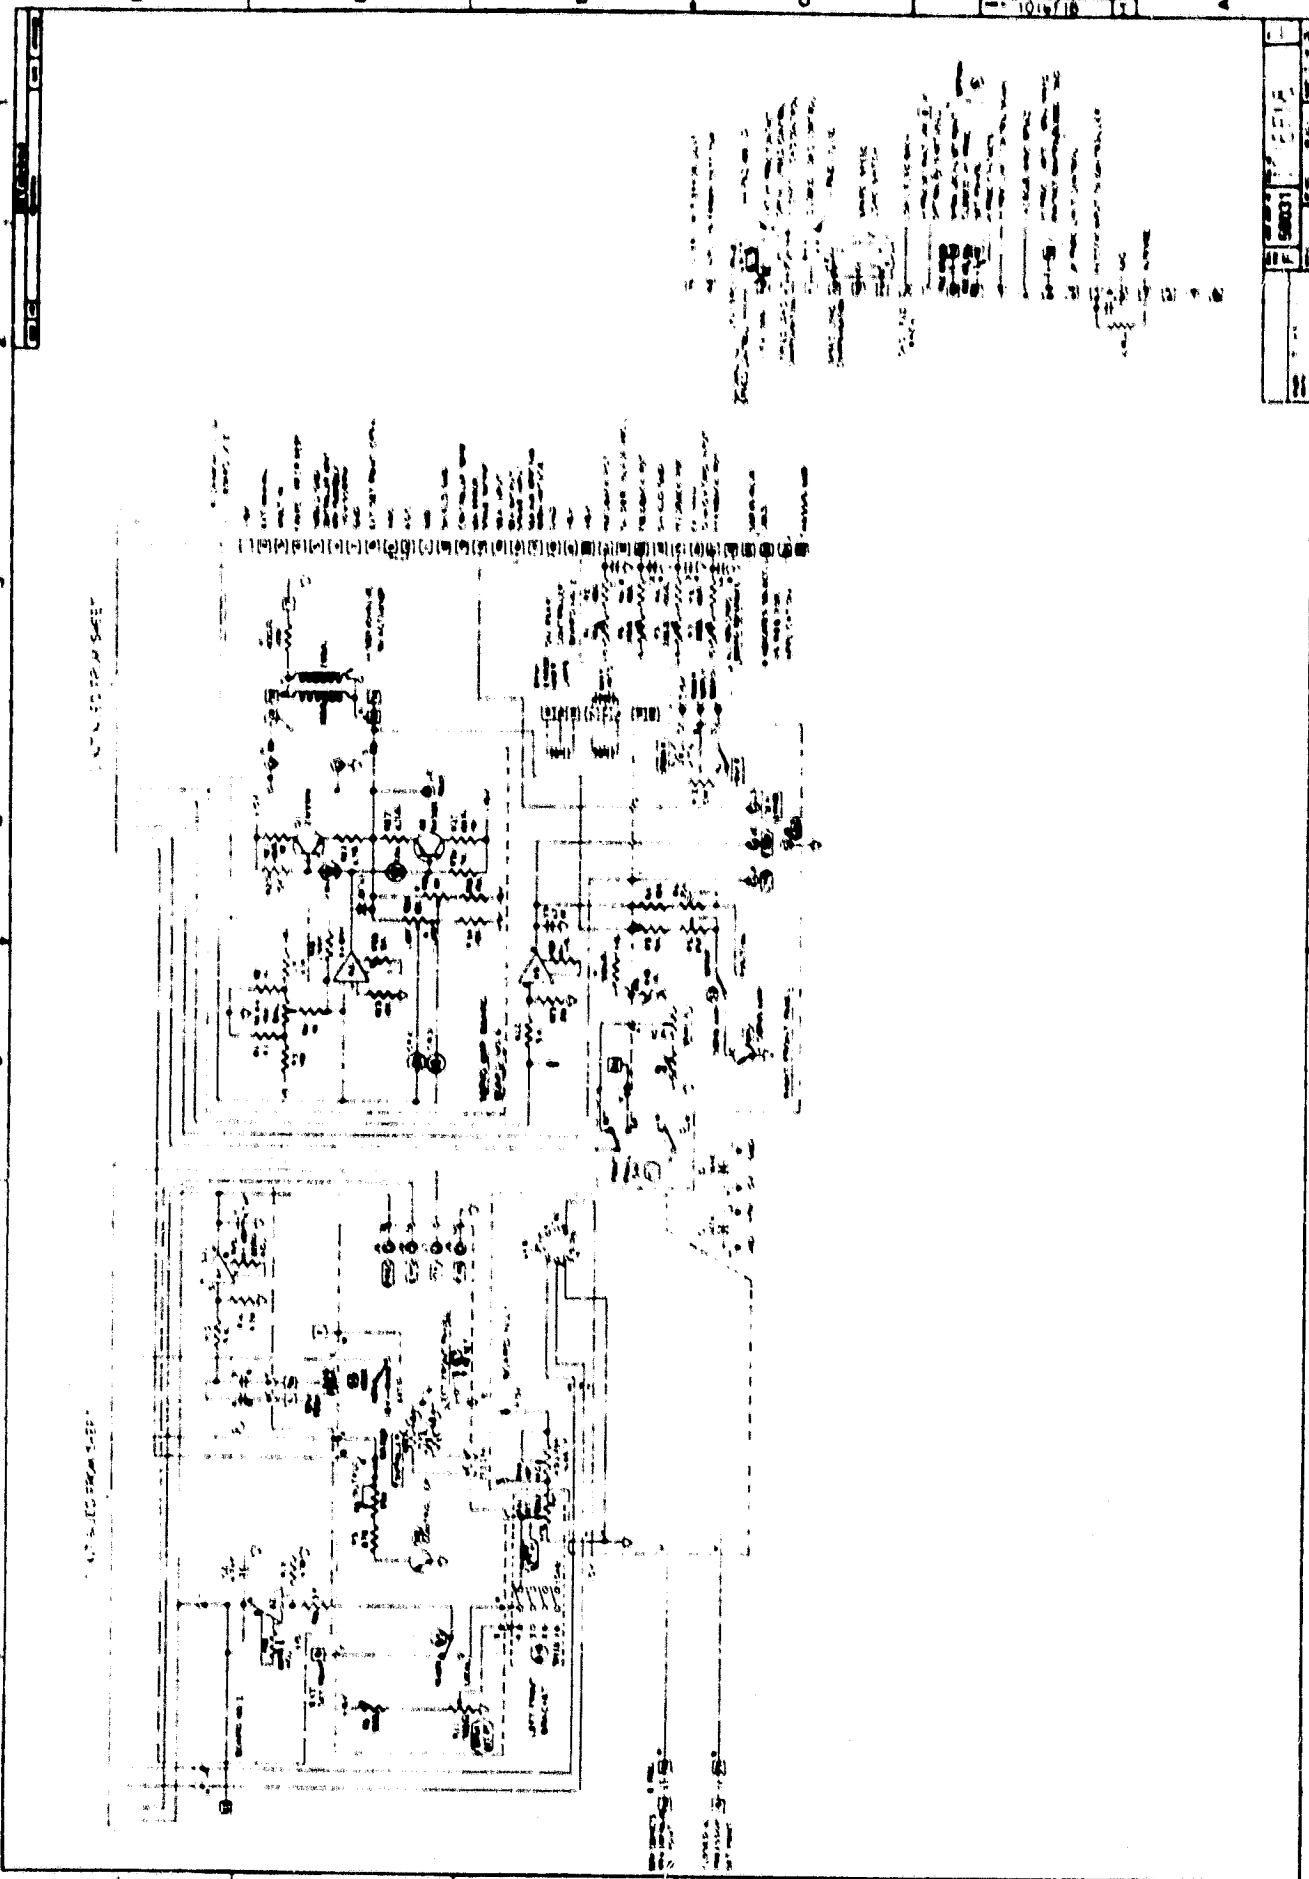

CONT. TO DRAW SHEET

CONT. TO DRAW SHEET


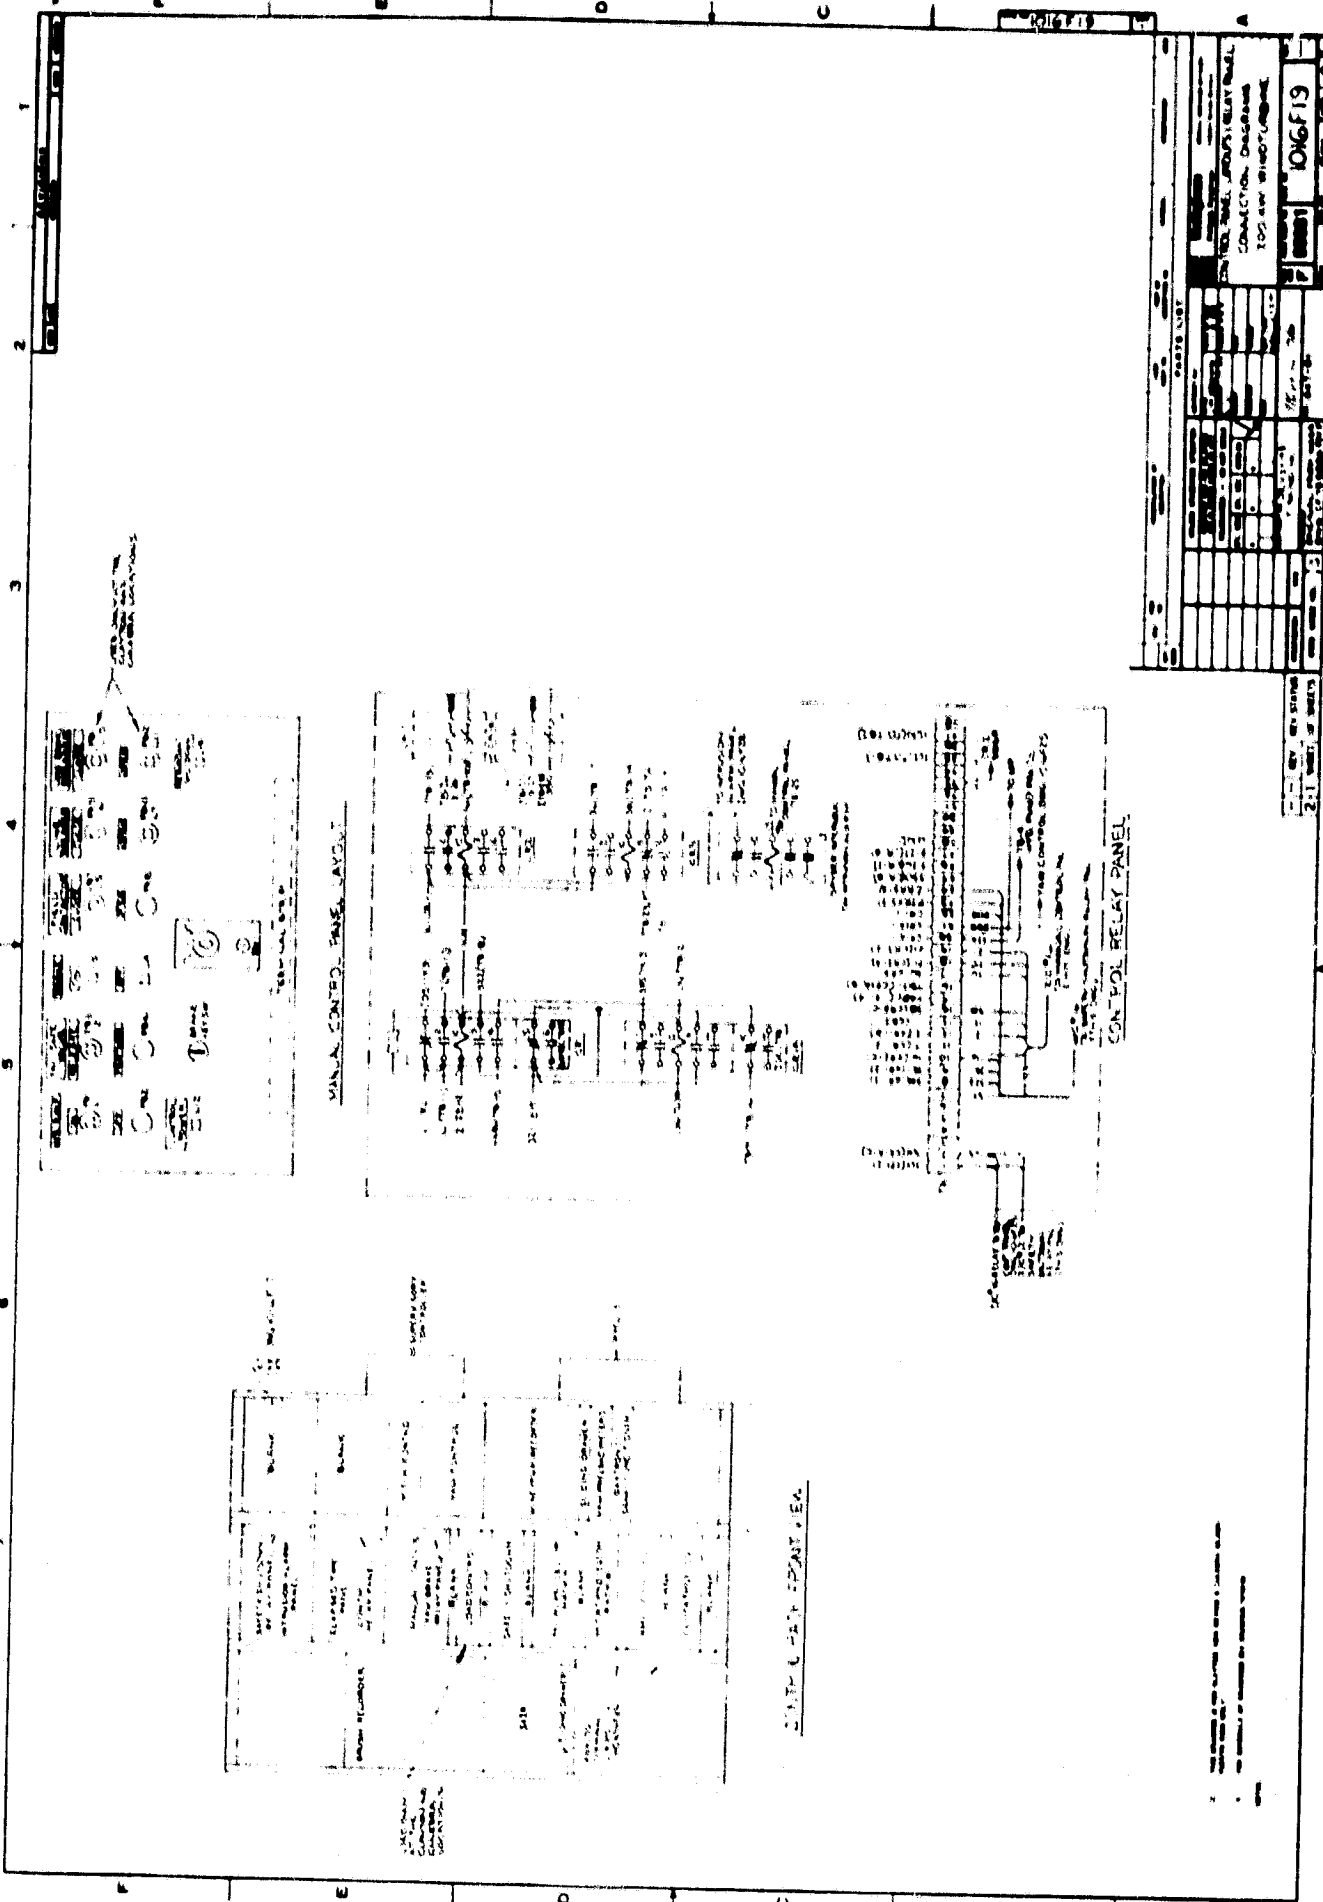


01619

NO.	DESCRIPTION	REV.	DATE

NO. OF SHEETS 31
NO. OF SHEETS 31


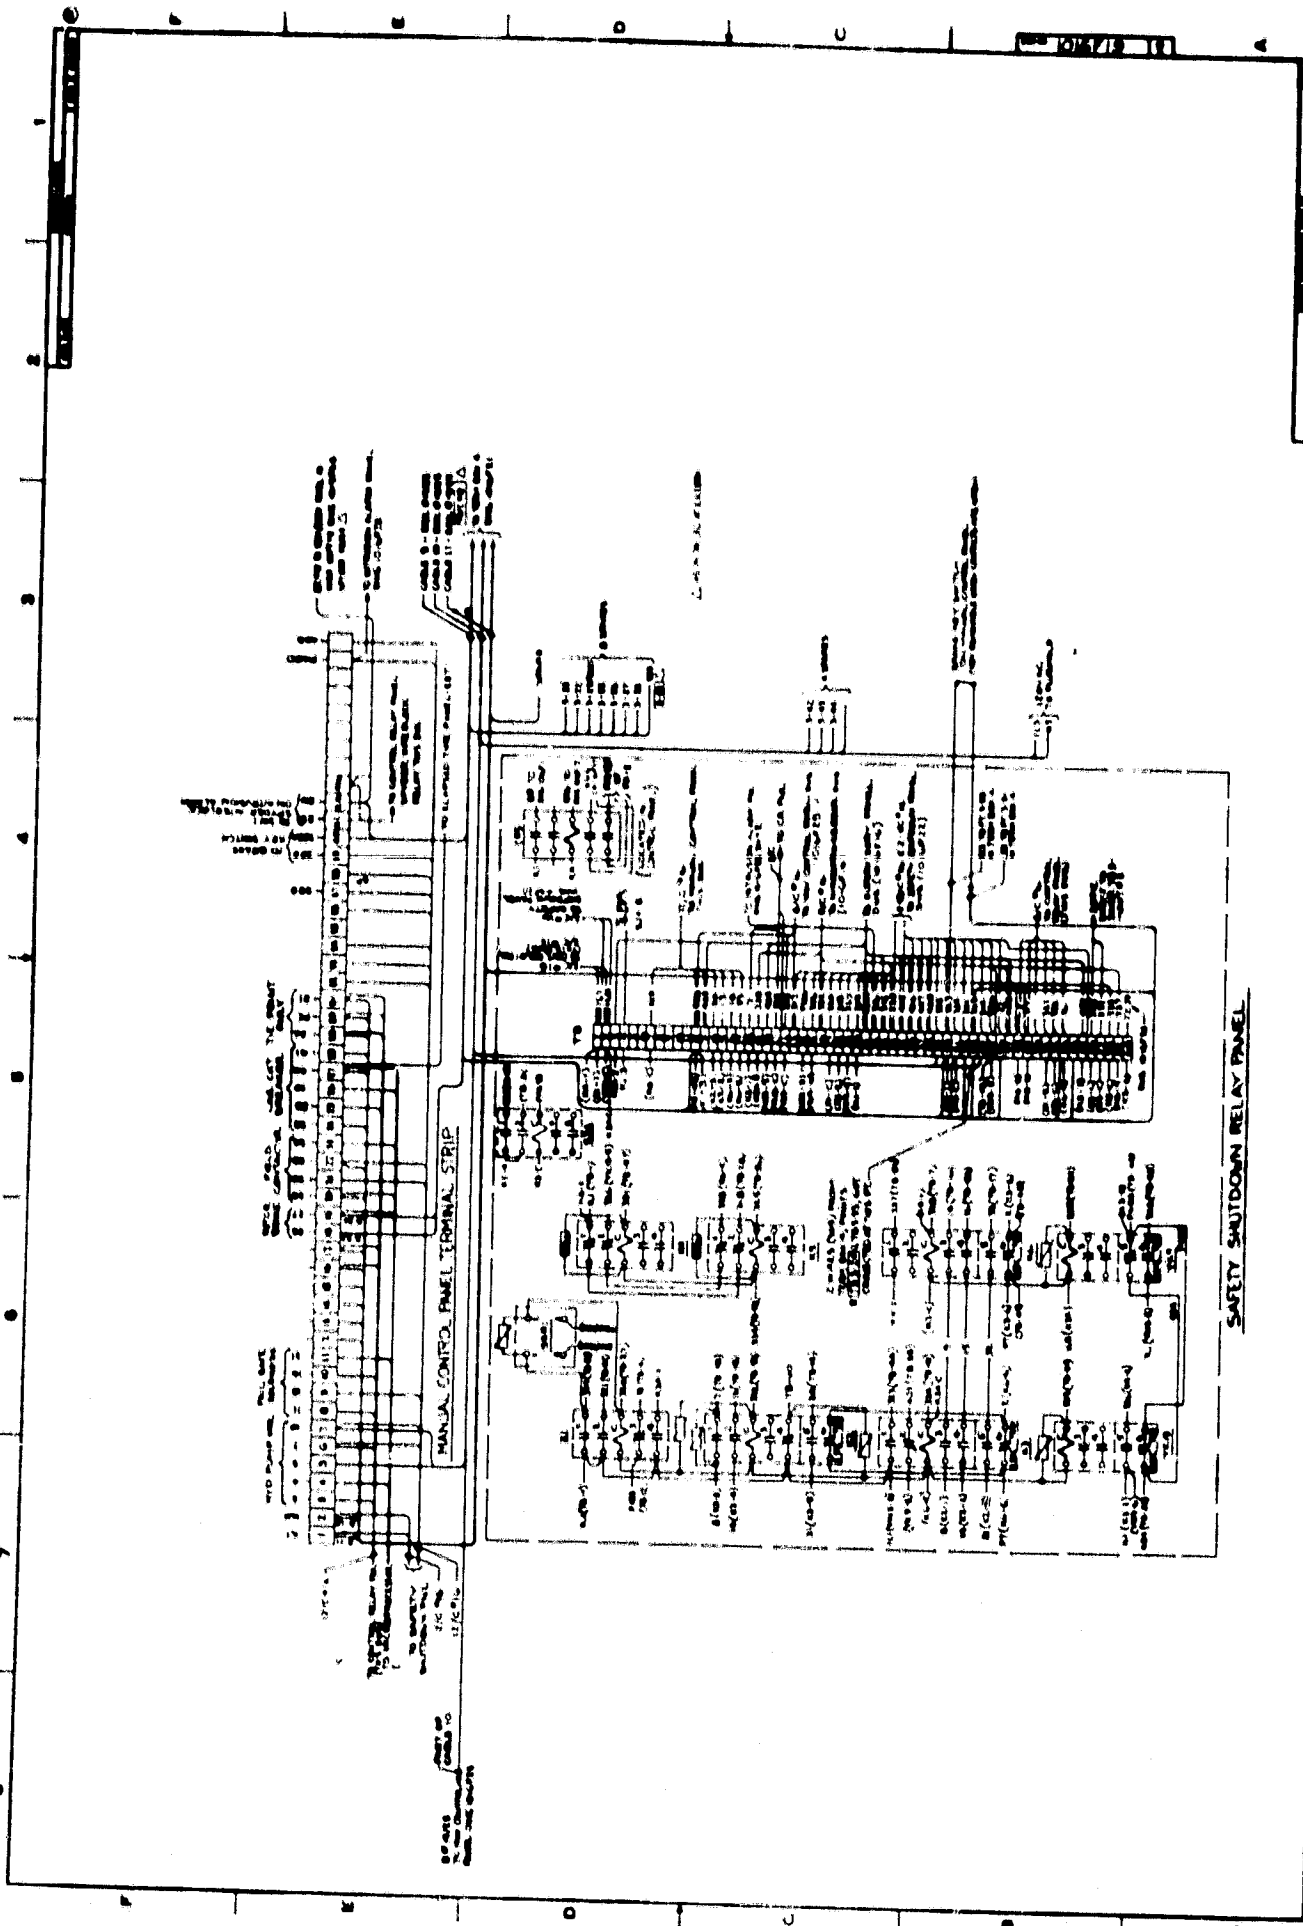

SAFETY SHUTDOWN RELAY PANEL

216




218

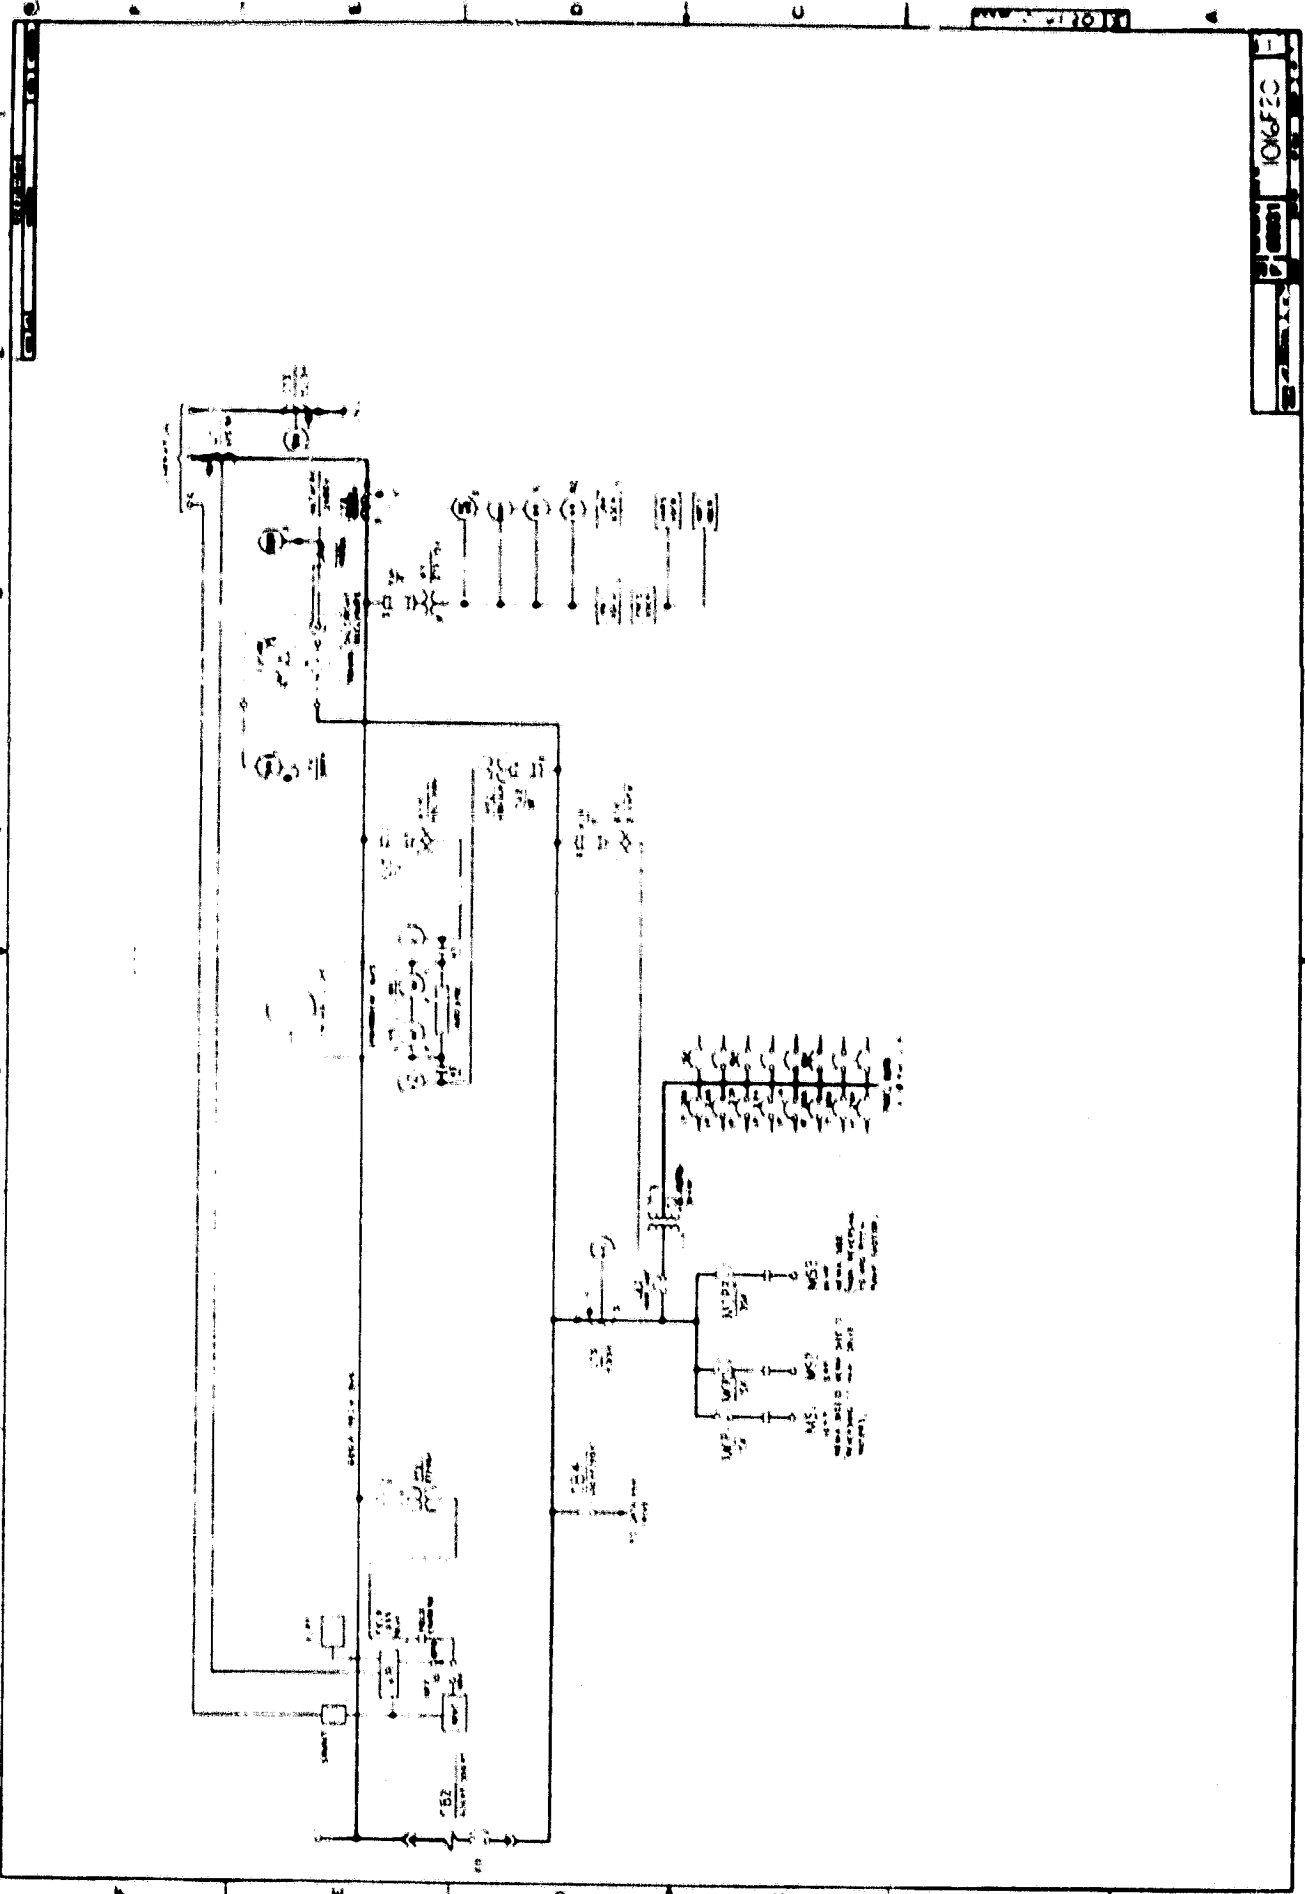


106520

106

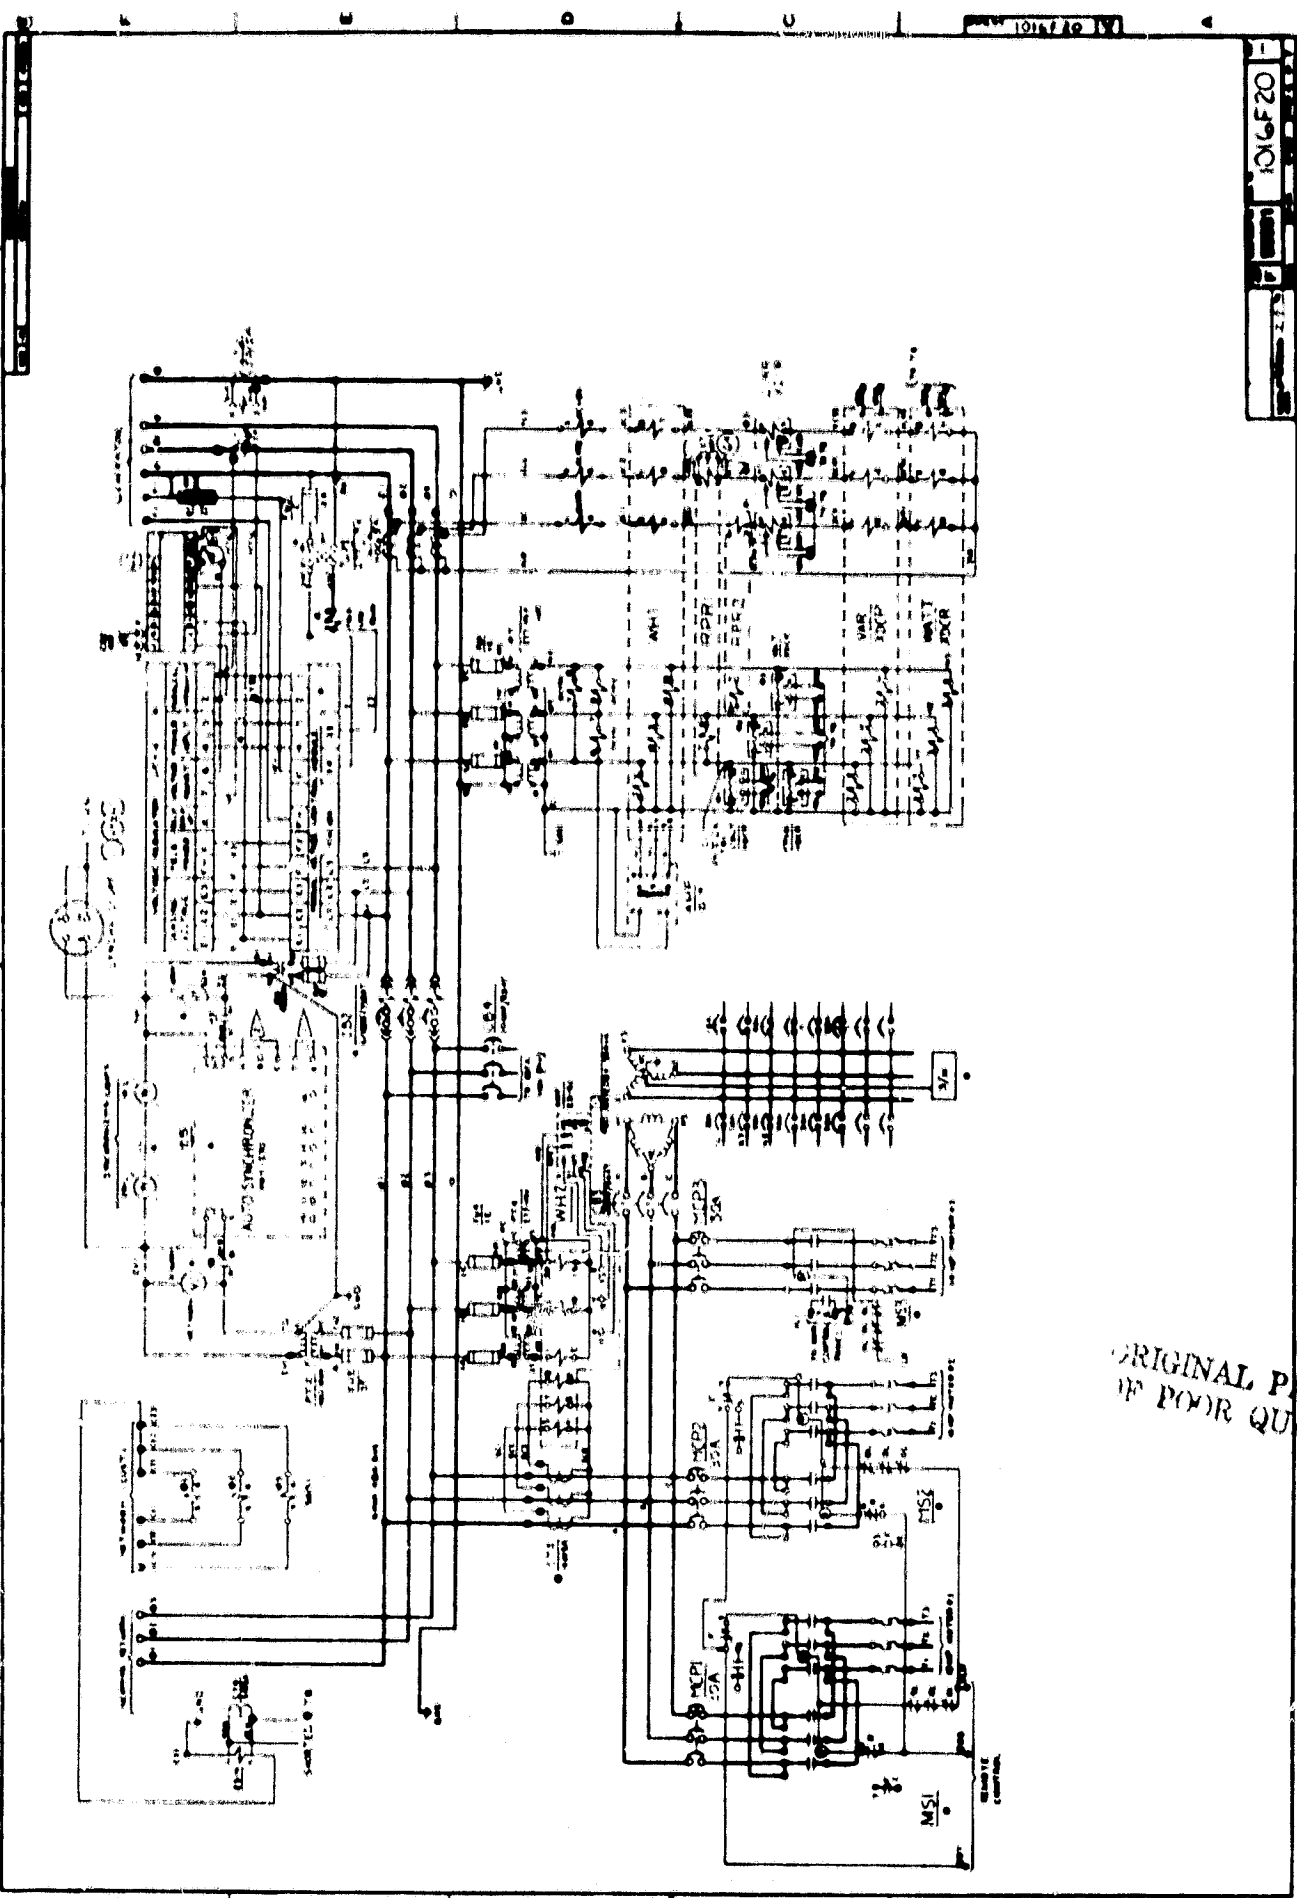

ORIGINAL PAGE IS
OF POOR QUALITY


340

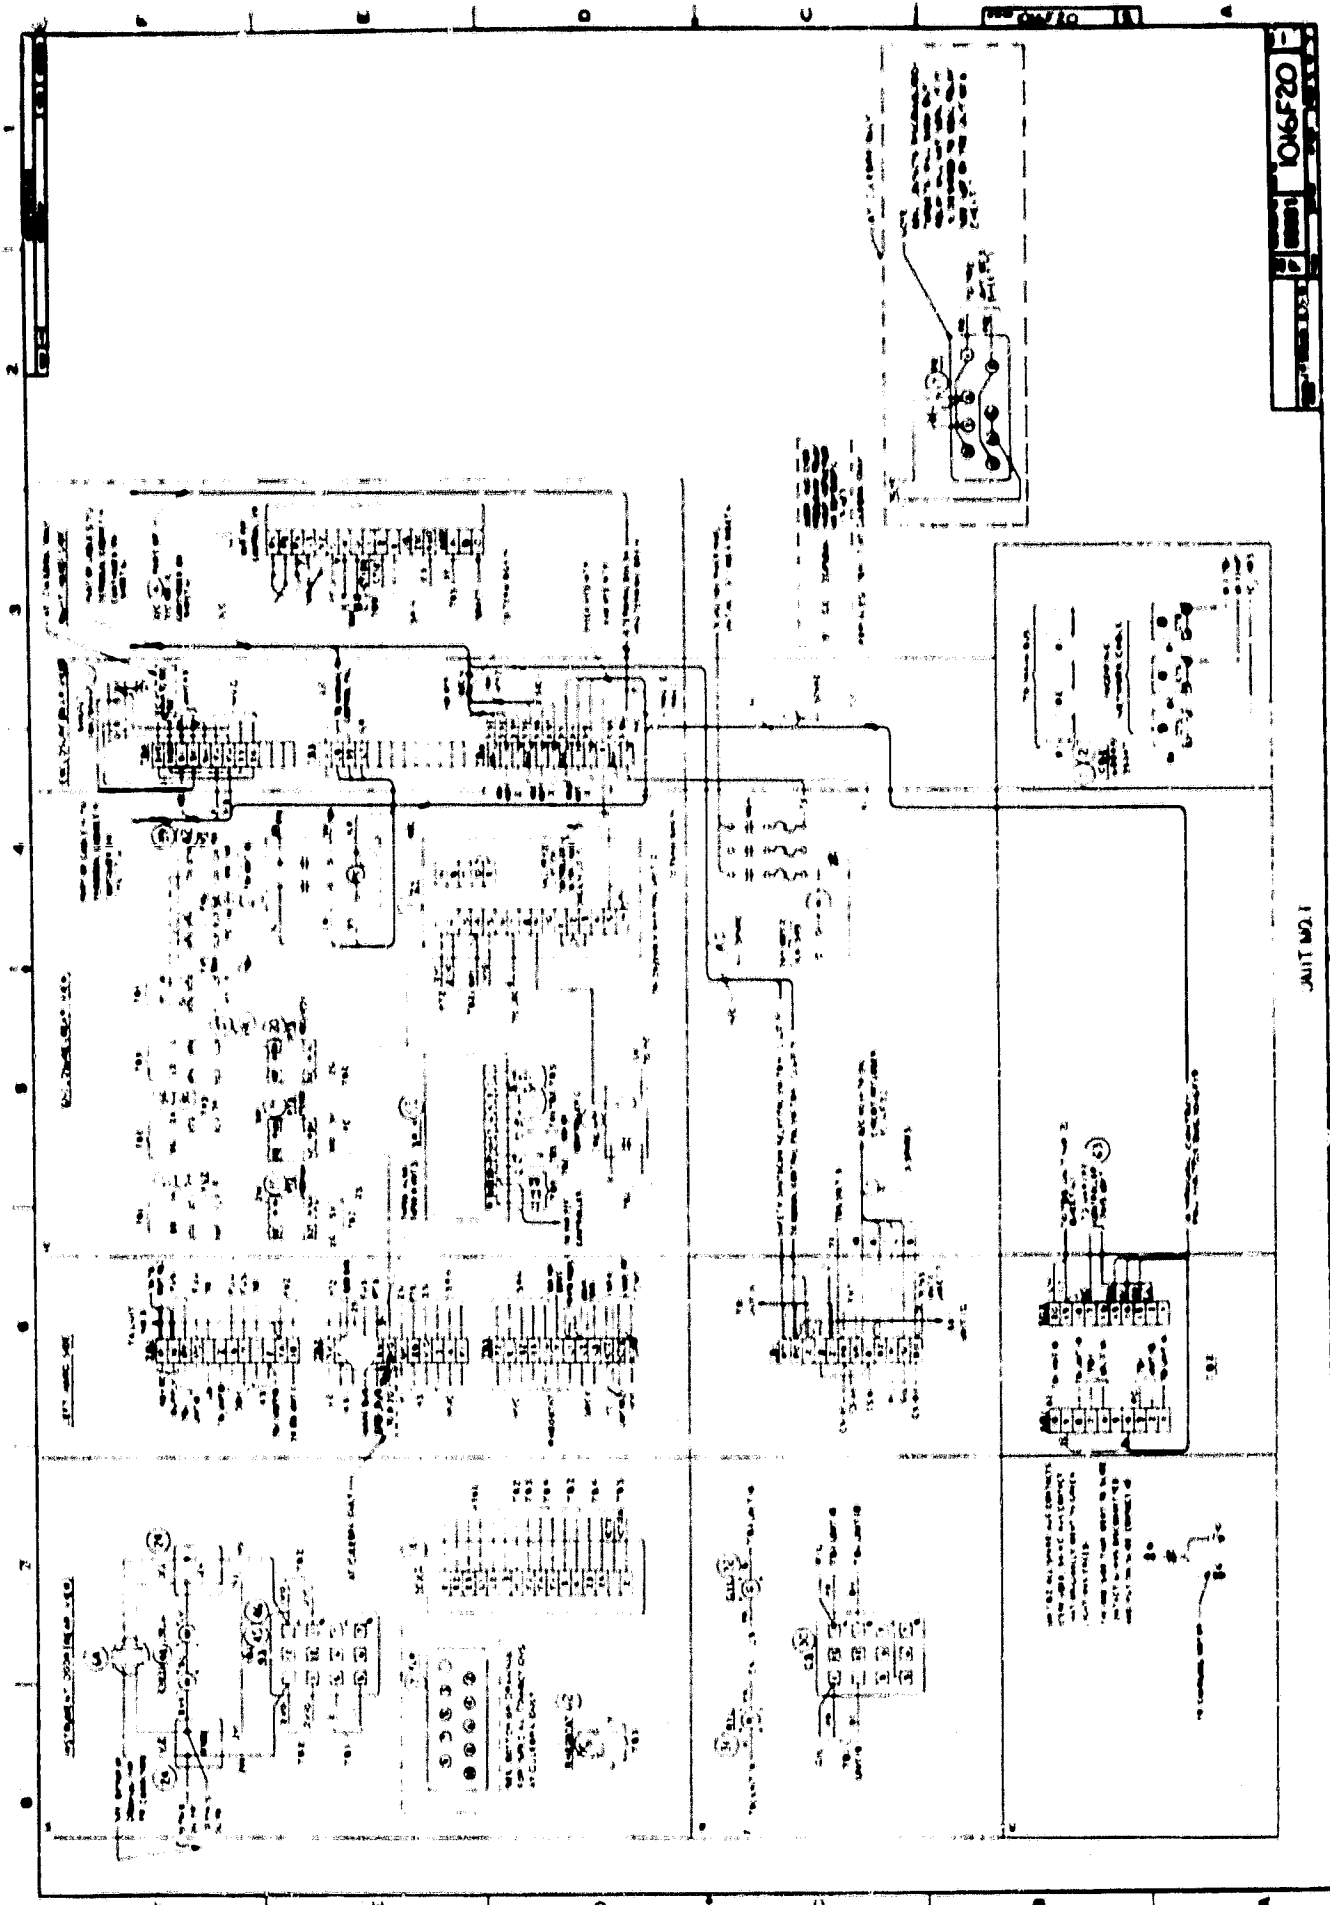

106F20


JUNIT NO. 1

221

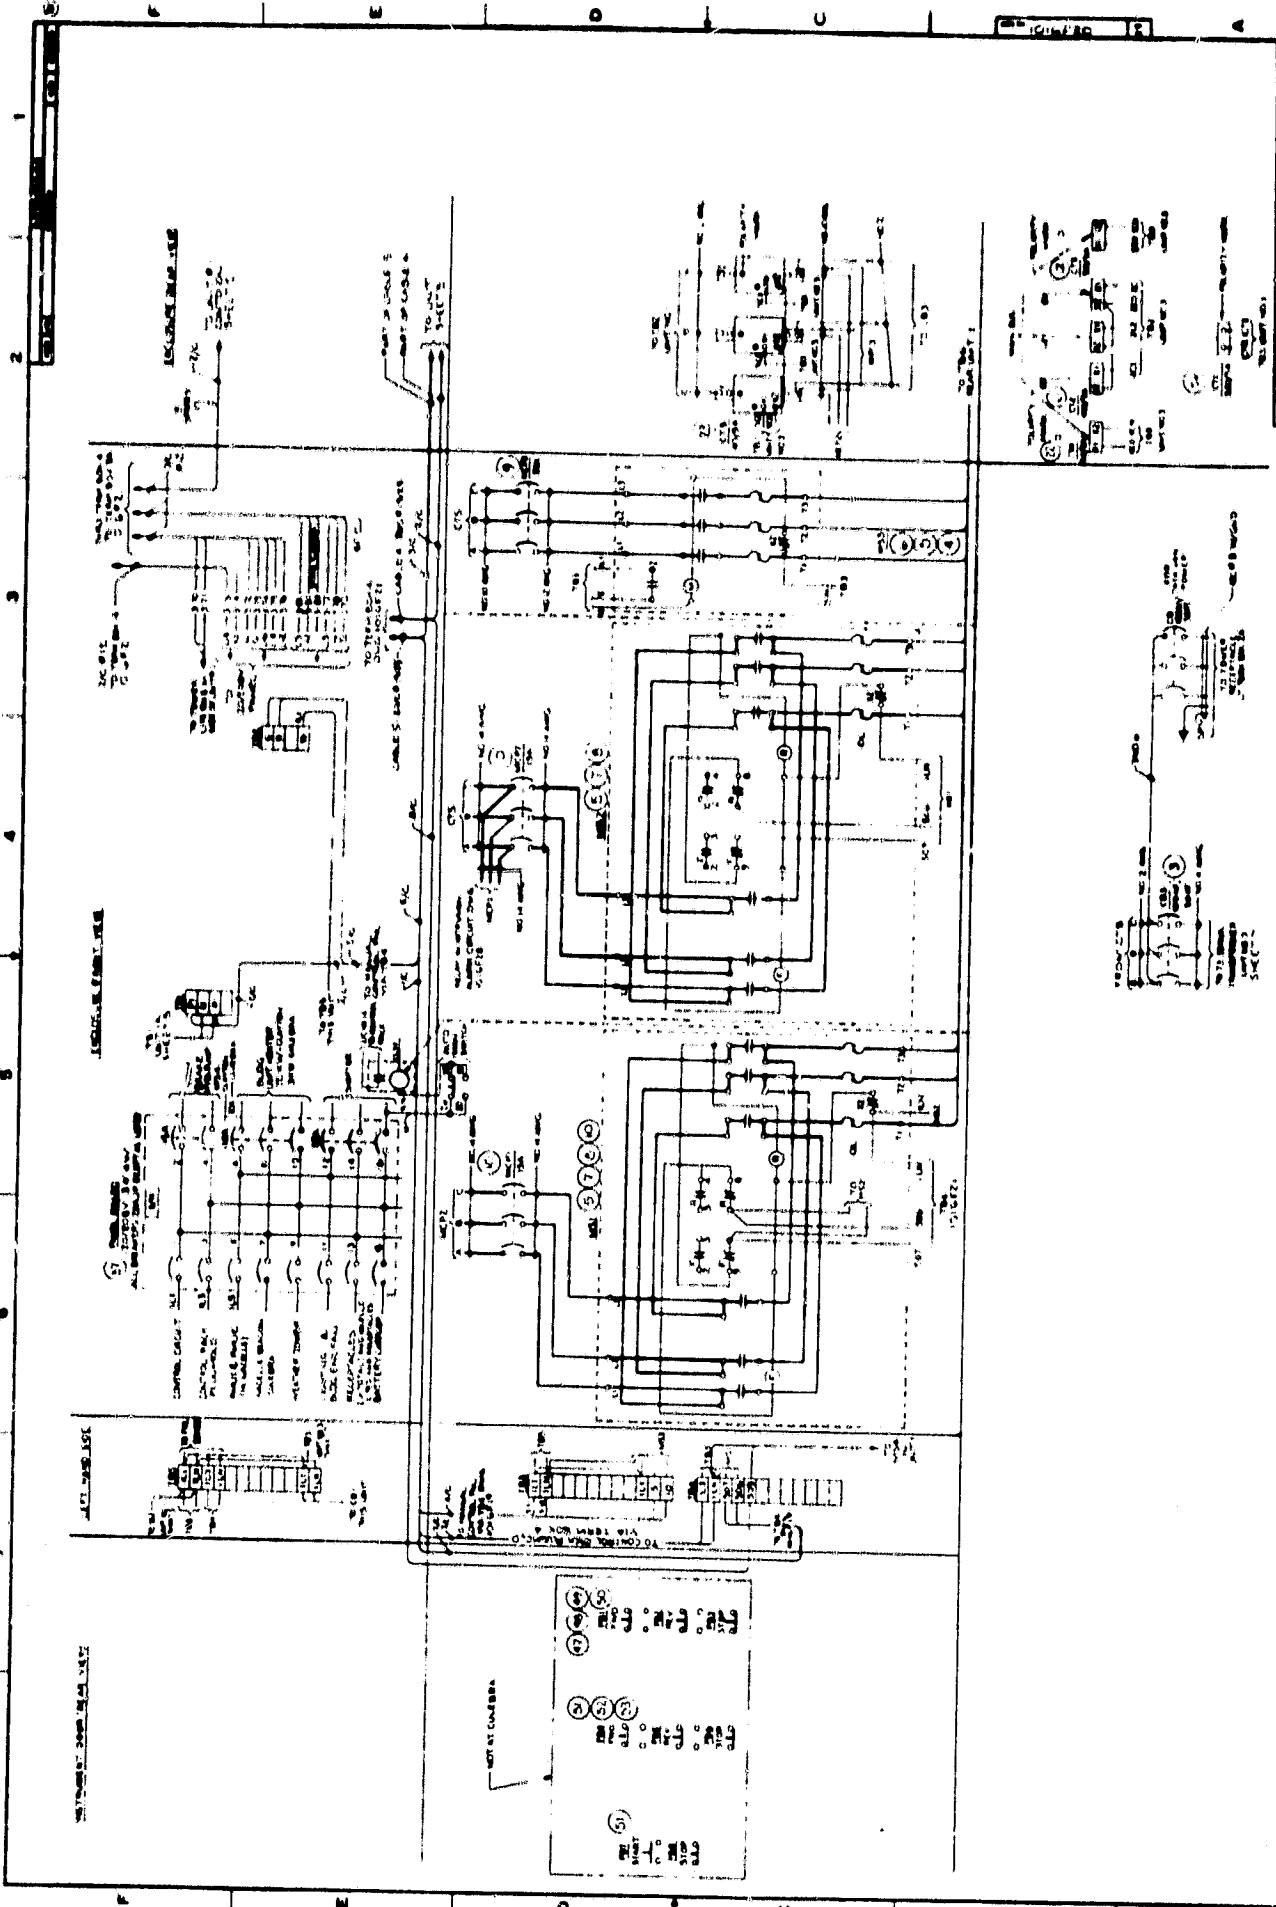


UNIT NO. 2
 106F20

UNIT NO. 2

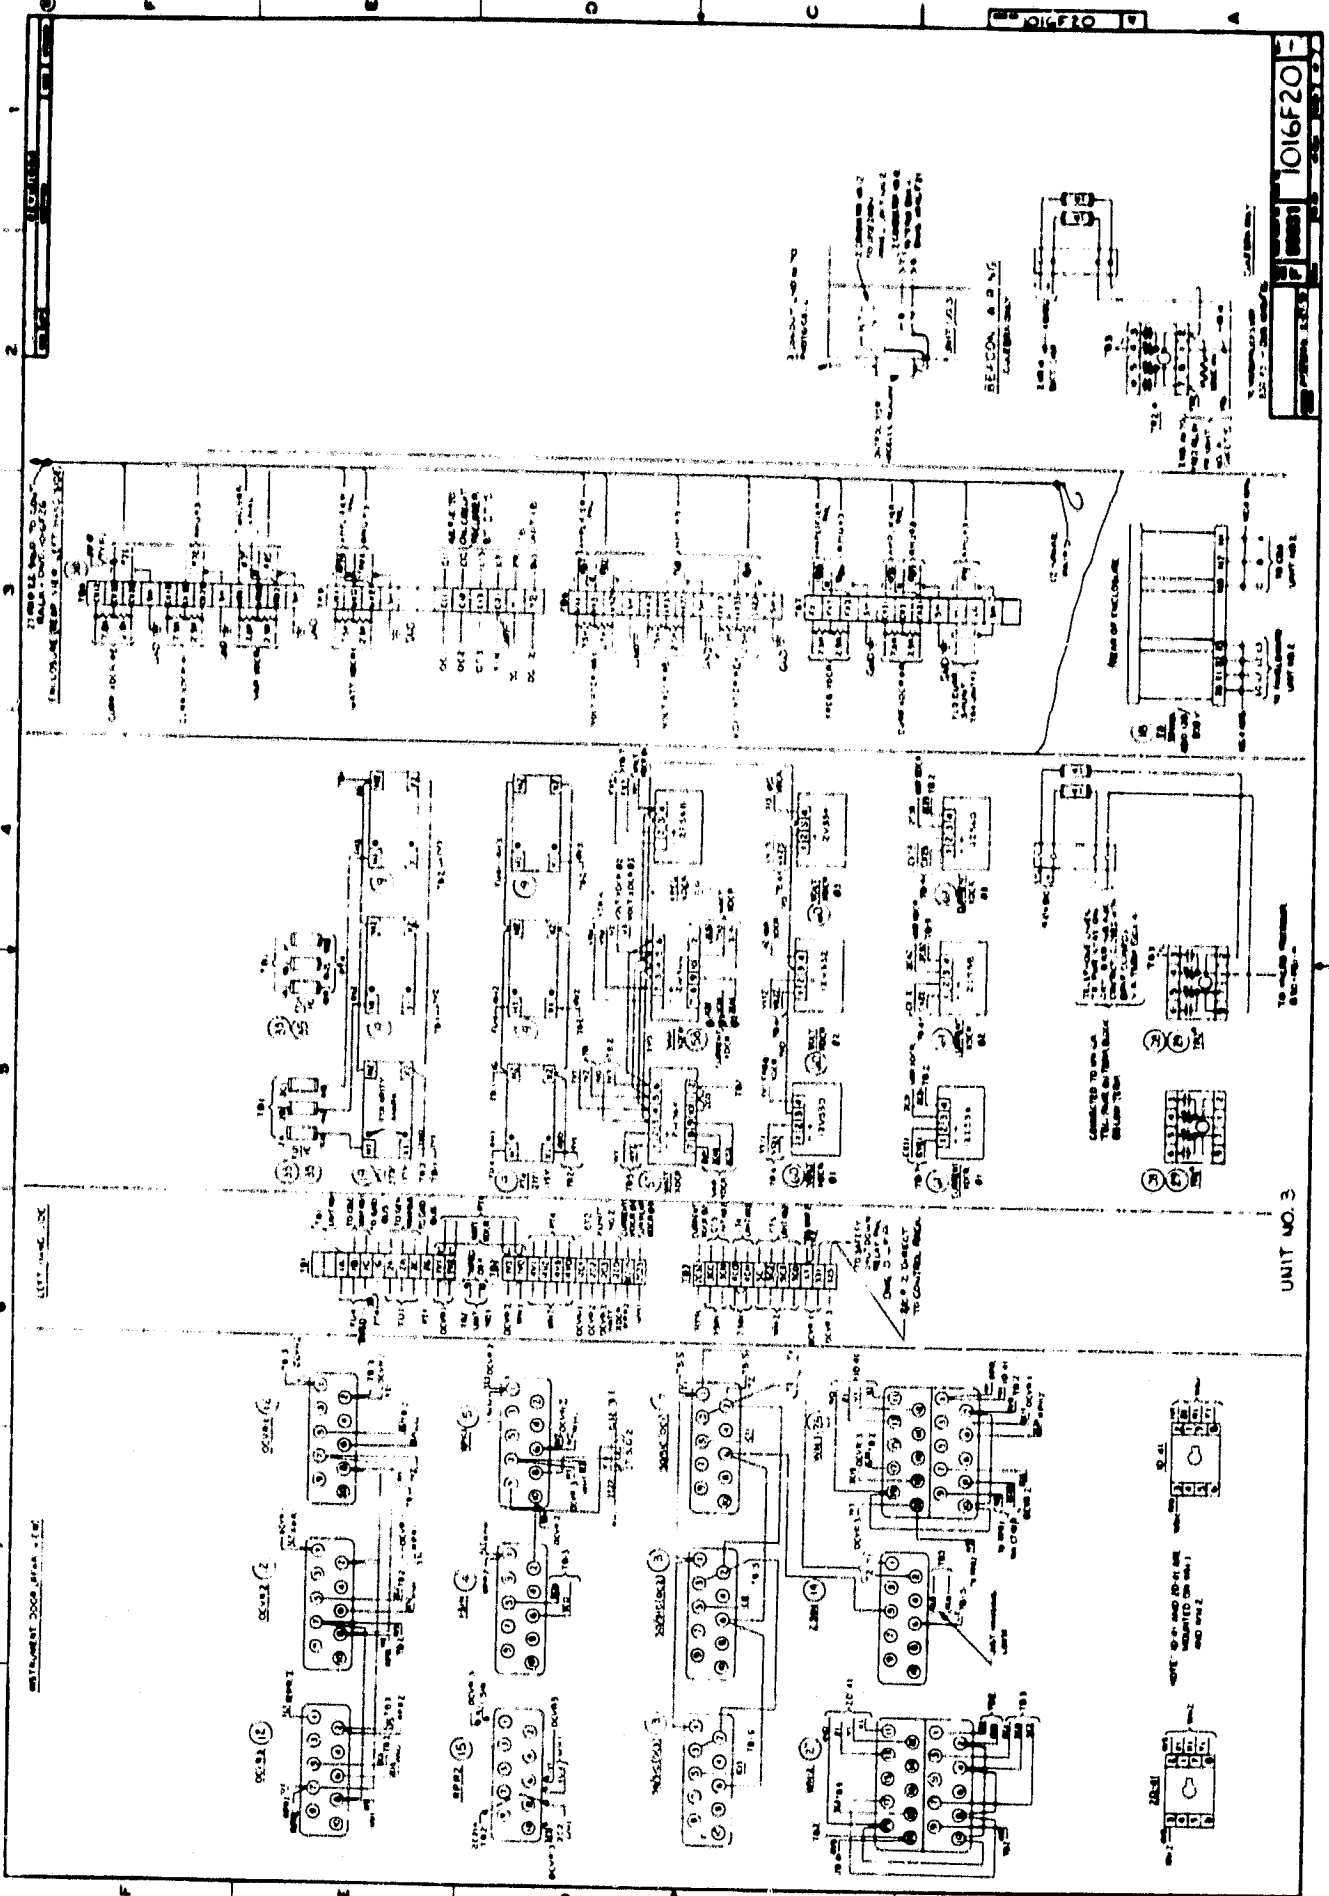

UNIT NO. 3

1016F20

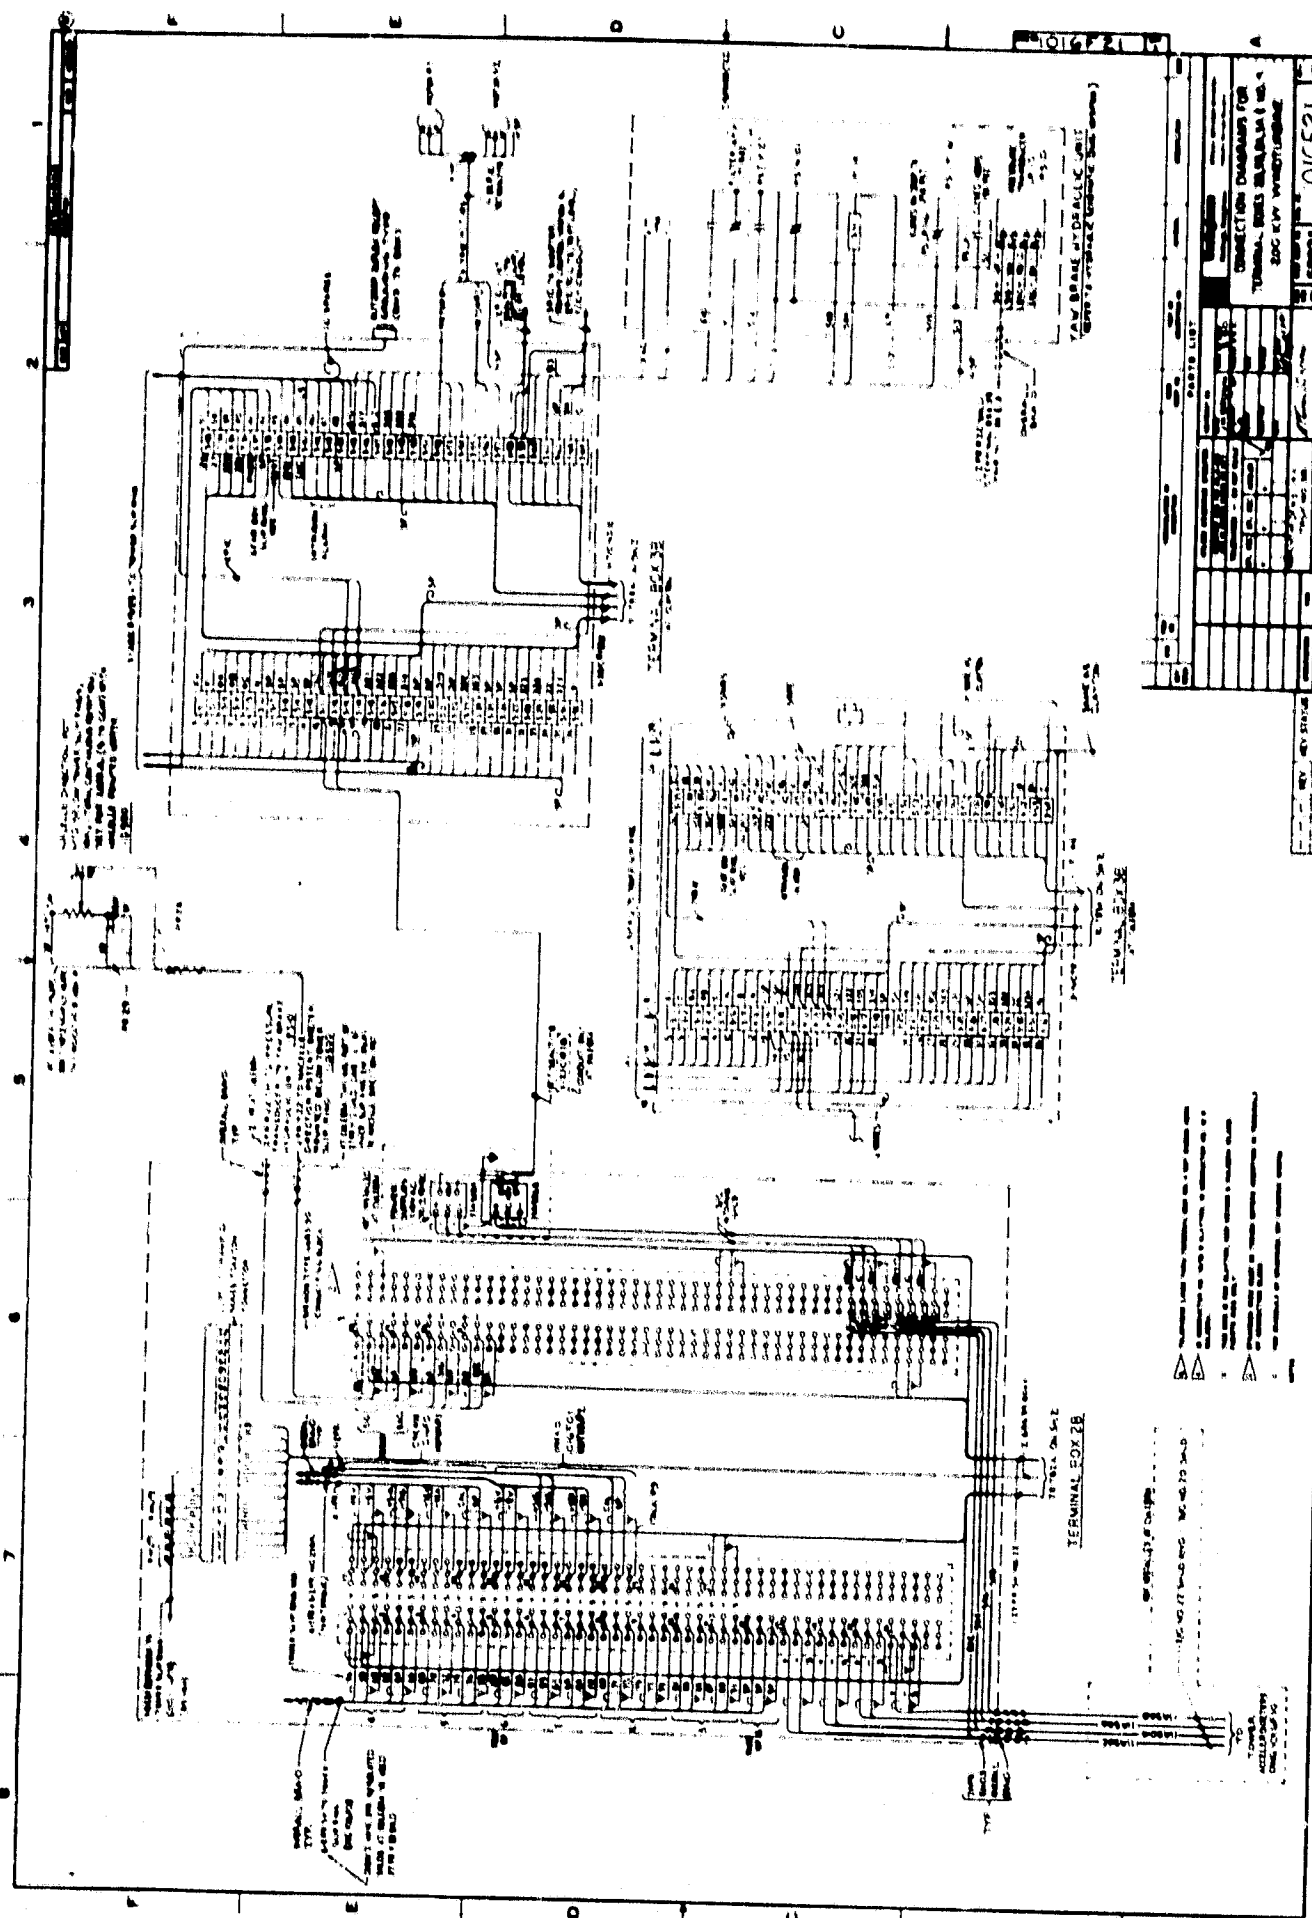


PARTS LIST		



1016F21

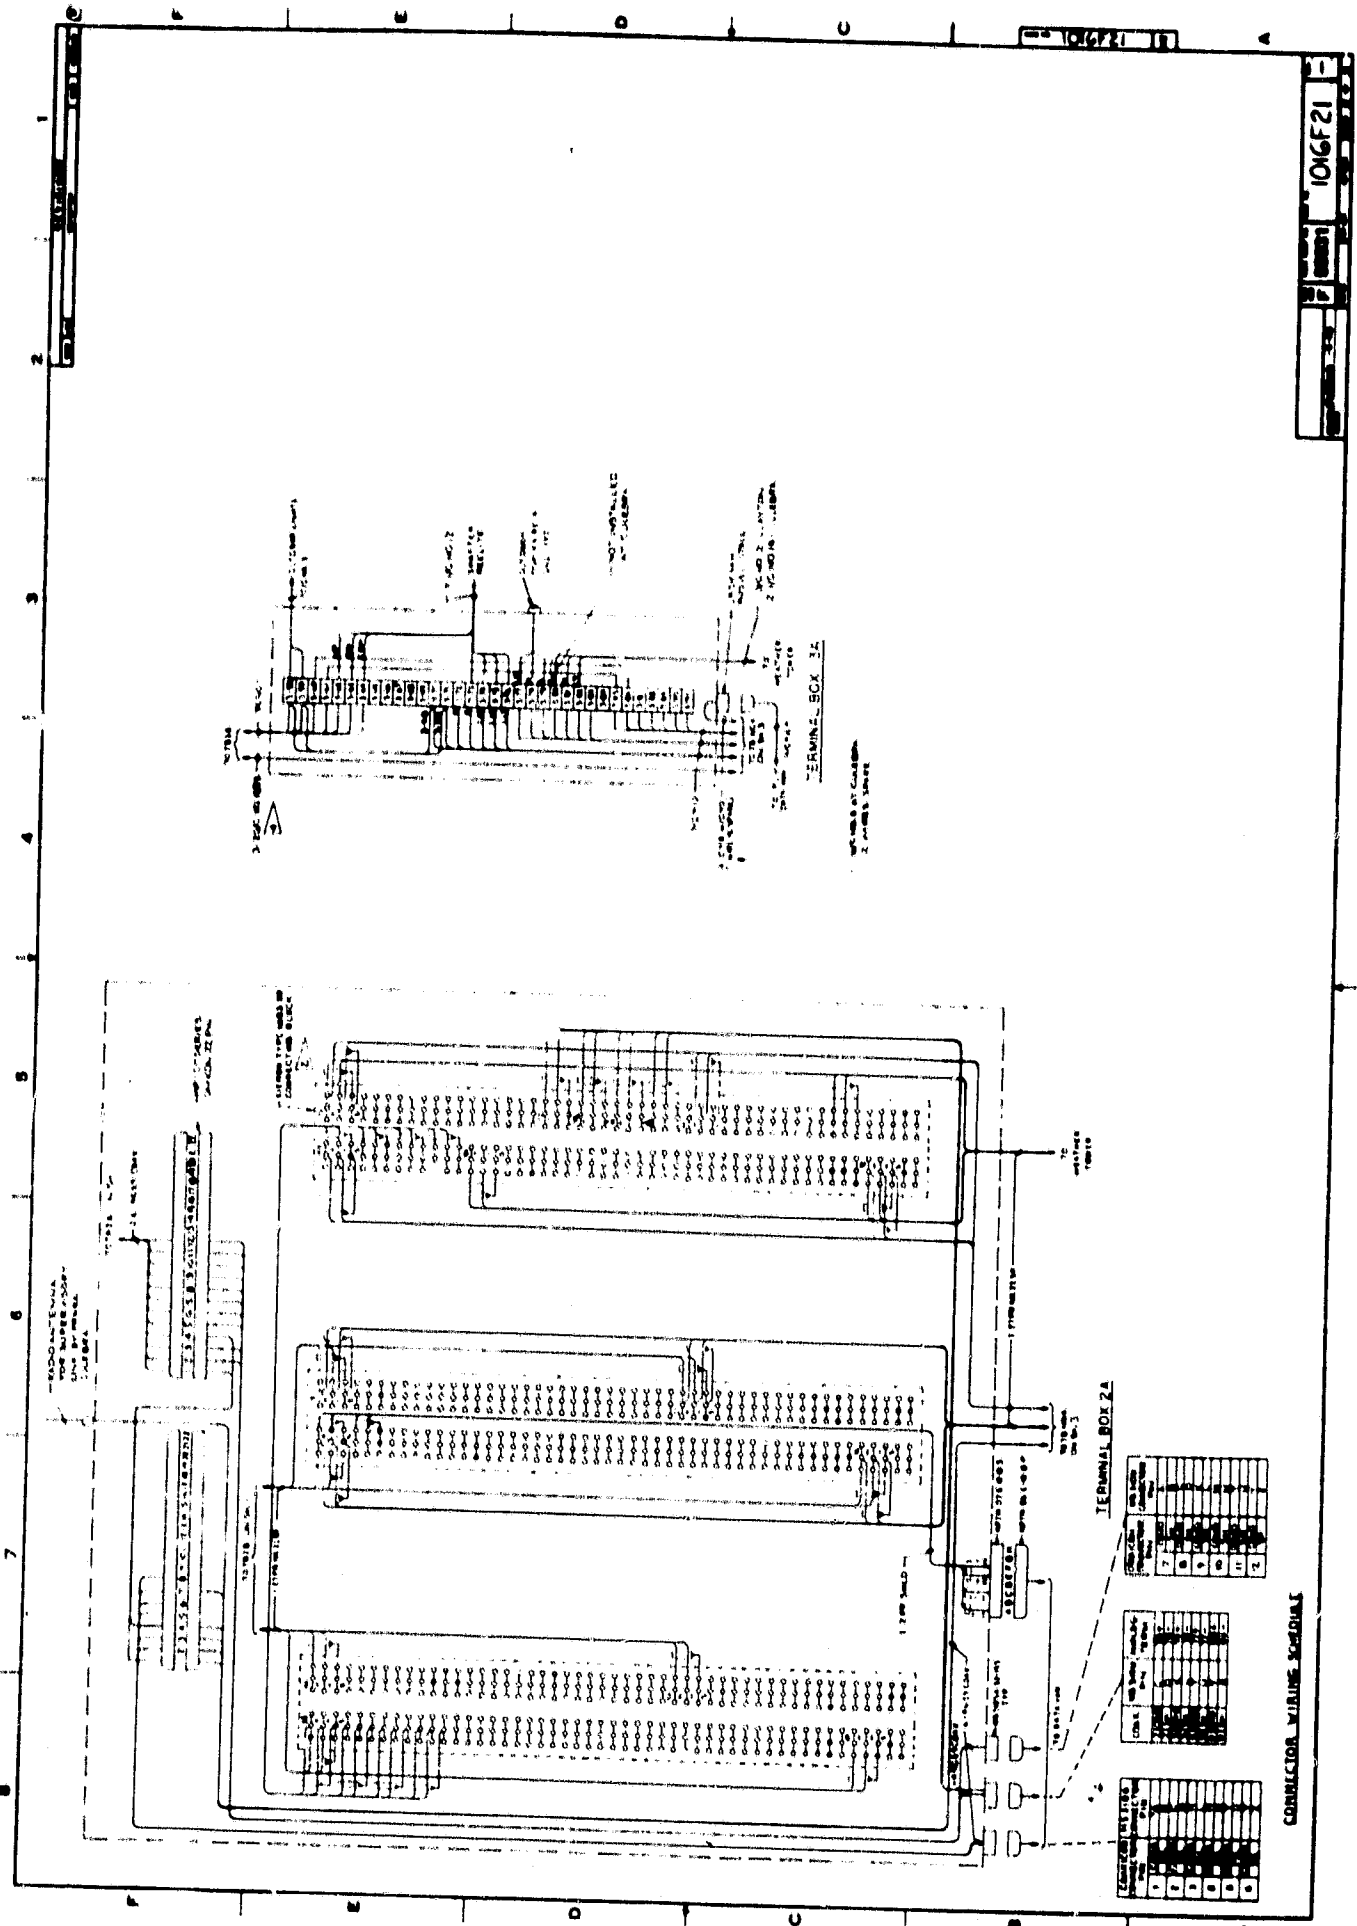

106GF21

CONNECTOR WIRING SCHEMATIC

TERMINAL BOX 3A

TERMINAL BOX 2A






















106GF21

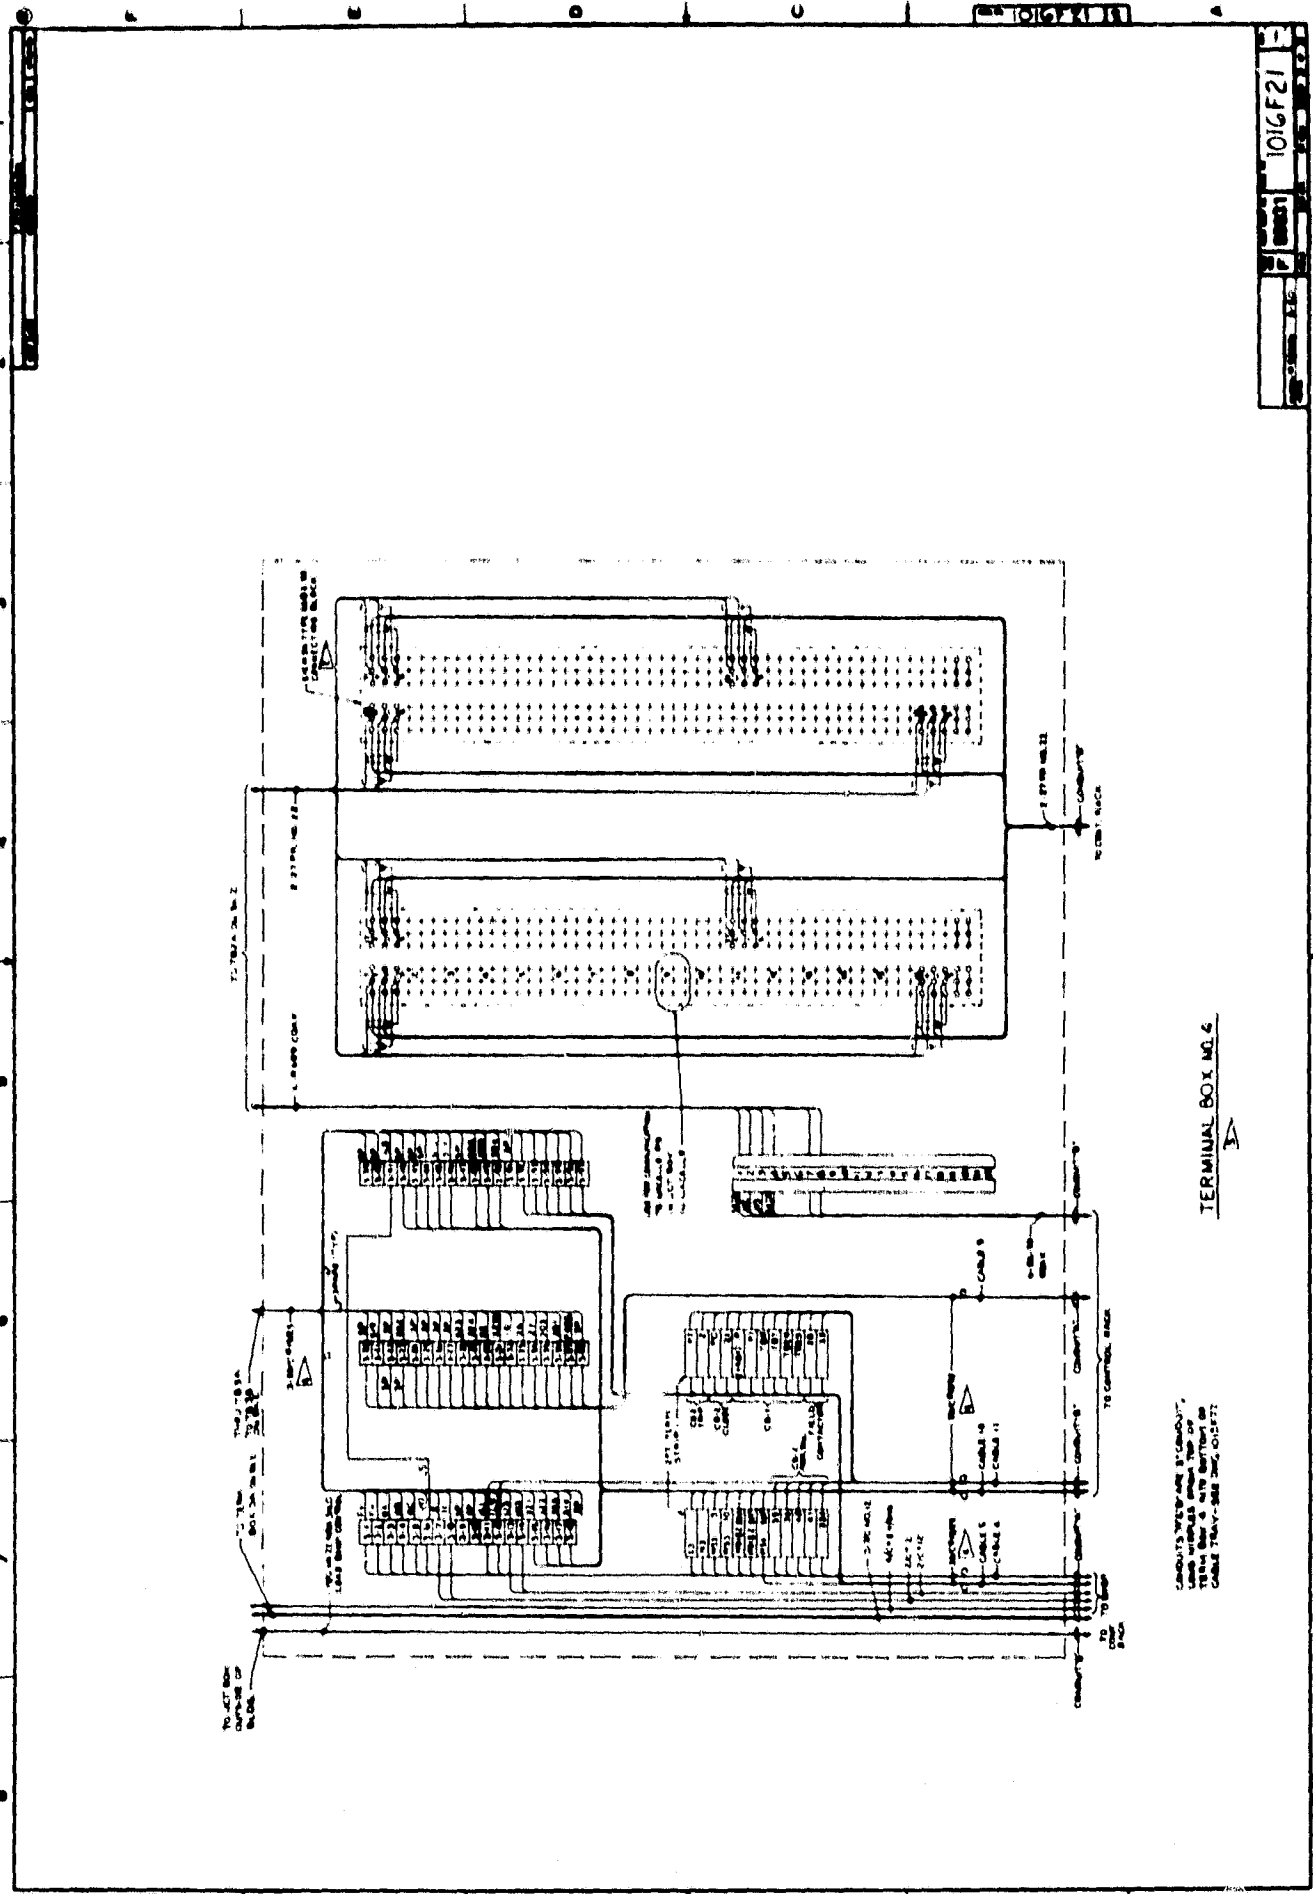


1016F21



CABLES W/IN ARE "C" CABLES
 USE W/IN ARE "B" CABLES
 CABLE TRAY-SEE FIG. 1016F21

376

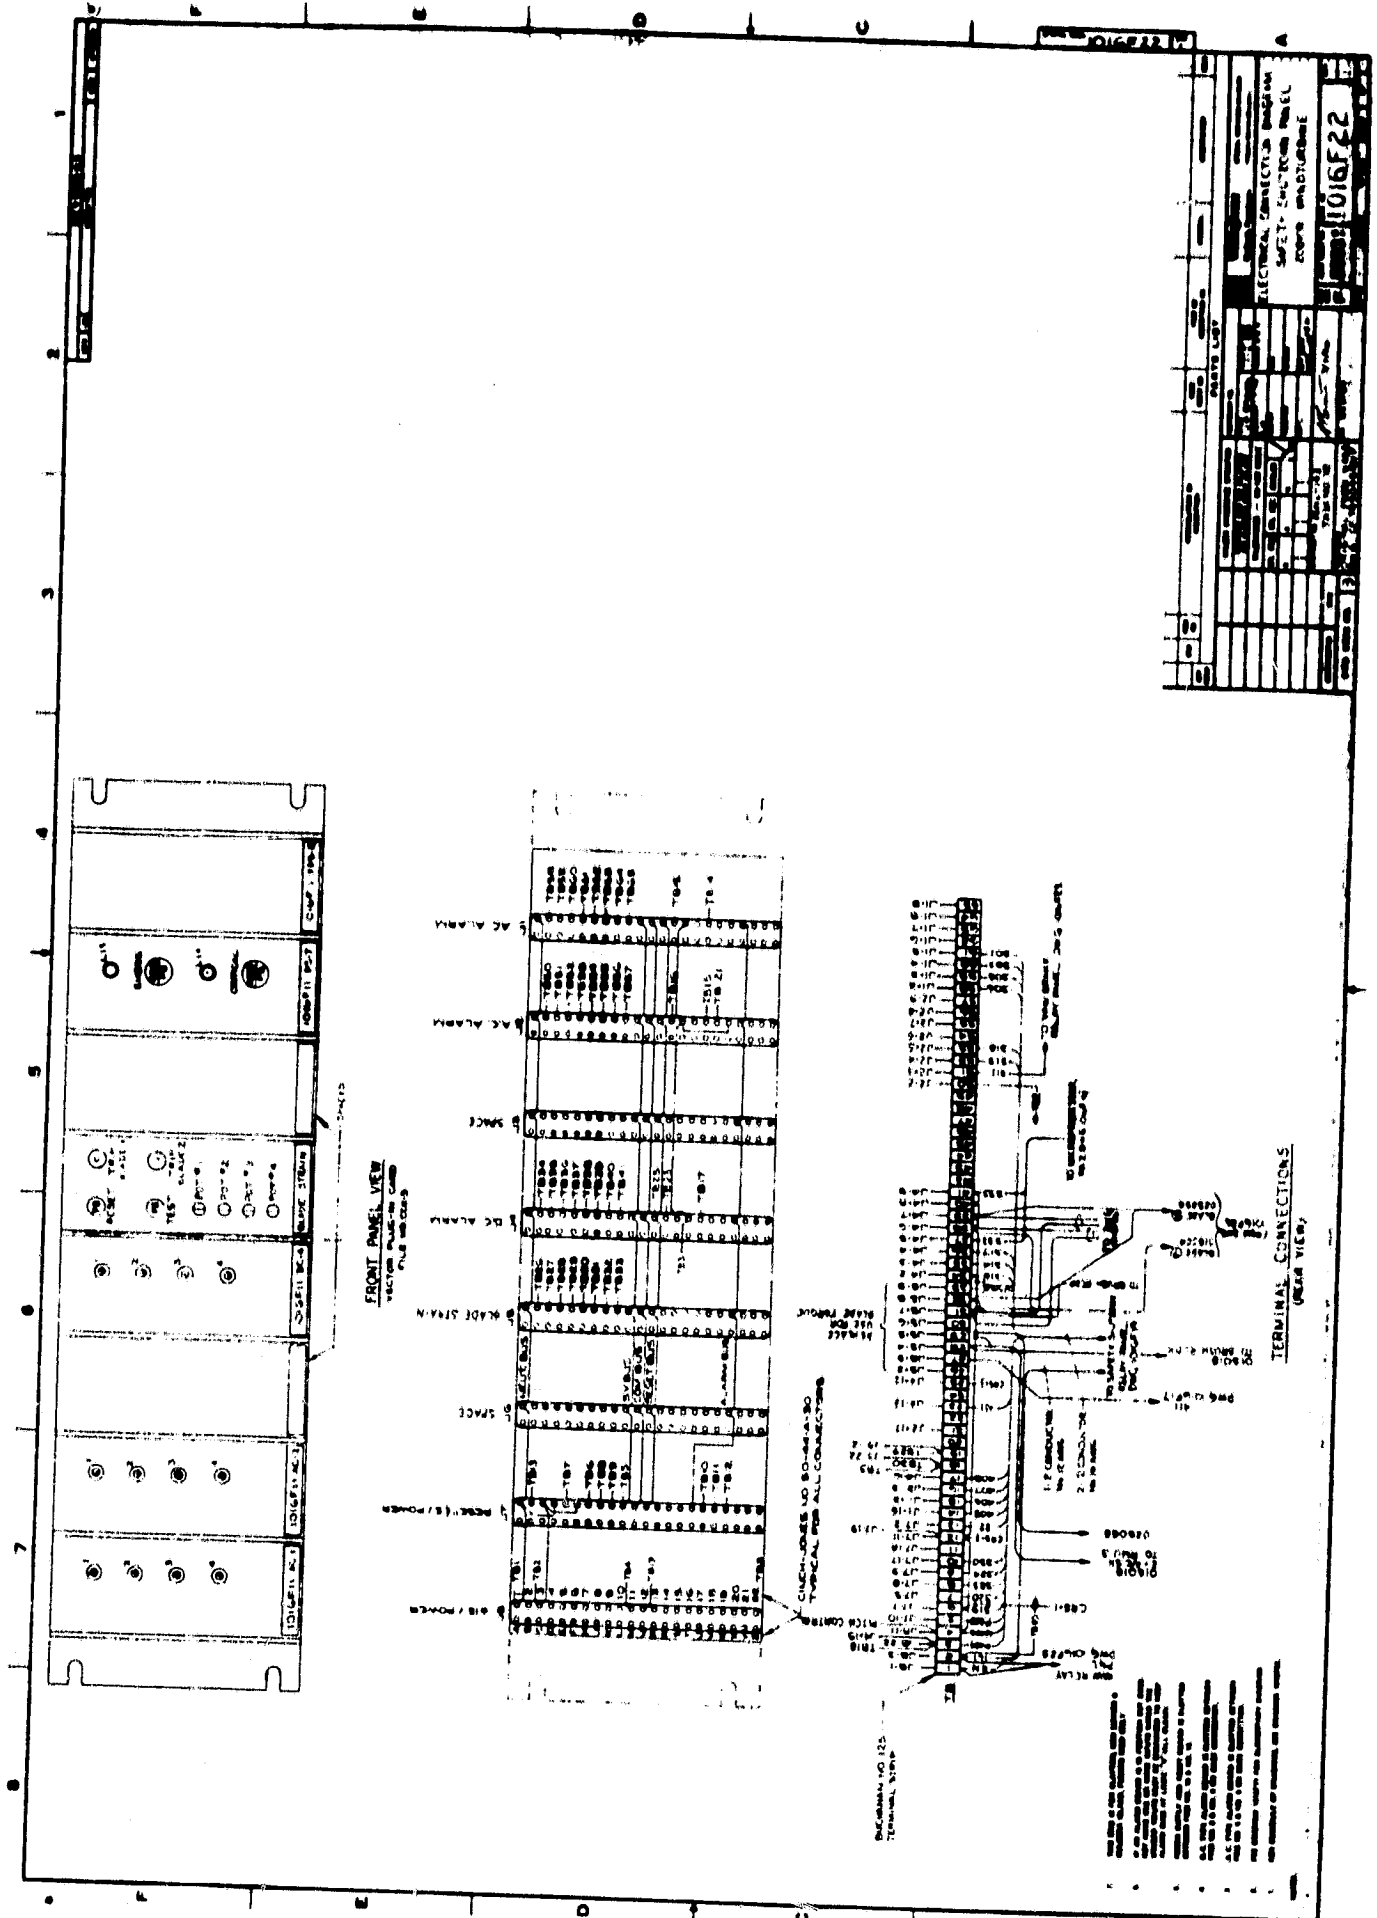

979

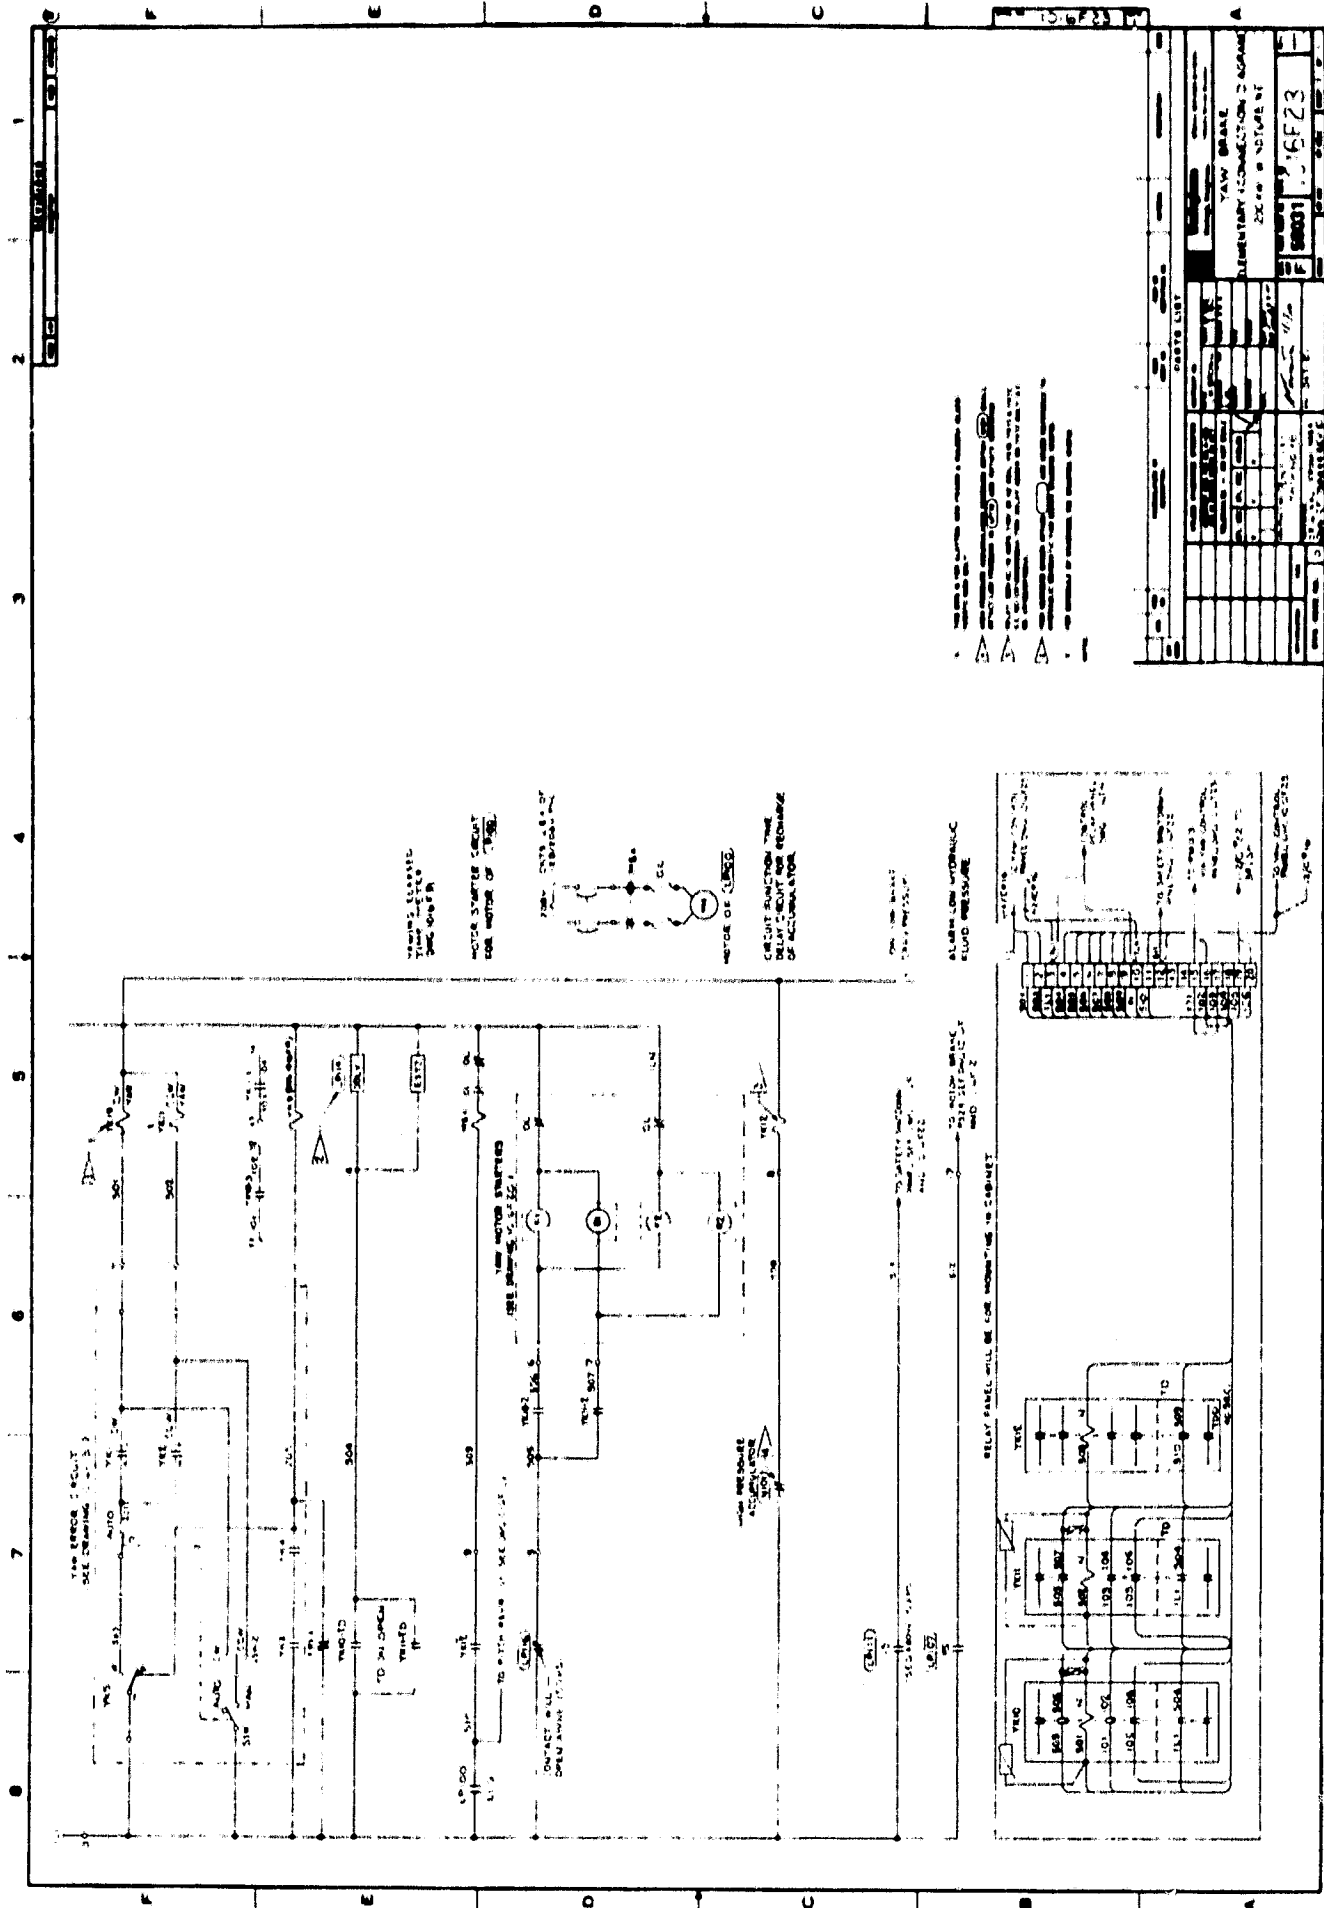






ALARM LOW HYDRAULIC FLUID PRESSURE.

RELAY PANEL WILL BE LOCATED IN THE CABINET.



PARTS LIST	
16F23

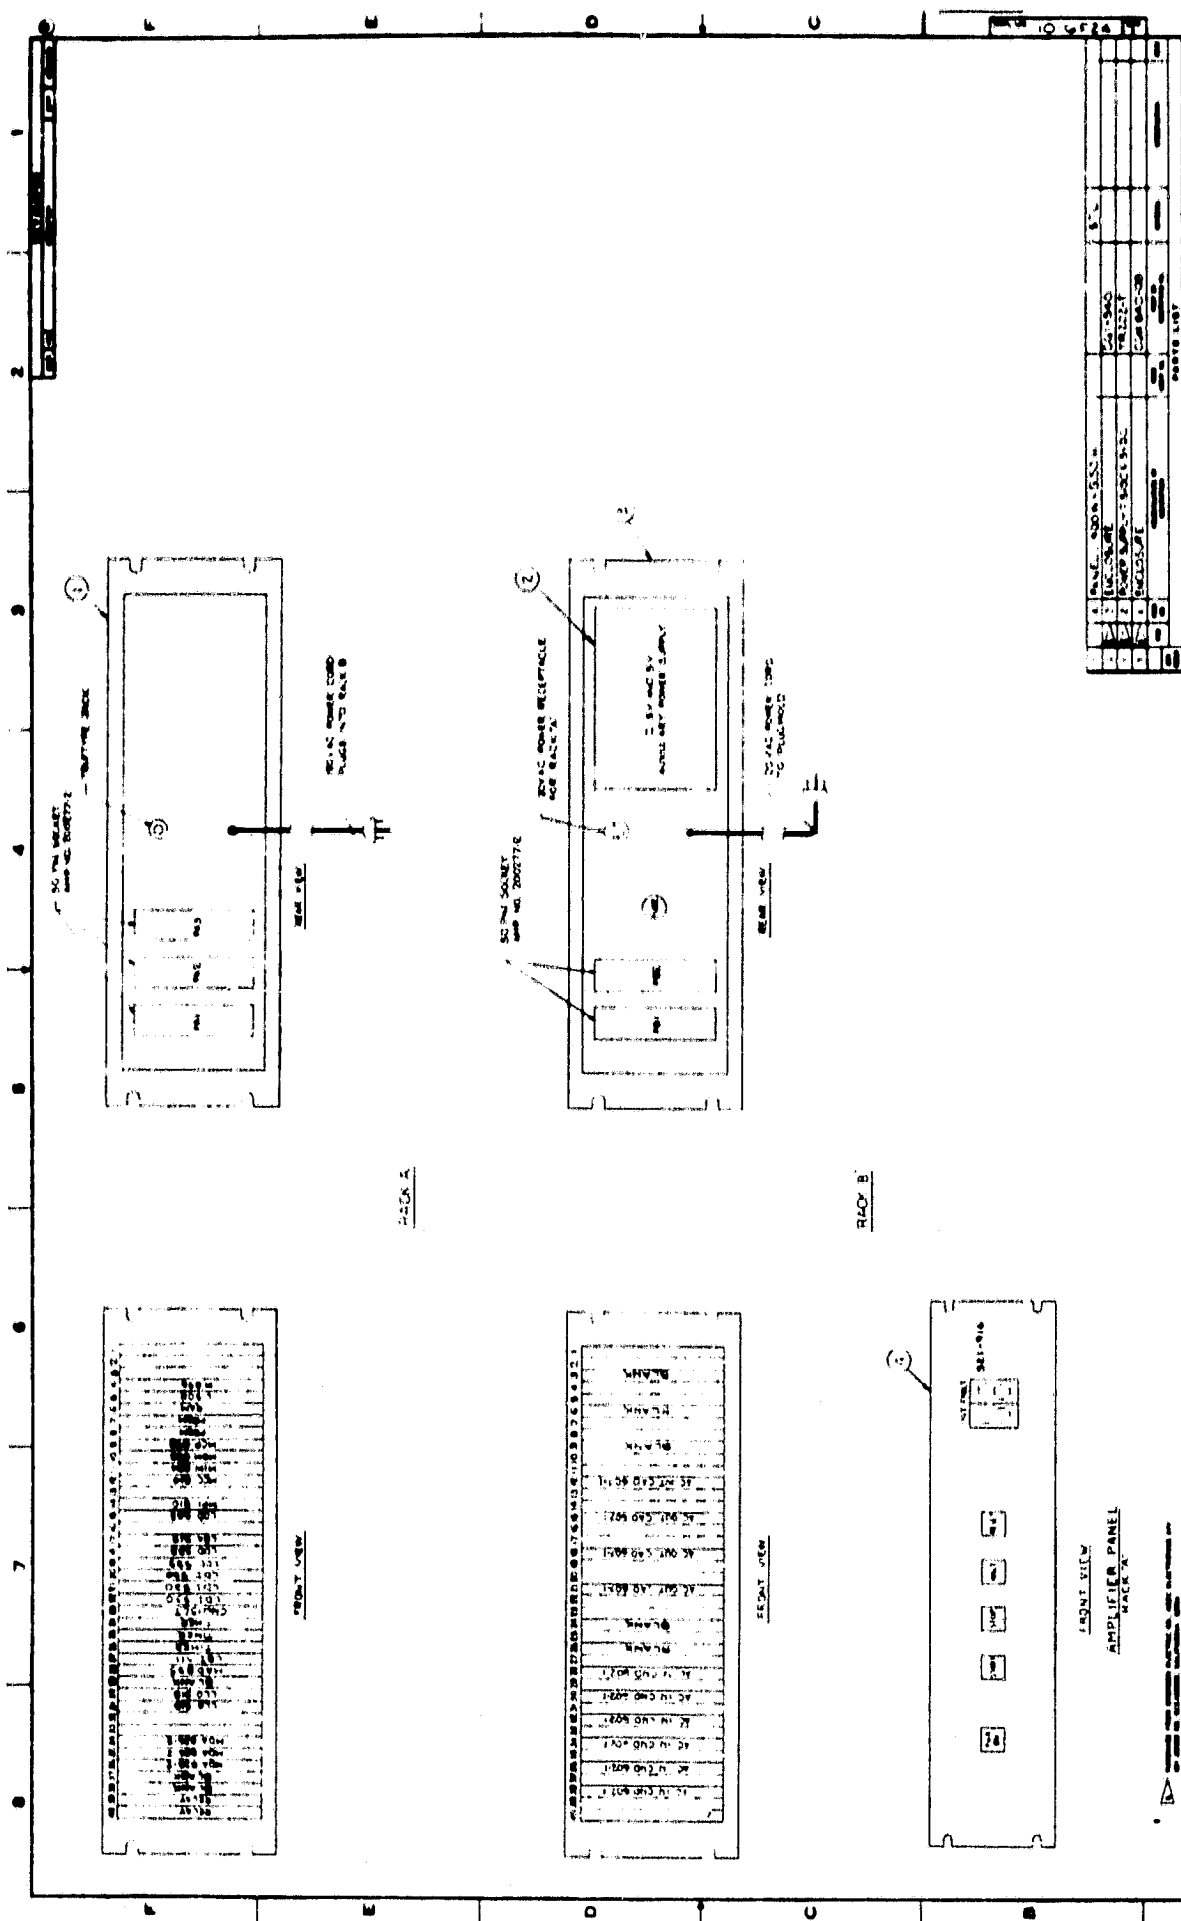

RACK A

RACK B


FRONT VIEW
AMPLIFIED PANEL
RACK A

PART LIST	


1016 F24

0370

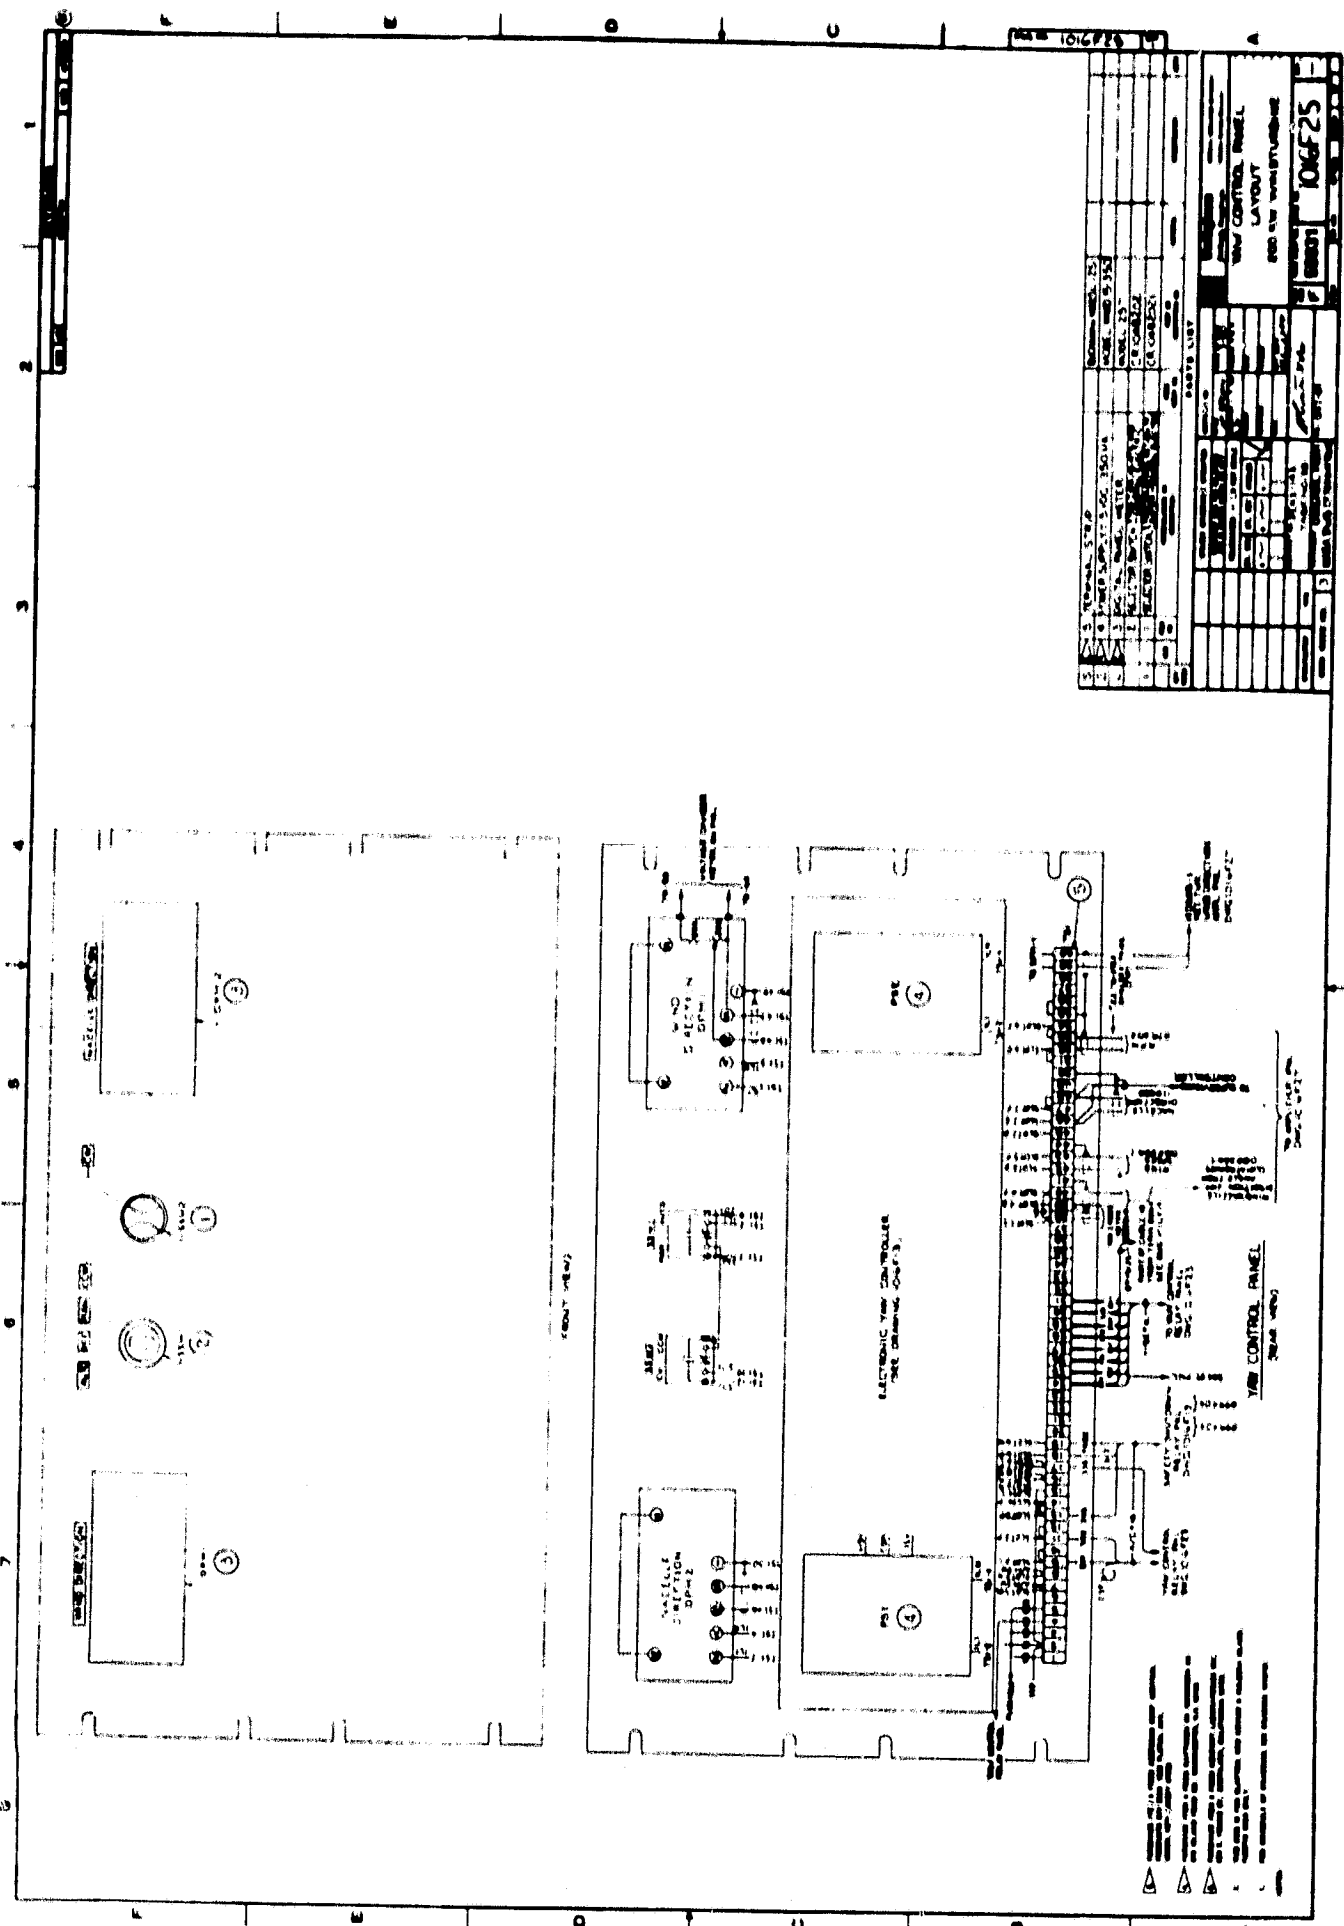


PARTS LIST	
NO.	DESCRIPTION
1	...
2	...
100

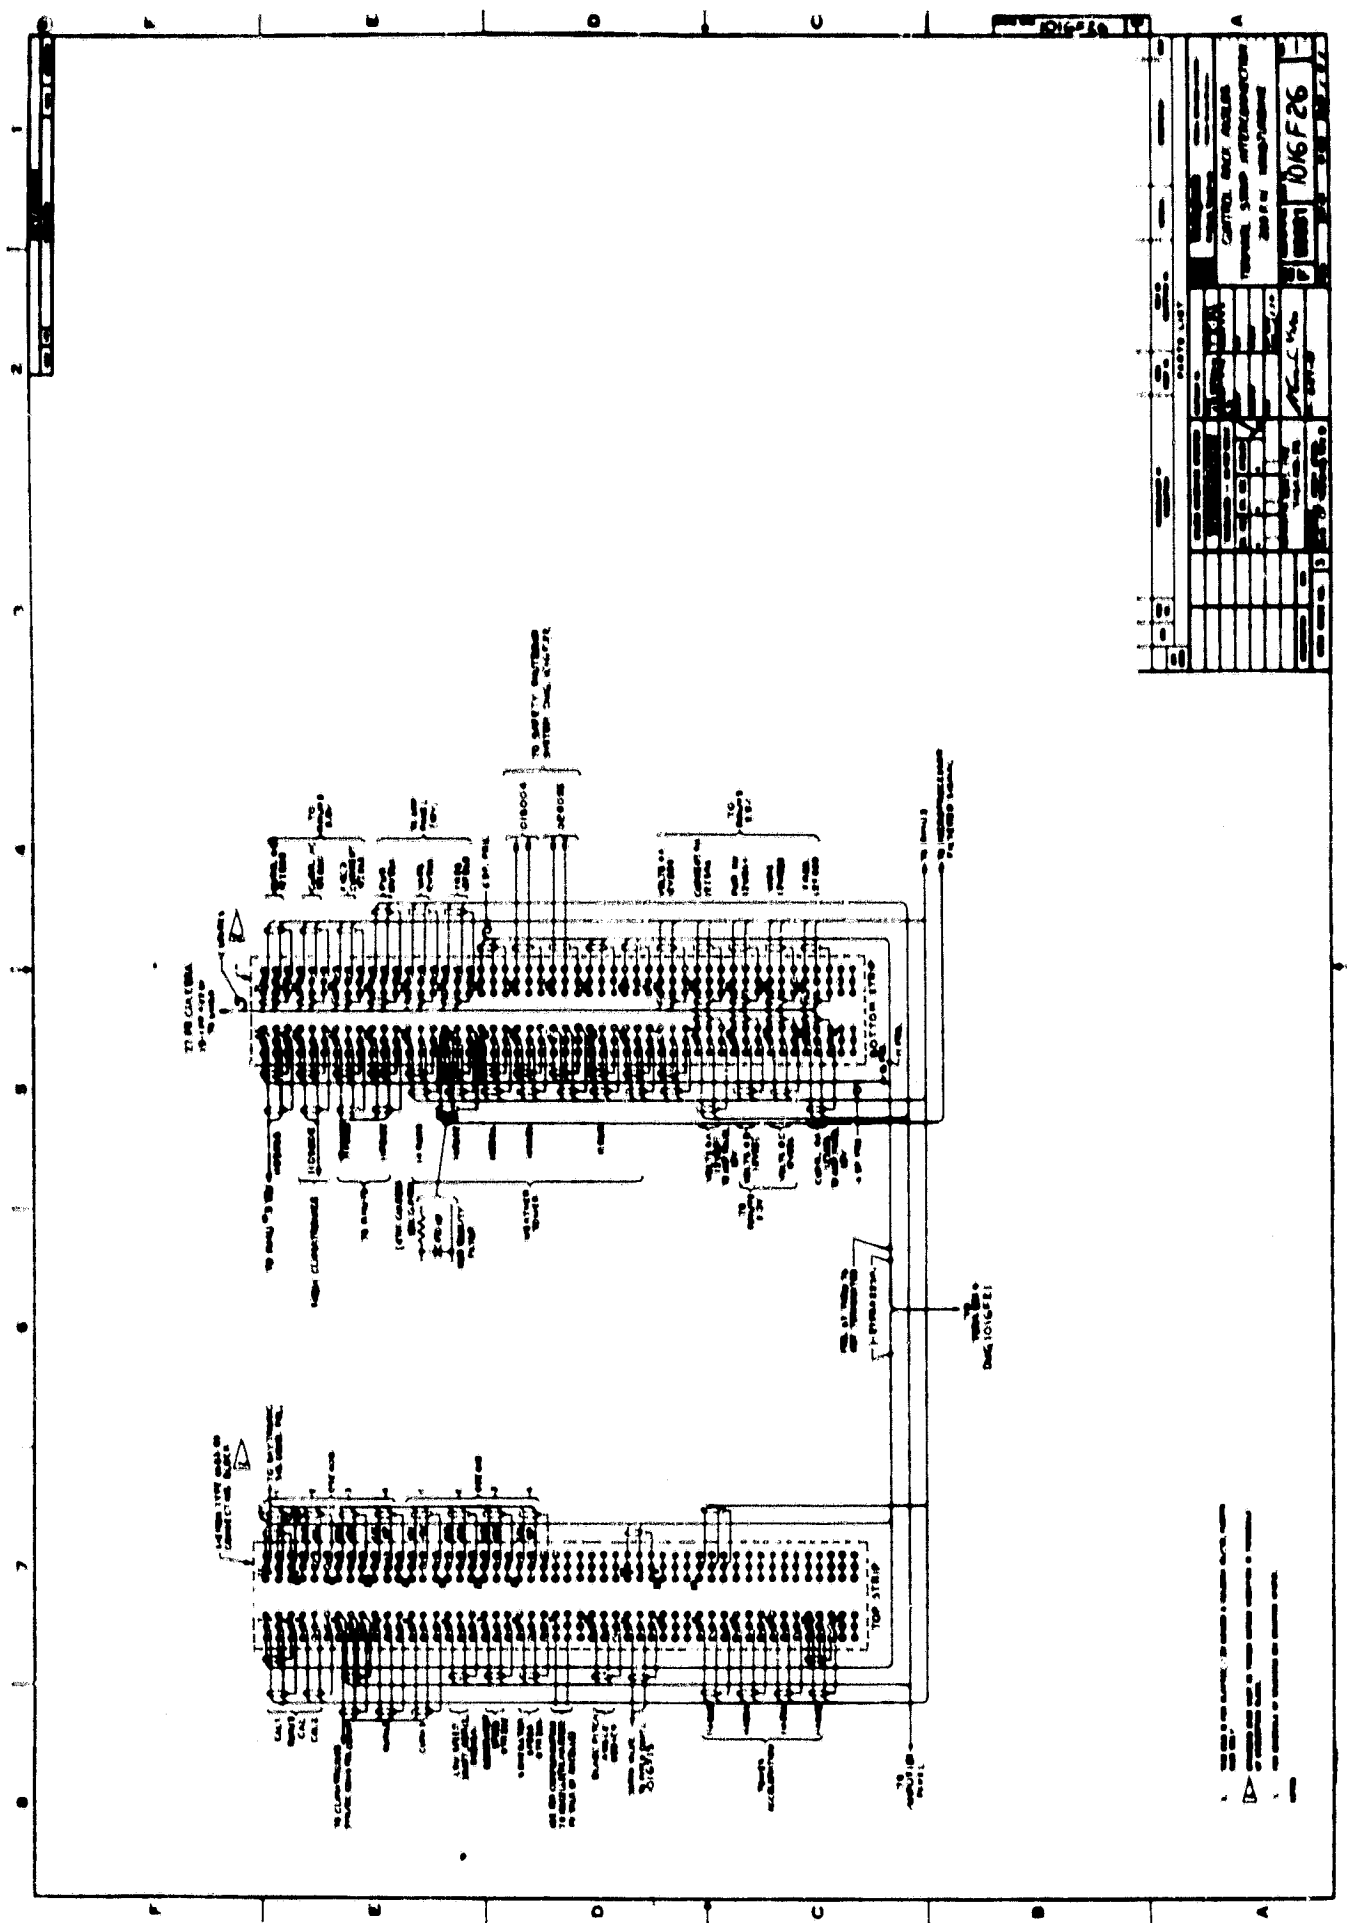

PROJECT NO.	
DATE	
SCALE	
DRWG. NO.	1016 F 26
CUSTOMER	...
DESIGNER	
CHECKED BY	
APPROVED BY	

Notes:
 1. ...
 2. ...
 3. ...

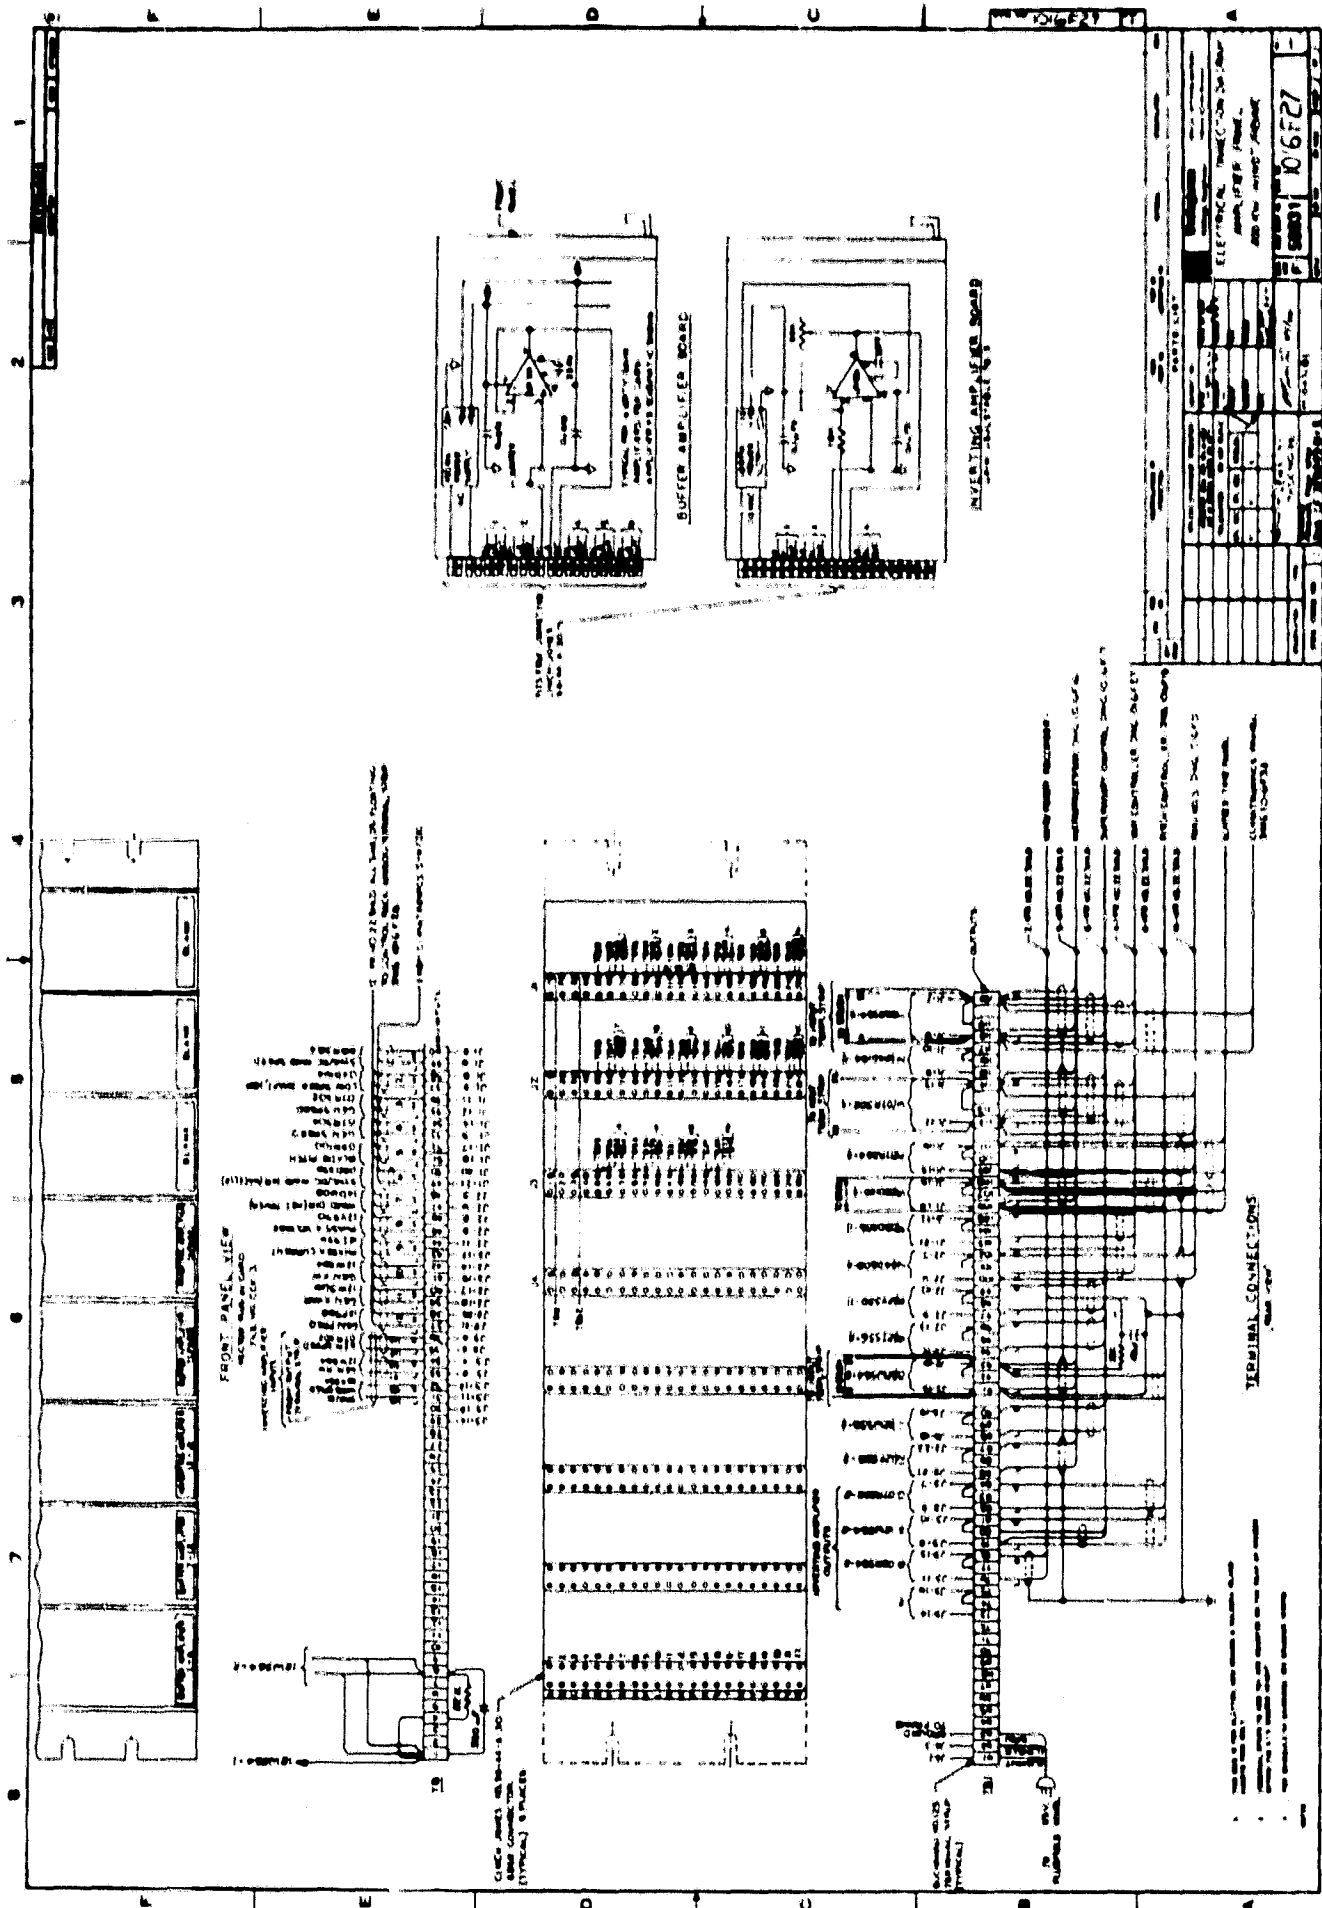

FRONT PANEL VIEW


BUFFER AMPLIFIER BOARD

INVERTING AMPLIFIER BOARD

TERMINAL CONNECTIONS

JAMES H. ...

1	2	3	4	5	6	7
<p>ORIGINAL PAGE IS OF POOR QUALITY</p>						



---	---	---	---	---	---	---	---	---	----	----	-----






101626

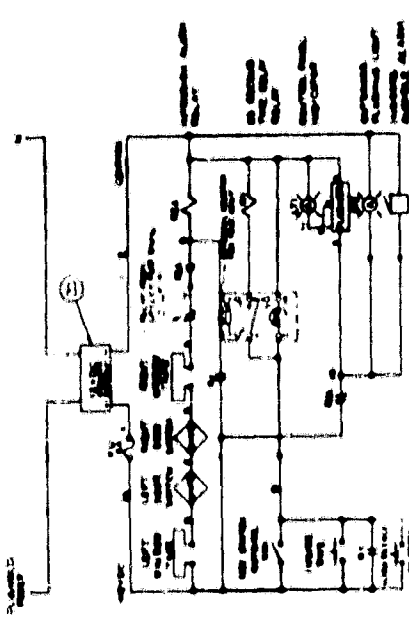


REVERSE POLARITY PROTECTION

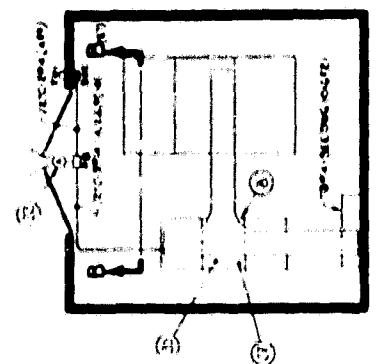



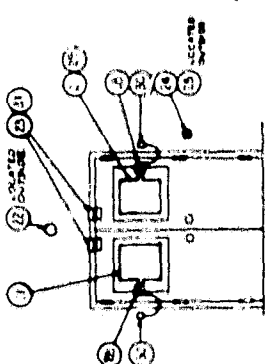


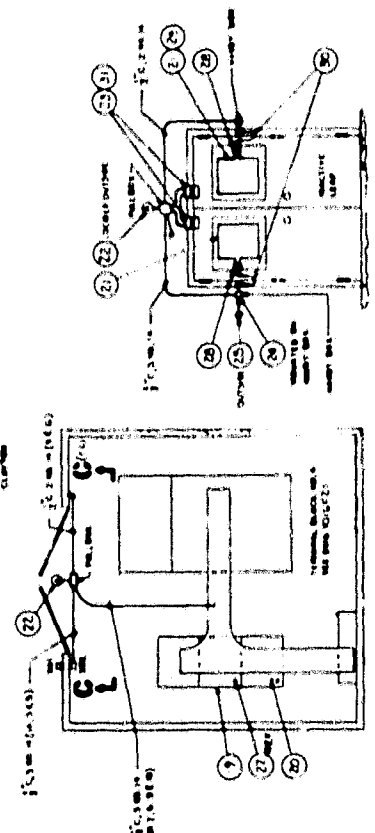



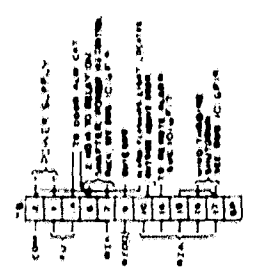

TERMINAL CONNECTIONS



GROUP NO.	PART NO.
1	1016700-1
2	1016700-2




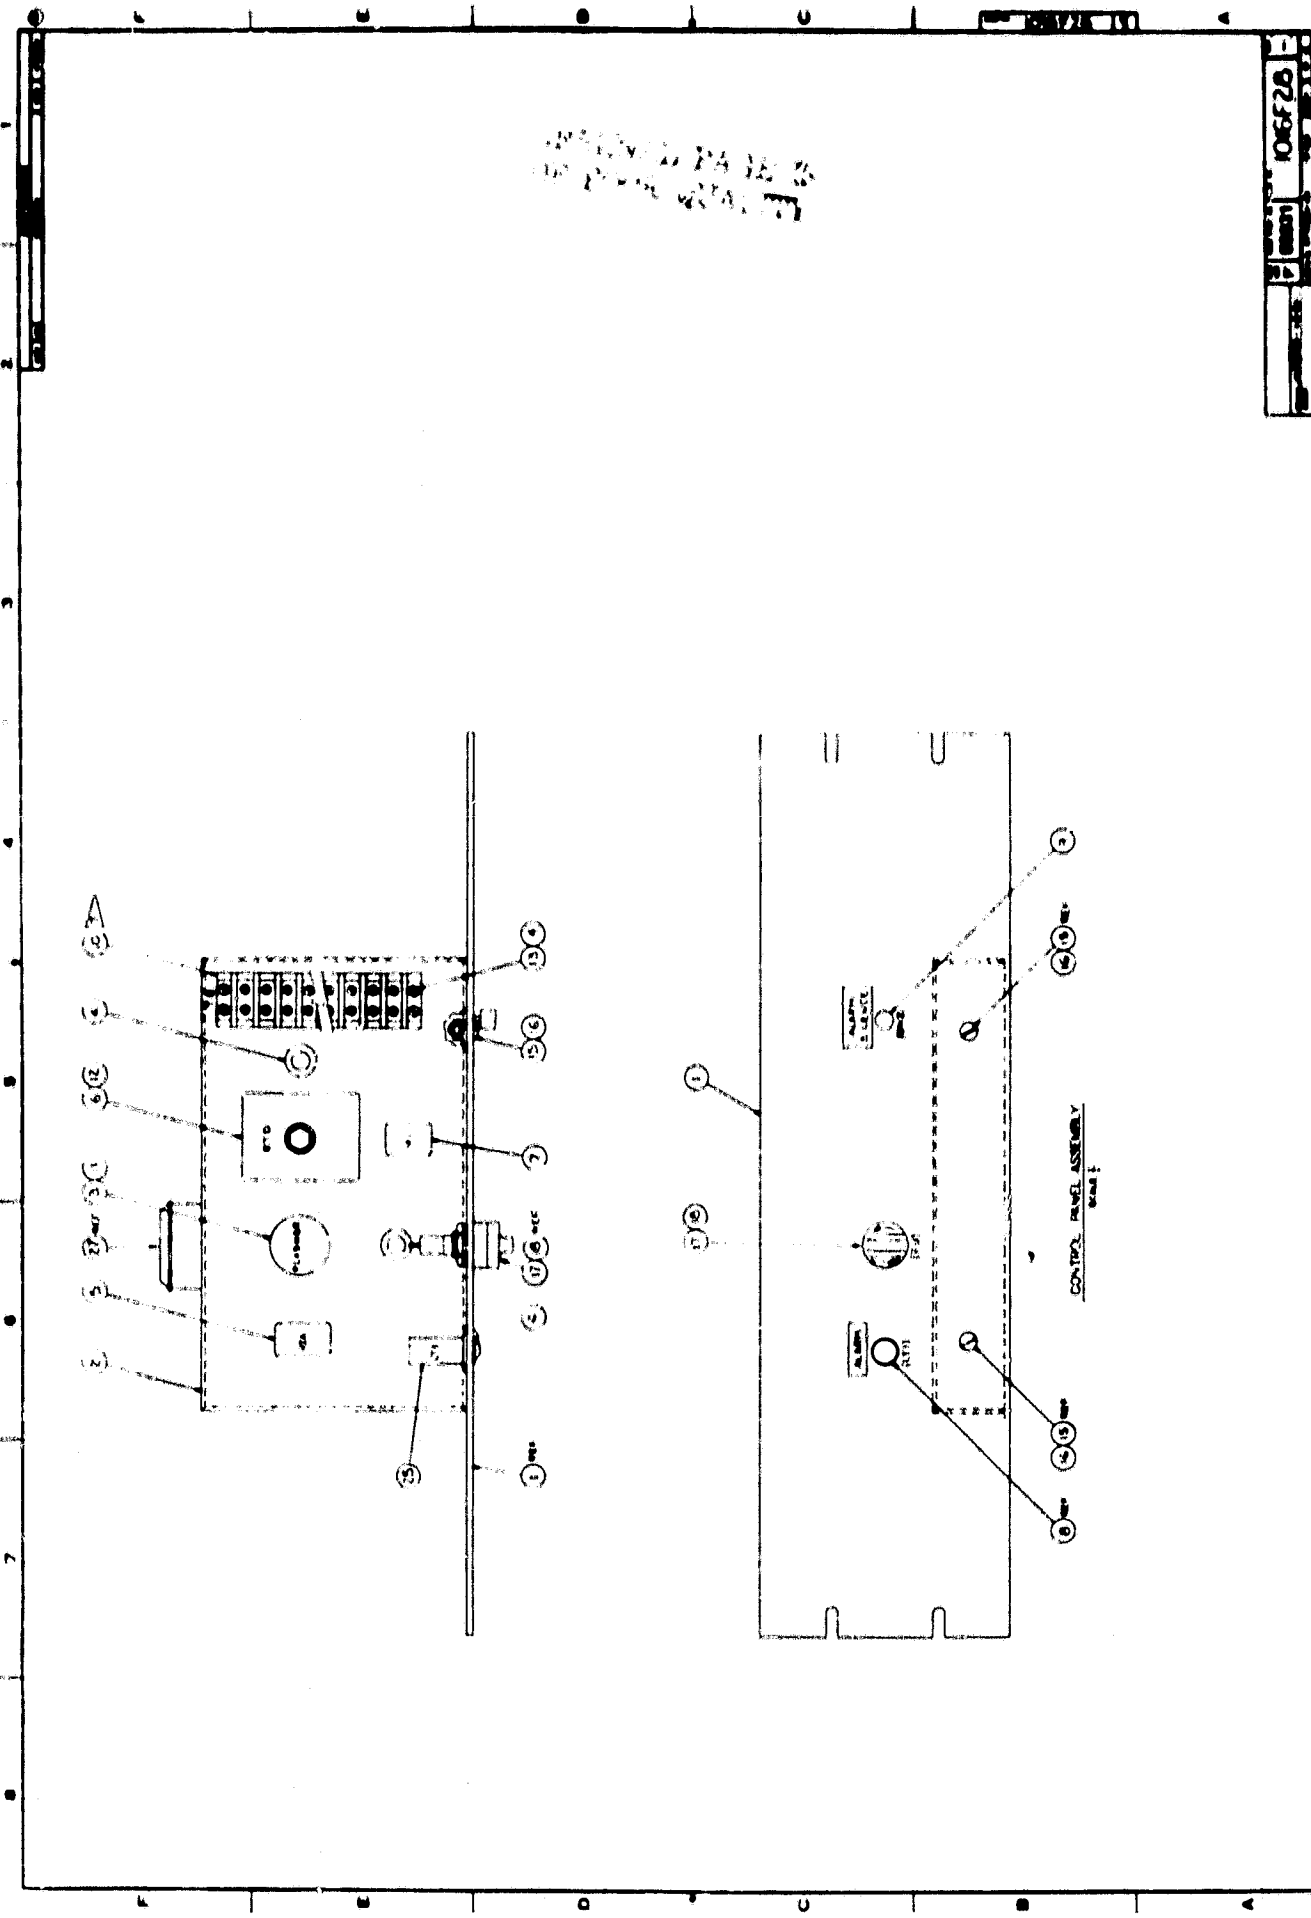

106F2A
 CONTROL PANEL ASSEMBLY

106F2A
 CONTROL PANEL ASSEMBLY

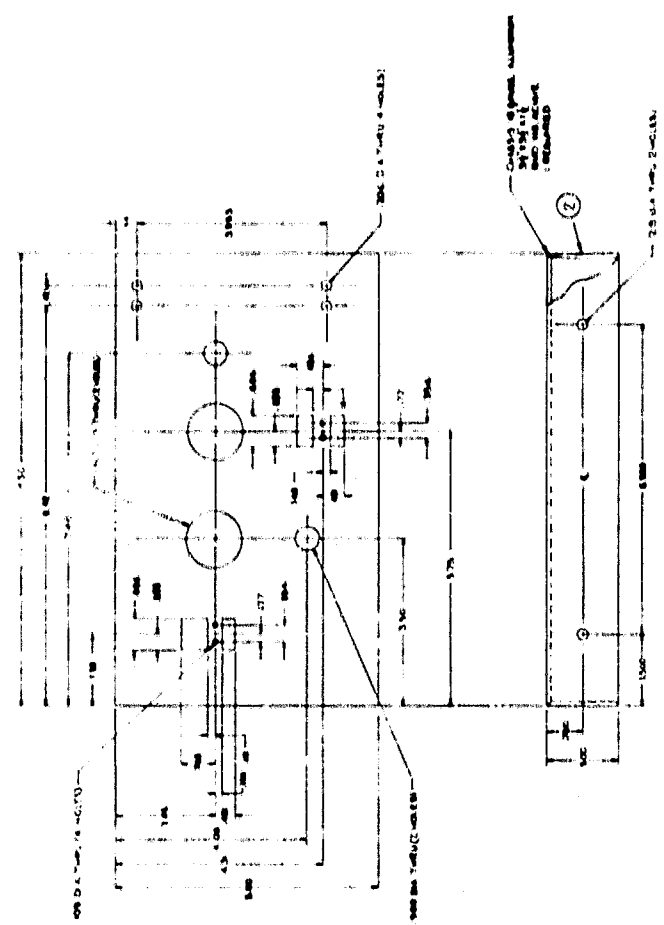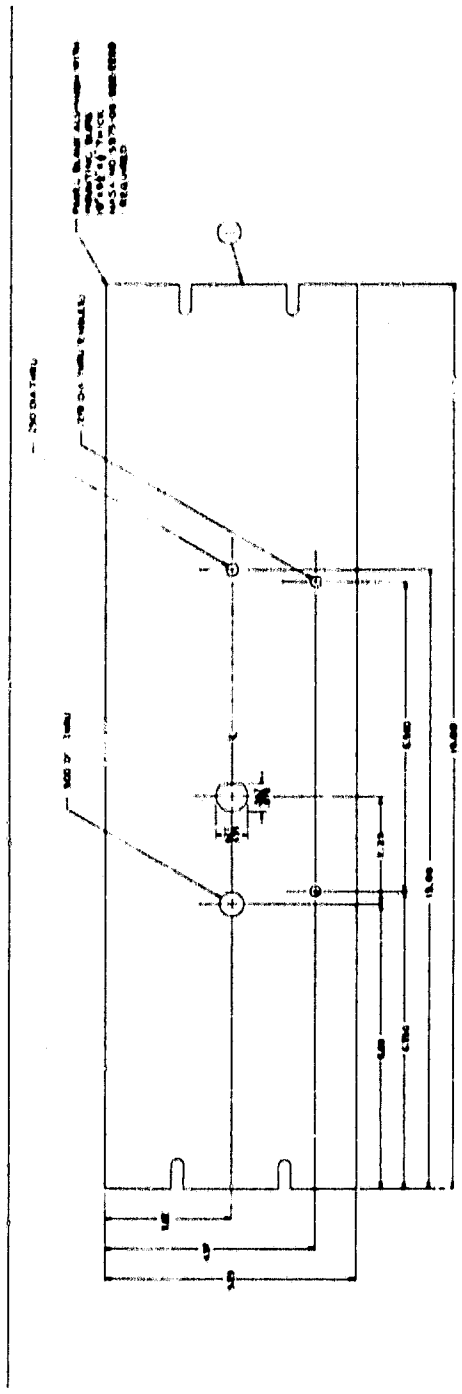

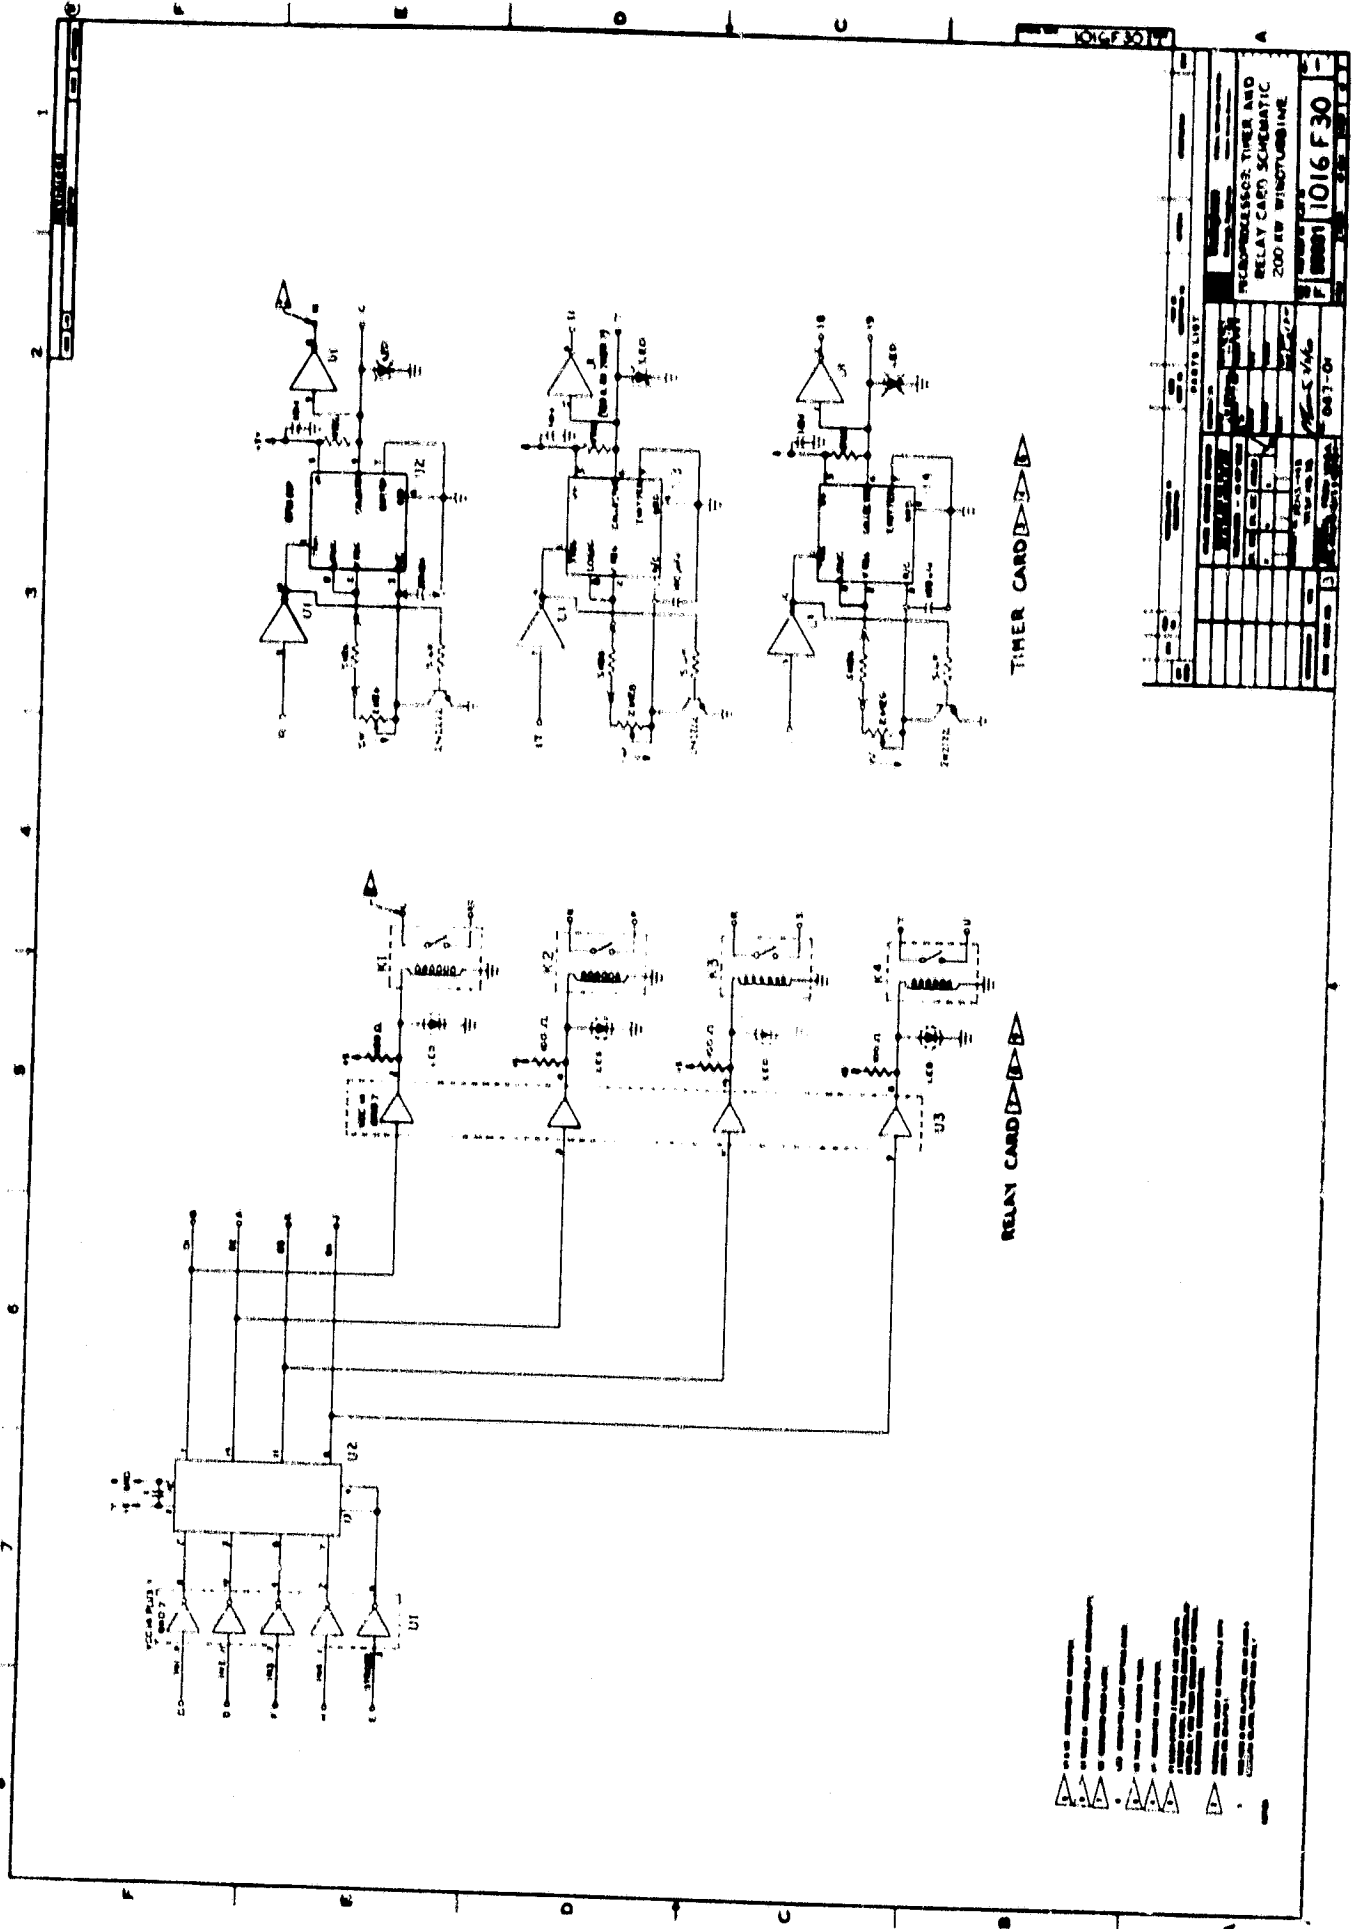


TIMER CARD

RELAY CARD


- ▲ U1
- ▲ U2
- ▲ U3
- ▲ K1
- ▲ K2
- ▲ K3
- ▲ K4

1016 F30			
MICROPROCESSOR TIMER AND RELAY CARD SCHEMATIC			
DATE	04-7-01		
DESIGNER	...		
CHECKED	...		
APPROVED	...		
PARTS LIST			
NO.	DESCRIPTION	QTY	REF.





1 2 3 4 5 6 7 8

 

FRONT PANEL VIEW
 (SEE NOTE 1)
 (SEE NOTE 2)

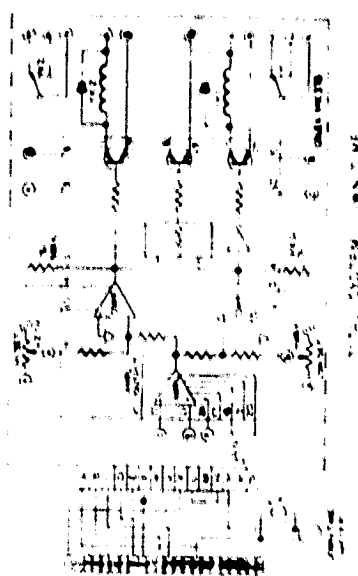

WIRE SYSTEM SCHEMATIC

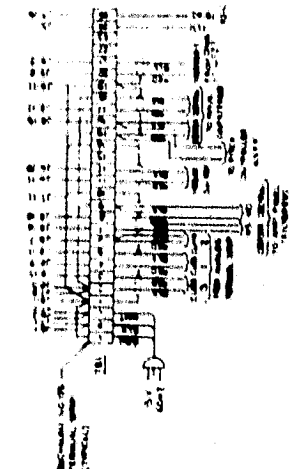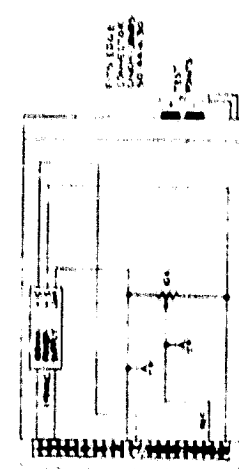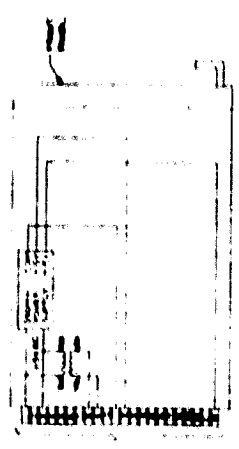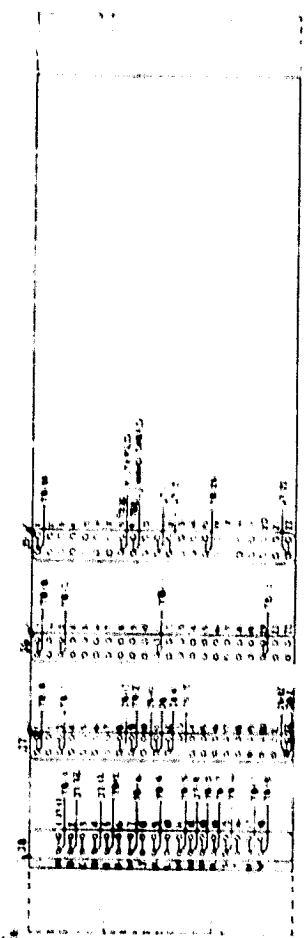


PARTS LIST	
QTY	DESCRIPTION
1	CLIMATIC REFERENCE BOARD
1	A.C. POWER SUPPLY BOARD
1	MAGNETIC POSITION REFERENCE BOARD
1	CONTROL SYSTEM BOARD
1	FRONT PANEL
1	TERMINAL BLOCK
1	WIRE SYSTEM

TERMINAL CONNECTION DIAGRAM
 (FROM VIEW 1)


ELECTRICAL CONNECTION DIAGRAM
 CLIMATIC REFERENCE BOARD
 A.C. POWER SUPPLY BOARD

106F33

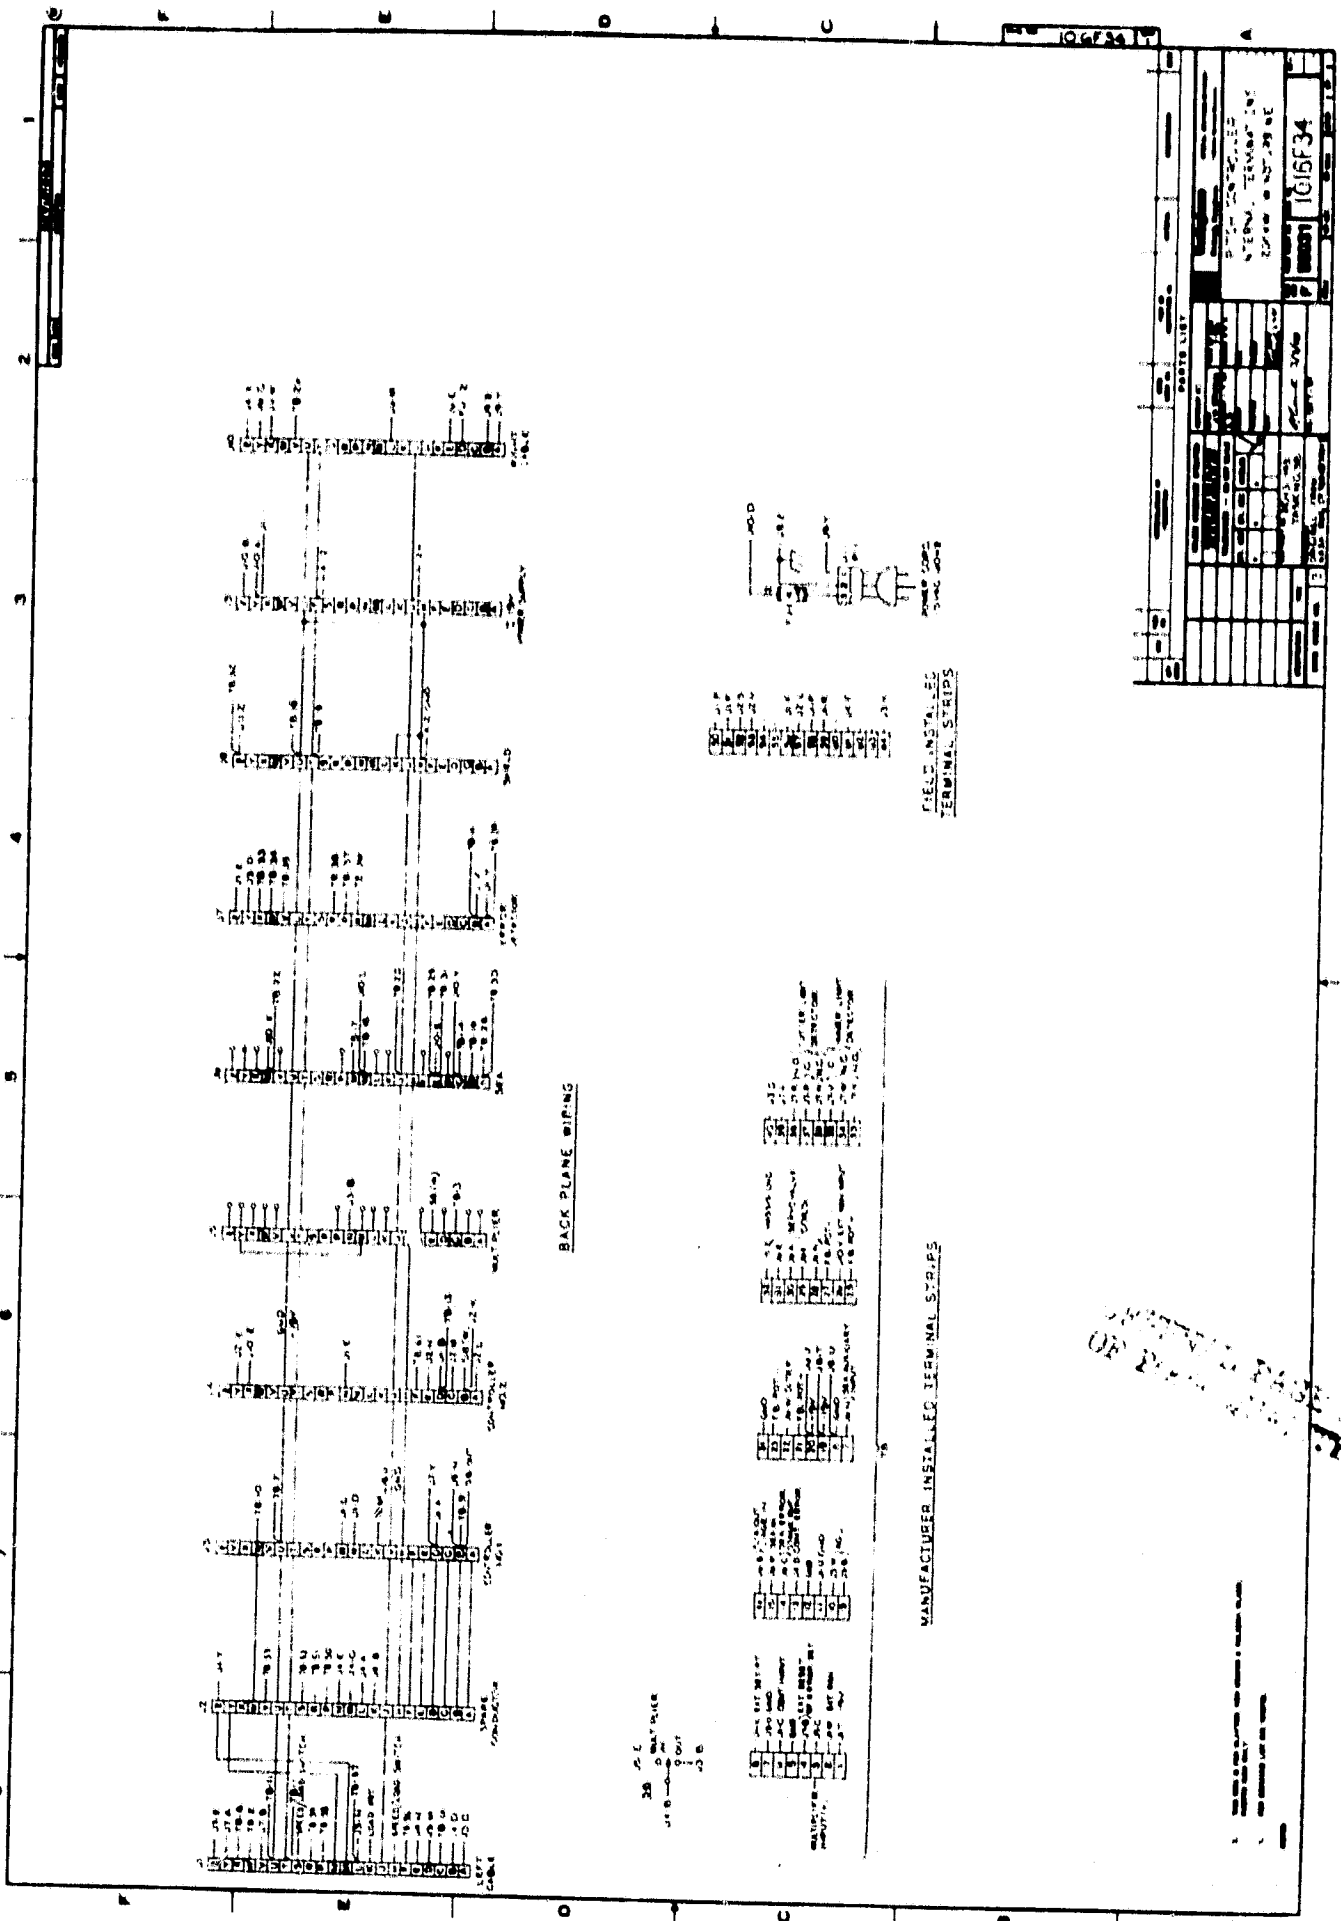


MANUFACTURER INSTALLED TERMINAL STRIPS




10/16/34	1016F34				

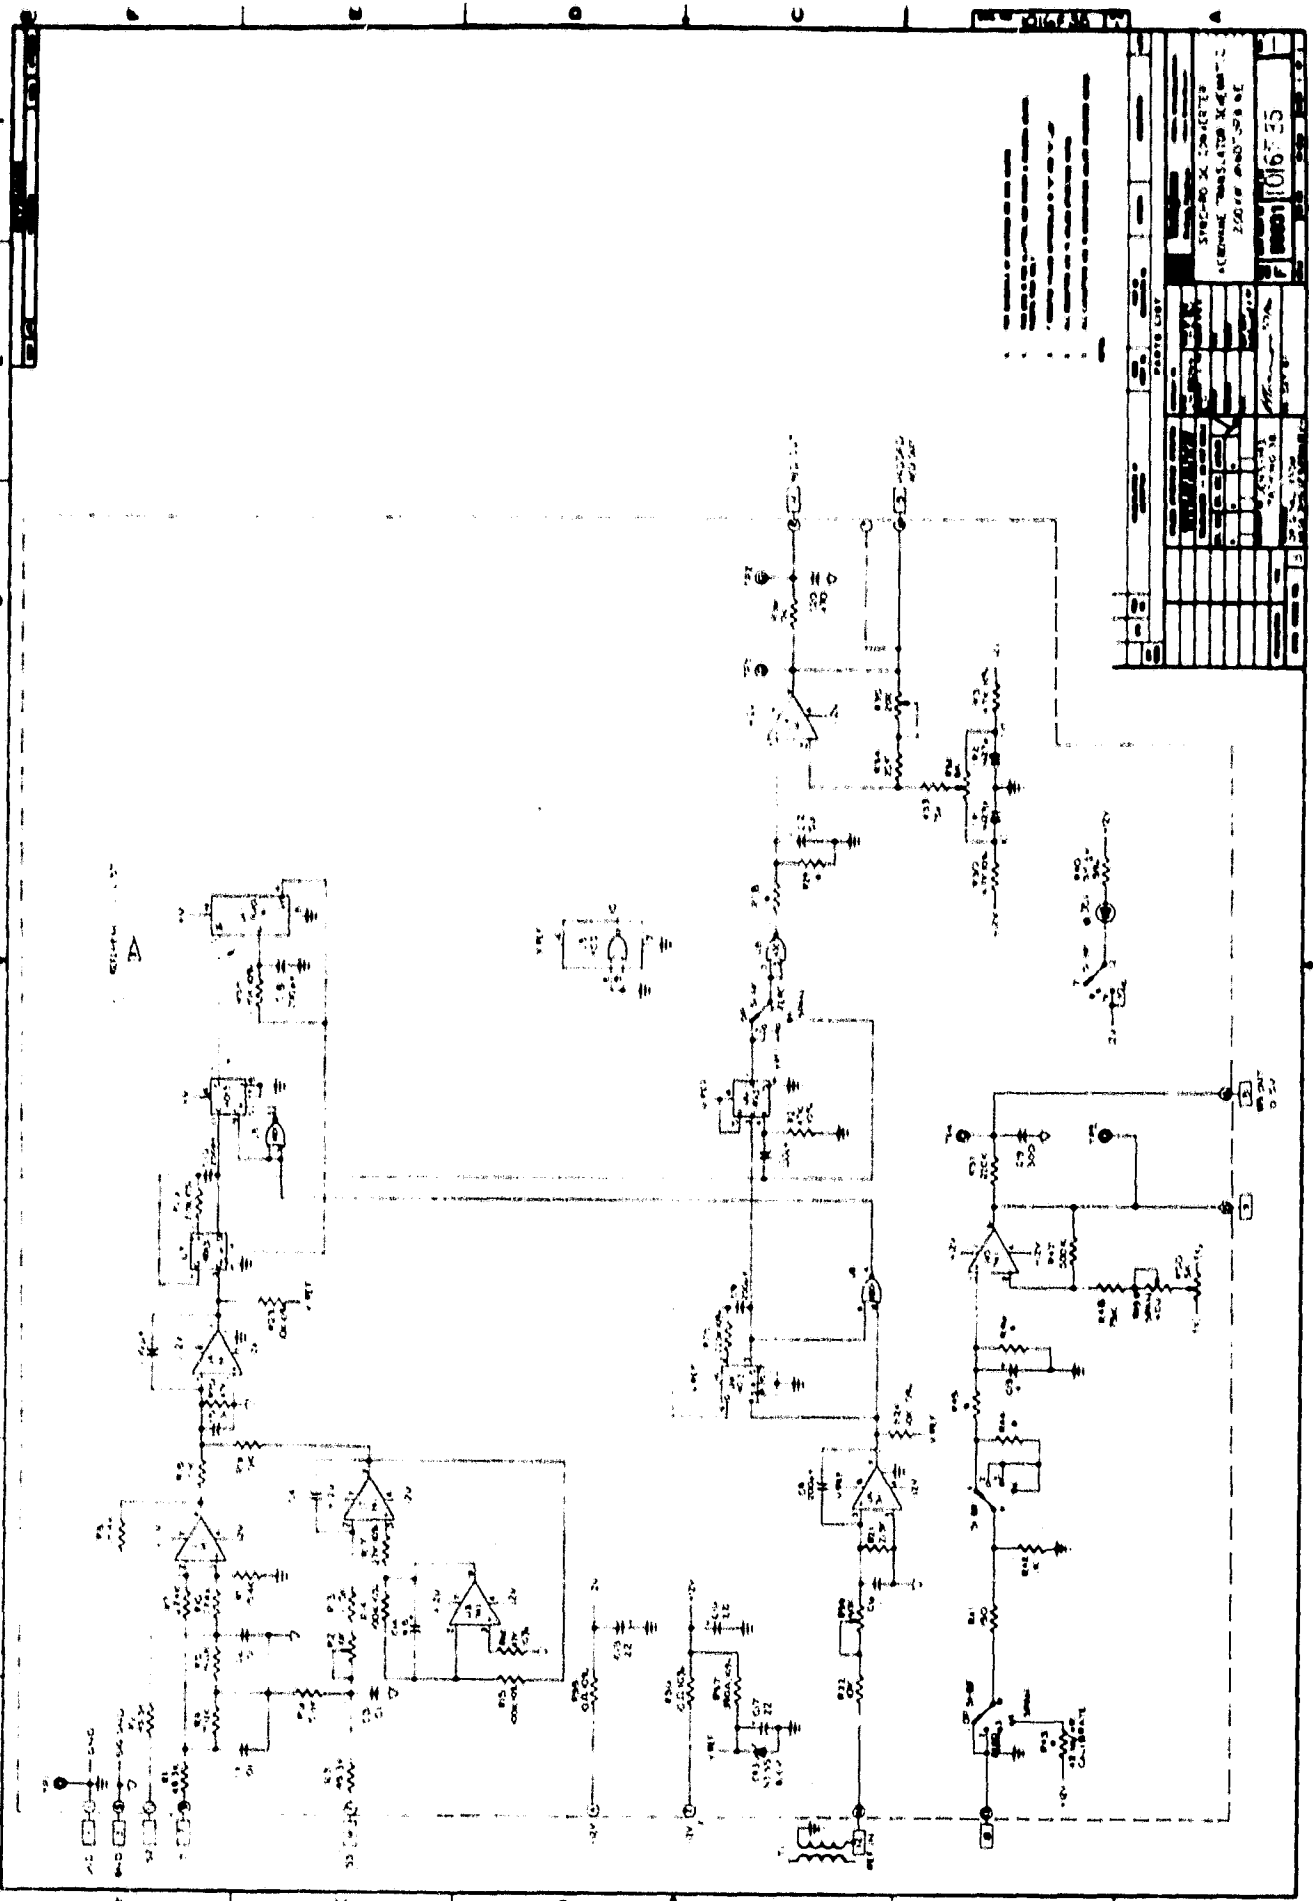



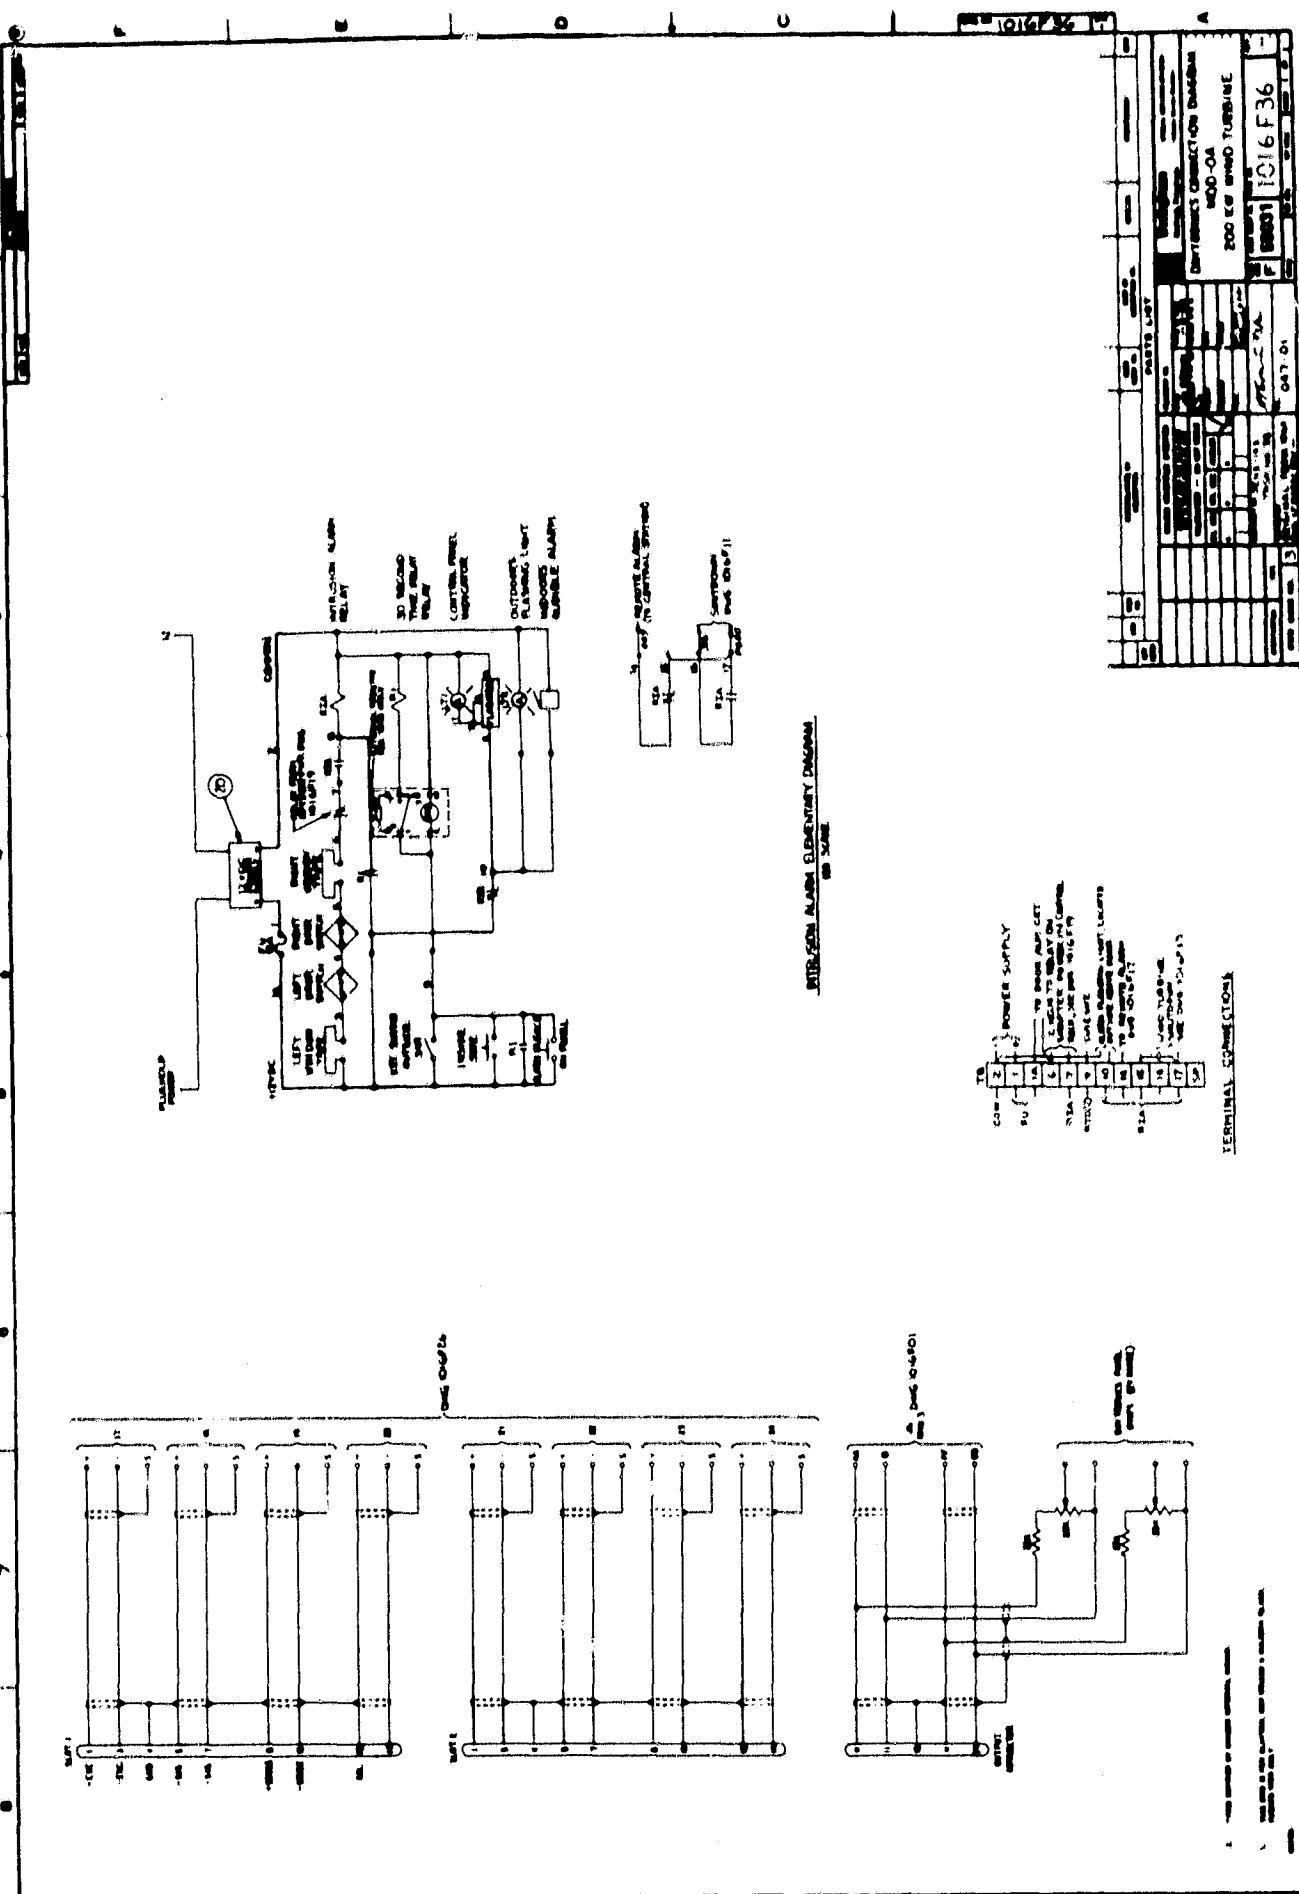


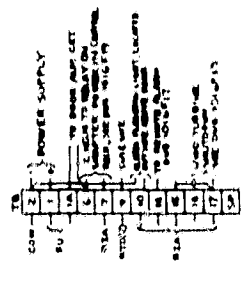

